

Addendum Number 2

Project: McEniry HVAC Renovation
The University of North Carolina at Charlotte
SCO Project # SCO #18-19463-01

Date: January 30, 2019
Owner: The University of North Carolina at Charlotte
Designer: McCracken & Lopez, PA

NOTICE TO BIDDERS

This addendum is issued prior to receipt of bids, proposals, and its contents do hereby become a part of the pricing documents for the above referenced project.

All trade contractor bidders are responsible for assuring that their subcontractors and vendors are properly apprised of the contents of this Addendum.

All information contained in this Addendum supersedes and takes precedence over any conflicting information in the original pricing documents.

All bidders must acknowledge receipt of this Addendum in the space provided on the Form of Proposal for their bid package.

GENERAL INFORMATION

The bid date is February 6, 2019 at 2:00 PM. The location is Room 112B of the Cone University Building at UNC Charlotte.

Bidders who will not attend the Bid Opening need to ensure their sealed bids are delivered no later than 2:00 PM, February 6, 2019.

ATTACHMENTS

The following files are provided for reference:

1. Main Building Control Drawings from 2005 installation.
2. As built for 1998 control system replacement. Reference these controls for AHU-4 (old 4a), AHU-5 (old 4b), AHU-6 (old 4c), AHU-7 (old 4d), AHU-8 (old 5a), AHU-9(old 5b)
3. 2016 Chiller plant control drawings not available. UNCC will provide for reference following bidding.

DRAWINGS

The following plans have been added, or updated/revised:

1. M203. Removed references to base bid and alternate #3 from reference chiller plant sequence.
2. M204. Added reheat coil and dehumidification to the old AHU-4a/b/c/d & AHU-5a/b sequence of operations. Reheat coil and dehumidification sequence is associated with Alternate #2 only.
3. M107 added. Sheet reflects additional scope associated for alternate #2 replacement of old AHU-4a/b/c/d & AHU-5a/b.
4. M006. Added schedule for AHU-4a/b/c/d & AHU-5a/b.

SPECIFICATIONS

Section 00 01 15 – List of Drawings

1. Add the following to the list of mechanical drawings: “M107 – Auditorium Enlarged Mechanical Rooms.”

Section 01 23 00 – Alternates

2. This section is being reissued in its entirety. (see attached)

Section 23 09 00 – “Facility Management and Control System:

1. Paragraph 1.2.D, revise list of acceptable contractors to include:
 - a. Platinum Building Automation (using Honeywell BACnet Controllers).
 - b. Schneider Electric Controls (using Invensys I/A series or approved BACnet).
 - c. McKenney’s Automation Group (using Honeywell BACnet controllers).


Form of Proposal

1. This section is being reissued in its entirety. (see attached)

BIDDER QUESTIONS

- 1) Question: What version is the existing JACE in the chiller plant?
Answer: The existing JACE panel is a series 8000
- 2) How many terminal units are to be provided with new controllers?
Answer: There are 138 existing dual duct VAV terminal units and 8 single duct VAV terminal units. Of the 8 single duct VAV terminal units, 7 have hot water reheat coils.
- 3) Is all control wiring required to be replaced?
Answer: Yes. All control wiring associated with the terminal units and air handling equipment shall be replaced. The wiring between the controllers and JACE shall also be replaced to ensure “like new” installation of air-side control system.

End of Addendum 2

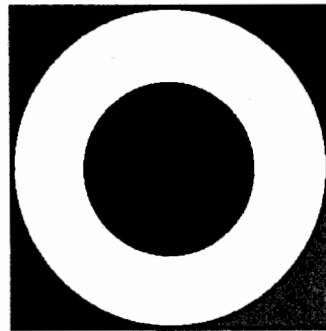

United Automation Corporation

CONTROLS AND AUTOMATION SERVICES





United Automation Corporation
CONTROLS AND AUTOMATION SERVICES

PROJECT: McENIRY CLASSROOM BUILDING- COMPREHENSIVE RENOVATIONS


DRAWING INDEX:

C2564-01	JACE 1 RISER DIAGRAM
C2564-02	AHU 1 VARIABLE & CONSTANT VOLUME BOX LIST
C2564-03	JACE 2 RISER DIAGRAM
C2564-04	JACE 2 RISER CONTINUED
C2564-05	JACE 3 RISER DIAGRAM
C2564-06	JACE 3 RISER CONTINUED
C2564-07	AHU 2, 3 VARIABLE & CONSTANT VOLUME BOX LIST
C2564-08	AHU CONTROL WIRING- PLANT CONTROLLER 1
C2564-08A	AHU CONTROL WIRING- PLANT CONTROLLER 2
C2564-09	MULTIPLE ACTUATOR WIRING
C2564-10	SUPPLY FAN CONTROL WIRING
C2564-11	RETURN FAN CONTROL WIRING
C2564-12	AHU SEQUENCE OF OPERATIONS & BILL OF MATERIALS
C2564-13	DUAL DUCT VV & CV CONTROL WIRING
C2564-14	SINGLE DUCT VV & CV CONTROL WIRING
C2564-15	VV & CV BOX SEQUENCE OF OPERATION & BILL OF MATERIALS
C2564-16	EXHAUST FAN CONTROL WIRING
C2564-17	HEATING PLANT & MISCELLANEOUS CONTROL WIRING
C2564-18	HEATING PLANT SEQUENCE OF OPERATION & BILL OF MATERIALS
C2564-19	AHU VALVE SCHEDULE
C2564-20	AHU POINT LIST
C2564-21	VAV POINT LIST

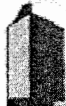PROJECT McENIRY CLASSROOM BUILDING UNIVERSITY OF NORTH CAROLINA AT CHARLOTTE CHARLOTTE, NORTH CAROLINA			
ARCHITECT			
ENGINEER UNITED ENGINEERING GROUP, INC CONSULTING ENGINEERS 5624 EXECUTIVE CENTER DRIVE SUITE 200 CHARLOTTE, NORTH CAROLINA 28212 704-532-8473			
MECHANICAL CONTRACTOR L.T. MECHANICAL, INC. P.O. BOX 580246 CHARLOTTE, NC 28256 704-598-4445			
INTEGRATION CONTRACTOR UNITED AUTOMATION CORPORATION 2811 CENTRAL AVENUE CHARLOTTE, NC 28205 704-342-0456			
IN CONSIDERATION OF THE RECEIPT OF THIS DOCUMENT, THE RECIPIENT AGREES NOT TO REPRODUCE, COPY, USE OR TRANSMIT THIS DOCUMENT AND/ OR THE INFORMATION THERE IN CONTAINED, IN WHOLE OR IN PART, OR TO SUFFER SUCH EXCEPT WITH THE WRITTEN PERMISSION OF UNITED AUTOMATION CORPORATION AND FURTHER AGREES TO SURRENDER SAME TO UNITED AUTOMATION CORPORATION UPON DEMAND.			
United Automation Corporation 2811 Central Avenue Charlotte, NC 28205 Phone: (704) 342-0456 Fax: (704) 358-0747		Honeywell  AUTHORIZED CONTROLS INTEGRATOR	
CONTRACT NUMBER 2564-S	DATE 4/12/05	REVISION NUMBER 1	REVISION DATE 5/16/05

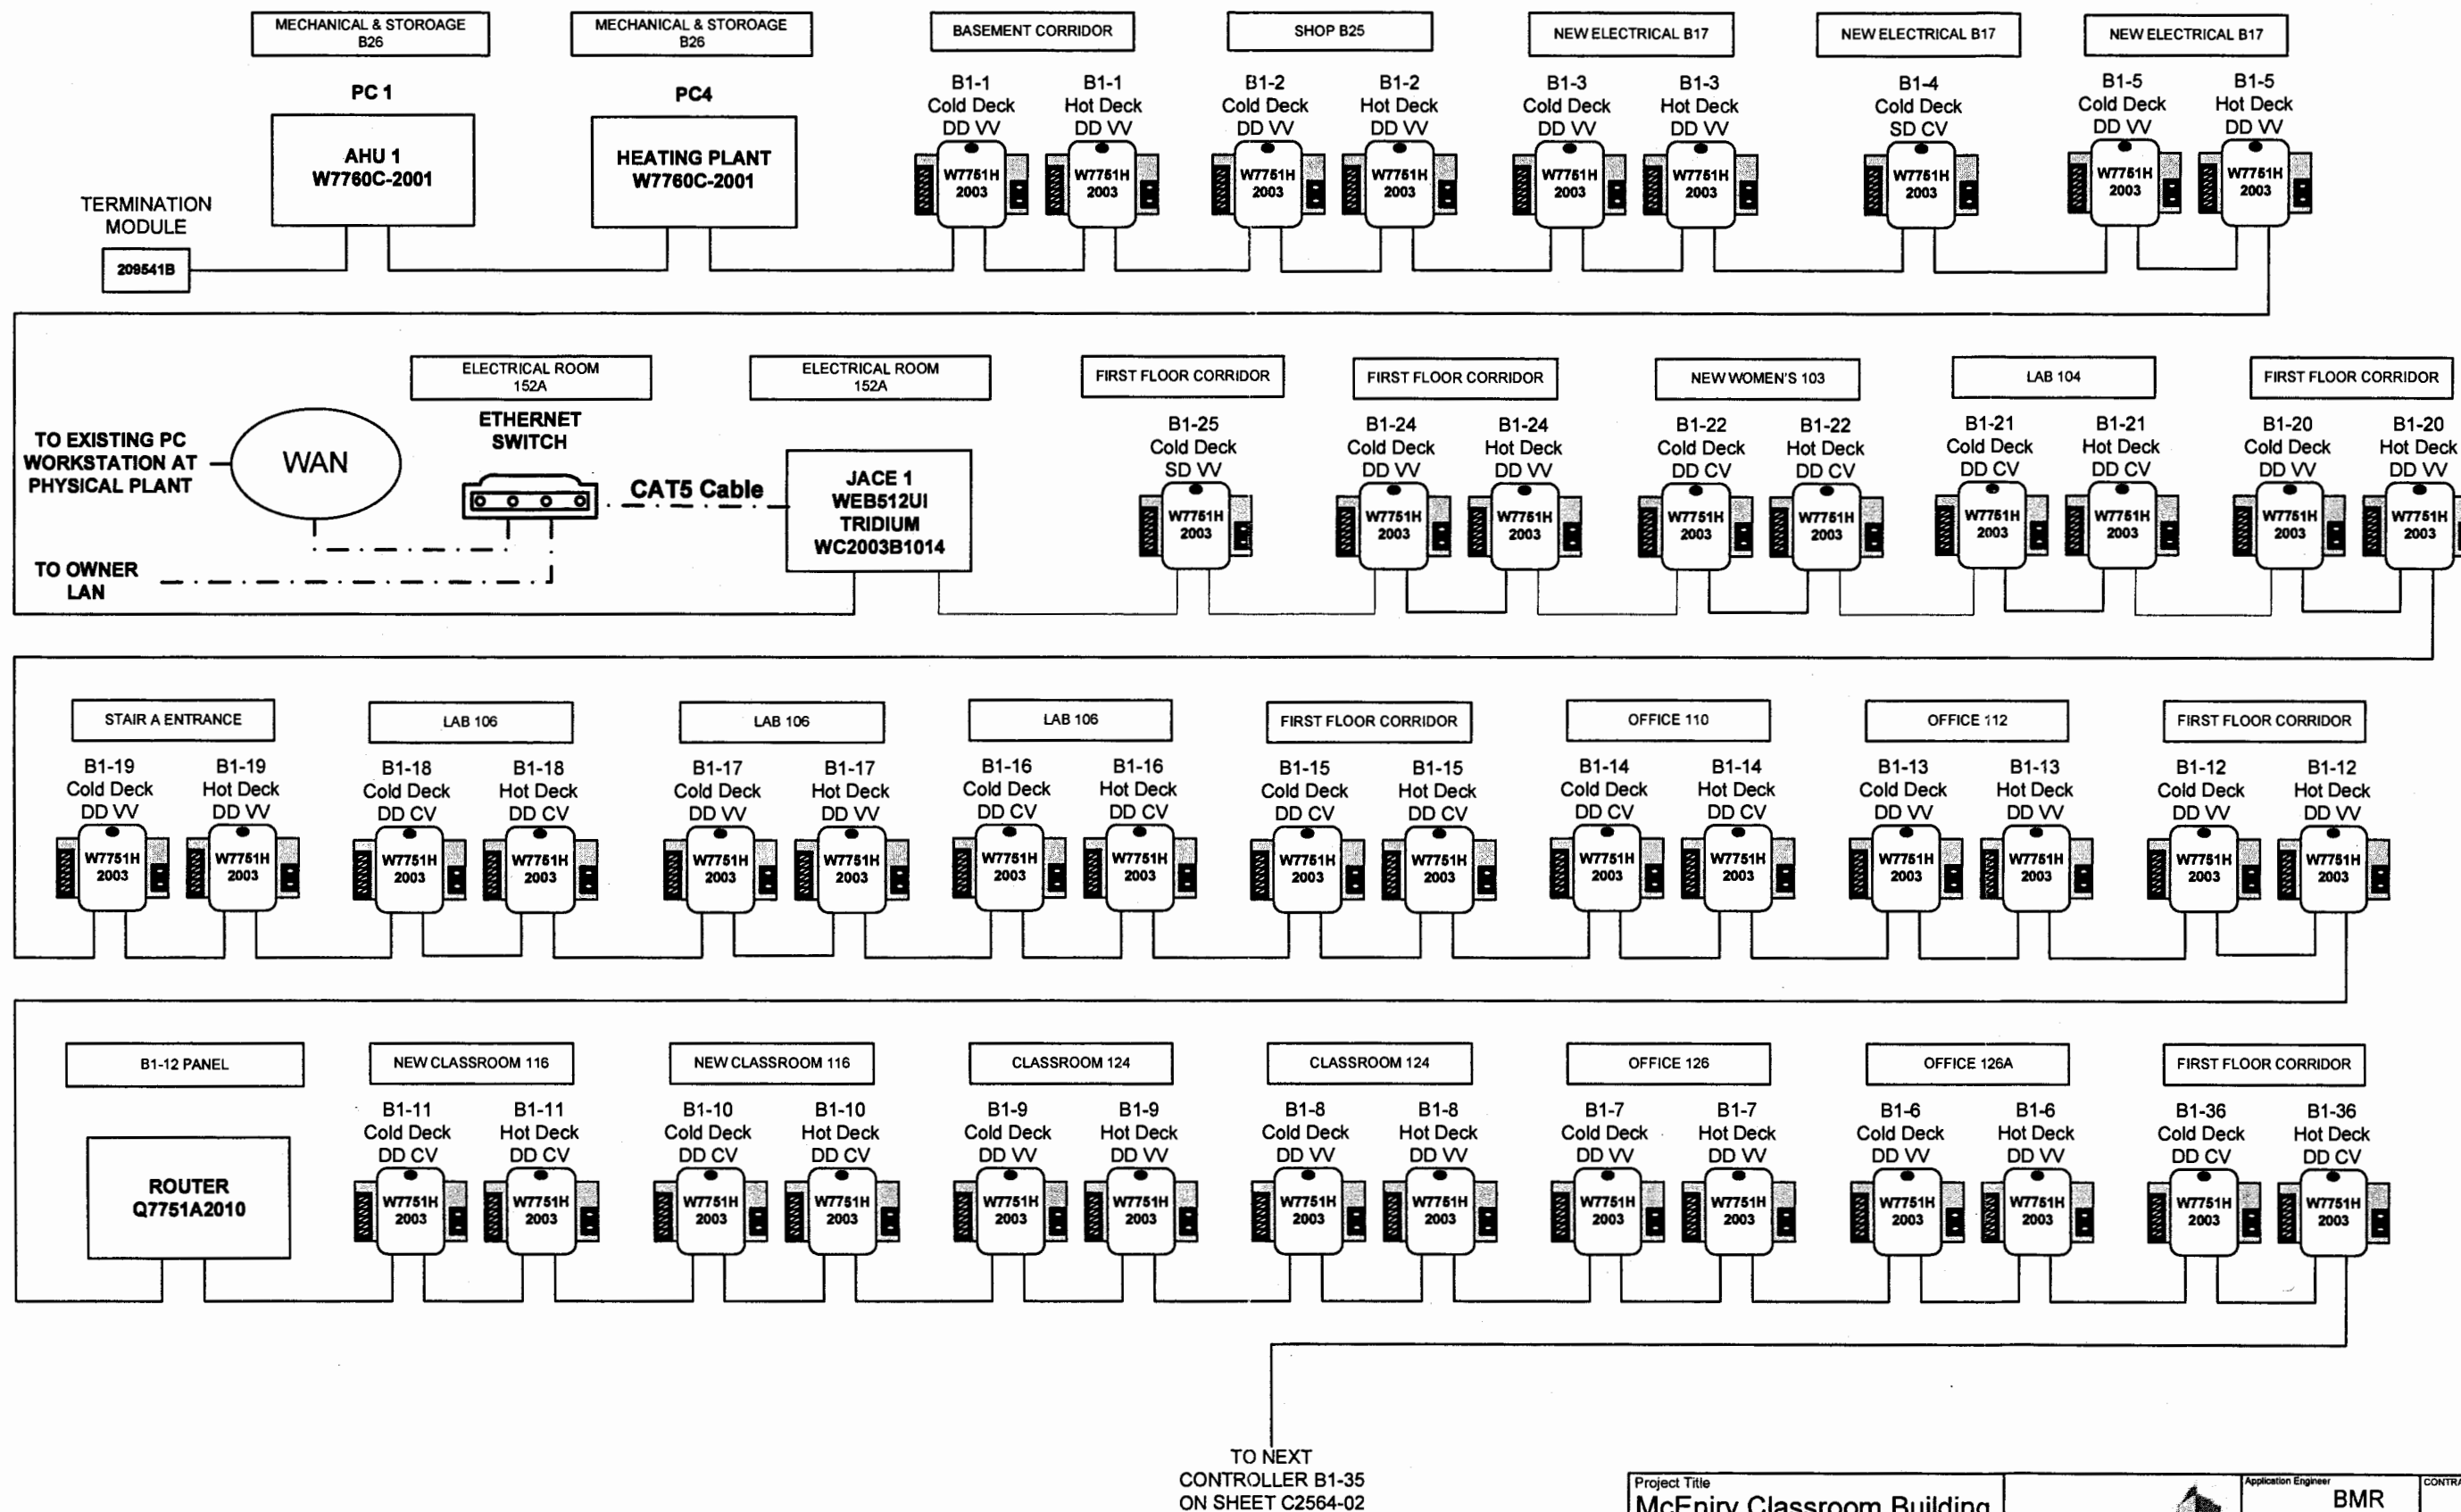


Project Title McEnery Classroom Building	 AUTHORIZED CONTROLS INTEGRATOR	Application Engineer BMR	CONTRACT NUMBER 2564-S
Drawing Title JACE 1 Riser Diagram		Project Manager JWJ	DRAWING NUMBER C2564-01
		Sales Engineer SJG	

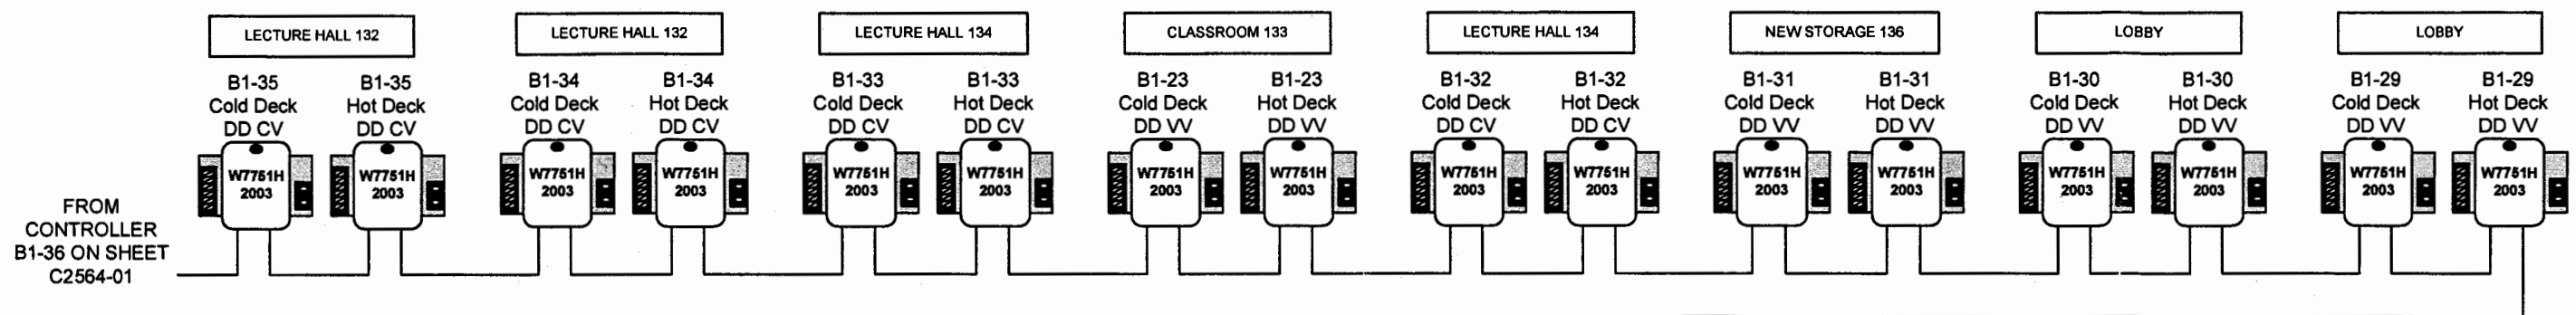


AHU 1 VV'S & CV'S- AREAS SERVED

BOX	TYPE	CONTROLLER	AREAS SERVED
B1-1	DDVV	W7751H (2)	STO. B28, TRASH B27
B1-2	DDVV	W7751H (2)	SHOP B25
B1-3	DDVV	W7751H (2)	JAN BO2, WOMENS TLT B22, MENS TLT B35, STO. B33, STO. B29
B1-4	SDCV	W7751H (1)	NEW DATA B17
B1-5	DDVV	W7751H (2)	STO. B18, OFFICE B15, OFFICE B16
B1-6	DDVV	W7751H (2)	TLT 126AA, OFFICE 126A, TLT. 1260
B1-7	DDVV	W7751H (2)	OFFICE 128, OFFICE 126B, CORRIDOR
B1-8	DDVV	W7751H (2)	CLASSROOM 124
B1-9	DDVV	W7751H (2)	OFFICE 126C, OFFICE 126E
B1-10	DDCV	W7751H (2)	NEW CLASSROM 116, CORRIDOR
B1-11	DDCV	W7751H (2)	NEW CLASSROM 116, CORRIDOR
B1-12	DDVV	W7751H (2)	CORRIDOR
B1-13	DDVV	W7751H (2)	OFFICE 112
B1-14	DDCV	W7751H (2)	OFFICE 110
B1-15	DDCV	W7751H (2)	LAB 108
B1-16	DDCV	W7751H (2)	LAB 106
B1-17	DDVV	W7751H (2)	LAB 106
B1-18	DDCV	W7751H (2)	106A
B1-19	DDVV	W7751H (2)	CORRIDOR
B1-20	DDVV	W7751H (2)	CORRIDOR
B1-21	DDCV	W7751H (2)	LAB 104
B1-22	DDCV	W7751H (2)	NEW WOMENS 103, NEW MENS 101
B1-23	DDVV	W7751H (2)	CLASSROOM 133
B1-24	DDVV	W7751H (2)	CORRIDOR
B1-25	SDVV	W7751H (1)	NEW TELECOM ROOM 152A
B1-26	DDVV	W7751H (2)	LOBBY
B1-27	DDVV	W7751H (2)	LOBBY
B1-28	DDVV	W7751H (2)	LOBBY
B1-29	DDVV	W7751H (2)	LOBBY
B1-30	DDVV	W7751H (2)	LOBBY
B1-31	DDVV	W7751H (2)	STO. 136A, EQUIP. 140
B1-32	DDVV	W7751H (2)	LECTURE HALL 134
B1-33	DDVV	W7751H (2)	LECTURE HALL 134
B1-34	DDVV	W7751H (2)	LECTURE HALL 132
B1-35	DDVV	W7751H (2)	LECTURE HALL 132
B1-36	DDVV	W7751H (2)	VEST. 127, EQUIP. 130

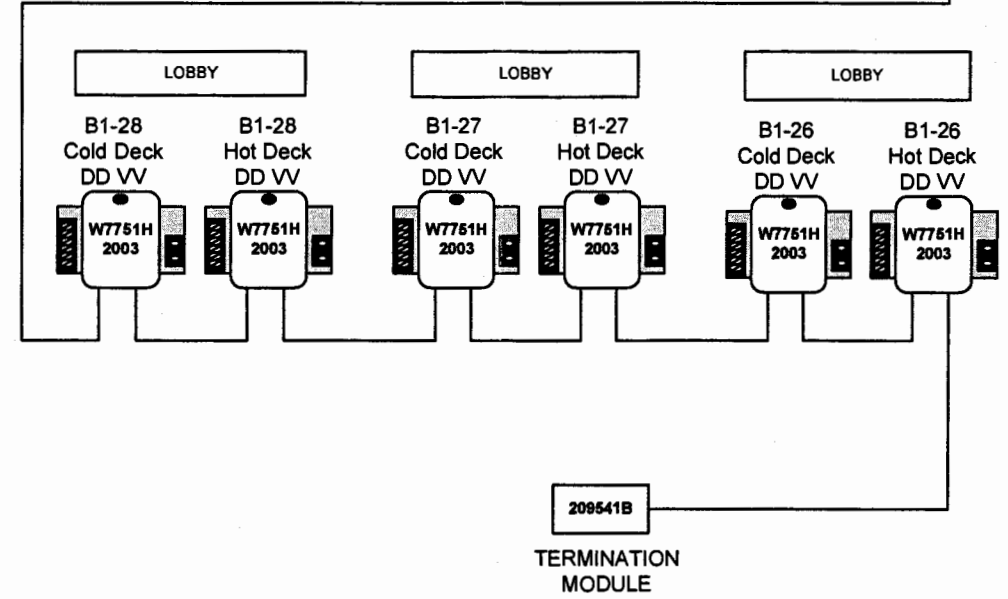


Project Title McEniry Classroom Building	 AUTHORIZED CONTROLS INTEGRATOR	Application Engineer BMR	CONTRACT NUMBER 2564-S
Drawing Title AHU1 W & CV LIST		Project Manager JWJ	DRAWING NUMBER C2564-02
		Sales Engineer SJG	

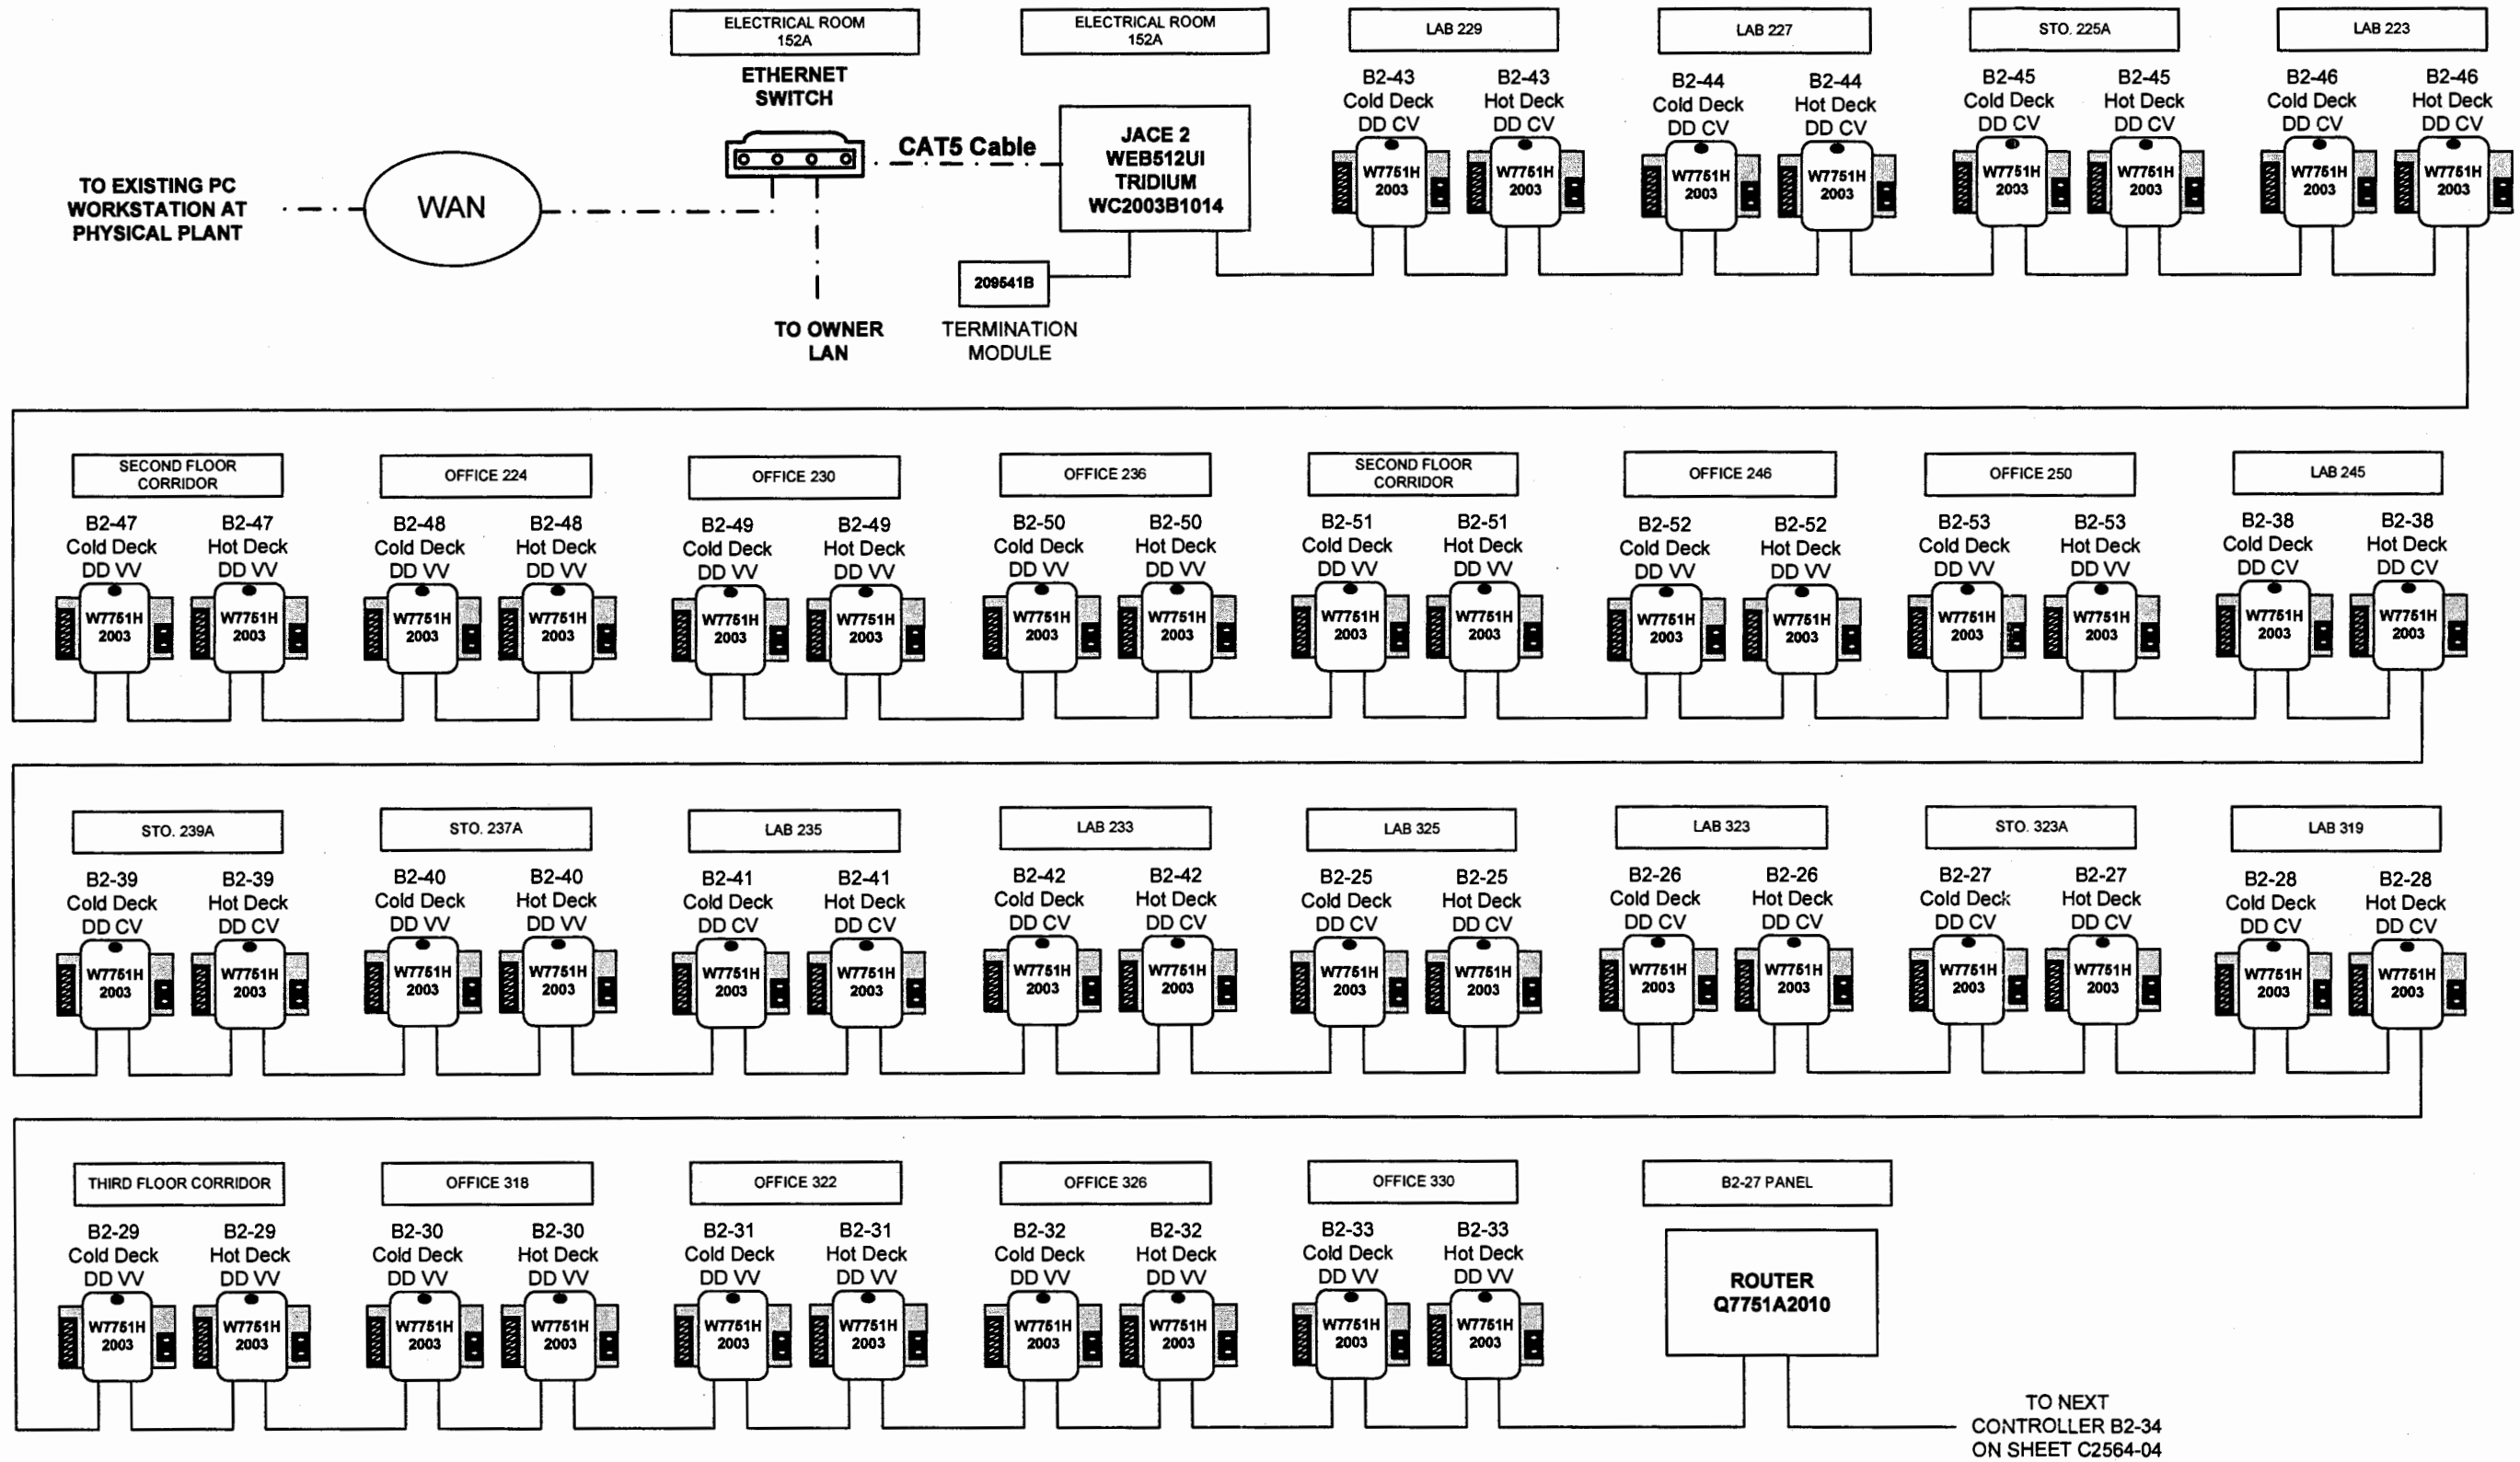

Project Title McEnery Classroom Building	 Honeywell <small>AUTHORIZED CONTROLS INTEGRATOR</small>	Application Engineer BMR	CONTRACT NUMBER 2564-S
Drawing Title JACE 2 Riser Diagram		Project Manager JWJ	DRAWING NUMBER C2564-03
		Sales Engineer SJG	

FROM LAST
CONTROLLER B2-33
ON SHEET C2564-03






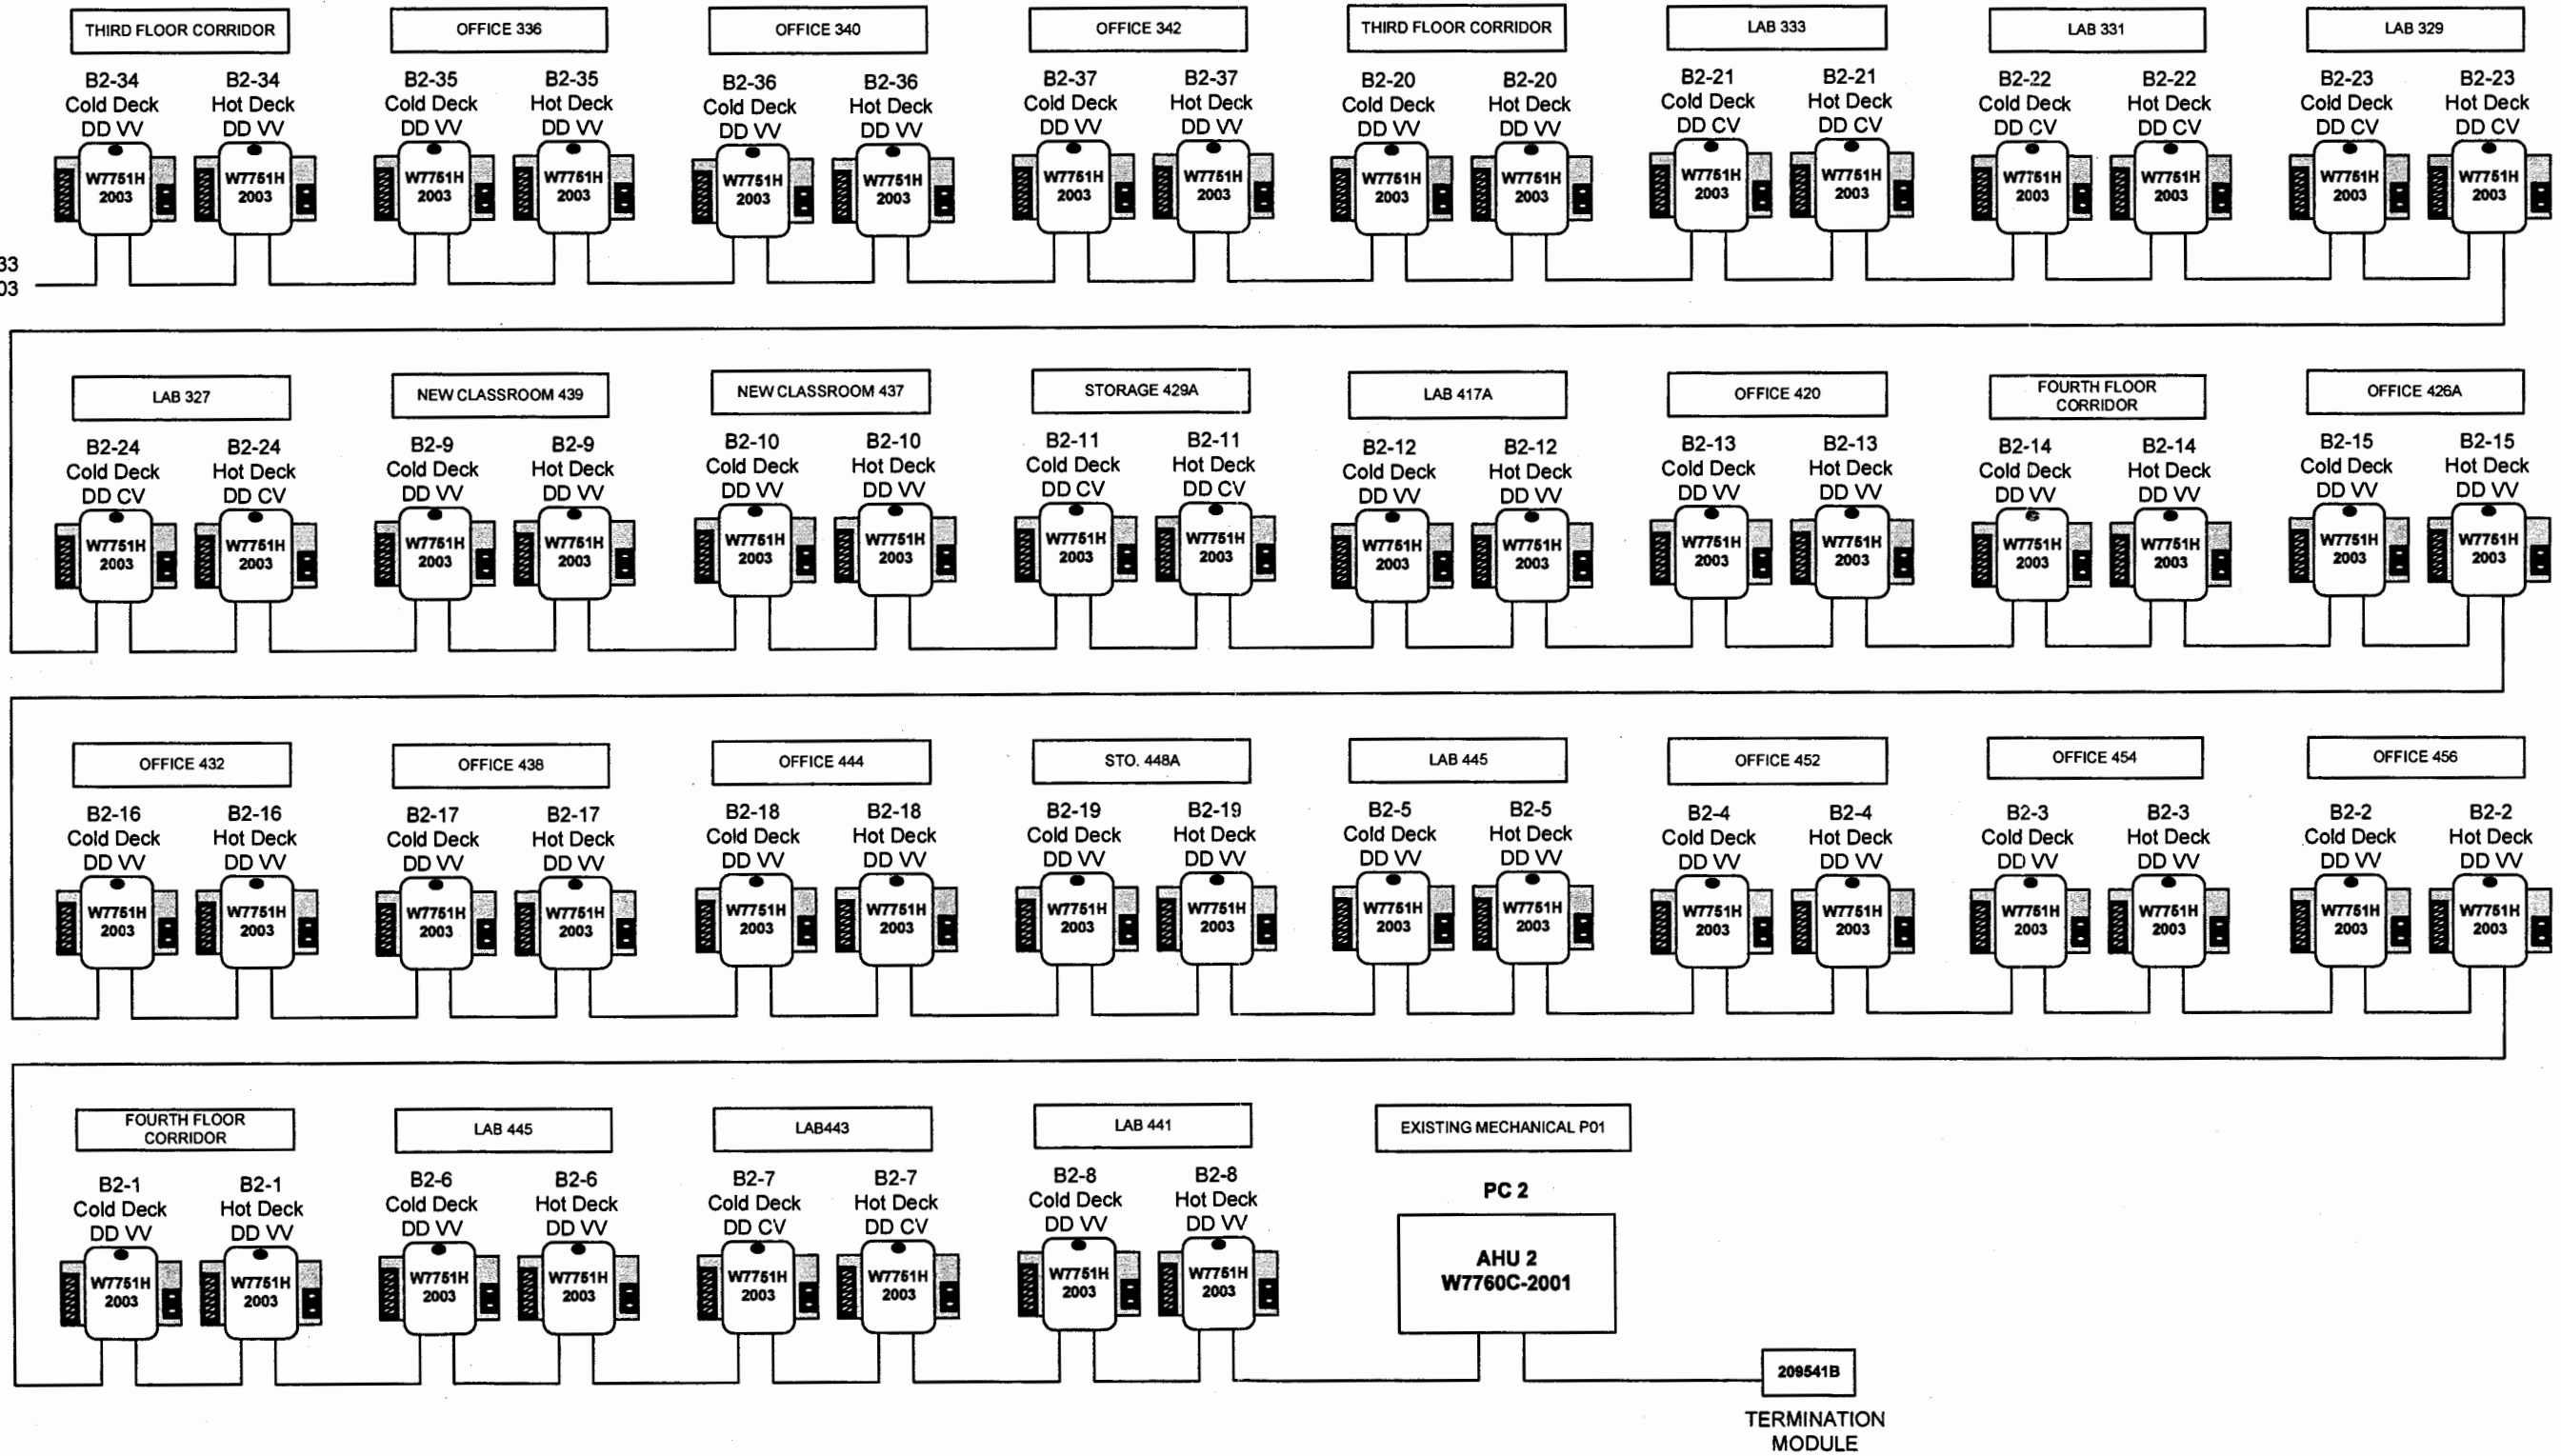


Project Title	McEniry Classroom Building	Application Engineer	BMR	CONTRACT NUMBER	2564-S
Drawing Title	JACE 2 Riser Continued	Project Manager	JWJ	DRAWING NUMBER	C2564-04
		Sales Engineer	SJG		



Electrical Rm 152A
~~EXISTING MECHANICAL R01~~
ETHERNET SWITCH


Elect Rm 152A
~~EXISTING MECHANICAL R01~~
**JACE 3
 WEB512UI
 TRIDIUM
 WC2003B1014**

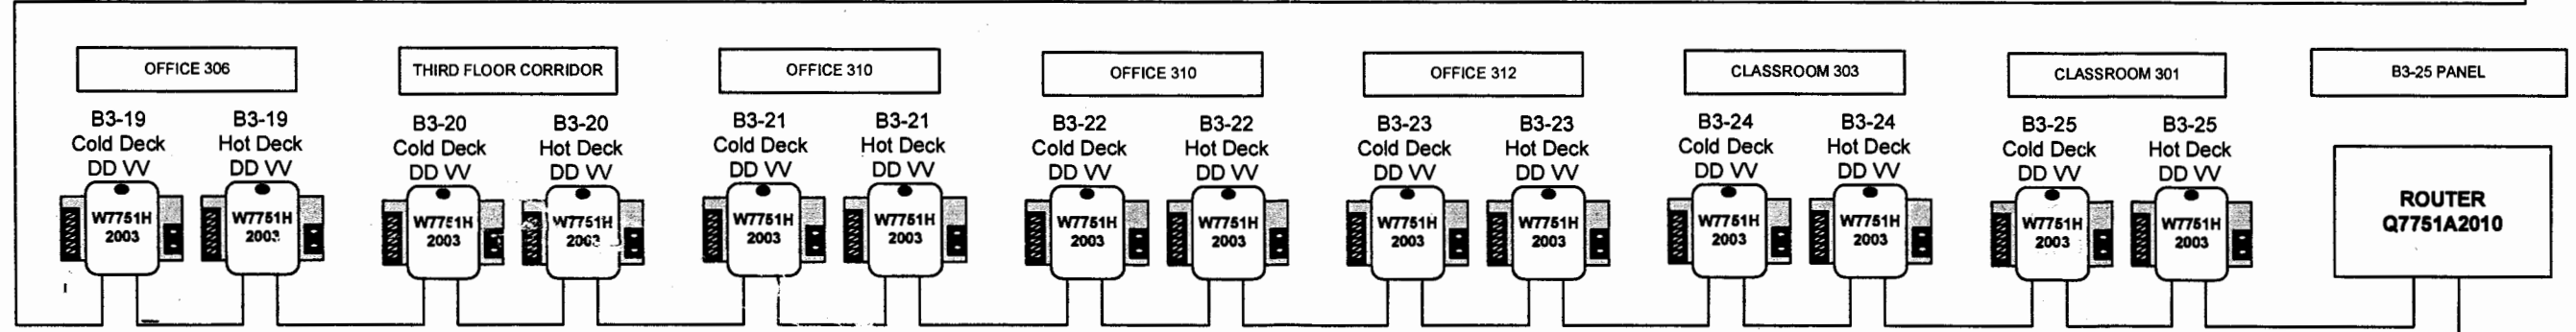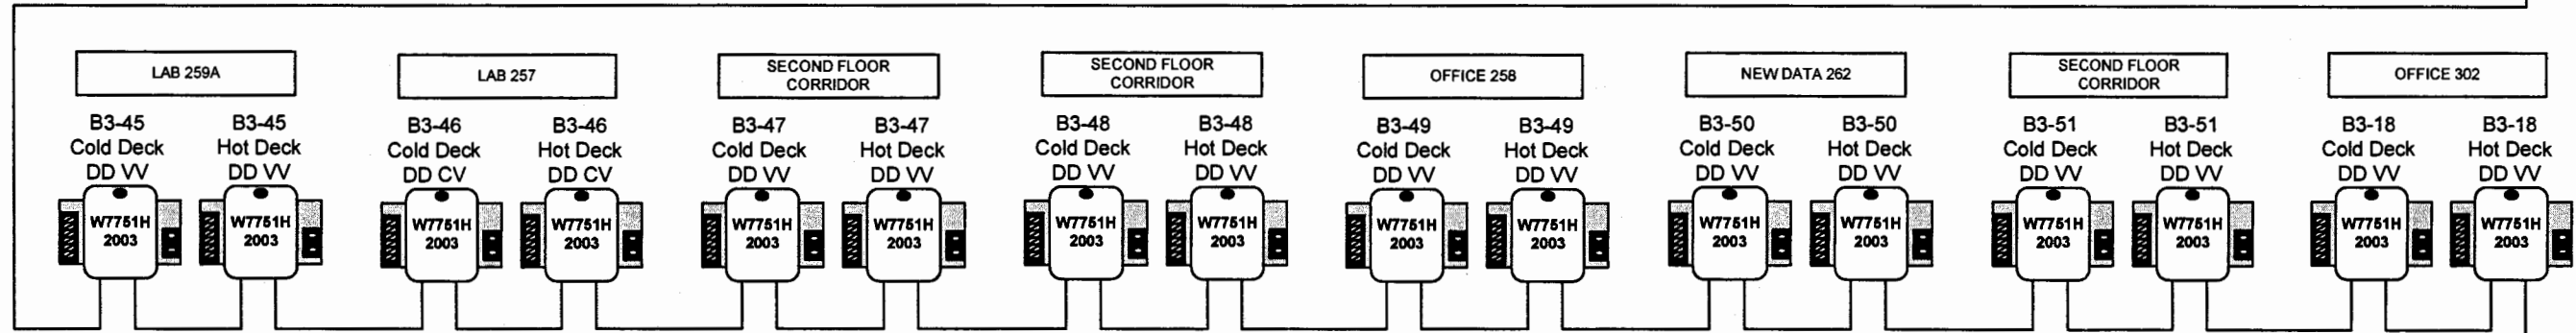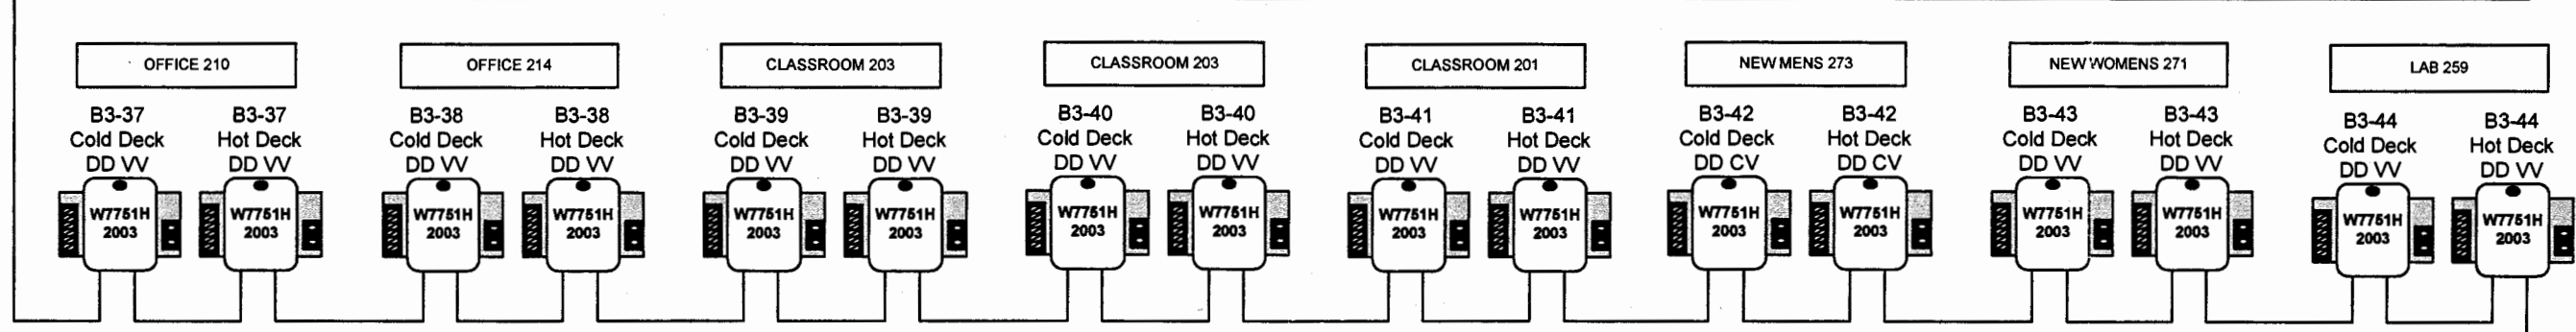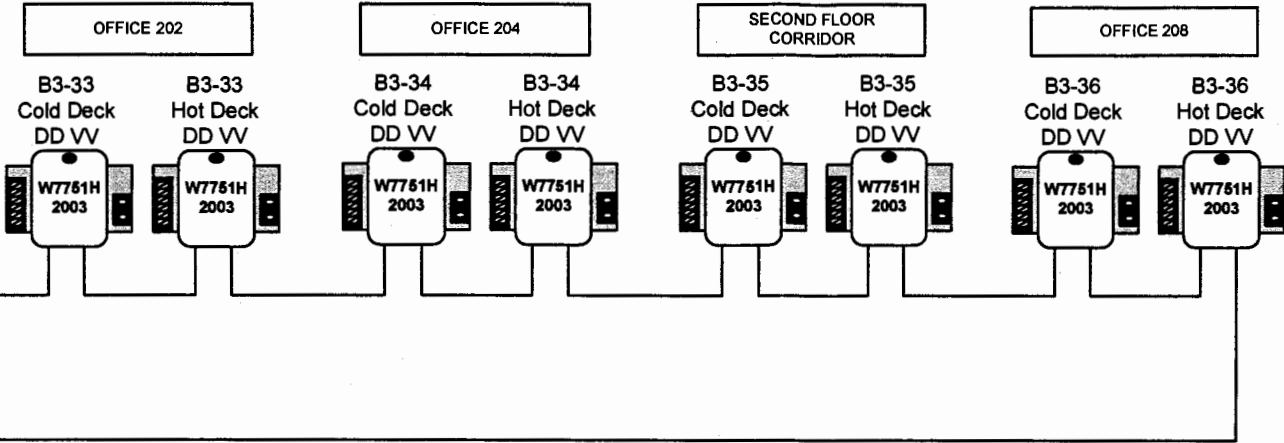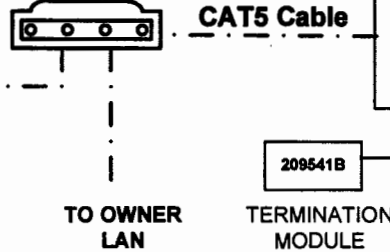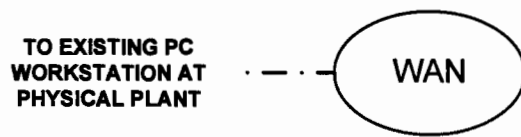

TO NEXT CONTROLLER B3-26 ON SHEET C2564-06

Project Title McEnery Classroom Building		Application Engineer BMR	CONTRACT NUMBER 2564-S
Drawing Title JACE 3 Riser Diagram		Project Manager JWJ	DRAWING NUMBER C2564-05
 AUTHORIZED CONTROLS INTEGRATOR		Sales Engineer SJG	

FROM LAST
CONTROLLER B3-25
ON SHEET C2564-05

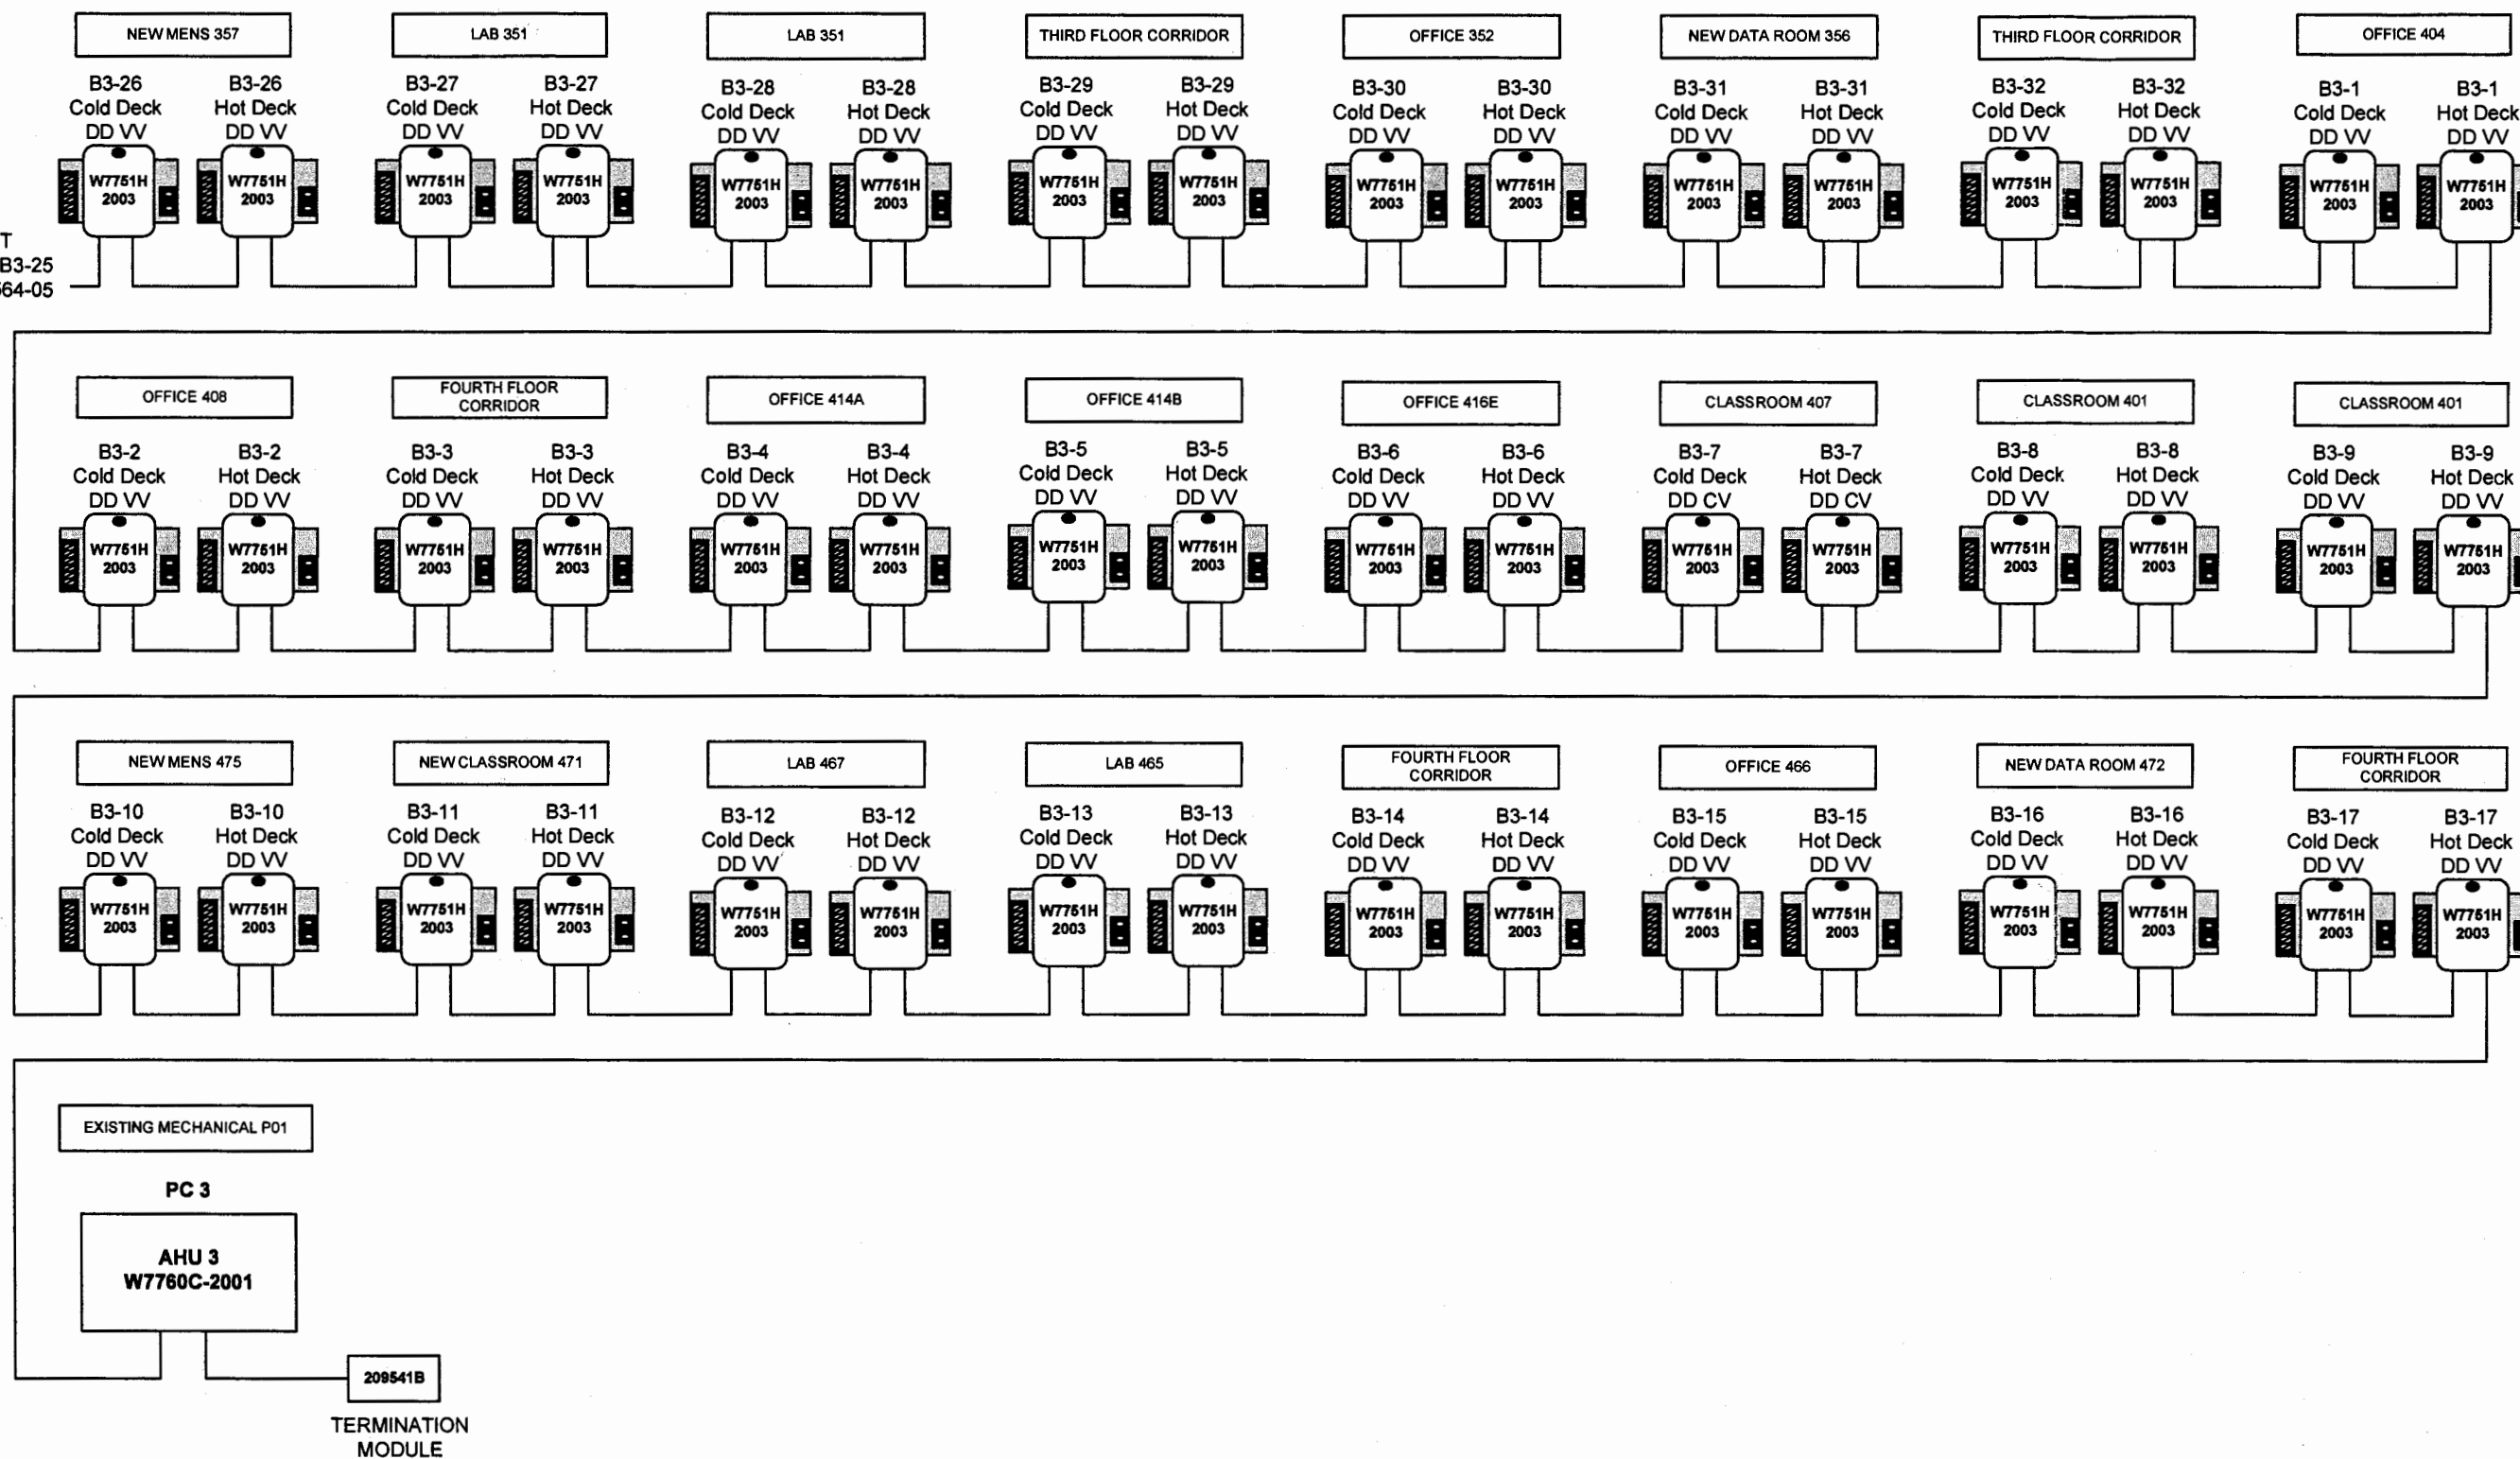

Project Title	McEniry Classroom Building	Application Engineer	BMR	CONTRACT NUMBER	2564-S
Drawing Title	JACE 3 Riser Continued	Project Manager	JWJ	DRAWING NUMBER	C2564-06
		Sales Engineer	SJG		



AHU 2 VV'S & CV'S- AREAS SERVED

BOX	TYPE	CONTROLLER	AREAS SERVED
B2-1	DDVV	W7751H (2)	OFFICE 462
B2-2	DDVV	W7751H (2)	OFFICE 456, OFFICE 458
B2-3	DDVV	W7751H (2)	OFFICE 454
B2-4	DDVV	W7751H (2)	OFFICE 452, OFFICE 450
B2-5	DDVV	W7751H (2)	FOURTH FLOOR CORRIDOR
B2-6	DDVV	W7751H (2)	LAB 445
B2-7	DDVV	W7751H (2)	STO. 447B, LAB 443, STO. 447A, STO. 447C, STO. 447D
B2-8	DDVV	W7751H (2)	LAB 441, LAB 447
B2-9	DDVV	W7751H (2)	NEW CLASSROOM 439
B2-10	DDVV	W7751H (2)	NEW CLASSROOM 437
B2-11	DDCV	W7751H (2)	STO. 429A, STO 429B
B2-12	DDVV	W7751H (2)	LAB 417A, LAB 417
B2-13	DDVV	W7751H (2)	OFFICE 420
B2-14	DDVV	W7751H (2)	FOURTH FLOOR CORRIDOR
B2-15	DDVV	W7751H (2)	STORGE 424, OFFICE 426A, OFFICE 426B, OFFICE 428
B2-16	DDVV	W7751H (2)	OFFICE 430, OFFICE 432, OFFICE 434
B2-17	DDVV	W7751H (2)	OFFICE 436, OFFICE 438, OFFICE 440
B2-18	DDVV	W7751H (2)	OFFICE 442, OFFICE 444
B2-19	DDVV	W7751H (2)	STO. 448A, OFFICE 448
B2-20	DDVV	W7751H (2)	OFFICE 346
B2-21	DDCV	W7751H (2)	LAB 333, STO. 333A
B2-22	DDCV	W7751H (2)	LAB 331, STO. 331A
B2-23	DDCV	W7751H (2)	LAB 329, STO. 329A
B2-24	DDCV	W7751H (2)	LAB 327, STO. 327A
B2-25	DDCV	W7751H (2)	LAB 325, STO. 325A
B2-26	DDCV	W7751H (2)	LAB 323
B2-27	DDCV	W7751H (2)	STO. 323, STO. 323B
B2-28	DDCV	W7751H (2)	LAB 319, STO. 319A
B2-29	DDVV	W7751H (2)	THIRD FLOOR CORRIDOR, STO. 312AA, OFFICE 312
B2-30	DDVV	W7751H (2)	OFFICE 316, OFFICE 318
B2-31	DDVV	W7751H (2)	OFFICE 322, OFFICE 320
B2-32	DDVV	W7751H (2)	OFFICE 326, OFFICE 324
B2-33	DDVV	W7751H (2)	STO. 332, OFFICE 330, OFFICE 328
B2-34	DDVV	W7751H (2)	THIRD FLOOR CORRIDOR
B2-35	DDVV	W7751H (2)	OFFICE 336
B2-36	DDVV	W7751H (2)	OFFICE 340
B2-37	DDVV	W7751H (2)	OFFICE 342
B2-38	DDCV	W7751H (2)	LAB 245, NEW STORAGE 247, SECOND FLOOR CORRIDOR
B2-39	DDCV	W7751H (2)	STO. 239A, LAB 239
B2-40	DDVV	W7751H (2)	STO. 237A, LAB 237
B2-41	DDCV	W7751H (2)	LAB 235, STO. 235A
B2-42	DDCV	W7751H (2)	LAB 233, STO. 233A
B2-43	DDCV	W7751H (2)	LAB 229, STO. 229A
B2-44	DDCV	W7751H (2)	LAB 227, STO. 227A
B2-45	DDCV	W7751H (2)	LAB 225, STO. 225A
B2-46	DDCV	W7751H (2)	LAB 223, STO. 223A
B2-47	DDVV	W7751H (2)	SECOND FLOOR CORRIDOR, STORAGE 218
B2-48	DDVV	W7751H (2)	OFFICE 222, OFFICE 224, OFFICE 226
B2-49	DDVV	W7751H (2)	OFFICE 228, OFFICE 230, OFFICE 232
B2-50	DDVV	W7751H (2)	OFFICE 234, OFFICE 236, OFFICE 238
B2-51	DDVV	W7751H (2)	STO. 241, OFFICE 242
B2-52	DDVV	W7751H (2)	OFFICE 246, OFFICE 248
B2-53	DDVV	W7751H (2)	OFFICE 250

AHU 3 VV'S & CV'S- AREAS SERVED

BOX	TYPE	CONTROLLER	AREAS SERVED
B3-1	DDVV	W7751H (2)	OFFICE 402, OFFICE 404
B3-2	DDVV	W7751H (2)	OFFICE 408, OFFICE 406
B3-3	DDVV	W7751H (2)	FOURTH FLOOR CORRIDOR
B3-4	DDVV	W7751H (2)	OFFICE 414A, OFFICE 414B
B3-5	DDVV	W7751H (2)	OFFICE 416C, OFFICE 416B, OFFICE 418D, OFFICE 418C
B3-6	DDVV	W7751H (2)	OFFICE 416E, OFFICE 416D, OFFICE 416A, OFFICE 418E, OFFICE 418A, OFFICE 418B
B3-7	DDCV	W7751H (2)	STO. 407A, CLASSROOM 407
B3-8	DDVV	W7751H (2)	CLASSROOM 401
B3-9	DDVV	W7751H (2)	CLASSROOM 401
B3-10	DDVV	W7751H (2)	NEW MENS 475, NEW WOMENS 407
B3-11	DDVV	W7751H (2)	NEW CLASSROOM 471
B3-12	DDVV	W7751H (2)	LAB 467
B3-13	DDVV	W7751H (2)	LAB 465, STO. 465A, SERVICE 460
B3-14	DDVV	W7751H (2)	FOURTH FLOOR CORRIDOR
B3-15	DDVV	W7751H (2)	OFFICE 466, OFFICE 468
B3-16	DDVV	W7751H (2)	NEW DATA RM 472, NEW STO. 470
B3-17	DDVV	W7751H (2)	FOURTH FLOOR CORRIDOR
B3-18	DDVV	W7751H (2)	OFFICE 302, OFFICE 304
B3-19	DDVV	W7751H (2)	OFFICE 306
B3-20	DDVV	W7751H (2)	THIRD FLOOR CORRIDOR
B3-21	DDVV	W7751H (2)	OFFICE 310
B3-22	DDVV	W7751H (2)	OFFICE 310
B3-23	DDVV	W7751H (2)	OFFICE 312
B3-24	DDVV	W7751H (2)	CLASSROOM 303
B3-25	DDVV	W7751H (2)	STO. 301A, CLASSROOM 301, NEW STO. 359
B3-26	DDVV	W7751H (2)	NEW WOMENS 355, NEW MENS 357
B3-27	DDVV	W7751H (2)	LAB 351
B3-28	DDVV	W7751H (2)	STO. 351A, LAB 349, LAB 343
B3-29	DDVV	W7751H (2)	THIRD FLOOR CORRIDOR, SERVICE 344
B3-30	DDVV	W7751H (2)	OFFICE 350, OFFICE 352
B3-31	DDVV	W7751H (2)	NEW DATA RM 356, NEW STORAGE 354
B3-32	DDVV	W7751H (2)	THIRD FLOOR CORRIDOR
B3-33	DDVV	W7751H (2)	OFFICE 202
B3-34	DDVV	W7751H (2)	OFFICE 204
B3-35	DDCV	W7751H (2)	SECOND FLOOR CORRIDOR
B3-36	DDVV	W7751H (2)	OFFICE 206
B3-37	DDVV	W7751H (2)	OFFICE 212, OFFICE 210
B3-38	DDVV	W7751H (2)	OFFICE 214, OFFICE 216
B3-39	DDVV	W7751H (2)	STO. 211A, LAB 211
B3-40	DDVV	W7751H (2)	CLASSROOM 203
B3-41	DDVV	W7751H (2)	CLASSROOM 201
B3-42	DDCV	W7751H (2)	NEW MENS 273, NEW WOMENS 271
B3-43	DDVV	W7751H (2)	LAB 259
B3-44	DDVV	W7751H (2)	LAB 259B, LAB 259C
B3-45	DDVV	W7751H (2)	LAB 259A
B3-46	DDCV	W7751H (2)	LAB 257C, LAB 257, SERVICE 252
B3-47	DDVV	W7751H (2)	SECOND FLOOR CORRIDOR, OFFICE 254
B3-48	DDVV	W7751H (2)	LAB 257A, OFFICE 257B
B3-49	DDVV	W7751H (2)	OFFICE 258
B3-50	DDVV	W7751H (2)	NEW DATA 262, NEW STORAGE 260
B3-51	DDVV	W7751H (2)	SECOND FLOOR CORRIDOR


Project Title
McEniry Classroom Building

Drawing Title
AHU 2, 3 VV & CV LIST



Application Engineer
BMR
Project Manager
JWJ
Sales Engineer
SJG

CONTRACT NUMBER
2564-S
DRAWING NUMBER
C2564-07

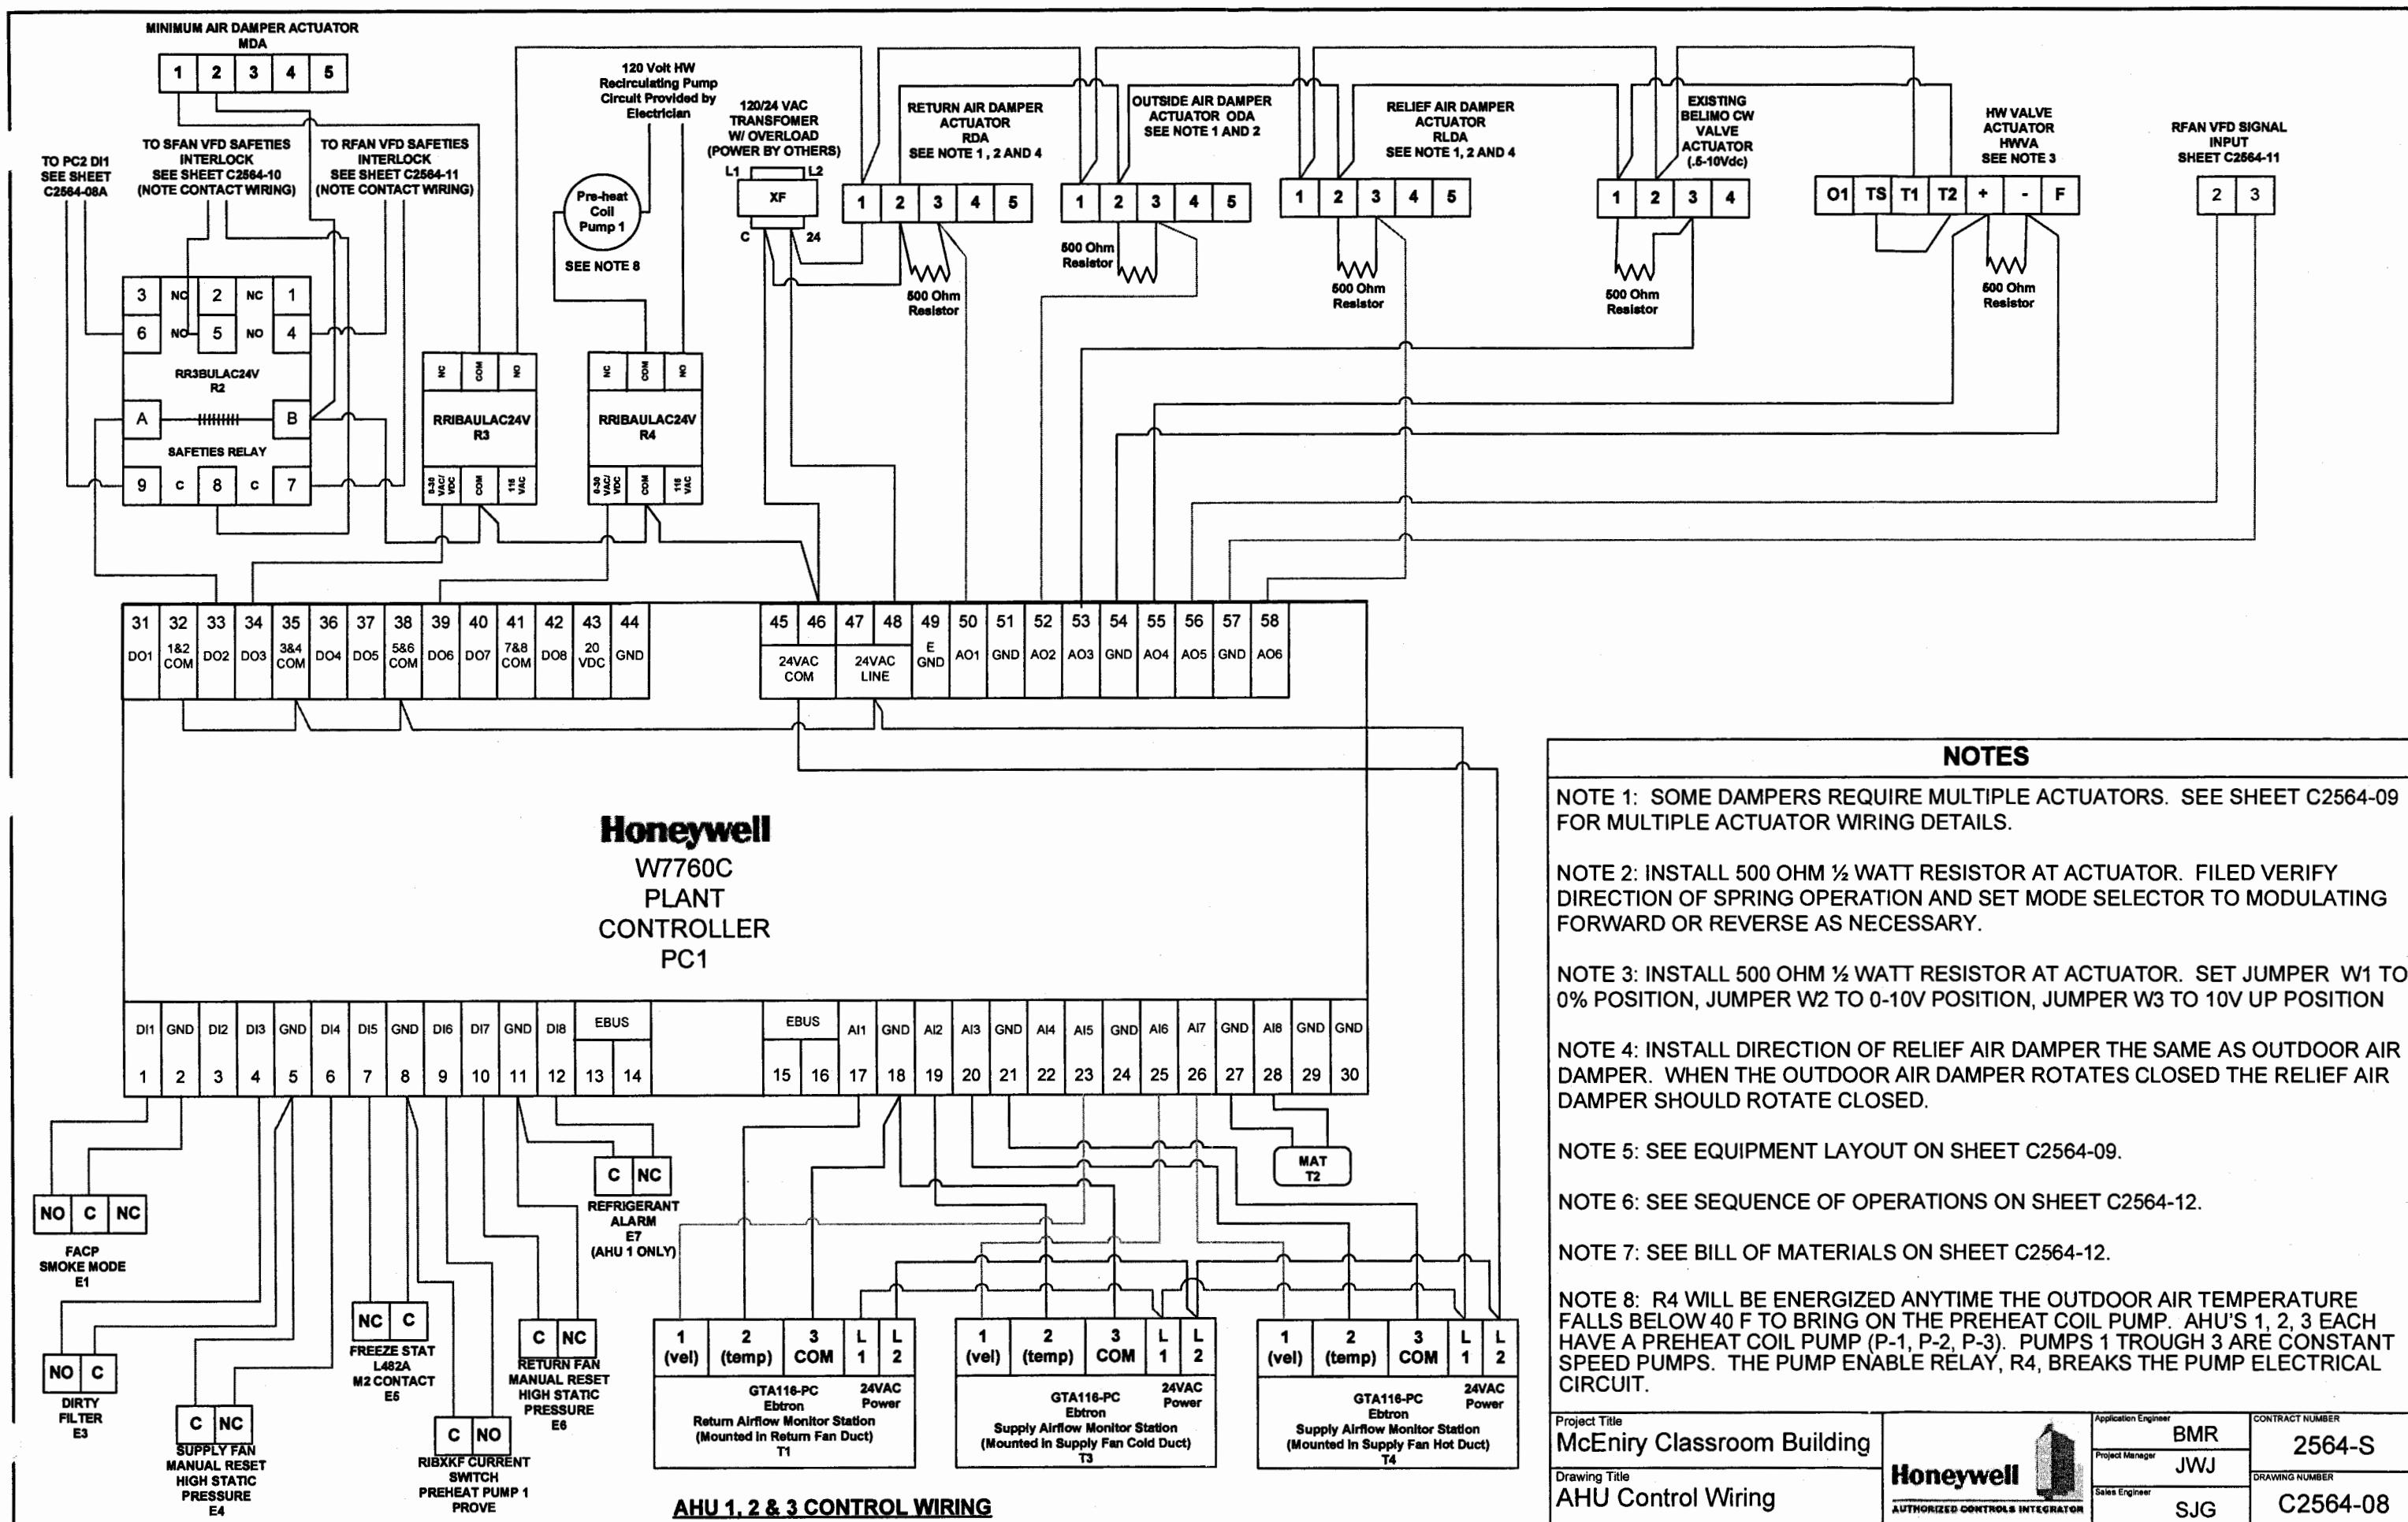


Honeywell
W7760C
PLANT
CONTROLLER
PC1

AHU 1, 2 & 3 CONTROL WIRING

NOTES

- NOTE 1: SOME DAMPERS REQUIRE MULTIPLE ACTUATORS. SEE SHEET C2564-09 FOR MULTIPLE ACTUATOR WIRING DETAILS.
- NOTE 2: INSTALL 500 OHM ½ WATT RESISTOR AT ACTUATOR. FILED VERIFY DIRECTION OF SPRING OPERATION AND SET MODE SELECTOR TO MODULATING FORWARD OR REVERSE AS NECESSARY.
- NOTE 3: INSTALL 500 OHM ½ WATT RESISTOR AT ACTUATOR. SET JUMPER W1 TO 0% POSITION, JUMPER W2 TO 0-10V POSITION, JUMPER W3 TO 10V UP POSITION
- NOTE 4: INSTALL DIRECTION OF RELIEF AIR DAMPER THE SAME AS OUTDOOR AIR DAMPER. WHEN THE OUTDOOR AIR DAMPER ROTATES CLOSED THE RELIEF AIR DAMPER SHOULD ROTATE CLOSED.
- NOTE 5: SEE EQUIPMENT LAYOUT ON SHEET C2564-09.
- NOTE 6: SEE SEQUENCE OF OPERATIONS ON SHEET C2564-12.
- NOTE 7: SEE BILL OF MATERIALS ON SHEET C2564-12.
- NOTE 8: R4 WILL BE ENERGIZED ANYTIME THE OUTDOOR AIR TEMPERATURE FALLS BELOW 40 F TO BRING ON THE PREHEAT COIL PUMP. AHU'S 1, 2, 3 EACH HAVE A PREHEAT COIL PUMP (P-1, P-2, P-3). PUMPS 1 TROUGH 3 ARE CONSTANT SPEED PUMPS. THE PUMP ENABLE RELAY, R4, BREAKS THE PUMP ELECTRICAL CIRCUIT.

Project Title McEniry Classroom Building	Application Engineer BMR	CONTRACT NUMBER 2564-S
Drawing Title AHU Control Wiring	Project Manager JWJ	DRAWING NUMBER C2564-08
Honeywell AUTHORIZED CONTROLS INTEGRATOR	Sales Engineer SJG	

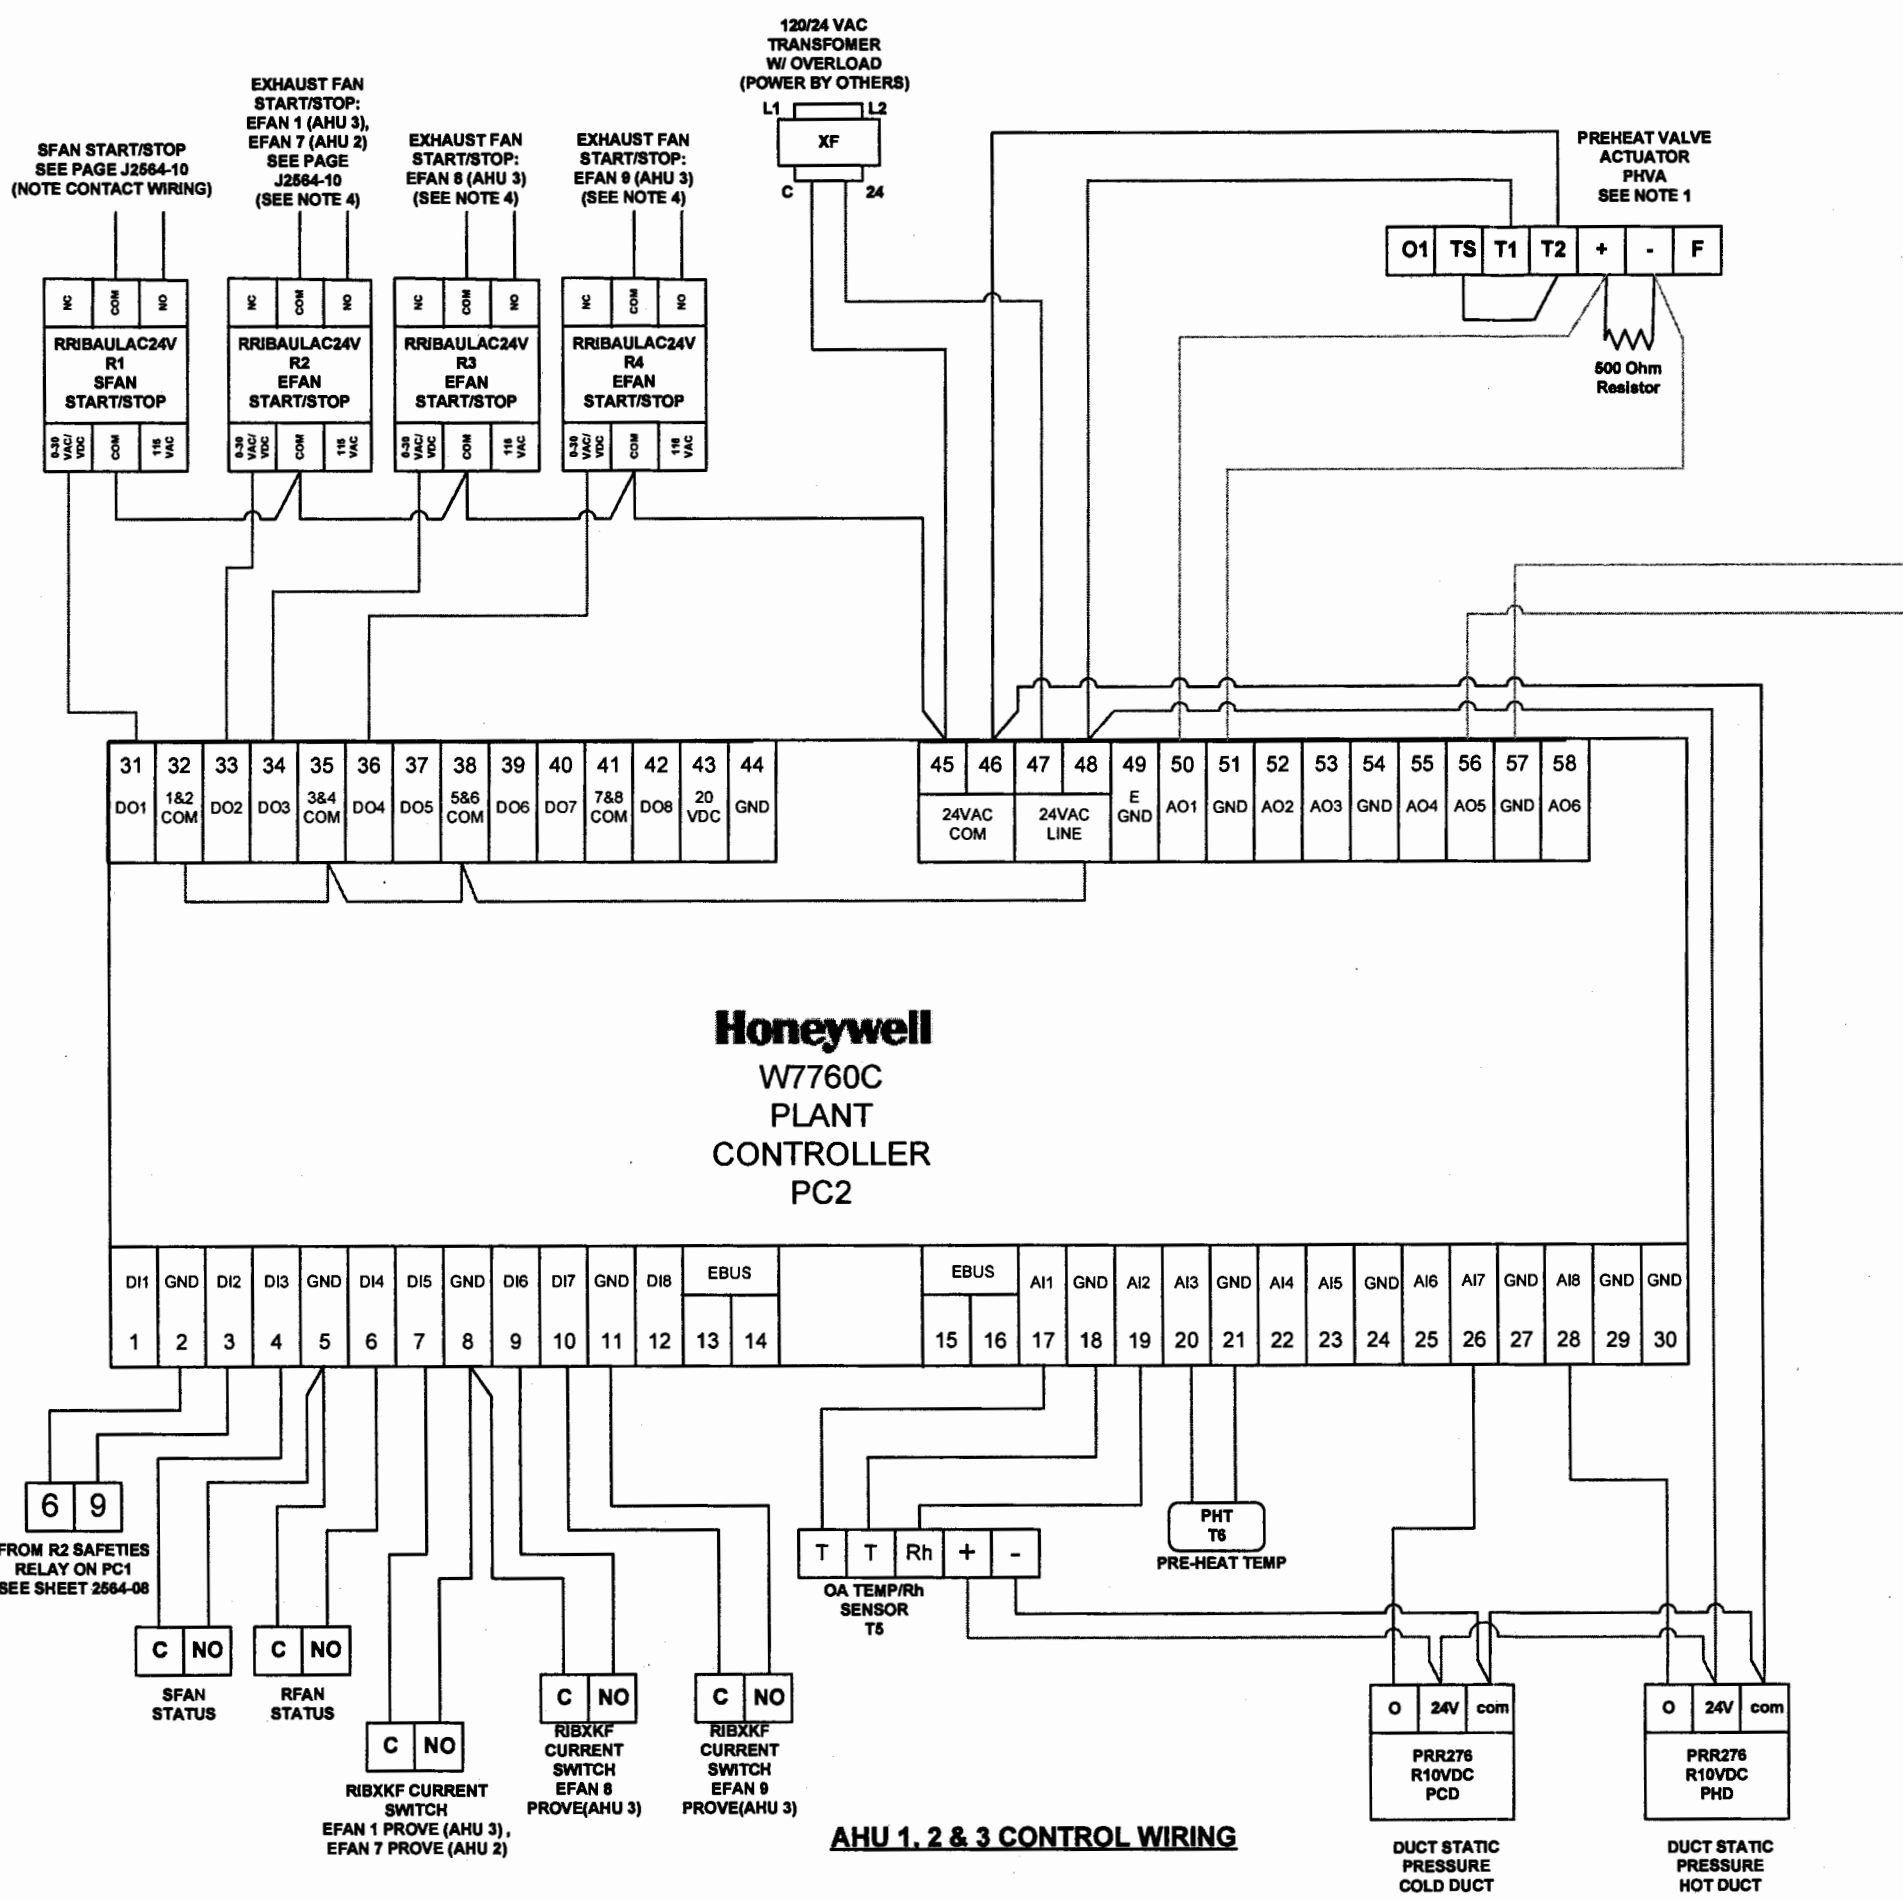


Honeywell
W7760C
PLANT
CONTROLLER
PC2

AHU 1, 2 & 3 CONTROL WIRING


NOTES

- NOTE 1: INSTALL 500 OHM ½ WATT RESISTOR AT ACTUATOR. SET JUMPER W1 TO 0% POSITION, JUMPER W2 TO 0-10V POSITION, JUMPER W3 TO 10V UP POSITION
- NOTE 2: SEE EQUIPMENT LAYOUT ON SHEET C2564-09.
- NOTE 3: SEE SEQUENCE OF OPERATIONS ON SHEET C2564-12.
- NOTE 4: SEE SHEET C2564-16 FOR EXHAUST FAN WIRING DETAILS. INSTALL CT SWITCH AROUND POWER WIRE OF EXHAUST FAN TO PROVE FAN STATUS.
- NOTE 7: SEE BILL OF MATERIALS ON SHEET C2564-12.

Project Title McEniry Classroom Building		Application Engineer BMR	CONTRACT NUMBER 2564-S
Drawing Title AHU Control Wiring		Project Manager JWJ	DRAWING NUMBER C2564-08A
 AUTHORIZED CONTROLS INTEGRATOR		Sales Engineer SJG	

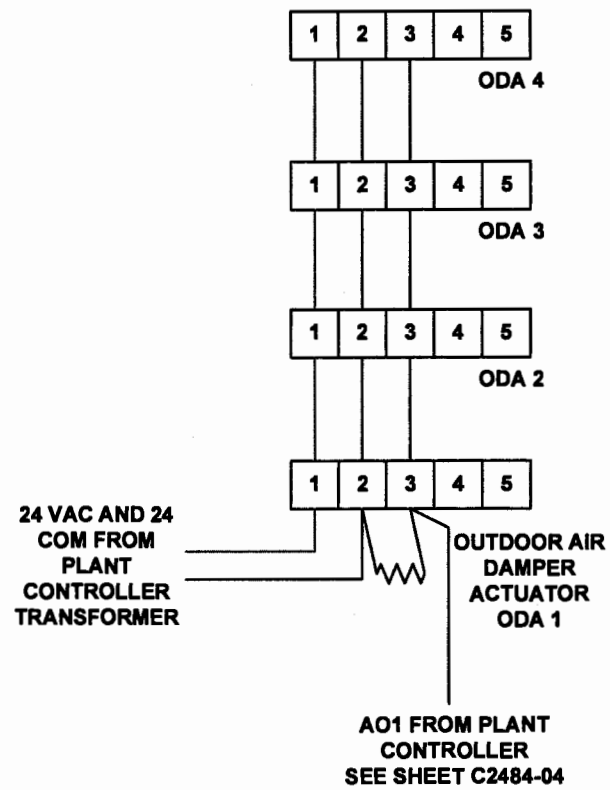

**AHU1 OUTDOOR AIR DAMPER WIRING DETAILS-
TYPICAL OF MULTIPLE ACTUATOR WIRING**

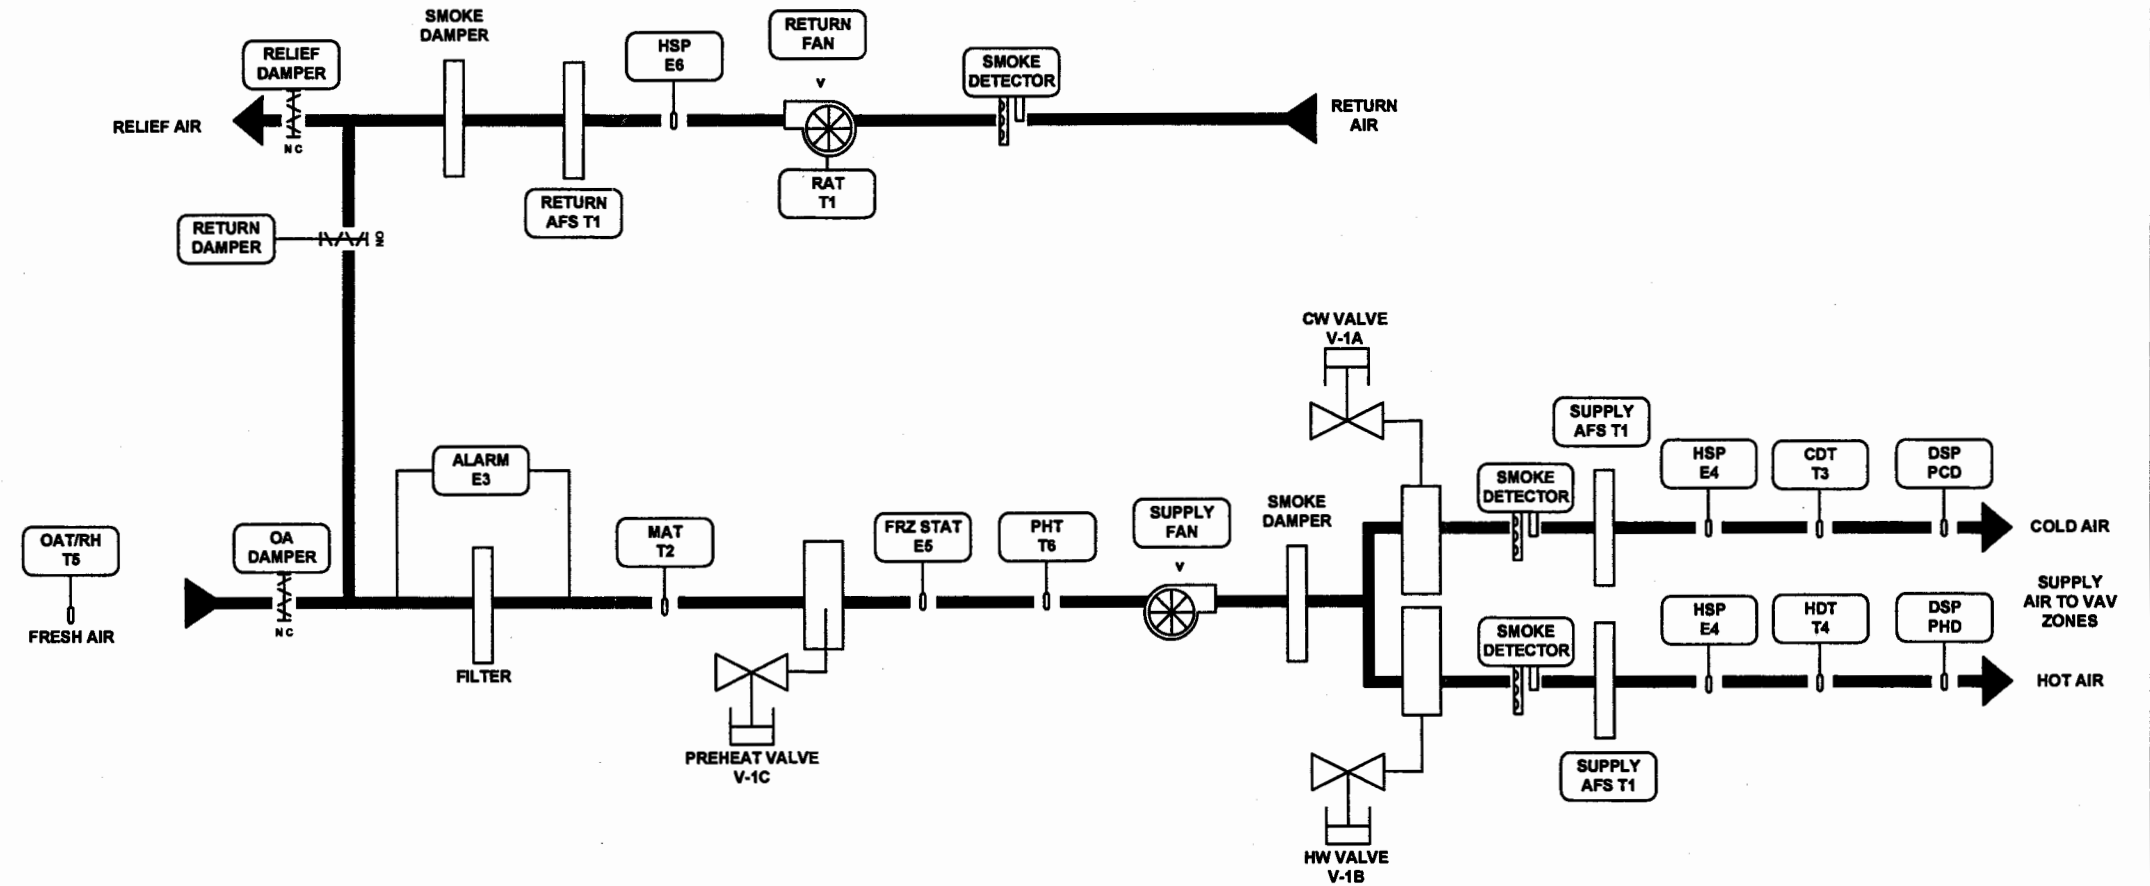

AHU FLOW DIAGRAM

Damper Actuator Count- 175inlb

Damper Actuator	AHU 1	AHU 2	AHU 3
Relief Air Damper	2	2	2
Return Air Damper	1	1	1
Outdoor Air Damper	4	1	1

Project Title
McEnery Classroom Building
 Drawing Title
Multiple Actuator Wiring

Honeywell
 AUTHORIZED CONTROLS INTEGRATOR


Application Engineer
BMR
 Project Manager
JWJ
 Sales Engineer
SJG

CONTRACT NUMBER
2564-S
 DRAWING NUMBER
C2564-09

NOTES

NOTE 1: SEE SEQUENCE OF OPERATIONS ON SHEET C2564-12.

NOTE 2: SEE BILL OF MATERIALS ON SHEET C2564-12.

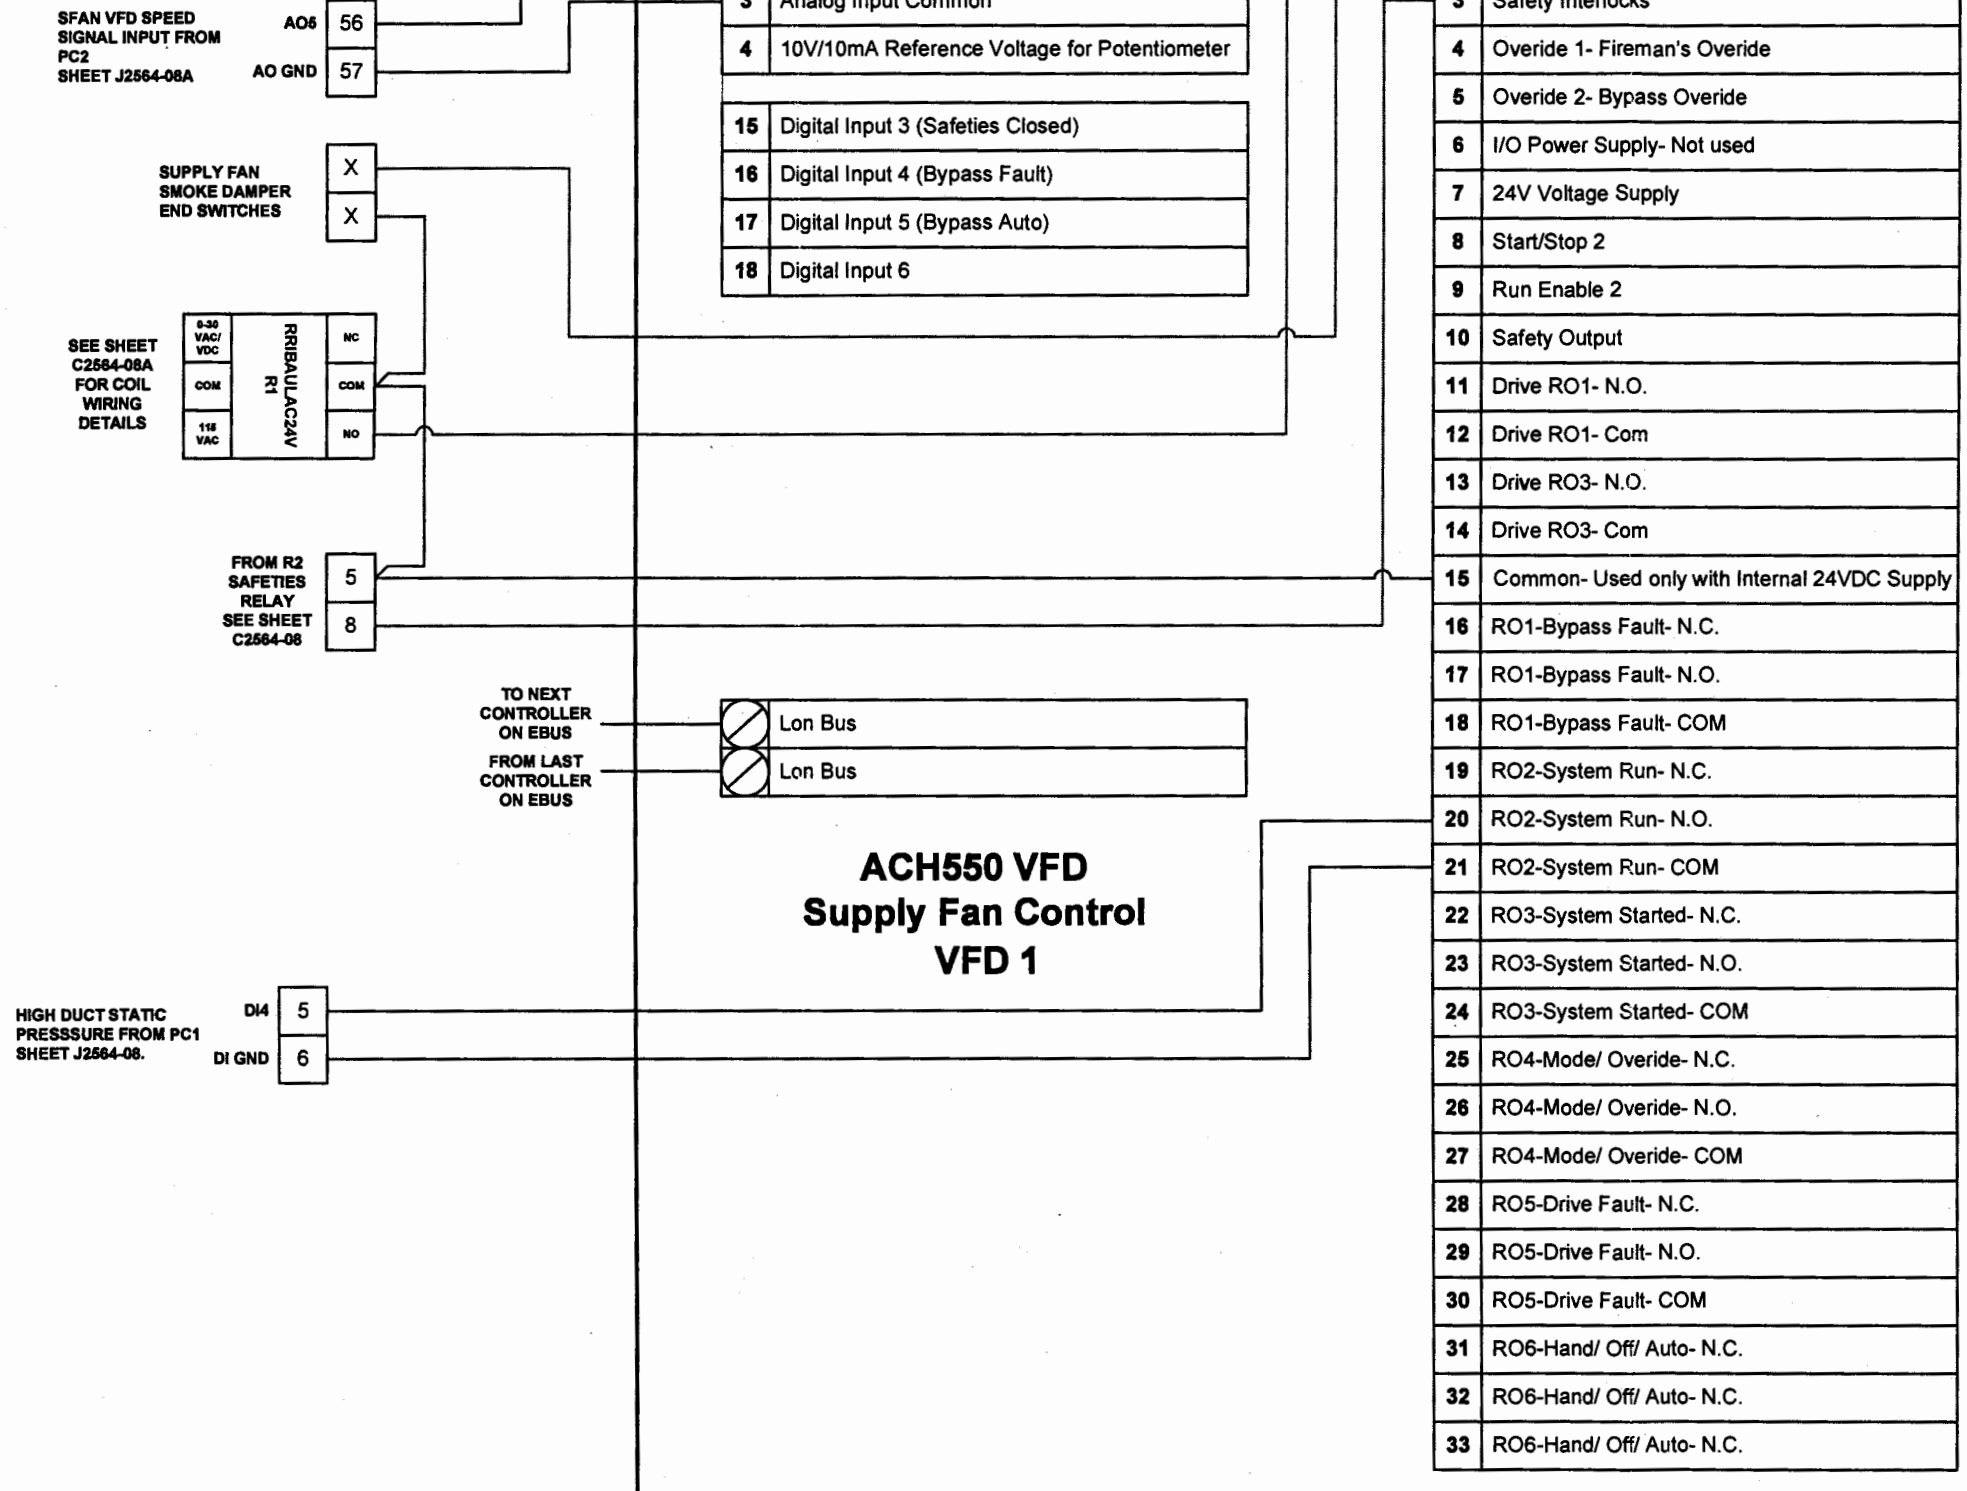

AHU-1, 2, 3 SUPPLY FAN AND DUCT PRESSURE MONITORING

Project Title McEnery Classroom Building	 AUTHORIZED CONTROLS INTEGRATOR	Application Engineer BMR	CONTRACT NUMBER 2564-S
Drawing Title Supply Fan Control Wiring		Project Manager JWJ	DRAWING NUMBER C2564-10
		Sales Engineer SJG	

NOTES

NOTE 1: SEE SEQUENCE OF OPERATIONS ON SHEET C2564-12.

NOTE 2: SEE BILL OF MATERIALS ON SHEET C2564-12.

RFAN VFD SPEED
SIGNAL INPUT FROM
PC1
SHEET J2564-08A

AO5 56
AO GND 57

SUPPLY FAN VFD
TERMINAL STRIP
(SYSTEM RUN)

20
21

FROM R2
SAFETIES
RELAY
SEE SHEET
C2564-08

4
7

TO NEXT
CONTROLLER
ON EBUS
FROM LAST
CONTROLLER
ON EBUS

Lon Bus
Lon Bus

HIGH DUCT STATIC
PRESSURE FROM PC1
SHEET J2564-08.

DI 7 10
DI GND 11

1	Start/Stop
2	Analog Input Channel 1
3	Analog Input Common
4	10V/10mA Reference Voltage for Potentiometer
5	Analog Input Channel 2

15	Digital Input 3 (Safeties Closed)
16	Digital Input 4 (Bypass Fault)
17	Digital Input 5 (Bypass Auto)
18	Digital Input 6

1	Start/Stop
2	Run Enable
3	Safety Interlocks
4	Override 1- Fireman's Override
5	Override 2- Bypass Override
6	I/O Power Supply- Not used
7	24V Voltage Supply
8	Start/Stop 2
9	Run Enable 2
10	Safety Output
11	Drive RO1- N.O.
12	Drive RO1- Com
13	Drive RO3- N.O.
14	Drive RO3- Com
15	Common- Used only with Internal 24VDC Supply
16	RO1-Bypass Fault- N.C.
17	RO1-Bypass Fault- N.O.
18	RO1-Bypass Fault- COM
19	RO2-System Run- N.C.
20	RO2-System Run- N.O.
21	RO2-System Fault- COM
22	RO3-System Started- N.C.
23	RO3-System Started- N.O.
24	RO3-System Started- COM
25	RO4-Mode/ Override- N.C.
26	RO4-Mode/ Override- N.O.
27	RO4-Mode/ Override- COM
28	RO5-Drive Fault- N.C.
29	RO5-Drive Fault- N.O.
30	RO5-Drive Fault- COM
31	RO6-Hand/ Off/ Auto- N.C.
32	RO6-Hand/ Off/ Auto- N.C.
33	RO6-Hand/ Off/ Auto- N.C.

**VFD Provided By
Equipment Manufacturer
Return Fan Control
VFD 2**

AHU- 1, 2, 3 RETURN FAN AND AIR FLOW MEASURING STATION

Project Title
McEniry Classroom Building
Drawing Title
Return Fan Control Wiring



Application Engineer
BMR
Project Manager
JWJ
Sales Engineer
SJG

CONTRACT NUMBER
2564-S
DRAWING NUMBER
C2564-11

BILL OF MATERIALS AHU 1, 2 & 3 (Parts Repeated On Each AHU)				
DESIGNATION	QTY	MARK	PART NUMBER	DESCRIPTION
Field Devices:	1	VFD1	ACH550	SUPPLY FAN VFD
	1	VFD2	ACH550	RETURN FAN VFD
	3	T3, 4, 6	TE-702-B-17-C	PREHEAT, COLD AND HOT DECK AIR TEMP SENSORS
	1	T2	TE-705-B-17-B-1	MIXED AIR TEMPERATURE SENSOR
	3	T1	GTA116-PC	EBTRON AIRFLOW (SUP/ RET) AND TEMP SENSOR (RET)
	1	T5	HO3XVSTM	OUTDOOR AIR TEMPERATURE/ Rh SENSOR
	1	E3	DWYER 1823-0	DIRTY FILTER
	3	E4/E6	AFS-460	MANUAL RESET HIGH STATIC PRESSURE
	1	E5	L482A-1004	FREEZE THERMOSTAT
	1	PCD	PRR275	DUCT STATIC PRES SENSORS, COLD DECK
	1	PHD	PRR275	DUCT STATIC PRES SENSORS, HOT DECK
Panel Devices:	1	XF	PSH100A100A	120 VAC TO 24 VAC TRANSFORMER
	4	R1,2,3,4	RRIBAULAC24V	PANEL MOUNTED RELAY
	1	PC1	W7760C-2001	HONEYWELL PLANT CONTROLLER

BILL OF MATERIALS AHU ACTUATORS AND VALVES (Specific to Each AHU)				
DESIGNATION	QTY	MARK	PART NUMBER	DESCRIPTION
AHU 1:	1	V1A	N/A	EXISTING COLD WATER VALVE
	1	V1B	V5011N1081	2 WAY, GLOBE, 1 1/2", HOT WATER VALVE
	1	V1C	V5011N1073	2 WAY, GLOBE, 1 1/4", PREHEAT VALVE
	1	CWVA	GM24MFTUS	24 VAC, EXISTING BELIMO VALVE ACTUATOR
	1	HWVA	ML7425B	24 VAC ,MOD SR ACTUATOR FOR HW VALVE
	1	PHVA	ML7425B	24 VAC ,MOD SR ACTUATOR FOR PH VALVE
	1	RDA	MS7520A2007	RETURN AIR 175inlb DAMPER ACTUATOR
	4	ODA	MS7520A2007	OUTDOOR AIR 175inlb DAMPER ACTUATORS
	1	RLDA	MS7520A2007	RELIEF AIR 175inlb DAMPER ACTUATOR
	1	MDA	MS7520A2007	MINIMUM OA 175inlb DAMPER ACTUATOR
AHU 2:	1	V2A	N/A	EXISTING COLD WATER VALVE
	1	V2B	V5011N1081	2 WAY, GLOBE, 1 1/2", HOT WATER VALVE
	1	V2C	V5011N1073	2 WAY, GLOBE, 1 1/4", PREHEAT VALVE
	1	CWVA	GM24MFTUS	24 VAC, EXISTING BELIMO VALVE ACTUATOR
	1	HWVA	ML7425B	24 VAC ,MOD SR ACTUATOR FOR HW VALVE
	1	PHVA	ML7425B	24 VAC ,MOD SR ACTUATOR FOR PH VALVE
	1	RDA	MS7520A2007	RETURN AIR 175inlb DAMPER ACTUATOR
	1	ODA	MS7520A2007	OUTDOOR AIR 175inlb DAMPER ACTUATOR
	2	RLDA	MS7520A2007	RELIEF AIR 175inlb DAMPER ACTUATORS
	1	MDA	MS7520A2007	MINIMUM OA 175inlb DAMPER ACTUATOR
AHU 3:	1	V3A	N/A	EXISTING COLD WATER VALVE
	1	V3B	V5011N1081	2 WAY, GLOBE, 1 1/2", HOT WATER VALVE
	1	V3C	V5011N1065	2 WAY, GLOBE, 1", PREHEAT VALVE
	1	CWVA	GM24MFTUS	24 VAC, EXISTING BELIMO VALVE ACTUATOR
	1	HWVA	ML7425B	24 VAC ,MOD SR ACTUATOR FOR HW VALVE
	1	PHVA	ML7425B	24 VAC ,MOD SR ACTUATOR FOR PH VALVE
	1	RDA	MS7520A2007	RETURN AIR 175inlb DAMPER ACTUATOR
	1	ODA	MS7520A2007	OUTDOOR AIR 175inlb DAMPER ACTUATOR
	2	RLDA	MS7520A2007	RELIEF AIR 175inlb DAMPER ACTUATORS
	1	MDA	MS7520A2007	MINIMUM OA 175inlb DAMPER ACTUATOR


SEQUENCE OF OPERATION AHU 1, 2 & 3	
CONTROL FEATURE	DESCRIPTION
Start/Stop	The air handling unit will be scheduled through the tridium workstation.
Supply Fan Control	The supply fan operates continuously in the occupied mode, and is cycled intermittently in the unoccupied mode with a call for cooling or heating. The supply fan VFD frequency is controlled to the Duct Static Pressure set point. Two static pressure sensors, PCD and PHD, placed in the hot and cold duct 2/3 of the distance of the main duct downstream from the fan will control the fan speed through the VFD. The lowest output of the two sensors will be the controlling duct static pressure sensor. The supply fan will be stopped if the return fan fails to operate.
Return Fan Control	The return fan will be interlocked with the supply fan to start simultaneously. It is controlled to maintain a difference in CFM between the supply and return fan. The return fan VFD maintains the minimum outdoor air quantity during periods where the economizer is disabled.
Minimum Outdoor Air Control	To maintain minimum outdoor air flow, Air Handler Units 1, 2 & 3 open their outside air damper to 50% (adj.) and modulate the return fan speed to maintain a 11,000 CFM offset between the supply air flow reading and the return airflow reading. The relief damper remains closed until the unit enters economizer conditions.
Economizer Control	During economizer conditions (outside air temperature below 55 degrees F) the relief, return and outside air dampers will modulate to maintain the cold deck air temperature at current set point. The return air fan will continue to maintain the offset airflow set point between supply and return.
Cooling Control	During start up, the outdoor air damper and the chilled water valve will remain closed until the return air temperature reaches the return temperature warm up set point. At this point, the outdoor air damper will open to its preset position and the cooling controls will be operational. If the outdoor air temperature, T5, is above 55 degrees F the economizer damper will be closed to minimum position and mechanical cooling will be enabled. The chilled water control valve will be modulated to maintain a discharge air temperature off 55 degrees F to 65 degrees F. The discharge air temperature set point will reset linearly from 55 degrees to 65 degrees as the outside air temperature drops from 80 degrees to 50 degrees.
Preheat Control	The preheat control valve will modulate to maintain a preheat temperature set point of 50 degrees. Preheat freeze protection pumps 1, 2 & 3 will be energized any time the outside air temperature drops to or below 40 degrees F.
Heating Control	At start-up, the unit will go into warm up mode with the outside air damper remaining closed and the hot water heating coil control valve being modulated wide open until the return air warm up set point of 70 degrees F is reached. The outdoor air damper will then be opened to its minimum position and the supply air temperature sensor in the hot duct, T4, will modulate the hot water valve to maintain the hot duct temperature set point. The set point will be based on outdoor temperature and will be increased linearly from 80 degrees F at 60 degrees F ambient to 110 degrees F at 40 degrees F ambient.
Emergency and Fire Operation	Upon activation of the building fire alarm system, E1 & E2, all outputs will be de-energized and dampers closed. Upon activation of the freeze protection thermostat, E5, the unit fans will be de-energized, control dampers will be closed, and the hot water and preheat valves will be opened. Upon activation of the hi pressure switch, E4, the unit fans will be de-energized. Upon activation of the refrigerant alarm, E7, in the basement, all outputs will be de-energized and dampers closed on Air Handler Unit 1. The Air Handler will be reactivated after clearance of refrigerant alarm.

Project Title	McEniry Classroom Building	Application Engineer	BMR	CONTRACT NUMBER	2564-S
Drawing Title	AHU Sequence of Ops	Project Manager	JWJ	DRAWING NUMBER	C2564-12
		Sales Engineer	SJG		



EQUIPMENT NOTES

- 1) For VAV actuator installation, set CCW to close.
- 2) Thermostat wiring color code: Red - Sensor, Green - Ground, Black - Setpoint
- 3) Install CT switch around power wire of the steam tunnel exhaust fan to prove fan status. Connect CT switch to VAV controller B1-1.

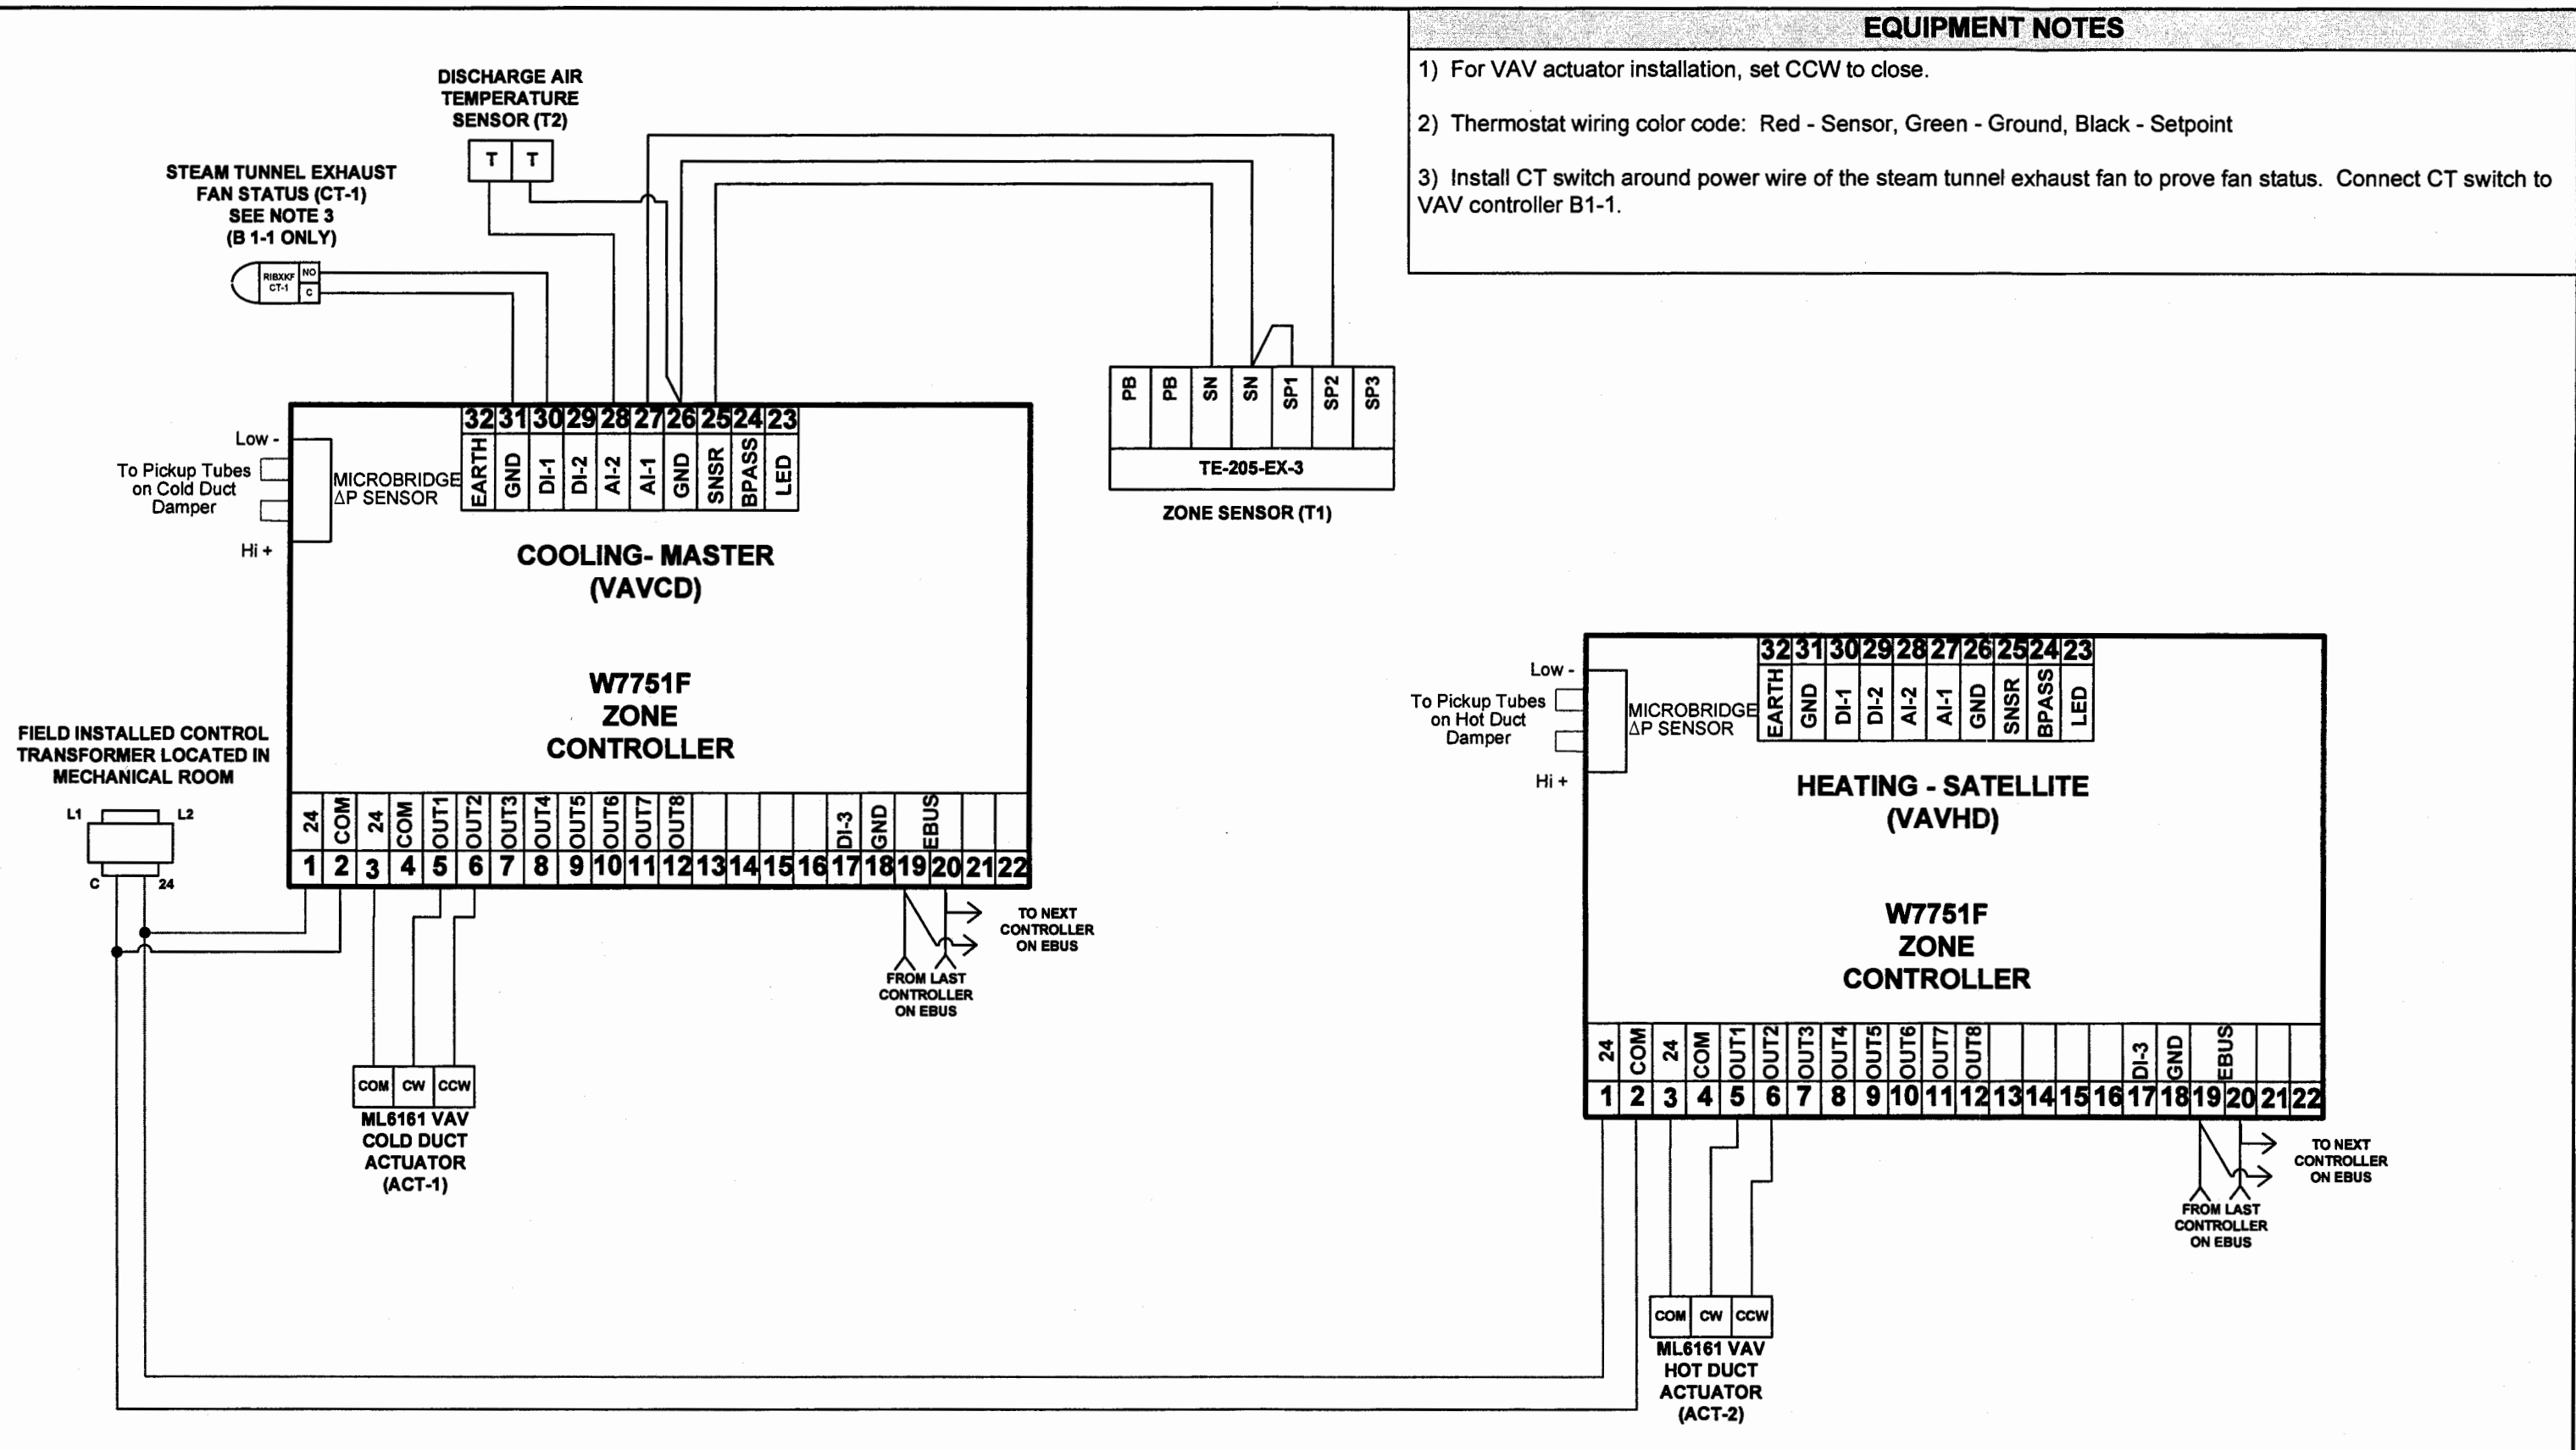


Dual Duct VV & CV Control Wiring

Project Title McEnery Classroom Building	 Honeywell <small>AUTHORIZED CONTROLS INTEGRATOR</small>	Application Engineer BMR	CONTRACT NUMBER 2564-S
Drawing Title Dual Duct VV & CV Wiring		Project Manager JWJ	DRAWING NUMBER C2564-13
		Sales Engineer SJG	

EQUIPMENT NOTES

- 1) For VAV actuator installation, set CCW to close.
- 2) Thermostat wiring color code: Red - Sensor, Green - Ground, Black - Setpoint

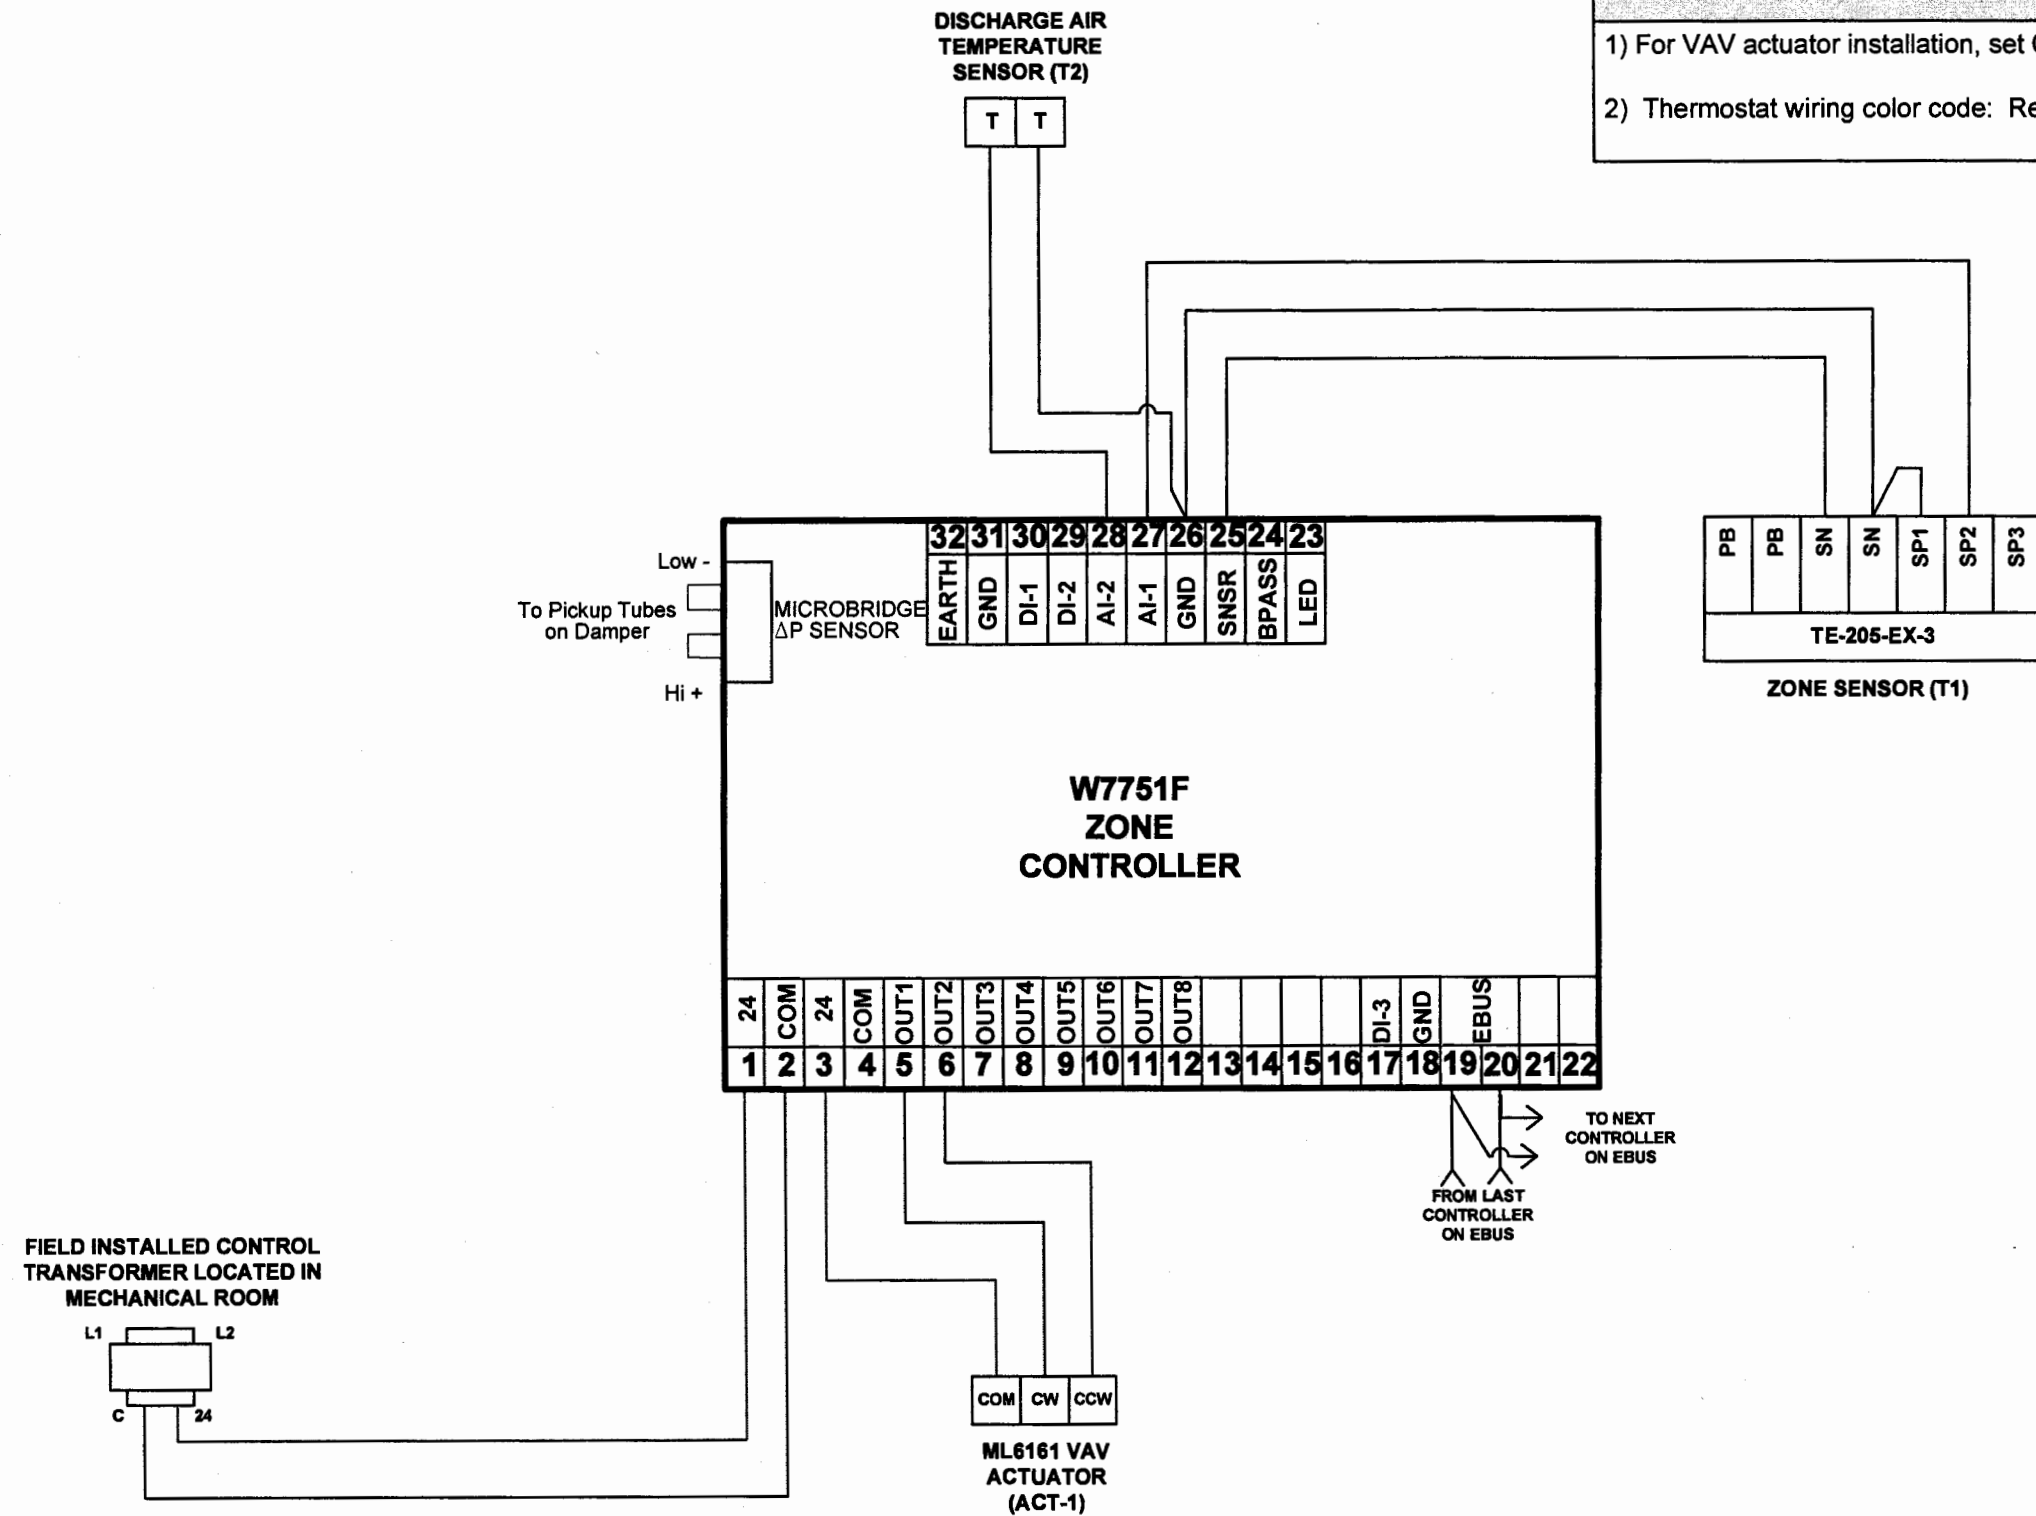


Single Duct VV & CV Control Wiring


Project Title	McEnery Classroom Building	Application Engineer	BMR	CONTRACT NUMBER	2564-S
Drawing Title	Single Duct VV & CV Wiring	Project Manager	JWJ	DRAWING NUMBER	C2564-14
 AUTHORIZED CONTROLS INTEGRATOR		Sales Engineer	SJG		

DUAL DUCT VAV BOXES BILL OF MATERIALS (PER VV OR CV BOX)					SINGLE DUCT VAV BOXES BILL OF MATERIALS (PER VV OR CV BOX)				
DESIGNATION	QTY	MARK	PART NUMBER	DESCRIPTION	DESIGNATION	QTY	MARK	PART NUMBER	DESCRIPTION
Field Devices:	1	T1	TE-205-EX-3	ZONE SENSOR	Field Devices:	1	T1	TE-205-EX-3	ZONE SENSOR
	1	T2	TE-702-B17-D2	20 KOhm NTC DUCT TEMPERATURE PROBE		1	T2	TE-702-B17-D2	20 KOhm NTC DUCT TEMPERATURE PROBE
Panel Devices:	1	VAVCD	W7751F2003	HONEYWELL XL10 VAV CONTROLLER	Panel Devices:	1	VAV	W7751F2003	HONEYWELL XL10 VAV CONTROLLER
	1	VAVHD	W7751F2003	HONEYWELL XL10 VAV CONTROLLER		1	ACT-1	ML6161B2024	HONEYWELL 24 VAC ACTUATOR
	2	ACT-1/ACT-2	ML6161B2024	HONEYWELL 24 VAC ACTUATOR					

SEQUENCE OF OPERATION DUAL DUCT VV & CV		SEQUENCE OF OPERATION SINGLE DUCT VV & CV	
CONTROL FEATURE	DESCRIPTION	CONTROL FEATURE	DESCRIPTION
DUAL DUCT VAV	Dual duct flow mixing uses two controls devices, a master for the cold duct (VAVCD) and a satellite for the hot duct (VAVHD) to provide pressure independent control for the zone. If there is a need for cooling, dual duct flow mixing will control temperature to the cooling setpoint, setting the flow control setpoint for the cold duct between minimum and maximum flow while setting the hot duct flow setpoint to zero. If the temperature of the space is between the cooling and heating setpoints, the cold duct will control to the minimum flow while the hot duct flow is set to zero. If there is a need for heating, the controllers will try to control to the heating setpoint by first modulating the cold duct flow from minimum flow to zero while simultaneously modulating the hot duct flow from zero to minimum flow. If there is additional need for heat, the hot duct will modulate from minimum to maximum flow while the cold duct is held at zero.	SINGLE DUCT VAV	The strategy used is single duct, pressure independent cooling only. There is one control device on the vav damper (VAV). If there is a call for cooling, temperature is controlled to the cooling set point, with the flow thru the damper being maintained between min and max flow setpoints. When the space temperature is at or below the cooling setpoint, the damper will be at minimum flow.
SETPOINTS	Occupied and unoccupied cooling and heating setpoints are adjusted through the existing tridium interface. Zone sensors are provided with a setpoint adjustment knob, the amount of adjustment allowed for each zone is configurable from the tridium interface.	SETPOINTS	Occupied and unoccupied cooling and heating setpoints are adjusted through the existing tridium interface. Zone sensors are provided with a setpoint adjustment knob, the amount of adjustment allowed for each zone is configurable from the tridium interface.
OCCUPIED/UNOCCUPIED	When the associated air handling unit is occupied, the vav boxes will be set to the occupied state.	OCCUPIED/UNOCCUPIED	When the associated air handling unit is occupied, the vav boxes will be set to the occupied state.

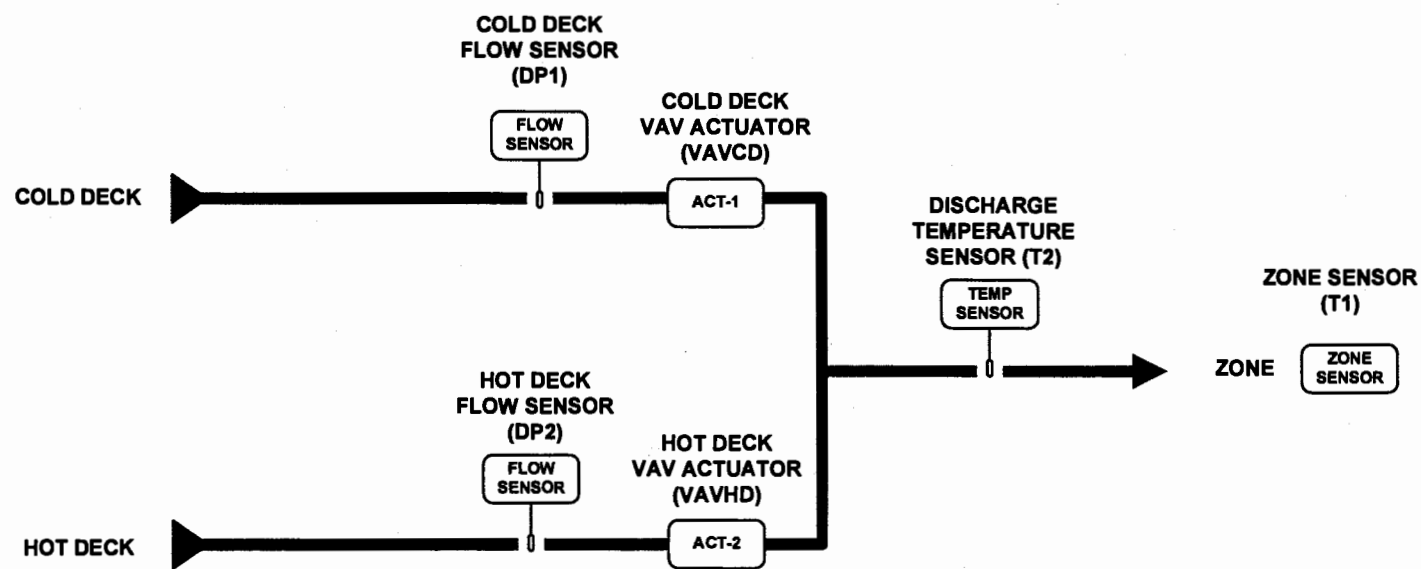


Dual Duct VV & CV Flow Diagram

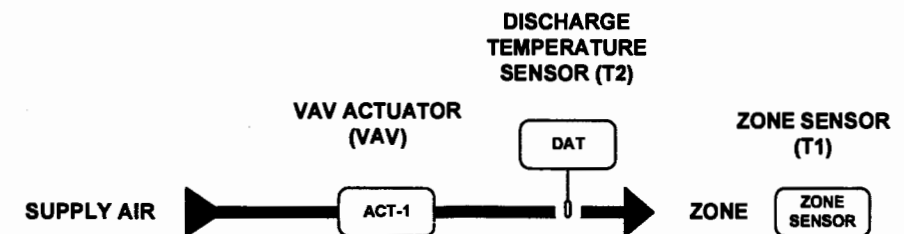

Single Duct VV & CV Flow Diagram

Project Title McEnery Classroom Building	 Honeywell <small>AUTHORIZED CONTROLS INTEGRATOR</small>	Application Engineer BMR	CONTRACT NUMBER 2564-S
Drawing Title VV & CV Sequence of Ops		Project Manager JWJ	DRAWING NUMBER C2564-15
		Sales Engineer SJG	

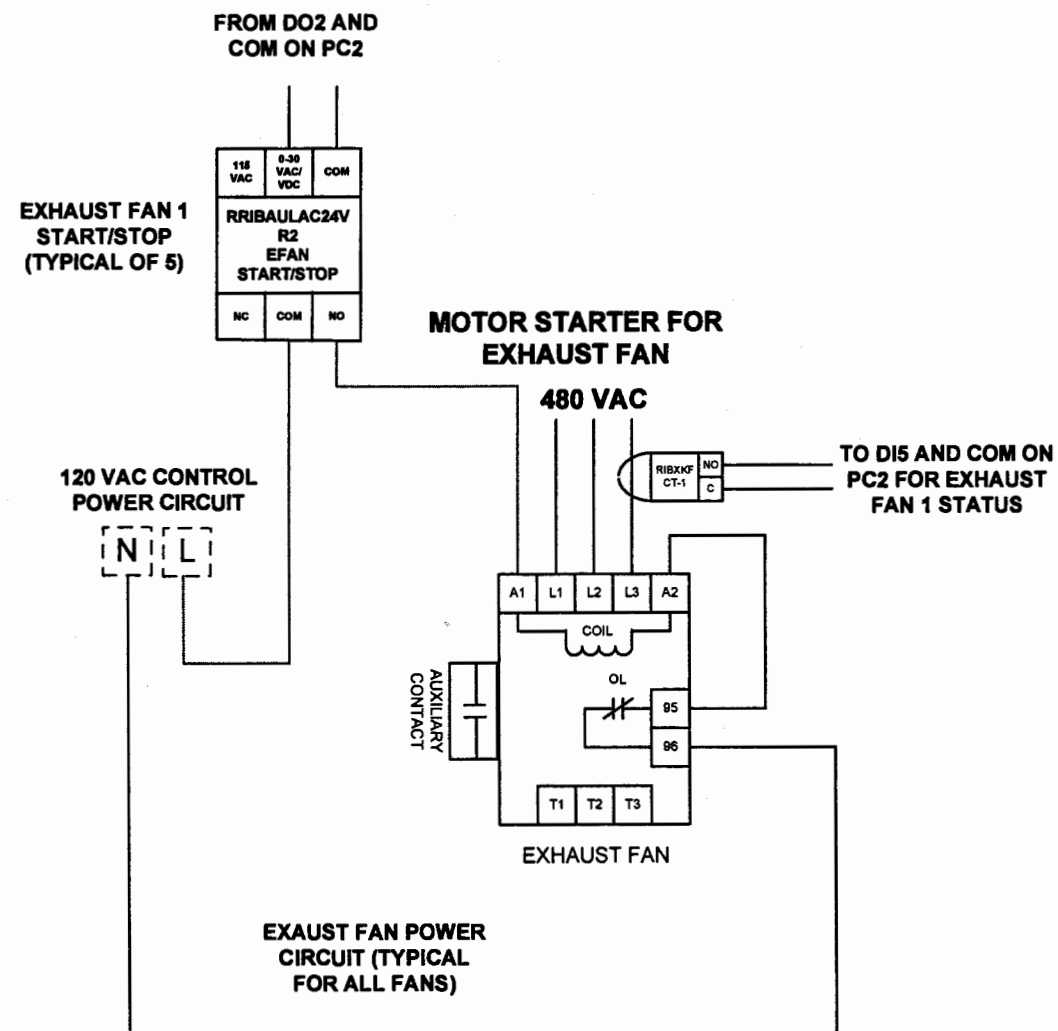

EXHAUST FAN BILL OF MATERIALS (Per Exhaust Fan)

DESIGNATION	QTY	MARK	PART NUMBER	DESCRIPTION
Field Devices:	5	CT-1	RIBXKF	CURRENT SWITCH- EXHAUST FAN PROVE
Panel Devices:	5	R2	RRIBAUAC24V	RELAY- EXHAUST FAN START/STOP

EXHAUST FAN MOTOR STARTERS

EXHAUST FAN	MOTOR STARTER	STARTED & MONITORED BY:
F-1: MIN 3HP	MAX 5 HP, 460V- CUTLER HAMMER ECN0501CAA	AHU 3 - PC 2
F-2: MIN 1/30 HP	MAX 2 HP, 460V- CUTLER HAMMER ECN05A1CAA	HEATING PLANT - PC4
F-7: MIN 2 HP	MAX 5 HP, 460V- CUTLER HAMMER ECN0501CAA	AHU 2 - PC 2
F-8: MIN 2 HP	MAX 5 HP, 460V- CUTLER HAMMER ECN0501CAA	AHU 3 - PC2
F-9: MIN 2 HP	MAX 5 HP, 460V- CUTLER HAMMER ECN0501CAA	AHU 3 - PC2

SEQUENCE OF OPERATION EXHAUST FANS

CONTROL FEATURE	DESCRIPTION
EXHAUST FAN STATUS	All new exhaust fans added with this project will be monitored with a current switch (CT) to prove fan operation.
EXHAUST FAN CONTROL	Exhaust fans designated in the project specifications will be controlled by a low voltage relay connected to the closest plant controller. The fans will run during occupied periods.
ALARMS	An alarm will be generated if the fan is scheduled to run but the current switch (CT-1) is not activated, or if the fan is not scheduled to run and the current switch (CT-1) is activated.

Project Title
McEnery Classroom Building

Drawing Title
Exhaust Fan Control Wiring




Application Engineer
BMR

Project Manager
JWJ


Sales Engineer
SJG

CONTRACT NUMBER
2564-S

DRAWING NUMBER
C2564-16

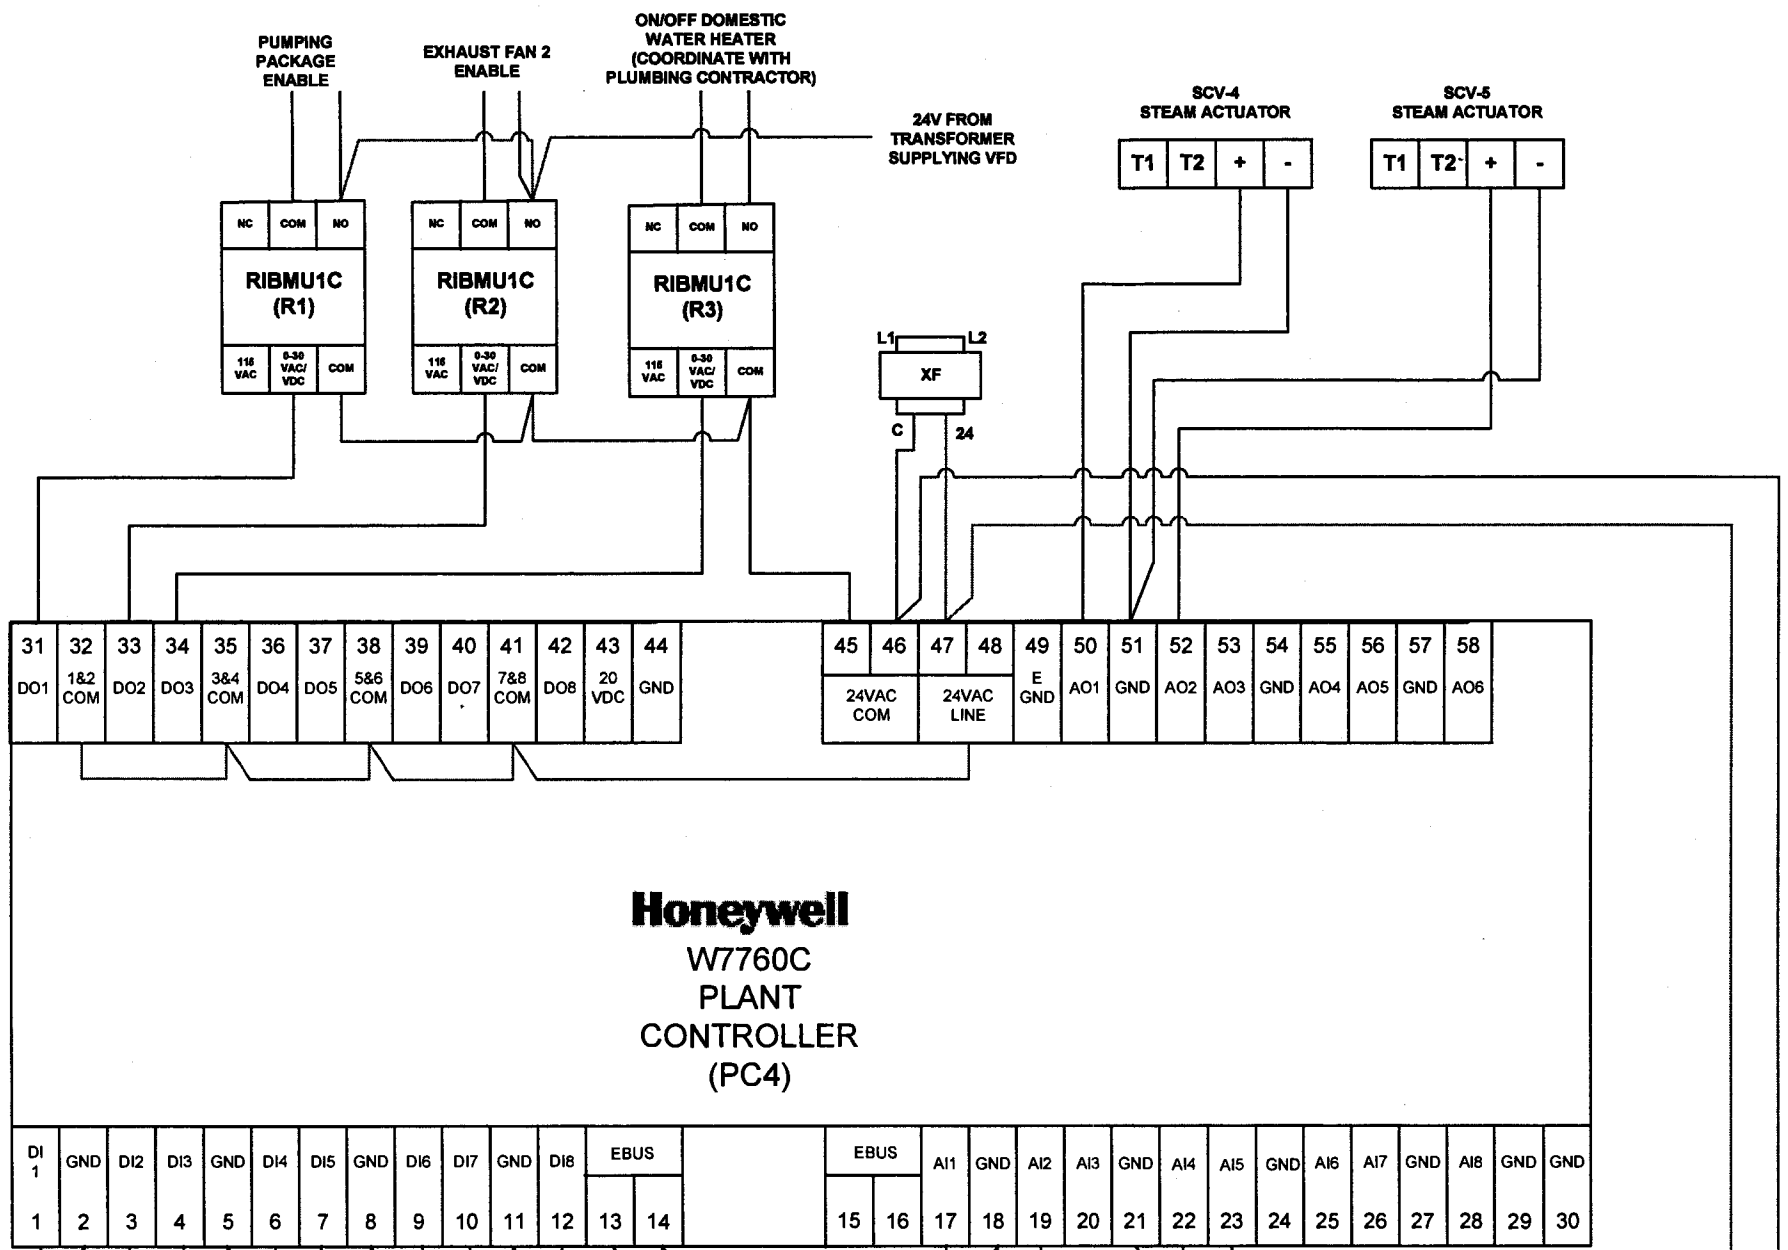

Honeywell
W7760C
PLANT
CONTROLLER
(PC4)

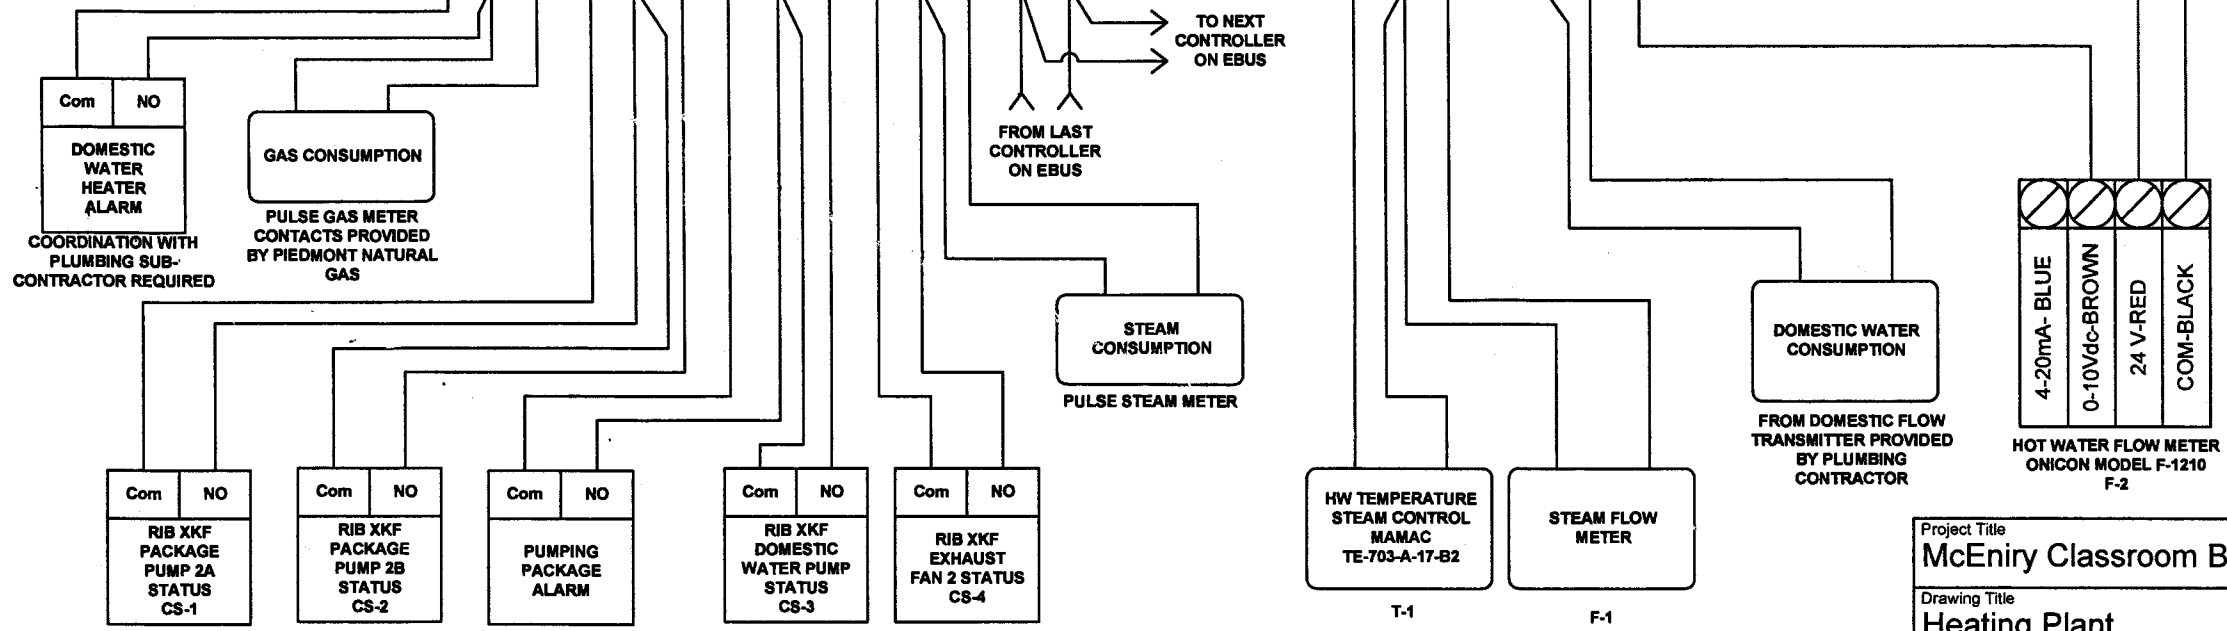

(SEE SHEET C2564-16)

Project Title
McEniry Classroom Building

Drawing Title
Heating Plant



Application Engineer
BMR

Project Manager
JWJ

Sales Engineer
SJG

CONTRACT NUMBER
2564-S

DRAWING NUMBER
C2564-17

BILL OF MATERIALS HW SYSTEM				
DESIGNATION	QTY	MARK	PART NUMBER	DESCRIPTION
Field Devices:	2	CS1-2	RIBXKF	CURRENT SWITCH- PUMP PROVE
	1	T-1	TE-703-A-17-B2	HONEYWELL WELL TEMPERATURE SENSOR
	1	T-1	A5001B1	HONEYWELL 4" TEMPERATURE WELL
	1	F-1	EMCO PHD	EMCO PHD VORTEX FLOW METER
	1	SCV-4	ML7425B3013	HONEYWELL GLOBE 1/3 STEAM VALVE ACTUATOR
	1	SCV-4	V5011N2097	HONEYWELL 2-WAY, 2", 1/3 STEAM VALVE
	1	SCV-5	2XAF24-MFT-US	BELIMO 2/3 STEAM VALVE ACTUATOR
	1	SCV-5	G680	BELIMO 2-WAY, 3", 2/3 STEAM VALVE
	1	F-2	F-1210	ONICON HOT WATER FLOW METER
	Panel Devices:	3	R1-3	RIBMU1C
1		PC1	W7760C-2001	HONEYWELL PLANT CONTROLLER

SEQUENCE OF OPERATION HOT WATER SYSTEM	
CONTROL FEATURE	DESCRIPTION
STEAM CONTROL VALVE	Steam control valves SCV-4 and SCV-5 to hot water convertor will modulate to maintain desired supply water temperature determined by T-1.
HOT WATER PUMPS	Hot water pumps along with VFD control will be provided in pumping package. The building DDC system will monitor and alarm pump status and will enable pumps.
DOMESTIC WATER HEATER	Points are provided to monitor status and to activate/ deactivate domestic water heater. The Plumbing subcontractor will be coordinated with for point access.
GAS CONSUMPTION	Points are provided to monitor gas consumption from pulse gas meter to be provided by Piedmont Natural Gas Co.
ELECTRIC METER	Points are provided to read data remotely from the electric meter provided under Division 16 to monitor KWH consumption and demand KW, Amps, Volts, KVARs, KVA, PF, Frequency.
STEAM FLOW METER	Steam flow meter will monitor steam consumption for the building. The meter will be located in the branch main coming off the steam main in the crawl space.
DOMESTIC WATER CONSUMPTION	Points are provided to monitor building's domestic water consumption from the water meter to be provided on the water main in the building by the Plumbing Sub-contractor.
HOT WATER FLOW	Building Hot Water Flow will be monitored by the Hot Water Flow Meter, F2, and displayed graphically.

Project Title	McEniry Classroom Building	Application Engineer	BMR	CONTRACT NUMBER	2564-S
Drawing Title	HW Sys Sequence of Ops	Project Manager	JWJ	DRAWING NUMBER	C2564-18
		Sales Engineer	SJG		



CONTROL VALVE SCHEDULE

VALVE	SERVICE	GPM	Calc Cv	Valve Cv	SIZE	TYPE	VALVE	ACTUATOR
V-1A	AHU-1 CW	*	*	*	*	2W	*	*
V-1B	AHU-1 HW	56	28	29.3	1½"	2W	V5011N1081	ML7425B3012
V-1C	AHU-1 PREHEAT	33	16.5	18.7	1¼"	2W	V5011N1073	ML7425B3012
V-2A	AHU-2 CW	*	*	*	*	2W	*	*
V-2B	AHU-2 HW	60	30	29.3	1½"	2W	V5011N1081	ML7425B3012
V-2C	AHU-2 PREHEAT	37	18.5	18.7	1¼"	2W	V5011N1073	ML7425B3012
V-3A	AHU-3 CW	*	*	*	*	2W	*	*
V-3B	AHU-3 HW	63	31.5	29.3	1½"	2W	V5011N1081	ML7425B3012
V-3C	AHU-3 PREHEAT	21	10.5	11.7	1"	2W	V5011N1065	ML7425B3012
SCV-4	HX-1 1/3 VALVE	2400 #/hr	36.3	46.8	2"	2W	V5011N2097	ML7425B3012
SCV-5	HX-1 2/3 VALVE	4869 #/hr	73.6	90.0	3"	2W	G680	2XAF24-MFT-US

Water valve Cv calculated based on 4 PSI pressure drop at design flow, per specifications section 15980.2.1.C


*Existing chilled water valves to remain.

GENERAL NOTES

All points specified on drawing M2.4 will be included in the custom designed graphics. All graphics will be generated following the UNCC templates and will be submitted to UNCC for approval prior to deployment per the specifications section 15975.2.12 FMS GRAPHICS.

Project Title	McEniry Classroom Building	Application Engineer	BMR	CONTRACT NUMBER	2564-S
Drawing Title	AHU Valve Schedule	Project Manager	JWJ	DRAWING NUMBER	C2564-19
		Sales Engineer	SJG		



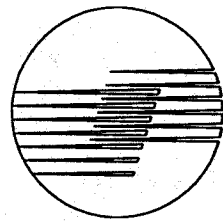

TRANE

Layne Trane
801 Pressley Rd.
Charlotte, N.C. 28217
704-525-3155

SHEET	UNIT WIRING DETAIL
1	FIBER TRUNK
2	BCU-5 DETAIL
3	TYPICAL PCM WIRING
4	BCU-5 COMMUNICATION TRUNK
5-9	AHU S-1, UPCM-1
5, 10, 11	AHU S-10, UPCM-1
12-16	AHU S-2, UPCM-2
17-21	AHU S-3, UPCM-3
22-24	EXHAUST FANS, UPCM-4
25-31	PLANT, UPCM-5
32-34	AHU-4, PCM-1
35-37	AHU-5, PCM-4
38-40	AHU-6, PCM-5
41-43	AHU-7, PCM-6
44-46	AHU-8, PCM-3
47-49	AHU-9, PCM-2
50	ADDRESSES
51	SEQUENCE

Controls Submittal

Project Name: UNCC McEniry Building Renovations

Project No. #: ICS-98014

*Engineer: SUD Associates, P.A.
Durham, North Carolina*

AS-BUILTS

LEGEND	
—————	INDICATES FACTORY WIRING
-----	INDICATES FIELD WIRING


THE DOCUMENTATION HEREIN IS THE EXCLUSIVE PROPERTY OF LAYNE TRANE, CHARLOTTE, N.C. REPRODUCTION AND/OR DISTRIBUTION TO OTHER THAN AUTHORIZED PARTIES IS PROHIBITED.

TRANE
LAYNE TRANE
801 PRESSLEY RD
CHARLOTTE, N.C. 28217
704 525 3155

REFERENCE DRAWING	NO.	REVISION-LOCATION	DATE	BY	FILE: COVER

SALES ENGR.	PROJ. MGR.	APPL. ENGR.	DRAWN BY	DATE
				4/3/98

PROJECT NAME	UNCC-McEniry Charlotte, North Carolina	CONTRACT NUMBER	ICS-98014
DRAWING NUMBER		SHEET COVER	

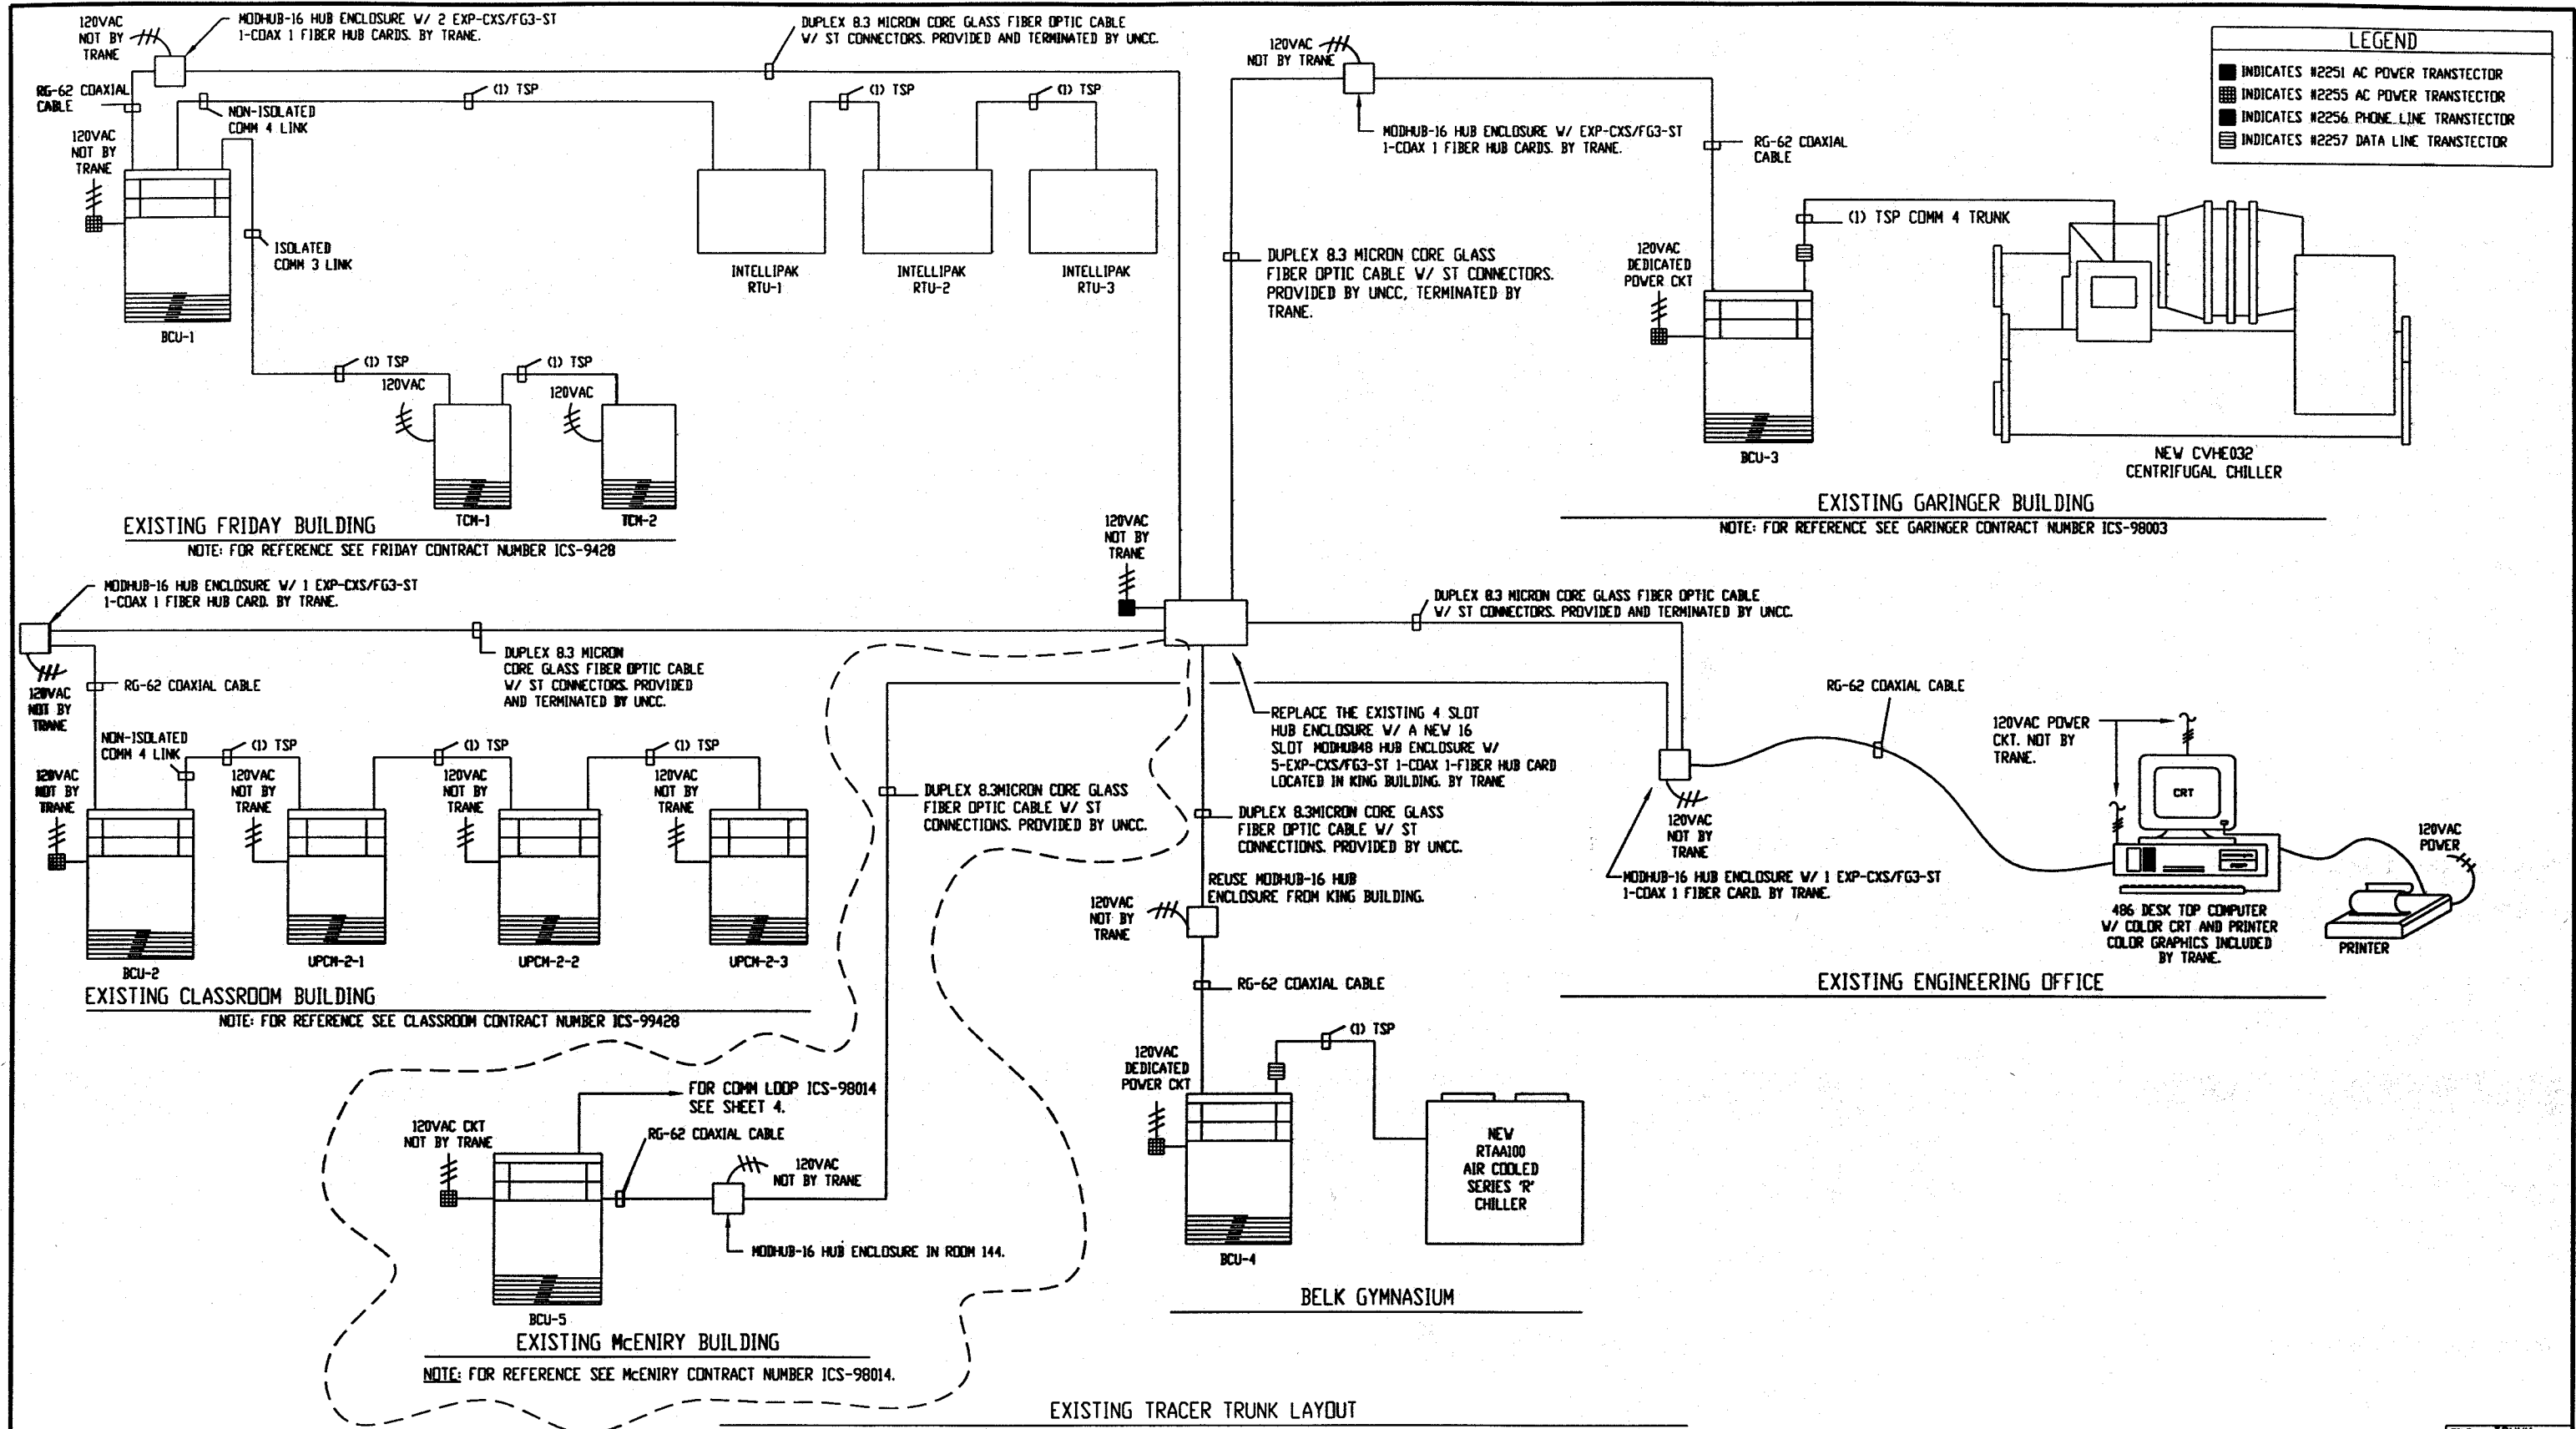

LEGEND


- INDICATES #2251 AC POWER TRANSECTOR
- ▣ INDICATES #2255 AC POWER TRANSECTOR
- ▤ INDICATES #2256 PHONE LINE TRANSECTOR
- ▥ INDICATES #2257 DATA LINE TRANSECTOR

THE DOCUMENTATION HEREIN IS THE EXCLUSIVE PROPERTY OF LAYNE TRANE, CHARLOTTE, N.C. REPRODUCTION AND/OR DISTRIBUTION TO OTHER THAN AUTHORIZED PARTIES IS PROHIBITED.

TRANE
LAYNE TRANE
801 PRESSLEY RD
CHARLOTTE, N.C. 28217
704 525 3155

REFERENCE DRAWING		NO.		REVISION-LOCATION		DATE		BY	

SALES ENGR. CCR	PROJ. MGR. CVF	APPL. ENGR. CVF	DRAWN BY DPC	DATE: 4/7/98
PROJECT NAME UNCC-McEniry Charlotte, North Carolina				CONTRACT NUMBER ICS-98014 DRAWING NUMBER SHEET 1 OF 51

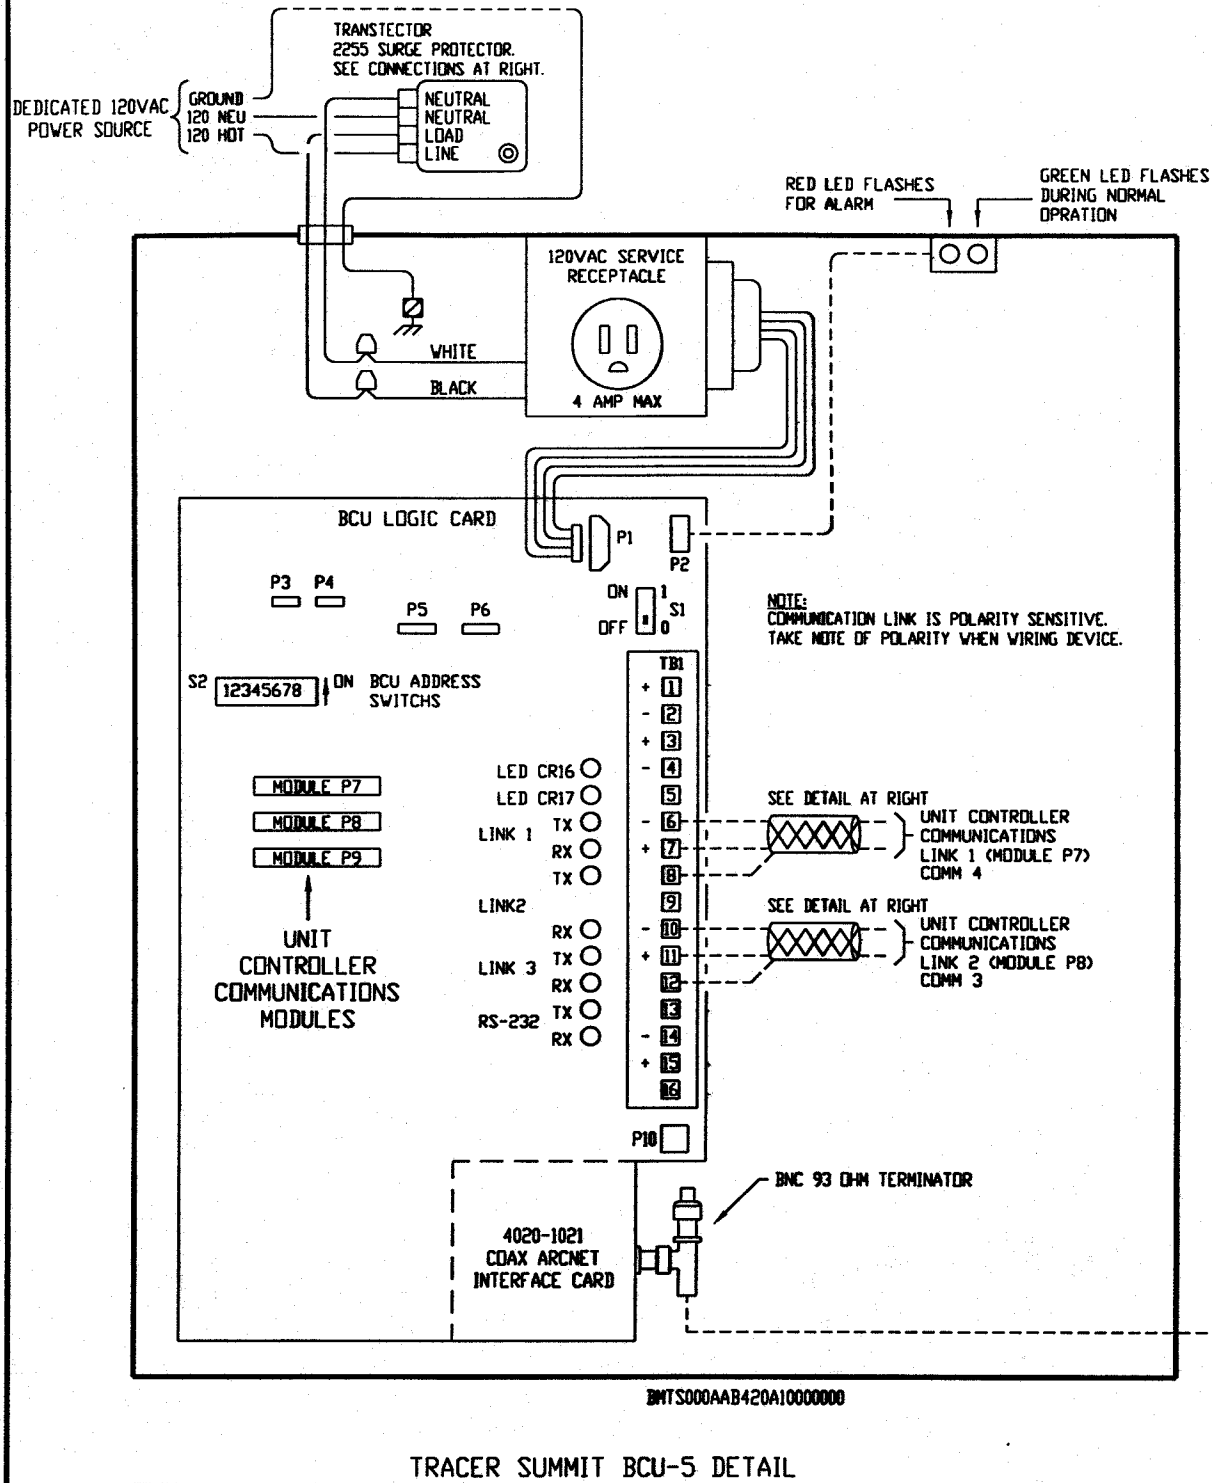


TRACER SUMMIT BCU-5 DETAIL

GENERAL WIRING NOTES:


- (1) ALL WIRING IS TO BE LABELED WITH A NUMBER AT ALL POINTS OF TERMINATION OR JUNCTION.
- (2) ALL WIRING SHOULD FOLLOW STANDARD COLORING CODING. EXAMPLE: ALL GROUND WIRES SHOULD BE GREEN WITH THE EXCEPTION OF BARE SHIELD WIRES IN CABLE.
- (3) TYPE AND USE OF CONDUIT OR PLENUM RATED CABLE SHOULD BE TAKEN FROM JOB SPECIFICATIONS AND FOLLOWED.
- (4) NO MORE THAN (1) EXTENSION ON A 4"x4" OR OTHER SIZED JUNCTION BOX. IF MORE ROOM IS NEEDED USE A BIGGER BOX.
- (5) IT IS THE ELECTRICAL SUBCONTRACTORS RESPONSIBILITY TO GENERATE AS-BUILT PRINTS AS THE JOB IS WIRED TO REFLECT TRUE WIRING, DEVICES AND WIRE NUMBERS.
- (6) PROVIDE A CONTROL CIRCUIT DISCONNECT SWITCH FOR EACH MECHANICAL ROOM OR DEVICE.

CUSTOMER NOTE:

1. COMPONENTS AND WIRING SHOWN DASHED ARE FURNISHED AND INSTALL BY ELECTRICAL SUBCONTRACTOR.
2. ALL CONTROL WIRING MUST BE IN ACCORDANCE WITH NATIONAL ELECTRIC CODES AND LOCAL CODES.
3. USE COPPER CONDUCTORS ONLY.
4. DO NOT RUN A/C POWER WITH ANY INPUT OR COMMUNICATIONS LINK WIRING.
5. INSTALL THE BCU INDOORS IN A CORROSIVE FREE, CLEAN ENVIRONMENT.
6. BINARY INPUT WIRING MUST BE SHIELDED, TWISTED PAIR, AND EACH CONDUCTOR MUST BE STRANDED, TINNED COPPER. RECOMMENDED WIRE SIZE IS 18 GAUGE. MAXIMUM BINARY INPUT WIRING DISTANCE IS 1000 FT.
7. ANALOG INPUT WIRING MUST BE SHIELDED, TWISTED PAIR, AND EACH CONDUCTOR MUST BE STRANDED TINNED COPPER. RECOMMENDED WIRE SIZE IS 18 GAUGE. MAXIMUM ANALOG INPUT WIRING DISTANCE IS 300 FT.
8. ALL COMMUNICATIONS LINK WIRING MUST BE LOW CAPACITANCE, 18 GAUGE, SHIELDED TWISTED PAIR WITH TINNED COPPER CONDUCTORS. MAXIMUM WIRE CAPACITANCE BETWEEN CONDUCTORS IS TO BE 25 PF/FT MAXIMUM COMMUNICATIONS LINK WIRING AT 25 PF/FT IS 5000 FT. LOOP OR DAISY CHAIN THE COMMUNICATIONS LINK BETWEEN CONTROLLERS WHERE POSSIBLE.
9. LAN COMMUNICATIONS LINK WIRING MUST BE A 93 OHM COAXIAL CABLE (RG-62) WITH A SOLID CENTER CONDUCTOR. MAXIMUM LAN COMMUNICATIONS WIRING IS 1000 FT AND THE MINIMUM DISTANCE IS 6 FT.
10. THE AC POWER OUTLET IS A SERVICE TOOL RECEPTACLE ONLY.

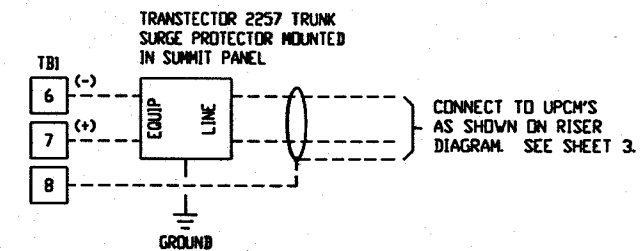


BCU TRUNK LINE SURGE PROTECTOR DETAIL

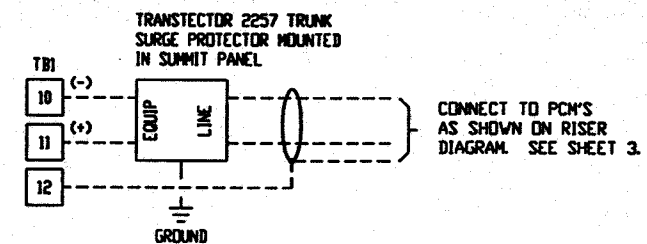

BCU TRUNK LINE SURGE PROTECTOR DETAIL

RG62 COAX CABLE

120VAC POWER CKT

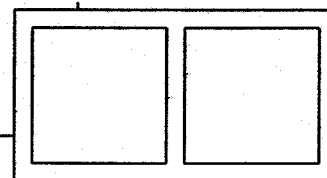

MODHUB-16 HUB ENCLOSURE WITH (2) EXPCXF/ FG3-ST FIBER/ COAX CARD. FIBER CONNECTION IN ROOM 144.

LEGEND


- INDICATES FACTORY WIRING
- - - INDICATES FIELD WIRING

THE DOCUMENTATION HEREIN IS THE EXCLUSIVE PROPERTY OF LAYNE TRANE, CHARLOTTE, N.C. REPRODUCTION AND/OR DISTRIBUTION TO OTHER THAN AUTHORIZED PARTIES IS PROHIBITED.

LAYNE TRANE
801 PRESSLEY RD
CHARLOTTE, N.C. 28217
704 525 3155

REFERENCE DRAWING					NO.		REVISION-LOCATION		DATE	BY
SALES ENGR. CCR	PROJ. MGR. CVF	APPL. ENGR. CVF	DRAWN BY. DPC	DATE: 4/2/98	PROJECT NAME		UNCC-McEniry Charlotte, North Carolina		CONTRACT NUMBER ICS-98014	DRAWING NUMBER SHEET 2 OF 51

FILE: BCU-1

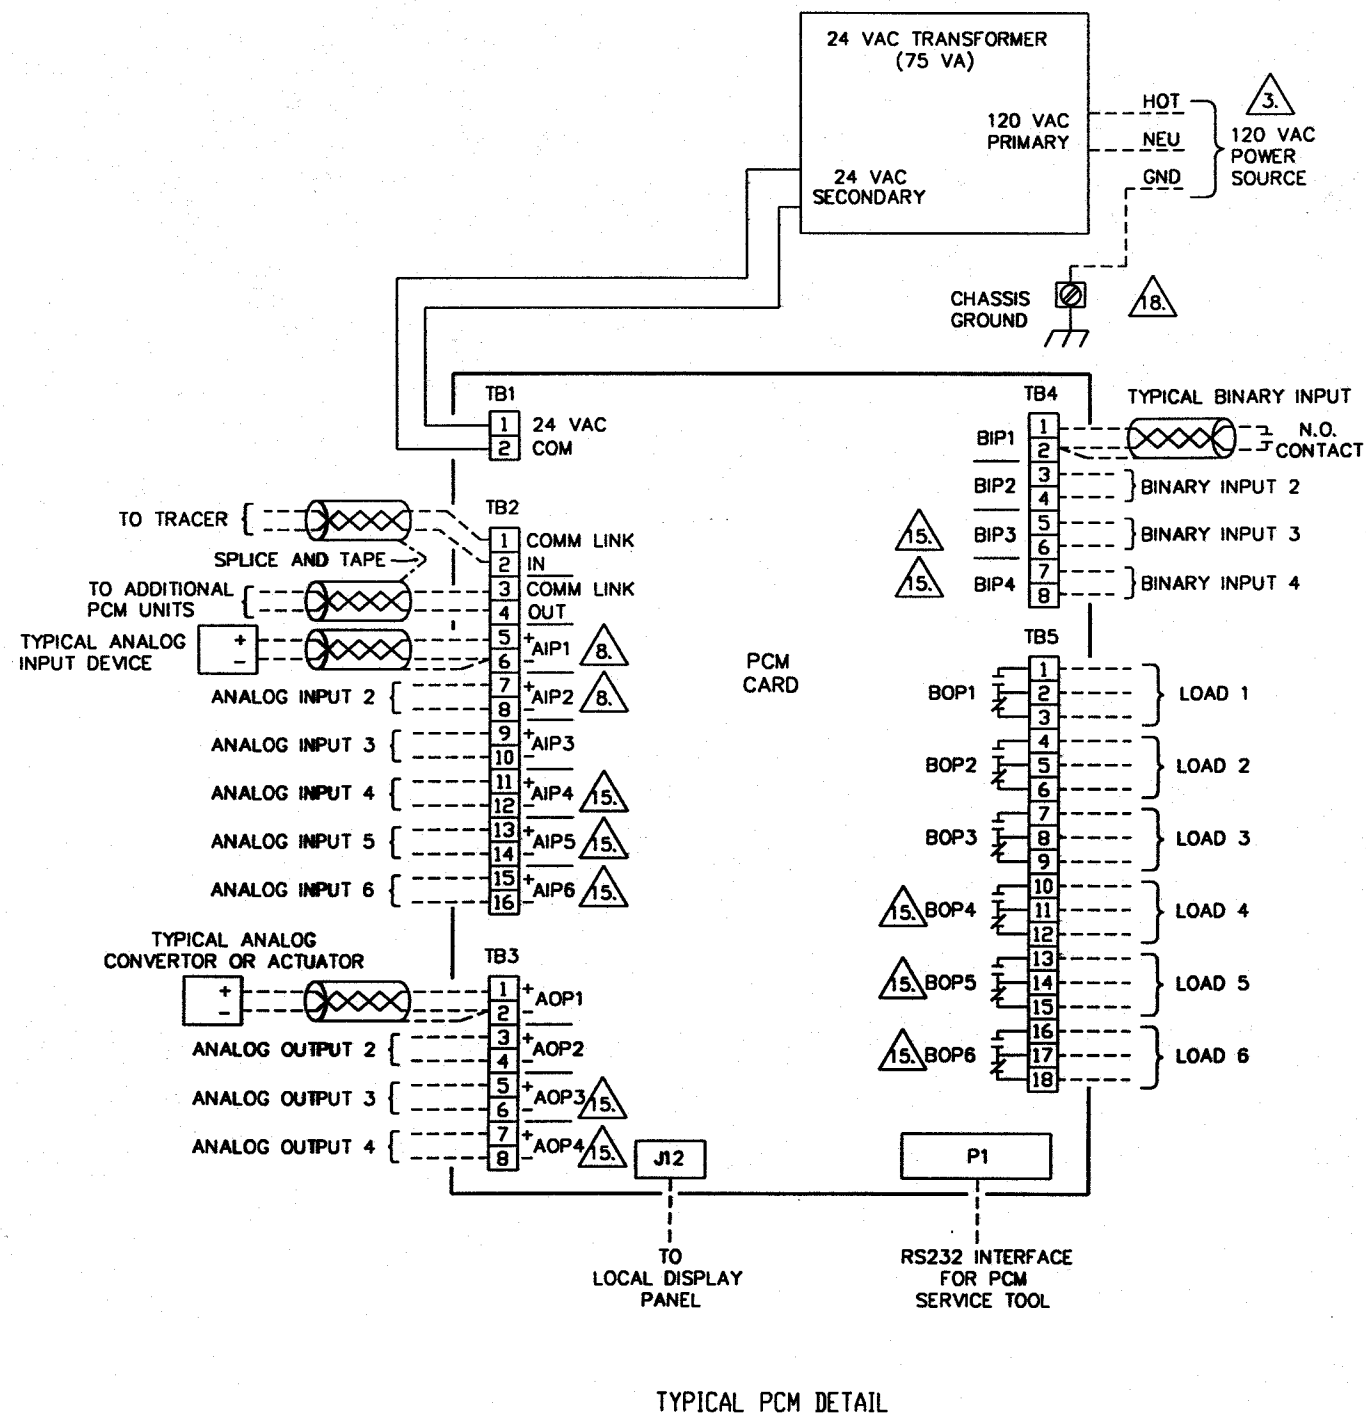

CUSTOMER NOTE

1. COMPONENTS AND WIRING SHOWN DASHED ARE FIELD WIRING. SPECIFICATIONS DETERMINE DIFFERENTIAL BETWEEN ELECTRICAL AND MECHANICAL WIRING.
2. ALL CONTROL WIRING MUST BE IN ACCORDANCE WITH NATIONAL ELECTRIC CODES AND LOCAL CODES.
3. THE NEMA 1 PCM REQUIRES A 120 VAC, 60 HZ, 1 AMP NON-DEDICATED AC POWER SOURCE.
4. BINARY INPUT (BIP) WIRING MUST BE SHIELDED, TWISTED PAIRS. RECOMMENDED SIZE IS 18 GA. AT SENSOR, SHIELD MUST BE CUT BACK AND TAPED. AT PCM BINARY INPUT TERMINALS, SHIELD MUST BE CONNECTED TO EVEN # TERMINAL OF THE RESPECTIVE INPUT. MAXIMUM BINARY INPUT WIRING DISTANCE IS 1000 FEET.
5. BINARY INPUTS MUST BE ISOLATED, UNGROUNDED CONTACTS.
6. ANALOG INPUT (AIP) WIRING MUST BE SHIELDED, TWISTED PAIRS. RECOMMENDED SIZE IS 18 GA. AT SENSOR, SHIELD MUST BE CUT BACK AND TAPED. AT PCM ANALOG INPUT TERMINALS, SHIELD MUST BE CONNECTED TO THE EVEN # TERMINAL OF THE RESPECTIVE INPUT. MAXIMUM ANALOG INPUT WIRING DISTANCE IS 300 FEET.
7. ANALOG INPUTS CAN BE RESISTANCE THERMISTOR TEMPERATURE SENSOR (-30 TO 220°F) AND IF SPECIFIED, PROVIDED WITH ADJUSTMENT KNOBS. ANALOG INPUTS CAN ALSO BE A 4 TO 20MA CURRENT SOURCE CAPABLE OF DRIVING 200 OHMS, OR A 0-10 VDC VOLTAGE SOURCE CAPABLE OF DRIVING 9000 OHMS.
8. ANALOG INPUTS 1 AND 2 (AIP1 AND AIP2) CAN ALSO BE RTD TEMPERATURE SENSORS (IN ADDITION TO THE STANDARD OPTIONS LISTED ABOVE). THE RANGE FOR 1000 OHM BALCO RTD'S IS -30 TO 220° F. THE RANGE FOR 1000 OHM 375 PLATINUM RTD'S IS -30 TO 200° F.
9. ANALOG OUTPUT (AOP) WIRING MUST BE SHIELDED, TWISTED PAIRS. RECOMMENDED SIZE IS 18 GA.. AT OUTPUT DEVICE, SHIELD MUST BE CUT BACK AND TAPED. AT PCM OUTPUT TERMINALS, SHIELD MUST BE CONNECTED TO EVEN # TERMINAL OF THE RESPECTIVE OUTPUT. MAXIMUM ANALOG OUTPUT DISTANCE IS 300 FEET.
10. ANALOG OUTPUTS PROVIDE A CONTINUOUS SIGNAL FOR DRIVING ANALOG TRANSDUCERS OR ACTUATORS. EACH ANALOG OUTPUT CAN PROVIDE 0 TO 10 VDC INTO 500 OHMS OR GREATER LOAD IMPEDANCE, OR 0 TO 20 MA INTO 500 OHMS OR LOWER LOAD IMPEDANCE.
11. BINARY OUTPUT (BOP) RELAY CONTACTS ARE RATED 24 VAC/VDC, 1 AMP, 24 VA PILOT DUTY.
12. THE TRACER COMMUNICATION LINK IS FOR COMMUNICATION WITH VARIOUS TRACER BUILDING MANAGEMENT SYSTEM CONTROLLERS. WIRING MUST BE 18 AWG TWISTED, SHIELDED PAIR. EACH CONDUCTOR MUST BE STRANDED, TINNED COPPER. THE WIRE CAPACITANCE BETWEEN CONDUCTORS (PICOFARADS PER FOOT) MUST BE IN ACCORDANCE WITH TABLE 1. MAXIMUM TOTAL WIRE LENGTH IS 5,000 FEET.
- 1.3. THE OPTIONAL 24 VDC POWER SUPPLY PROVIDES 24 VDC AT 100 MA MAXIMUM FOR USE WITH 4 TO 20 MA OR 0 TO 10 VDC TRANSMITTING SENSORS.
- 1.4. IN ADDITION TO POWERING THE PCM CARD AND THE OPTIONAL 24 VDC (100 MA) POWER SUPPLY, THE 24 VAC (75 VA) TRANSFORMER PROVIDES AN ADDITIONAL 35 VA TO POWER EXTERNAL BINARY OUTPUT LOAD RELAYS. A SEPARATE 1.5 AMP MAXIMUM FUSE MUST BE PROVIDED FOR THE EXTERNAL LOAD.
- 1.5. ANALOG INPUTS 4 THRU 6, ANALOG OUTPUTS 3 AND 4, BINARY INPUTS 3 AND 4, AND BINARY OUTPUTS 4 THRU 6 ARE ONLY AVAILABLE ON 20 POINT PCM'S.
16. ALL CUSTOMER CONNECTIONS ON THE PCM ARE #4 CAPTIVE SCREW TERMINALS WITH PRESSURE PLATES, SUITABLE FOR BARE WIRE TERMINATIONS.
17. NBLT DENTED NOT BY LAYNE TRANE.
- 1.8. NOT CONNECTING GREEN GROUND WIRE WILL CAUSE ERRATIC PCM OPERATION.

TABLE 1 - COMMUNICATION LINK WIRING

MAXIMUM COMMUNICATION LINK WIRE LENGTH (FEET)	MAXIMUM CAPACITANCE BETWEEN CONDUCTORS (PICOFARADS/FOOT)
1,000	60
2,000	50
3,000	40
4,000	30
5,000	25

CAUTION
USE COPPER CONDUCTORS ONLY TO PREVENT EQUIPMENT DAMAGE. UNIT TERMINALS ARE NOT DESIGNED TO ACCEPT ANY OTHER WIRING.

ATTENTION
UTILISER SEULEMENT DES CONDUCTEURS EN CUIVRE POUR EVITER D'ENDOMMAGER L'EQUIPEMENT. LES BORNES NE SONT PAS PREVUES POUR AUTRES TYPES DE FILS CONDUCTEURS.

WARNING
DISCONNECT ELECTRIC POWER SUPPLY BEFORE SERVICING TO PREVENT INJURY OR DEATH DUE TO ELECTRICAL SHOCK.

AVERTISSEMENT
DEBRANCHER DU CIRCUIT D'ALIMENTATION ELECTRIQUE AVANT L'ENTRETIEN POUR EVITER BLESSURE OU MORT PAR ELECTROCUTION.

LEGEND

— INDICATES FACTORY WIRING
- - - INDICATES FIELD WIRING

THE DOCUMENTATION HEREIN IS THE EXCLUSIVE PROPERTY OF LAYNE TRANE, CHARLOTTE, N.C. REPRODUCTION AND/OR DISTRIBUTION TO OTHER THAN AUTHORIZED PARTIES IS PROHIBITED.

TRANE
LAYNE TRANE
801 PRESSLEY RD
CHARLOTTE, N.C. 28217
704 525 3155


REFERENCE DRAWING	NO.	REVISION-LOCATION	DATE	BY

SALES ENGR. CCR PROJ. MGR. CVF APPL. ENGR. CVF DRAWN BY. DPC DATE: 4/2/98

PROJECT NAME: UNCC-McEniry, Charlotte, North Carolina

CONTRACT NUMBER: ICS-98014

DRAWING NUMBER: SHEET 3 OF 51

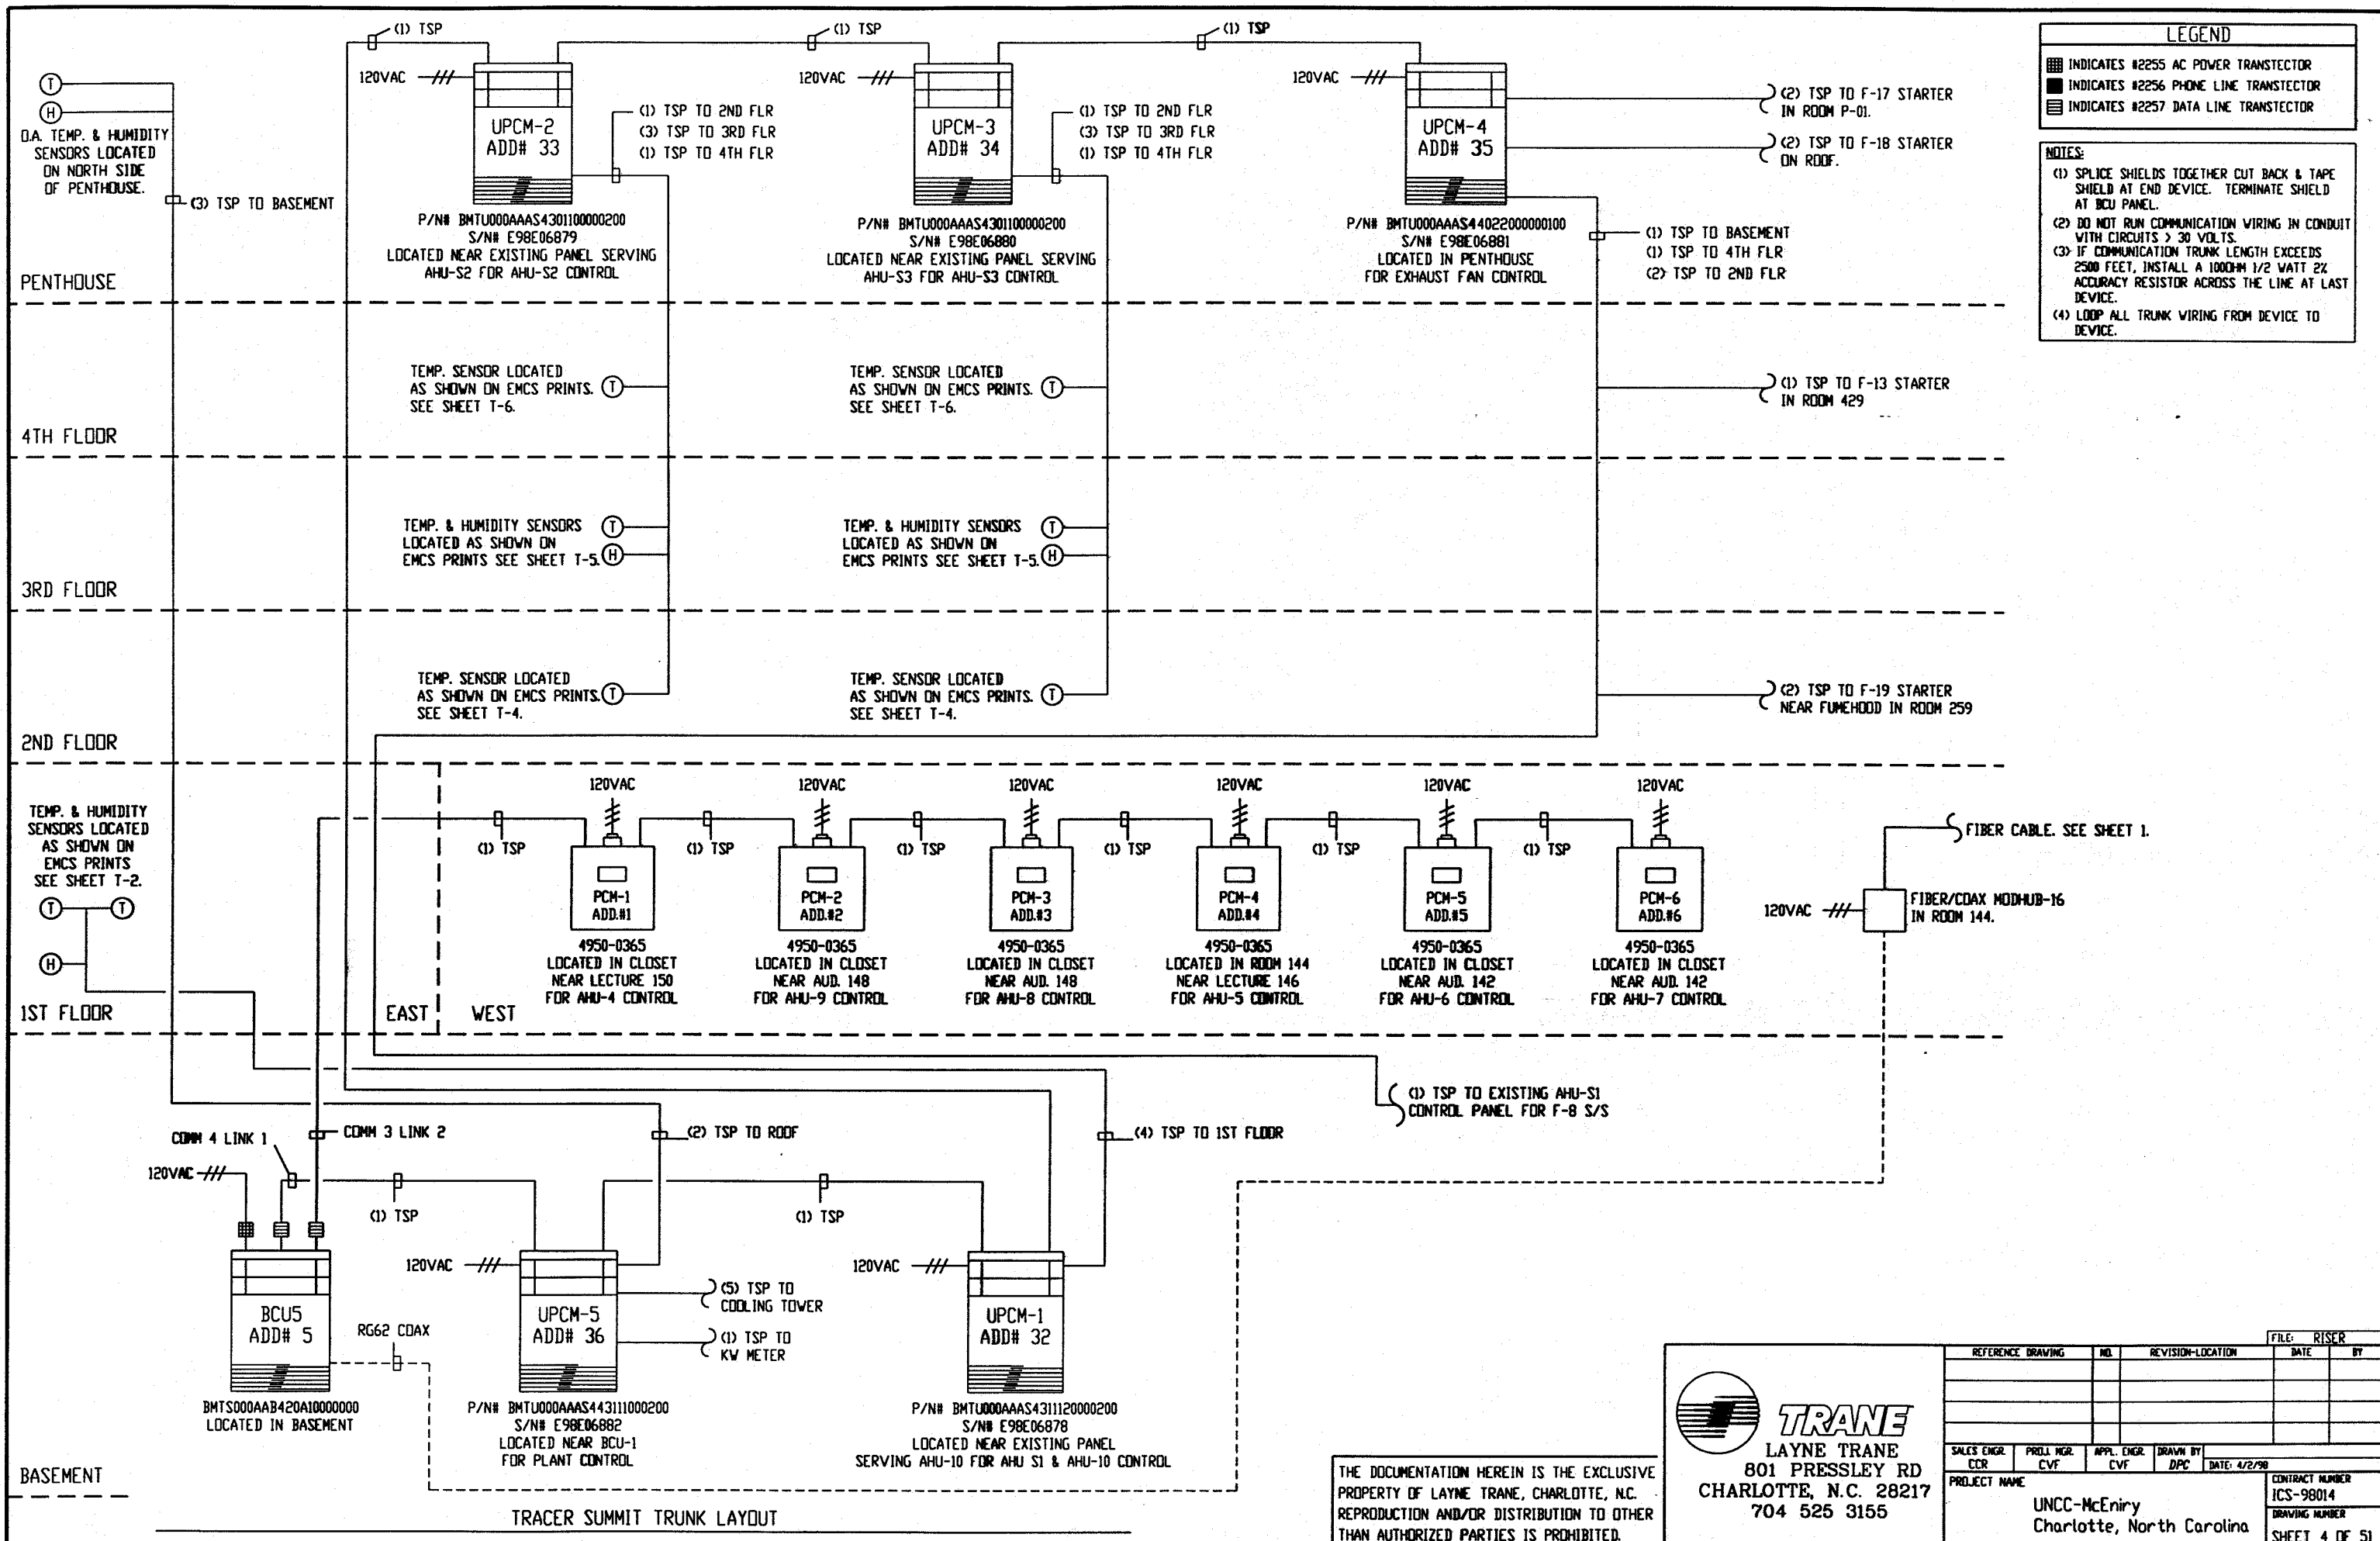

LEGEND	
	INDICATES #2255 AC POWER TRANSECTOR
	INDICATES #2256 PHONE LINE TRANSECTOR
	INDICATES #2257 DATA LINE TRANSECTOR

- NOTES:**
- (1) SPLICE SHIELDS TOGETHER CUT BACK & TAPE SHIELD AT END DEVICE. TERMINATE SHIELD AT BCU PANEL.
 - (2) DO NOT RUN COMMUNICATION WIRING IN CONDUIT WITH CIRCUITS > 30 VOLTS.
 - (3) IF COMMUNICATION TRUNK LENGTH EXCEEDS 2500 FEET, INSTALL A 100OHM 1/2 WATT 2% ACCURACY RESISTOR ACROSS THE LINE AT LAST DEVICE.
 - (4) LOOP ALL TRUNK WIRING FROM DEVICE TO DEVICE.


REFERENCE DRAWING	NO.	REVISION-LOCATION	DATE	BY

SALES ENGR. ECR	PROJ. MGR. CVF	APPL. ENGR. CVF	DRAWN BY DPC	DATE: 4/2/98
PROJECT NAME				CONTRACT NUMBER
UNCC-McEniry				ICS-98014
Charlotte, North Carolina				DRAWING NUMBER
				SHEET 4 OF 51

TRANE
 LAYNE TRANE
 801 PRESSLEY RD
 CHARLOTTE, N.C. 28217
 704 525 3155

THE DOCUMENTATION HEREIN IS THE EXCLUSIVE PROPERTY OF LAYNE TRANE, CHARLOTTE, N.C. REPRODUCTION AND/OR DISTRIBUTION TO OTHER THAN AUTHORIZED PARTIES IS PROHIBITED.

TRACER SUMMIT TRUNK LAYOUT

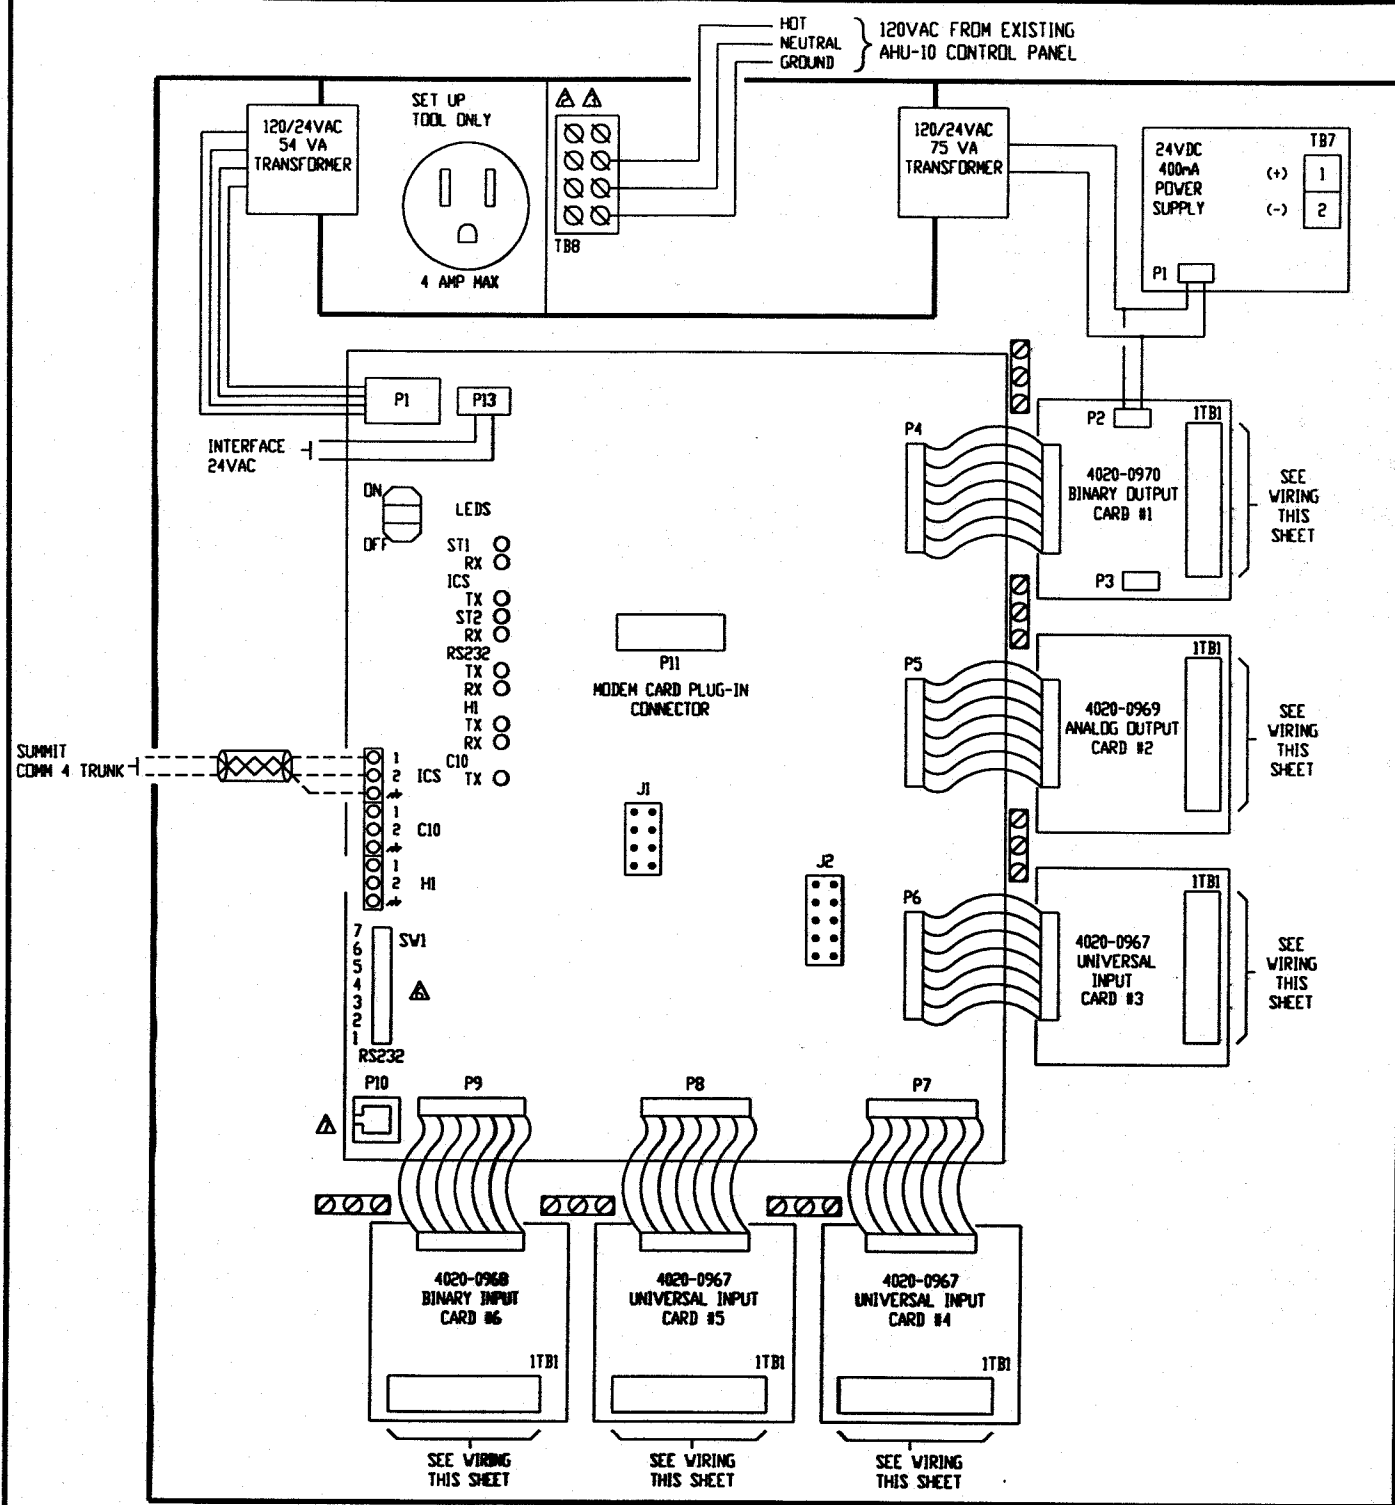


WIRING DIAGRAM NOTES.

- COMPONENTS AND WIRING SHOWN DASHED ARE FURNISHED AND FIELD INSTALLED.
- ALL WIRING MUST BE IN ACCORDANCE WITH NATIONAL ELECTRIC CODES AND LOCAL CODES. GREEN WIRE GROUND MUST BE CONTINUOUS BACK TO CIRCUIT BREAKER PANEL.
- USE COPPER CONDUCTORS ONLY.
- THE OPTIONAL 24 VAC, 75 VA TRANSFORMER PROVIDES 53 VA FOR BINARY OUTPUT TRIACS AND 22 VA TO THE 24VDC @ 400mA POWER SUPPLY.
- THE OPTIONAL POWER SUPPLY PROVIDES 24VDC AT 400mA MAXIMUM FOR USE WITH 4 TO 20mA OR 0-10VDC TRANSMITTING SENSORS
- SWITCH SW1 CONFIGURES UPCM ADDRESS. REFER TO INSTALLATION MANUAL FOR ADDRESS SETUP.
- POSITION P10 IS AN RJ-12 PLUG FOR RS-232 CONNECTION. REFER TO INSTALLATION MANUAL FOR INFORMATION ON REQUIRED CABLES AND ADAPTERS.
- BINARY OUTPUTS ARE TRIAC, 24VAC, RATED 12 VA MAX EACH.
- ANALOG OUTPUTS ARE 0-20mA MAX. 0-10 VDC.
- UNIVERSAL INPUTS CAN BE INDIVIDUALLY CONFIGURED FOR EITHER ANALOG INPUTS (AIP) OR BINARY INPUT (BIP).


UPCM-1 AHU-S1 & AHU-10

BMTU000AAAS431112000200
S/N# E98E06878


- ANALOG INPUT (AIP) WIRING MUST BE SHIELDED, TWISTED PAIR. EACH CONDUCTOR MUST BE STRANDED, TINNED COPPER. RECOMMENDED SIZE IS 18-22 GAUGE AT SENSOR. SHIELD MUST BE CUT BACK AND TAPED. MAXIMUM ANALOG INPUT WIRING DISTANCE IS 300 FT (91 M). ANALOG INPUTS CAN BE THERMISTOR, RTD, 4-20mA OR 0-10VDC.
- BINARY INPUT (BIP) WIRING MUST BE SHIELDED, TWISTED PAIR. EACH CONDUCTOR MUST BE STRANDED, TINNED COPPER. RECOMMENDED SIZE IS 18-22 GAUGE AT SENSOR. SHIELD MUST BE CUT BACK AND TAPED. MAXIMUM BINARY INPUT WIRING DISTANCE IS 1000FT. (305), BINARY INPUTS MUST BE ISOLATED, UNGROUNDED CONTACTS.

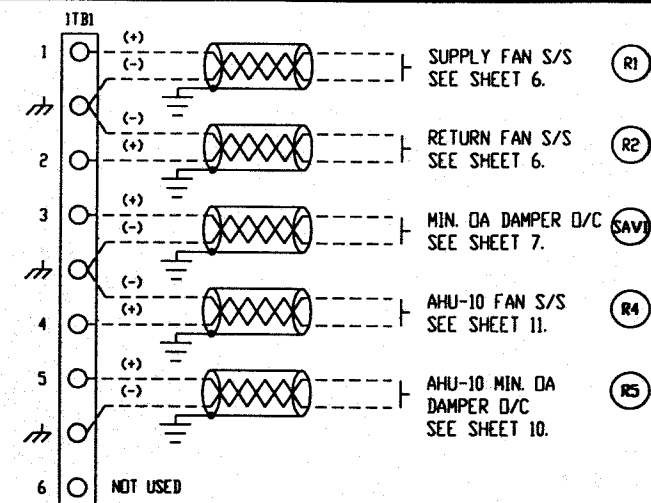


CARD #1 BINARY OUTPUT WIRING

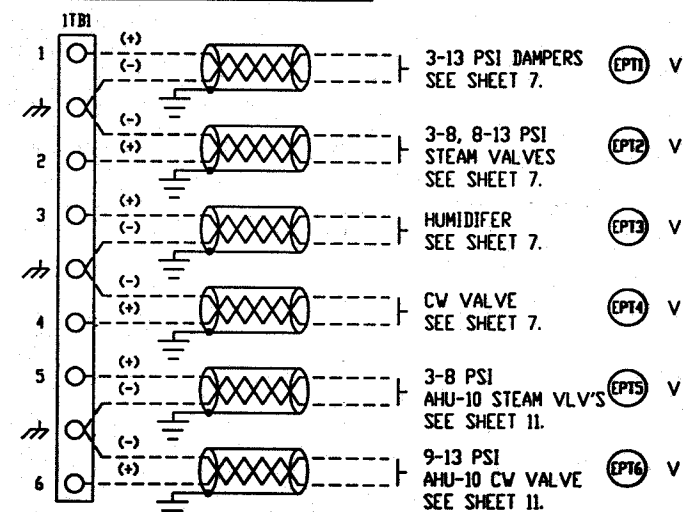


CARD #2 ANALOG OUTPUT WIRING

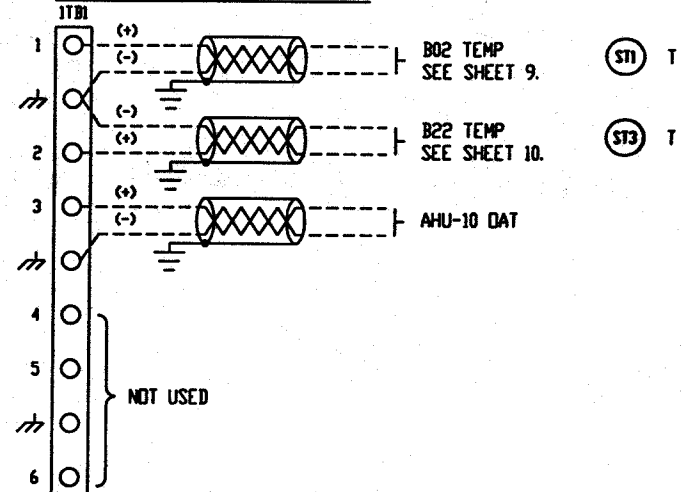


CARD #3 UNIVERSAL INPUT WIRING

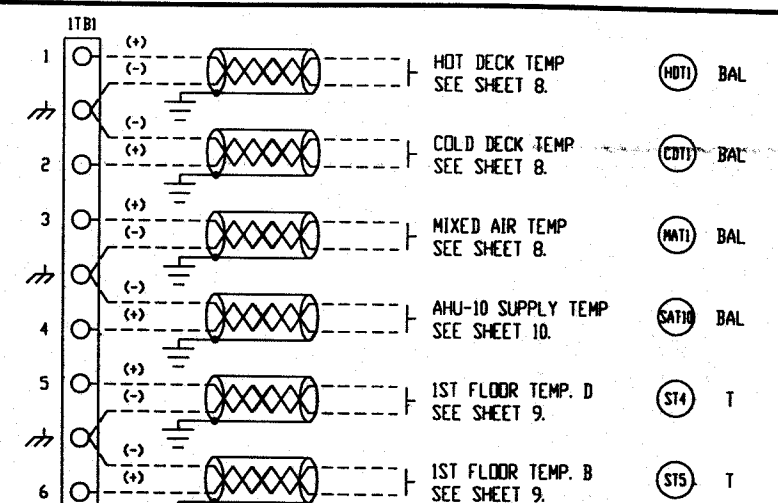

CARD #4 UNIVERSAL INPUT WIRING

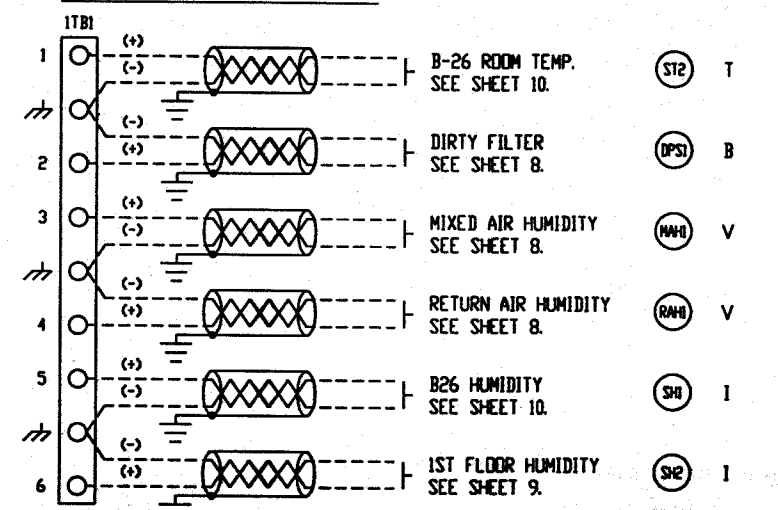



CARD #5 UNIVERSAL INPUT WIRING

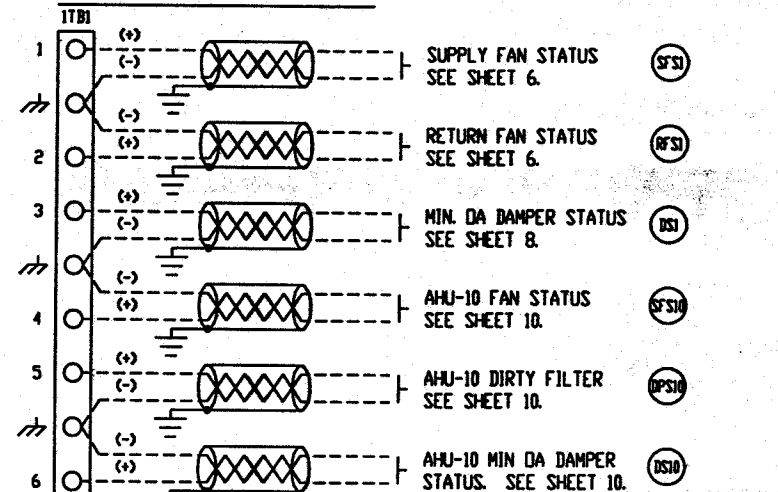






CARD #6 BINARY INPUT WIRING

THE DOCUMENTATION HEREIN IS THE EXCLUSIVE PROPERTY OF LAYNE TRANE, CHARLOTTE, N.C. REPRODUCTION AND/OR DISTRIBUTION TO OTHER THAN AUTHORIZED PARTIES IS PROHIBITED.

<p>LAYNE TRANE 801 PRESSLEY RD CHARLOTTE, N.C. 28217 704 525 3155</p>		REFERENCE DRAWING		NO.	REVISION-LOCATION	DATE	BY
		SALES ENGR. ECR		PREL. MGR. CVF	APPL. ENGR. CVF	DRAWN BY DPC	DATE: 4/2/90
PROJECT NAME		UNCC-McEniry Charlotte, North Carolina		CONTRACT NUMBER ICS-98014		DRAWING NUMBER SHEET 5 OF 51	

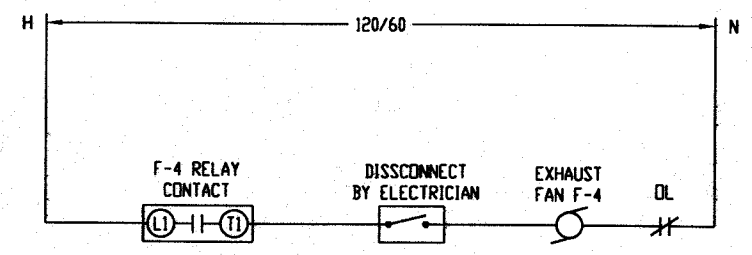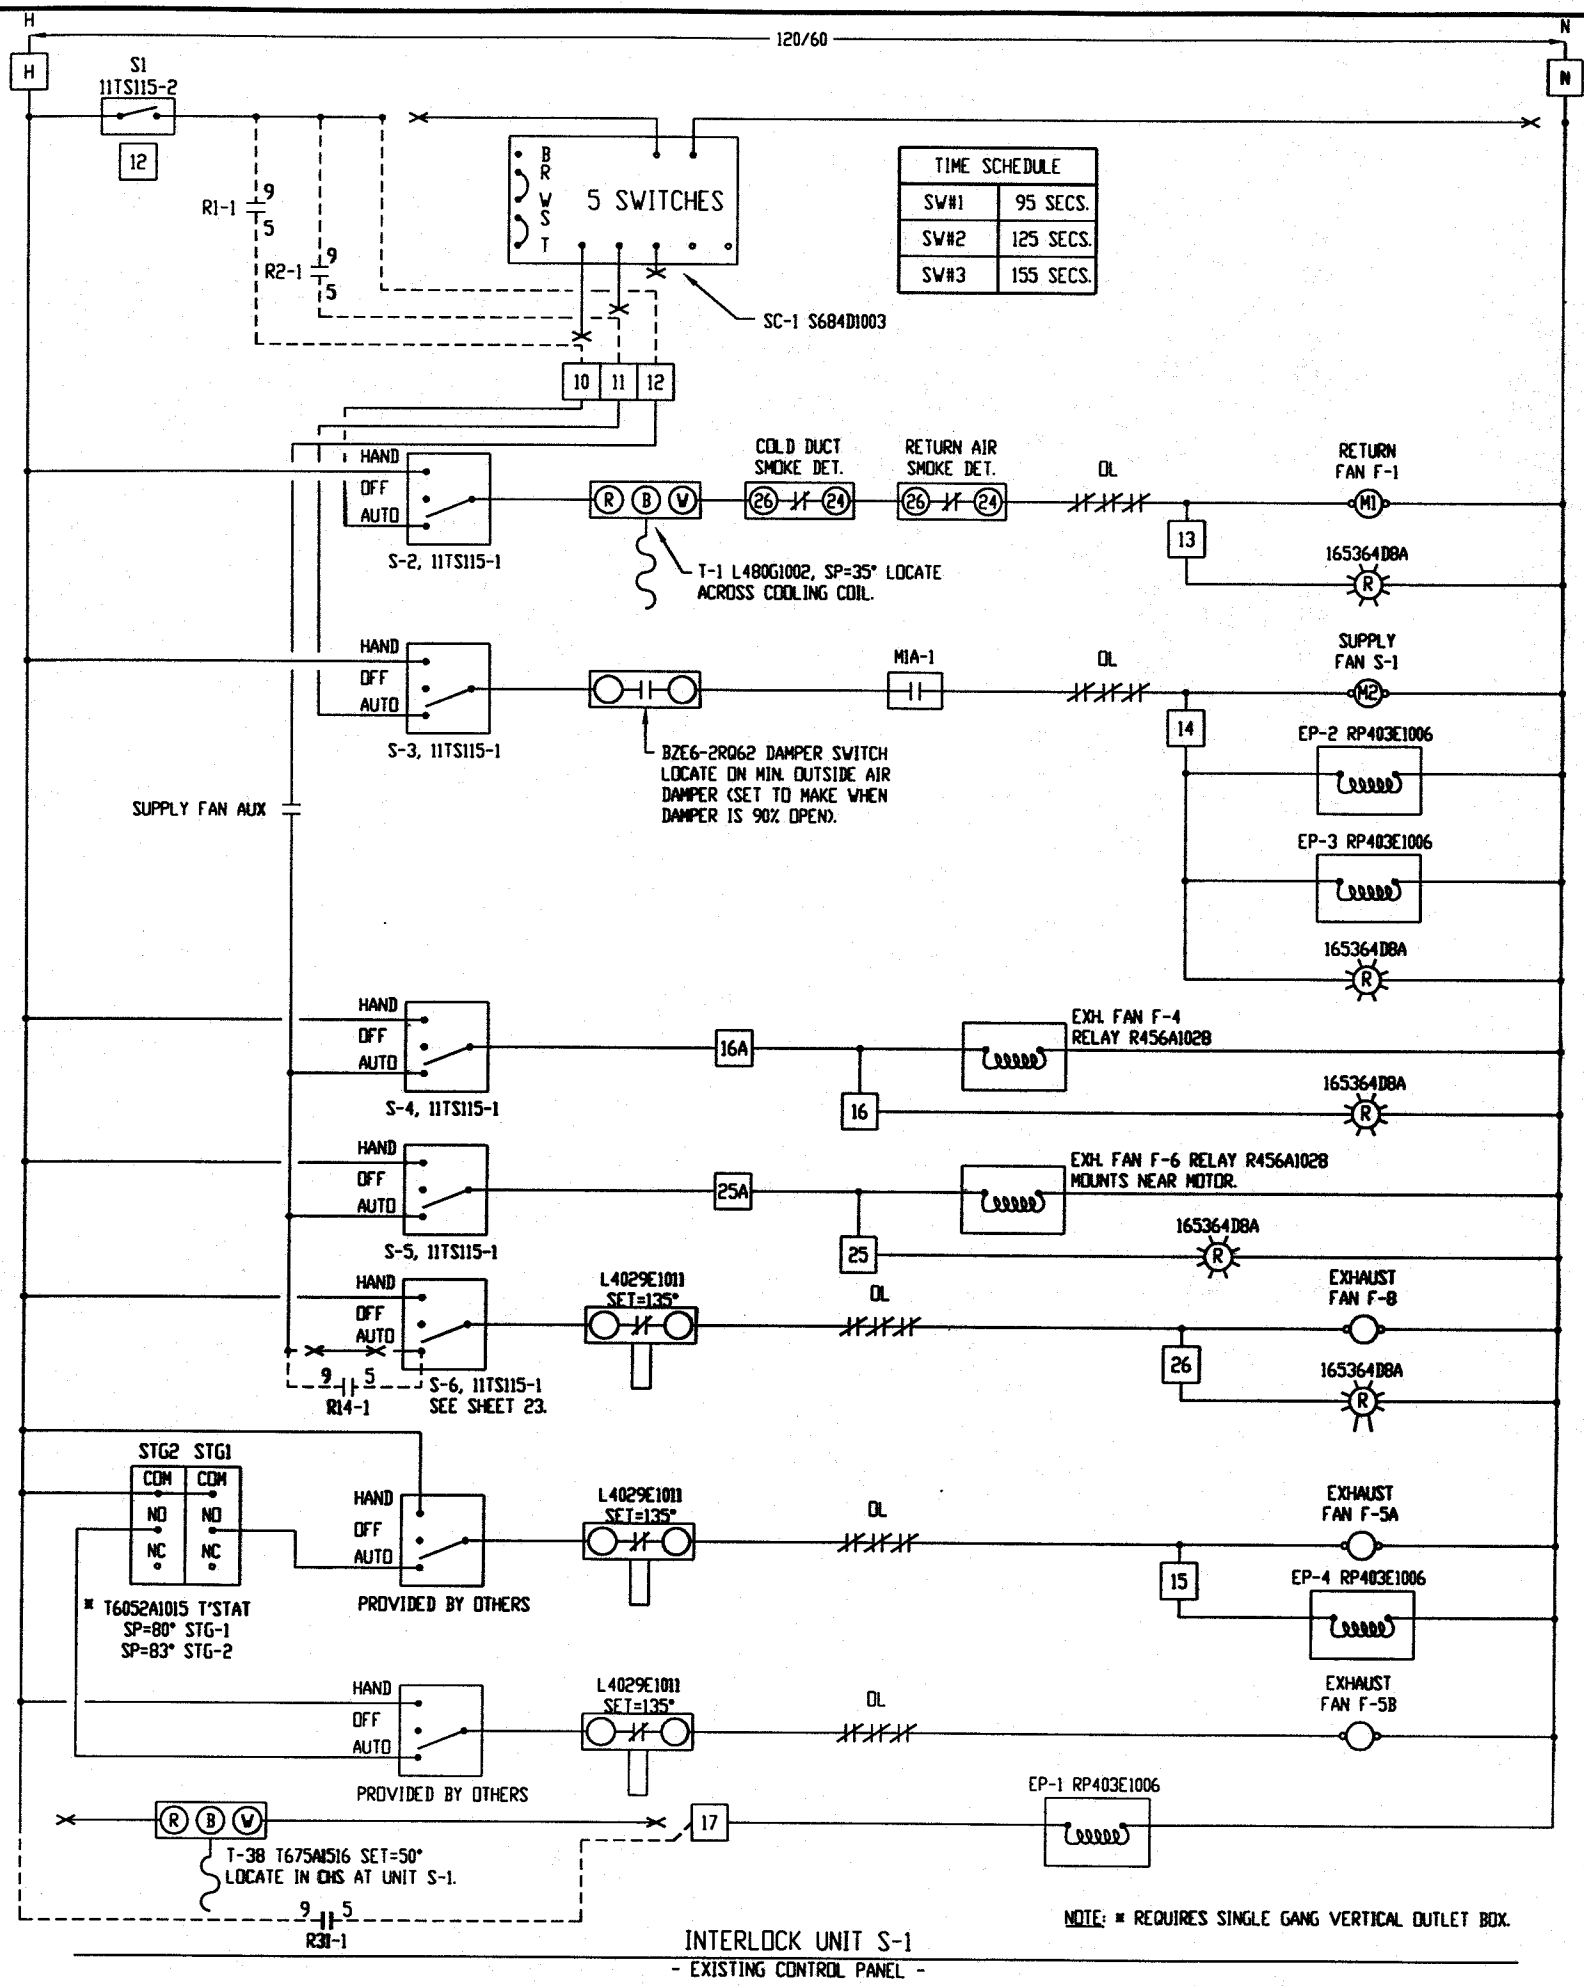

EXHAUST FAN F-4 WIRING

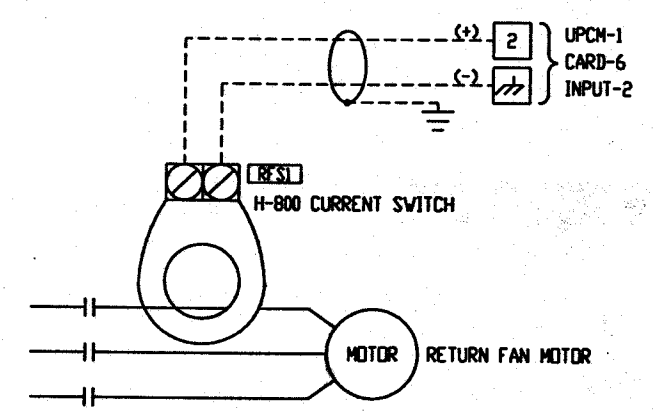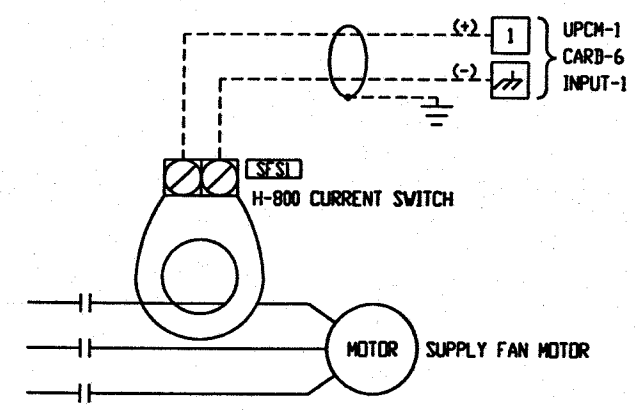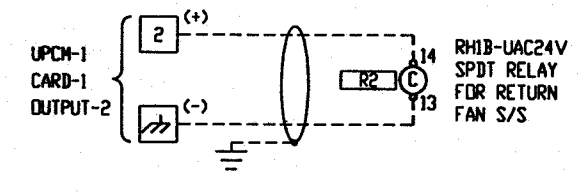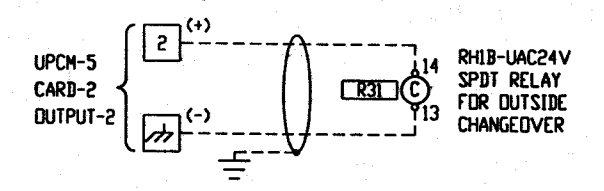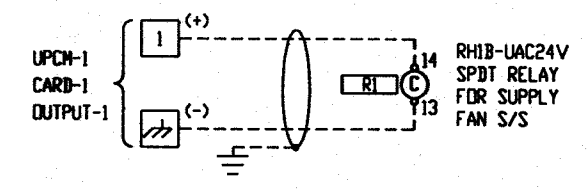

SUPPLY & RETURN FAN S/S & STATUS

LEGEND

- THIS COLOR IS INDICATING EXISTING, TO REMAIN AS IS.
- THIS COLOR IS INDICATING TO BE REMOVED.
- THIS COLOR IS INDICATING TO BE ABANDONED IN PLACE.
- THIS COLOR IS INDICATING NEW TO BE ADDED.
- (M) MAIN AIR
- * INDICATES GAUGE MOUNTED ON PANEL FACE.
- ⊕ CONNECT TO EXISTING

LEGEND


- INDICATES EXISTING WIRING
- - - INDICATES FIELD WIRING

THE DOCUMENTATION HEREIN IS THE EXCLUSIVE PROPERTY OF LAYNE TRANE, CHARLOTTE, N.C. REPRODUCTION AND/OR DISTRIBUTION TO OTHER THAN AUTHORIZED PARTIES IS PROHIBITED.

TRANE
 LAYNE TRANE
 801 PRESSLEY RD
 CHARLOTTE, N.C. 28217
 704 525 3155

REFERENCE DRAWING	NO.	REVISION-LOCATION	DATE	BY

SALES ENGR. CLR	PROJ. MGR. CVT	APPL. ENGR. CVT	DRAWN BY DPC	DATE: 4/7/98
PROJECT NAME				CONTRACT NUMBER
UNCC-McEniry				ICS-98014
Charlotte, North Carolina				DRAWING NUMBER
				SHEET 6 OF 51

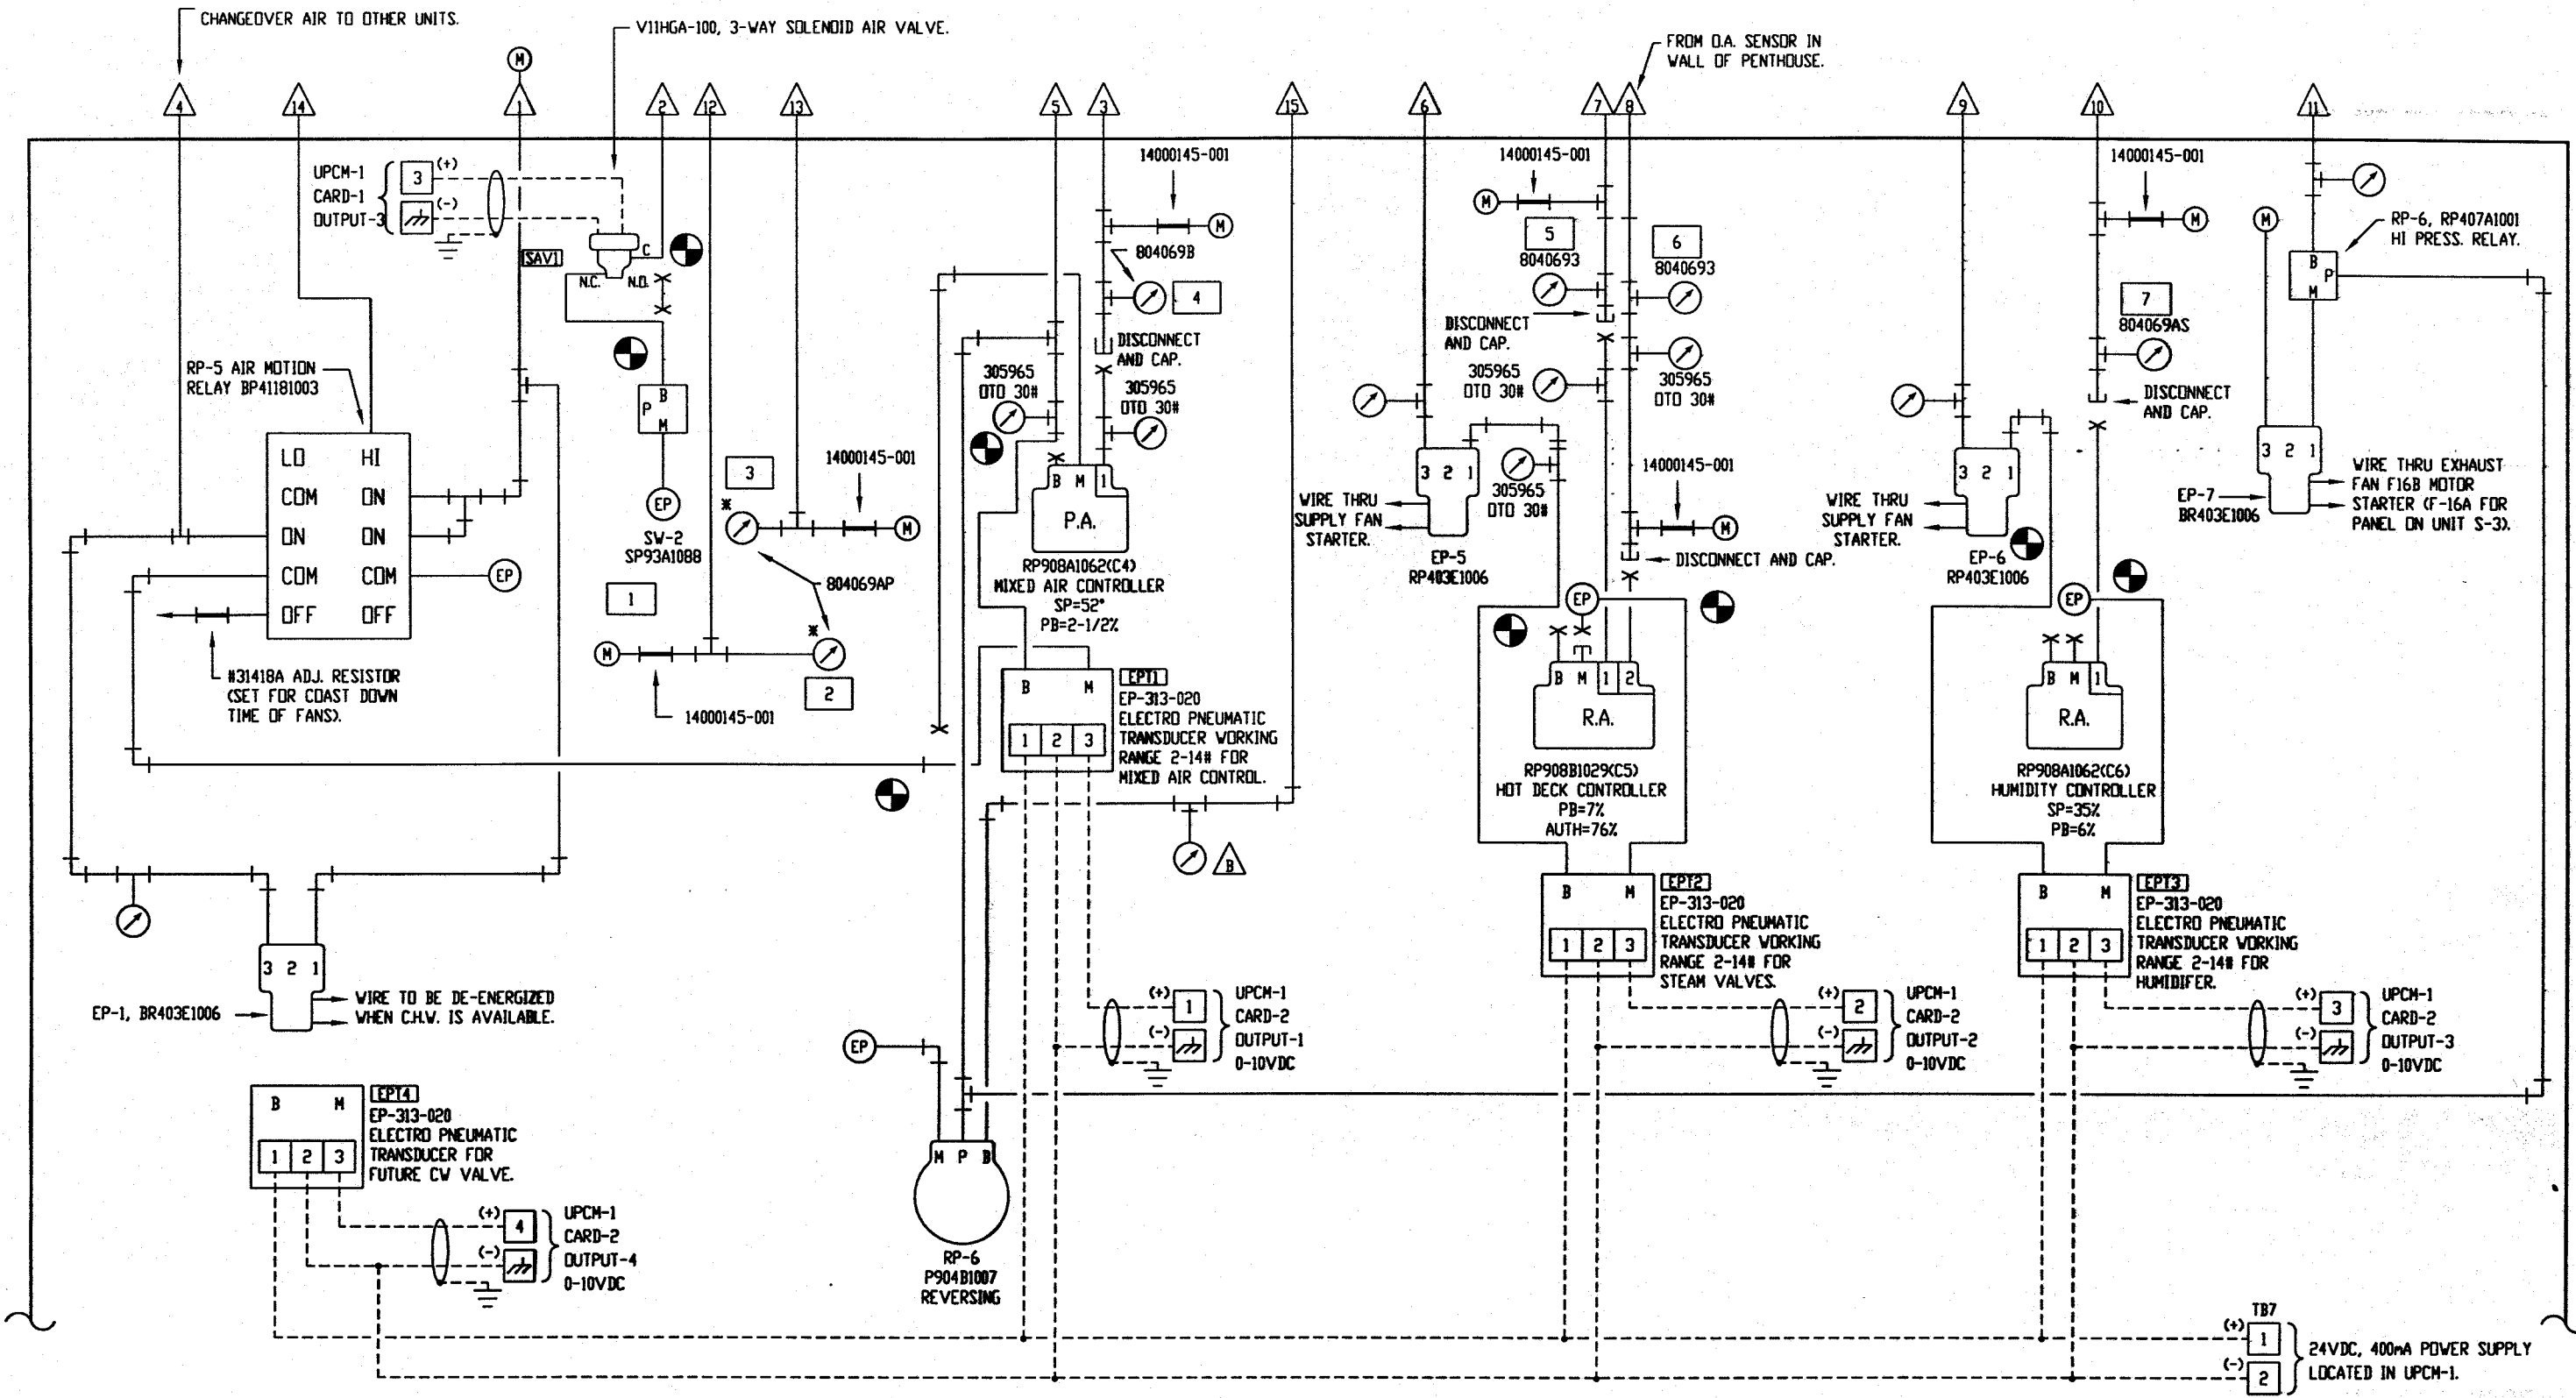

AHU-S1 PANEL PNEUMATIC SCHEMATIC

- EXISTING CONTROL PANEL -

LEGEND

- THIS COLOR IS INDICATING EXISTING, TO REMAIN AS IS.
- THIS COLOR IS INDICATING TO BE REMOVED.
- THIS COLOR IS INDICATING TO BE ABANDONED IN PLACE.
- THIS COLOR IS INDICATING NEW TO BE ADDED.
- (M) MAIN AIR
- * INDICATES GAUGE MOUNTED ON PANEL FACE.
- CONNECT TO EXISTING

- 1 MIN. OA DAMPER POSITION
- 2 COLD DECK DISCHARGE TEMP.
- 3 RETURN AIR TEMP.
- 4 MIXED AIR TEMP.
- 5 HOT DECK DISCHARGE TEMP.
- 6 OUTSIDE AIR TEMP.
- 7 RETURN AIR TEMP.

LEGEND

- INDICATES EXISTING WIRING
- - - INDICATES FIELD WIRING

THE DOCUMENTATION HEREIN IS THE EXCLUSIVE PROPERTY OF LAYNE TRANE, CHARLOTTE, N.C. REPRODUCTION AND/OR DISTRIBUTION TO OTHER THAN AUTHORIZED PARTIES IS PROHIBITED.


TRANE
 LAYNE TRANE
 801 PRESSLEY RD
 CHARLOTTE, N.C. 28217
 704 525 3155

REFERENCE DRAWING	NO.	REVISION-LOCATION	DATE	BY

FILE: AHU-P

SALES ENGR. CCR	PROJ. MGR. CVF	APPL. ENGR. CVF	DRAWN BY. DPC	DATE: 4/2/98
PROJECT NAME				CONTRACT NUMBER
UNCC-McEniry				ICS-98014
Charlotte, North Carolina				DRAWING NUMBER
				SHEET 7 OF 51

NOTE: ALL PRESSURE GAUGES 305909, 0 TO 30# RANGE EXCEPT AS NOTED.

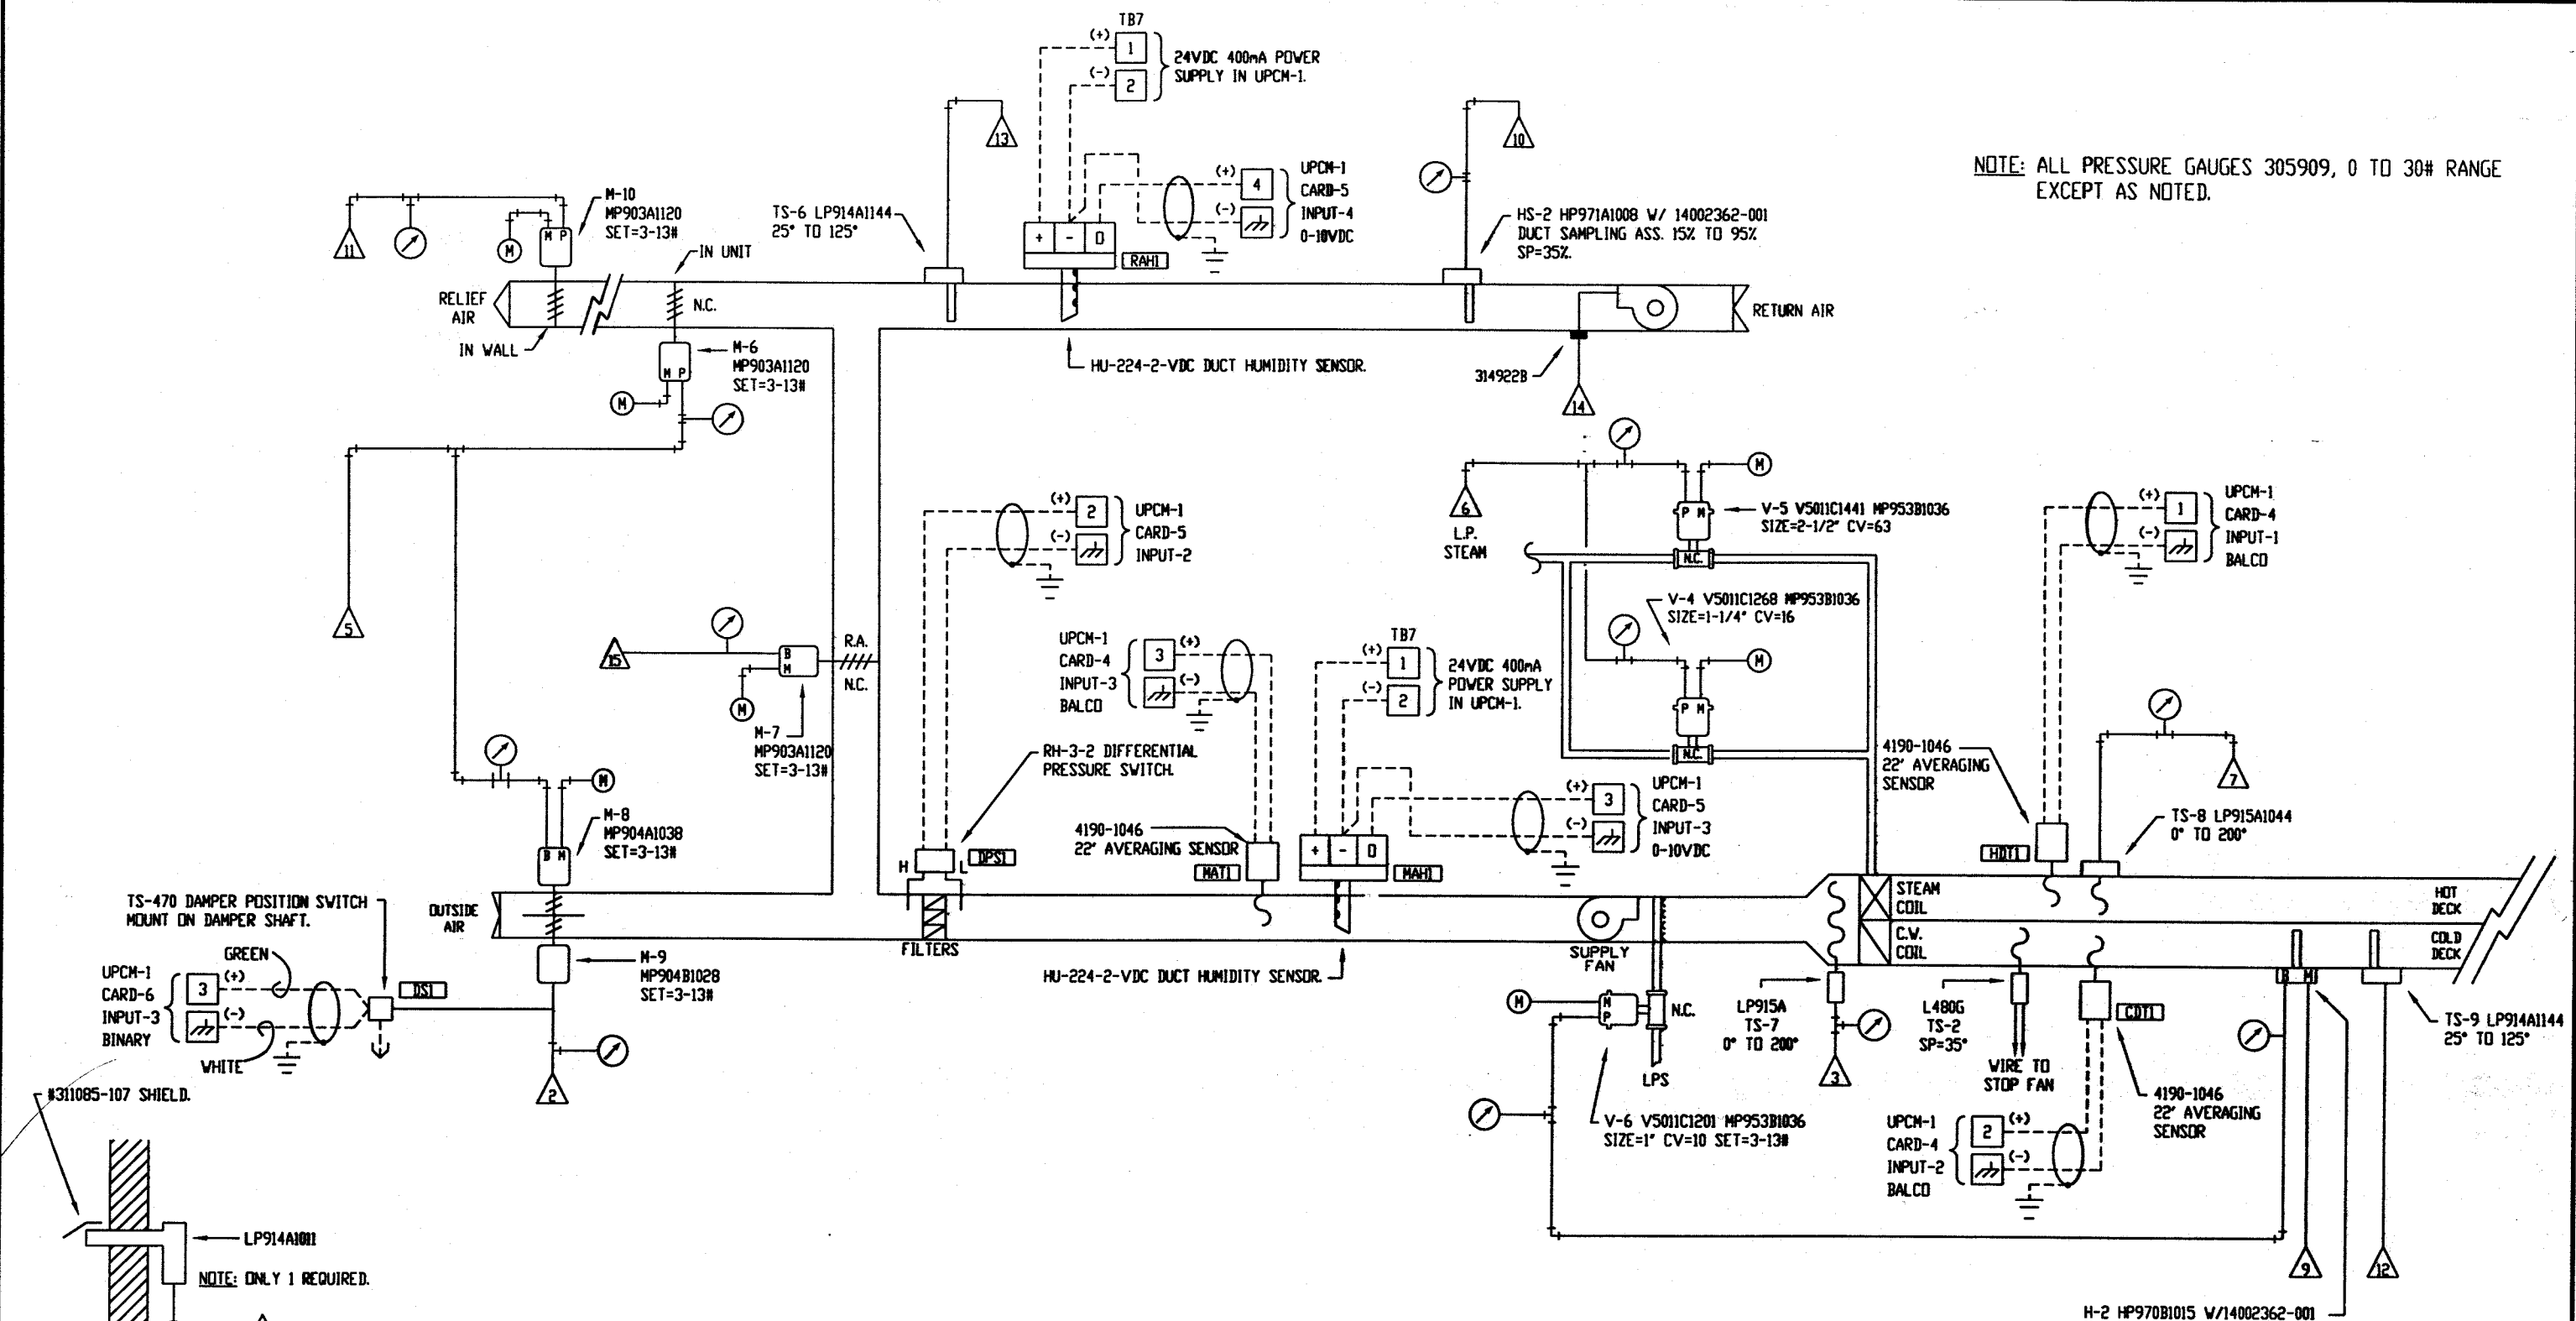

AHU-S1 AIR FLOW SCHEMATIC

H-2 HP970B1015 W/14002362-001
DUCT SAMPLING ASS. 65% TO 95%
SP=90%.


LEGEND	
■	THIS COLOR IS INDICATING EXISTING, TO REMAIN AS IS.
■	THIS COLOR IS INDICATING TO BE REMOVED.
■	THIS COLOR IS INDICATING TO BE ABANDONED IN PLACE.
■	THIS COLOR IS INDICATING NEW TO BE ADDED.
(M)	MAIN AIR
*	INDICATES GAUGE MOUNTED ON PANEL FACE.
⊕	CONNECT TO EXISTING

THE DOCUMENTATION HEREIN IS THE EXCLUSIVE PROPERTY OF LAYNE TRANE, CHARLOTTE, N.C. REPRODUCTION AND/OR DISTRIBUTION TO OTHER THAN AUTHORIZED PARTIES IS PROHIBITED.

LAYNE TRANE
801 PRESSLEY RD
CHARLOTTE, N.C. 28217
704 525 3155


REFERENCE DRAWING	NO.	REVISION-LOCATION	DATE	BY

SALES ENGR. CDR	PROJ. MGR. CVT	APPL. ENGR. CVT	DRAWN BY DPC	DATE: 4/2/98
PROJECT NAME: UNCC-McEniry Charlotte, North Carolina				CONTRACT NUMBER: ICS-98014
				DRAWING NUMBER: SHEET 8 OF 51

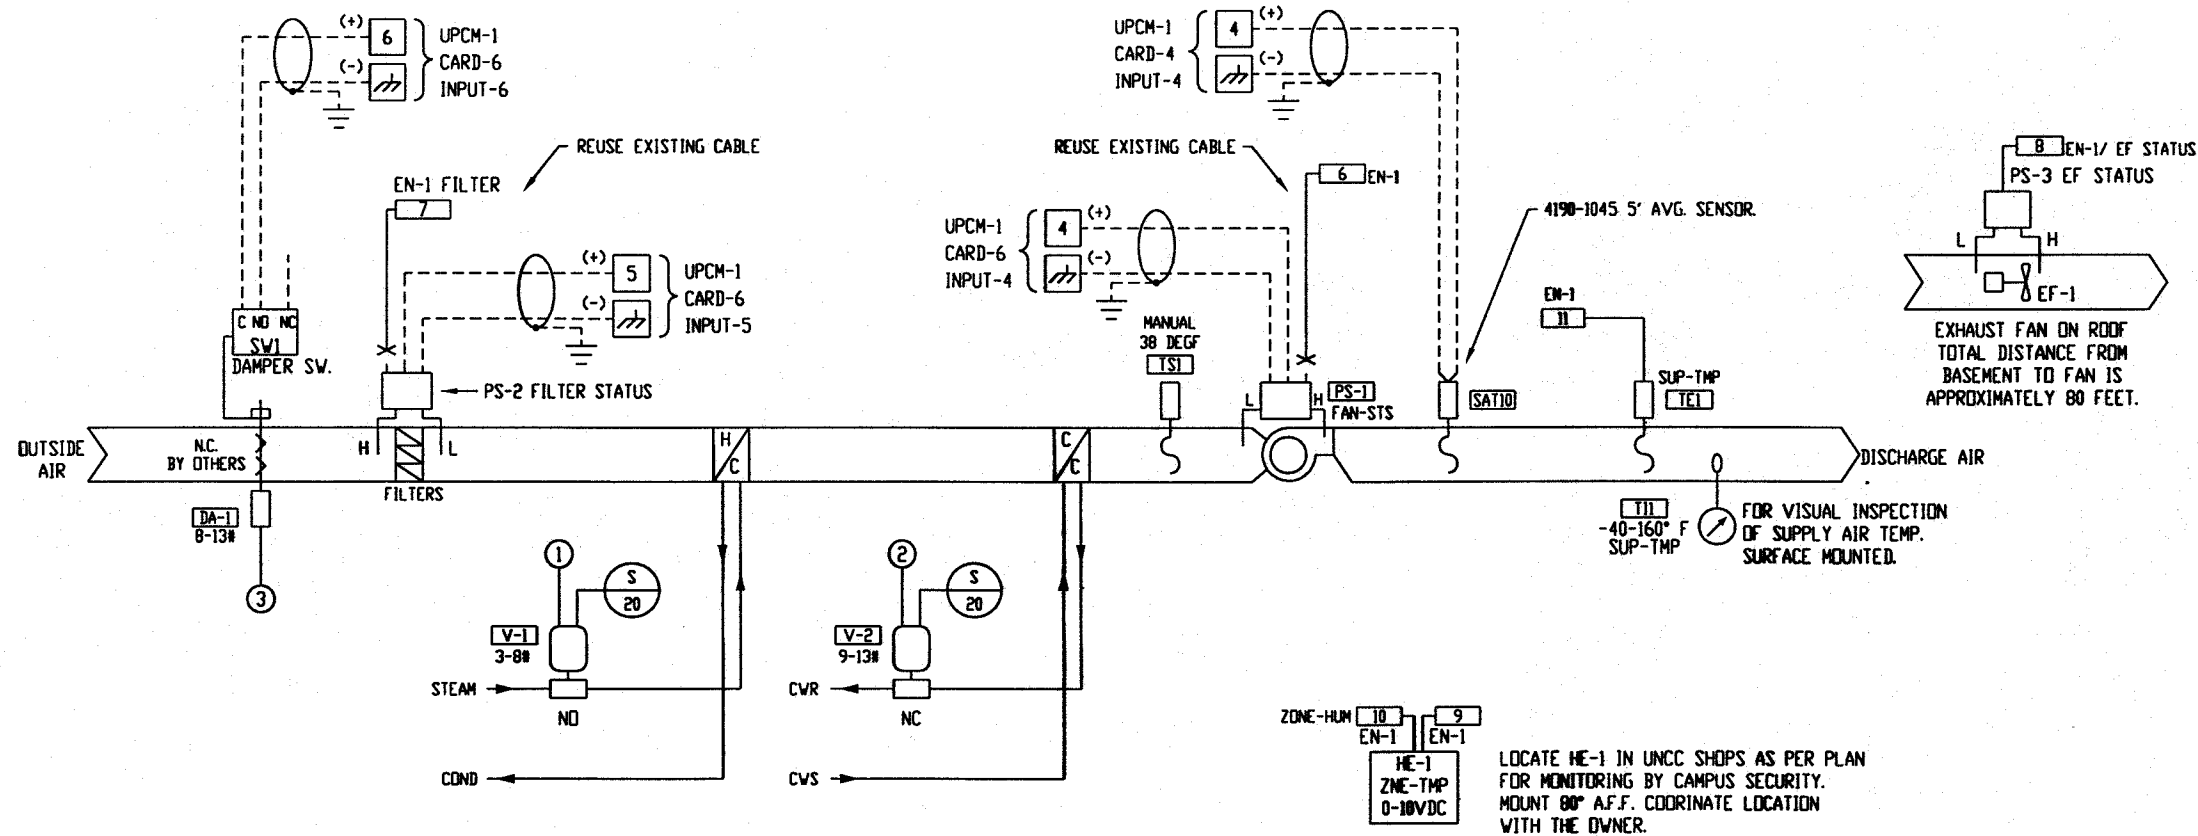


100% OUTSIDE AIR UNIT UNCC-McENIRY ANIMAL FACILITY



- AHU-10 -

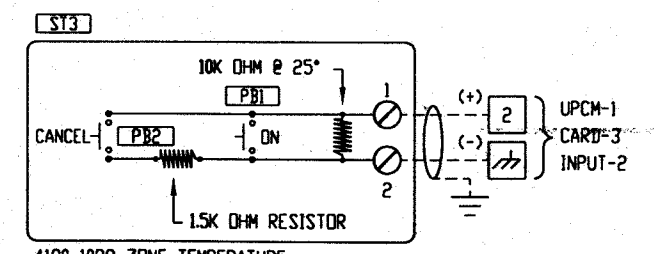


4190-1088 ZONE TEMPERATURE SENSOR LOCATED IN ROOM B22.

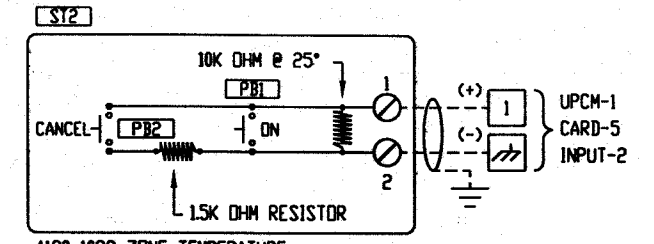


4190-1088 ZONE TEMPERATURE SENSOR LOCATED IN ROOM B26.

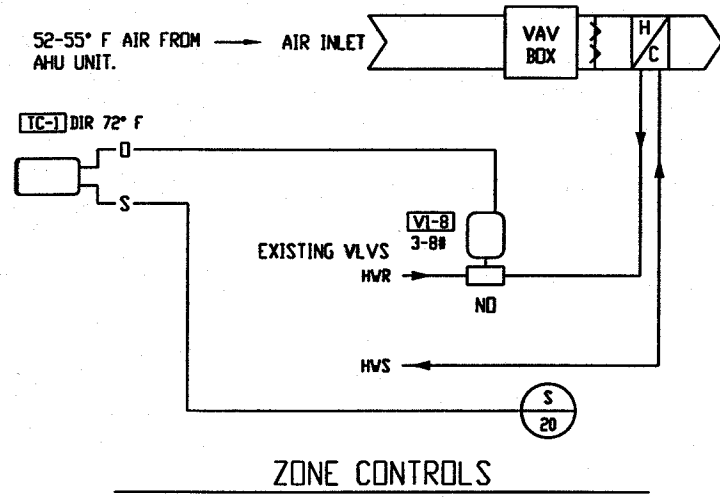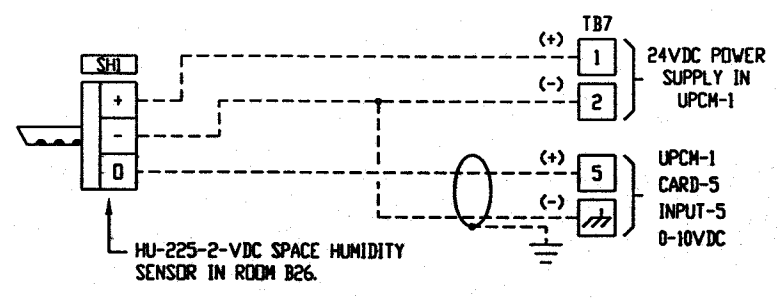

ZONE CONTROLS

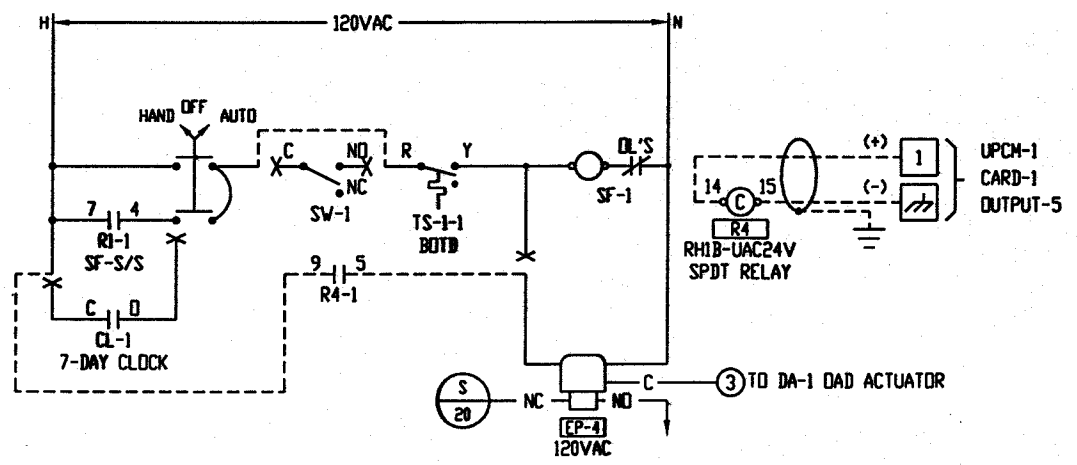

SF MOTOR CONTROL WIRING DETAIL

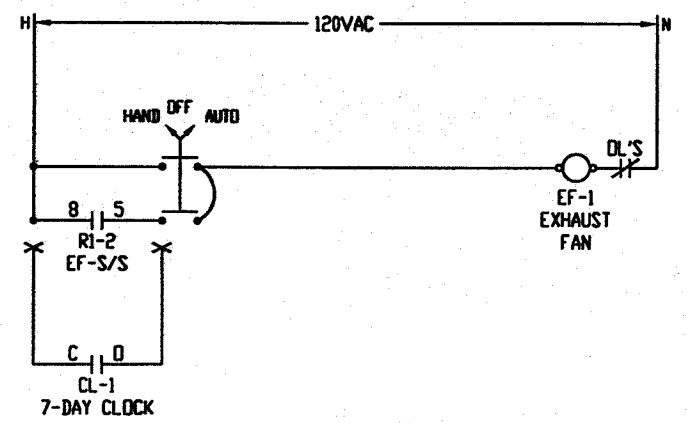

EF MOTOR CONTROL WIRING DETAIL

LEGEND

- THIS COLOR IS INDICATING EXISTING, TO REMAIN AS IS.
- THIS COLOR IS INDICATING TO BE REMOVED.
- THIS COLOR IS INDICATING TO BE ABANDONED IN PLACE.
- THIS COLOR IS INDICATING NEW TO BE ADDED.



MAIN AIR
 * INDICATES GAUGE MOUNTED ON PANEL FACE.
 CONNECT TO EXISTING

THE DOCUMENTATION HEREIN IS THE EXCLUSIVE PROPERTY OF LAYNE TRANE, CHARLOTTE, N.C. REPRODUCTION AND/OR DISTRIBUTION TO OTHER THAN AUTHORIZED PARTIES IS PROHIBITED.


LAYNE TRANE
 801 PRESSLEY RD
 CHARLOTTE, N.C. 28217
 704 525 3155

REFERENCE DRAWING	NO.	REVISION-LOCATION	DATE	BY

SALES ENGR. CCR	PROJ. MGR. CVF	APPL. ENGR. CVF	DRAWN BY DPC	DATE: 1/6/98
PROJECT NAME: UNCC-McEniry Charlotte, North Carolina				CONTRACT NUMBER: ICS-98014
DRAWING NUMBER: SHEET 10 OF 51				

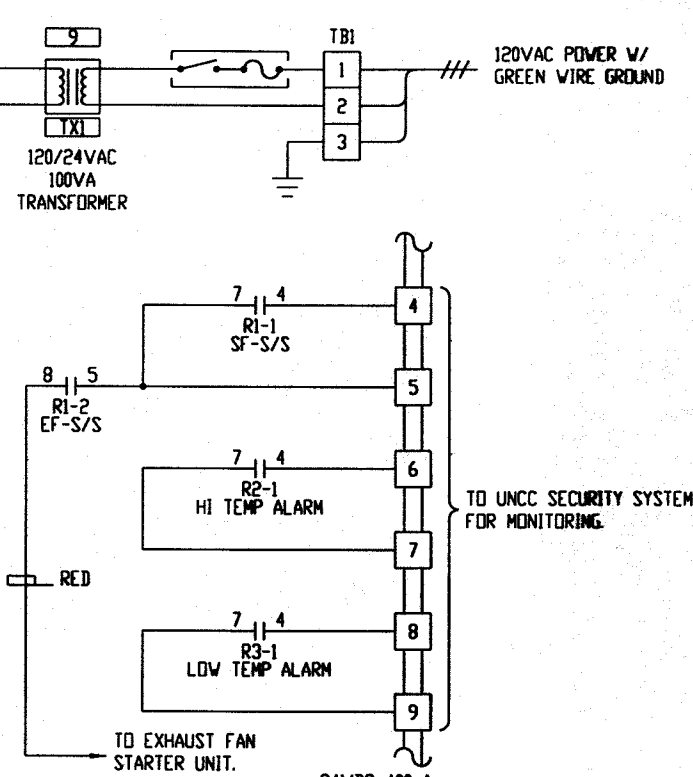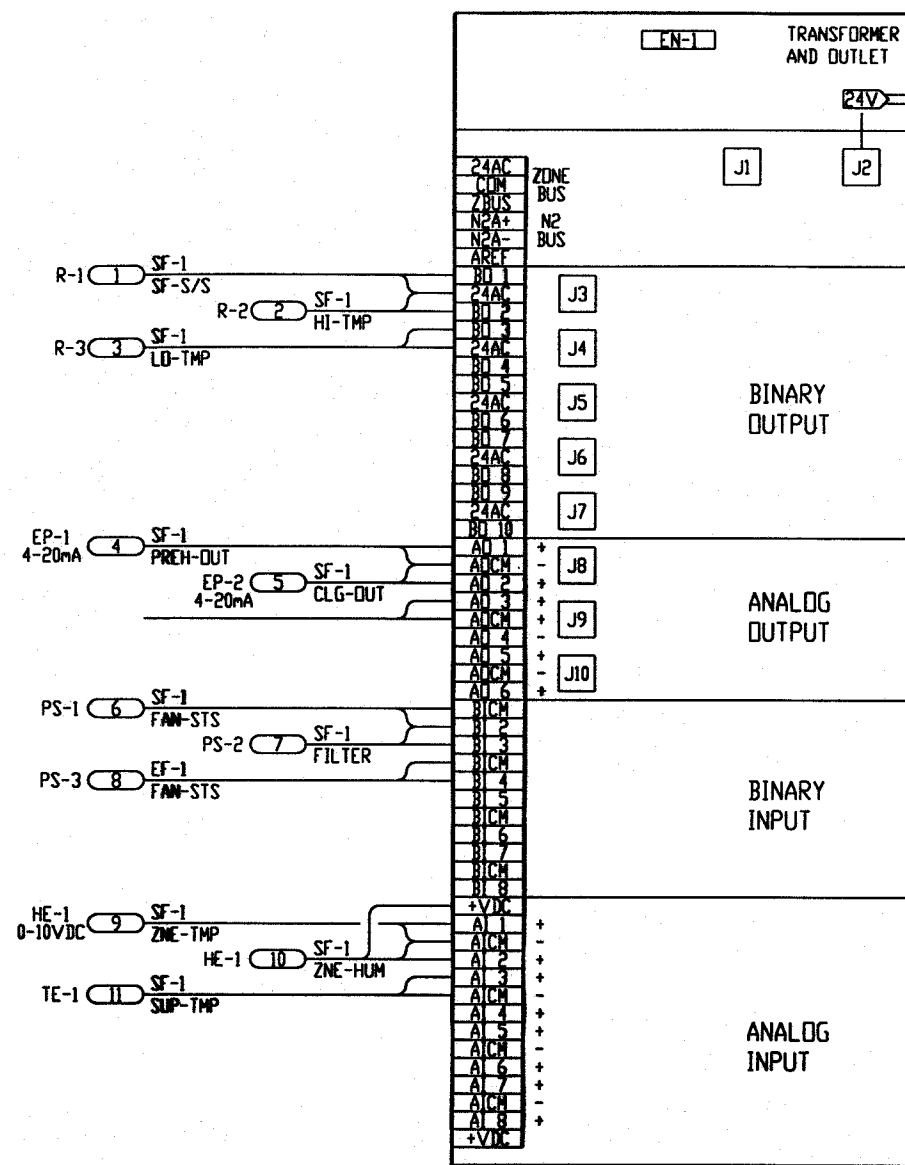


NAMETAG SCHEDULE		
ITEM	DEVICE TAG	DESCRIPTION
1	P-1	UNCC McENIRY ANIMAL FACILITY DDC AIR HANDLER CONTROL PANEL.
2	EN-1	AIR HANDLER DDC CONTROL UNIT.
3	EP-1	PNEUMATIC X-DUCER, 4-20mA 3-15# PSI, PREHEAT CONTROL
4	EP-2	PNEUMATIC X-DUCER, 4-20mA 3-15# PSI, COOLING VLV CONTROL
5	R-1	3PDT/ 24VAC RELAY AIR HANDLER S/S CONTROL
6	R-2	3PDT/ 24VAC RELAY HIGH ZONE TEMP. ALARM
7	R-3	3PDT/ 24VAC RELAY LOW ZONE TEMP. ALARM
8	TX-1	100VA, 120/24VAC TRANSFORMER
9	MS-1	PANEL POWER DISCONNECT WITH 5 AMP BUSS SSU FUSE.

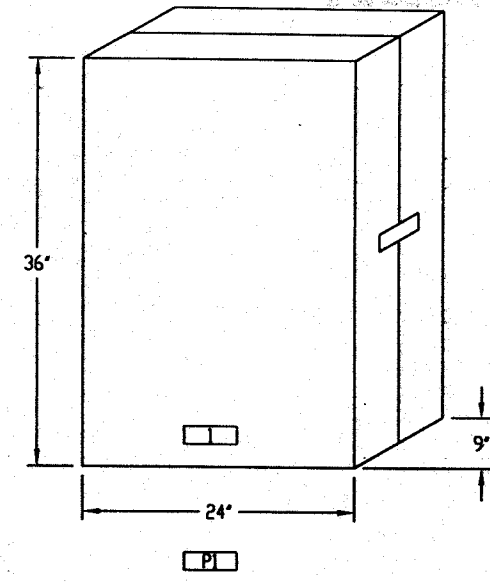


PANEL MATERIAL			
DEVICE TAG	QTY	CODE NUMBER	DESCRIPTION
ACC	10	M-8000-392	SCREW-ON LAMINATED NAME-
ACC	8	PD-113-3	TERMINAL BLOCK, MEDIUM
ACC	1	PD-113-3	TERMINAL BLOCK, MEDIUM
ACC	1	PD-113-4	END SECTION, F/PPD, 113-3
CL-1	1	C-7335-1	TIME SWITCH, 7-DAY
EN-1	1	AS-AHU101-0	AIR HANDLING UNIT ENC/TER
EN-1	1	AS-AHU102-0	AIR HANDLING LOGIC B
EP-1-EP-2	2	EP-8000-4	EP TRANSD, 4/20 MILLI-A H
EP-1-EP-2	2	A-4000-137	FILTER, OIL, IN-LINE
MS-1	1	PD-112-22	BUSS SSU FUSE HOLDER
MS-1	1	PD-112-23	FUSE T-5 (5AMP) FOR
P-1	1	M-8100-2436	CONTROL CABINET, STD. FACE
PI-1-PI-3	3	G-2010-5	AIR GAGE 1-1/2"
R-1-R-3	3	PD-109-21	RELAY, PLUG IN 3PDT
R-1-R-3	3	PD-101-35	RELAY SOCKET, 11 PIN BLADE
TX-1	1	Y64AL-2C	TRANSFORMER

LEGEND	
■	THIS COLOR IS INDICATING EXISTING, TO REMAIN AS IS.
■	THIS COLOR IS INDICATING TO BE REMOVED.
■	THIS COLOR IS INDICATING TO BE ABANDONED IN PLACE.
■	THIS COLOR IS INDICATING NEW TO BE ADDED.
(M)	MAIN AIR
*	INDICATES GAUGE MOUNTED ON PANEL FACE.
⊕	CONNECT TO EXISTING

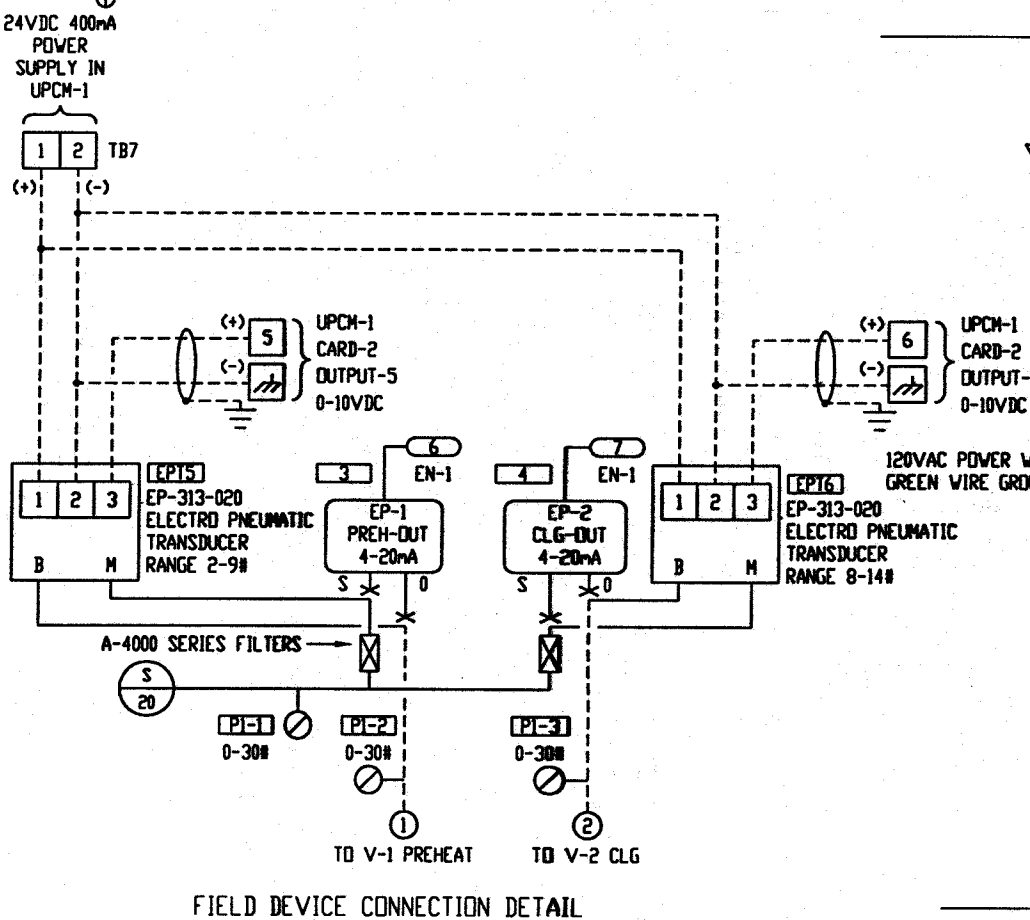

LEGEND	
—	INDICATES EXISTING WIRING
- - -	INDICATES FIELD WIRING

THE DOCUMENTATION HEREIN IS THE EXCLUSIVE PROPERTY OF LAYNE TRANE, CHARLOTTE, N.C. REPRODUCTION AND/OR DISTRIBUTION TO OTHER THAN AUTHORIZED PARTIES IS PROHIBITED.

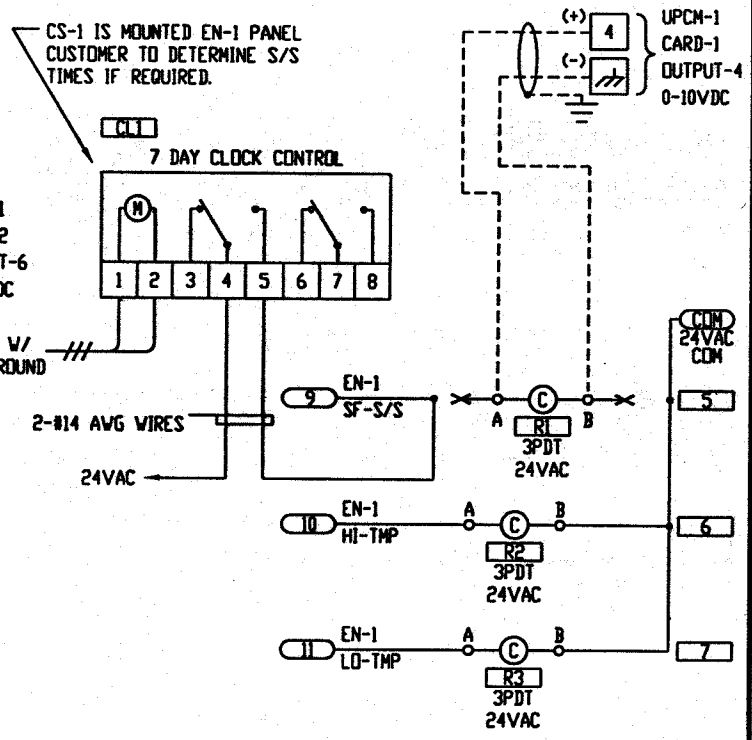

TRANE
LAYNE TRANE
801 PRESSLEY RD
CHARLOTTE, N.C. 28217
704 525 3155


REFERENCE DRAWING	NO.	REVISION-LOCATION	DATE	BY

SALES ENGR.	PROJ. MGR.	APPL. ENGR.	DRWN BY	DATE
CCR	CVF	CVF	DPC	4/6/90

PROJECT NAME: UNCC-McEniry, Charlotte, North Carolina

CONTRACT NUMBER: ICS-98014

DRAWING NUMBER: SHEET 11 OF 51

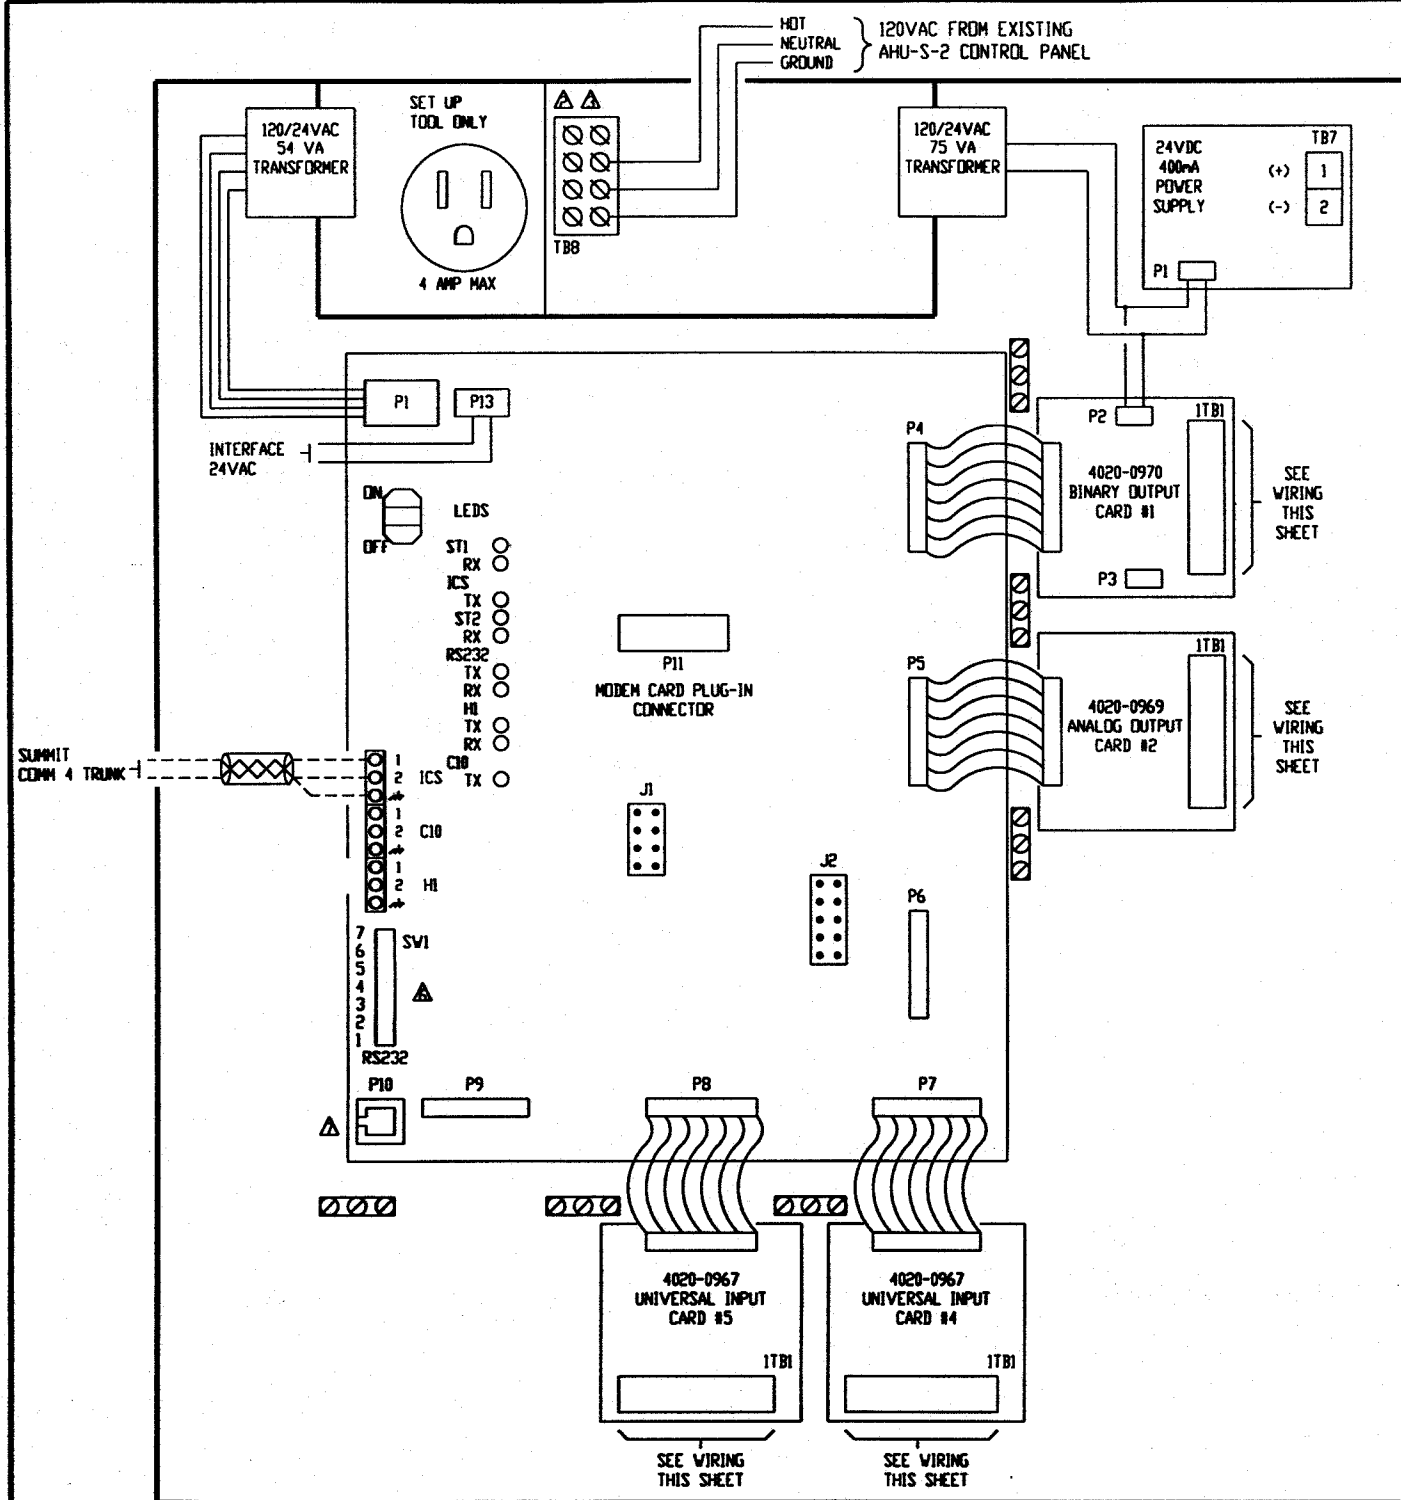


WIRING DIAGRAM NOTES.


- COMPONENTS AND WIRING SHOWN DASHED ARE FURNISHED AND FIELD INSTALLED.
- ALL WIRING MUST BE IN ACCORDANCE WITH NATIONAL ELECTRIC CODES AND LOCAL CODES. GREEN WIRE GROUND MUST BE CONTINUOUS BACK TO CIRCUIT BREAKER PANEL.
- USE COPPER CONDUCTORS ONLY.
 - THE OPTIONAL 24 VAC, 75 VA TRANSFORMER PROVIDES 53 VA FOR BINARY OUTPUT TRIACS AND 22 VA TO THE 24VDC @ 400mA POWER SUPPLY.
 - THE OPTIONAL POWER SUPPLY PROVIDES 24VDC AT 400mA MAXIMUM FOR USE WITH 4 TO 20mA OR 0-10VDC TRANSMITTING SENSORS
- SWITCH SW1 CONFIGURES UPCM ADDRESS. REFER TO INSTALLATION MANUAL FOR ADDRESS SETUP.
- POSITION P10 IS AN RJ-12 PLUG FOR RS-232 CONNECTION. REFER TO INSTALLATION MANUAL FOR INFORMATION ON REQUIRED CABLES AND ADAPTERS.
- BINARY OUTPUTS ARE TRIAC, 24VAC, RATED 12 VA MAX EACH.
- ANALOG OUTPUTS ARE 0-20mA MAX. 0-10 VDC.
- UNIVERSAL INPUTS CAN BE INDIVIDUALLY CONFIGURED FOR EITHER ANALOG INPUTS (AIP) OR BINARY INPUT (BIP).

UPCM-2 AHU-S2
BMTU000AAAS4301100000200


- ANALOG INPUT (AIP) WIRING MUST BE SHIELDED, TWISTED PAIR. EACH CONDUCTOR MUST BE STRANDED, TINNED COPPER. RECOMMENDED SIZE IS 18-22 GAUGE AT SENSOR. SHIELD MUST BE CUT BACK AND TAPED. MAXIMUM ANALOG INPUT WIRING DISTANCE IS 300 FT (91 M). ANALOG INPUTS CAN BE THERMISTOR, RTD, 4-20mA OR 0-10VDC.
- BINARY INPUT (BIP) WIRING MUST BE SHIELDED, TWISTED PAIR. EACH CONDUCTOR MUST BE STRANDED, TINNED COPPER. RECOMMENDED SIZE IS 18-22 GAUGE AT SENSOR. SHIELD MUST BE CUT BACK AND TAPED. MAXIMUM BINARY INPUT WIRING DISTANCE IS 1000FT. (305), BINARY INPUTS MUST BE ISOLATED, UNGROUNDED CONTACTS.

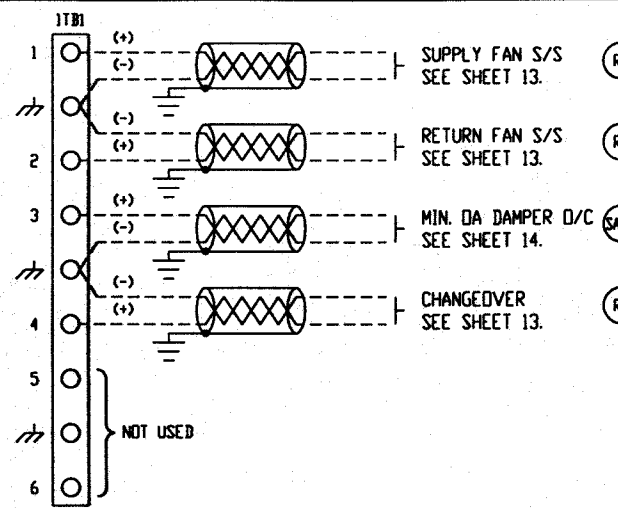


CARD #1 BINARY OUTPUT WIRING

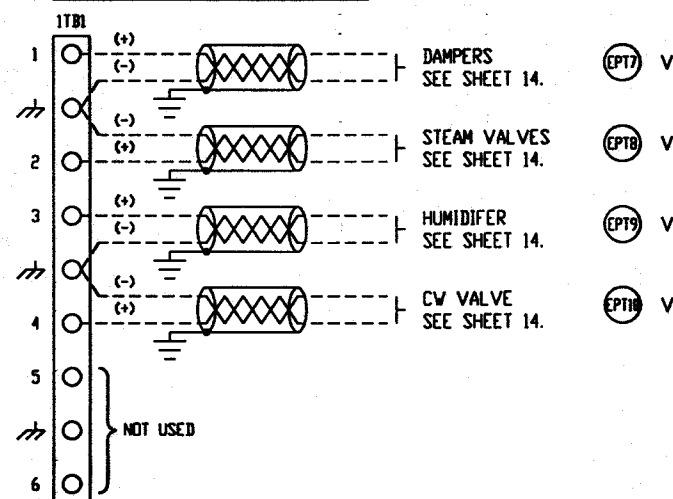


CARD #2 ANALOG OUTPUT WIRING

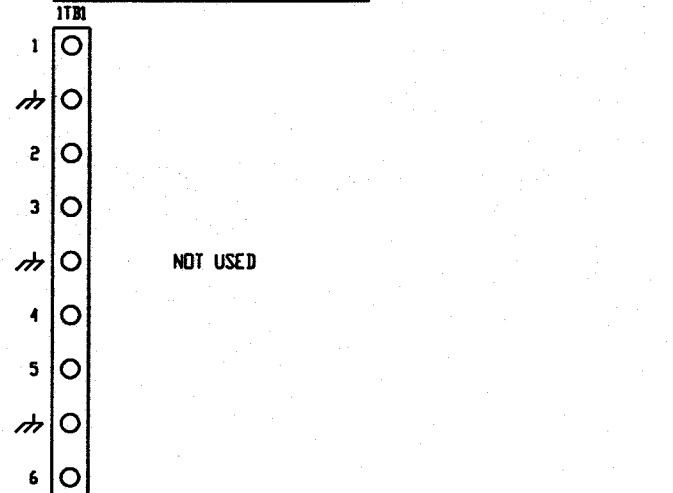


CARD #3 ANALOG OUTPUT WIRING

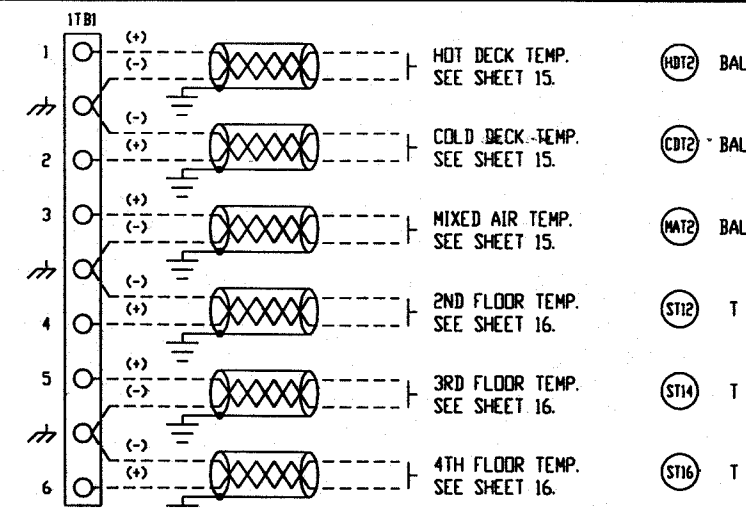

CARD #4 UNIVERSAL INPUT WIRING

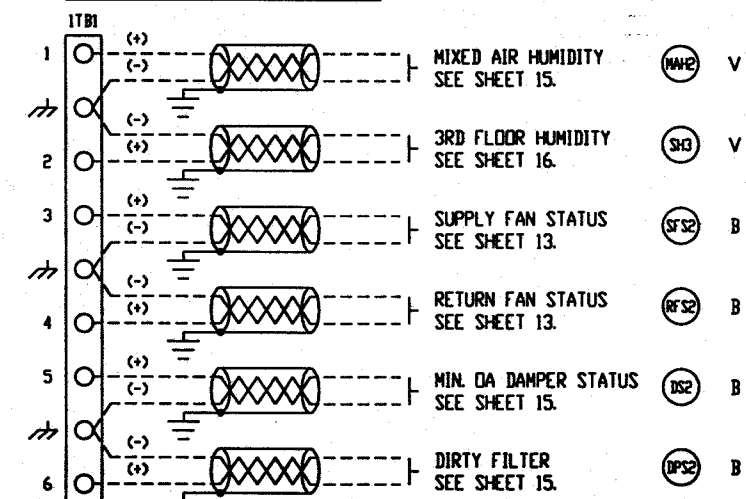

CARD #5 UNIVERSAL INPUT WIRING

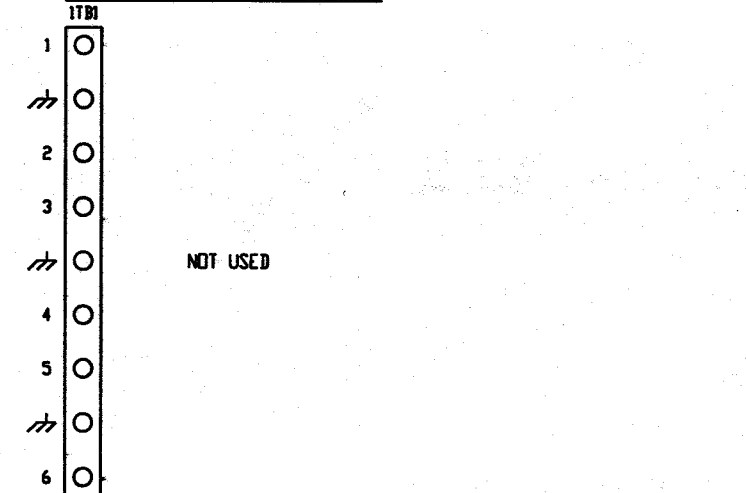


CARD #6 UNIVERSAL INPUT WIRING

THE DOCUMENTATION HEREIN IS THE EXCLUSIVE PROPERTY OF LAYNE TRANE, CHARLOTTE, N.C. REPRODUCTION AND/OR DISTRIBUTION TO OTHER THAN AUTHORIZED PARTIES IS PROHIBITED.

LAYNE TRANE
801 PRESSLEY RD
CHARLOTTE, N.C. 28217
704 525 3155


SALES ENGR		PROJ. MGR		APPL. ENGR		DRAWN BY		DATE: 4/2/98	
CCR	CVF	CVF	CVF	DPC					
PROJECT NAME: UNCC-McEniry Charlotte, North Carolina								CONTRACT NUMBER: ICS-98014	
								DRAWING NUMBER: SHEET 12 OF 51	

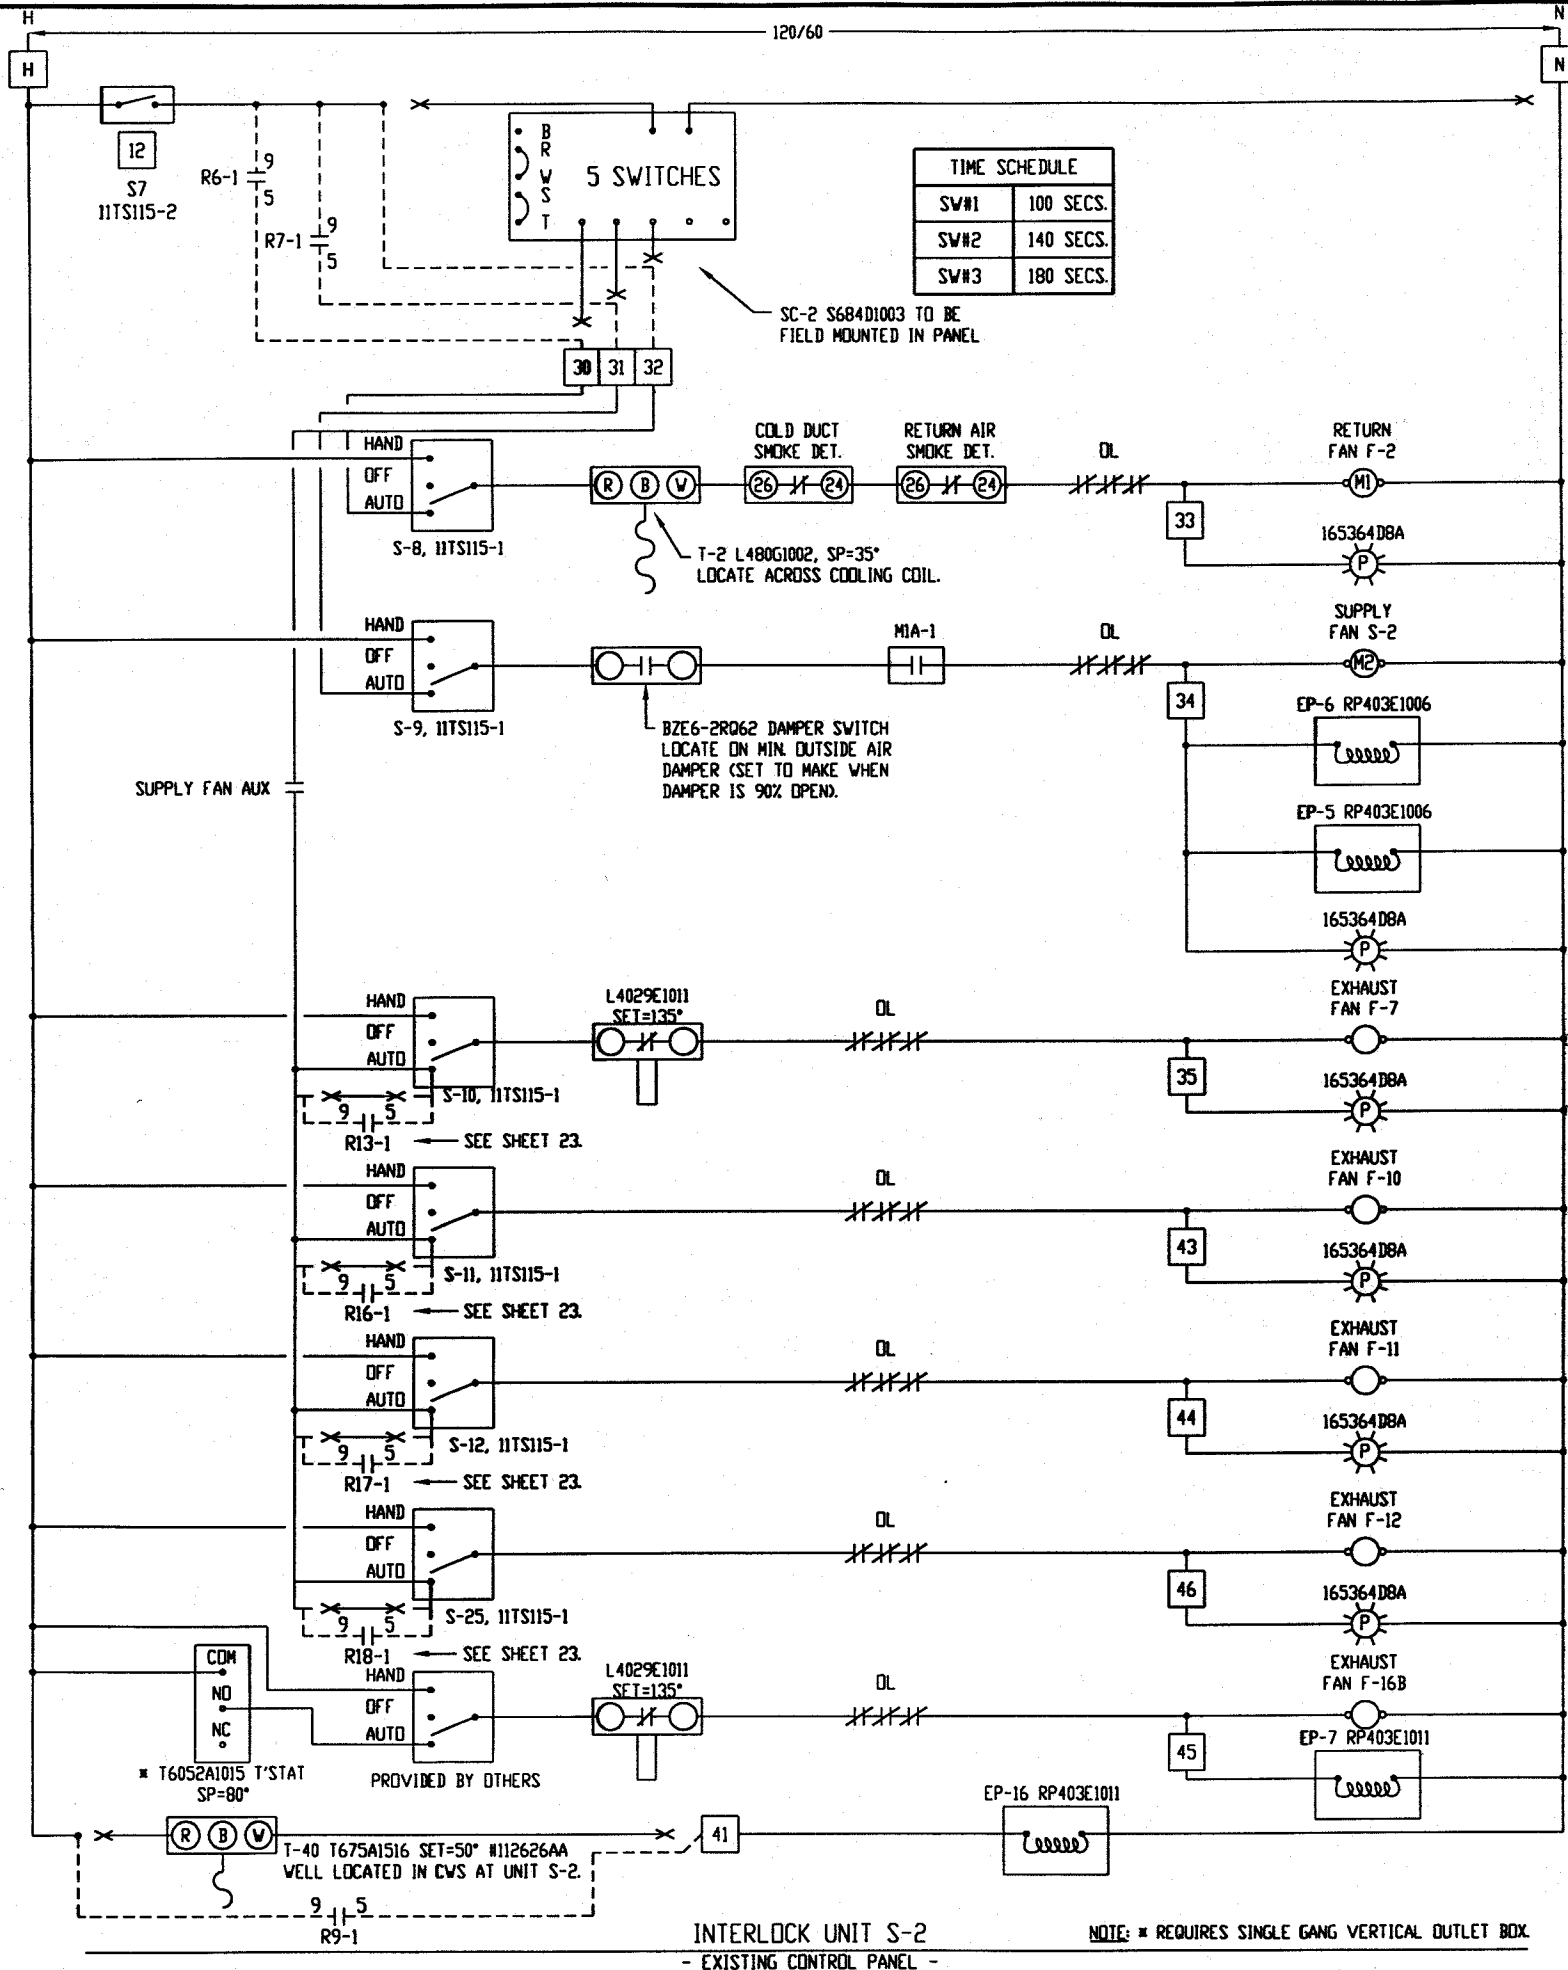





TIME SCHEDULE	
SW#1	100 SECS.
SW#2	140 SECS.
SW#3	180 SECS.

LEGEND

- THIS COLOR IS INDICATING EXISTING, TO REMAIN AS IS.
- THIS COLOR IS INDICATING TO BE REMOVED.
- THIS COLOR IS INDICATING TO BE ABANDONED IN PLACE.
- THIS COLOR IS INDICATING NEW TO BE ADDED.
- (M) MAIN AIR
- * INDICATES GAUGE MOUNTED ON PANEL FACE.
- ⊕ CONNECT TO EXISTING

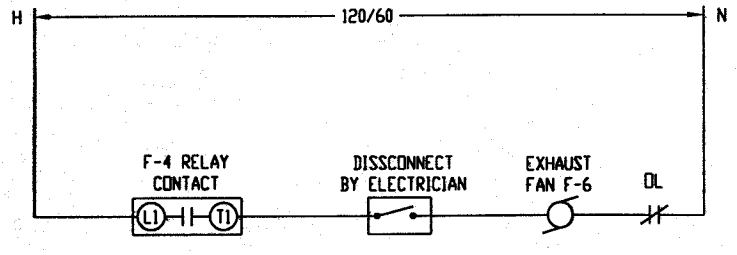

EXHAUST FAN F-6 WIRING

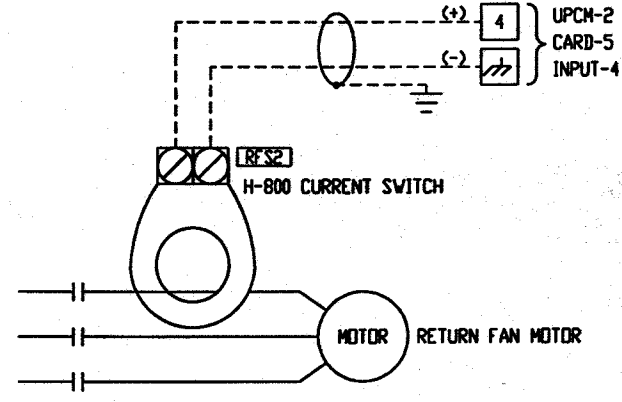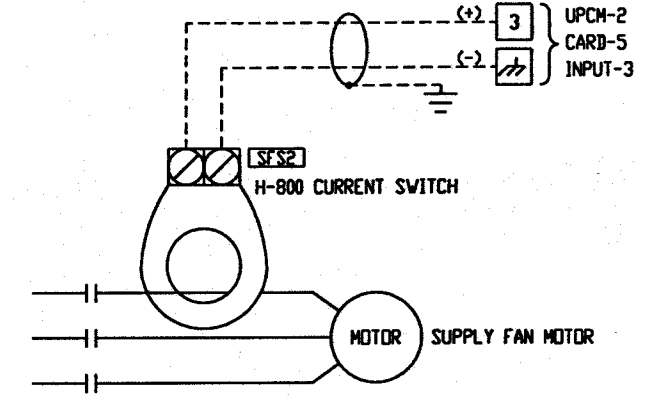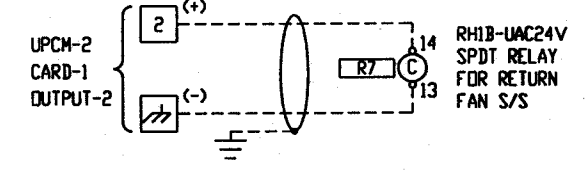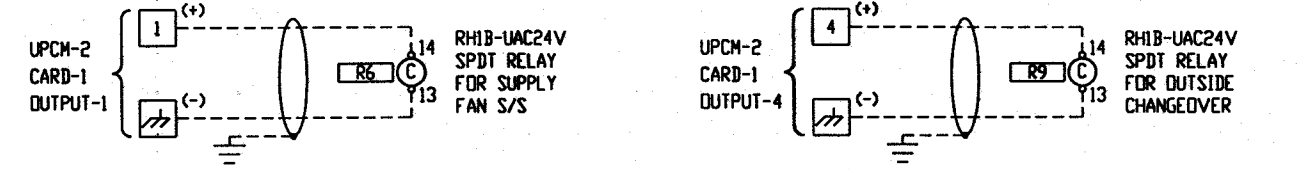

SUPPLY & RETURN FAN S/S/ SWITCH

LEGEND


- INDICATES EXISTING WIRING
- - - INDICATES FIELD WIRING

THE DOCUMENTATION HEREIN IS THE EXCLUSIVE PROPERTY OF LAYNE TRANE, CHARLOTTE, N.C. REPRODUCTION AND/OR DISTRIBUTION TO OTHER THAN AUTHORIZED PARTIES IS PROHIBITED.

TRANE
 LAYNE TRANE
 801 PRESSLEY RD
 CHARLOTTE, N.C. 28217
 704 525 3155

REFERENCE DRAWING	NO.	REVISION-LOCATION	DATE	BY

SALES ENGR. CCR	PROJ. MGR. CVF	APPL. ENGR. CVF	DRAWN BY DPC	DATE: 4/7/98
PROJECT NAME				CONTRACT NUMBER
UNCC-McEniry				ICS-98014
Charlotte, North Carolina				DRAWING NUMBER
				SHEET 13 OF 51

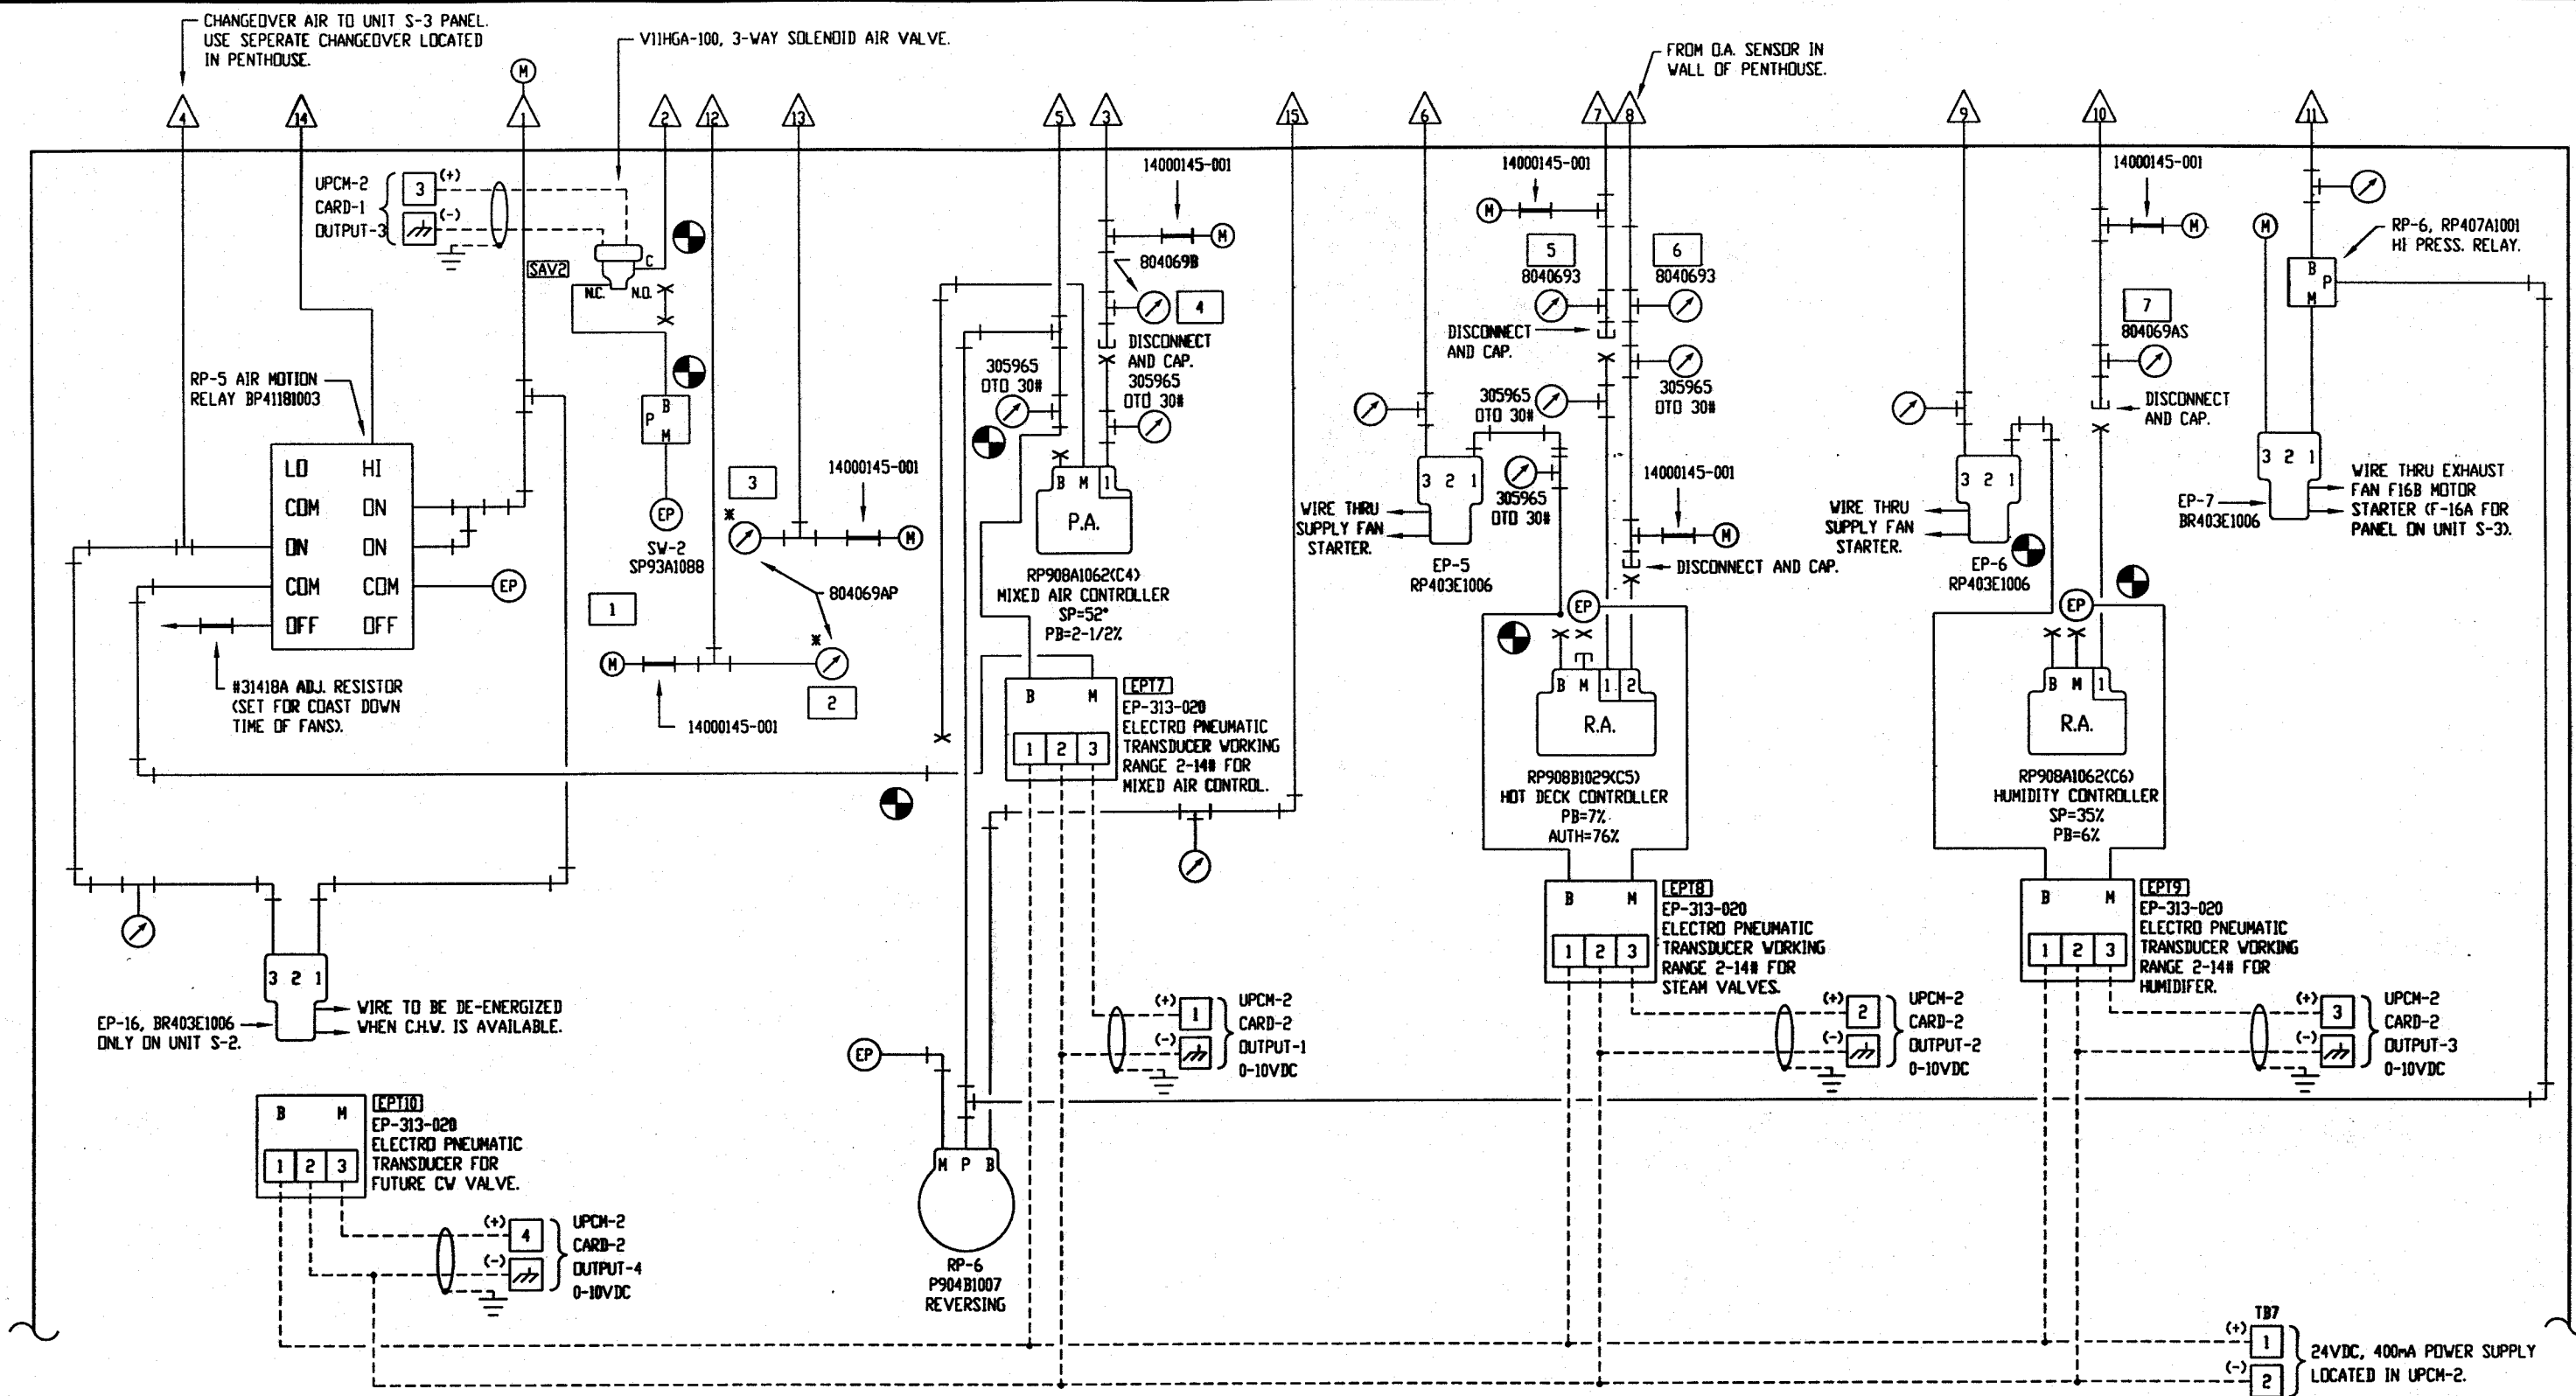

AHU-S2 PANEL PNEUMATIC SCHEMATIC

- EXISTING CONTROL PANEL -

LEGEND

- THIS COLOR IS INDICATING EXISTING, TO REMAIN AS IS.
- THIS COLOR IS INDICATING TO BE REMOVED.
- THIS COLOR IS INDICATING TO BE ABANDONED IN PLACE.
- THIS COLOR IS INDICATING NEW TO BE ADDED.
- (M) MAIN AIR
- * INDICATES GAUGE MOUNTED ON PANEL FACE.
- ⊕ CONNECT TO EXISTING

- 1 MIN. OA DAMPER POSITION
- 2 COLD DECK DISCHARGE TEMP.
- 3 RETURN AIR TEMP.
- 4 MIXED AIR TEMP.
- 5 HOT DECK DISCHARGE TEMP.
- 6 OUTSIDE AIR TEMP.
- 7 RETURN AIR TEMP.

LEGEND


- INDICATES EXISTING WIRING
- - - INDICATES FIELD WIRING

THE DOCUMENTATION HEREIN IS THE EXCLUSIVE PROPERTY OF LAYNE TRANE, CHARLOTTE, N.C. REPRODUCTION AND/OR DISTRIBUTION TO OTHER THAN AUTHORIZED PARTIES IS PROHIBITED.

TRANE
LAYNE TRANE
801 PRESSLEY RD
CHARLOTTE, N.C. 28217
704 525 3155

REFERENCE DRAWING	NO.	REVISION-LOCATION	DATE	BY
SALES ENGR. CCR	PROJ. MGR. CVF	APPL. ENGR. CVF	DRAWN BY DPC	DATE: 4/2/98
PROJECT NAME: UNCC-McEniry Charlotte, North Carolina				CONTRACT NUMBER: ICS-98014
				DRAWING NUMBER: SHEET 14 OF 51

NOTE: ALL PRESSURE GAUGES 305909, 0 TO 30# RANGE EXCEPT AS NOTED.

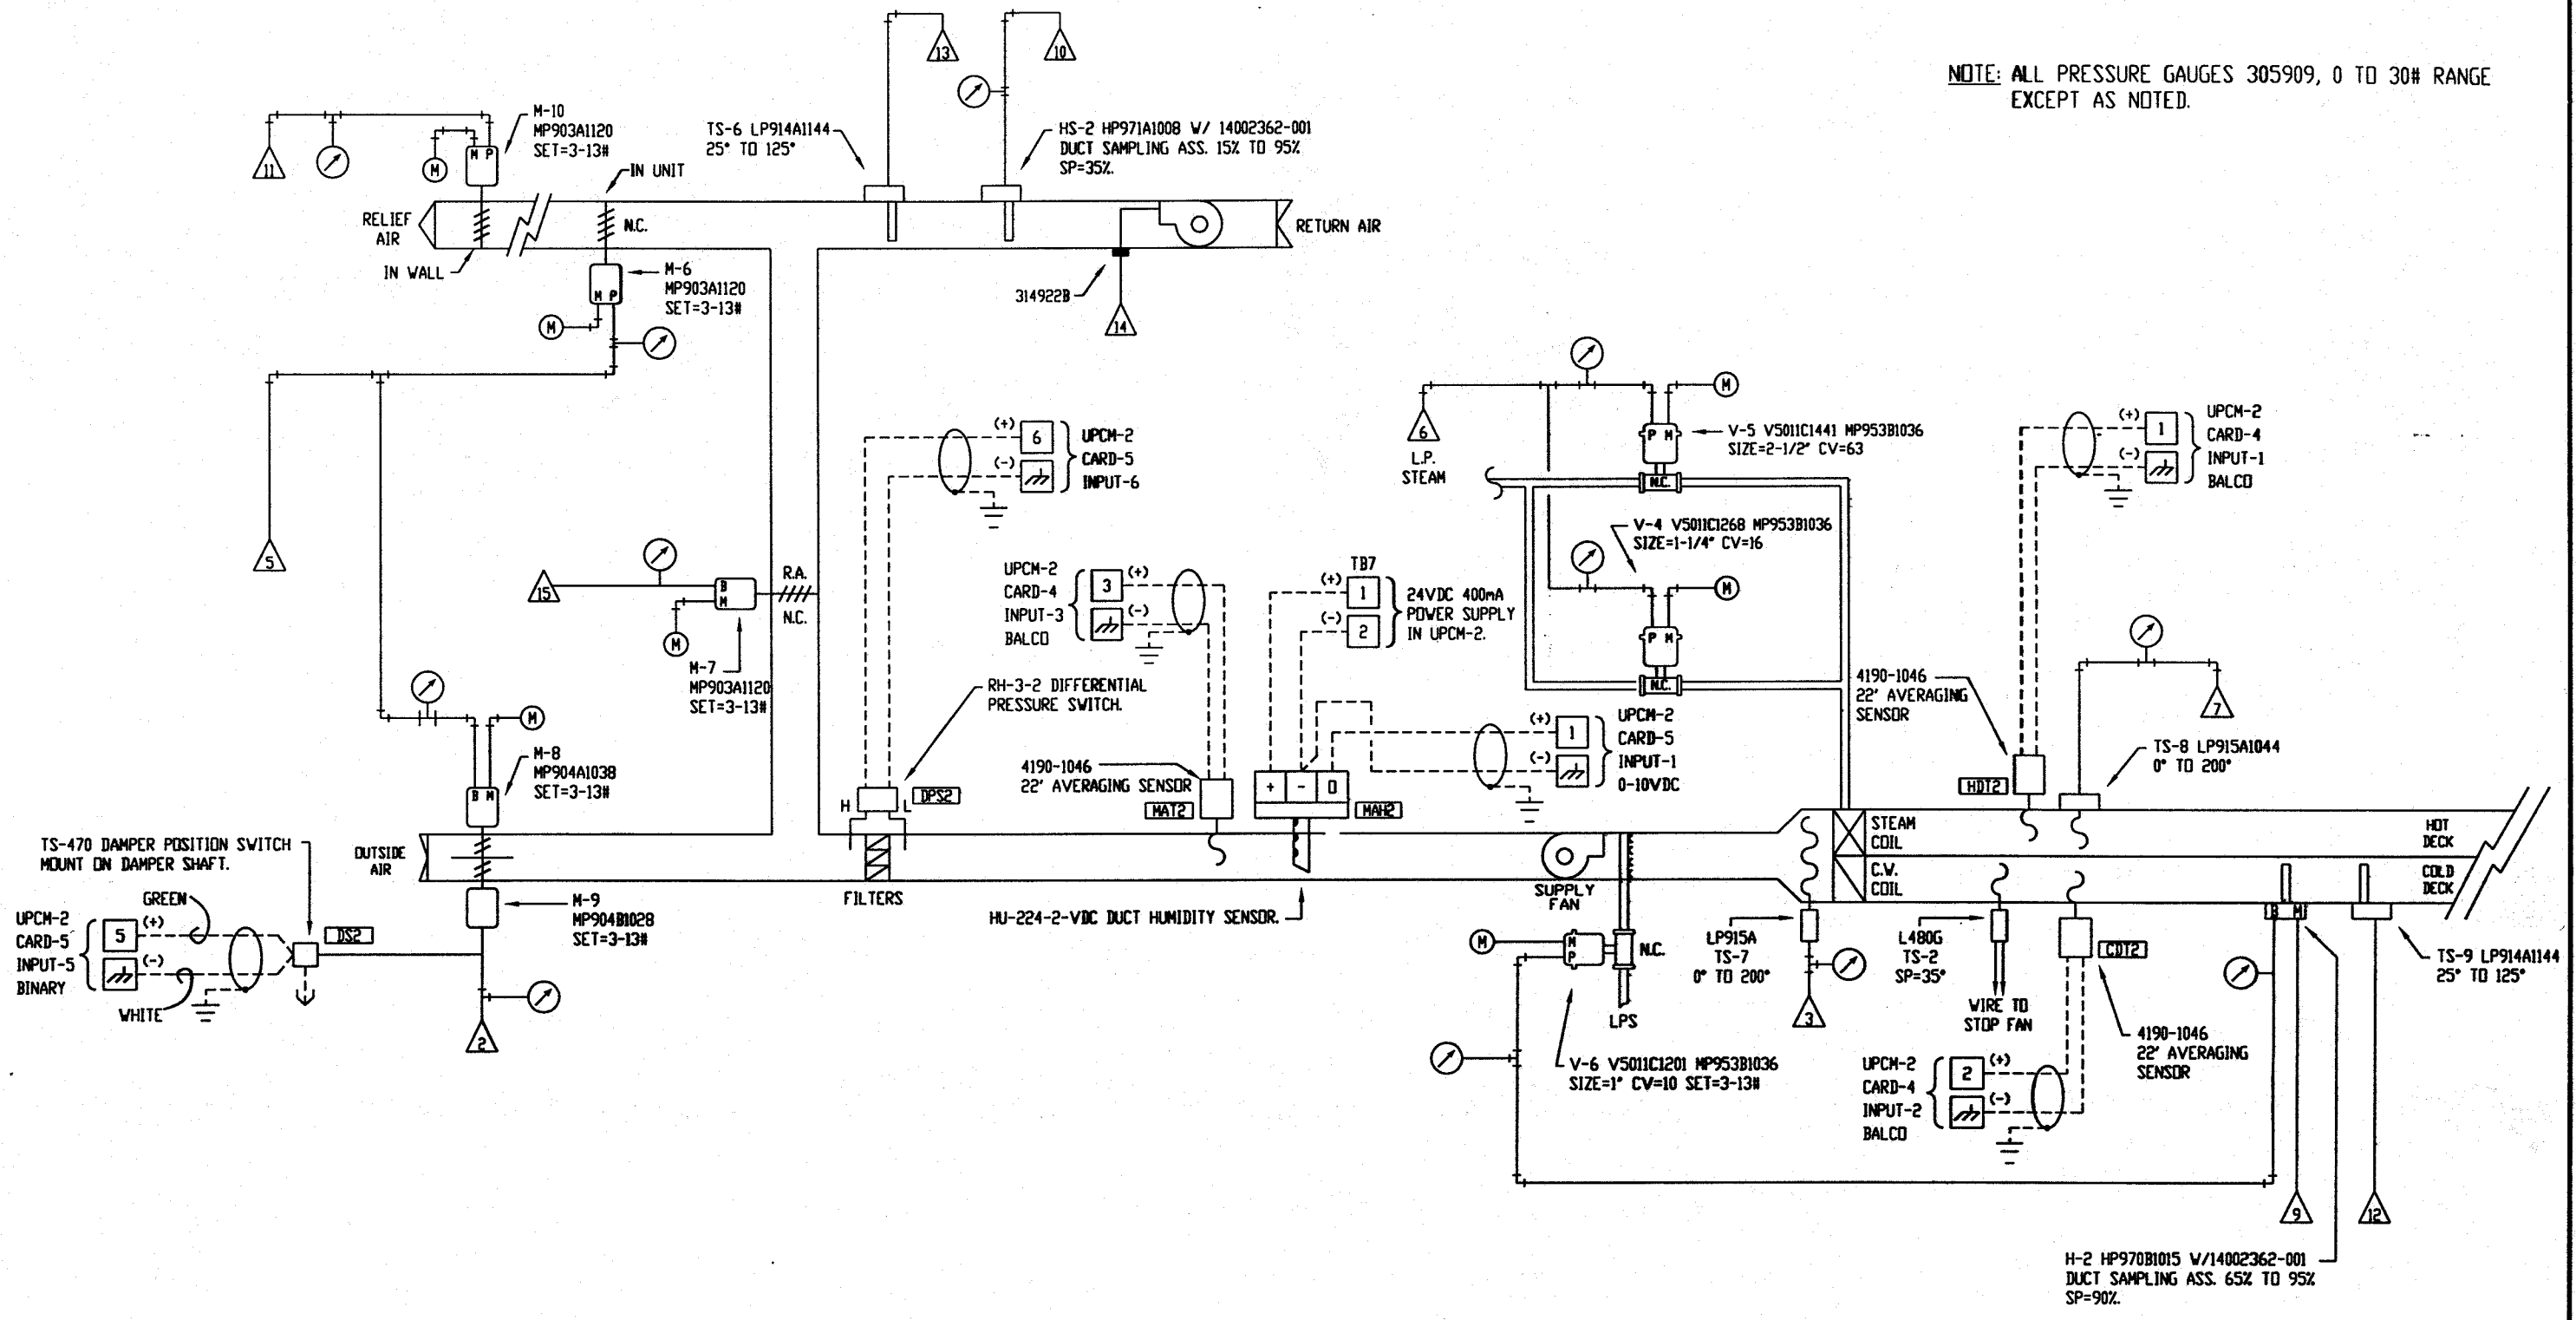


AHU-S2 AIR FLOW SCHEMATIC

LEGEND	
■	THIS COLOR IS INDICATING EXISTING, TO REMAIN AS IS.
■	THIS COLOR IS INDICATING TO BE REMOVED.
■	THIS COLOR IS INDICATING TO BE ABANDONED IN PLACE.
■	THIS COLOR IS INDICATING NEW TO BE ADDED.
Ⓜ	MAIN AIR
*	INDICATES GAUGE MOUNTED ON PANEL FACE.
⊕	CONNECT TO EXISTING


THE DOCUMENTATION HEREIN IS THE EXCLUSIVE PROPERTY OF LAYNE TRANE, CHARLOTTE, N.C. REPRODUCTION AND/OR DISTRIBUTION TO OTHER THAN AUTHORIZED PARTIES IS PROHIBITED.

LAYNE TRANE
801 PRESSLEY RD
CHARLOTTE, N.C. 28217
704 525 3155


REFERENCE DRAWING				NO.	REVISION-LOCATION	DATE	BY
SALES ENGR. CCR				PROJ. MGR. CVF	APPL. ENGR. CVF	DRAWN BY DPC	DATE: 4/2/98
PROJECT NAME						CONTRACT NUMBER	
UNCC-McEniry Charlotte, North Carolina						JCS-98014	
						DRAWING NUMBER	
						SHEET 15 OF 51	

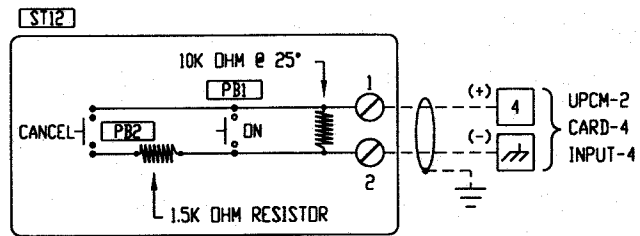


4190-1088 ZONE TEMPERATURE SENSOR LOCATED ON SECOND FLOOR IN CORRIDOR NEAR STAIRWELL 'D'.

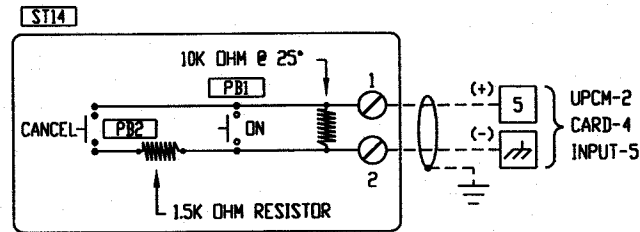

4190-1088 ZONE TEMPERATURE SENSOR LOCATED ON THIRD FLOOR IN CORRIDOR NEAR STAIRWELL 'D'.

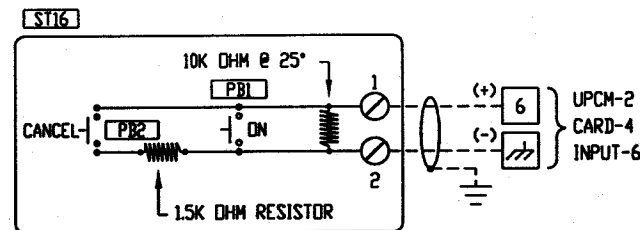

4190-1088 ZONE TEMPERATURE SENSOR LOCATED ON FOURTH FLOOR IN CORRIDOR NEAR STAIRWELL 'D'.

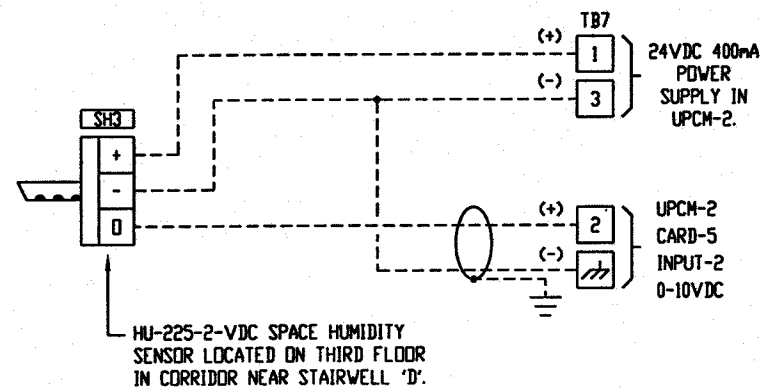


LEGEND	
—————	INDICATES FACTORY WIRING
-----	INDICATES FIELD WIRING

THE DOCUMENTATION HEREIN IS THE EXCLUSIVE PROPERTY OF LAYNE TRANE, CHARLOTTE, N.C. REPRODUCTION AND/OR DISTRIBUTION TO OTHER THAN AUTHORIZED PARTIES IS PROHIBITED.

TRANE
 LAYNE TRANE
 801 PRESSLEY RD
 CHARLOTTE, N.C. 28217
 704 525 3155

REFERENCE DRAWING					NO.		REVISION-LOCATION		DATE	BY
SALES ENGR. CLR	PRBL MGR CVF	APPL. ENGR. CVF	DRAWN BY DPC	DATE: 4/13/98	PROJECT NAME		CONTRACT NUMBER			
UNCC-McEniry Charlotte, North Carolina					ICS-98014		DRAWING NUMBER			
					SHEET 16 OF 51					

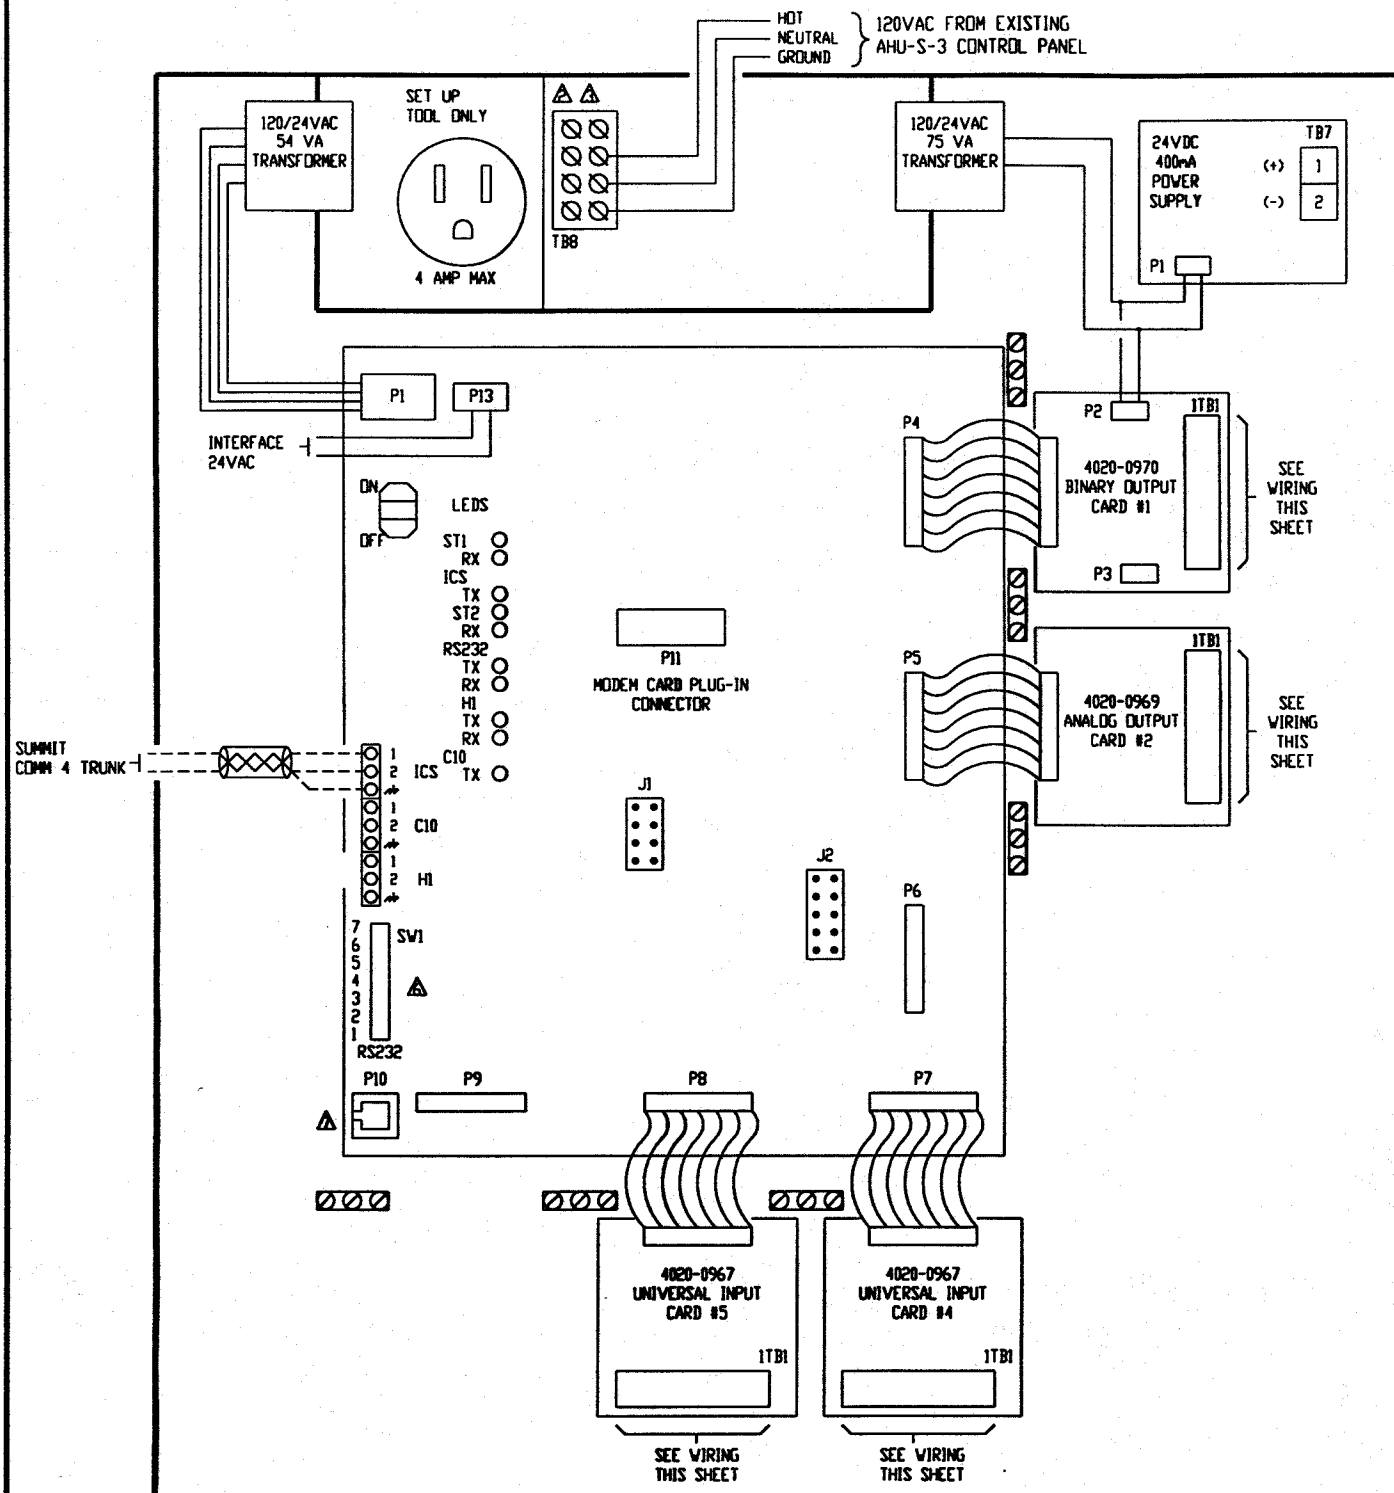


WIRING DIAGRAM NOTES.


- COMPONENTS AND WIRING SHOWN DASHED ARE FURNISHED AND FIELD INSTALLED.
- ALL WIRING MUST BE IN ACCORDANCE WITH NATIONAL ELECTRIC CODES AND LOCAL CODES. GREEN WIRE GROUND MUST BE CONTINUOUS BACK TO CIRCUIT BREAKER PANEL.
- USE COPPER CONDUCTORS ONLY.
 THE OPTIONAL 24 VAC, 75 VA TRANSFORMER PROVIDES 53 VA FOR BINARY OUTPUT TRIACS AND 22 VA TO THE 24VDC @ 400mA POWER SUPPLY.
 THE OPTIONAL POWER SUPPLY PROVIDES 24VDC AT 400mA MAXIMUM FOR USE WITH 4 TO 20mA OR 0-10VDC TRANSMITTING SENSORS
 SWITCH SW1 CONFIGURES UPCM ADDRESS. REFER TO INSTALLATION MANUAL FOR ADDRESS SETUP.
 POSITION P10 IS AN RJ-12 PLUG FOR RS-232 CONNECTION. REFER TO INSTALLATION MANUAL FOR INFORMATION ON REQUIRED CABLES AND ADAPTERS.
 BINARY OUTPUTS ARE TRIAC, 24VAC, RATED 12 VA MAX EACH.
 ANALOG OUTPUTS ARE 0-20mA MAX. 0-10 VDC.
 UNIVERSAL INPUTS CAN BE INDIVIDUALLY CONFIGURED FOR EITHER ANALOG INPUTS (AIP) OR BINARY INPUT (BIP).

UPCM-3 AHU-S3
BMTU000AAAS4301100000200


- ANALOG INPUT (AIP) WIRING MUST BE SHIELDED, TWISTED PAIR. EACH CONDUCTOR MUST BE STRANDED, TINNED COPPER. RECOMMENDED SIZE IS 18-22 GAUGE AT SENSOR, SHIELD MUST BE CUT BACK AND TAPED. MAXIMUM ANALOG INPUT WIRING DISTANCE IS 300 FT (91 M). ANALOG INPUTS CAN BE THERMISTOR, RTD, 4-20mA OR 0-10VDC.
- BINARY INPUT (BIP) WIRING MUST BE SHIELDED, TWISTED PAIR. EACH CONDUCTOR MUST BE STRANDED, TINNED COPPER. RECOMMENDED SIZE IS 18-22 GAUGE AT SENSOR. SHIELD MUST BE CUT BACK AND TAPED. MAXIMUM BINARY INPUT WIRING DISTANCE IS 1000FT. (305), BINARY INPUTS MUST BE ISOLATED, UNGROUNDED CONTACTS.

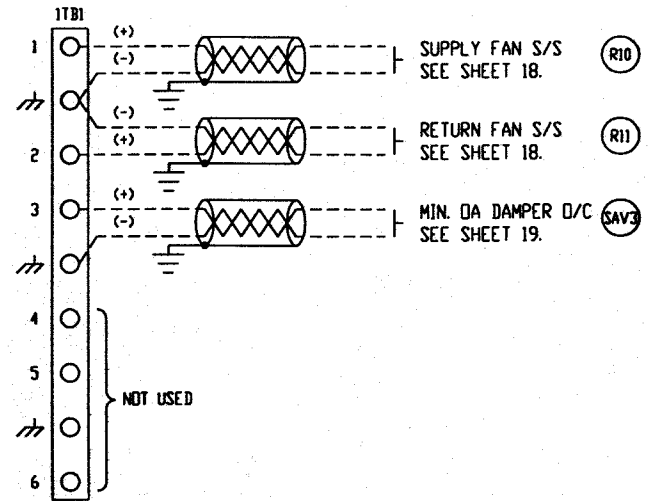


CARD #1 BINARY OUTPUT WIRING

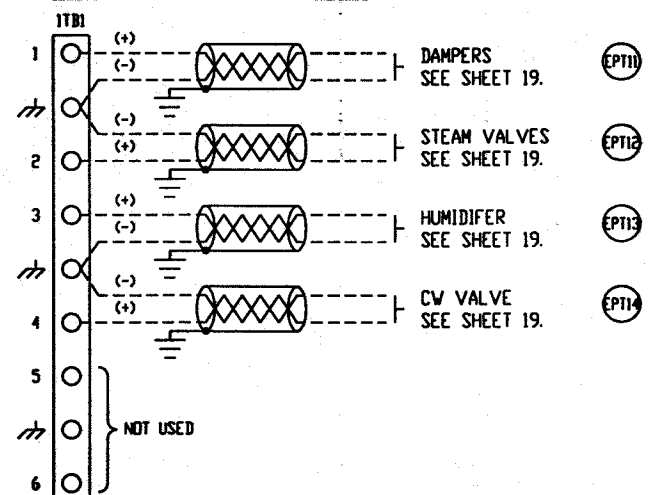


CARD #2 ANALOG OUTPUT WIRING

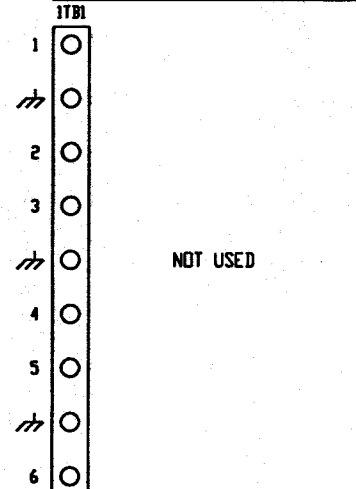


OPEN SLOT

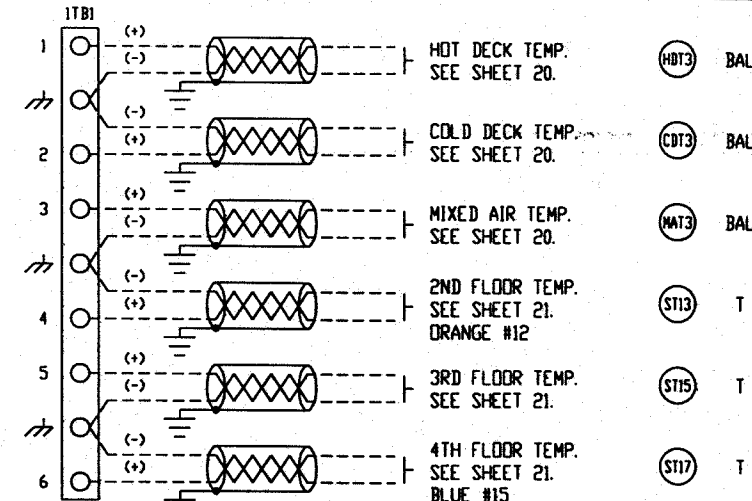

CARD #4 UNIVERSAL INPUT WIRING

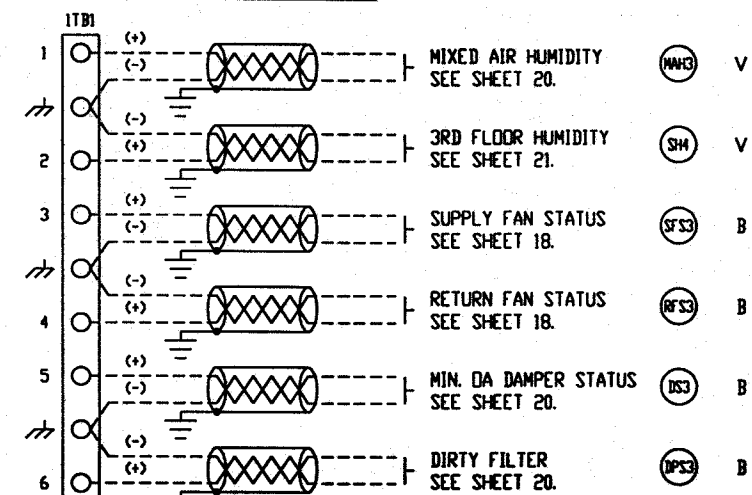

CARD #5 UNIVERSAL INPUT WIRING

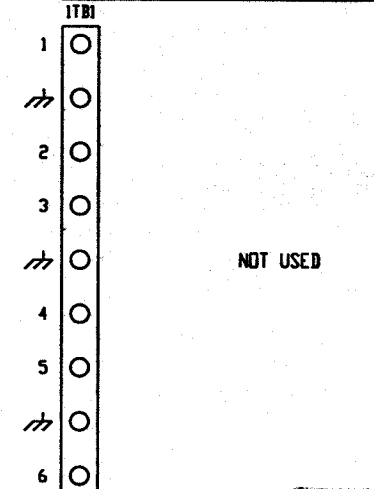


OPEN SLOT

TRANE
LAYNE TRANE
801 PRESSLEY RD
CHARLOTTE, N.C. 28217
704 525 3155

REFERENCE WIRING	NO.	REVISION-LOCATION	DATE	BY

SALES ENGR. CCR	PROJ. MGR. CVF	APPL. ENGR. CVF	DRAWN BY DPC	DATE: 4/2/90
PROJECT NAME: UNCC-McEniry Charlotte, North Carolina				CONTRACT NUMBER: ICS-98014
DRAWING NUMBER: SHEET 17 OF 51				

THE DOCUMENTATION HEREIN IS THE EXCLUSIVE PROPERTY OF LAYNE TRANE, CHARLOTTE, N.C. REPRODUCTION AND/OR DISTRIBUTION TO OTHER THAN AUTHORIZED PARTIES IS PROHIBITED.

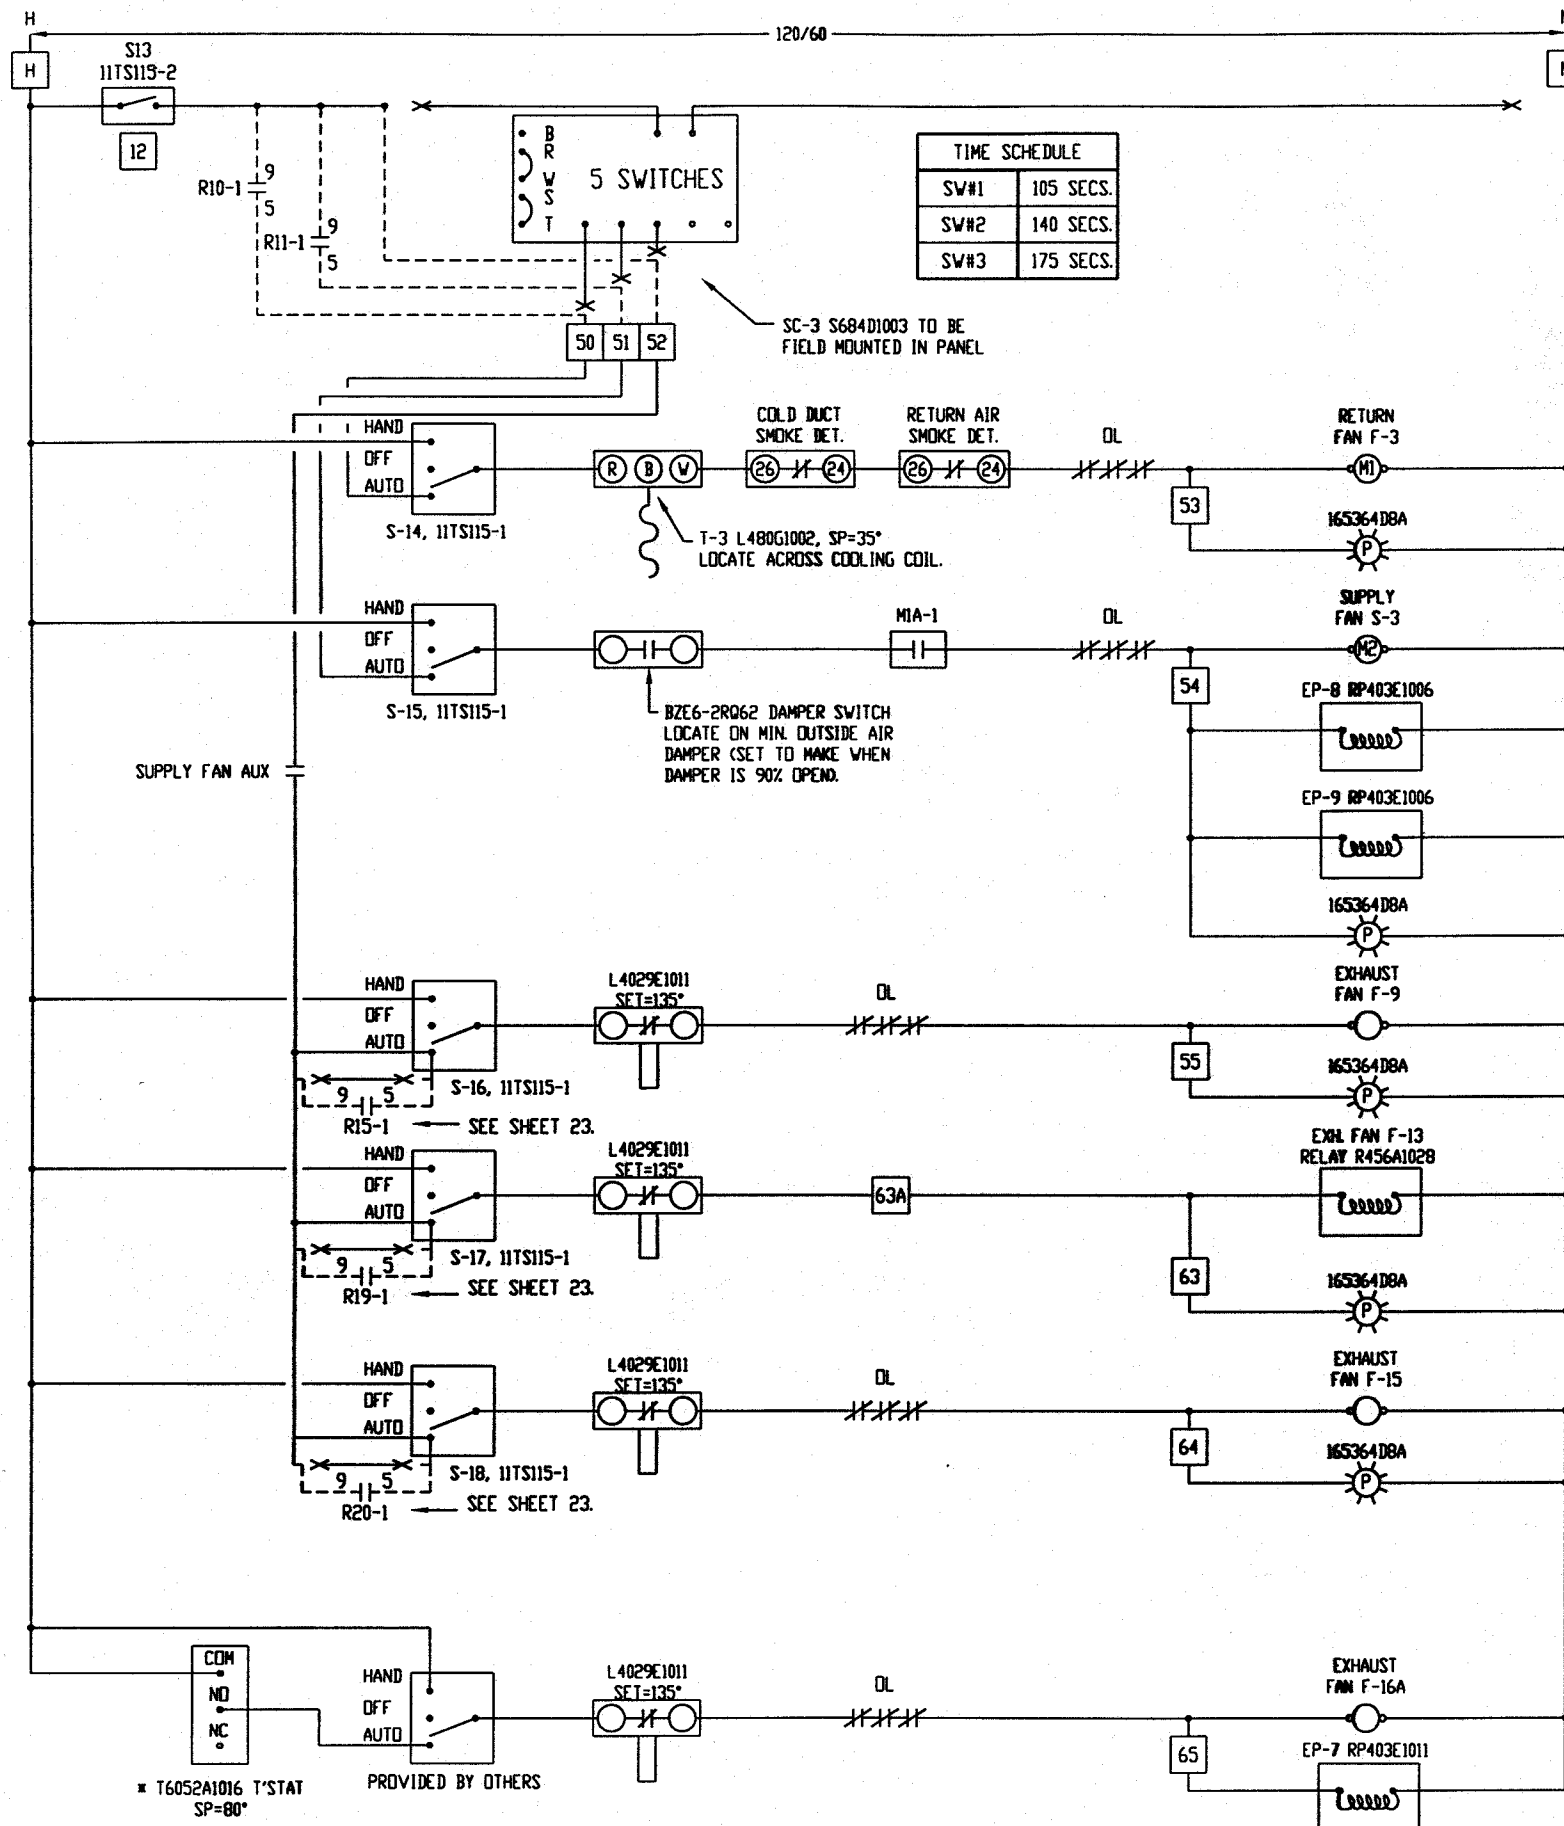

TIME SCHEDULE	
SW#1	105 SECS.
SW#2	140 SECS.
SW#3	175 SECS.

SC-3 S684D1003 TO BE FIELD MOUNTED IN PANEL

T-3 L480G1002, SP=35° LOCATE ACROSS COOLING COIL.


BZE6-2R062 DAMPER SWITCH LOCATE ON MIN. OUTSIDE AIR DAMPER (SET TO MAKE WHEN DAMPER IS 90% OPEN).

SUPPLY FAN AUX

* T6052A1016 T'STAT SP=80° PROVIDED BY OTHERS

INTERLOCK UNIT S-3
- EXISTING CONTROL PANEL -





NOTE: * REQUIRES SINGLE GANG VERTICAL OUTLET BOX.

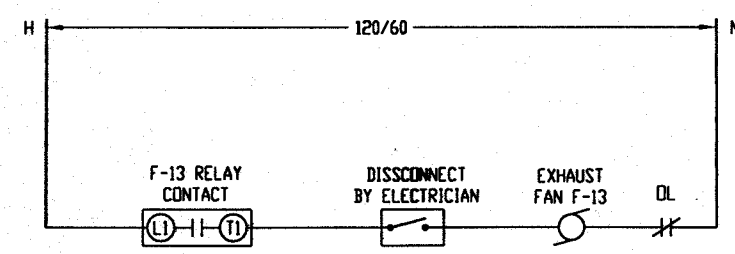

EXHAUST FAN F-13 WIRING

LEGEND

- THIS COLOR IS INDICATING EXISTING, TO REMAIN AS IS.
- THIS COLOR IS INDICATING TO BE REMOVED.
- THIS COLOR IS INDICATING TO BE ABANDONED IN PLACE.
- THIS COLOR IS INDICATING NEW TO BE ADDED.
- (M) MAIN AIR
- * INDICATES GAUGE MOUNTED ON PANEL FACE.
- ⊕ CONNECT TO EXISTING

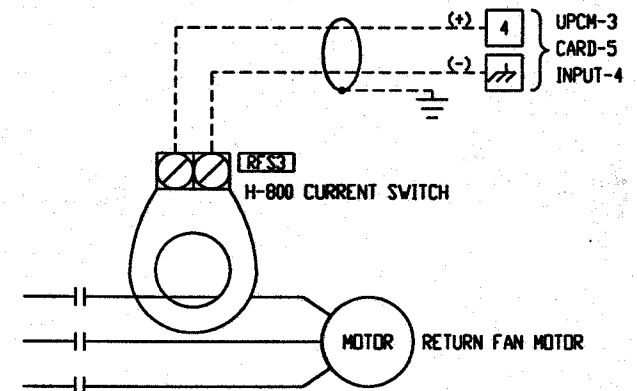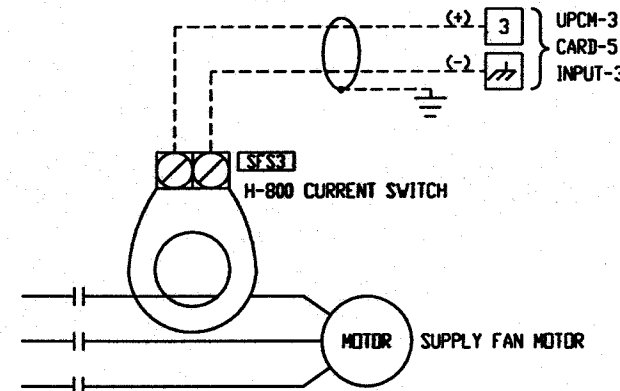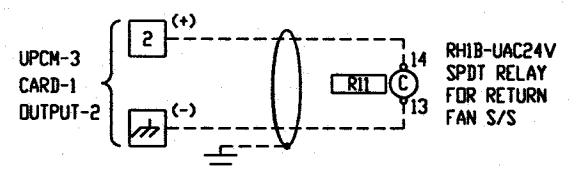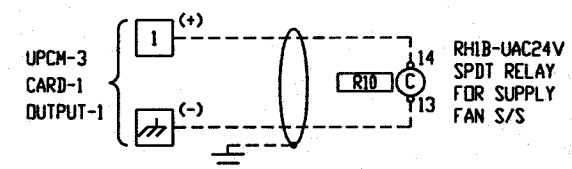

SUPPLY & RETURN FAN S/S/ SWITCH

LEGEND


- INDICATES EXISTING WIRING
- - - INDICATES FIELD WIRING

THE DOCUMENTATION HEREIN IS THE EXCLUSIVE PROPERTY OF LAYNE TRANE, CHARLOTTE, N.C. REPRODUCTION AND/OR DISTRIBUTION TO OTHER THAN AUTHORIZED PARTIES IS PROHIBITED.

TRANE
Layne Trane
801 PRESSLEY RD
CHARLOTTE, N.C. 28217
704 525 3155

REFERENCE DRAWING	NO.	REVISION-LOCATION	DATE	BY

SALES ENGR. CCR	PROJ. MGR. CVF	APPL. ENGR. CVF	DRAWN BY. DPC	DATE: 4/7/98
PROJECT NAME				CONTRACT NUMBER
UNCC-McEniry				ICS-98014
Charlotte, North Carolina				DRAWING NUMBER
				SHEET 18 OF 51

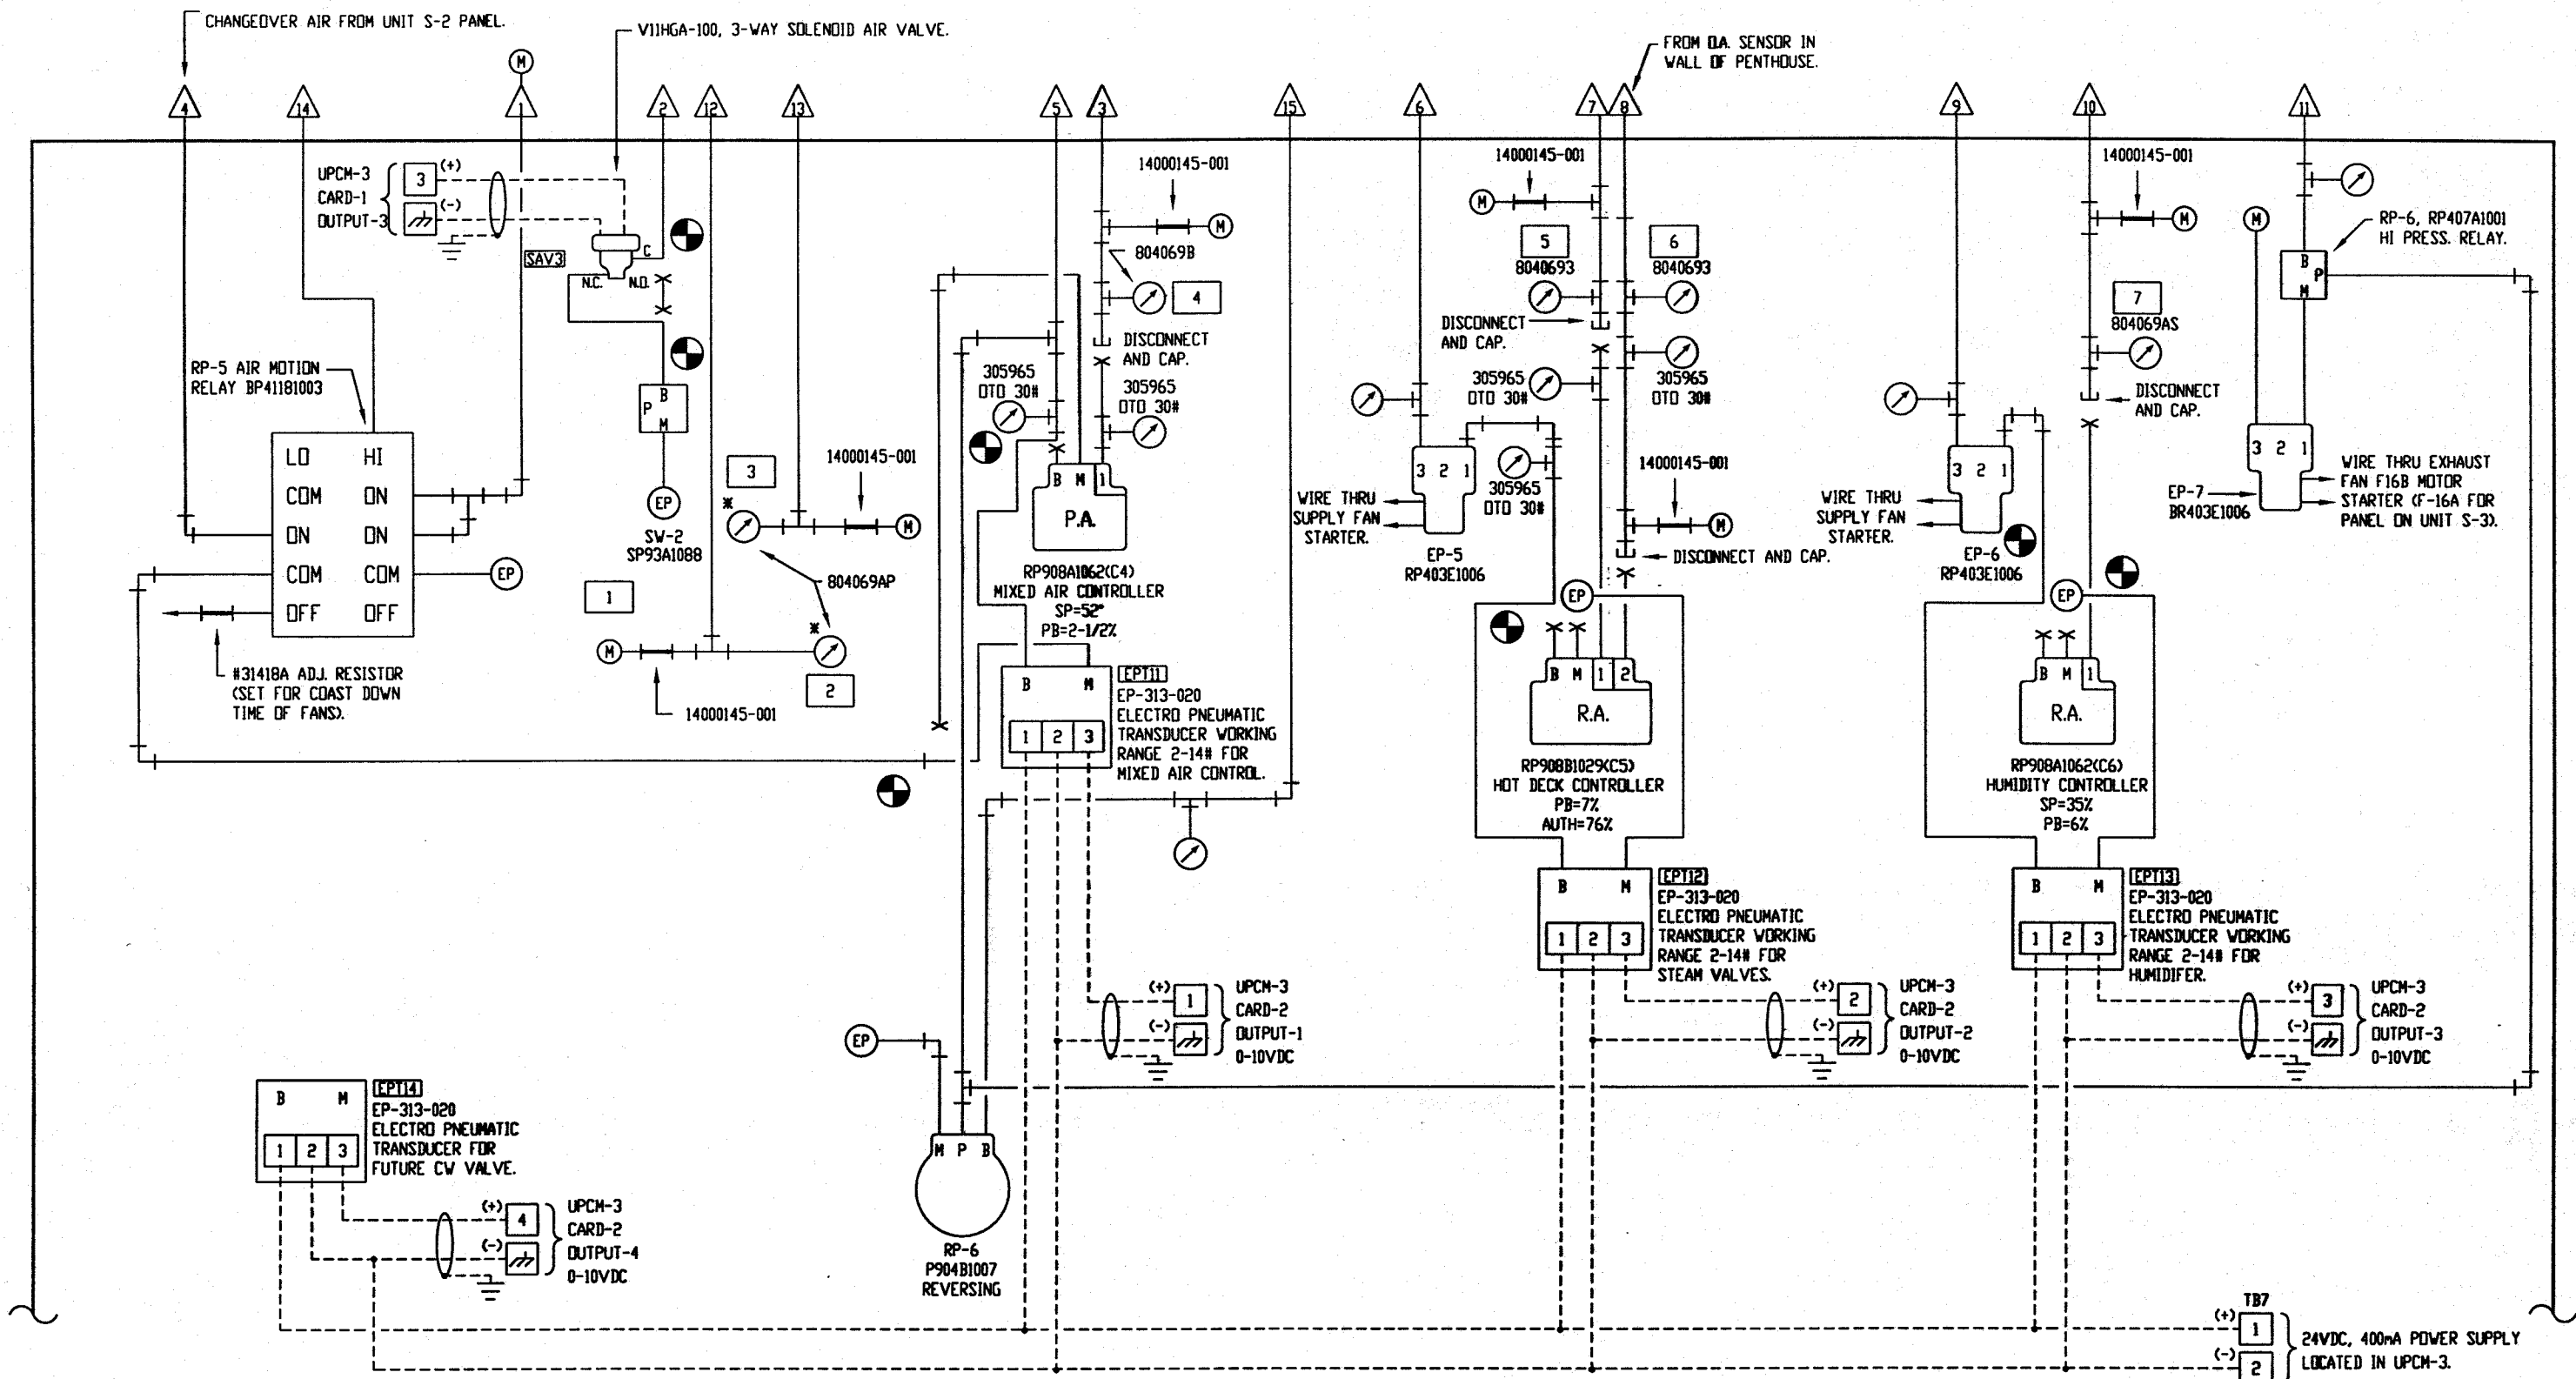

AHU-S3 PANEL PNEUMATIC SCHEMATIC

- EXISTING CONTROL PANEL -

LEGEND



■ THIS COLOR IS INDICATING EXISTING, TO REMAIN AS IS.	1 MIN. OA DAMPER POSITION
■ THIS COLOR IS INDICATING TO BE REMOVED.	2 COLD DECK DISCHARGE TEMP.
■ THIS COLOR IS INDICATING TO BE ABANDONED IN PLACE.	3 RETURN AIR TEMP.
■ THIS COLOR IS INDICATING NEW TO BE ADDED.	4 MIXED AIR TEMP.
(M) MAIN AIR	5 HOT DECK DISCHARGE TEMP.
* INDICATES GAUGE MOUNTED ON PANEL FACE.	6 OUTSIDE AIR TEMP.
⊕ CONNECT TO EXISTING	7 RETURN AIR TEMP.

THE DOCUMENTATION HEREIN IS THE EXCLUSIVE PROPERTY OF LAYNE TRANE, CHARLOTTE, N.C. REPRODUCTION AND/OR DISTRIBUTION TO OTHER THAN AUTHORIZED PARTIES IS PROHIBITED.

TRANE
LAYNE TRANE
801 PRESSLEY RD
CHARLOTTE, N.C. 28217
704 525 3155

REFERENCE DRAWING	NO.	REVISION-LOCATION	DATE	BY
SALES ENGR.	PROJ. MGR.	APPL. ENGR.	DRAWN BY	DATE: 4/2/98
CCR	CVF	CVF	DPC	
PROJECT NAME				CONTRACT NUMBER
UNCC-McEniry				ICS-98014
Charlotte, North Carolina				DRAWING NUMBER
				SHEET 19 OF 51

NOTE: ALL PRESSURE GAUGES 305909, 0 TO 30# RANGE EXCEPT AS NOTED.

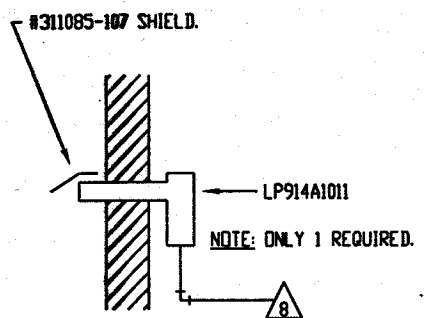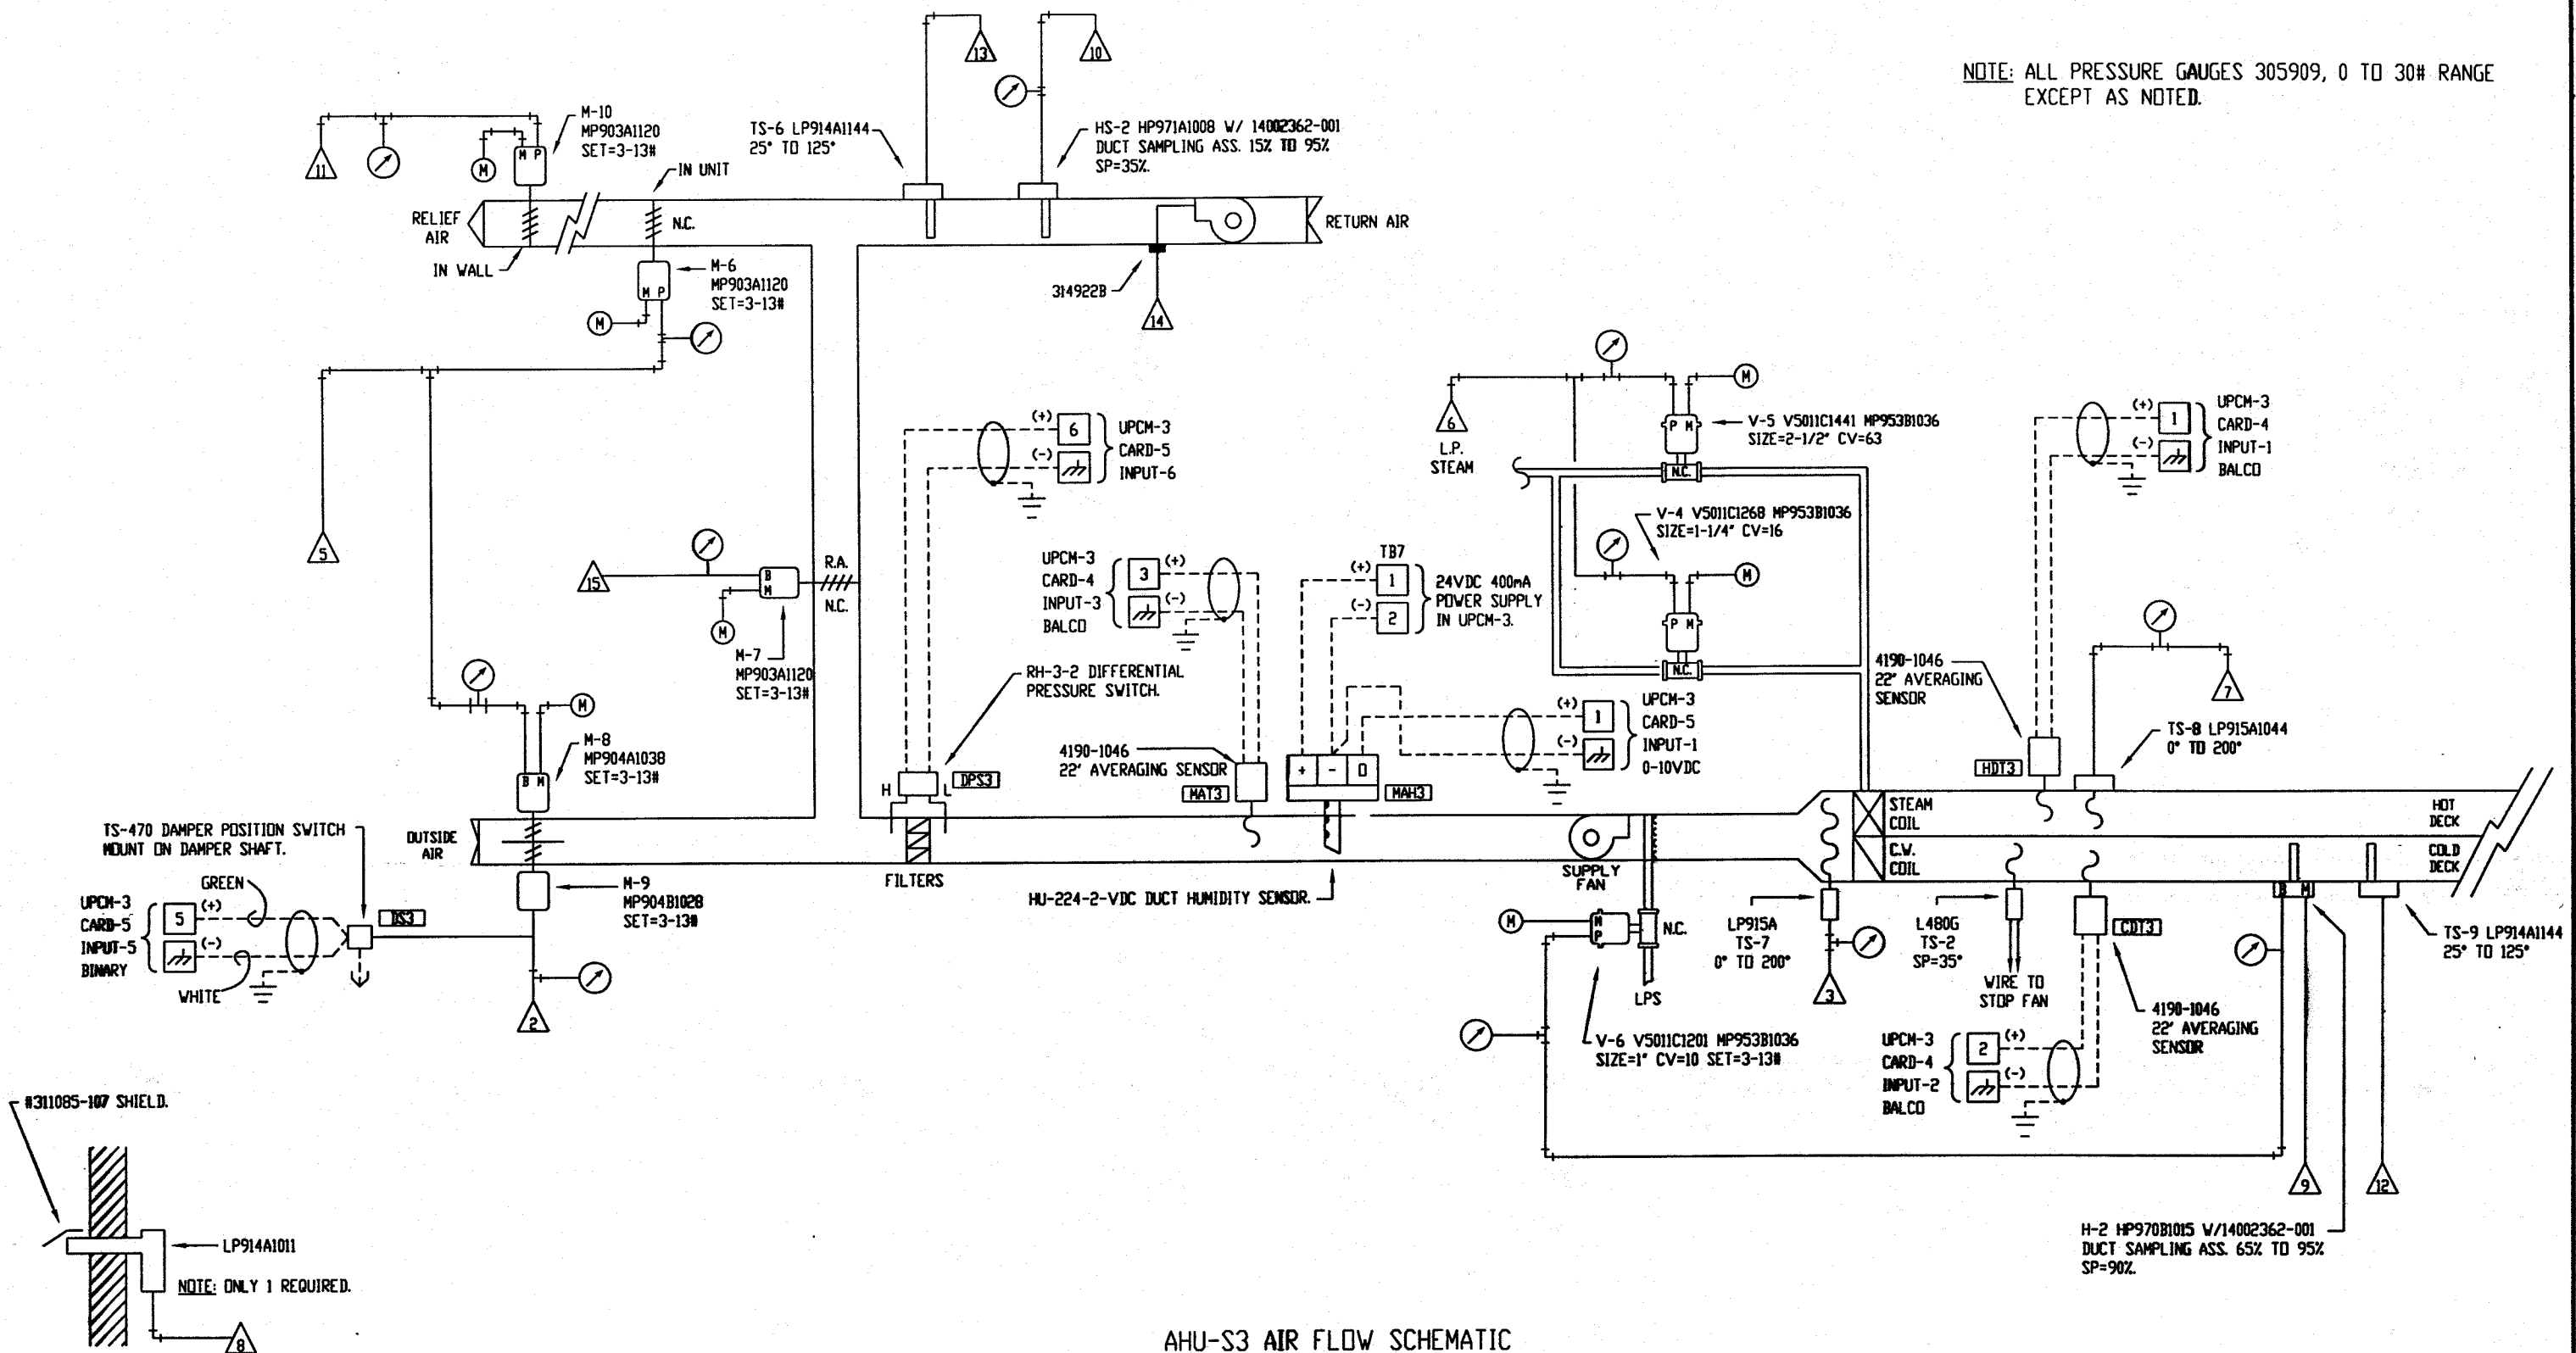

AHU-S3 AIR FLOW SCHEMATIC


LEGEND	
■	THIS COLOR IS INDICATING EXISTING, TO REMAIN AS IS.
■	THIS COLOR IS INDICATING TO BE REMOVED.
■	THIS COLOR IS INDICATING TO BE ABANDONED IN PLACE.
■	THIS COLOR IS INDICATING NEW TO BE ADDED.
(M)	MAIN AIR
*	INDICATES GAUGE MOUNTED ON PANEL FACE.
⊙	CONNECT TO EXISTING

THE DOCUMENTATION HEREIN IS THE EXCLUSIVE PROPERTY OF LAYNE TRANE, CHARLOTTE, N.C. REPRODUCTION AND/OR DISTRIBUTION TO OTHER THAN AUTHORIZED PARTIES IS PROHIBITED.


LAYNE TRANE
 801 PRESSLEY RD
 CHARLOTTE, N.C. 28217
 704 525 3155

REFERENCE DRAWING	REV.	REVISION-LOCATION	DATE	BY


SALES ENGR. CCR	PROJ. MGR. CVF	APPL. ENGR. CVF	DRAWN BY DPC	DATE: 4/2/98
PROJECT NAME: UNCC-McEniry Charlotte, North Carolina				CONTRACT NUMBER: ICS-98014
DRAWING NUMBER: SHEET 20 OF 51				

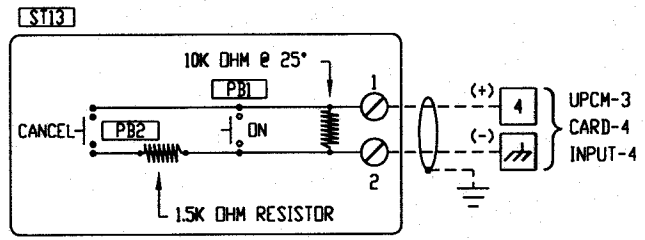


4190-1088 ZONE TEMPERATURE SENSOR LOCATED ON SECOND FLOOR IN CORRIDOR NEAR STAIRWELL 'B'.

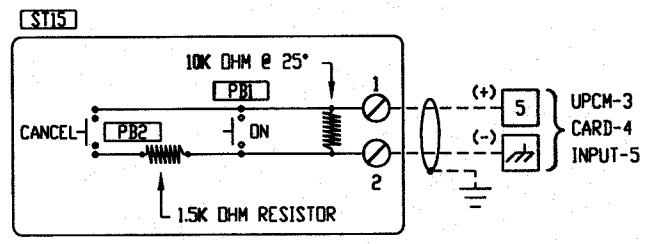

4190-1088 ZONE TEMPERATURE SENSOR LOCATED ON THIRD FLOOR IN CORRIDOR NEAR STAIRWELL 'B'.

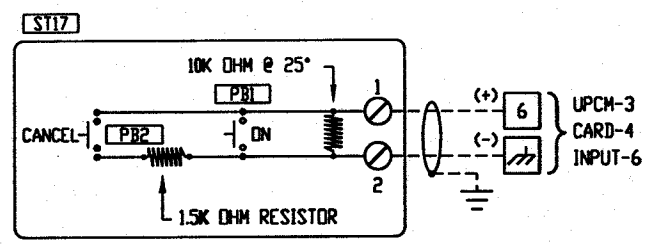

4190-1088 ZONE TEMPERATURE SENSOR LOCATED ON FOURTH FLOOR IN CORRIDOR NEAR STAIRWELL 'B'.

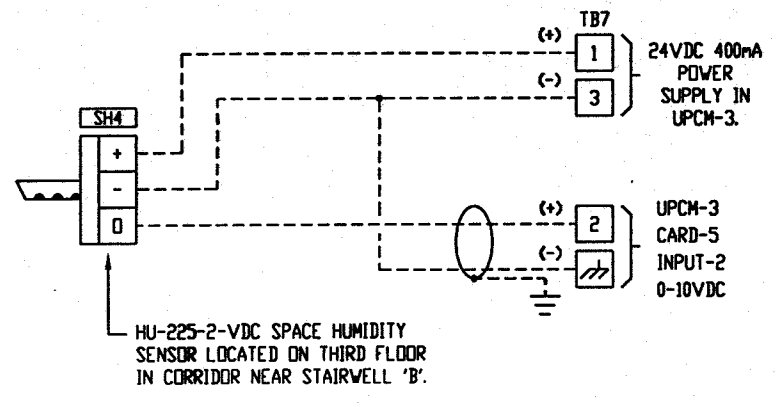


LEGEND	
———	INDICATES FACTORY WIRING
-----	INDICATES FIELD WIRING

THE DOCUMENTATION HEREIN IS THE EXCLUSIVE PROPERTY OF LAYNE TRANE, CHARLOTTE, N.C. REPRODUCTION AND/OR DISTRIBUTION TO OTHER THAN AUTHORIZED PARTIES IS PROHIBITED.

TRANE
 LAYNE TRANE
 801 PRESSLEY RD
 CHARLOTTE, N.C. 28217
 704 525 3155

REFERENCE DRAWING					FILE: WIR-3	
NO.	REVISION-LOCATION	DATE	BY			
SALES ENGR.	PROJ. MGR.	APPL. ENGR.	DRAWN BY			
CCR	CVF	CVF	DPC	DATE: 4/13/98	CONTRACT NUMBER ICS-98014	
PROJECT NAME				DRAWING NUMBER		
UNCC-McEniry Charlotte, North Carolina				SHEET 21 OF 51		

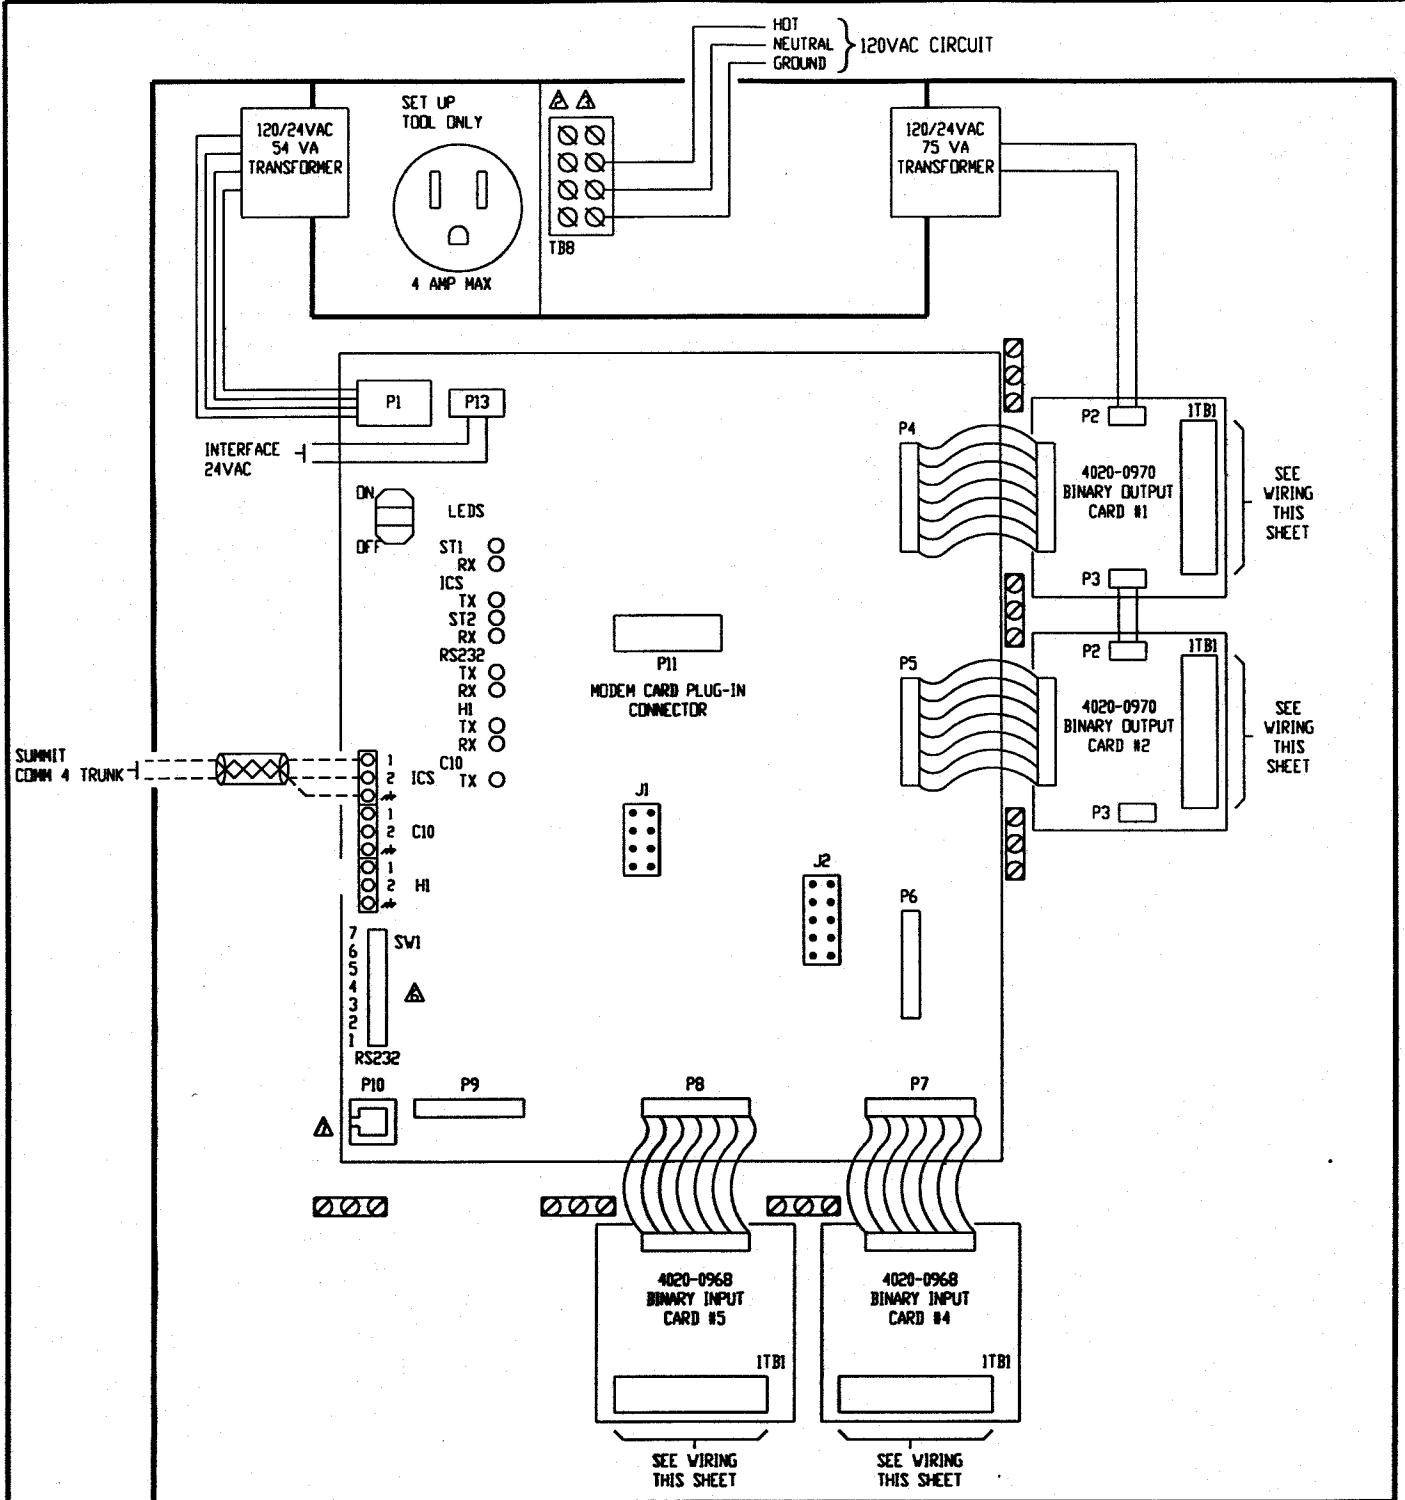


WIRING DIAGRAM NOTES.


- COMPONENTS AND WIRING SHOWN DASHED ARE FURNISHED AND FIELD INSTALLED.
- ALL WIRING MUST BE IN ACCORDANCE WITH NATIONAL ELECTRIC CODES AND LOCAL CODES. GREEN WIRE GROUND MUST BE CONTINUOUS BACK TO CIRCUIT BREAKER PANEL.
- USE COPPER CONDUCTORS ONLY.
 - THE OPTIONAL 24 VAC, 75 VA TRANSFORMER PROVIDES 53 VA FOR BINARY OUTPUT TRIACS AND 22 VA TO THE 24VDC @ 400mA POWER SUPPLY.
 - THE OPTIONAL POWER SUPPLY PROVIDES 24VDC AT 400mA MAXIMUM FOR USE WITH 4 TO 20mA OR 0-10VDC TRANSMITTING SENSORS
 - SWITCH SW1 CONFIGURES UPCM ADDRESS. REFER TO INSTALLATION MANUAL FOR ADDRESS SETUP.
 - POSITION P10 IS AN RJ-12 PLUG FOR RS-232 CONNECTION. REFER TO INSTALLATION MANUAL FOR INFORMATION ON REQUIRED CABLES AND ADAPTERS.
 - BINARY OUTPUTS ARE TRIAC, 24VAC, RATED 12 VA MAX EACH.
 - ANALOG OUTPUTS ARE 0-20mA MAX. 0-10 VDC.
 - UNIVERSAL INPUTS CAN BE INDIVIDUALLY CONFIGURED FOR EITHER ANALOG INPUTS (AIP) OR BINARY INPUT (BIP).

UPCM-4 EXHAUST FANS
BNTU000AAAS4402200000100


- ANALOG INPUT (AIP) WIRING MUST BE SHIELDED, TWISTED PAIR. EACH CONDUCTOR MUST BE STRANDED, TINNED COPPER. RECOMMENDED SIZE IS 18-22 GAUGE AT SENSOR. SHIELD MUST BE CUT BACK AND TAPED. MAXIMUM ANALOG INPUT WIRING DISTANCE IS 300 FT (91 M). ANALOG INPUTS CAN BE THERMISTOR, RTD, 4-20mA OR 0-10VDC.
- BINARY INPUT (BIP) WIRING MUST BE SHIELDED, TWISTED PAIR. EACH CONDUCTOR MUST BE STRANDED, TINNED COPPER. RECOMMENDED SIZE IS 18-22 GAUGE AT SENSOR. SHIELD MUST BE CUT BACK AND TAPED. MAXIMUM BINARY INPUT WIRING DISTANCE IS 1000FT. (305), BINARY INPUTS MUST BE ISOLATED, UNGROUNDED CONTACTS.

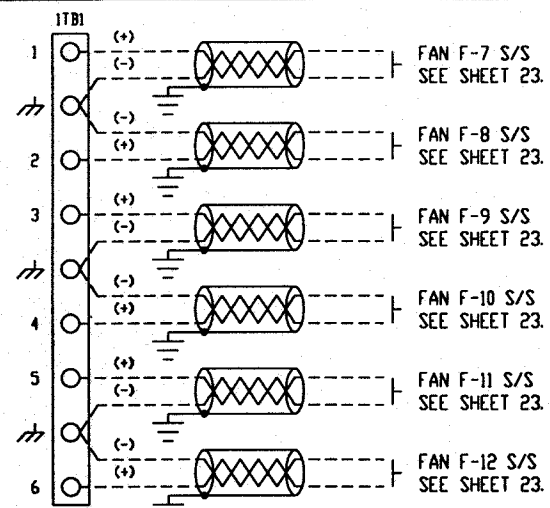


CARD #1 BINARY OUTPUT WIRING

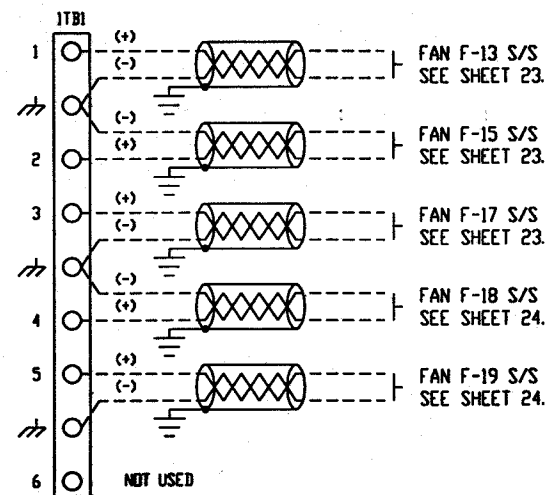


CARD #2 BINARY OUTPUT WIRING

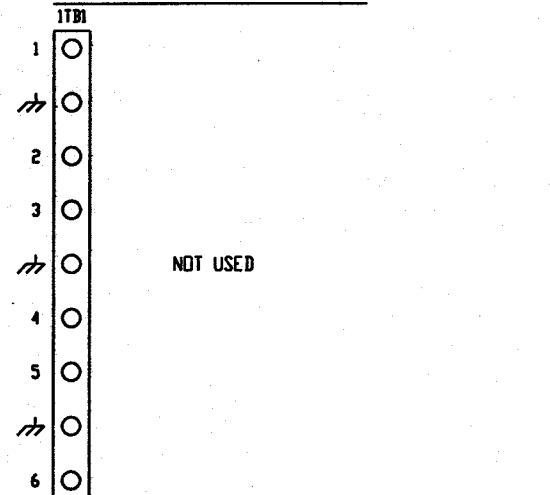


OPEN SLOT

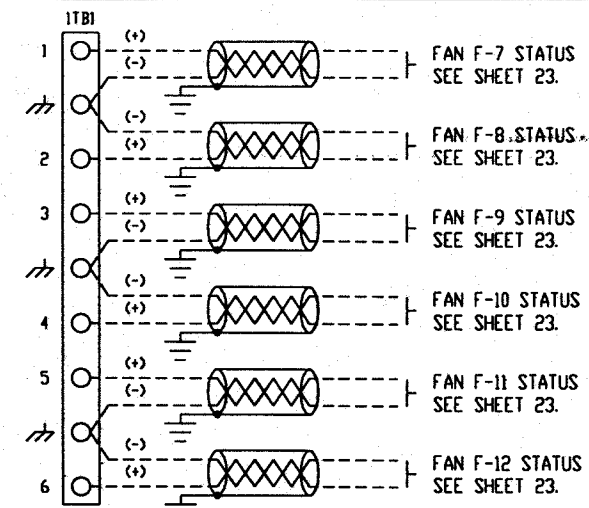

CARD #4 BINARY INPUT WIRING

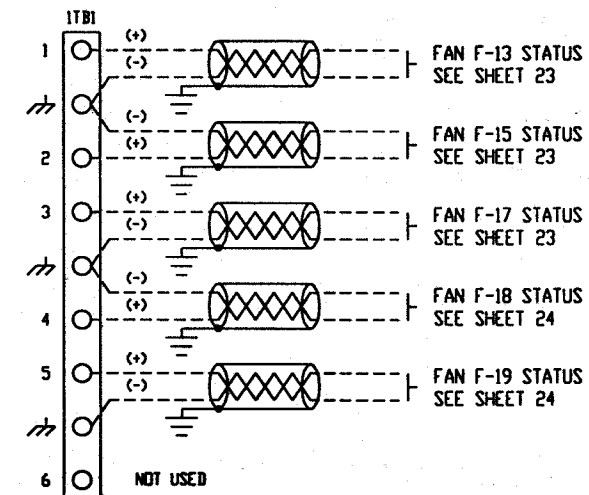

CARD #5 BINARY INPUT WIRING

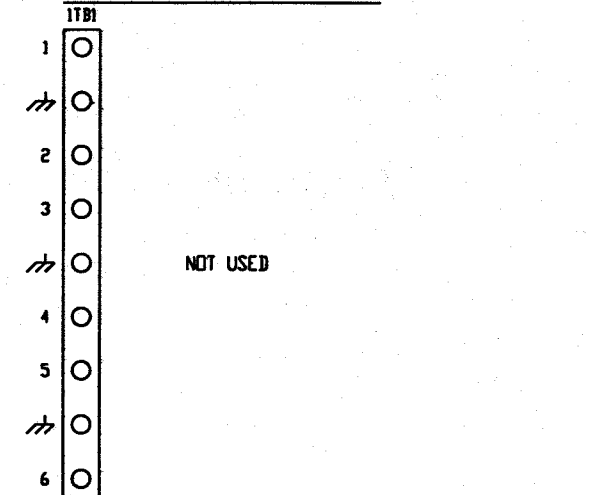

OPEN SLOT

THE DOCUMENTATION HEREIN IS THE EXCLUSIVE PROPERTY OF LAYNE TRANE, CHARLOTTE, N.C. REPRODUCTION AND/OR DISTRIBUTION TO OTHER THAN AUTHORIZED PARTIES IS PROHIBITED.


LAYNE TRANE
801 PRESSLEY RD
CHARLOTTE, N.C. 28217
704 525 3155

REFERENCE DRAWING	NO.	REVISION-LOCATION	DATE	BY


SALES ENGR. CDR
PROJ. MGR. CVF
APPL. ENGR. CVF
DRAWN BY DPC
DATE: 4/6/98

PROJECT NAME
UNCC-McEniry
Charlotte, North Carolina


FILE: UPCM-4
CONTRACT NUMBER
ICS-98014
DRAWING NUMBER
SHEET 22 OF 51

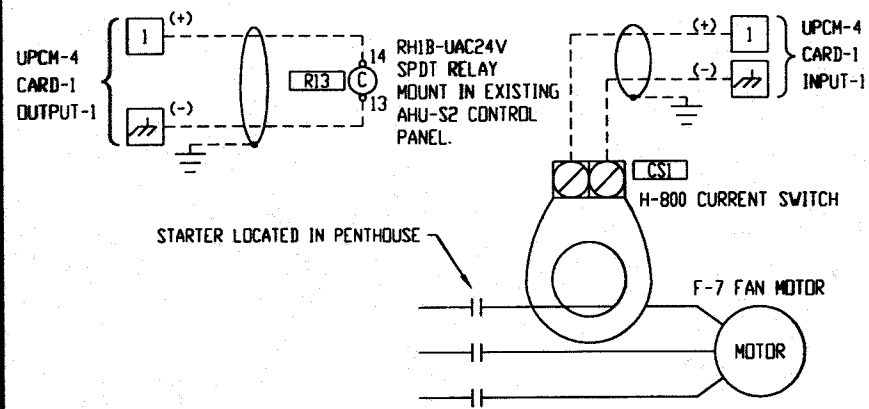


EXHAUST FAN F-7 S/S AND STATUS

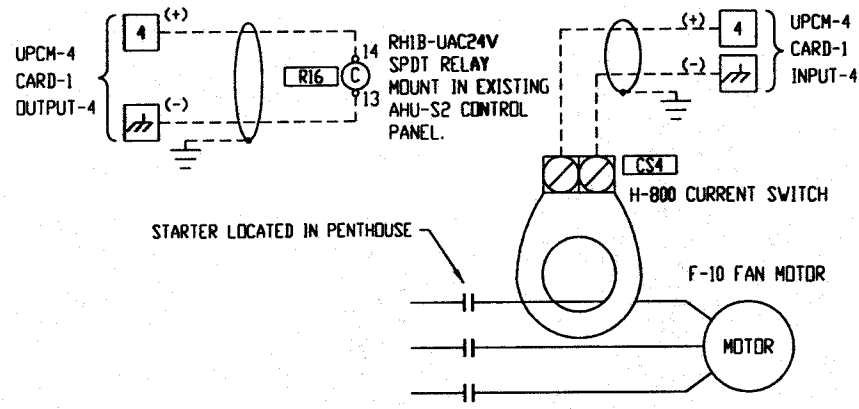


EXHAUST FAN F-10 S/S AND STATUS

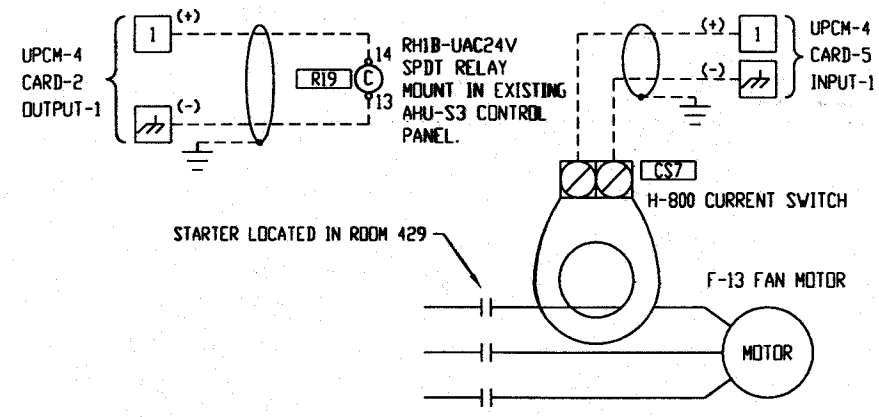


EXHAUST FAN F-13 S/S AND STATUS

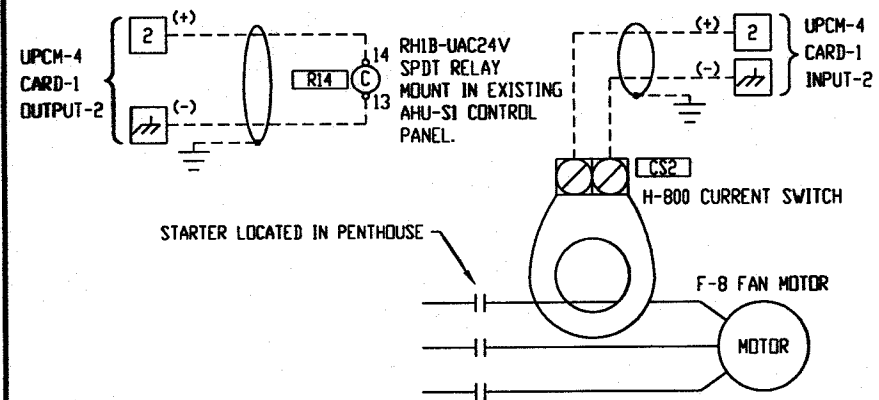


EXHAUST FAN F-8 S/S AND STATUS

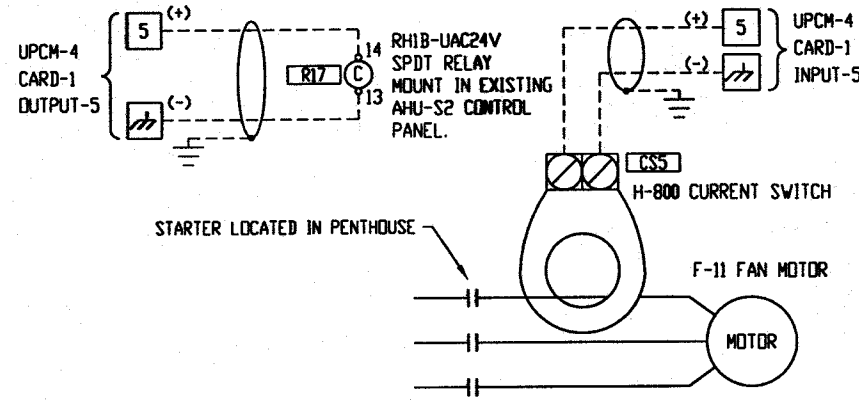


EXHAUST FAN F-11 S/S AND STATUS

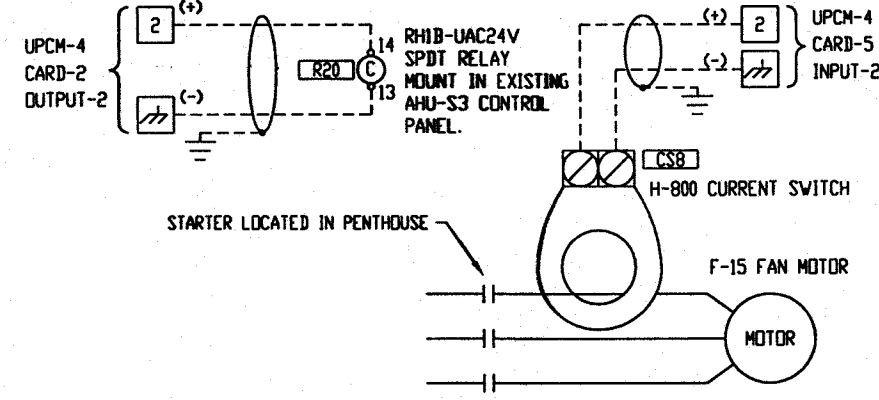


EXHAUST FAN F-15 S/S AND STATUS

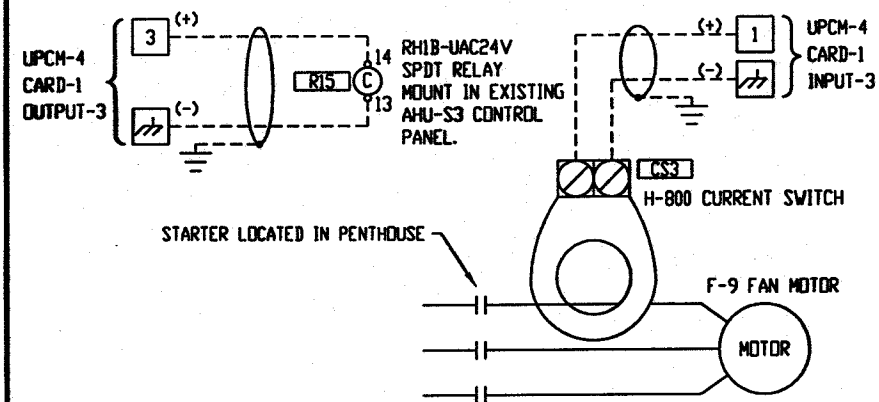

EXHAUST FAN F-9 S/S AND STATUS

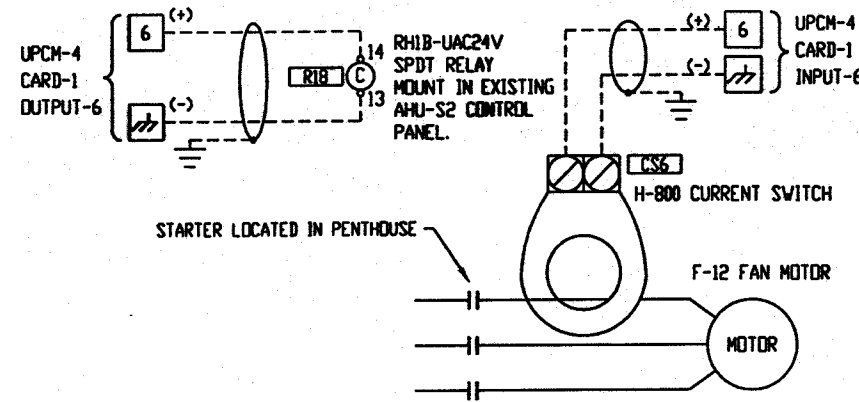

EXHAUST FAN F-12 S/S AND STATUS

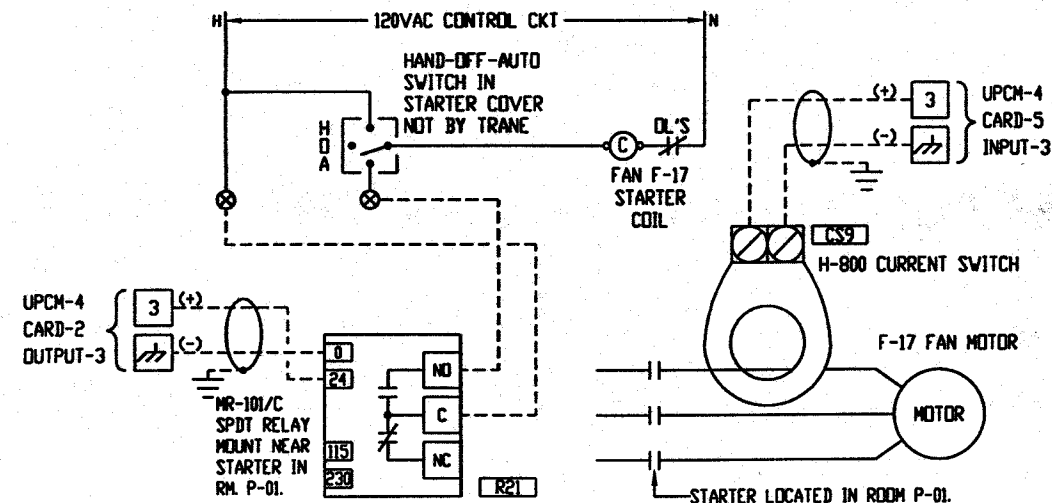

EXHAUST FAN F-17 S/S AND STATUS


LEGEND

- INDICATES EXISTING WIRING
- - - INDICATES FIELD WIRING


THE DOCUMENTATION HEREIN IS THE EXCLUSIVE PROPERTY OF LAYNE TRANE, CHARLOTTE, N.C. REPRODUCTION AND/OR DISTRIBUTION TO OTHER THAN AUTHORIZED PARTIES IS PROHIBITED.

TRANE
 LAYNE TRANE
 801 PRESSLEY RD
 CHARLOTTE, N.C. 28217
 704 525 3155

REFERENCE DRAWING	NO.	REVISION-LOCATION	DATE	BY
SALES ENGR. CCR	PROJ. MGR. CVF	APPL. ENGR. CVF	DRAWN BY DPC	DATE: 4/7/98
PROJECT NAME				CONTRACT NUMBER
UNCC-McEniry				ICS-98014
Charlotte, North Carolina				DRAWING NUMBER
				SHEET 23 OF 51

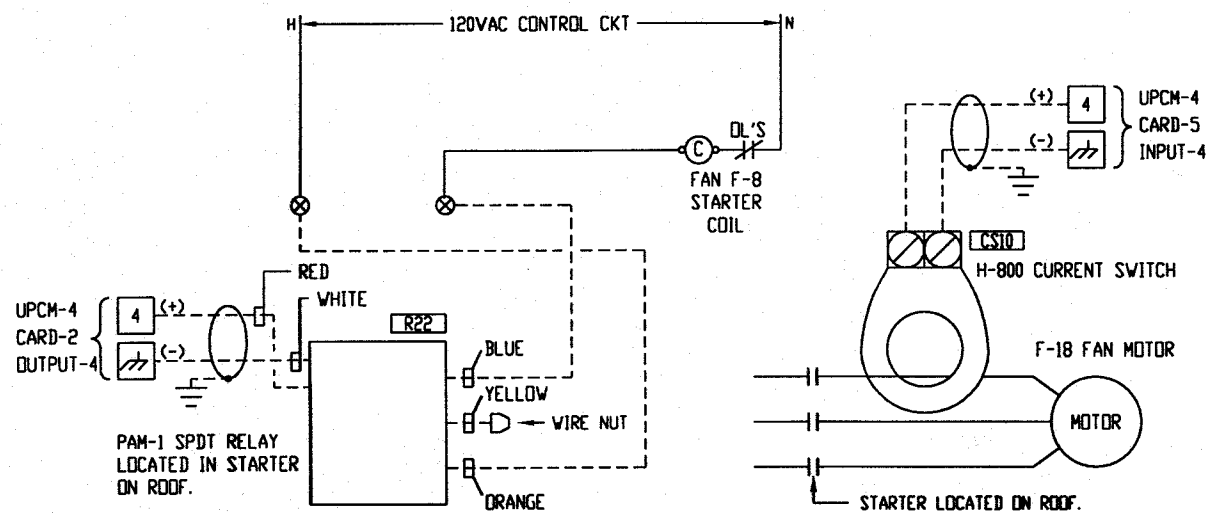

EXHAUST FAN F-8 S/S AND STATUS

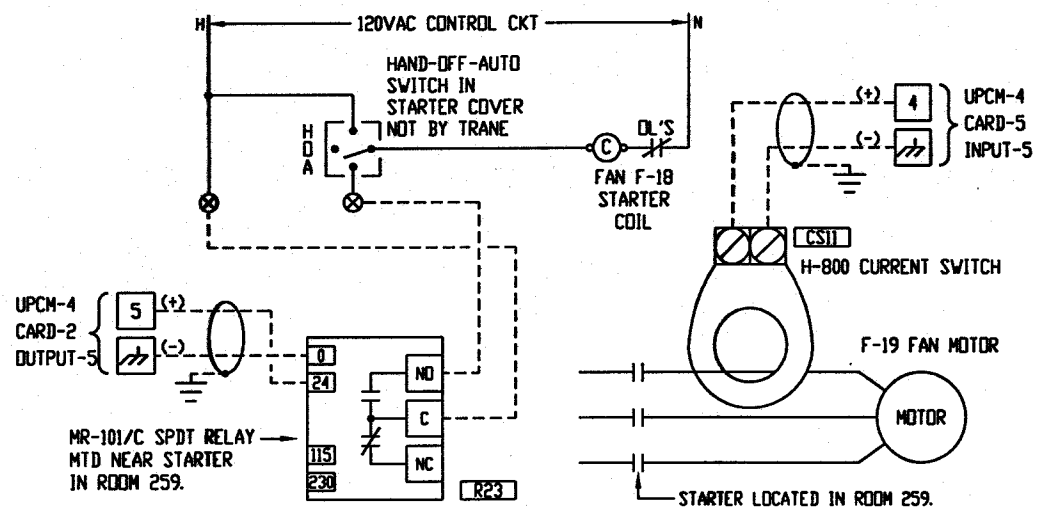

EXHAUST FAN F-19 S/S AND STATUS


LEGEND	
—	INDICATES FACTORY WIRING
- - -	INDICATES FIELD WIRING

THE DOCUMENTATION HEREIN IS THE EXCLUSIVE PROPERTY OF LAYNE TRANE, CHARLOTTE, N.C. REPRODUCTION AND/OR DISTRIBUTION TO OTHER THAN AUTHORIZED PARTIES IS PROHIBITED.

TRANE
 LAYNE TRANE
 801 PRESSLEY RD
 CHARLOTTE, N.C. 28217
 704 525 3155

REFERENCE DRAWING	NO.	REVISION-LOCATION	DATE	BY

SALES ENGR. CCR	PROJ. MGR. CVF	APPL. ENGR. CVF	DRAWN BY DPC	DATE: 4/13/98
PROJECT NAME UNCC-McEniry Charlotte, North Carolina				CONTRACT NUMBER ICS-98014 DRAWING NUMBER SHEET 24 OF 51

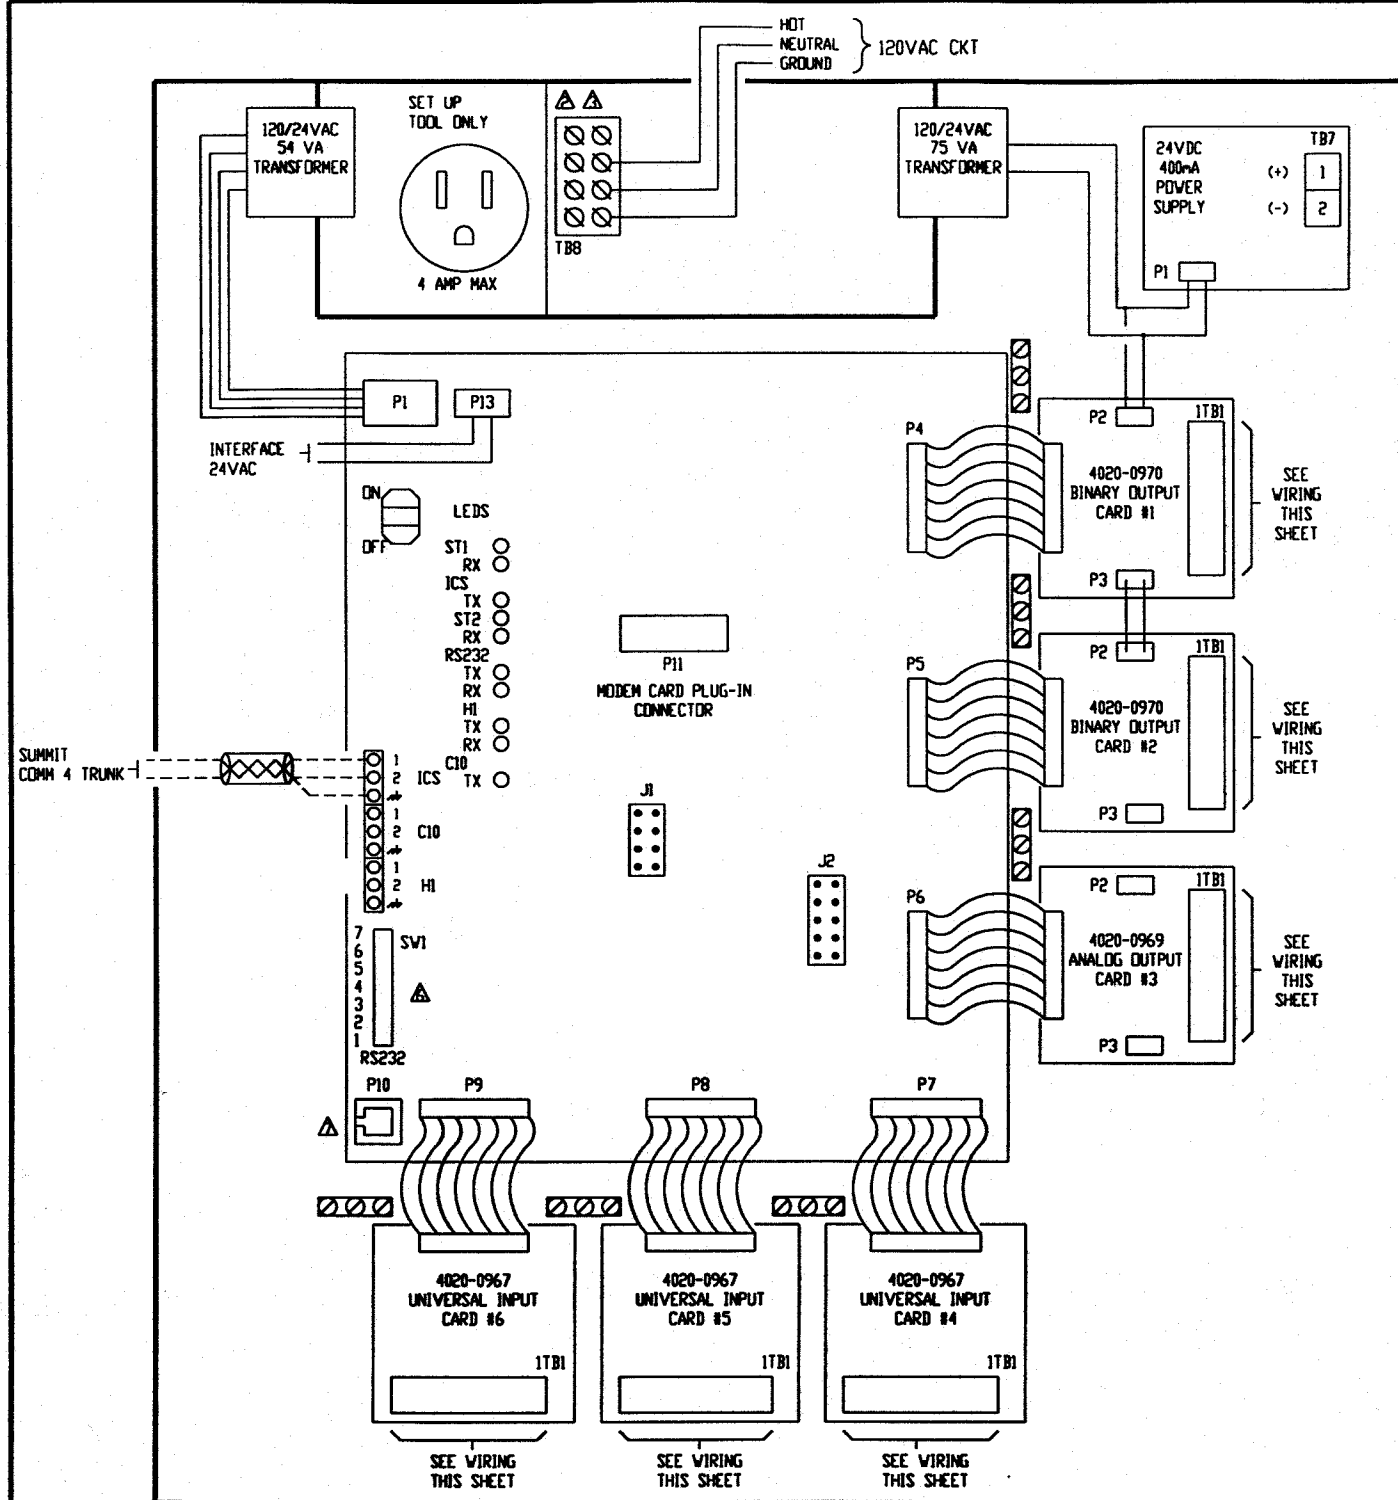


WIRING DIAGRAM NOTES.


- COMPONENTS AND WIRING SHOWN DASHED ARE FURNISHED AND FIELD INSTALLED.
- ALL WIRING MUST BE IN ACCORDANCE WITH NATIONAL ELECTRIC CODES AND LOCAL CODES. GREEN WIRE GROUND MUST BE CONTINUOUS BACK TO CIRCUIT BREAKER PANEL.
- USE COPPER CONDUCTORS ONLY.
 - THE OPTIONAL 24 VAC, 75 VA TRANSFORMER PROVIDES 53 VA FOR BINARY OUTPUT TRIACS AND 22 VA TO THE 24VDC @ 400mA POWER SUPPLY.
 - THE OPTIONAL POWER SUPPLY PROVIDES 24VDC AT 400mA MAXIMUM FOR USE WITH 4 TO 20mA OR 0-10VDC TRANSMITTING SENSORS
 - SWITCH SW1 CONFIGURES UPCM ADDRESS. REFER TO INSTALLATION MANUAL FOR ADDRESS SETUP.
 - POSITION P10 IS AN RJ-12 PLUG FOR RS-232 CONNECTION. REFER TO INSTALLATION MANUAL FOR INFORMATION ON REQUIRED CABLES AND ADAPTERS.
 - BINARY OUTPUTS ARE TRIAC, 24VAC, RATED 12 VA MAX EACH.
 - ANALOG OUTPUTS ARE 0-20mA MAX. 0-10 VDC.
 - UNIVERSAL INPUTS CAN BE INDIVIDUALLY CONFIGURED FOR EITHER ANALOG INPUTS (AIP) OR BINARY INPUT (BIP).

UCPM-5 PLANT
BMTU000AAAS4431110000200


- ANALOG INPUT (AIP) WIRING MUST BE SHIELDED, TWISTED PAIR. EACH CONDUCTOR MUST BE STRANDED, TINNED COPPER. RECOMMENDED SIZE IS 18-22 GAUGE AT SENSOR. SHIELD MUST BE CUT BACK AND TAPED. MAXIMUM ANALOG INPUT WIRING DISTANCE IS 300 FT (91 M). ANALOG INPUTS CAN BE THERMISTOR, RTD, 4-20mA OR 0-10VDC.
- BINARY INPUT (BIP) WIRING MUST BE SHIELDED, TWISTED PAIR. EACH CONDUCTOR MUST BE STRANDED, TINNED COPPER. RECOMMENDED SIZE IS 18-22 GAUGE AT SENSOR. SHIELD MUST BE CUT BACK AND TAPED. MAXIMUM BINARY INPUT WIRING DISTANCE IS 1000FT. (305), BINARY INPUTS MUST BE ISOLATED, UNGROUNDED CONTACTS.

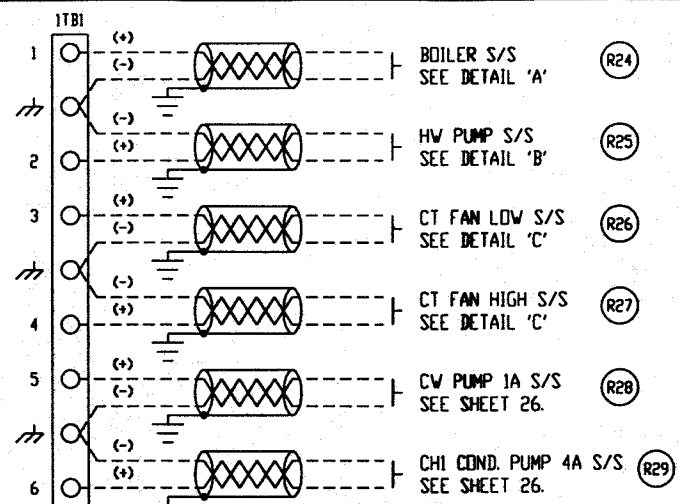


CARD #1 BINARY OUTPUT WIRING

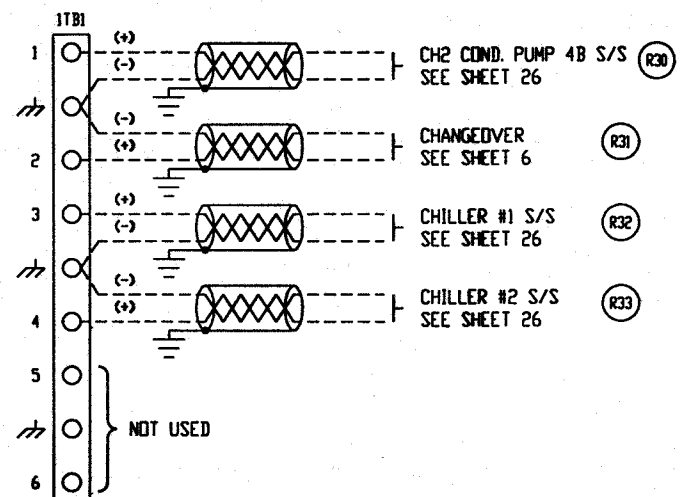


CARD #2 BINARY OUTPUT WIRING

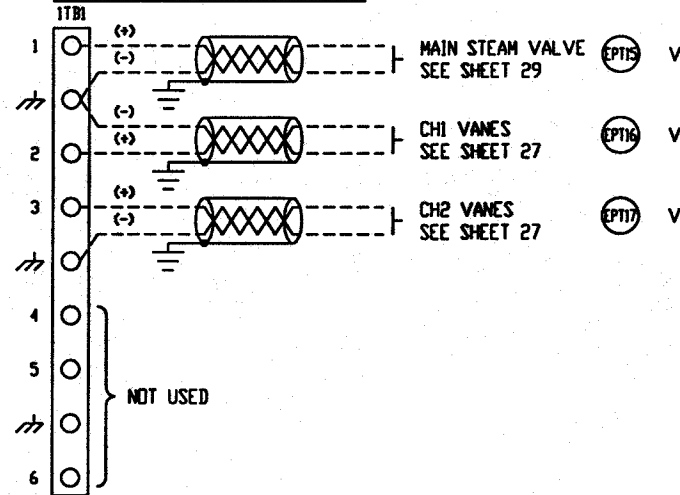


CARD #3 ANALOG OUTPUT WIRING

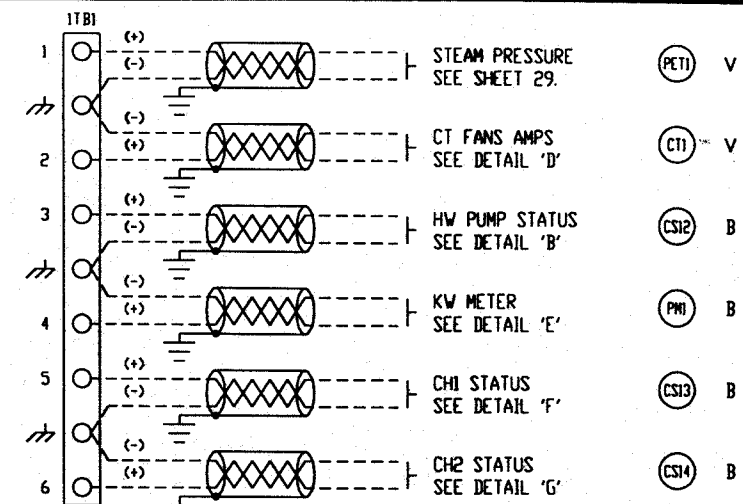

CARD #4 UNIVERSAL INPUT WIRING

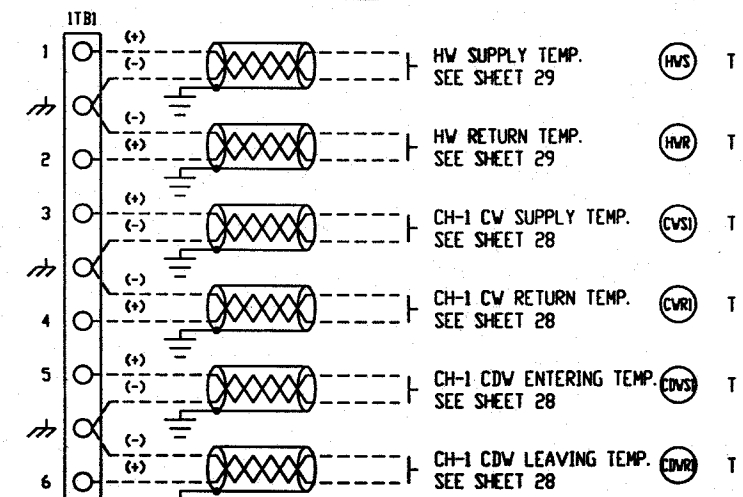

CARD #5 UNIVERSAL INPUT WIRING

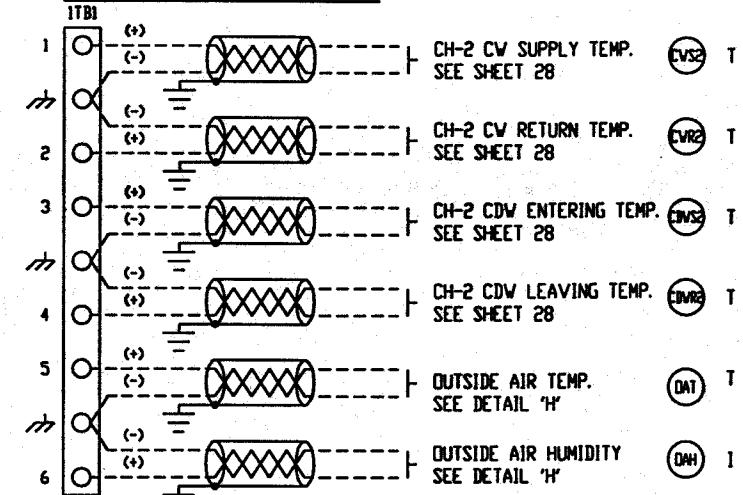

CARD #6 UNIVERSAL INPUT WIRING

THE DOCUMENTATION HEREIN IS THE EXCLUSIVE PROPERTY OF LAYNE TRANE, CHARLOTTE, N.C. REPRODUCTION AND/OR DISTRIBUTION TO OTHER THAN AUTHORIZED PARTIES IS PROHIBITED.


TRANE
LAYNE TRANE
801 PRESSLEY RD
CHARLOTTE, N.C. 28217
704 525 3155

REFERENCE DRAWING	NO.	REVISION-LOCATION	DATE	BY


SALES ENGR. CCR PROJ. MGR. CVF APPL. ENGR. CVF DRAWN BY DPC DATE: 4/6/98

PROJECT NAME: UNCC-McEniry, Charlotte, North Carolina


CONTRACT NUMBER: ICS-98014
DRAWING NUMBER: SHEET 25 OF 51

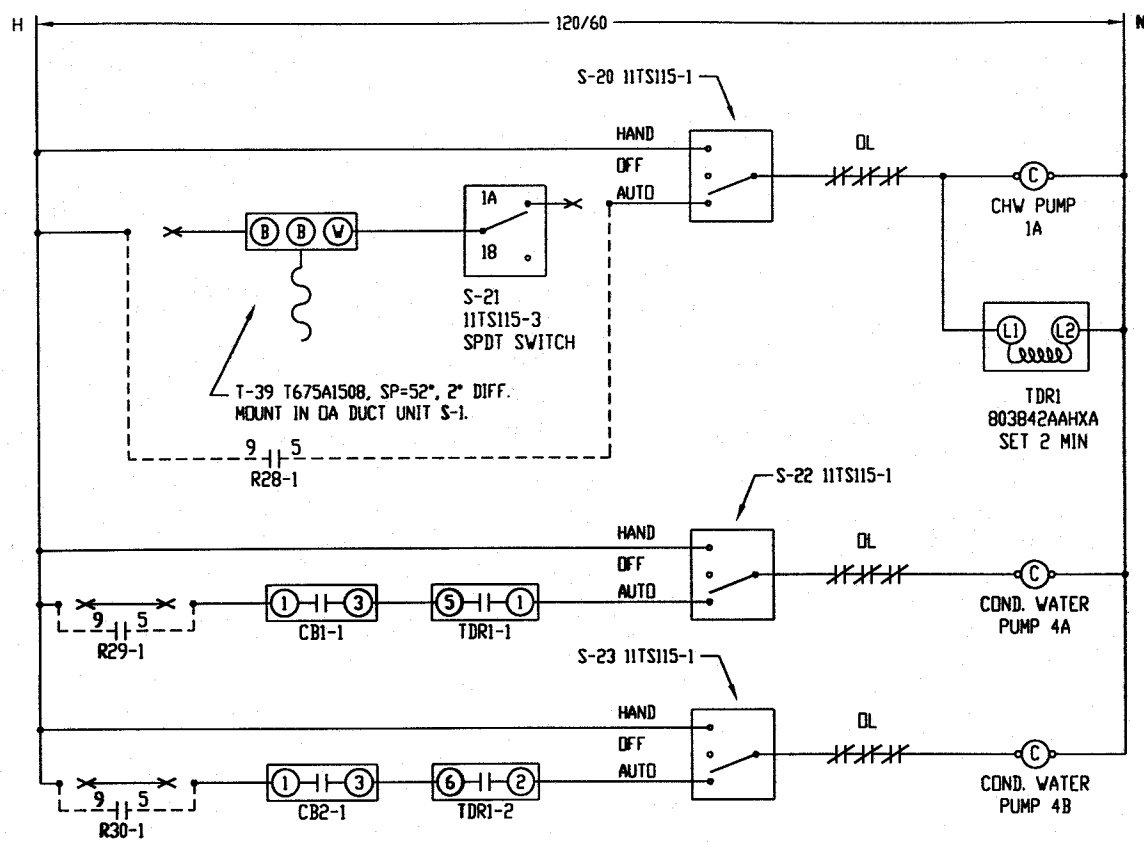


CHILL WATER & CONDENSER WATER PUMP CONTROL WIRING

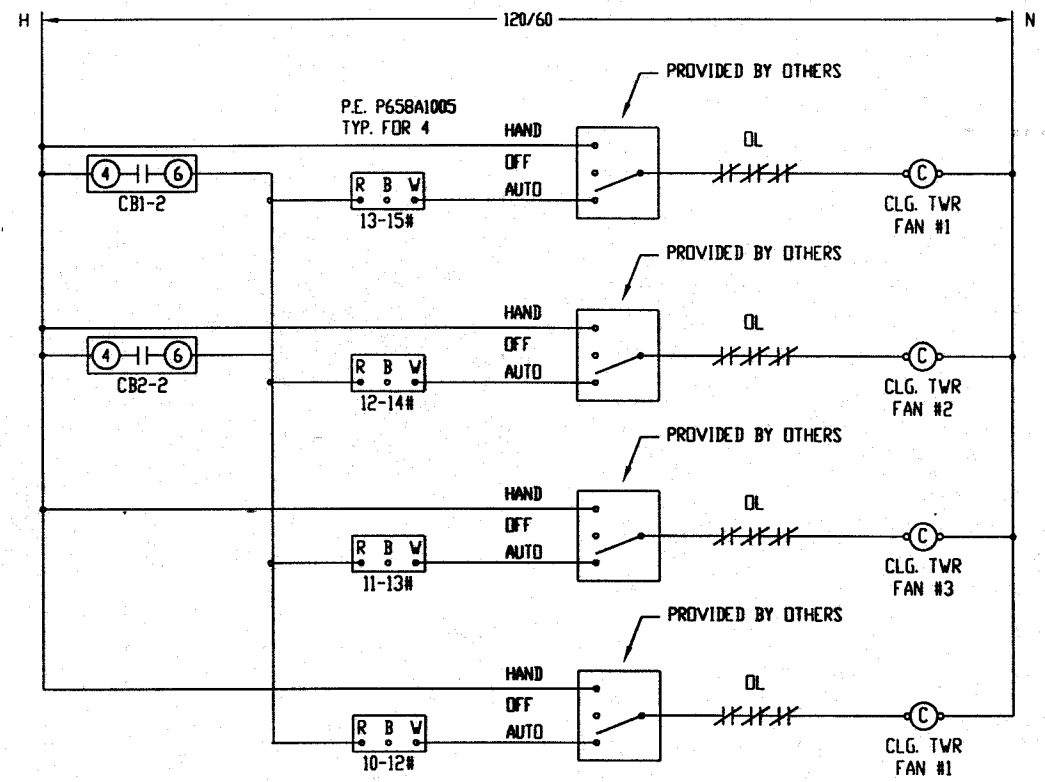

COOLING TOWER FAN CONTROL WIRING

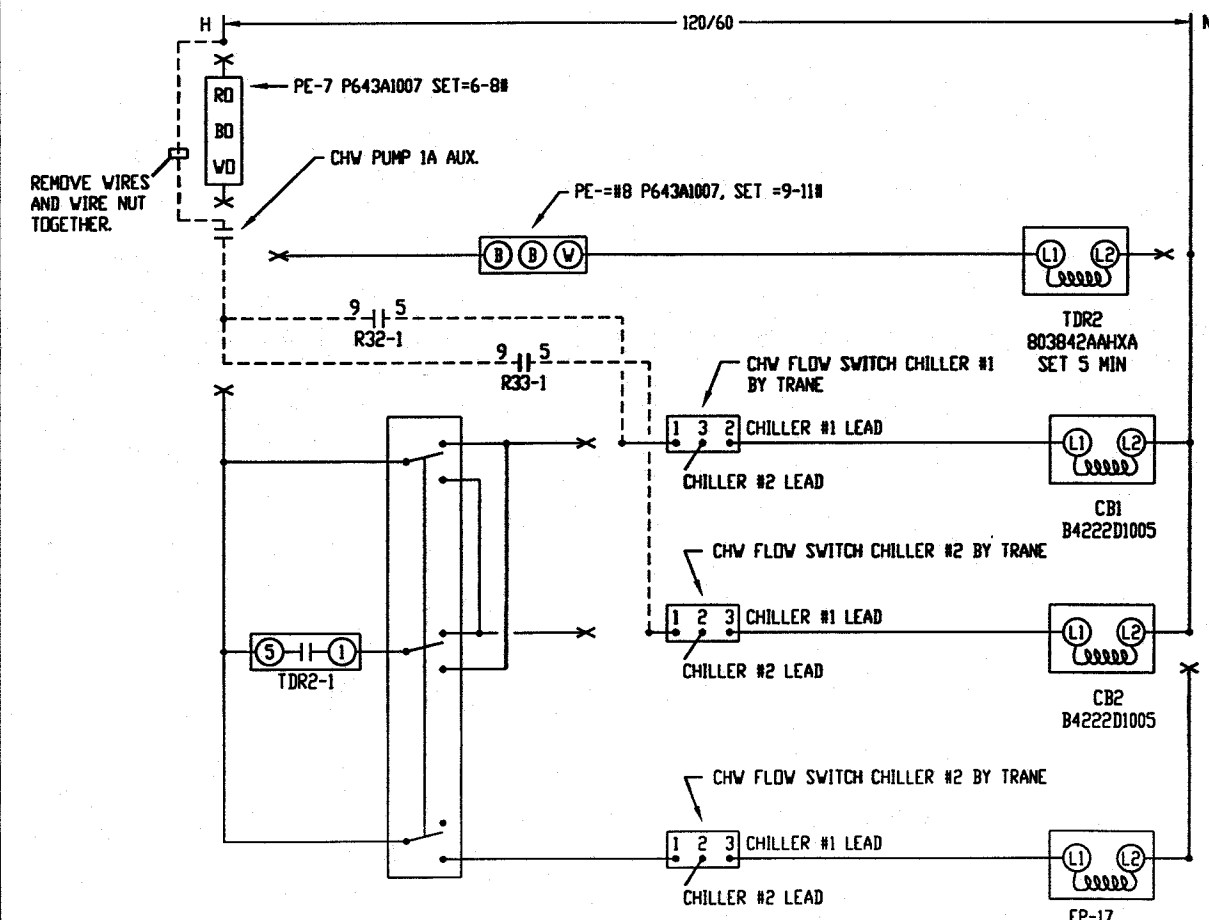

LEAD-LAG CONTROL FOR SEQUENCING CHILLERS

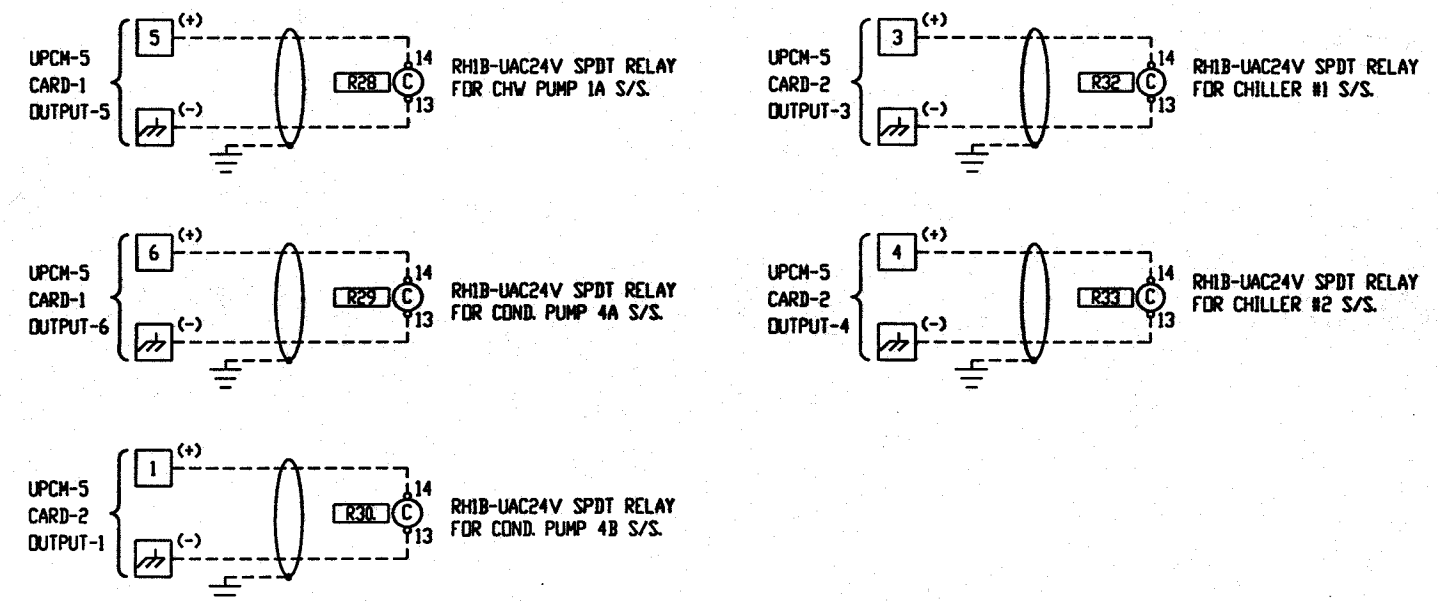

LEGEND


—	INDICATES FACTORY WIRING
- - -	INDICATES FIELD WIRING


THE DOCUMENTATION HEREIN IS THE EXCLUSIVE PROPERTY OF LAYNE TRANE, CHARLOTTE, N.C. REPRODUCTION AND/OR DISTRIBUTION TO OTHER THAN AUTHORIZED PARTIES IS PROHIBITED.

TRANE
 LAYNE TRANE
 801 PRESSLEY RD
 CHARLOTTE, N.C. 28217
 704 525 3155

REFERENCE DRAWING	NO.	REVISION-LOCATION	DATE	BY

SALES ENGR. CCR	PROJ. MGR. CVF	APPL. ENGR. CVF	DRAWN BY DPC	DATE: 4/6/98
PROJECT NAME UNCC-McEniry Charlotte, North Carolina				CONTRACT NUMBER ICS-98014 DRAWING NUMBER SHEET 26 OF 51

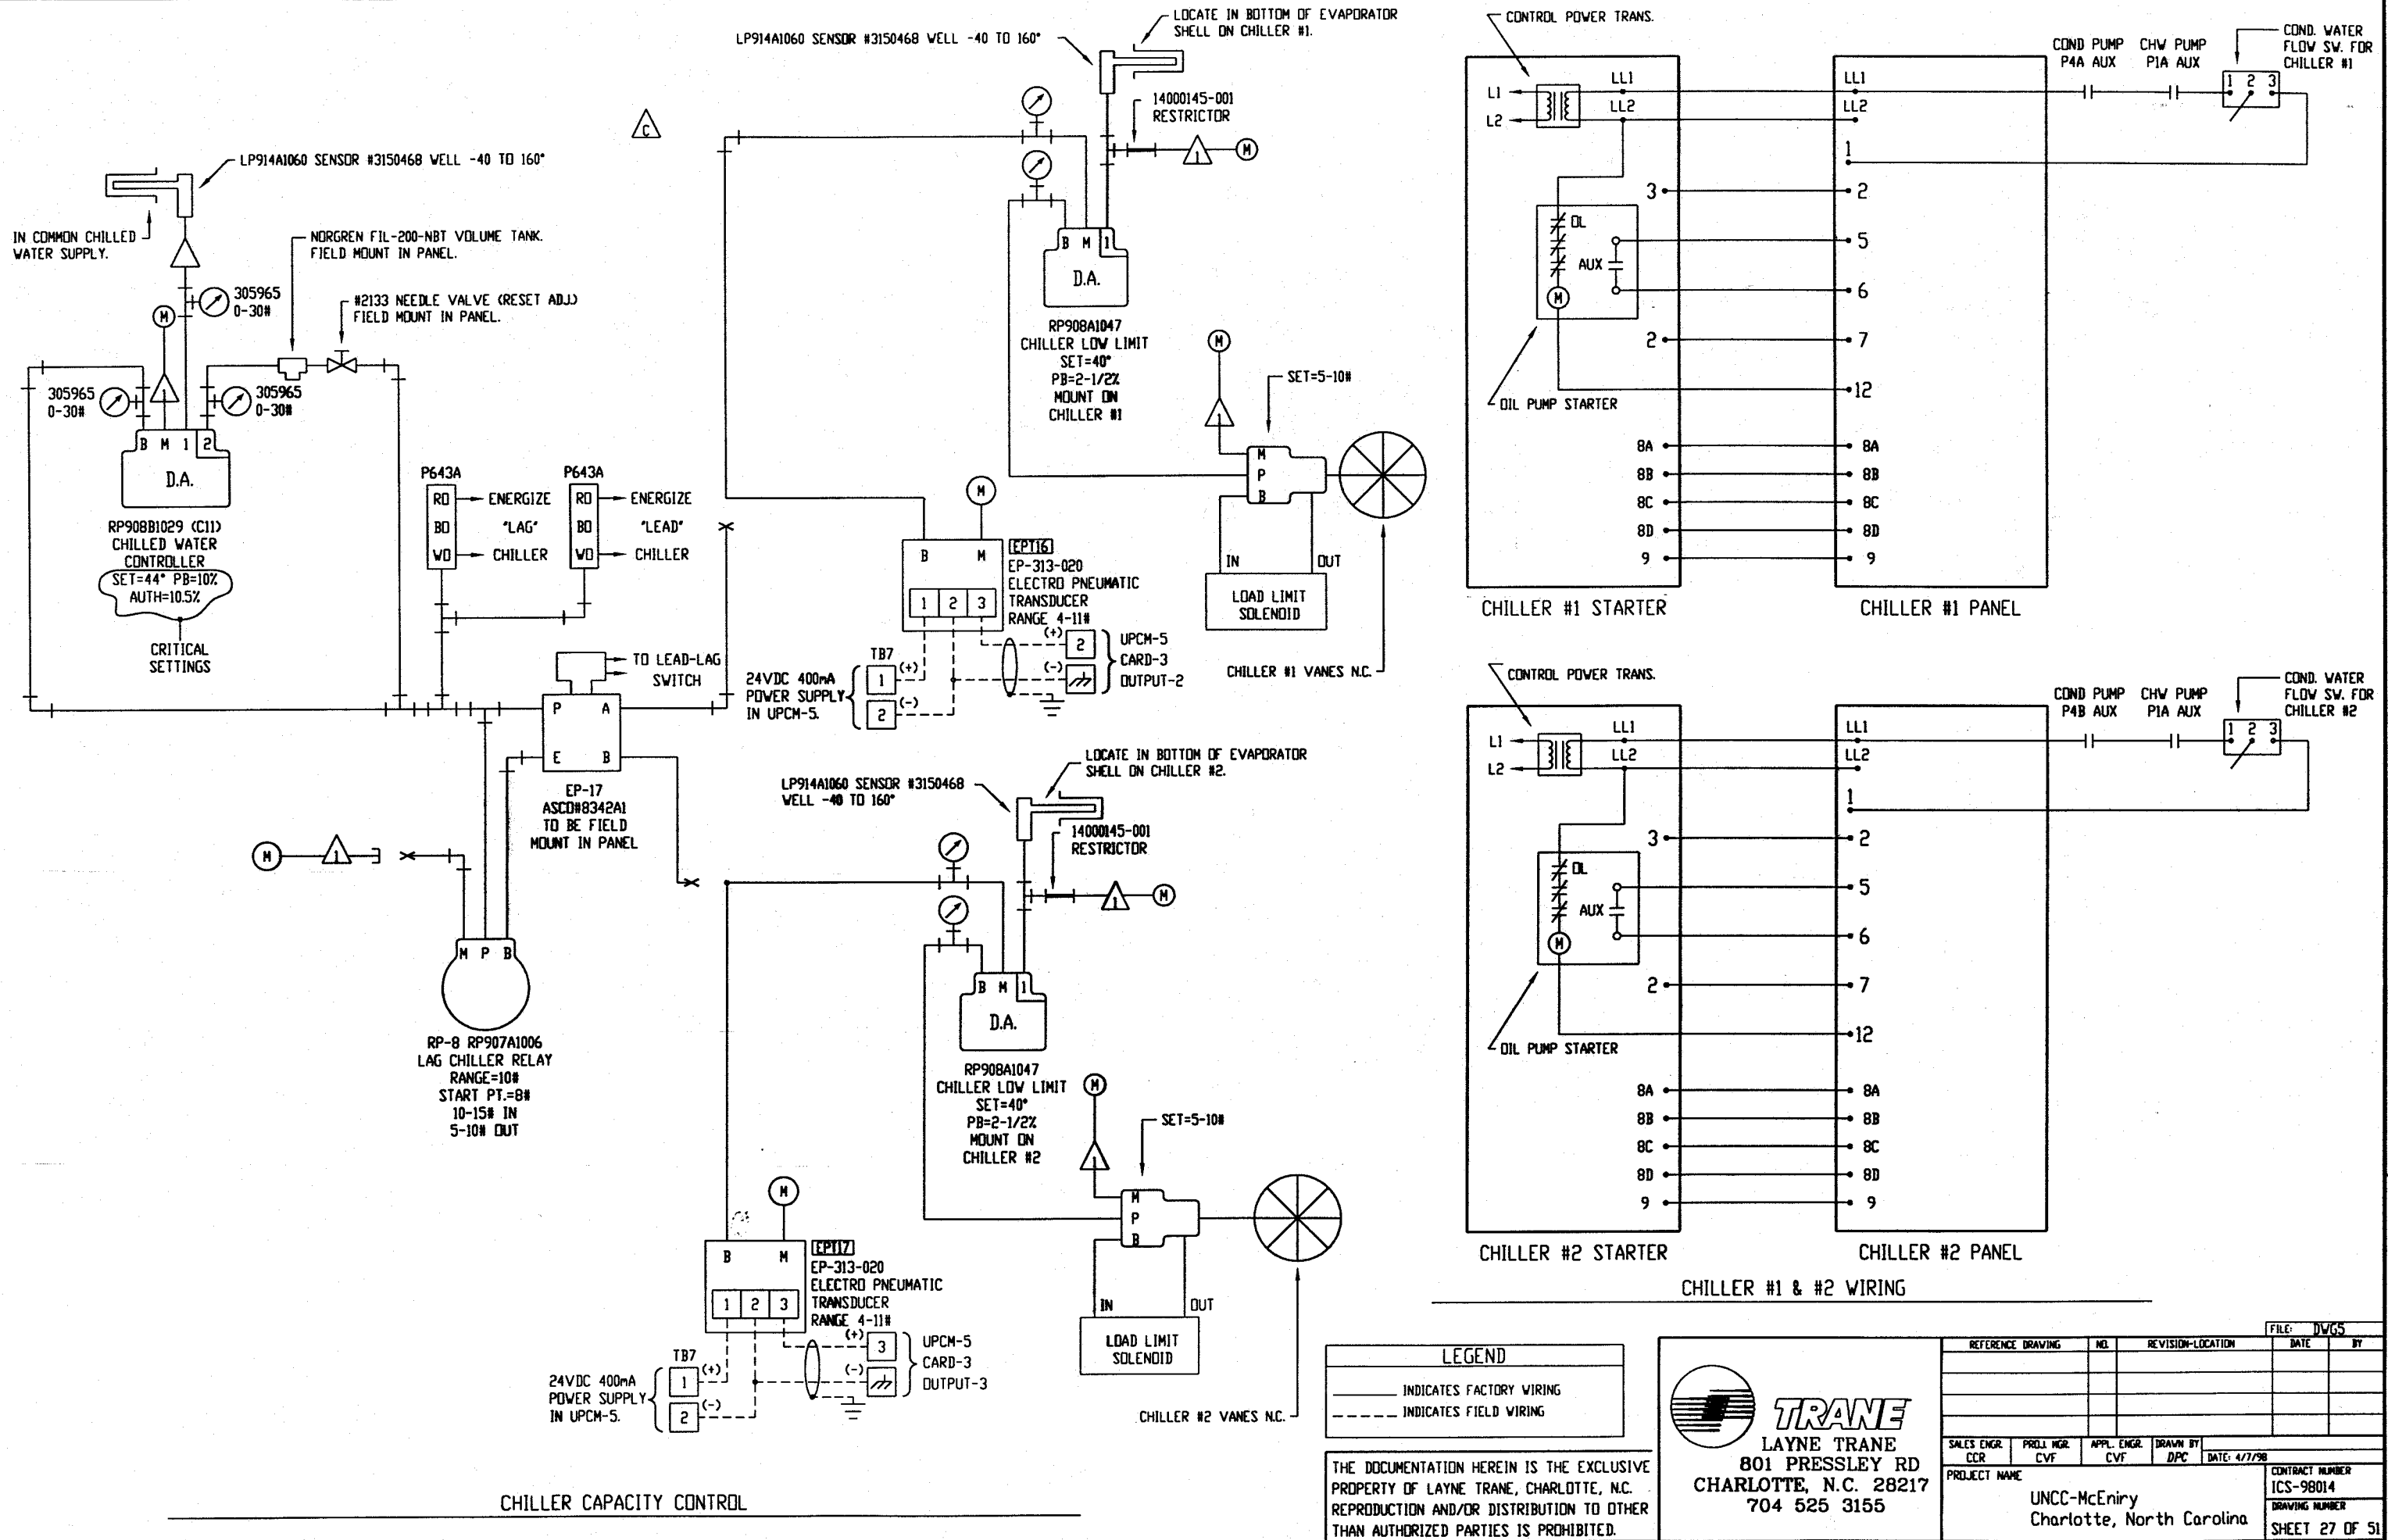

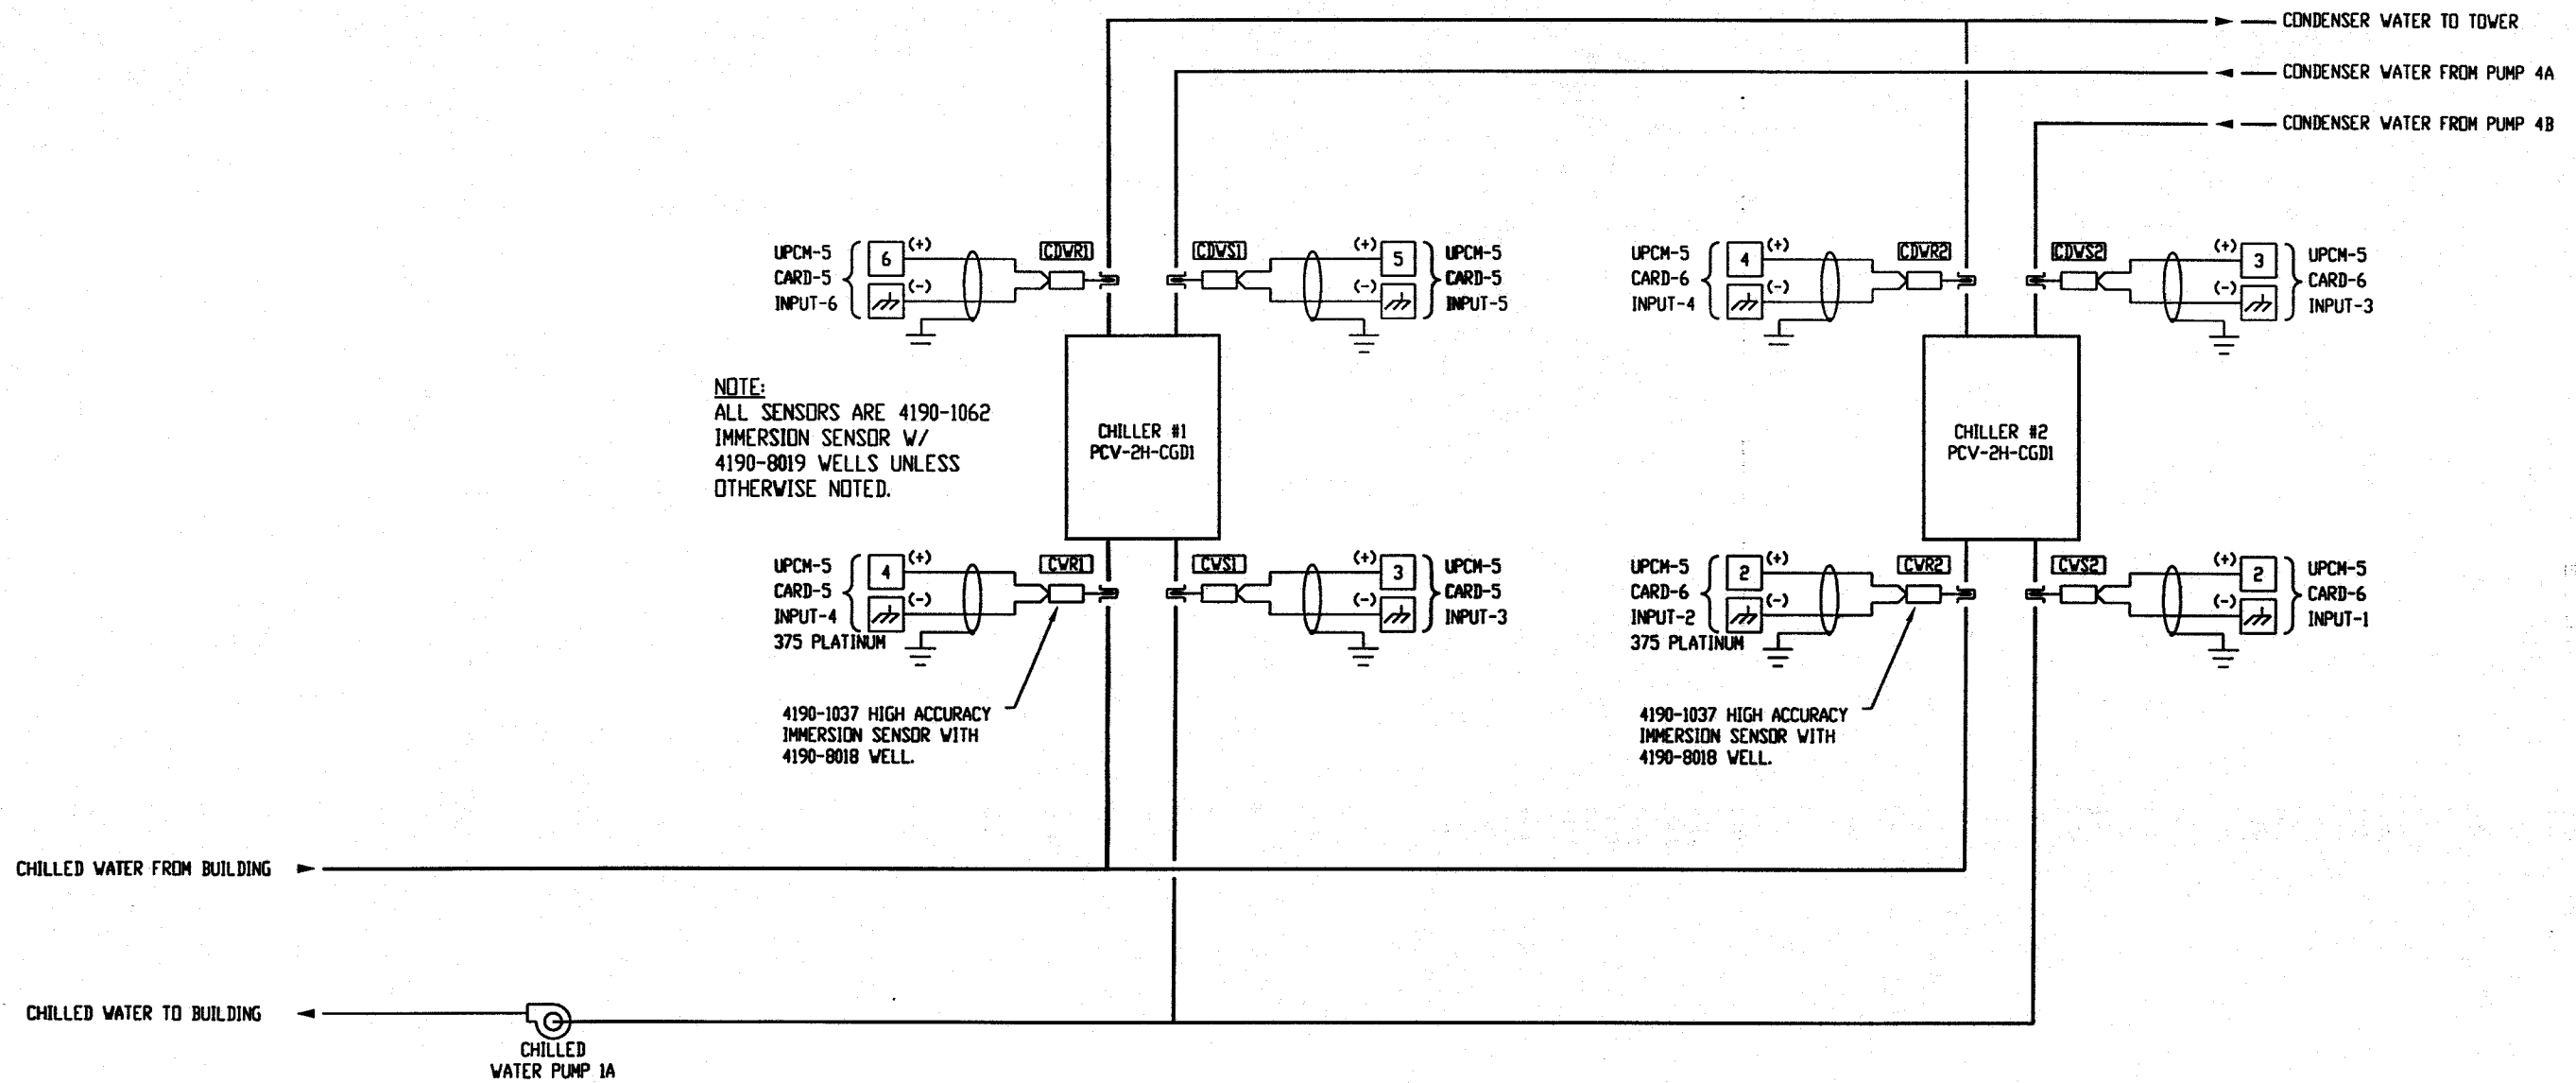

CHILLER PIPING SCHEMATIC

LEGEND	
—	INDICATES EXISTING WIRING
- - -	INDICATES FIELD WIRING

THE DOCUMENTATION HEREIN IS THE EXCLUSIVE PROPERTY OF LAYNE TRANE, CHARLOTTE, N.C. REPRODUCTION AND/OR DISTRIBUTION TO OTHER THAN AUTHORIZED PARTIES IS PROHIBITED.




LAYNE TRANE
 801 PRESSLEY RD
 CHARLOTTE, N.C. 28217
 704 525 3155


REFERENCE DRAWING	NO.	REVISION-LOCATION	DATE	FILE: MECH	BY

SALES ENGR.	PROJ. MGR.	APPL. ENGR.	DRAWN BY	DATE
CCR	CVF	CVF	DPC	4/13/98


PROJECT NAME	CONTRACT NUMBER
UNCC-McEniry Charlotte, North Carolina	ICS-98014
	DRAWING NUMBER
	SHEET 28 OF 51

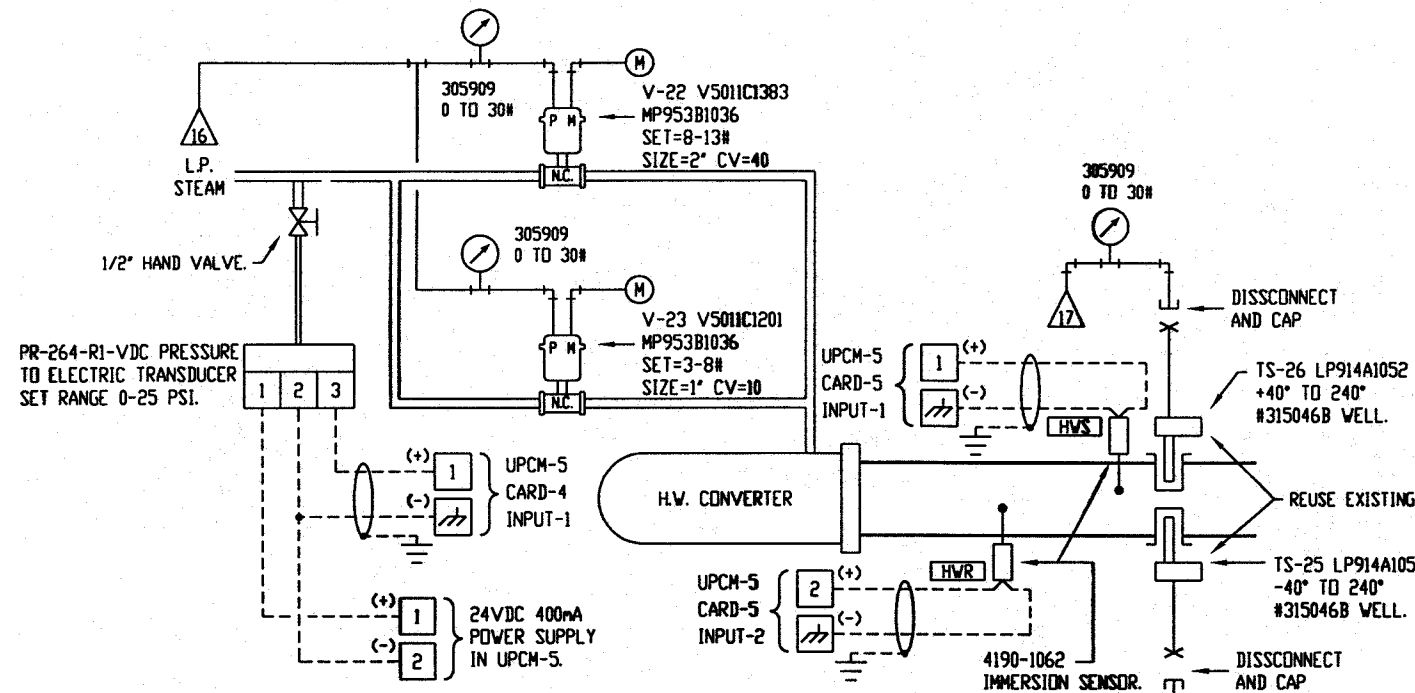


LEGEND	
■	THIS COLOR IS INDICATING EXISTING, TO REMAIN AS IS.
■	THIS COLOR IS INDICATING TO BE REMOVED.
■	THIS COLOR IS INDICATING TO BE ABANDONED IN PLACE.
■	THIS COLOR IS INDICATING NEW TO BE ADDED.
(M)	MAIN AIR
*	INDICATES GAUGE MOUNTED ON PANEL FACE.
⊕	CONNECT TO EXISTING

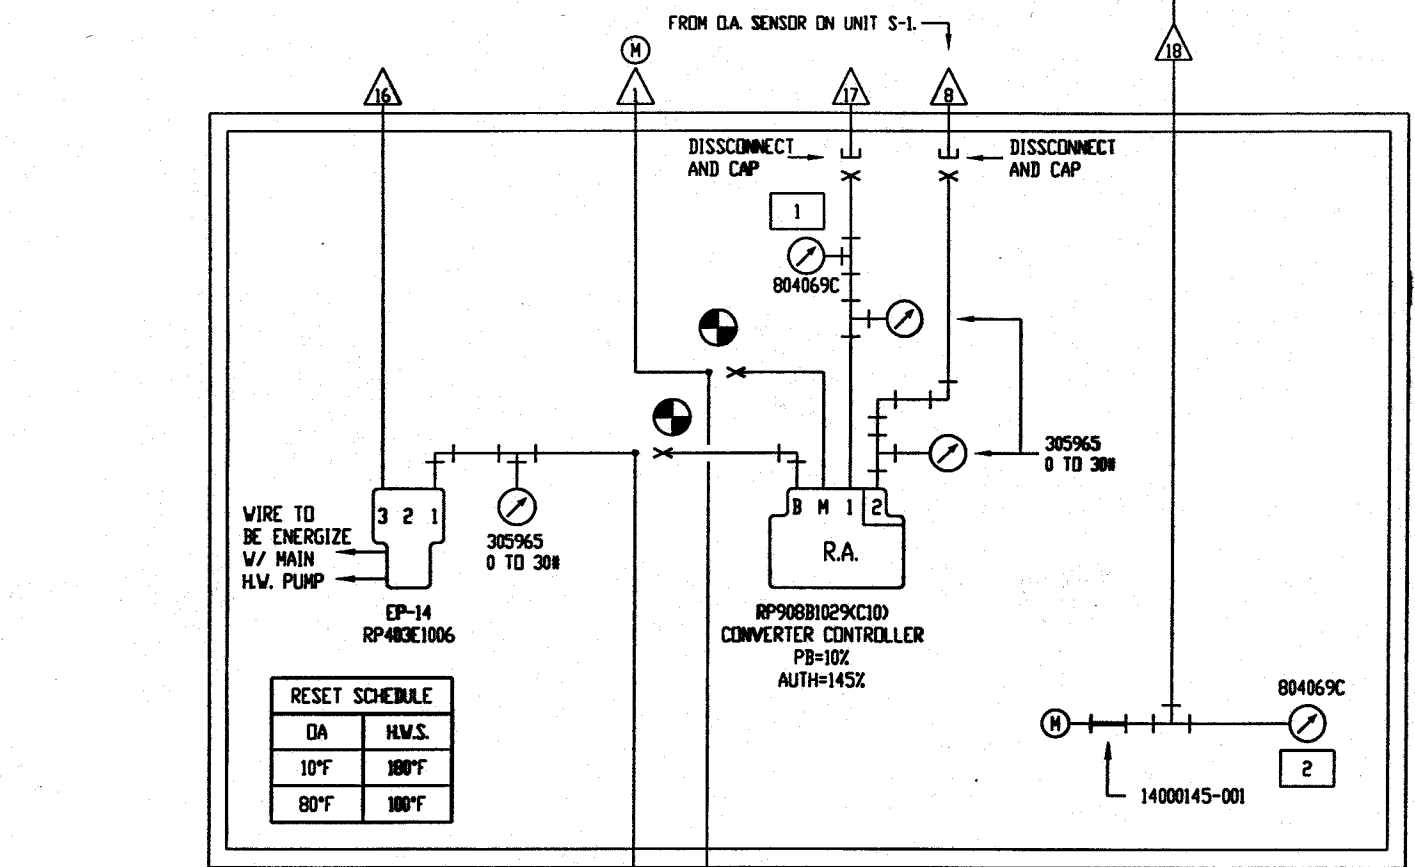

RESET SCHEDULE	
DA	H.W.S.
10°F	180°F
80°F	100°F

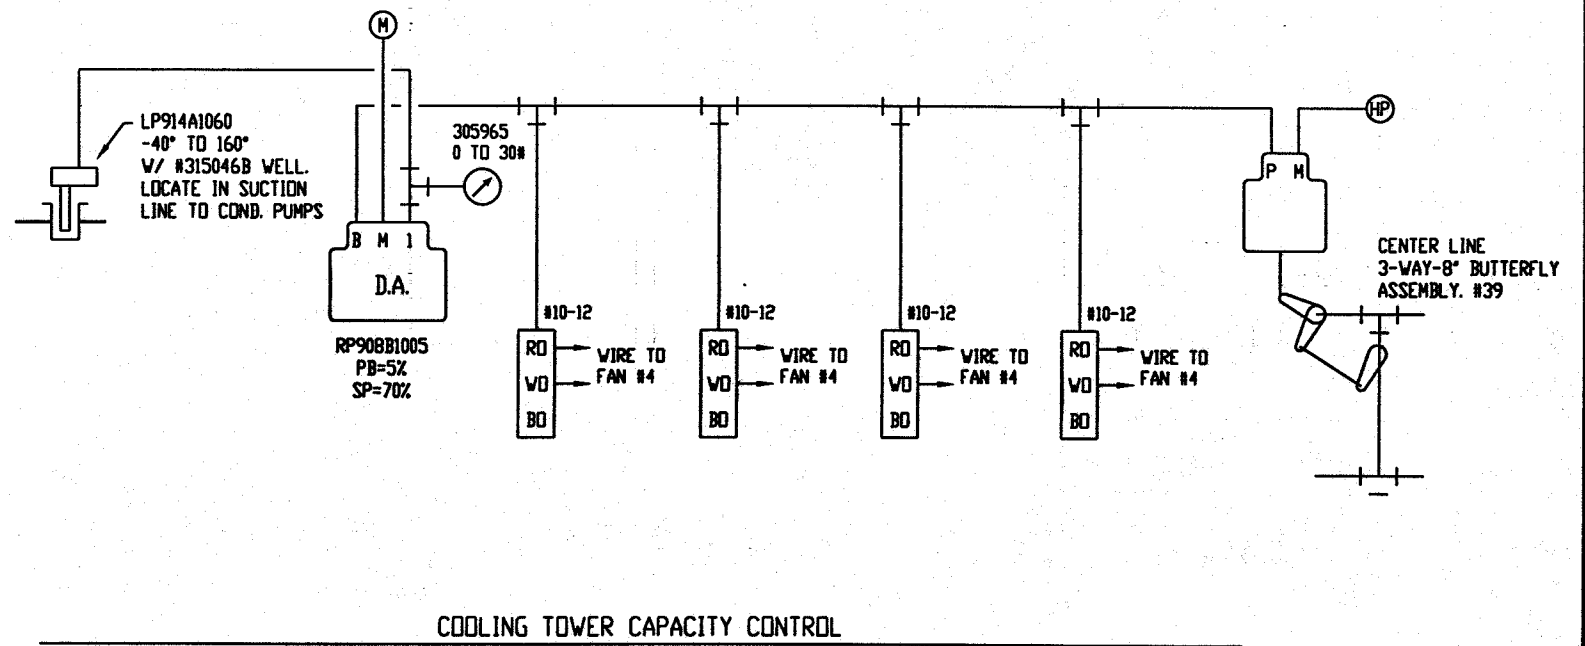

COOLING TOWER CAPACITY CONTROL

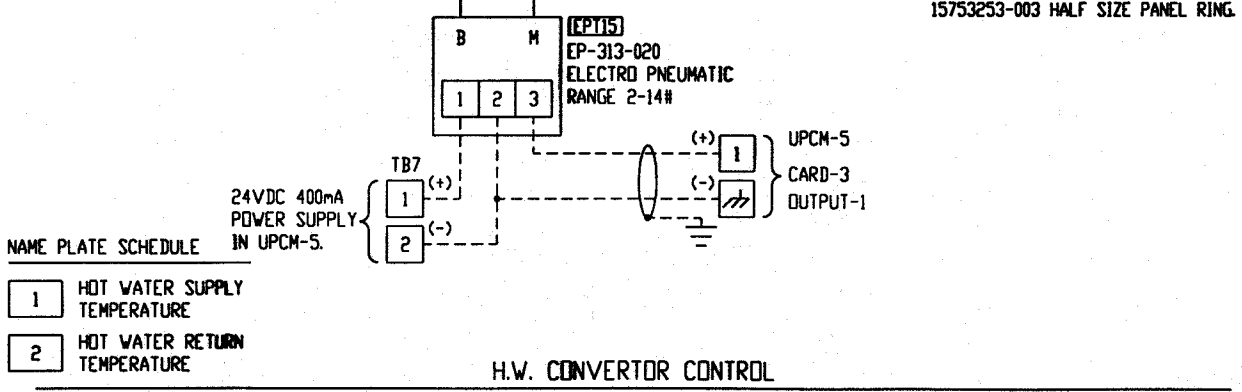

NAME PLATE SCHEDULE	
1	HOT WATER SUPPLY TEMPERATURE
2	HOT WATER RETURN TEMPERATURE


LEGEND	
—	INDICATES FACTORY WIRING
- - -	INDICATES FIELD WIRING

THE DOCUMENTATION HEREIN IS THE EXCLUSIVE PROPERTY OF LAYNE TRANE, CHARLOTTE, N.C. REPRODUCTION AND/OR DISTRIBUTION TO OTHER THAN AUTHORIZED PARTIES IS PROHIBITED.


TRANE
 LAYNE TRANE
 801 PRESSLEY RD
 CHARLOTTE, N.C. 28217
 704 525 3155

REFERENCE DRAWING	NO.	REVISION-LOCATION	DATE	BY


SALES ENGR. CER	PROJ. MGR. CVF	APPL. ENGR. CVF	DRAWN BY DPC	DATE: 4/6/98
PROJECT NAME UNCC-McEniry Charlotte, North Carolina				CONTRACT NUMBER ICS-98014 DRAWING NUMBER SHEET 29 OF 51

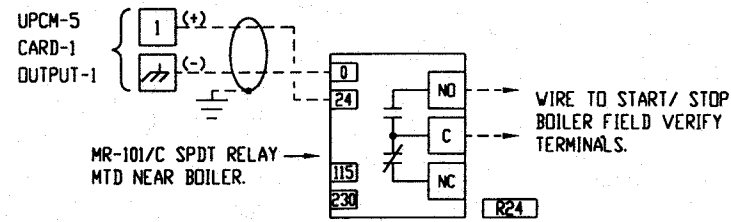


BOILER S/S DETAIL 'A'

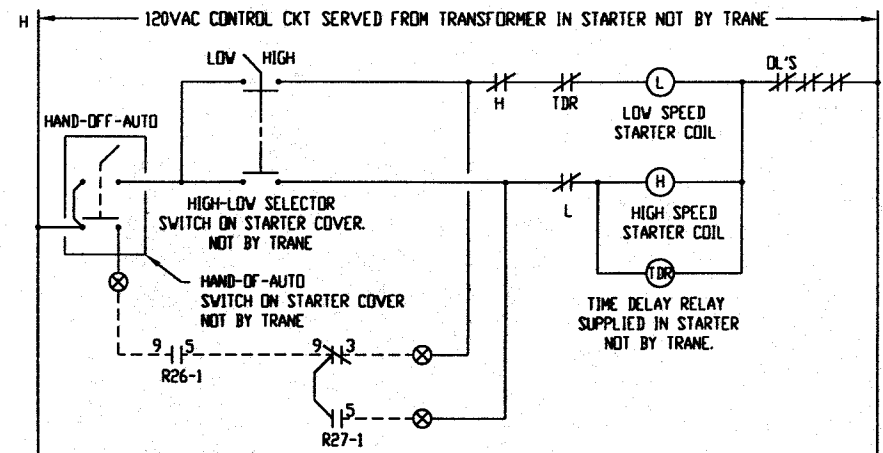

FIELD VERIFY TERMINALS IN EXISTING TOWER FAN CONTROL PANEL.

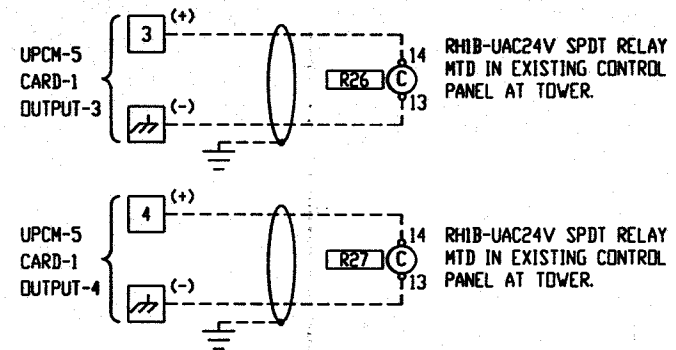

COOLING TOWER FAN S/S DETAIL 'C'

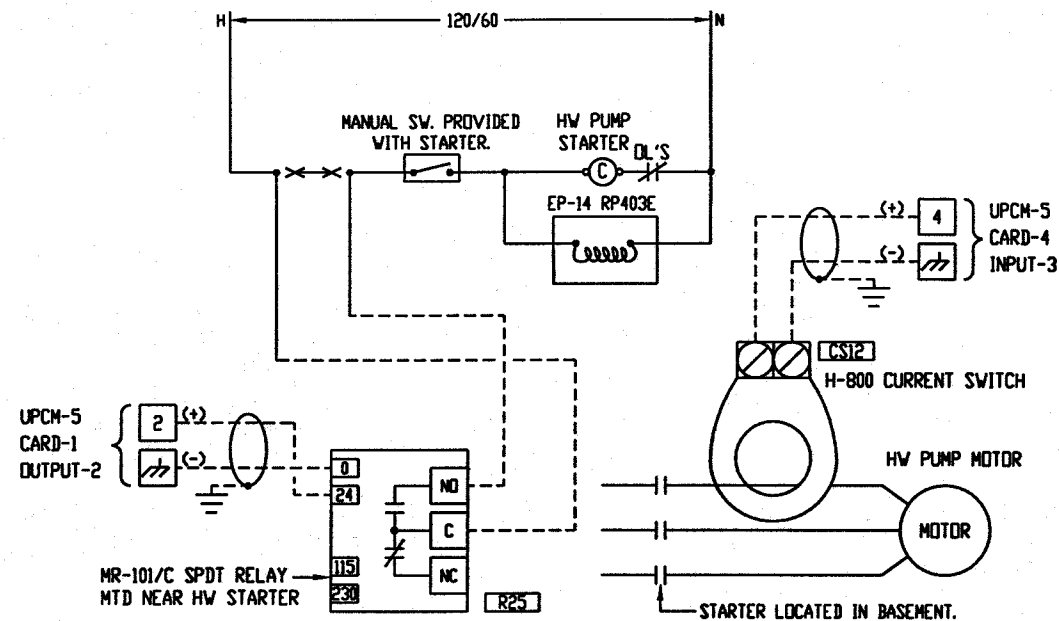


HW PUMP S/S AND STATUS DETAIL 'B'


LEGEND	
—————	INDICATES FACTORY WIRING
-----	INDICATES FIELD WIRING

THE DOCUMENTATION HEREIN IS THE EXCLUSIVE PROPERTY OF LAYNE TRANE, CHARLOTTE, N.C. REPRODUCTION AND/OR DISTRIBUTION TO OTHER THAN AUTHORIZED PARTIES IS PROHIBITED.


<p>LAYNE TRANE 801 PRESSLEY RD CHARLOTTE, N.C. 28217 704 525 3155</p>		REFERENCE DRAWING		NO.	REVISION-LOCATION	DATE	BY
		SALES ENGR. CCR	PROJ. MGR. CVF	APPL. ENGR. CVF	DRAWN BY DPC	DATE: 4/7/98	CONTRACT NUMBER ICS-98014
PROJECT NAME						DRAWING NUMBER	
UNCC-McEniry Charlotte, North Carolina						SHEET 30 OF 51	

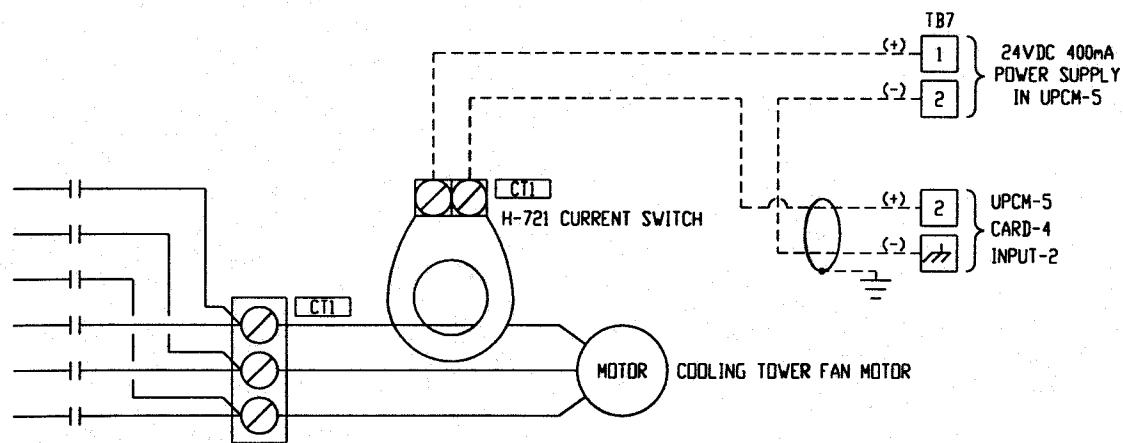



COOLING TOWER FAN AMPS DETAIL 'D'

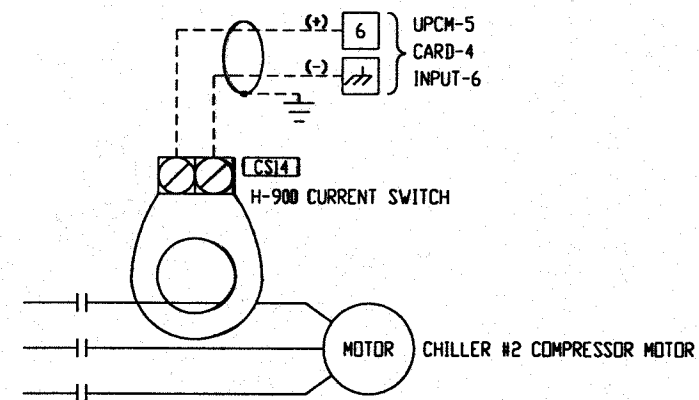


CHILLER #2 STATUS DETAIL 'G'

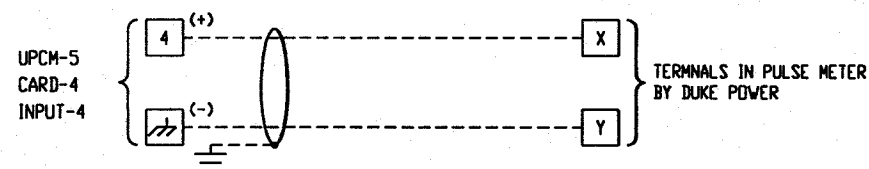

KW PULSE METER DETAIL 'E'

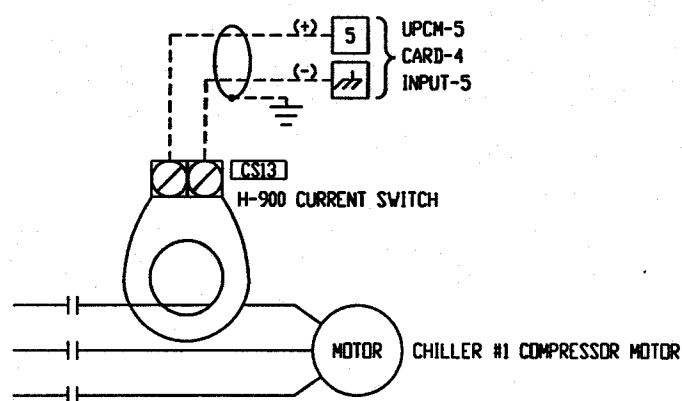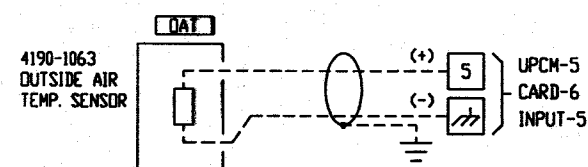

CHILLER #1 STATUS DETAIL 'F'

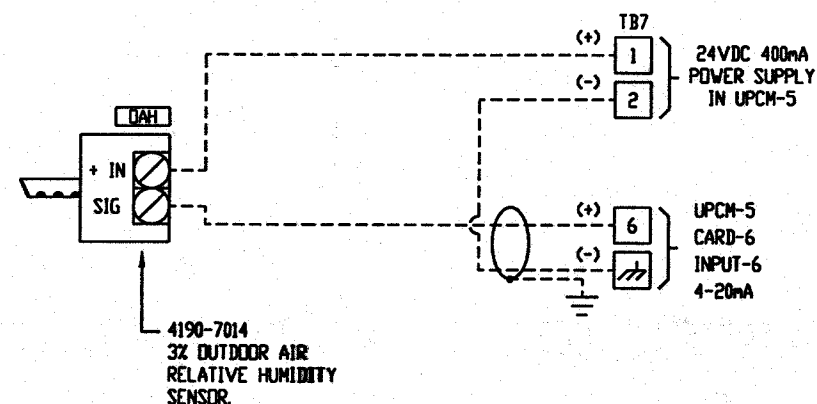

NOTE:
CORRECT PLACEMENT OF THESE SENSORS IS CRITICAL TO BUILDING FUNCTIONS. SENSORS SHOULD BE LOCATED IN THE SHADE AWAY FROM ALL DEVICES (SUCH AS EXHAUST FANS). THE BEST LOCATION WOULD BE BELOW THE EAVES, ONE FOOT DOWN FROM THE TOP OF A WALL WITH A NORTHERN EXPOSURE.



OUTSIDE AIR TEMPERATURE & HUMIDITY DETAIL 'H'

LEGEND	
—————	INDICATES FACTORY WIRING
-----	INDICATES FIELD WIRING

THE DOCUMENTATION HEREIN IS THE EXCLUSIVE PROPERTY OF LAYNE TRANE, CHARLOTTE, N.C. REPRODUCTION AND/OR DISTRIBUTION TO OTHER THAN AUTHORIZED PARTIES IS PROHIBITED.

TRANE
LAYNE TRANE
801 PRESSLEY RD
CHARLOTTE, N.C. 28217
704 525 3155


REFERENCE DRAWING				NO.		REVISION-LOCATION		DATE		BY	
SALES ENGR CCR	PROJ. MGR CVF	APPL. ENGR CVF	DRAWN BY DPC	DATE: 4/13/98	PROJECT NAME UNCC-McEniry Charlotte, North Carolina			CONTRACT NUMBER ICS-98014		DRAWING NUMBER SHEET 31 OF 51	

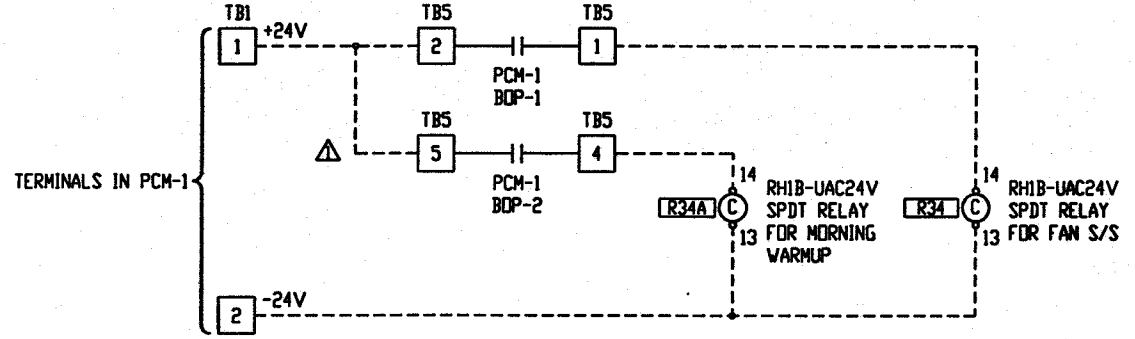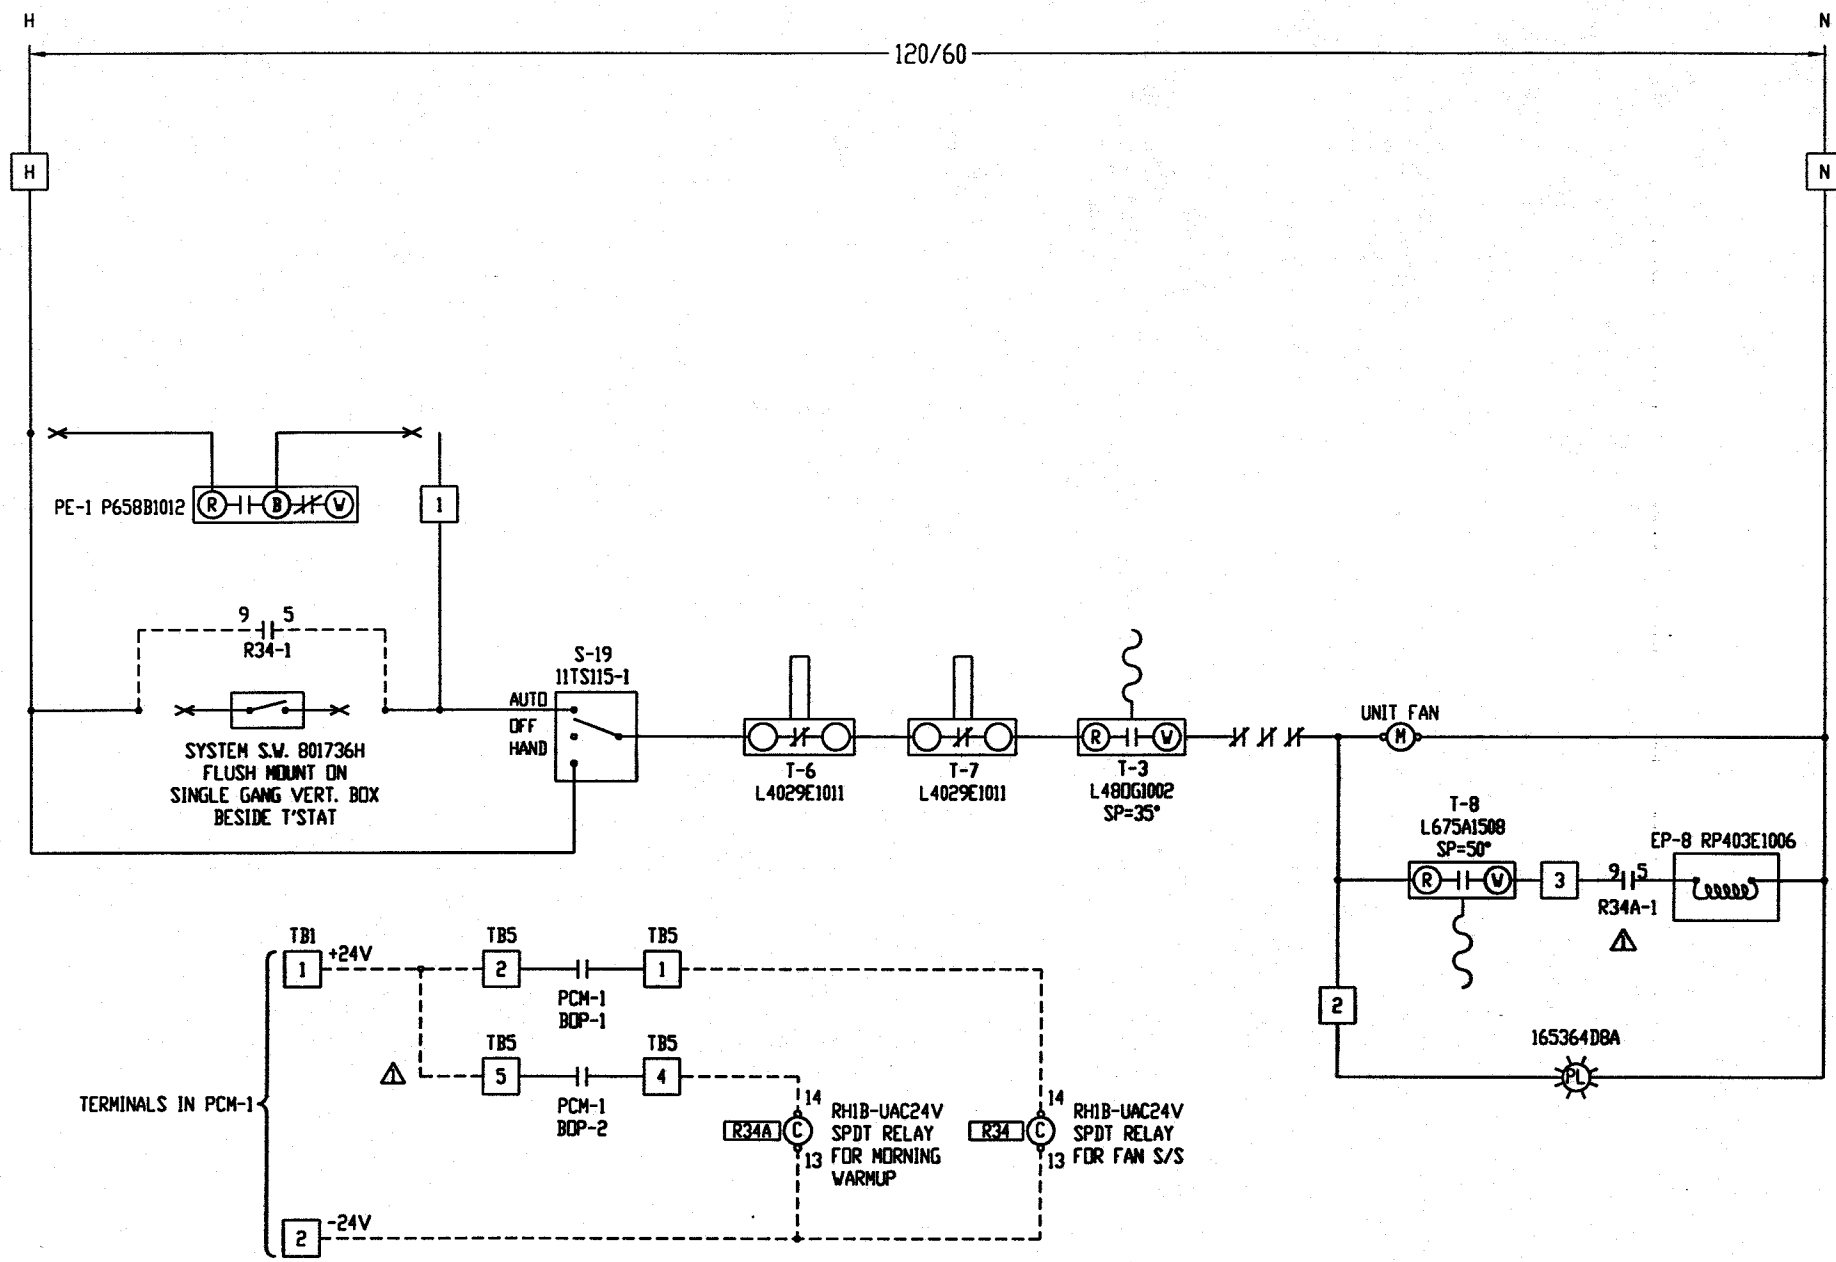

AHU-4 INTERLOCK WIRING DIAGRAM
- EXISTING CONTROL PANEL -

AHU-4 POINTS LIST FOR PCM-1. S/NO# E98E06415
- SERVING AHU-4 -

- AIP-1 MIXED AIR TEMPERATURE MAT-4.
- AIP-2 LECTURE 150 TEMPERATURE ST-6.
- AIP-3 SPARE
- ADP-1 VALVE CONTROL EPT-18.
- ADP-2 SPARE
- BIP-1 FAN STATUS CS-15.
- BIP-2 SPARE
- BOP-1 FAN START/STOP R34.
- △ BOP-2 M.V. RELAY
- BOP-3 SPARE

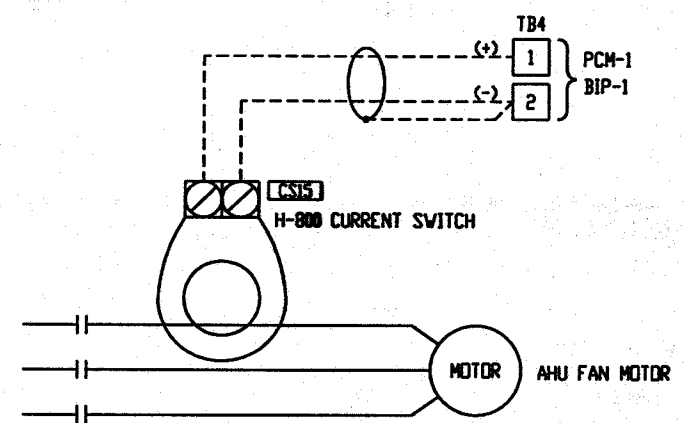

FAN STATUS SWITCH

LEGEND

- THIS COLOR IS INDICATING EXISTING, TO REMAIN AS IS.
- THIS COLOR IS INDICATING TO BE REMOVED.
- THIS COLOR IS INDICATING TO BE ABANDONED IN PLACE.
- THIS COLOR IS INDICATING NEW TO BE ADDED.
- (M) MAIN AIR
- * INDICATES GAUGE MOUNTED ON PANEL FACE.
- ⊕ CONNECT TO EXISTING


LEGEND

- INDICATES EXISTING WIRING
- - - INDICATES FIELD WIRING

THE DOCUMENTATION HEREIN IS THE EXCLUSIVE PROPERTY OF LAYNE TRANE, CHARLOTTE, N.C. REPRODUCTION AND/OR DISTRIBUTION TO OTHER THAN AUTHORIZED PARTIES IS PROHIBITED.

TRANE
LAYNE TRANE
801 PRESSLEY RD
CHARLOTTE, N.C. 28217
704 525 3155

REFERENCE DRAWING	NO.	REVISION-LOCATION	DATE	BY
		△ AS-BUILT	4/9/99	CVF
SALES ENGR. CCR	PROJ. MGR. CVF	APPL. ENGR. CVF	DRAWN BY DPC	DATE: 4/8/98
PROJECT NAME			CONTRACT NUMBER	
UNCC-McEniry Charlotte, North Carolina			ICS-98014	
			DRAWING NUMBER	
			SHEET 32 OF 51	

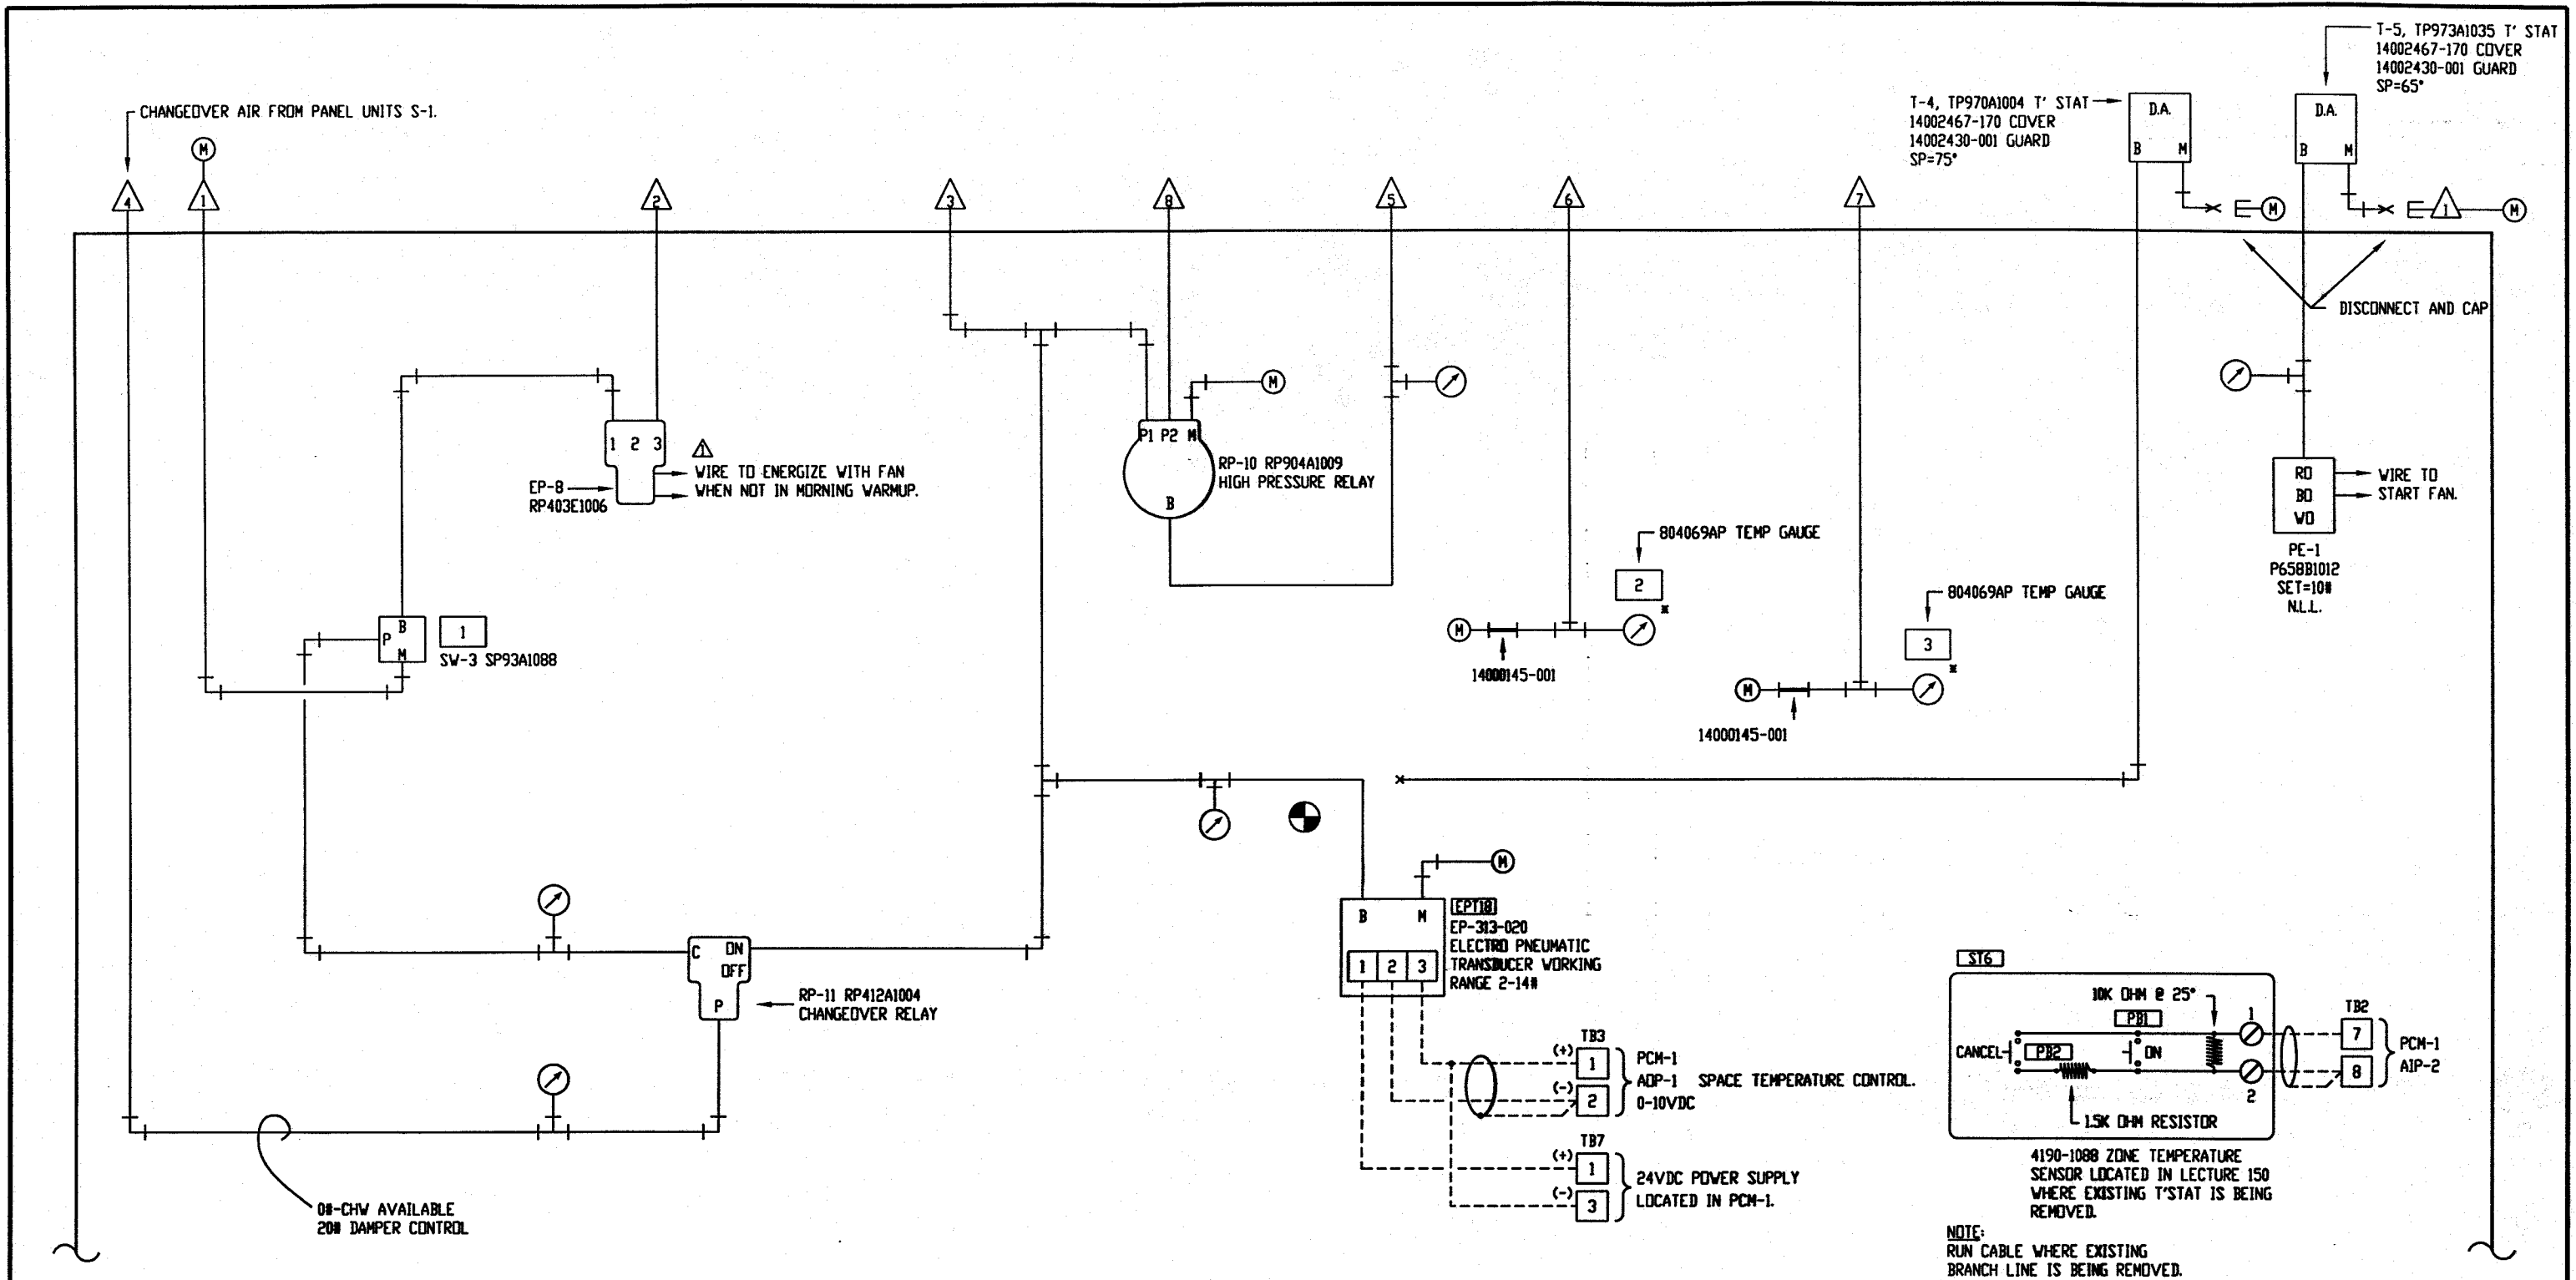

AHU-4 PANEL PNEUMATIC SCHEMATIC
- EXISTING CONTROL PANEL -

LEGEND	
■	THIS COLOR IS INDICATING EXISTING, TO REMAIN AS IS.
■	THIS COLOR IS INDICATING TO BE REMOVED.
■	THIS COLOR IS INDICATING TO BE ABANDONED IN PLACE.
■	THIS COLOR IS INDICATING NEW TO BE ADDED.
Ⓜ	MAIN AIR
*	INDICATES GAUGE MOUNTED ON PANEL FACE.
⊕	CONNECT TO EXISTING

- 1 MIN. OA DAMPER POSITION
- 2 SUPPLY AIR TEMP.
- 3 RETURN AIR TEMP.

THE DOCUMENTATION HEREIN IS THE EXCLUSIVE PROPERTY OF LAYNE TRANE, CHARLOTTE, N.C. REPRODUCTION AND/OR DISTRIBUTION TO OTHER THAN AUTHORIZED PARTIES IS PROHIBITED.


LAYNE TRANE
801 PRESSLEY RD
CHARLOTTE, N.C. 28217
704 525 3155

REFERENCE DRAWING	NO.	REVISION-LOCATION	DATE	BY
	Δ	AS-BUILT	4/9/99	CVF

SALES ENGR. CCR	PROJ. MGR. CVF	APPL. ENGR. CVF	DRAWN BY DPC	DATE: 4/2/98
PROJECT NAME				CONTRACT NUMBER
UNCC-McEniry Charlotte, North Carolina				ICS-98014
				DRAWING NUMBER
				SHEET 33 OF 51

FILE: AHU4-P

NOTE: ALL PRESSURE GAUGES 305909, 0 TO 30# RANGE EXCEPT AS NOTED.

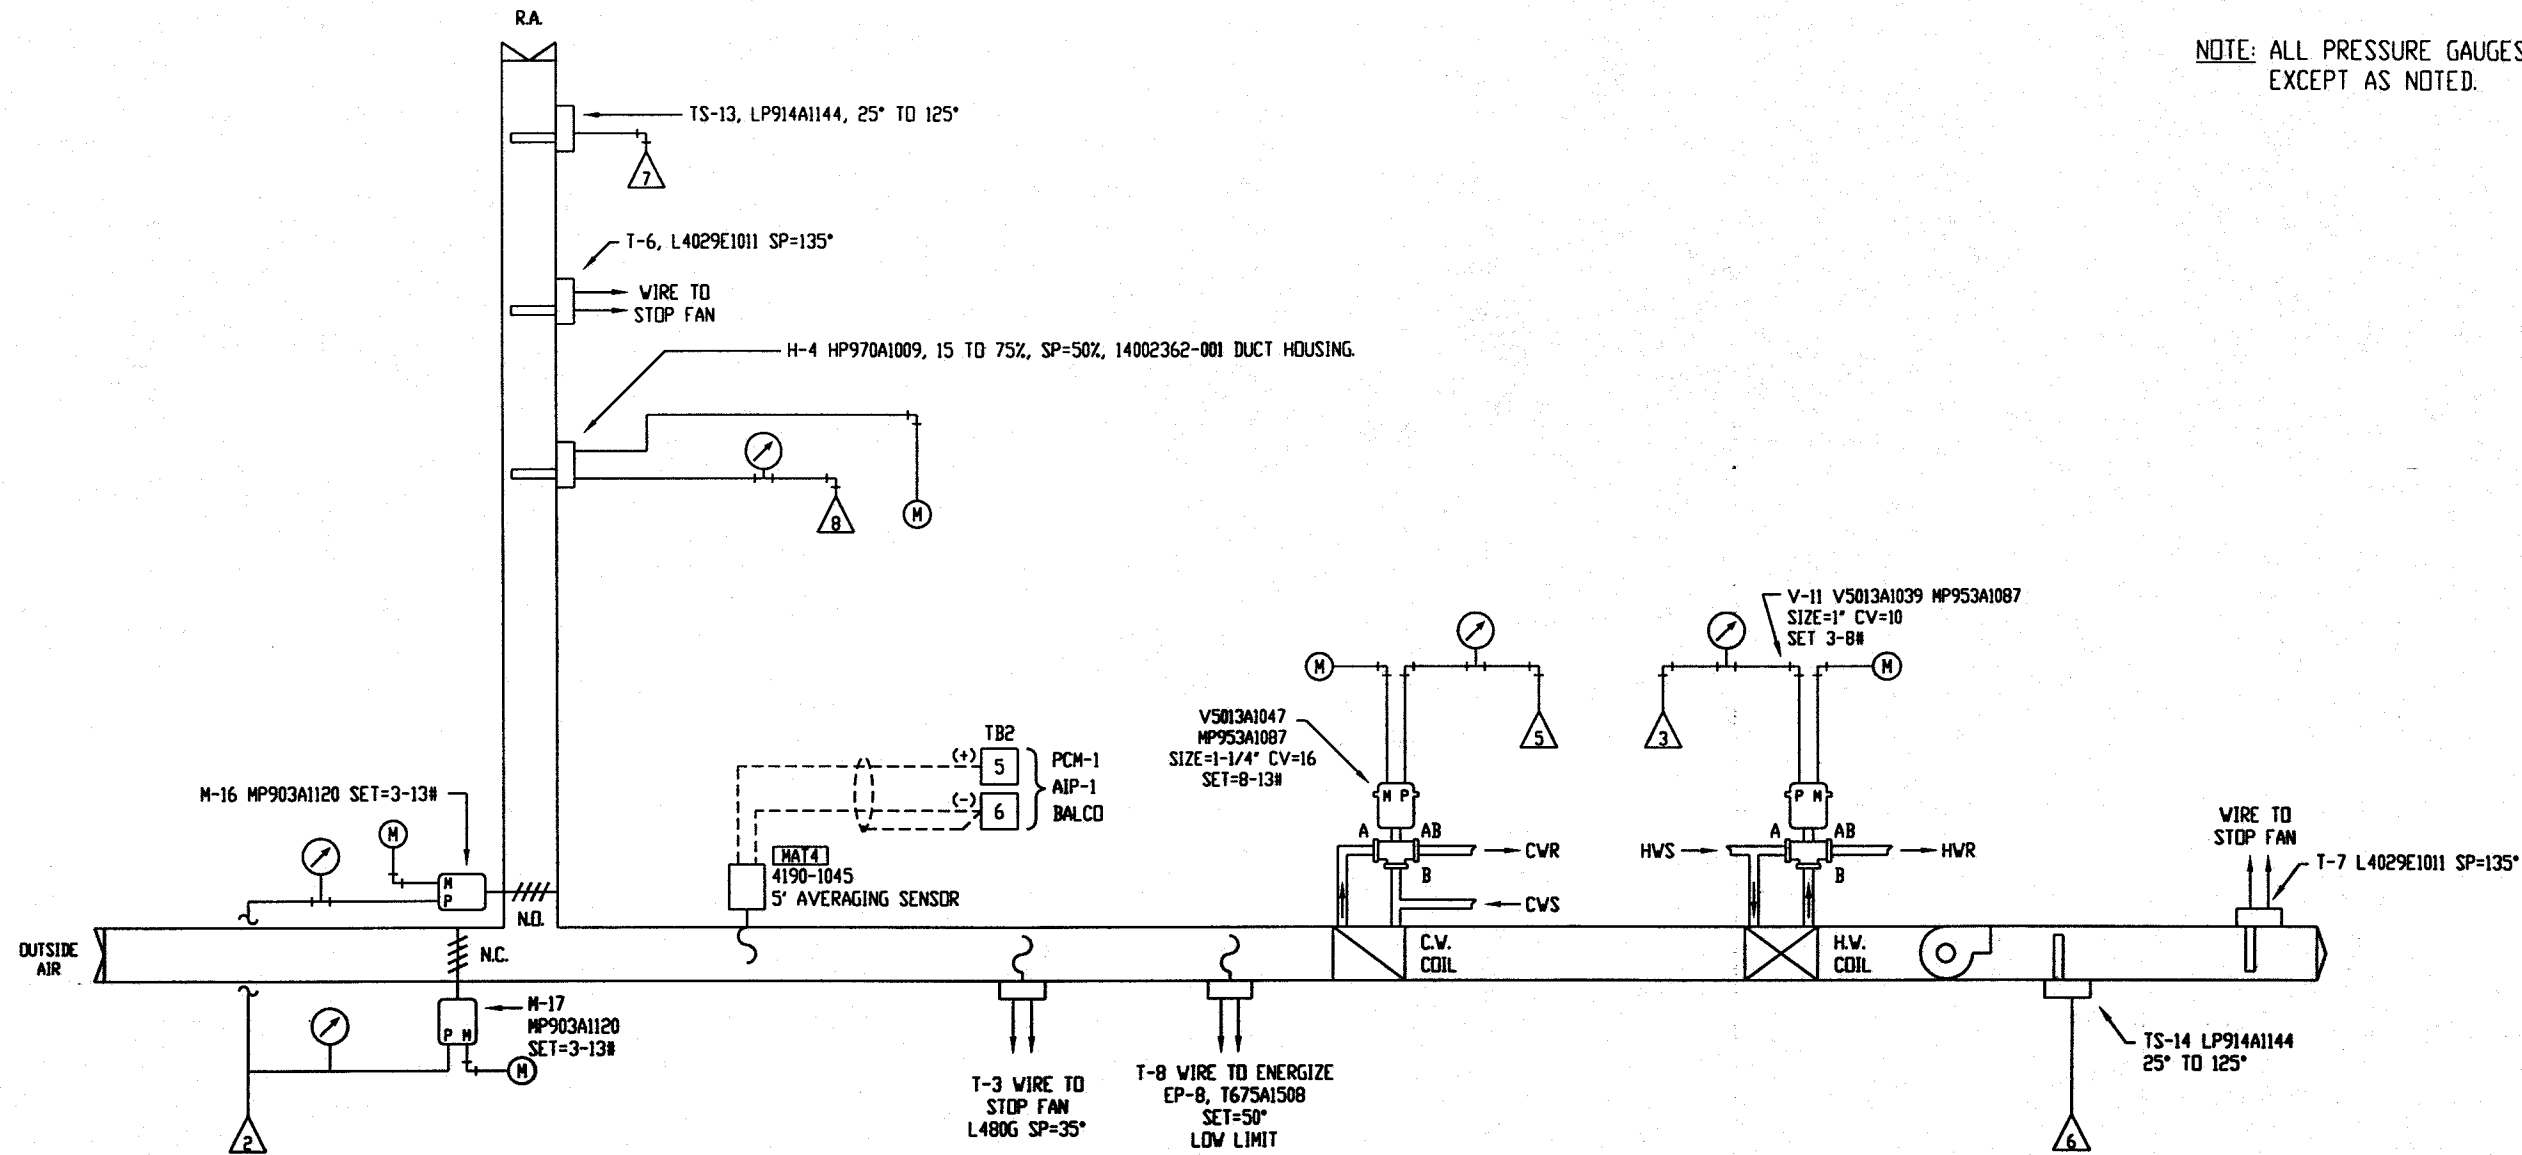


AHU-4 AIR FLOW SCHEMATIC

LEGEND

- THIS COLOR IS INDICATING EXISTING, TO REMAIN AS IS.
- THIS COLOR IS INDICATING TO BE REMOVED.
- THIS COLOR IS INDICATING TO BE ABANDONED IN PLACE.
- THIS COLOR IS INDICATING NEW TO BE ADDED.
- Ⓜ MAIN AIR
- ✱ INDICATES GAUGE MOUNTED ON PANEL FACE.
- ⊕ CONNECT TO EXISTING


THE DOCUMENTATION HEREIN IS THE EXCLUSIVE PROPERTY OF LAYNE TRANE, CHARLOTTE, N.C. REPRODUCTION AND/OR DISTRIBUTION TO OTHER THAN AUTHORIZED PARTIES IS PROHIBITED.

<p>LAYNE TRANE 801 PRESSLEY RD CHARLOTTE, N.C. 28217 704 525 3155</p>		SALES ENGR. CCR	PROJ. MGR. CVF	APPL. ENGR. CVF	DRAWN BY DPC	DATE: 4/2/98
		PROJECT NAME UNCC-McEniry Charlotte, North Carolina				

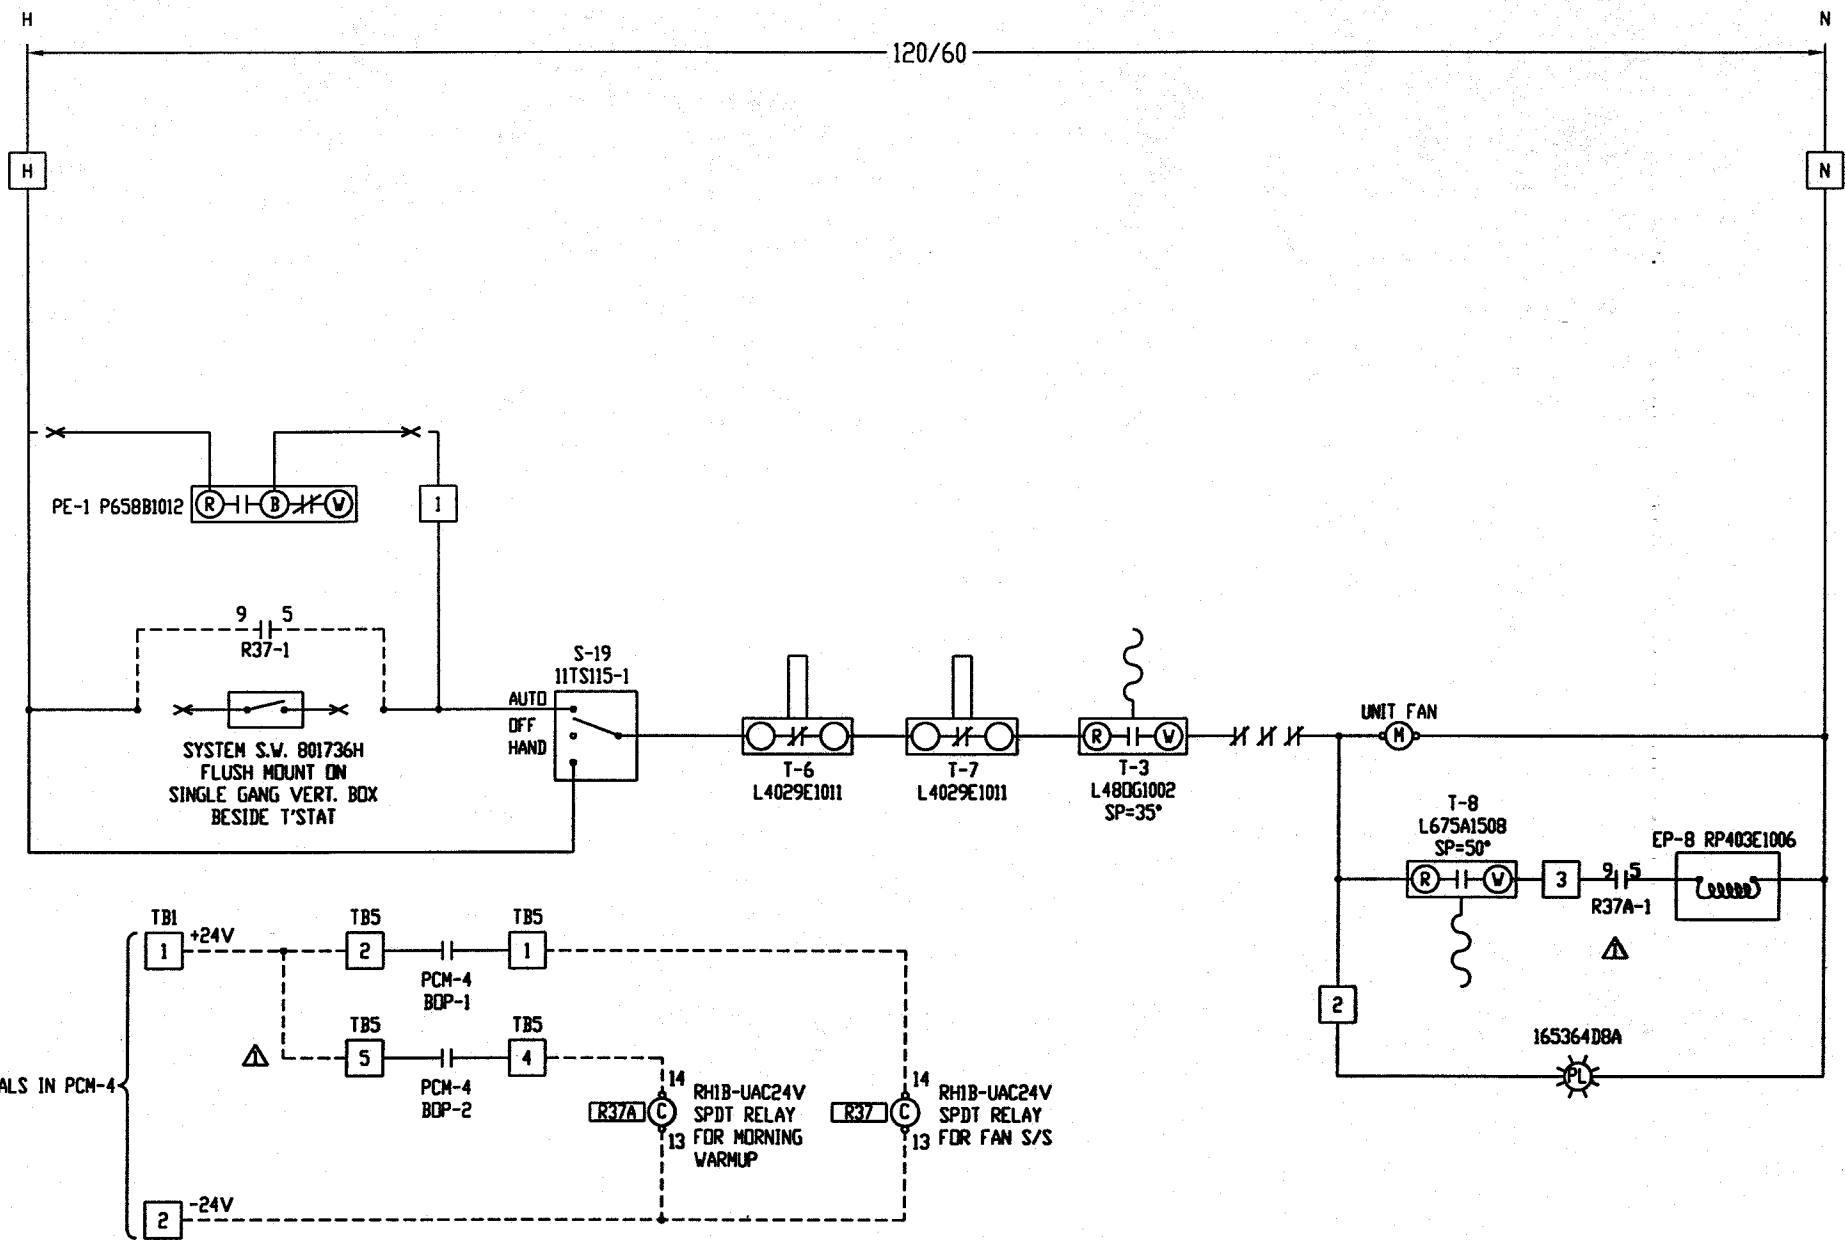

AHU-5 INTERLOCK WIRING DIAGRAM
- EXISTING CONTROL PANEL -

- AHU-5 POINTS LIST FOR PCM-4, S/N# E98E06414**
- SERVING AHU-5 -
- AIP-1 MIXED AIR TEMPERATURE MAT-5.
 - AIP-2 LECTURE 146 TEMPERATURE ST-9.
 - AIP-3 SPARE
 - ADP-1 VALVE CONTROL EPT-21.
 - ADP-2 SPARE
 - BIP-1 FAN STATUS CS-18.
 - BIP-2 SPARE
 - BOP-1 FAN START/STOP R-37.
 - BOP-2 M.V. RELAY
 - BOP-3 SPARE

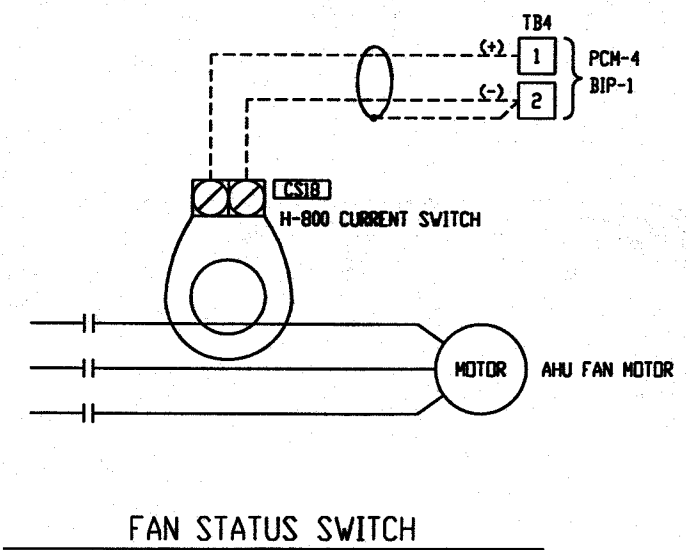

LEGEND	
■	THIS COLOR IS INDICATING EXISTING, TO REMAIN AS IS.
■	THIS COLOR IS INDICATING TO BE REMOVED.
■	THIS COLOR IS INDICATING TO BE ABANDONED IN PLACE.
■	THIS COLOR IS INDICATING NEW TO BE ADDED.
(M)	MAIN AIR
*	INDICATES GAUGE MOUNTED ON PANEL FACE.
⊙	CONNECT TO EXISTING


LEGEND	
—	INDICATES EXISTING WIRING
- - -	INDICATES FIELD WIRING

THE DOCUMENTATION HEREIN IS THE EXCLUSIVE PROPERTY OF LAYNE TRANE, CHARLOTTE, N.C. REPRODUCTION AND/OR DISTRIBUTION TO OTHER THAN AUTHORIZED PARTIES IS PROHIBITED.

TRANE
LAYNE TRANE
801 PRESSLEY RD
CHARLOTTE, N.C. 28217
704 525 3155

REFERENCE DRAWING	NO.	REVISION-LOCATION	DATE	BY
		AS-BUILT	4/9/99	CVF

SALES ENGR. CCR	PROJ. MGR. CVF	APPL. ENGR. CVF	DRAWN BY. JPC	DATE: 4/8/98
PROJECT NAME				CONTRACT NUMBER
UNCC-McEniry				ICS-98014
Charlotte, North Carolina				DRAWING NUMBER
				SHEET 35 OF 51

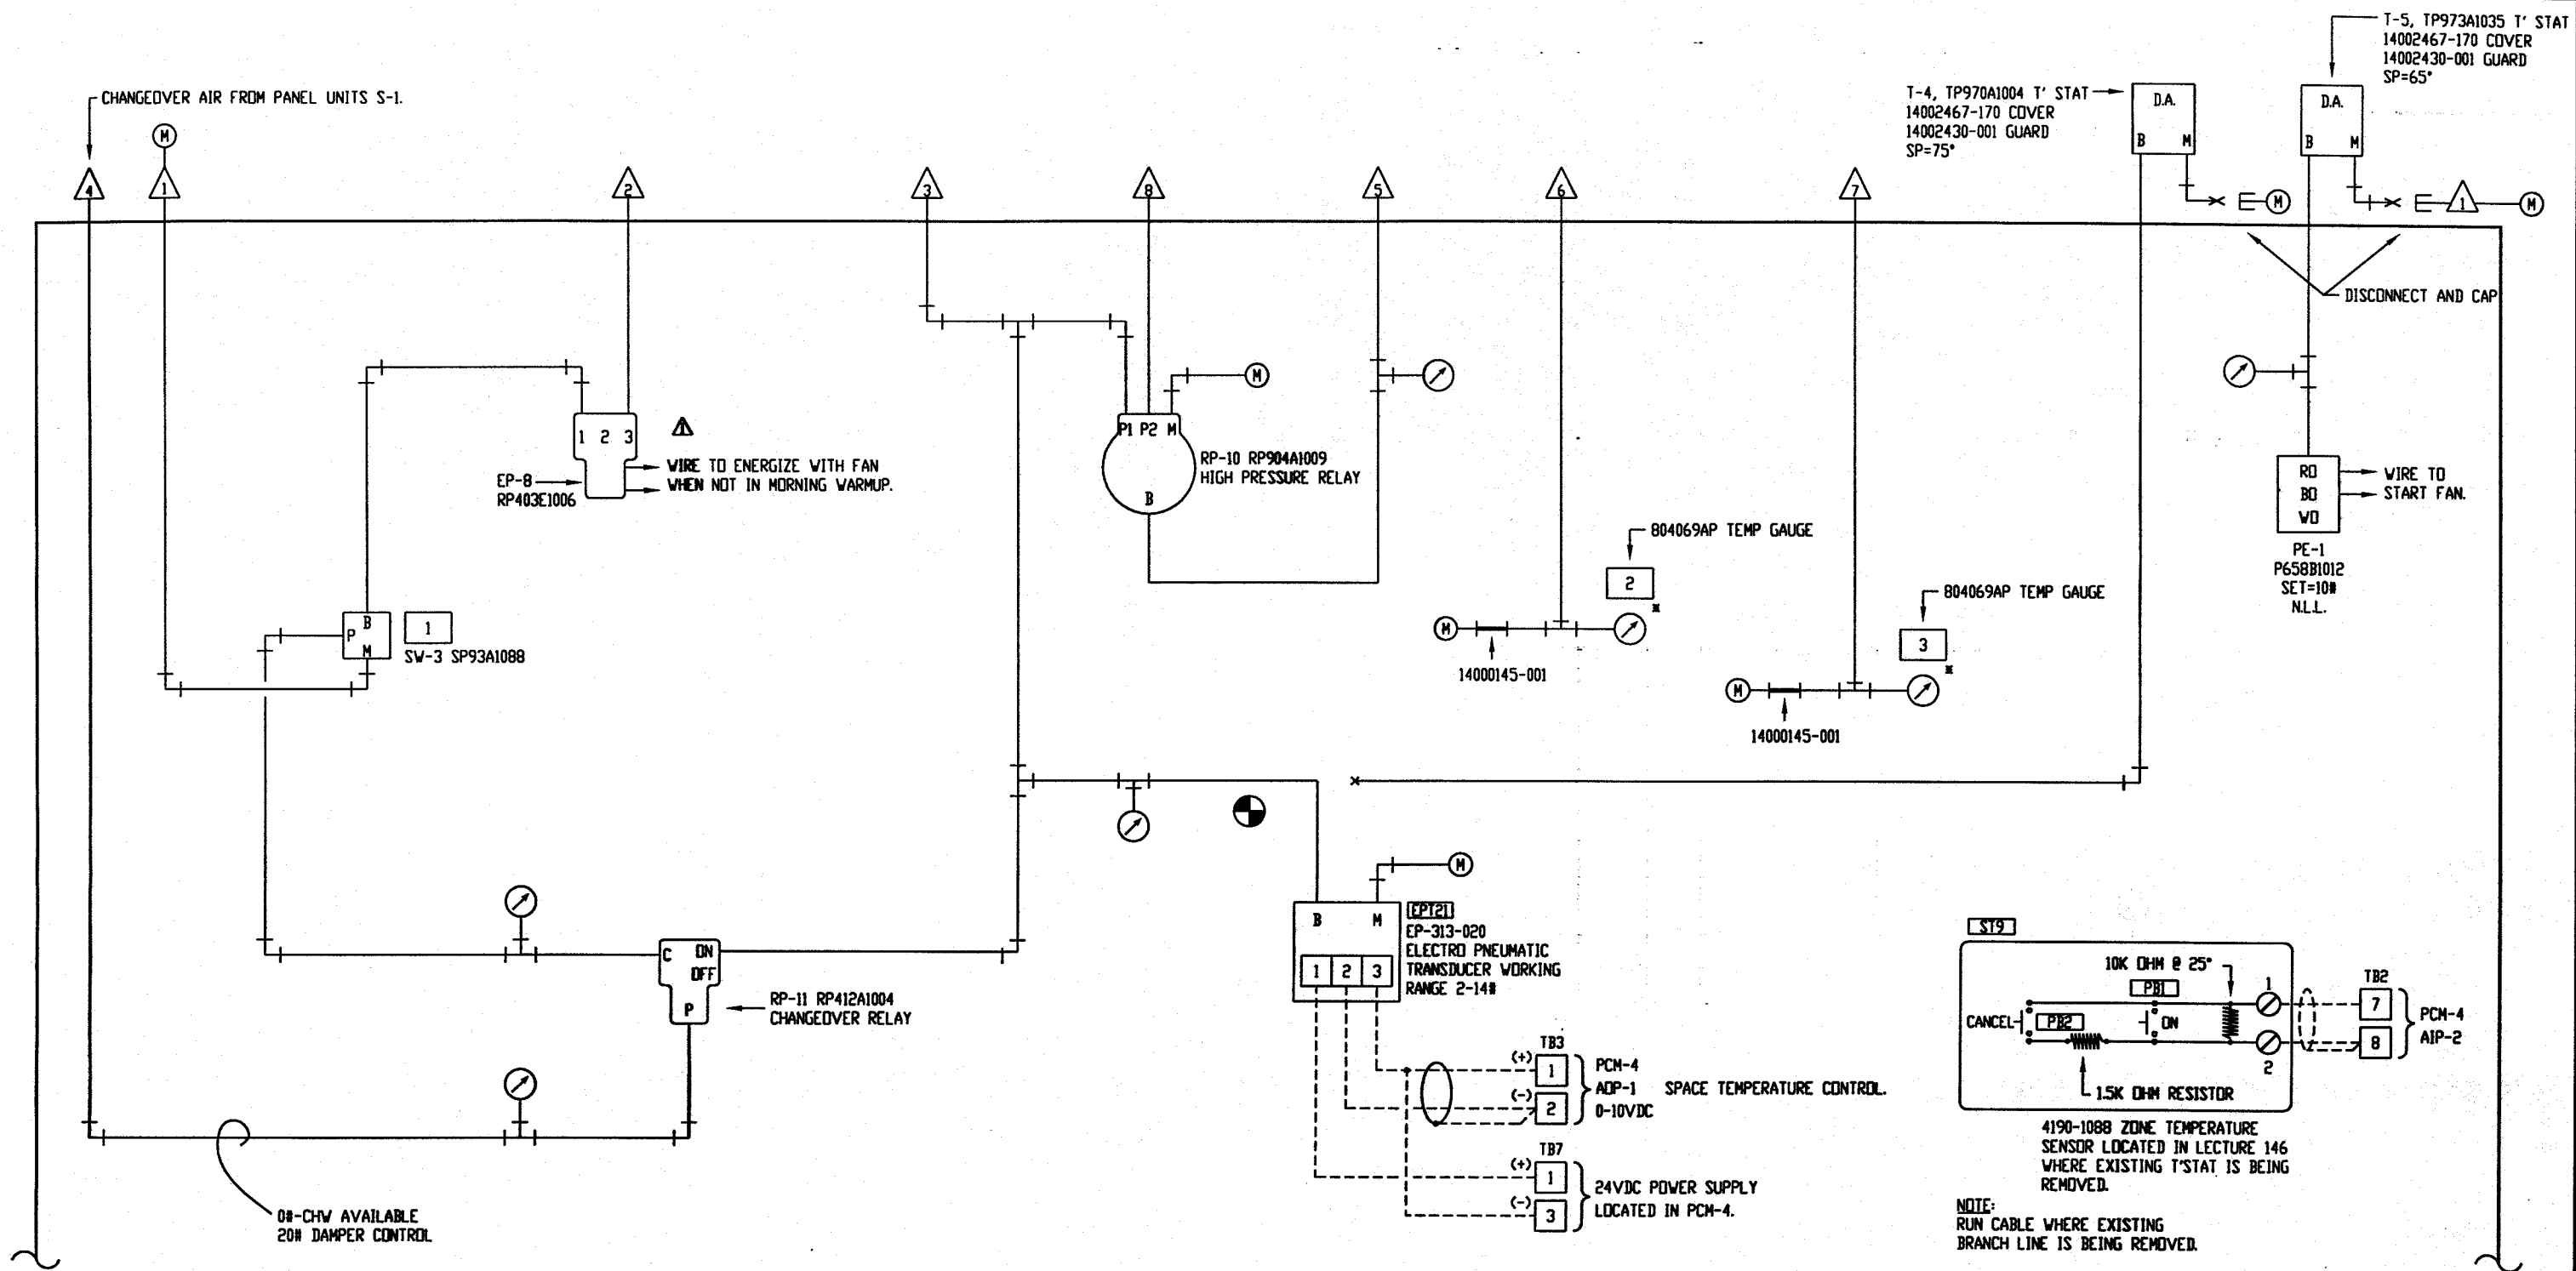

AHU-5 PANEL PNEUMATIC SCHEMATIC
- EXISTING CONTROL PANEL -

LEGEND	
■	THIS COLOR IS INDICATING EXISTING, TO REMAIN AS IS.
■	THIS COLOR IS INDICATING TO BE REMOVED.
■	THIS COLOR IS INDICATING TO BE ABANDONED IN PLACE.
■	THIS COLOR IS INDICATING NEW TO BE ADDED.
(M)	MAIN AIR
*	INDICATES GAUGE MOUNTED ON PANEL FACE.
⊕	CONNECT TO EXISTING

- 1 MIN. DA DAMPER POSITION
- 2 SUPPLY AIR TEMP.
- 3 RETURN AIR TEMP.


THE DOCUMENTATION HEREIN IS THE EXCLUSIVE PROPERTY OF LAYNE TRANE, CHARLOTTE, N.C. REPRODUCTION AND/OR DISTRIBUTION TO OTHER THAN AUTHORIZED PARTIES IS PROHIBITED.

LAYNE TRANE
801 PRESSLEY RD
CHARLOTTE, N.C. 28217
704 525 3155

REFERENCE DRAWING	NO.	REVISION-LOCATION	DATE	BY
	AS-BUILT		4/9/99	CVF

SALES ENGR. CCR	PROJ. MGR. CVF	APPL. ENGR. CVF	DRAWN BY DPC	DATE: 4/2/98
PROJECT NAME				CONTRACT NUMBER
UNCC-McEniry Charlotte, North Carolina				ICS-98014
				DRAWING NUMBER
				SHEET 36 OF 51

NOTE: ALL PRESSURE GAUGES 305909, 0 TO 30# RANGE EXCEPT AS NOTED.

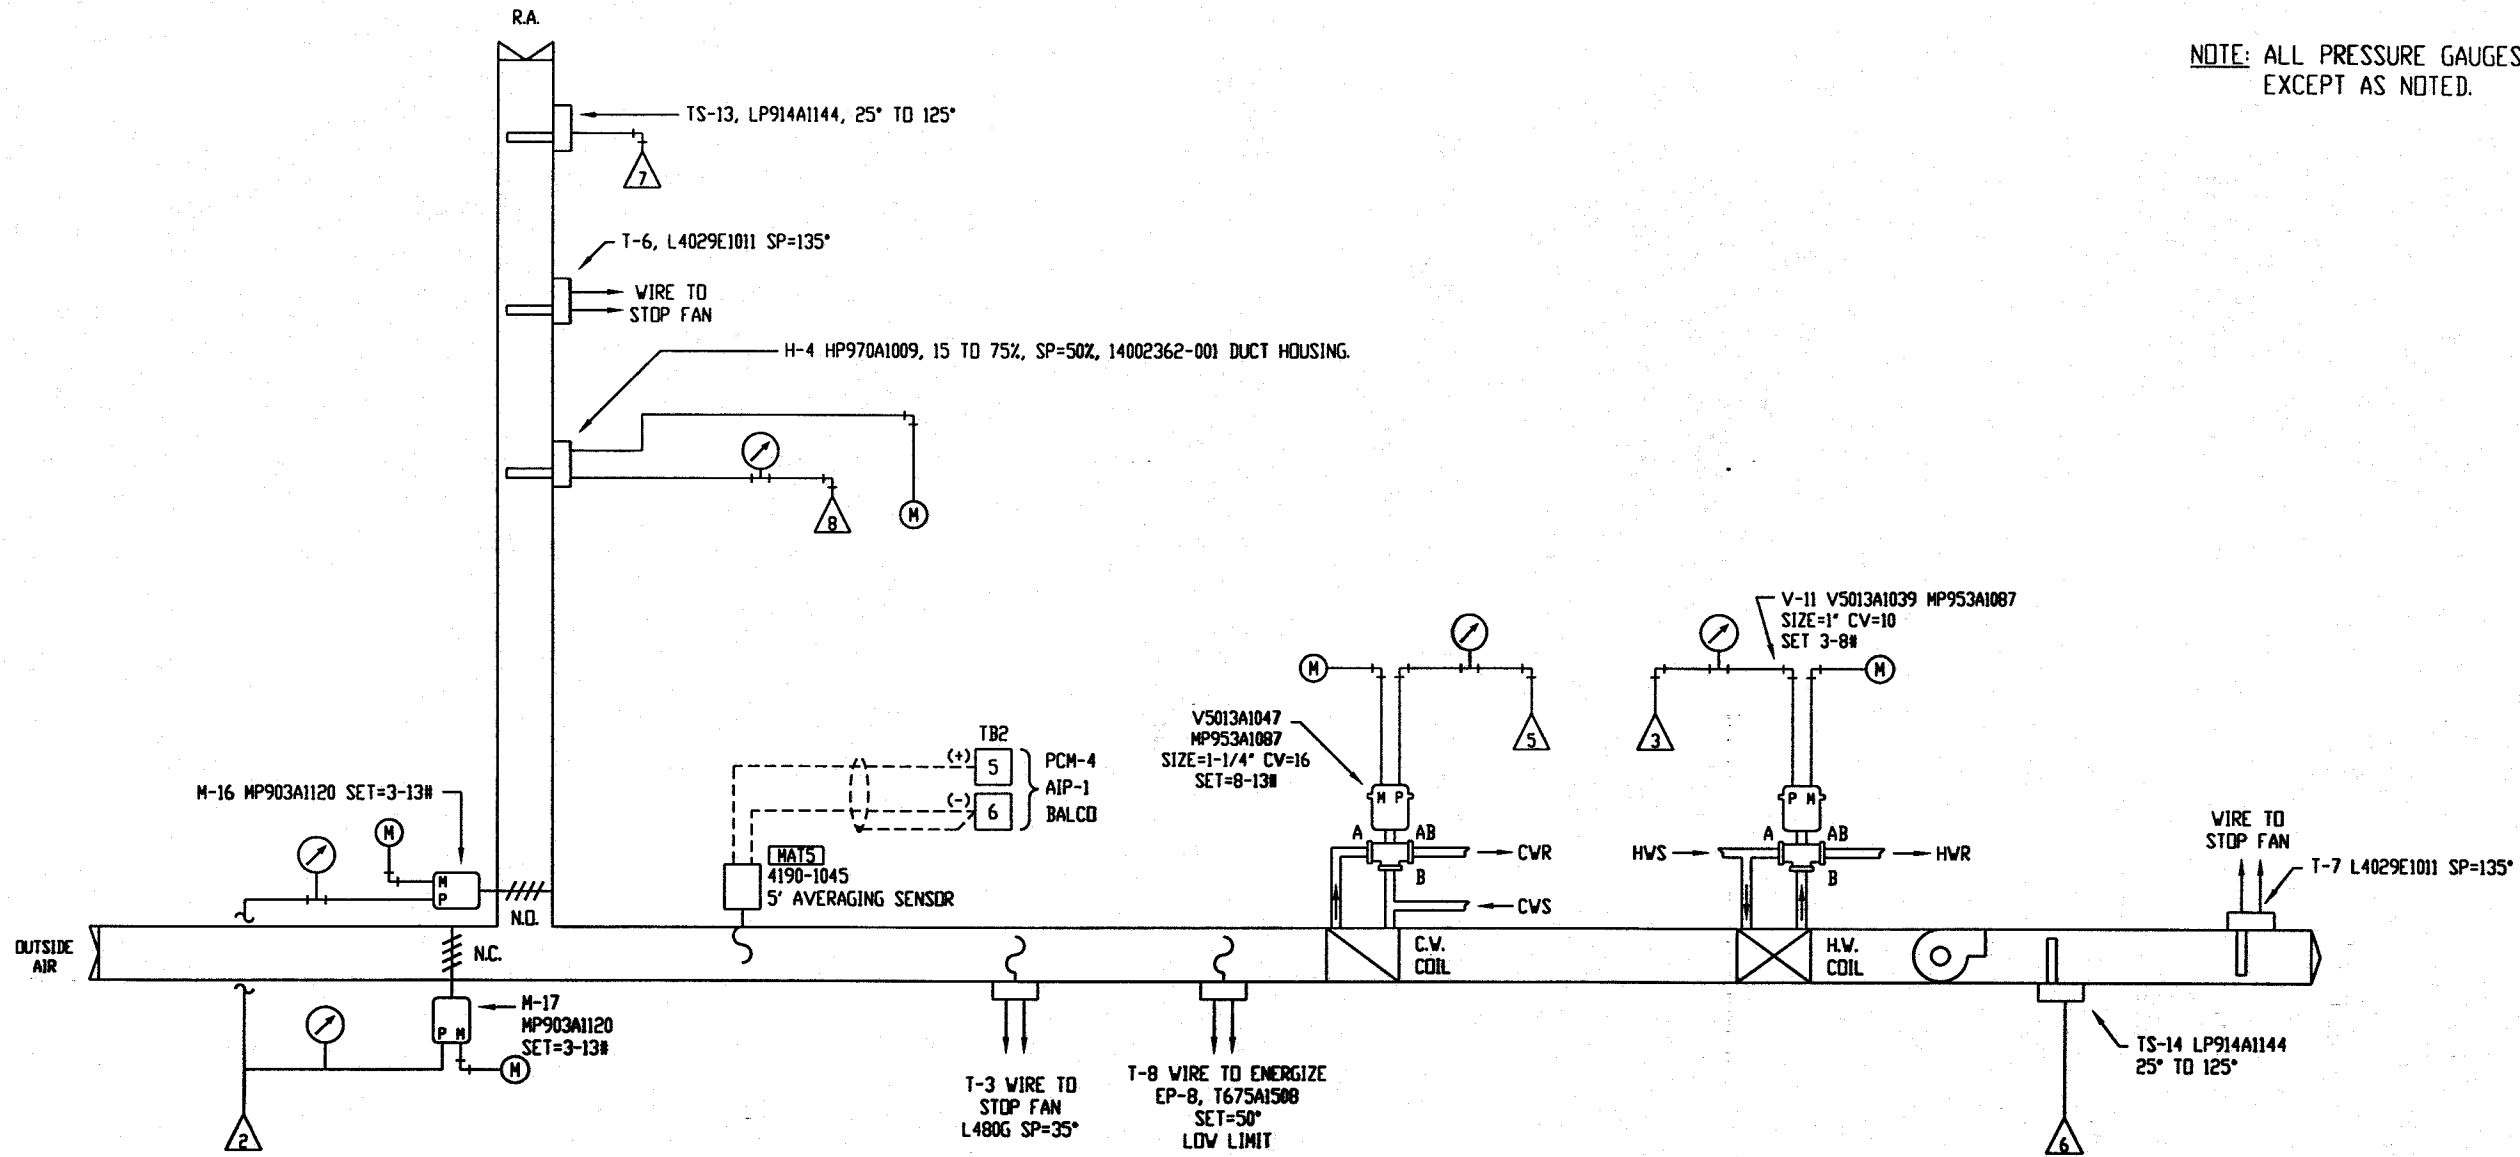

AHU-5 AIR FLOW SCHEMATIC

LEGEND


- THIS COLOR IS INDICATING EXISTING, TO REMAIN AS IS.
- THIS COLOR IS INDICATING TO BE REMOVED.
- THIS COLOR IS INDICATING TO BE ABANDONED IN PLACE.
- THIS COLOR IS INDICATING NEW TO BE ADDED.
- ⊕ MAIN AIR
- ★ INDICATES GAUGE MOUNTED ON PANEL FACE.
- ⊕ CONNECT TO EXISTING

THE DOCUMENTATION HEREIN IS THE EXCLUSIVE PROPERTY OF LAYNE TRANE, CHARLOTTE, N.C. REPRODUCTION AND/OR DISTRIBUTION TO OTHER THAN AUTHORIZED PARTIES IS PROHIBITED.



TRANE
 LAYNE TRANE
 801 PRESSLEY RD
 CHARLOTTE, N.C. 28217
 704 525 3155

REFERENCE DRAWING		NO.	REVISION-LOCATION	DATE	BY

SALES ENGR. CCR	PROJ. MGR. CVF	APPL. ENGR. CVF	DRAWN BY. DPC	DATE: 4/2/98
PROJECT NAME: UNCC-McEniry Charlotte, North Carolina				CONTRACT NUMBER: ICS-98014 DRAWING NUMBER: SHEET 37 OF 51

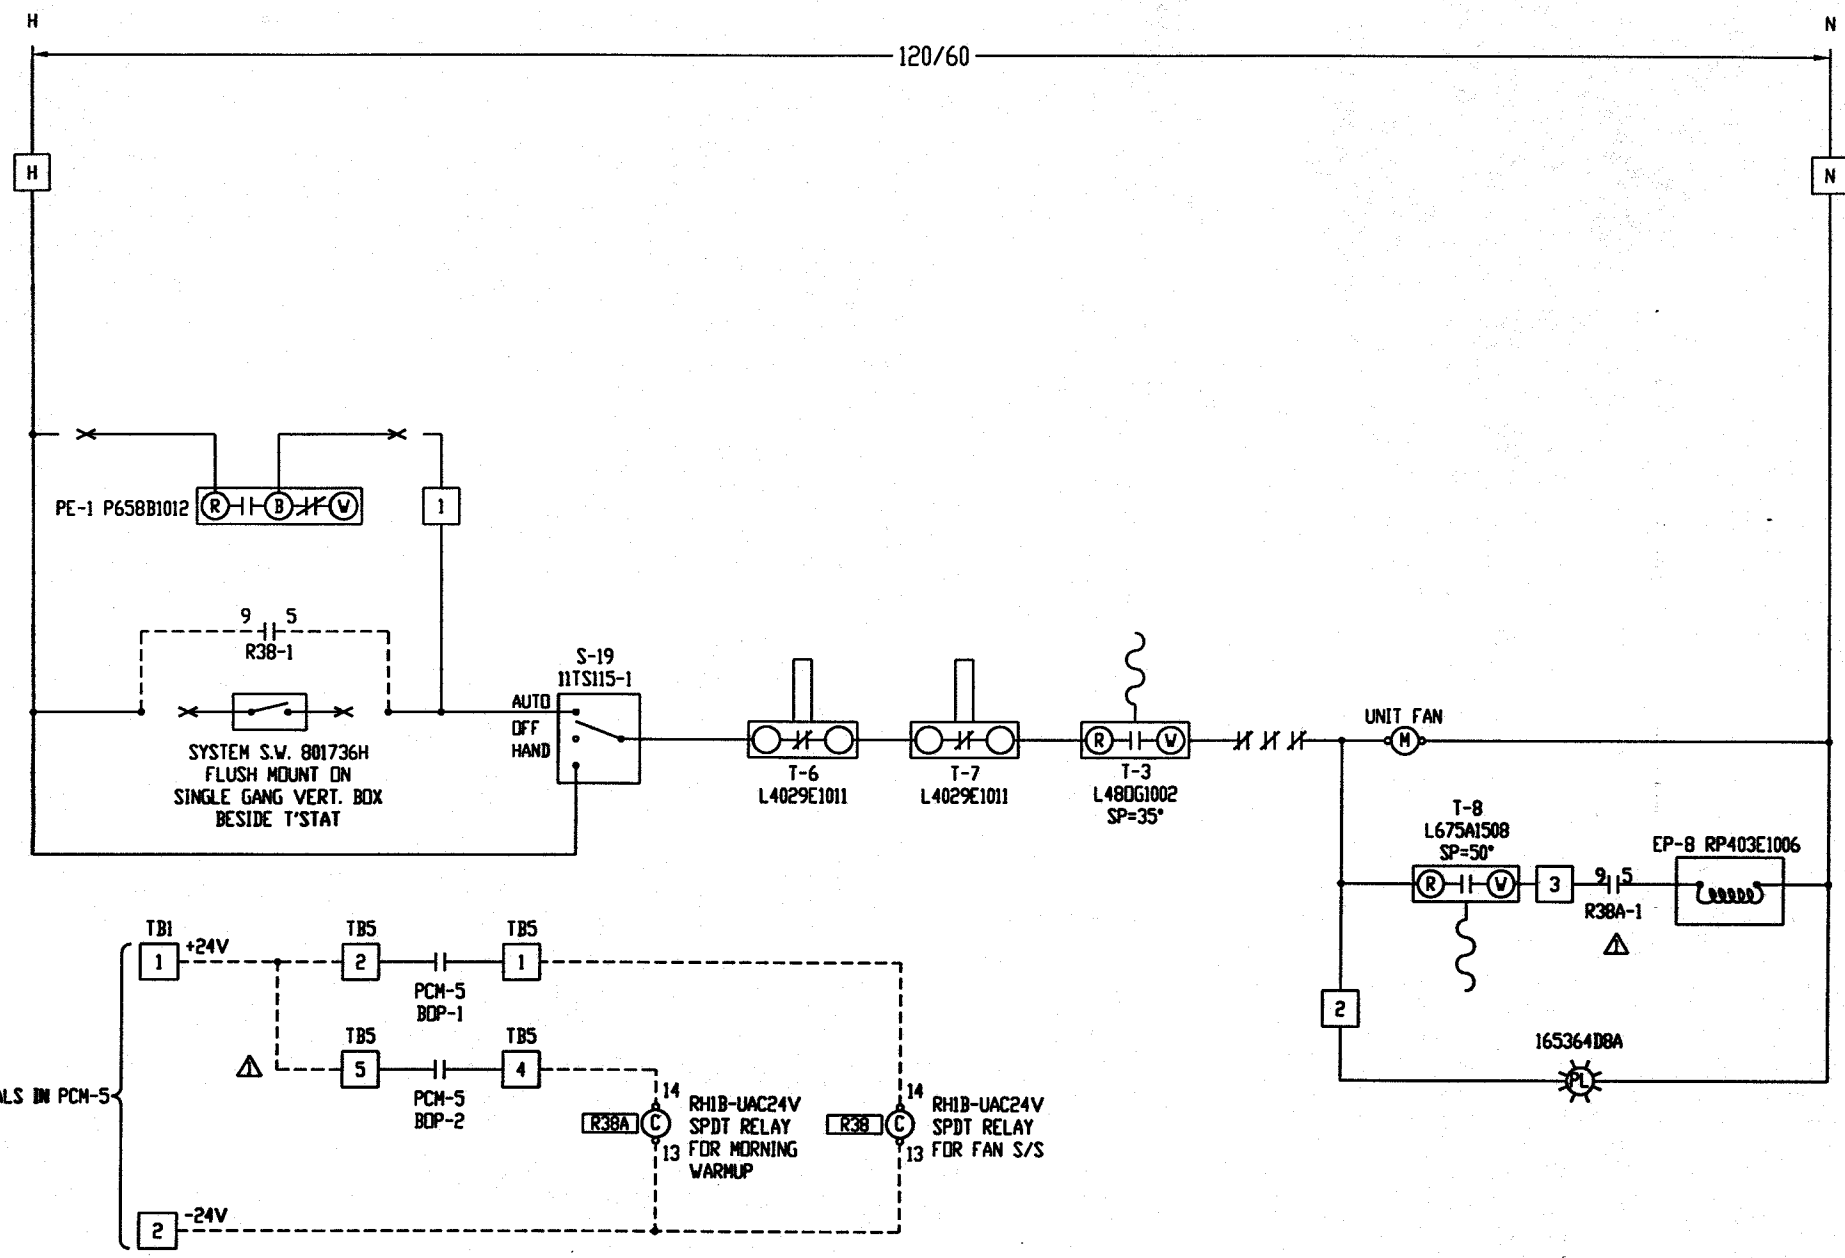

- AHU-6 POINTS LIST FOR PCM-5, S/N# E98E06413**
 - SERVING AHU-6 -
- AIP-1 MIXED AIR TEMPERATURE MAT-6.
 - AIP-2 AUDITORIUM 142 TEMPERATURE ST-10.
 - AIP-3 SPARE
 - ADP-1 VALVE CONTROL EPT-22.
 - ADP-2 SPARE
 - BIP-1 FAN STATUS CS-19.
 - BIP-2 SPARE
 - BOP-1 FAN START/STOP R-38.
 - ▲ BOP-2 M.V. RELAY
 - BOP-3 SPARE

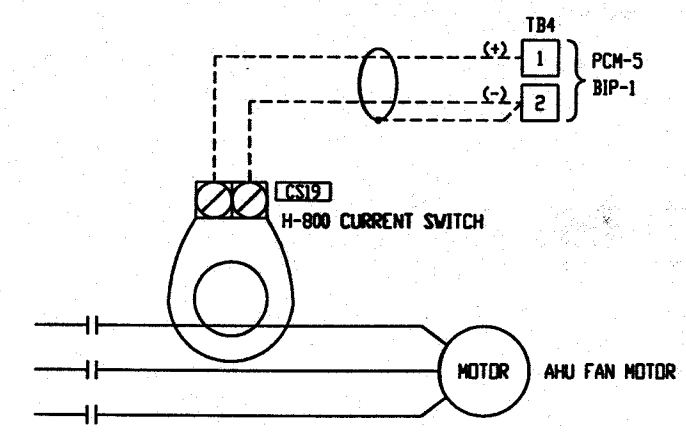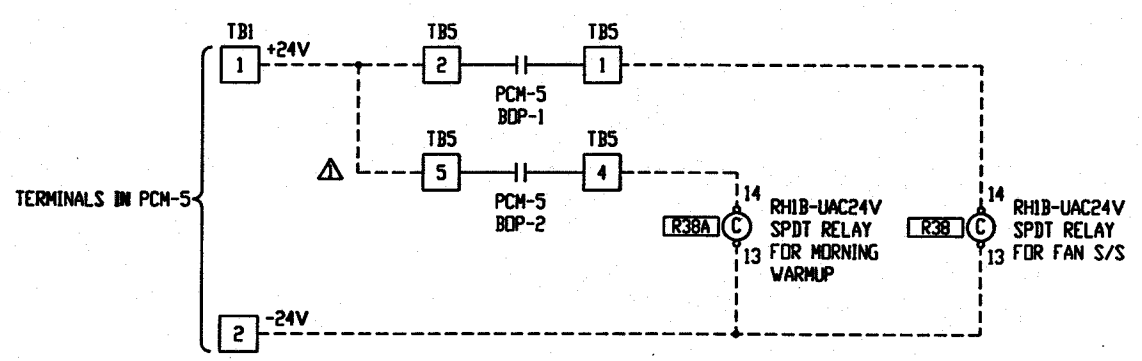

AHU-6 INTERLOCK WIRING DIAGRAM
 - EXISTING CONTROL PANEL -

FAN STATUS SWITCH

LEGEND	
■	THIS COLOR IS INDICATING EXISTING, TO REMAIN AS IS.
■	THIS COLOR IS INDICATING TO BE REMOVED.
■	THIS COLOR IS INDICATING TO BE ABANDONED IN PLACE.
■	THIS COLOR IS INDICATING NEW TO BE ADDED.
(M)	MIAN AIR
*	INDICATES GAUGE MOUNTED ON PANEL FACE.
⊕	CONNECT TO EXISTING

LEGEND	
—	INDICATES FACTORY WIRING
- - -	INDICATES FIELD WIRING

THE DOCUMENTATION HEREIN IS THE EXCLUSIVE PROPERTY OF LAYNE TRANE, CHARLOTTE, N.C. REPRODUCTION AND/OR DISTRIBUTION TO OTHER THAN AUTHORIZED PARTIES IS PROHIBITED.


TRANE
 LAYNE TRANE
 801 PRESSLEY RD
 CHARLOTTE, N.C. 28217
 704 525 3155

REFERENCE DRAWING	NO.	REVISION-LOCATION	DATE	BY
	▲	AS-BUILT	4/9/99	CVF

SALES ENGR.	PROJ. MGR.	APPL. ENGR.	DRAWN BY	DATE
CCR	CVF	CVF	DPC	4/8/99

PROJECT NAME	CONTRACT NUMBER
UNCC-McEniry Charlotte, North Carolina	ICS-98014

DRAWING NUMBER: SHEET 38 OF 51

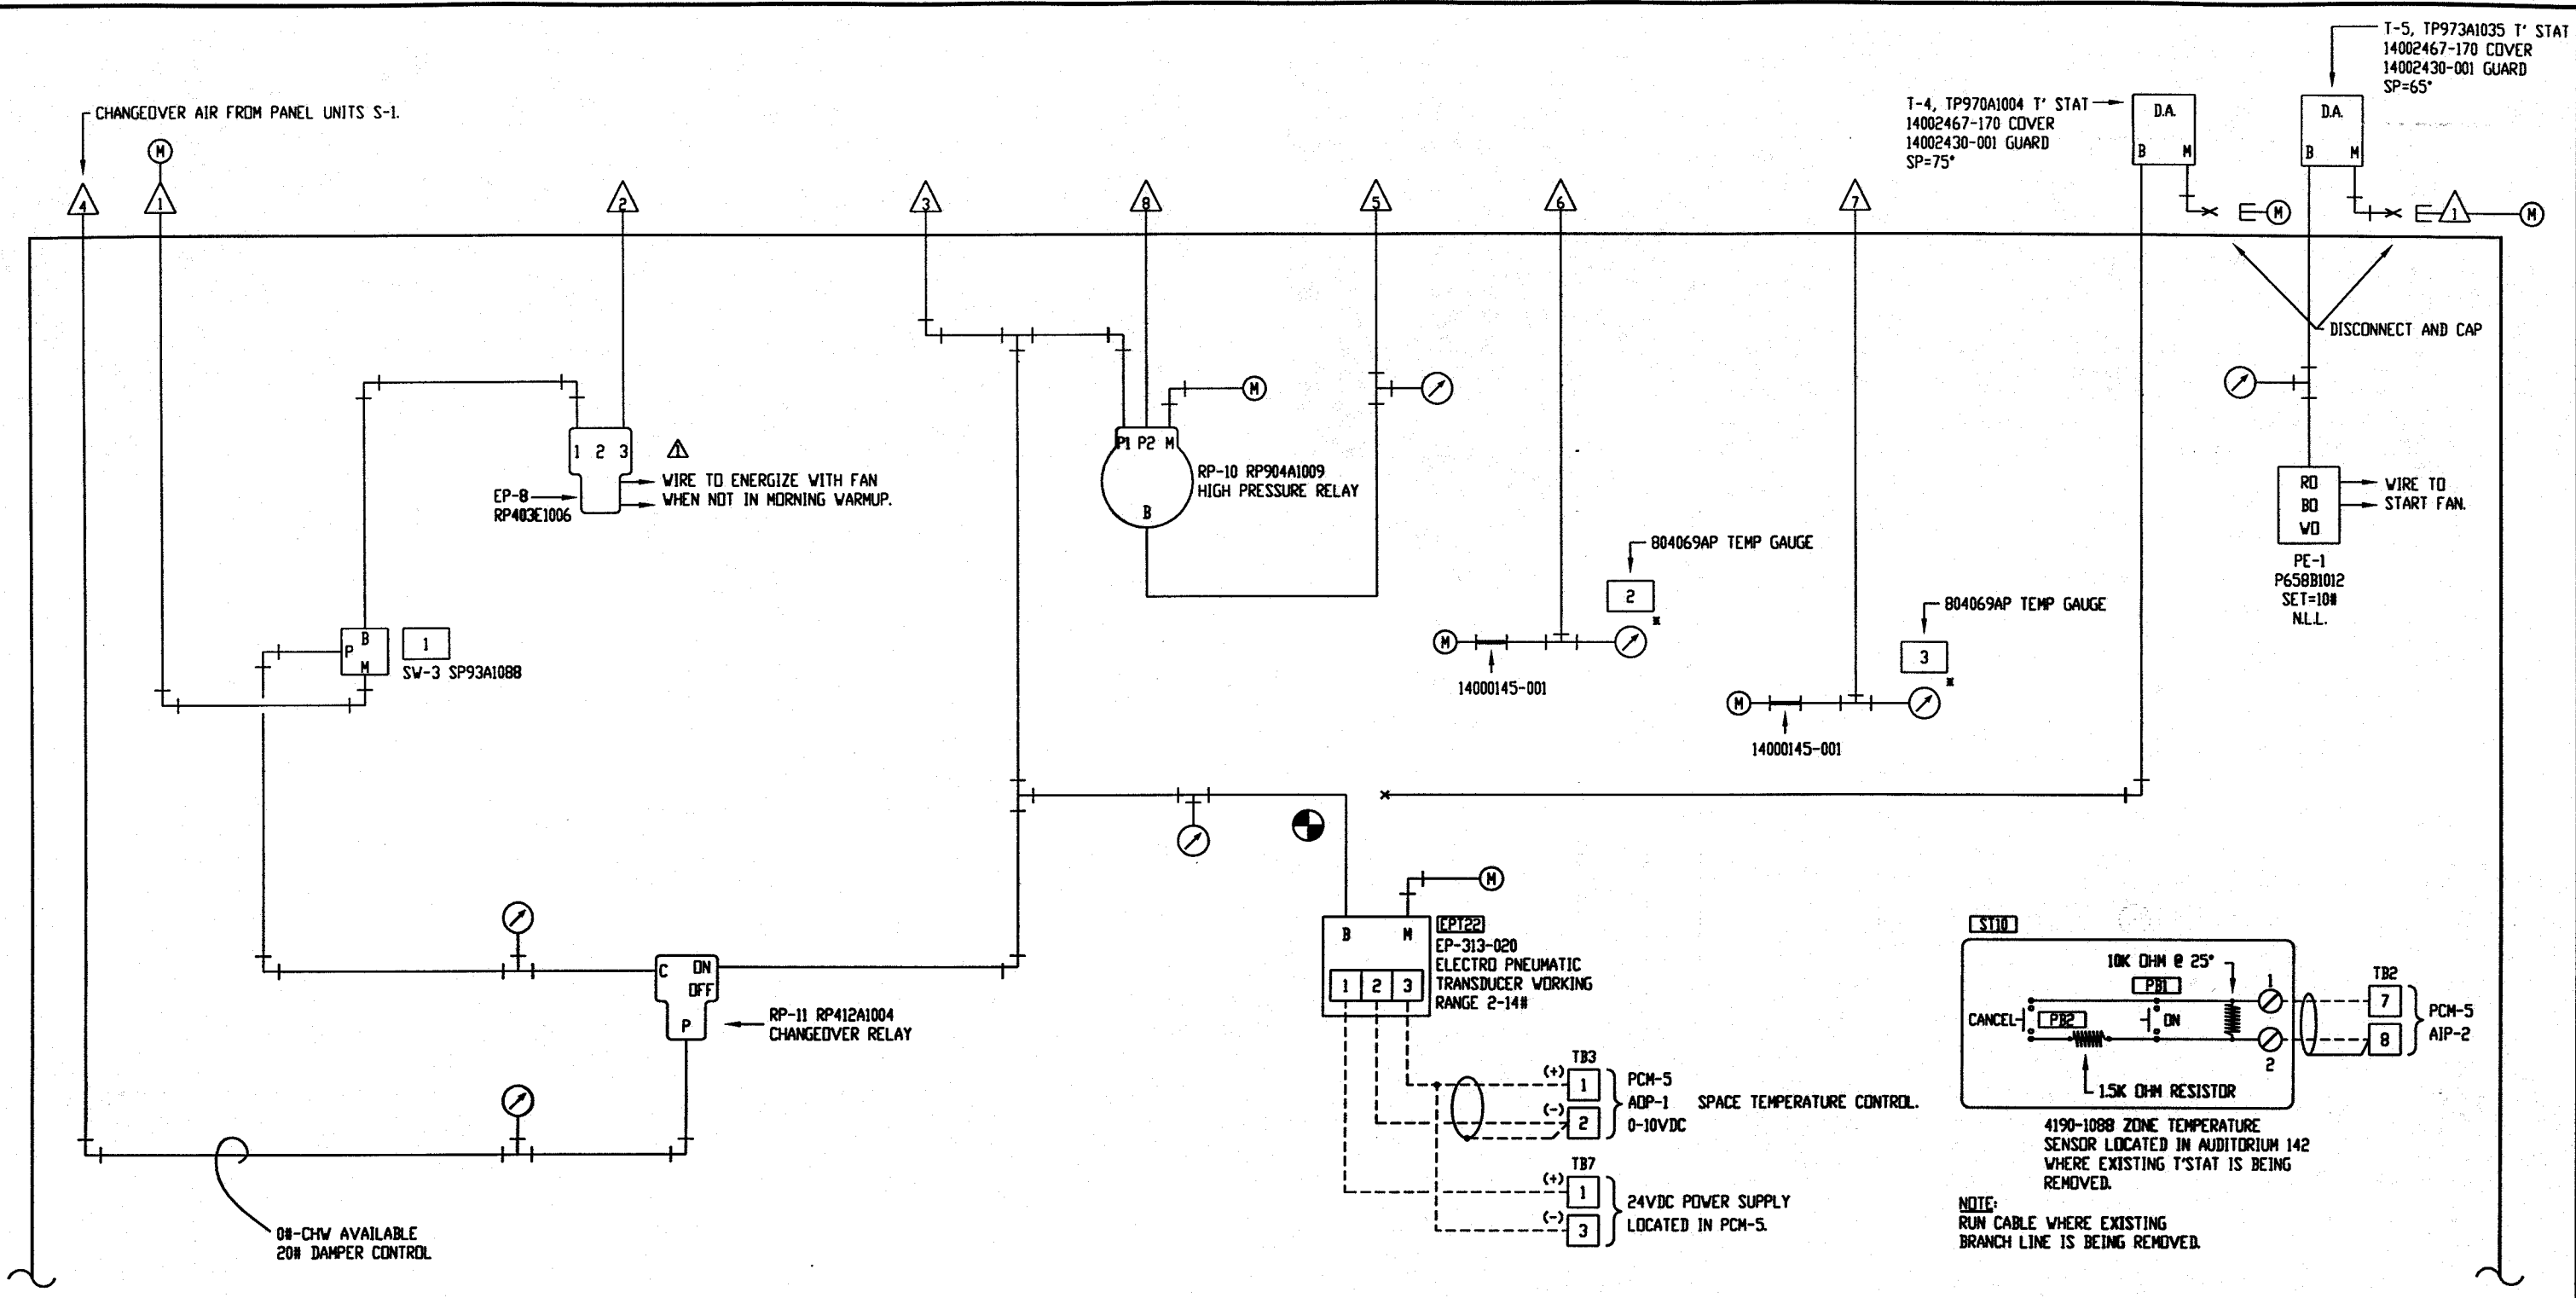

AHU-6 PANEL PNEUMATIC SCHEMATIC
- EXISTING CONTROL PANEL -

LEGEND	
	THIS COLOR IS INDICATING EXISTING, TO REMAIN AS IS.
	THIS COLOR IS INDICATING TO BE REMOVED.
	THIS COLOR IS INDICATING TO BE ABANDONED IN PLACE.
	THIS COLOR IS INDICATING NEW TO BE ADDED.
	MAIN AIR
	INDICATES GAUGE MOUNTED ON PANEL FACE.
	CONNECT TO EXISTING

- 1 MIN. OA DAMPER POSITION
- 2 SUPPLY AIR TEMP.
- 3 RETURN AIR TEMP.

THE DOCUMENTATION HEREIN IS THE EXCLUSIVE PROPERTY OF LAYNE TRANE, CHARLOTTE, N.C. REPRODUCTION AND/OR DISTRIBUTION TO OTHER THAN AUTHORIZED PARTIES IS PROHIBITED.

TRANE
LAYNE TRANE
801 PRESSLEY RD
CHARLOTTE, N.C. 28217
704 525 3155


REFERENCE DRAWING	NO.	REVISION-LOCATION	DATE	BY
	Δ	AS-BUILT	4/9/99	CVF

SALES ENGR.	PROJ. MGR.	APPL. ENGR.	DRAWN BY	DATE
CVF	CVF	CVF	DPC	4/2/98

PROJECT NAME: UNCC-McEniry
Charlotte, North Carolina

CONTRACT NUMBER: ICS-98014
DRAWING NUMBER: SHEET 39 OF 51

NOTE: ALL PRESSURE GAUGES 305909, 0 TO 30# RANGE EXCEPT AS NOTED.

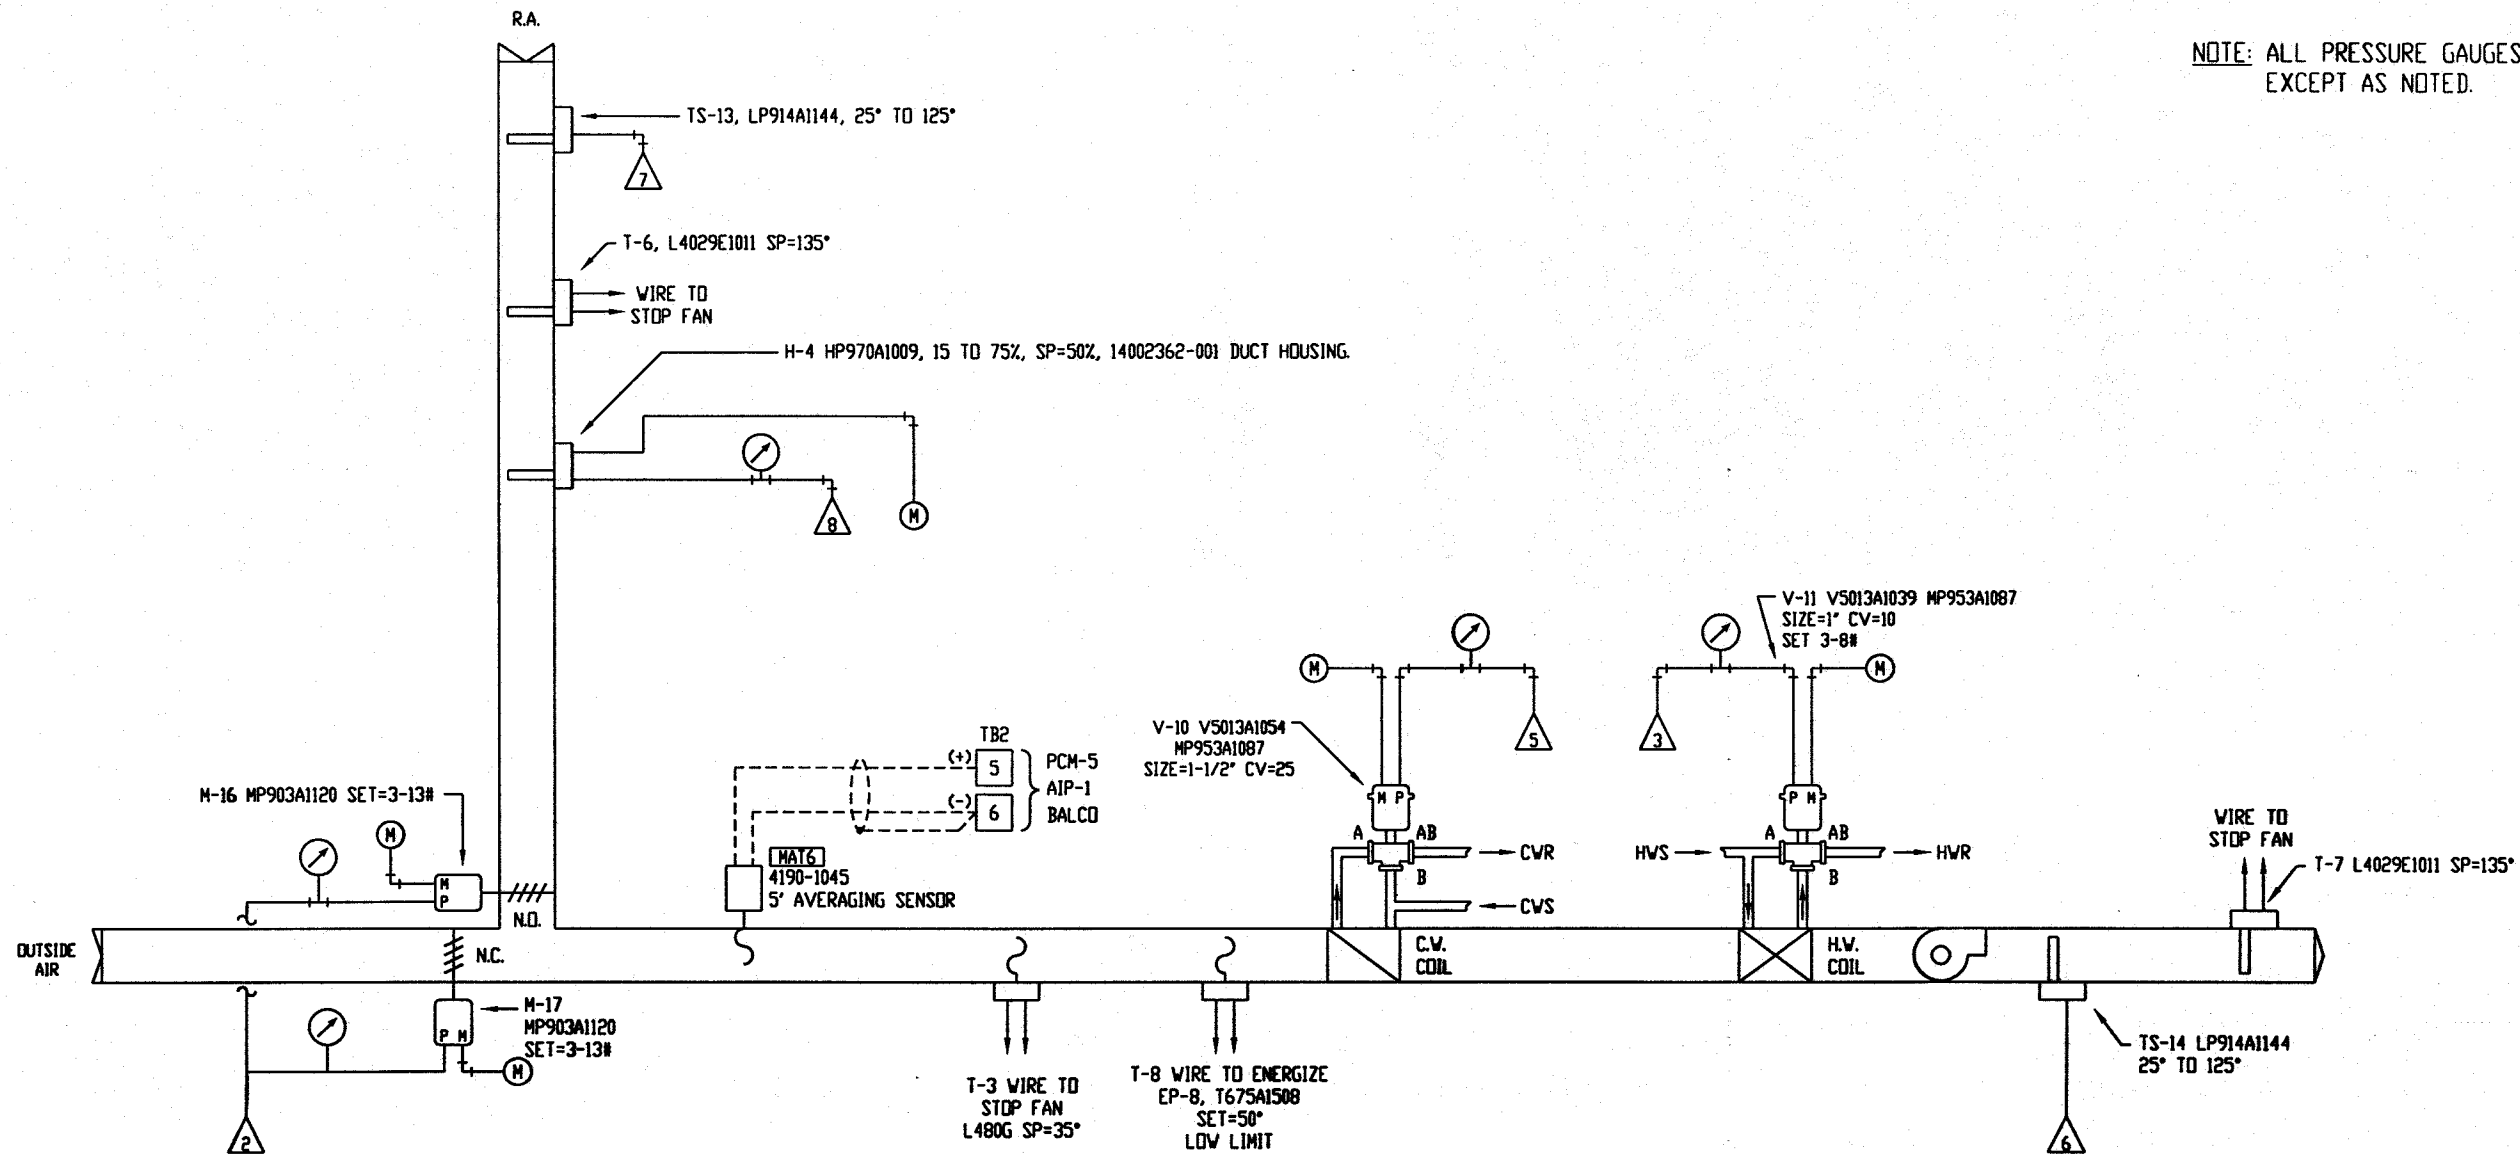


AHU-6 AIR FLOW SCHEMATIC

LEGEND

- THIS COLOR IS INDICATING EXISTING, TO REMAIN AS IS.
- THIS COLOR IS INDICATING TO BE REMOVED.
- THIS COLOR IS INDICATING TO BE ABANDONED IN PLACE.
- THIS COLOR IS INDICATING NEW TO BE ADDED.
- Ⓜ MAIN AIR
- INDICATES GAUGE MOUNTED ON PANEL FACE.
- ⊕ CONNECT TO EXISTING

THE DOCUMENTATION HEREIN IS THE EXCLUSIVE PROPERTY OF LAYNE TRANE, CHARLOTTE, N.C. REPRODUCTION AND/OR DISTRIBUTION TO OTHER THAN AUTHORIZED PARTIES IS PROHIBITED.

<p>LAYNE TRANE 801 PRESSLEY RD CHARLOTTE, N.C. 28217 704 525 3155</p>		REFERENCE DRAWING	NO.	REVISION-LOCATION	DATE	BY
		SALES ENGR. CCR	PROJ. MGR. CVT	APPL. ENGR. CVT	DRAWN BY DPC	DATE: 4/2/98
PROJECT NAME					CONTRACT NUMBER	
UNCC-McEniry Charlotte, North Carolina					ICS-98014	
					DRAWING NUMBER	
					SHEET 40 OF 51	

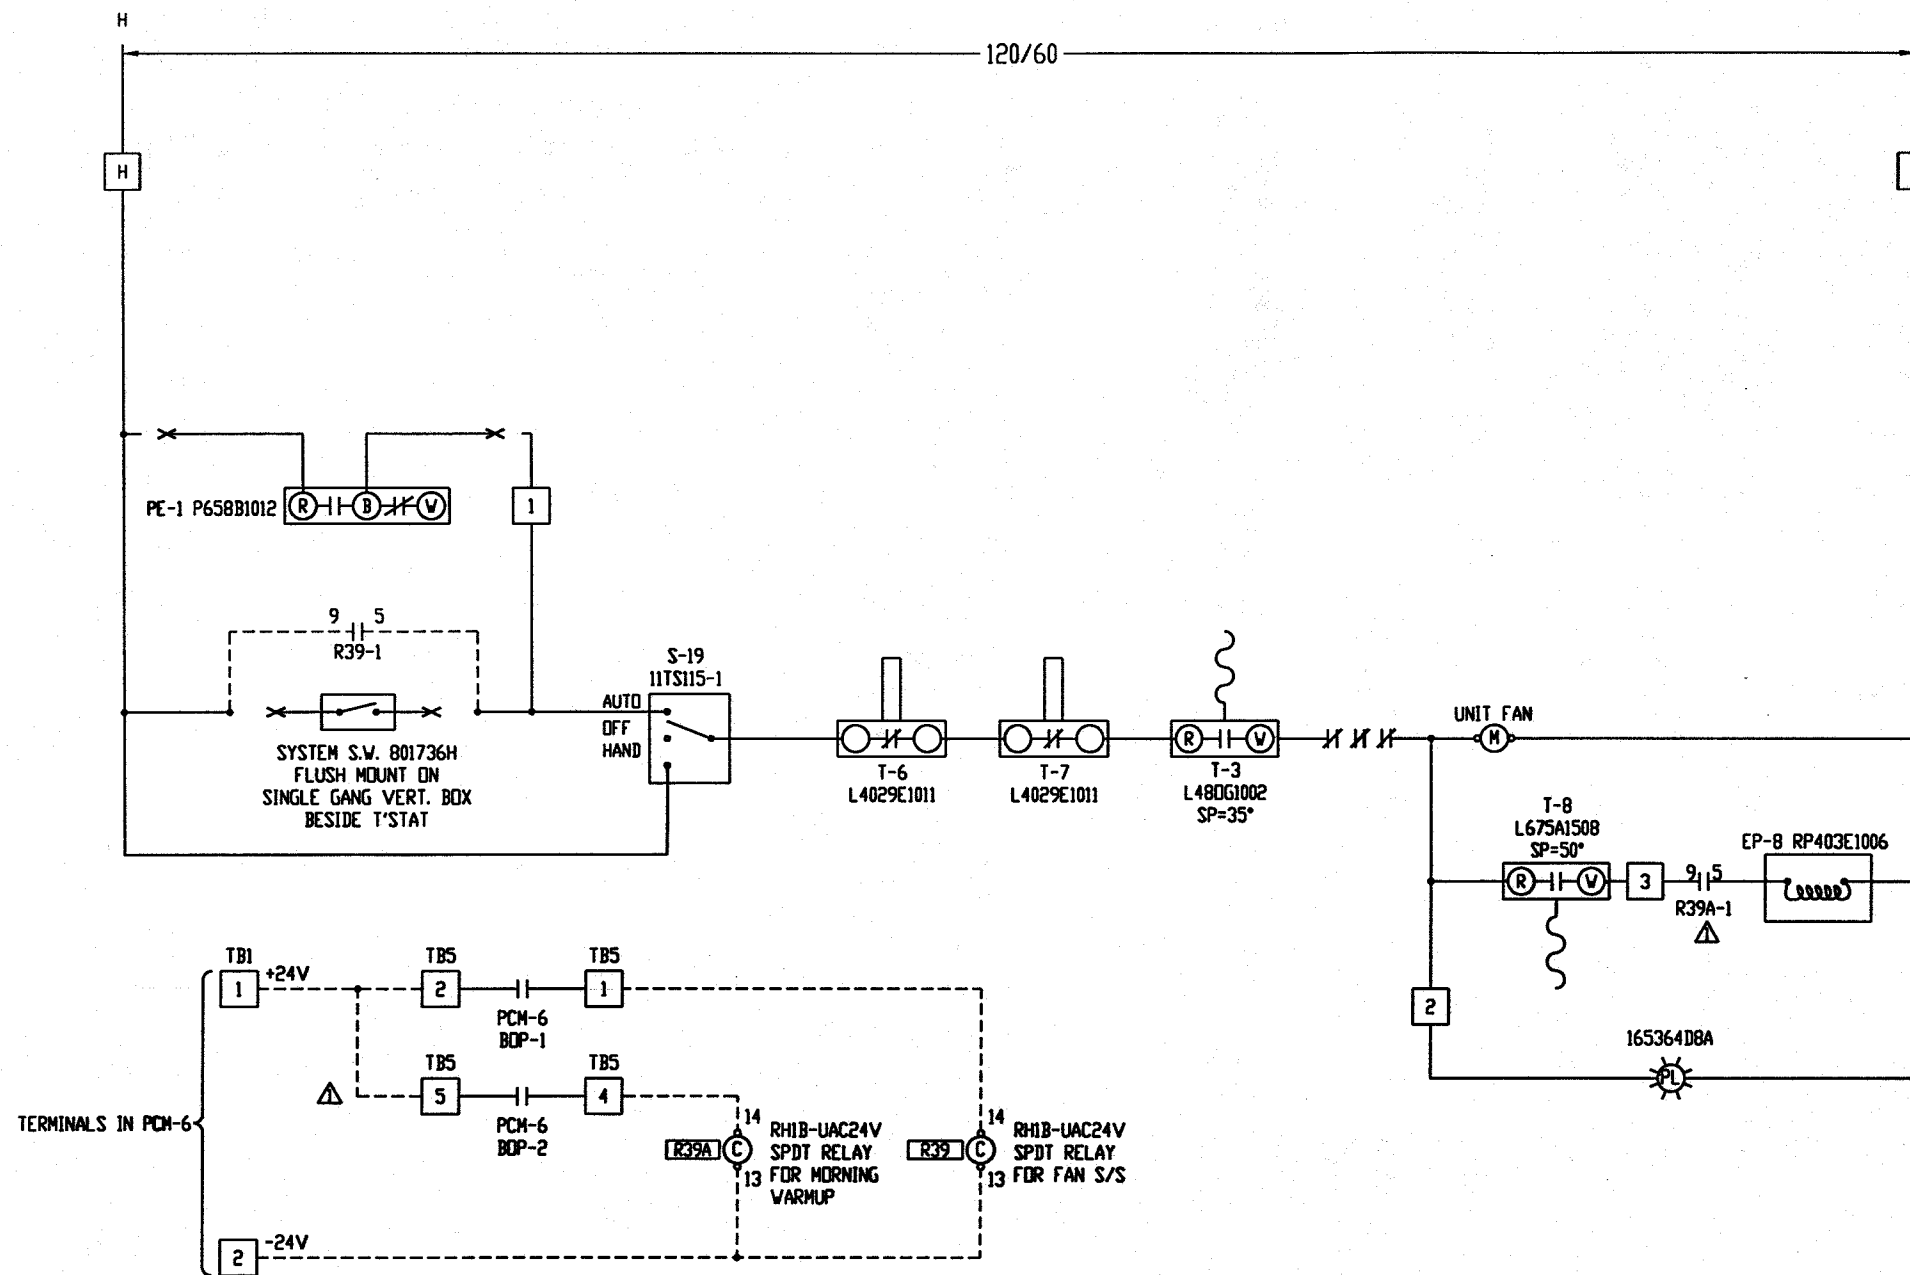



AHU-7 POINTS LIST FOR PCM-6
- SERVING AHU-7 -

- AIP-1 MIXED AIR TEMPERATURE MAT-7.
- AIP-2 AUDITORIUM 142 TEMPERATURE ST-11.
- AIP-3 SPARE

- ADP-1 VALVE CONTROL EPT-23.
- ADP-2 SPARE

- BIP-1 FAN STATUS CS-20.
- BIP-2 SPARE

- BOP-1 FAN START/STOP R-39.
- BOP-2 M.V. RELAY
- BOP-3 SPARE

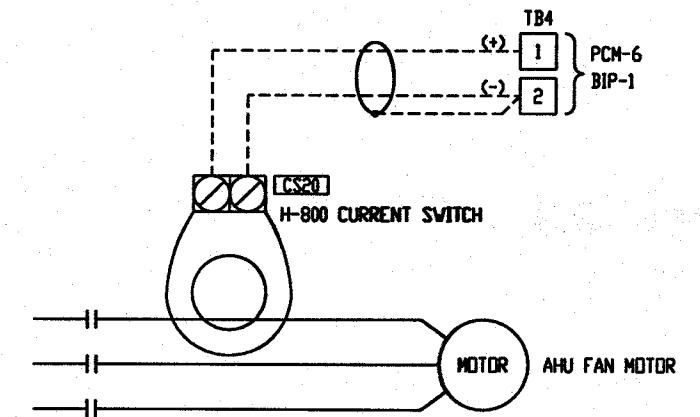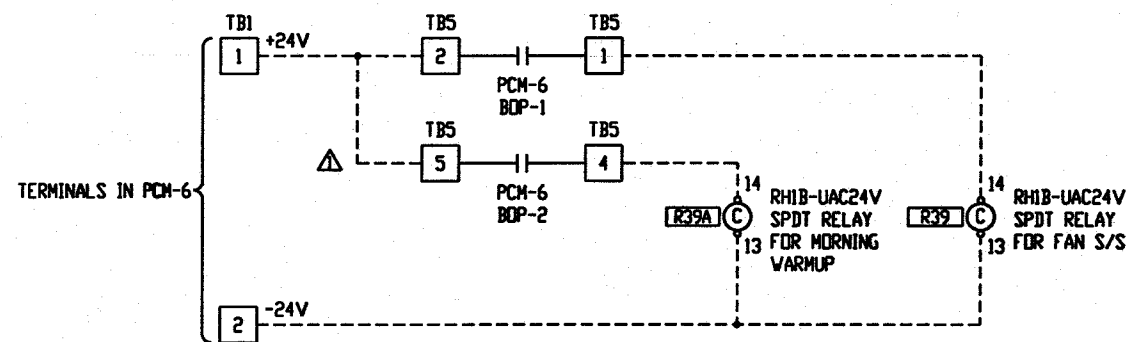

AHU-7 INTERLOCK WIRING DIAGRAM

- EXISTING CONTROL PANEL -

FAN STATUS SWITCH

LEGEND

- THIS COLOR IS INDICATING EXISTING, TO REMAIN AS IS.
- THIS COLOR IS INDICATING TO BE REMOVED.
- THIS COLOR IS INDICATING TO BE ABANDONED IN PLACE.
- THIS COLOR IS INDICATING NEW TO BE ADDED.
- (M) MIAN AIR
- * INDICATES GAUGE MOUNTED ON PANEL FACE.
- ⊕ CONNECT TO EXISTING


LEGEND

- INDICATES EXISTING WIRING
- - - INDICATES FIELD WIRING

THE DOCUMENTATION HEREIN IS THE EXCLUSIVE PROPERTY OF LAYNE TRANE, CHARLOTTE, N.C. REPRODUCTION AND/OR DISTRIBUTION TO OTHER THAN AUTHORIZED PARTIES IS PROHIBITED.

TRANE
LAYNE TRANE
801 PRESSLEY RD
CHARLOTTE, N.C. 28217
704 525 3155


REFERENCE DRAWING	NO.	REVISION-LOCATION	FILE: 11-DWG4
		AS-BUILT	DATE: 4/9/99
			BY: CVF
SALES ENGR. CCR	PROJ. MGR. CVF	APPL. ENGR. CVF	DRAWN BY: DPC
PROJECT NAME: UNCC-McEniry Charlotte, North Carolina			DATE: 4/8/98
CONTRACT NUMBER: ICS-98014			DRAWING NUMBER: SHEET 41 OF 51

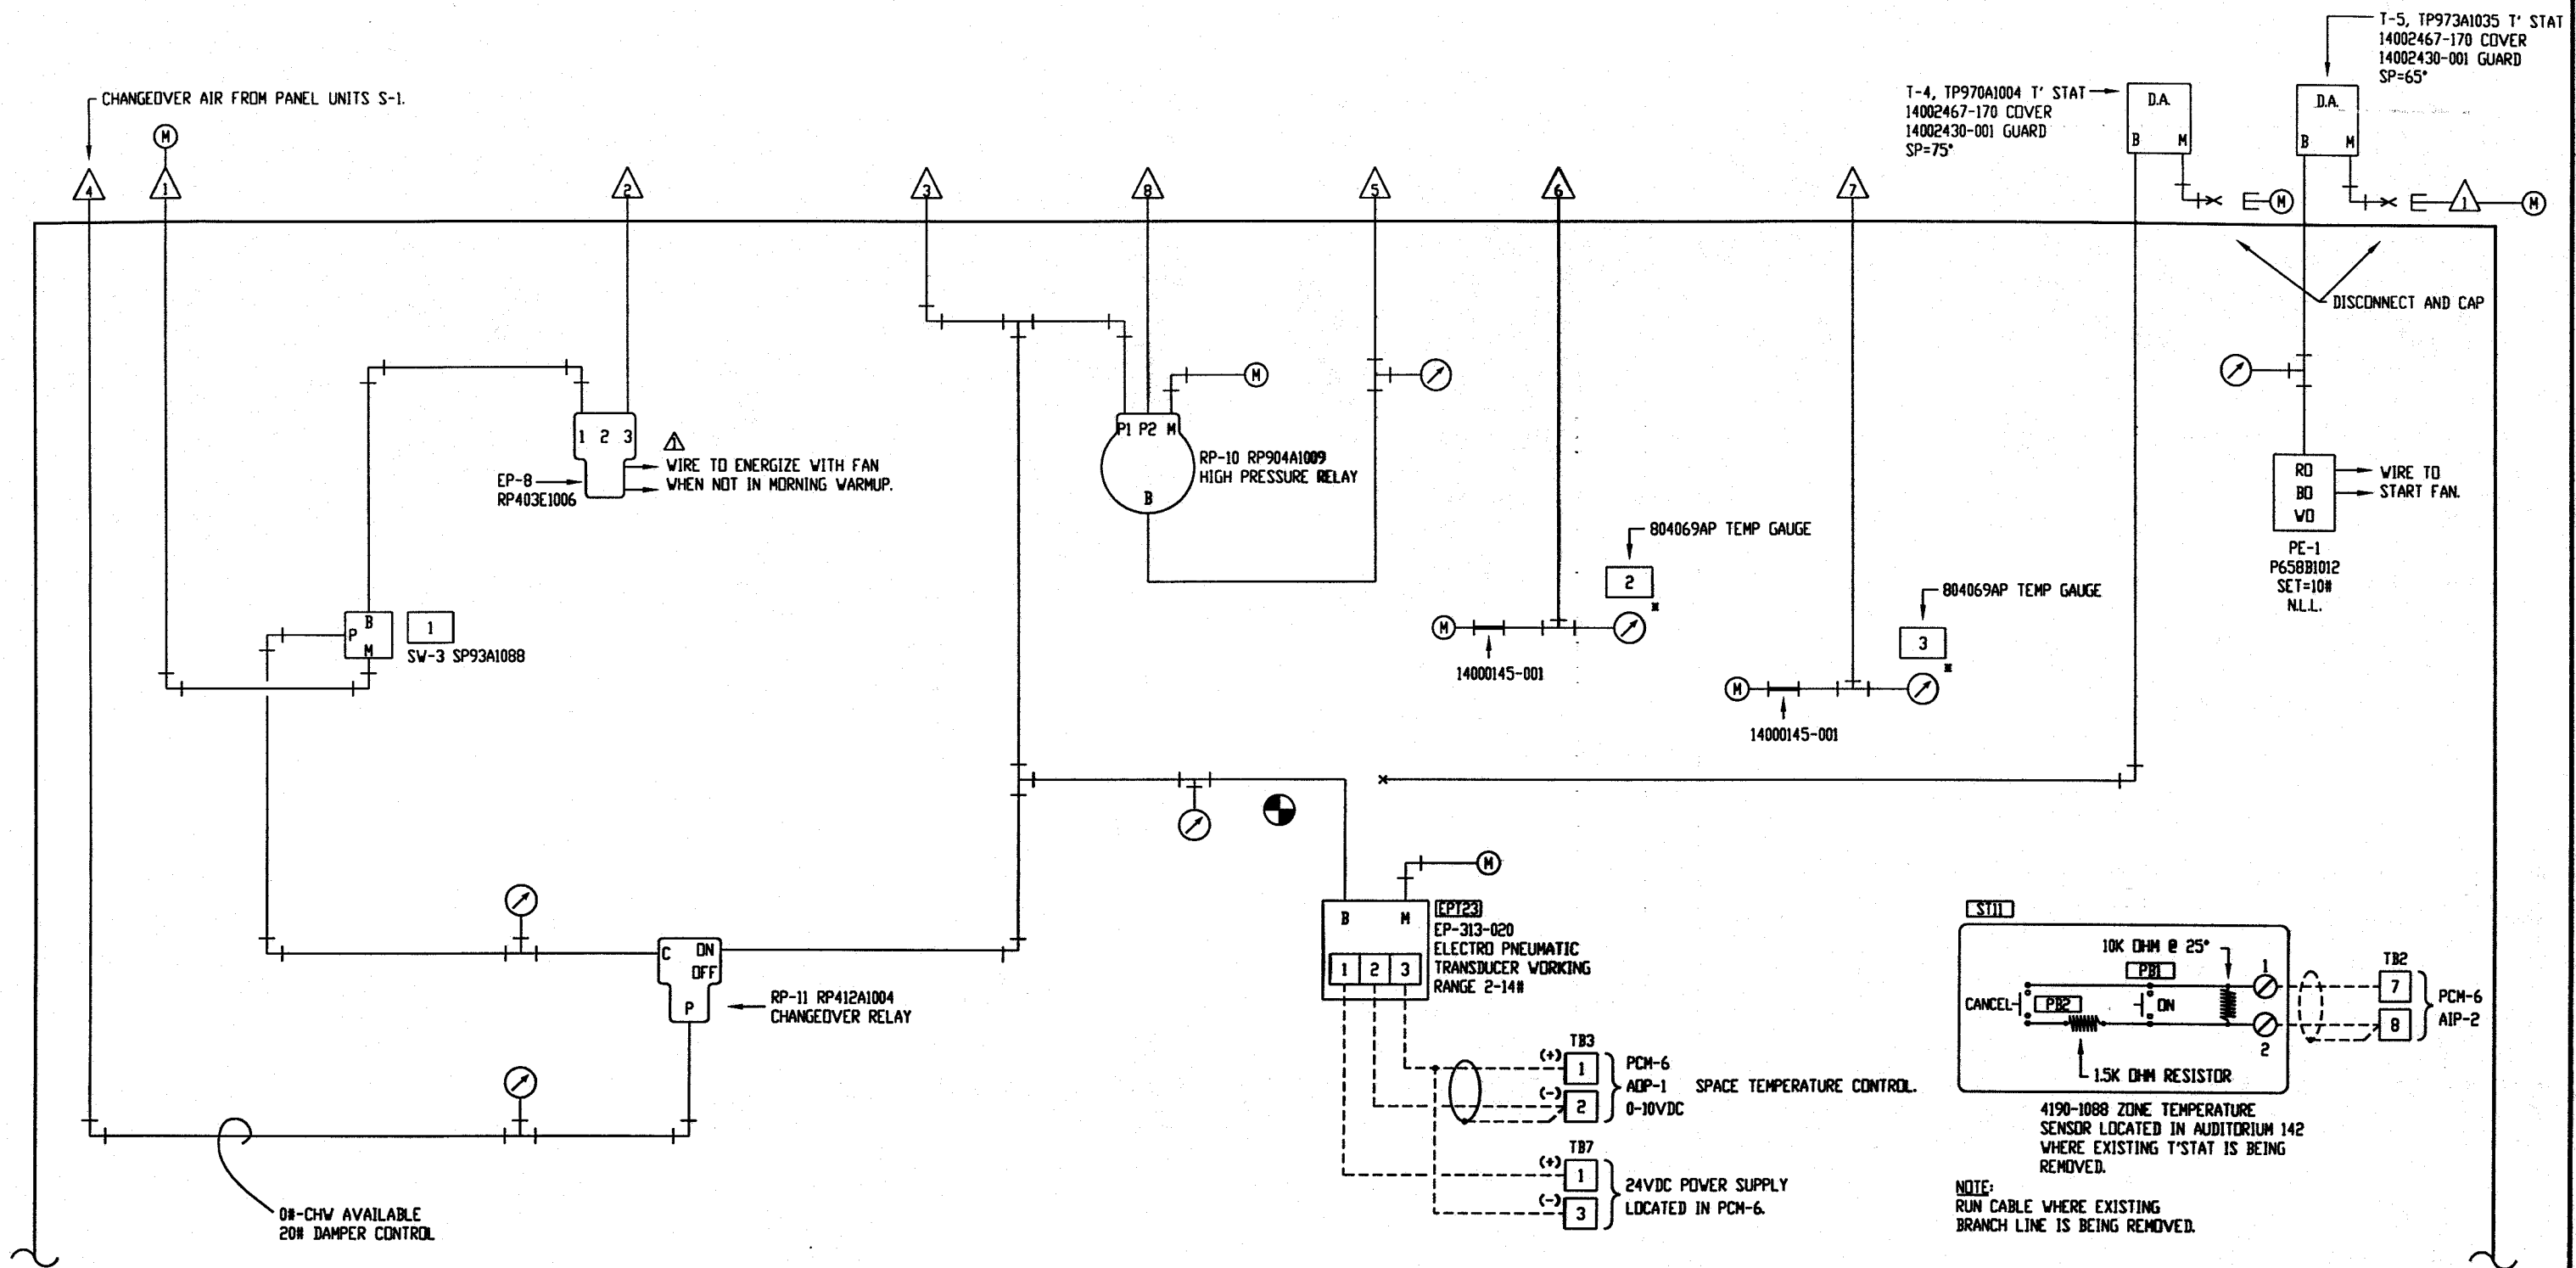

AHU-7 PANEL PNEUMATIC SCHEMATIC
- EXISTING CONTROL PANEL -

LEGEND	
■	THIS COLOR IS INDICATING EXISTING, TO REMAIN AS IS.
■	THIS COLOR IS INDICATING TO BE REMOVED.
■	THIS COLOR IS INDICATING TO BE ABANDONED IN PLACE.
■	THIS COLOR IS INDICATING NEW TO BE ADDED.
(M)	MAIN AIR
*	INDICATES GAUGE MOUNTED ON PANEL FACE.
⊕	CONNECT TO EXISTING

- 1 MIN. OA DAMPER POSITION
- 2 SUPPLY AIR TEMP.
- 3 RETURN AIR TEMP.

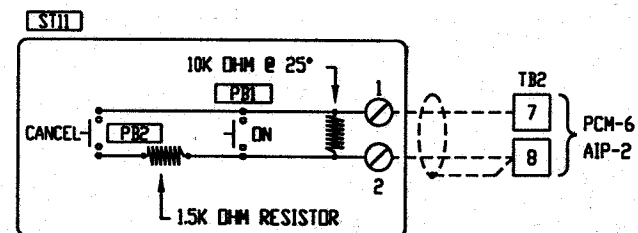

4190-1088 ZONE TEMPERATURE SENSOR LOCATED IN AUDITORIUM 142 WHERE EXISTING T*STAT IS BEING REMOVED.
NOTE: RUN CABLE WHERE EXISTING BRANCH LINE IS BEING REMOVED.


THE DOCUMENTATION HEREIN IS THE EXCLUSIVE PROPERTY OF LAYNE TRANE, CHARLOTTE, N.C. REPRODUCTION AND/OR DISTRIBUTION TO OTHER THAN AUTHORIZED PARTIES IS PROHIBITED.

TRANE
LAYNE TRANE
801 PRESSLEY RD
CHARLOTTE, N.C. 28217
704 525 3155

REFERENCE DRAWING	NO.	REVISION-LOCATION	DATE	BY
	AS-BUILT		4/9/99	CVF

SALES ENGR. CCR	PROJ. MGR. CVF	APPL. ENGR. CVF	DRAWN BY DPC	DATE: 4/2/98
PROJECT NAME				CONTRACT NUMBER
UNCC-McEniry				ICS-98014
Charlotte, North Carolina				DRAWING NUMBER
				SHEET 42 OF 51

NOTE: ALL PRESSURE GAUGES 305909, 0 TO 30# RANGE EXCEPT AS NOTED.

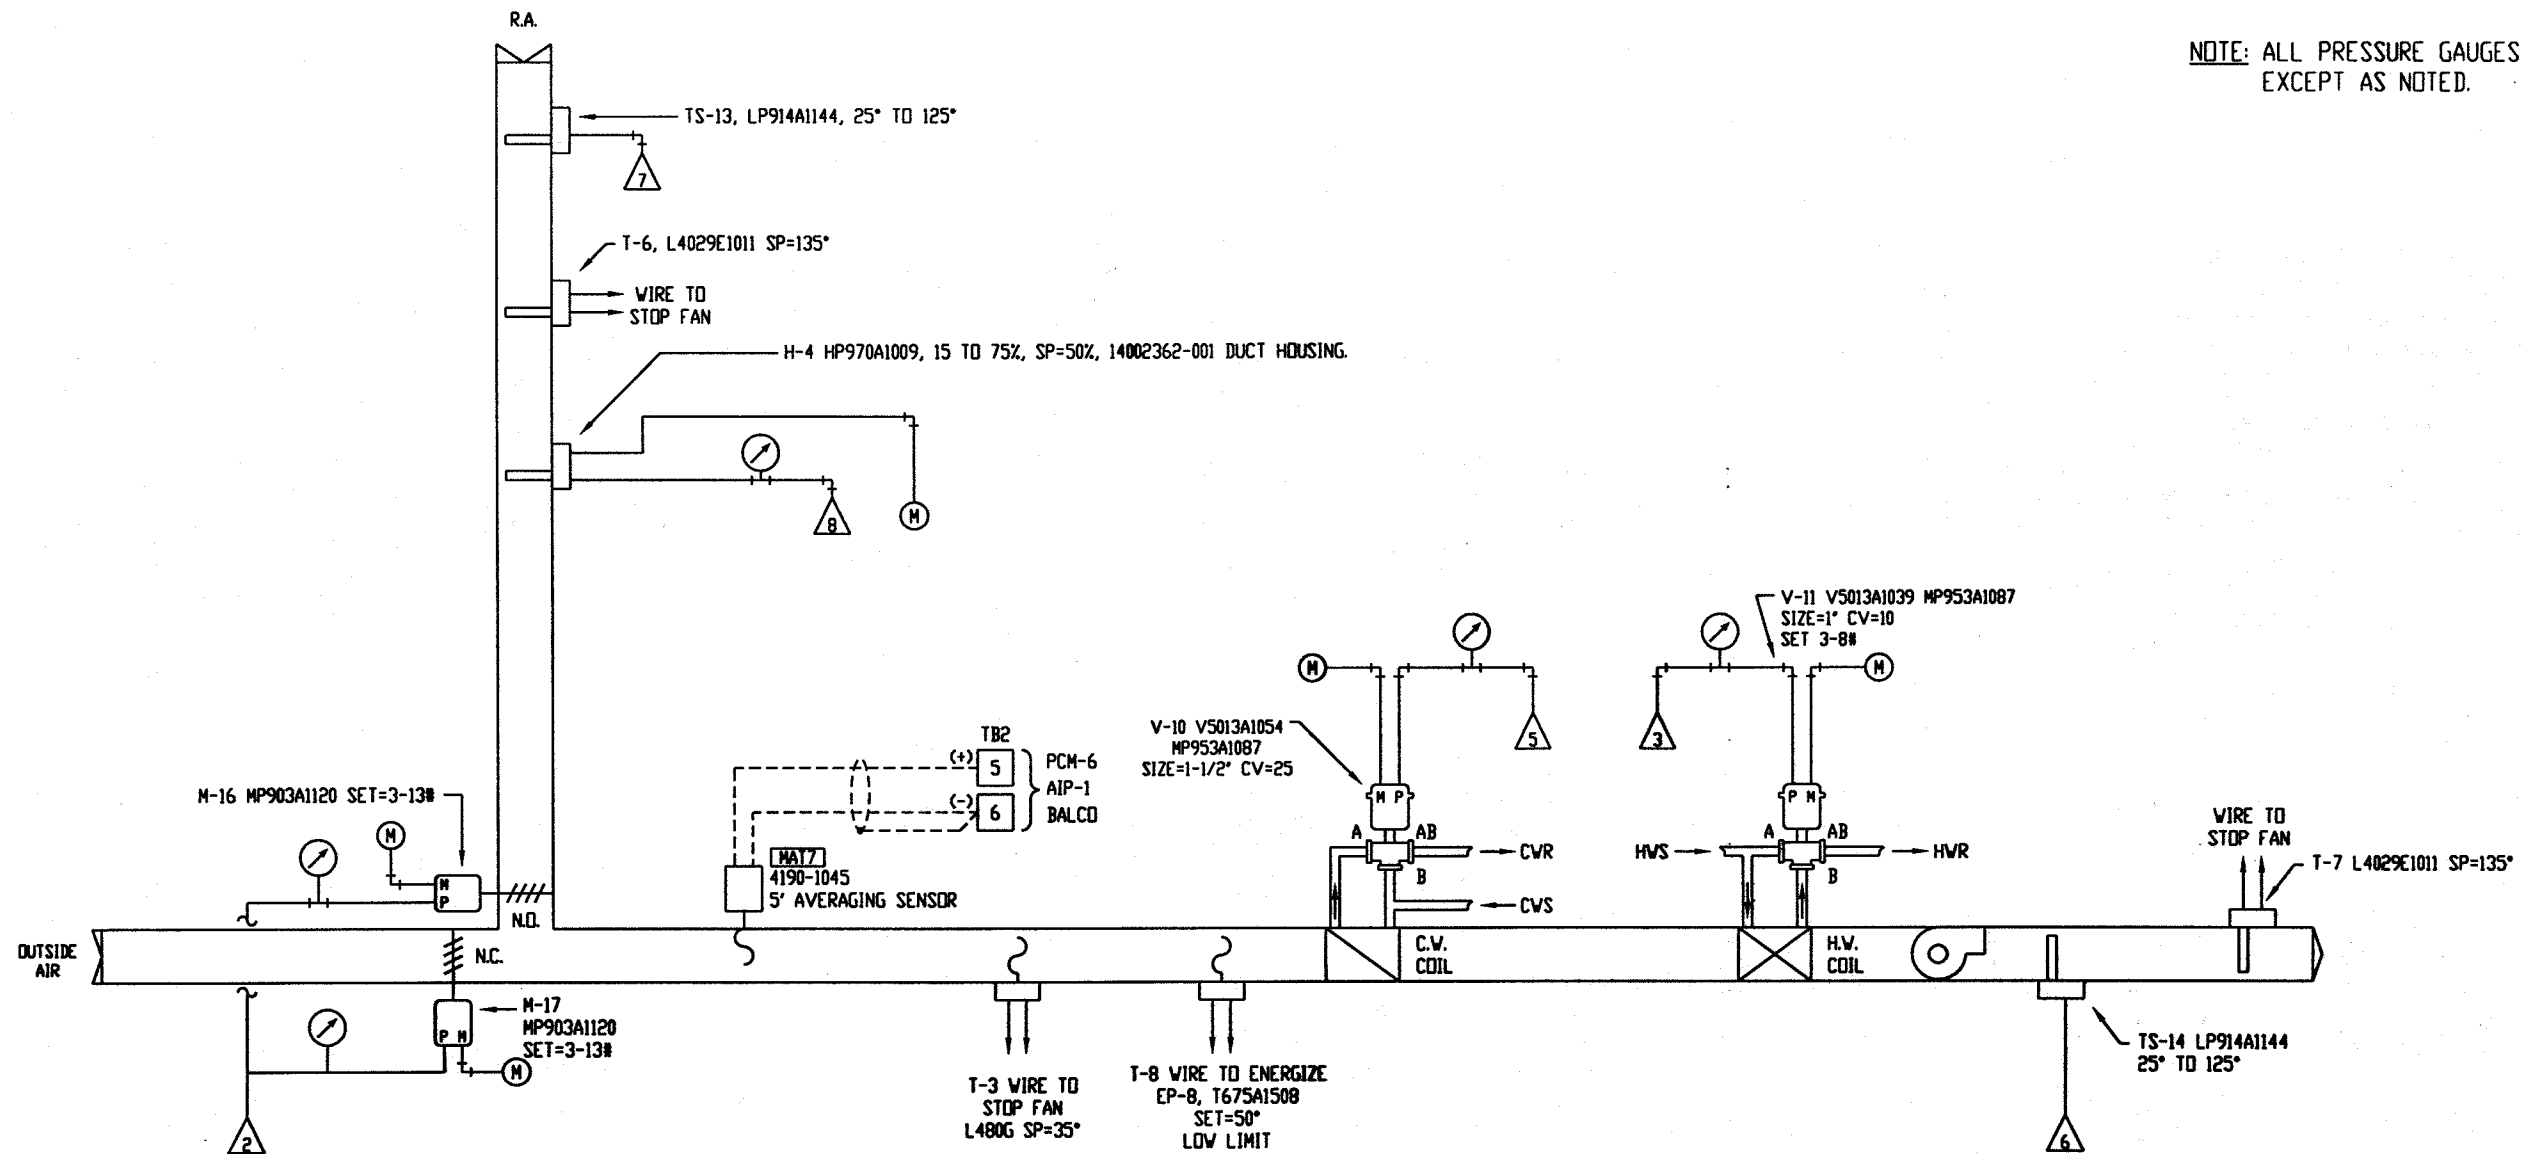


AHU-7 AIR FLOW SCHEMATIC

LEGEND	
■	THIS COLOR IS INDICATING EXISTING, TO REMAIN AS IS.
■	THIS COLOR IS INDICATING TO BE REMOVED.
■	THIS COLOR IS INDICATING TO BE ABANDONED IN PLACE.
■	THIS COLOR IS INDICATING NEW TO BE ADDED.
(M)	MAIN AIR
*	INDICATES GAUGE MOUNTED ON PANEL FACE.
⊕	CONNECT TO EXISTING

THE DOCUMENTATION HEREIN IS THE EXCLUSIVE PROPERTY OF LAYNE TRANE, CHARLOTTE, N.C. REPRODUCTION AND/OR DISTRIBUTION TO OTHER THAN AUTHORIZED PARTIES IS PROHIBITED.



REFERENCE DRAWING		NO.		REVISION-LOCATION		DATE		BY	
SALES ENGR	PROJ. MGR	APPL. ENGR	DRAWN BY	DATE: 4/2/98					
CER	CVF	CVF	DPC	PROJECT NAME: UNCC-McEniry, Charlotte, North Carolina					
				CONTRACT NUMBER: ICS-98014					
				DRAWING NUMBER: SHEET 43 OF 51					

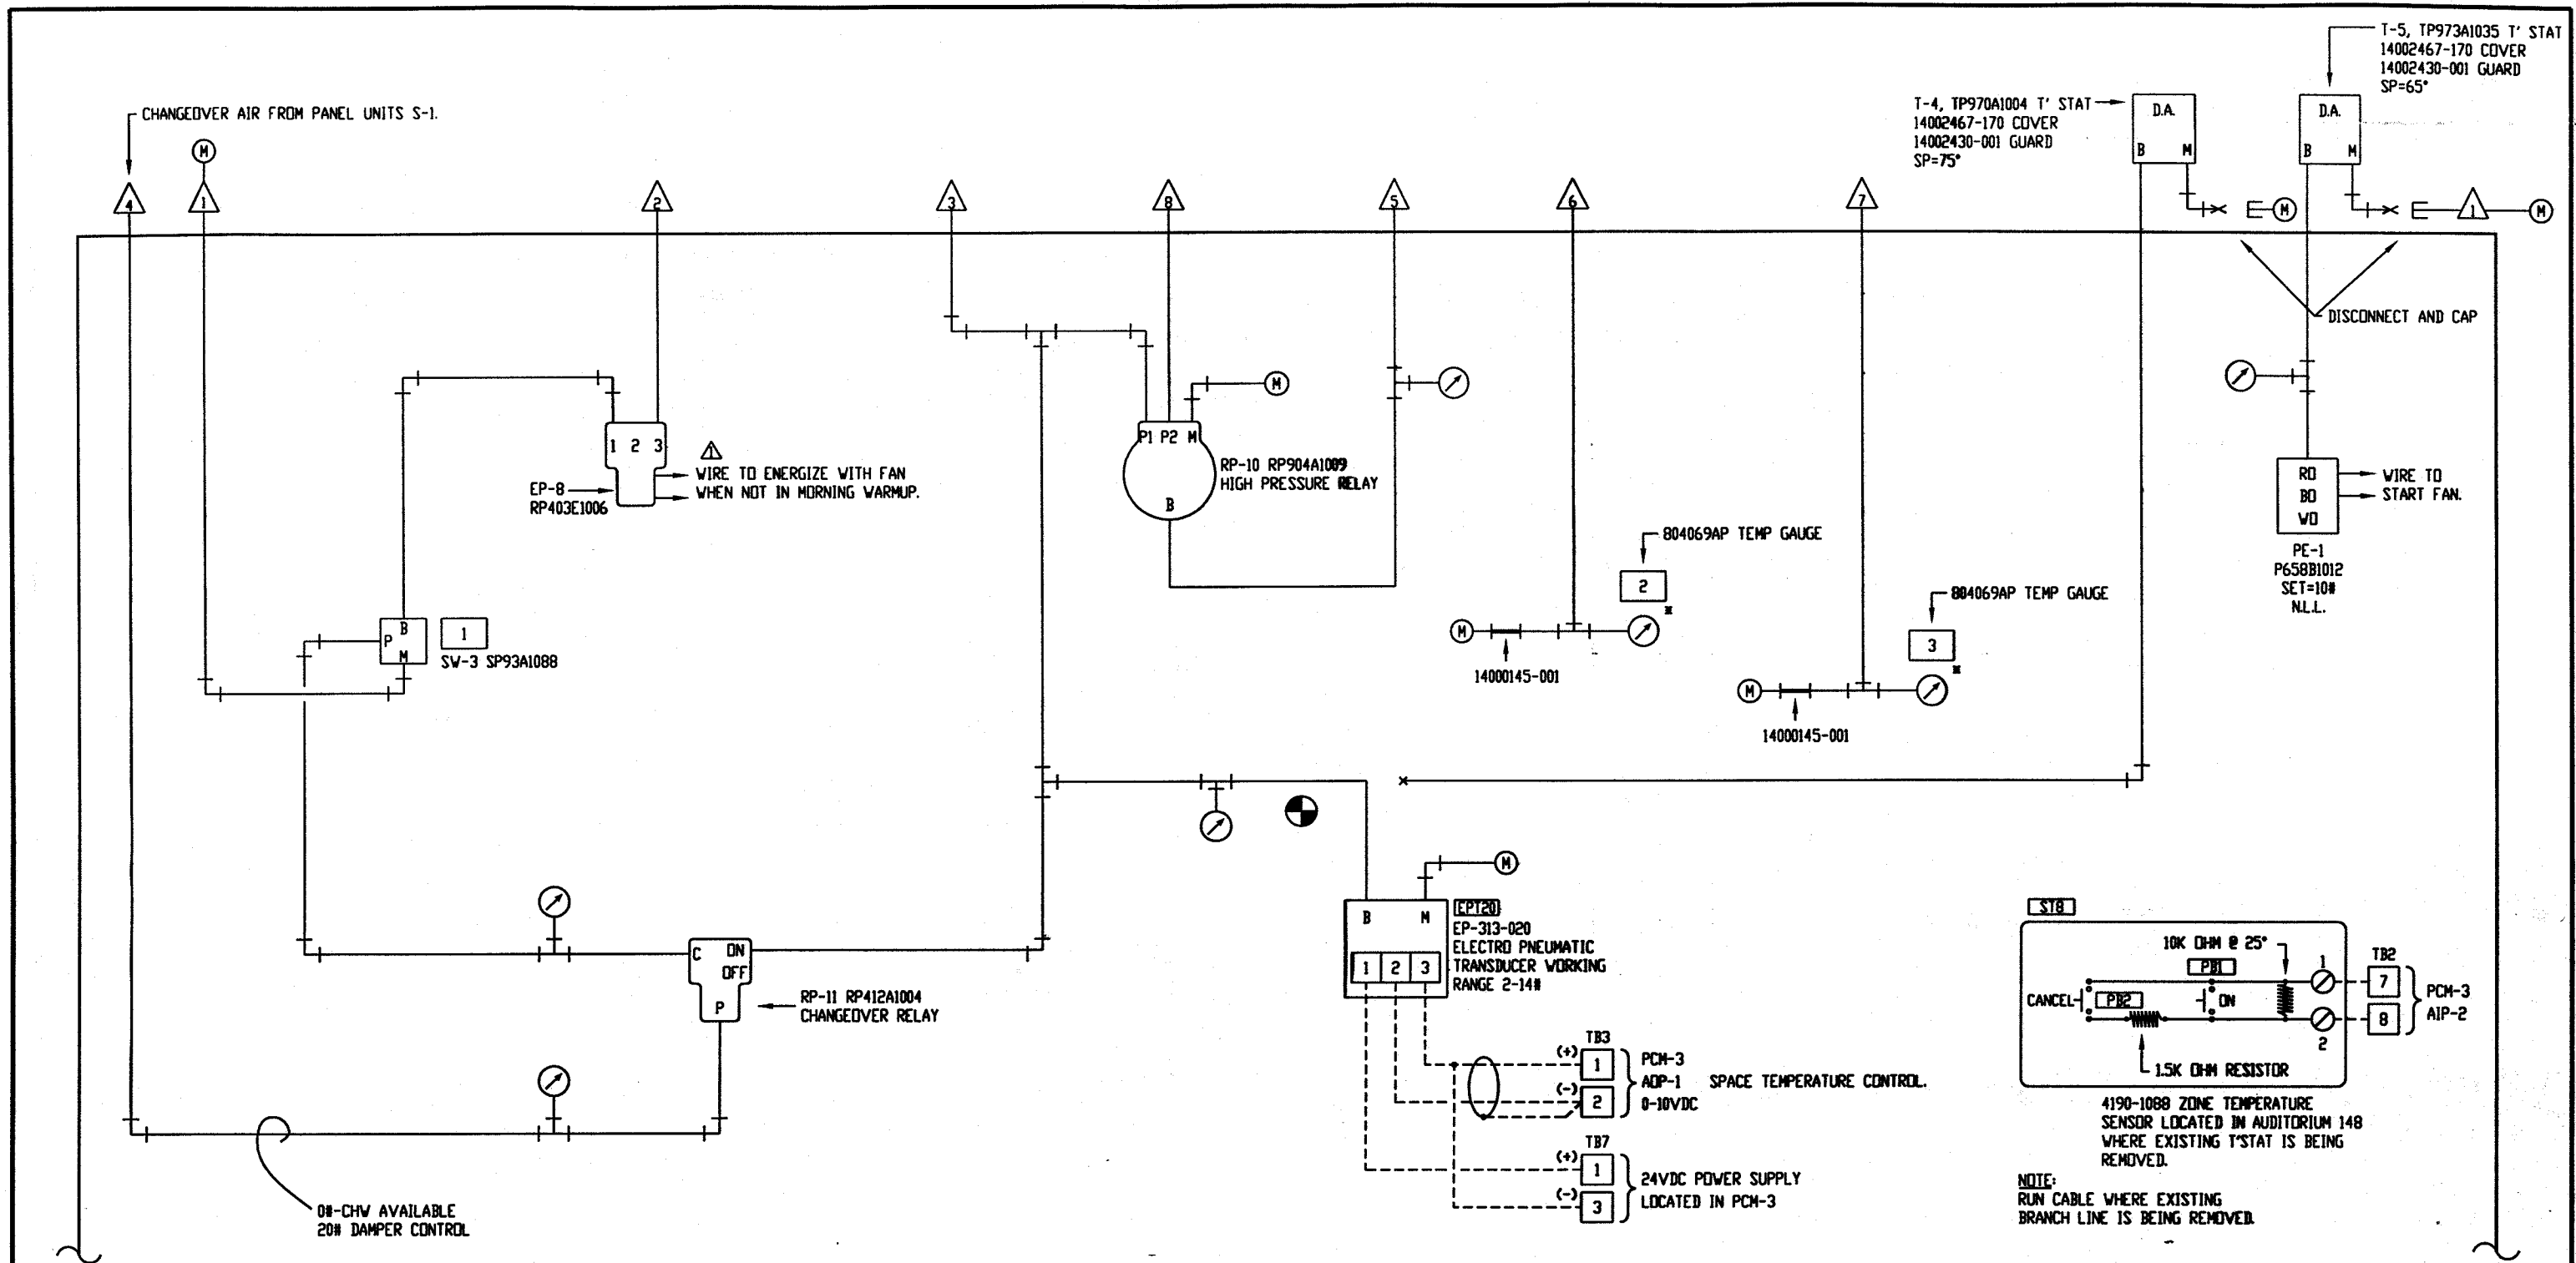

AHU-8 PANEL PNEUMATIC SCHEMATIC

LEGEND	
■	THIS COLOR IS INDICATING EXISTING, TO REMAIN AS IS.
■	THIS COLOR IS INDICATING TO BE REMOVED.
■	THIS COLOR IS INDICATING TO BE ABANDONED IN PLACE.
■	THIS COLOR IS INDICATING NEW TO BE ADDED.
(M)	MAIN AIR
*	INDICATES GAUGE MOUNTED ON PANEL FACE.
⊕	CONNECT TO EXISTING

- 1 MIN. DA DAMPER POSITION
- 2 SUPPLY AIR TEMP.
- 3 RETURN AIR TEMP.


LEGEND	
—	INDICATES EXISTING WIRING
- - -	INDICATES FIELD WIRING

THE DOCUMENTATION HEREIN IS THE EXCLUSIVE PROPERTY OF LAYNE TRANE, CHARLOTTE, N.C. REPRODUCTION AND/OR DISTRIBUTION TO OTHER THAN AUTHORIZED PARTIES IS PROHIBITED.

TRANE
 LAYNE TRANE
 801 PRESSLEY RD
 CHARLOTTE, N.C. 28217
 704 525 3155

FILE: AHU8-P				
REFERENCE DRAWING	NO.	REVISION-LOCATION	DATE	BY
	Δ	AS-BUILT	4/9/99	CVF
SALES ENGR. CCR PROJ. MGR. CVF APPL. ENGR. CVF DRAWN BY DPC DATE: 4/2/98				
PROJECT NAME			CONTRACT NUMBER	
UNCC-McEniry Charlotte, North Carolina			ICS-98014	
			DRAWING NUMBER	
			SHEET 45 OF 51	

NOTE: ALL PRESSURE GAUGES 305909, 0 TO 30# RANGE EXCEPT AS NOTED.

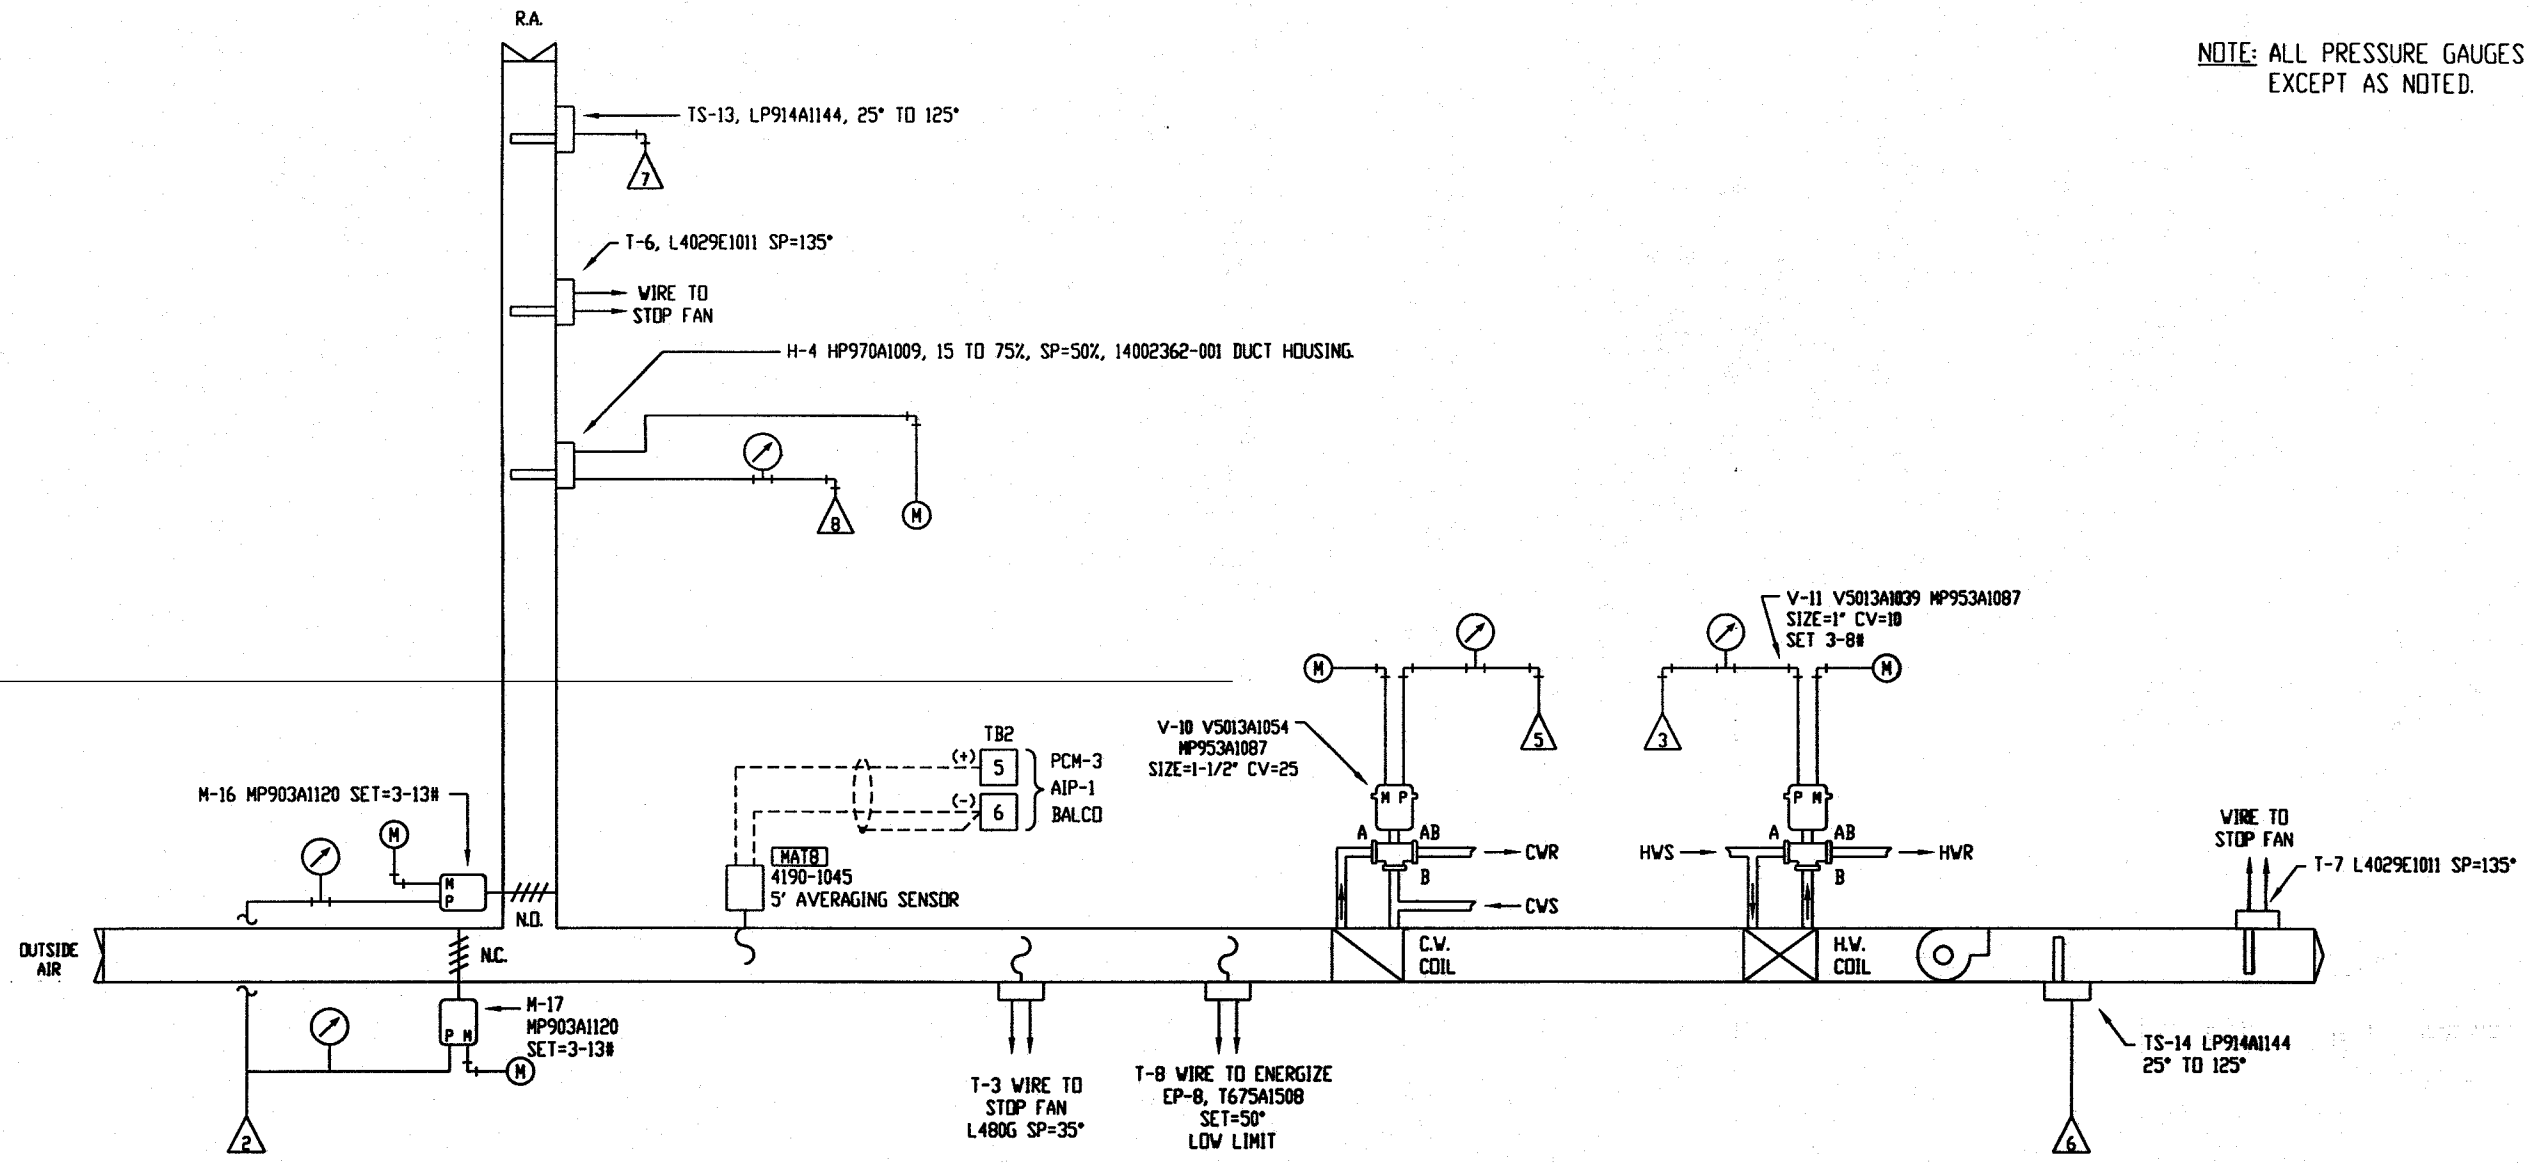


AHU-8 AIR FLOW SCHEMATIC

LEGEND	
■	THIS COLOR IS INDICATING EXISTING, TO REMAIN AS IS.
■	THIS COLOR IS INDICATING TO BE REMOVED.
■	THIS COLOR IS INDICATING TO BE ABANDONED IN PLACE.
■	THIS COLOR IS INDICATING NEW TO BE ADDED.
Ⓜ	MAIN AIR
*	INDICATES GAUGE MOUNTED ON PANEL FACE.
⊕	CONNECT TO EXISTING


THE DOCUMENTATION HEREIN IS THE EXCLUSIVE PROPERTY OF LAYNE TRANE, CHARLOTTE, N.C. REPRODUCTION AND/OR DISTRIBUTION TO OTHER THAN AUTHORIZED PARTIES IS PROHIBITED.

LAYNE TRANE
801 PRESSLEY RD
CHARLOTTE, N.C. 28217
704 525 3155


REFERENCE DRAWING				NO.		REVISION-LOCATION		FILE: AHU-8	
SALES ENGR.	PROJ. MGR.	APPL. ENGR.	DRAWN BY	DATE	BY				
CCR	CVF	CVF	DPC	4/2/98					
PROJECT NAME						CONTRACT NUMBER			
UNCC-McEniry						ICS-98014			
Charlotte, North Carolina						DRAWING NUMBER			
						SHEET 46 OF 51			

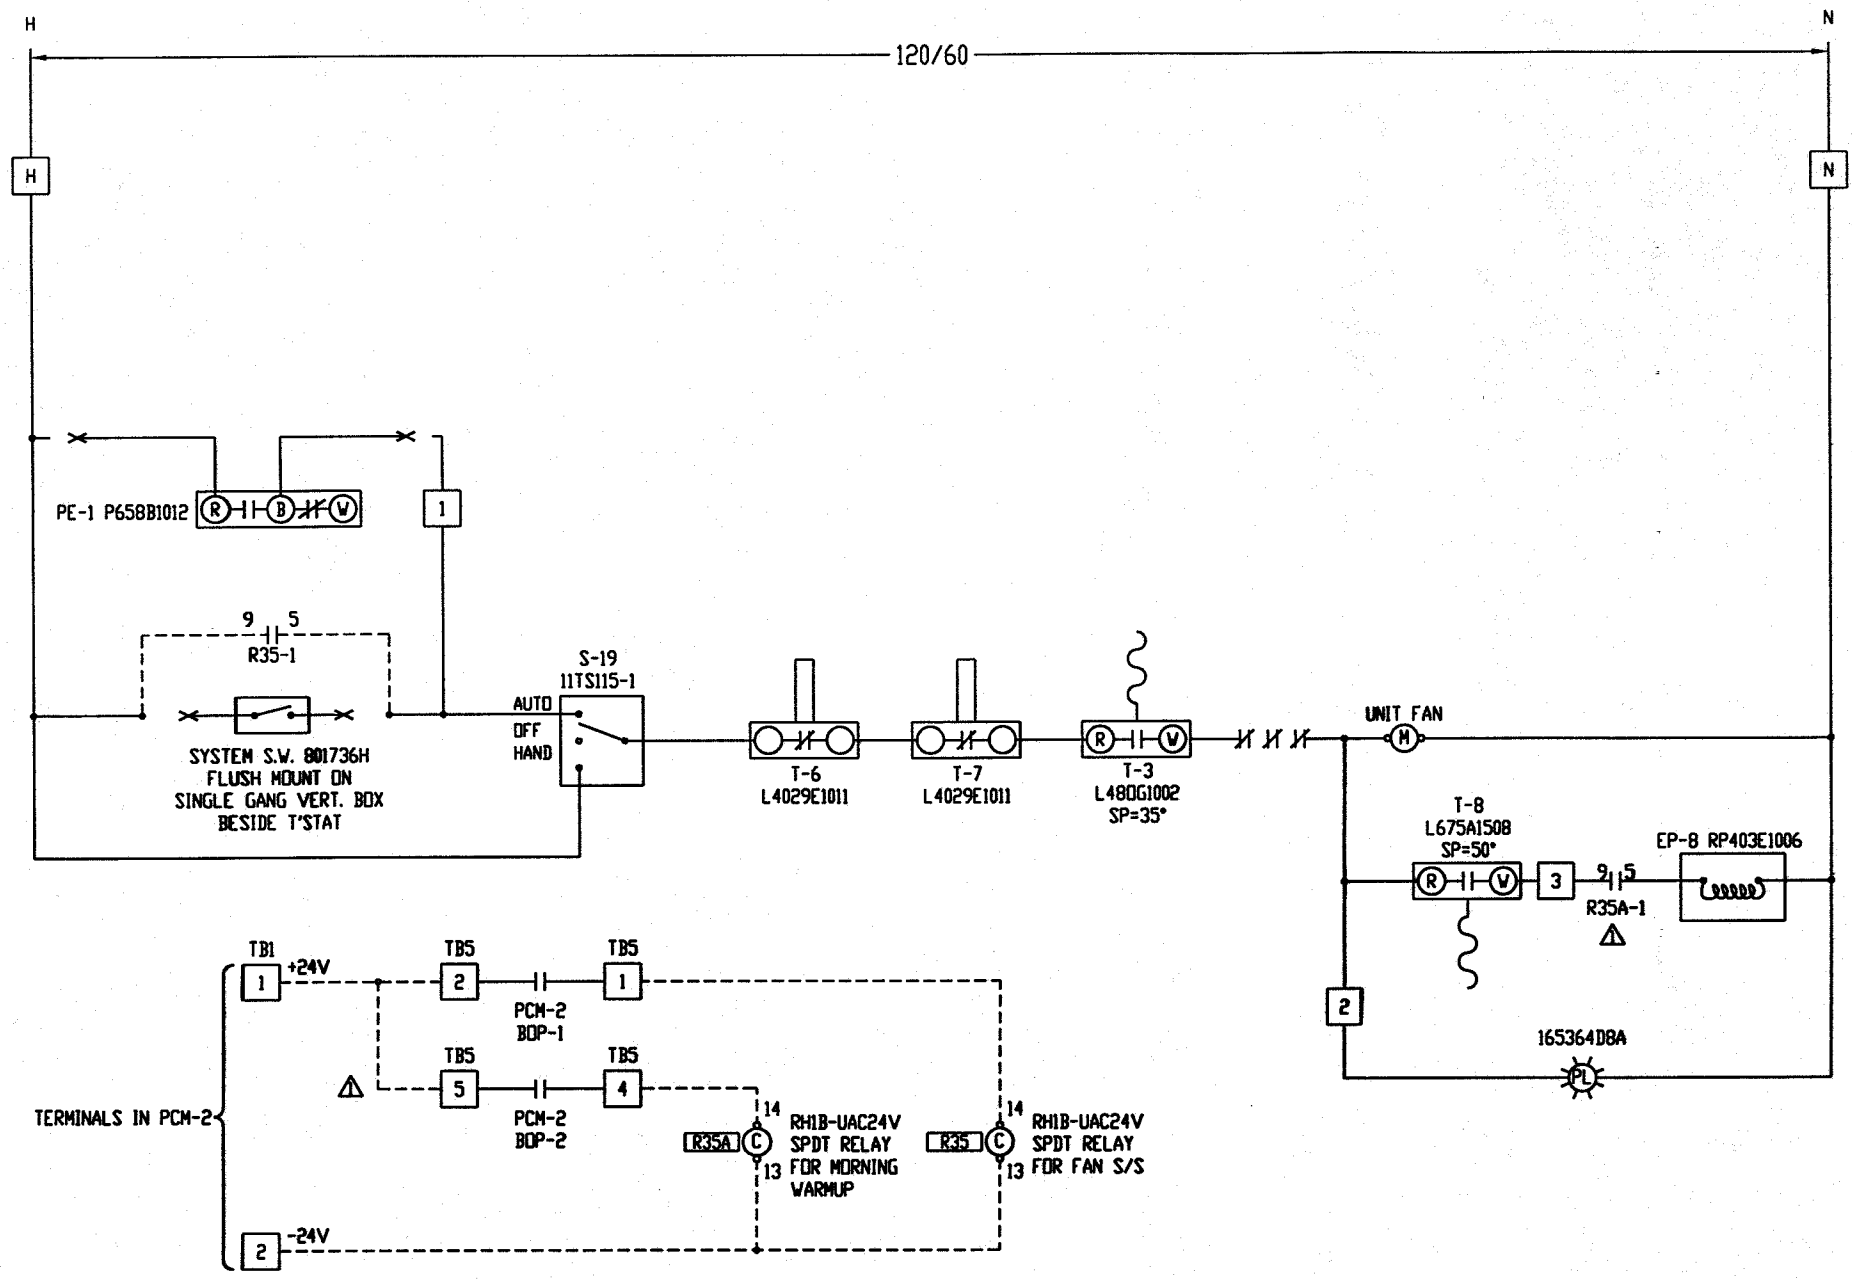

- AHU-9 POINTS LIST FOR PCM-2, S/NO E98E06412**
 - SERVING AHU-9 -
- AIP-1 MIXED AIR TEMPERATURE MAT-9.
 - AIP-2 AUDITORIUM 14B TEMPERATURE ST-7.
 - AIP-3 SPARE
 - ADP-1 VALVE CONTROL EPT-19.
 - ADP-2 SPARE
 - BIP-1 FAN STATUS CS-16.
 - BIP-2 SPARE
 - BOP-1 FAN START/STOP R-35.
 - △ BOP-2 M.V. RELAY
 - BOP-3 SPARE

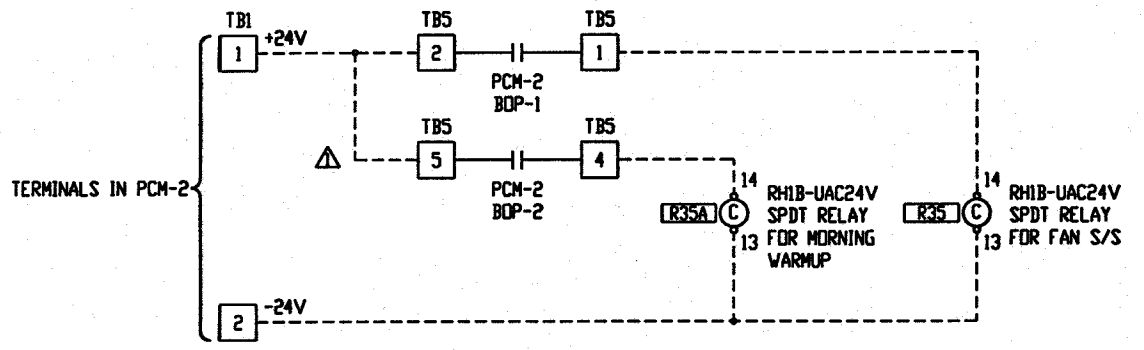

AHU-9 INTERLOCK WIRING DIAGRAM
 - EXISTING CONTROL PANEL -

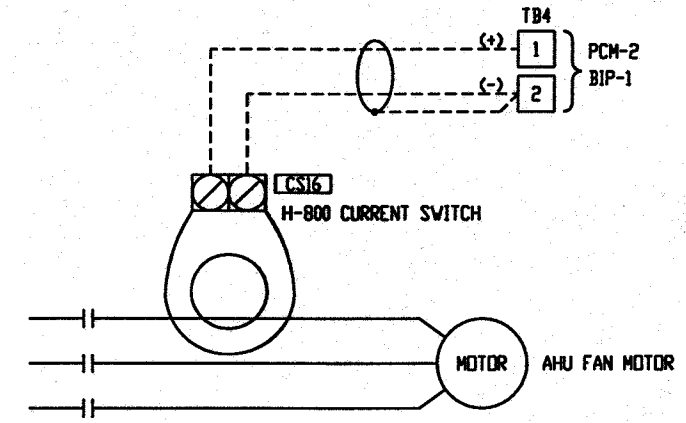

FAN STATUS SWITCH

LEGEND

- THIS COLOR IS INDICATING EXISTING, TO REMAIN AS IS.
- THIS COLOR IS INDICATING TO BE REMOVED.
- THIS COLOR IS INDICATING TO BE ABANDONED IN PLACE.
- THIS COLOR IS INDICATING NEW TO BE ADDED.
- (M) MIAN AIR
- * INDICATES GAUGE MOUNTED ON PANEL FACE.
- CONNECT TO EXISTING

LEGEND


- INDICATES EXISTING WIRING
- - - INDICATES FIELD WIRING

THE DOCUMENTATION HEREIN IS THE EXCLUSIVE PROPERTY OF LAYNE TRANE, CHARLOTTE, N.C. REPRODUCTION AND/OR DISTRIBUTION TO OTHER THAN AUTHORIZED PARTIES IS PROHIBITED.

TRANE
 LAYNE TRANE
 801 PRESSLEY RD
 CHARLOTTE, N.C. 28217
 704 525 3155

REFERENCE DRAWING		NO.	REVISION-LOCATION	DATE	BY
		△	AS-BUILT	4/9/99	CVF
SALES ENGR	PROJ. MGR.	APPL. ENGR.	DRAWN BY	DATE: 4/8/98	
CCR	CVF	CVF	DPC		
PROJECT NAME				CONTRACT NUMBER	
UNCC-McEniry				ICS-98014	
Charlotte, North Carolina				DRAWING NUMBER	
				SHEET 47 OF 51	


NOTE: ALL PRESSURE GAUGES 305909, 0 TO 30# RANGE EXCEPT AS NOTED.

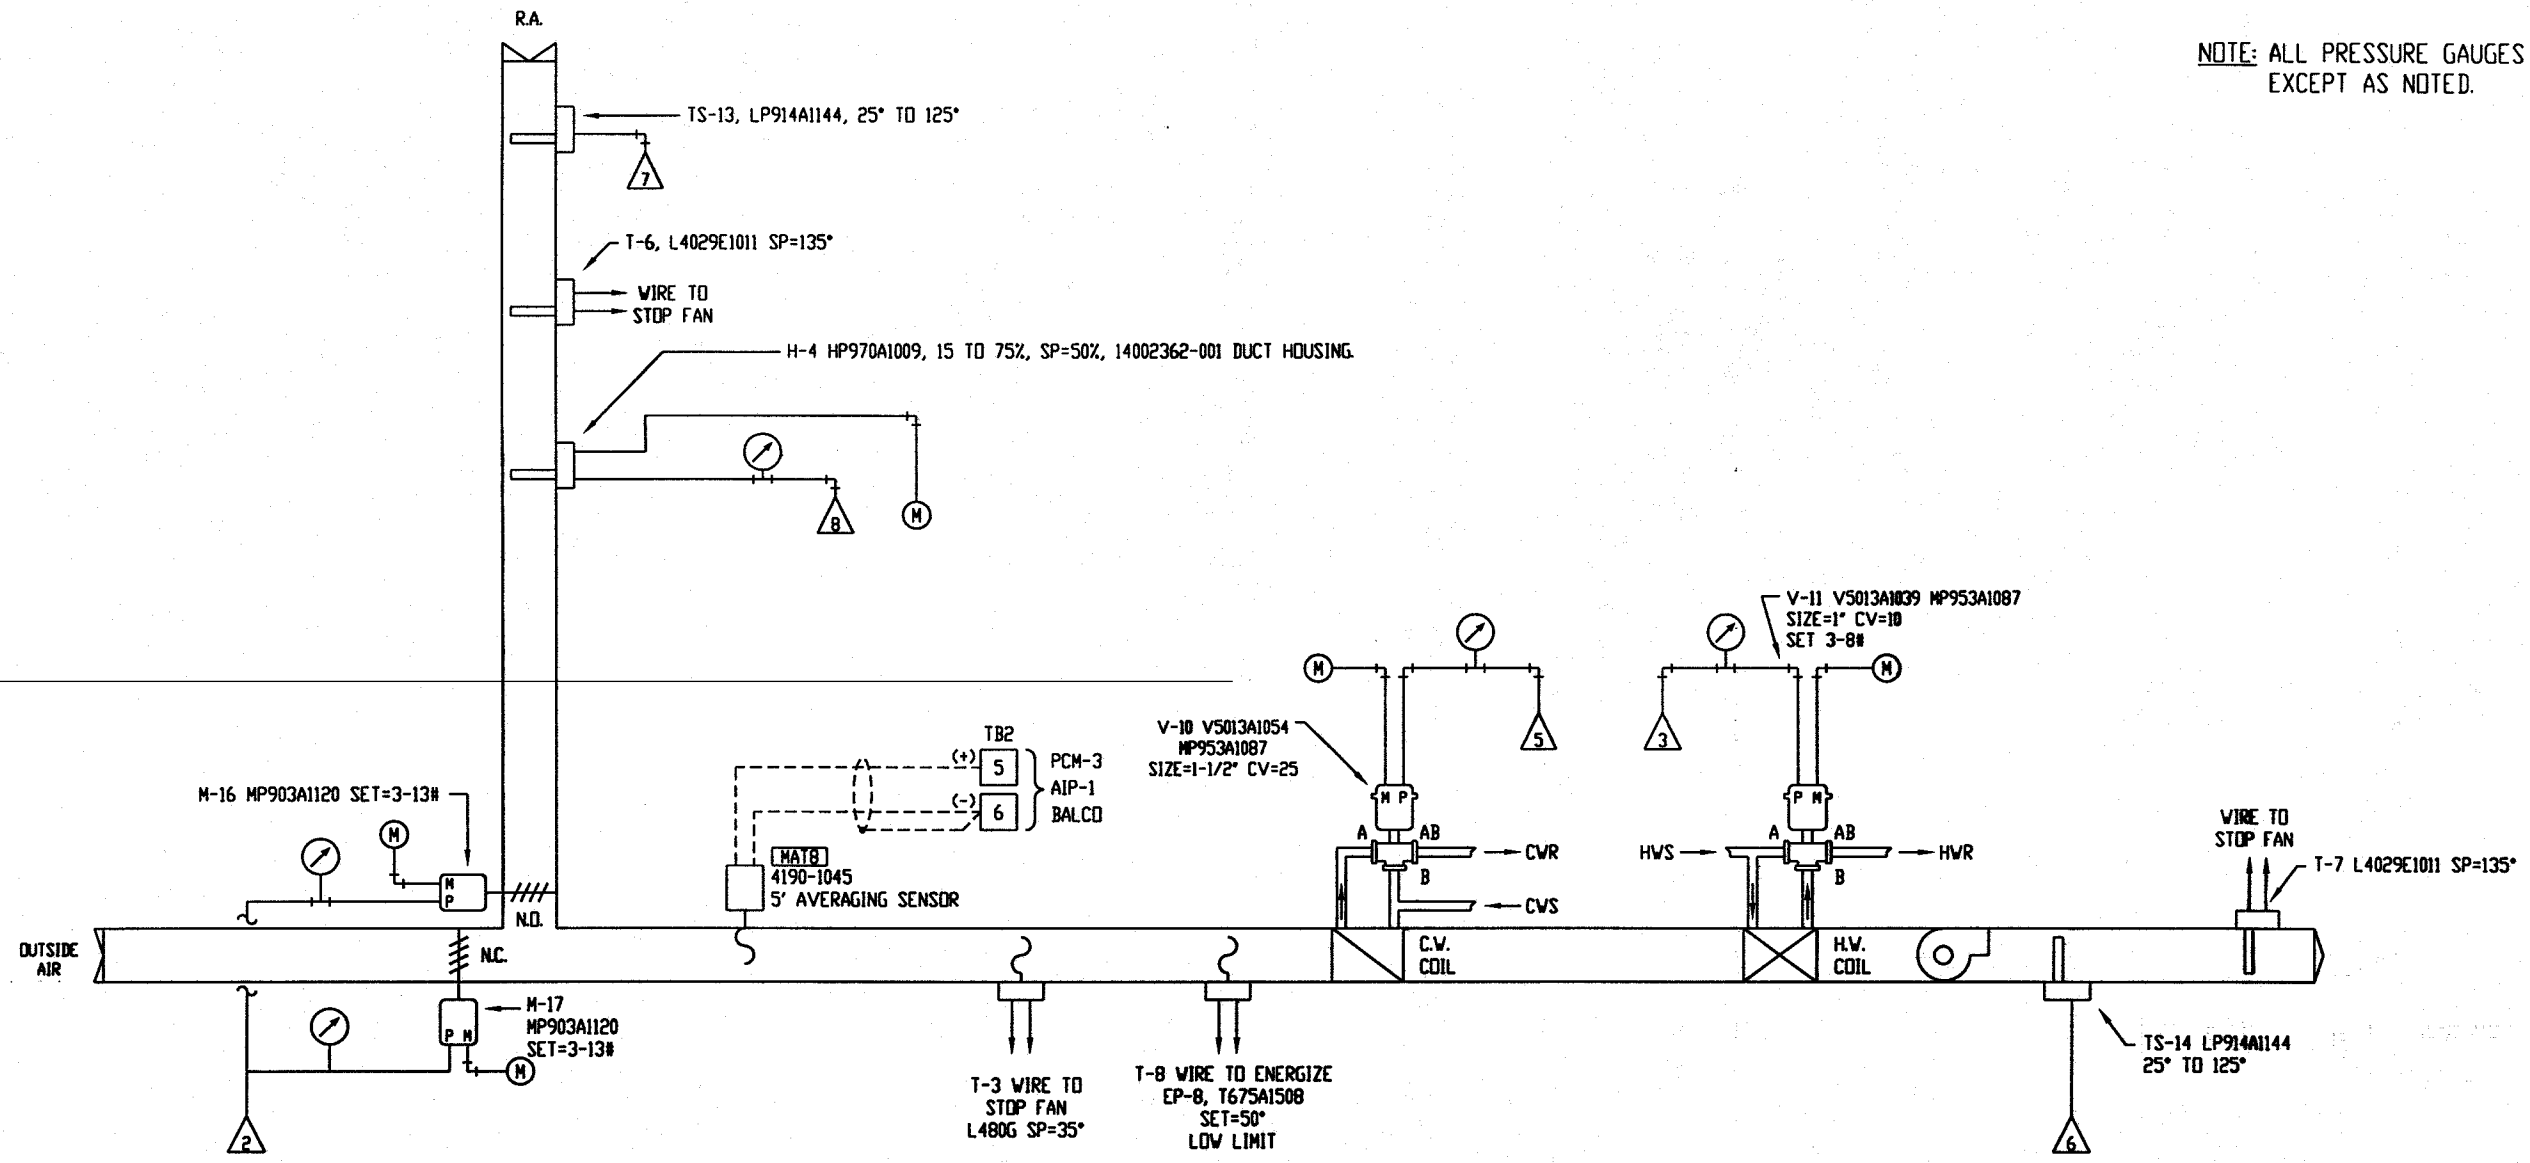

AHU-8 AIR FLOW SCHEMATIC

LEGEND	
	THIS COLOR IS INDICATING EXISTING, TO REMAIN AS IS.
	THIS COLOR IS INDICATING TO BE REMOVED.
	THIS COLOR IS INDICATING TO BE ABANDONED IN PLACE.
	THIS COLOR IS INDICATING NEW TO BE ADDED.
(M)	MAIN AIR
*	INDICATES GAUGE MOUNTED ON PANEL FACE.
⊕	CONNECT TO EXISTING

THE DOCUMENTATION HEREIN IS THE EXCLUSIVE PROPERTY OF LAYNE TRANE, CHARLOTTE, N.C. REPRODUCTION AND/OR DISTRIBUTION TO OTHER THAN AUTHORIZED PARTIES IS PROHIBITED.




TRANE
LAYNE TRANE
801 PRESSLEY RD
CHARLOTTE, N.C. 28217
704 525 3155

REFERENCE DRAWING				NO.		REVISION-LOCATION		DATE		BY	

SALES ENGR. CCR	PROJ. MGR. CVF	APPL. ENGR. CVF	DRAWN BY DPC	DATE: 4/2/98
PROJECT NAME				CONTRACT NUMBER
UNCC-McEniry				ICS-98014
Charlotte, North Carolina				DRAWING NUMBER
				SHEET 46 OF 51

NOTE: ALL PRESSURE GAUGES 305909, 0 TO 30# RANGE EXCEPT AS NOTED.

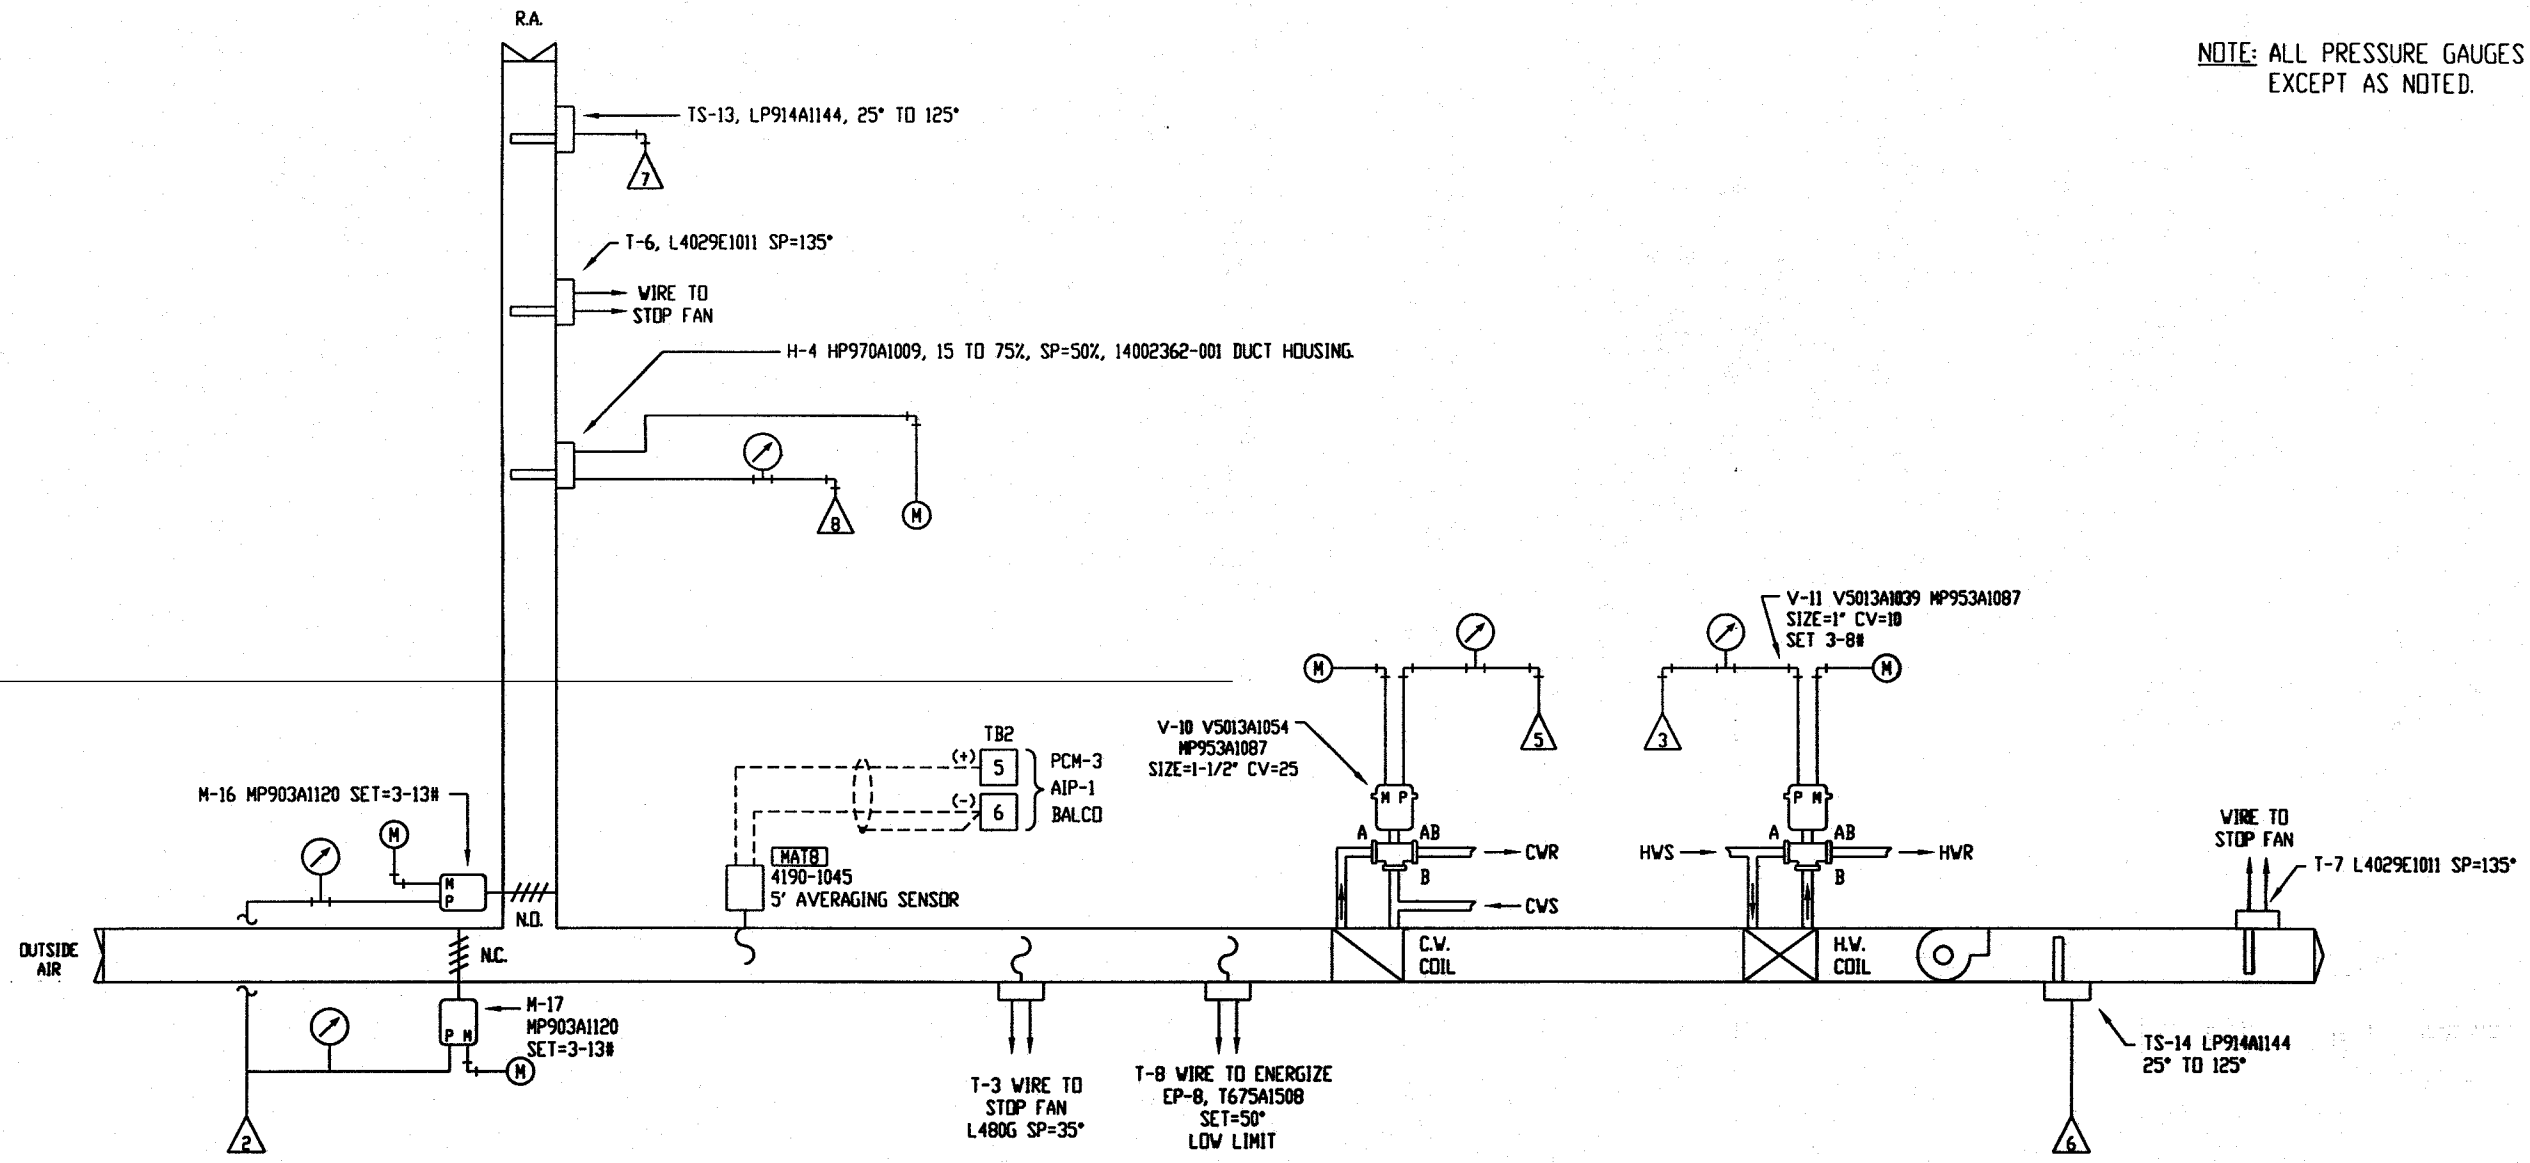

AHU-8 AIR FLOW SCHEMATIC


LEGEND	
■	THIS COLOR IS INDICATING EXISTING, TO REMAIN AS IS.
■	THIS COLOR IS INDICATING TO BE REMOVED.
■	THIS COLOR IS INDICATING TO BE ABANDONED IN PLACE.
■	THIS COLOR IS INDICATING NEW TO BE ADDED.
(M)	MAIN AIR
*	INDICATES GAUGE MOUNTED ON PANEL FACE.
⊕	CONNECT TO EXISTING

THE DOCUMENTATION HEREIN IS THE EXCLUSIVE PROPERTY OF LAYNE TRANE, CHARLOTTE, N.C. REPRODUCTION AND/OR DISTRIBUTION TO OTHER THAN AUTHORIZED PARTIES IS PROHIBITED.

LAYNE TRANE
801 PRESSLEY RD
CHARLOTTE, N.C. 28217
704 525 3155

REFERENCE DRAWING	NO.	REVISION-LOCATION	DATE	BY

SALES ENGR. CCR	PROJ. MGR. CVF	APPL. ENGR. CVF	DRAWN BY DPC	DATE: 4/2/98
PROJECT NAME: UNCC-McEniry Charlotte, North Carolina				CONTRACT NUMBER: ICS-98014
				DRAWING NUMBER: SHEET 46 OF 51

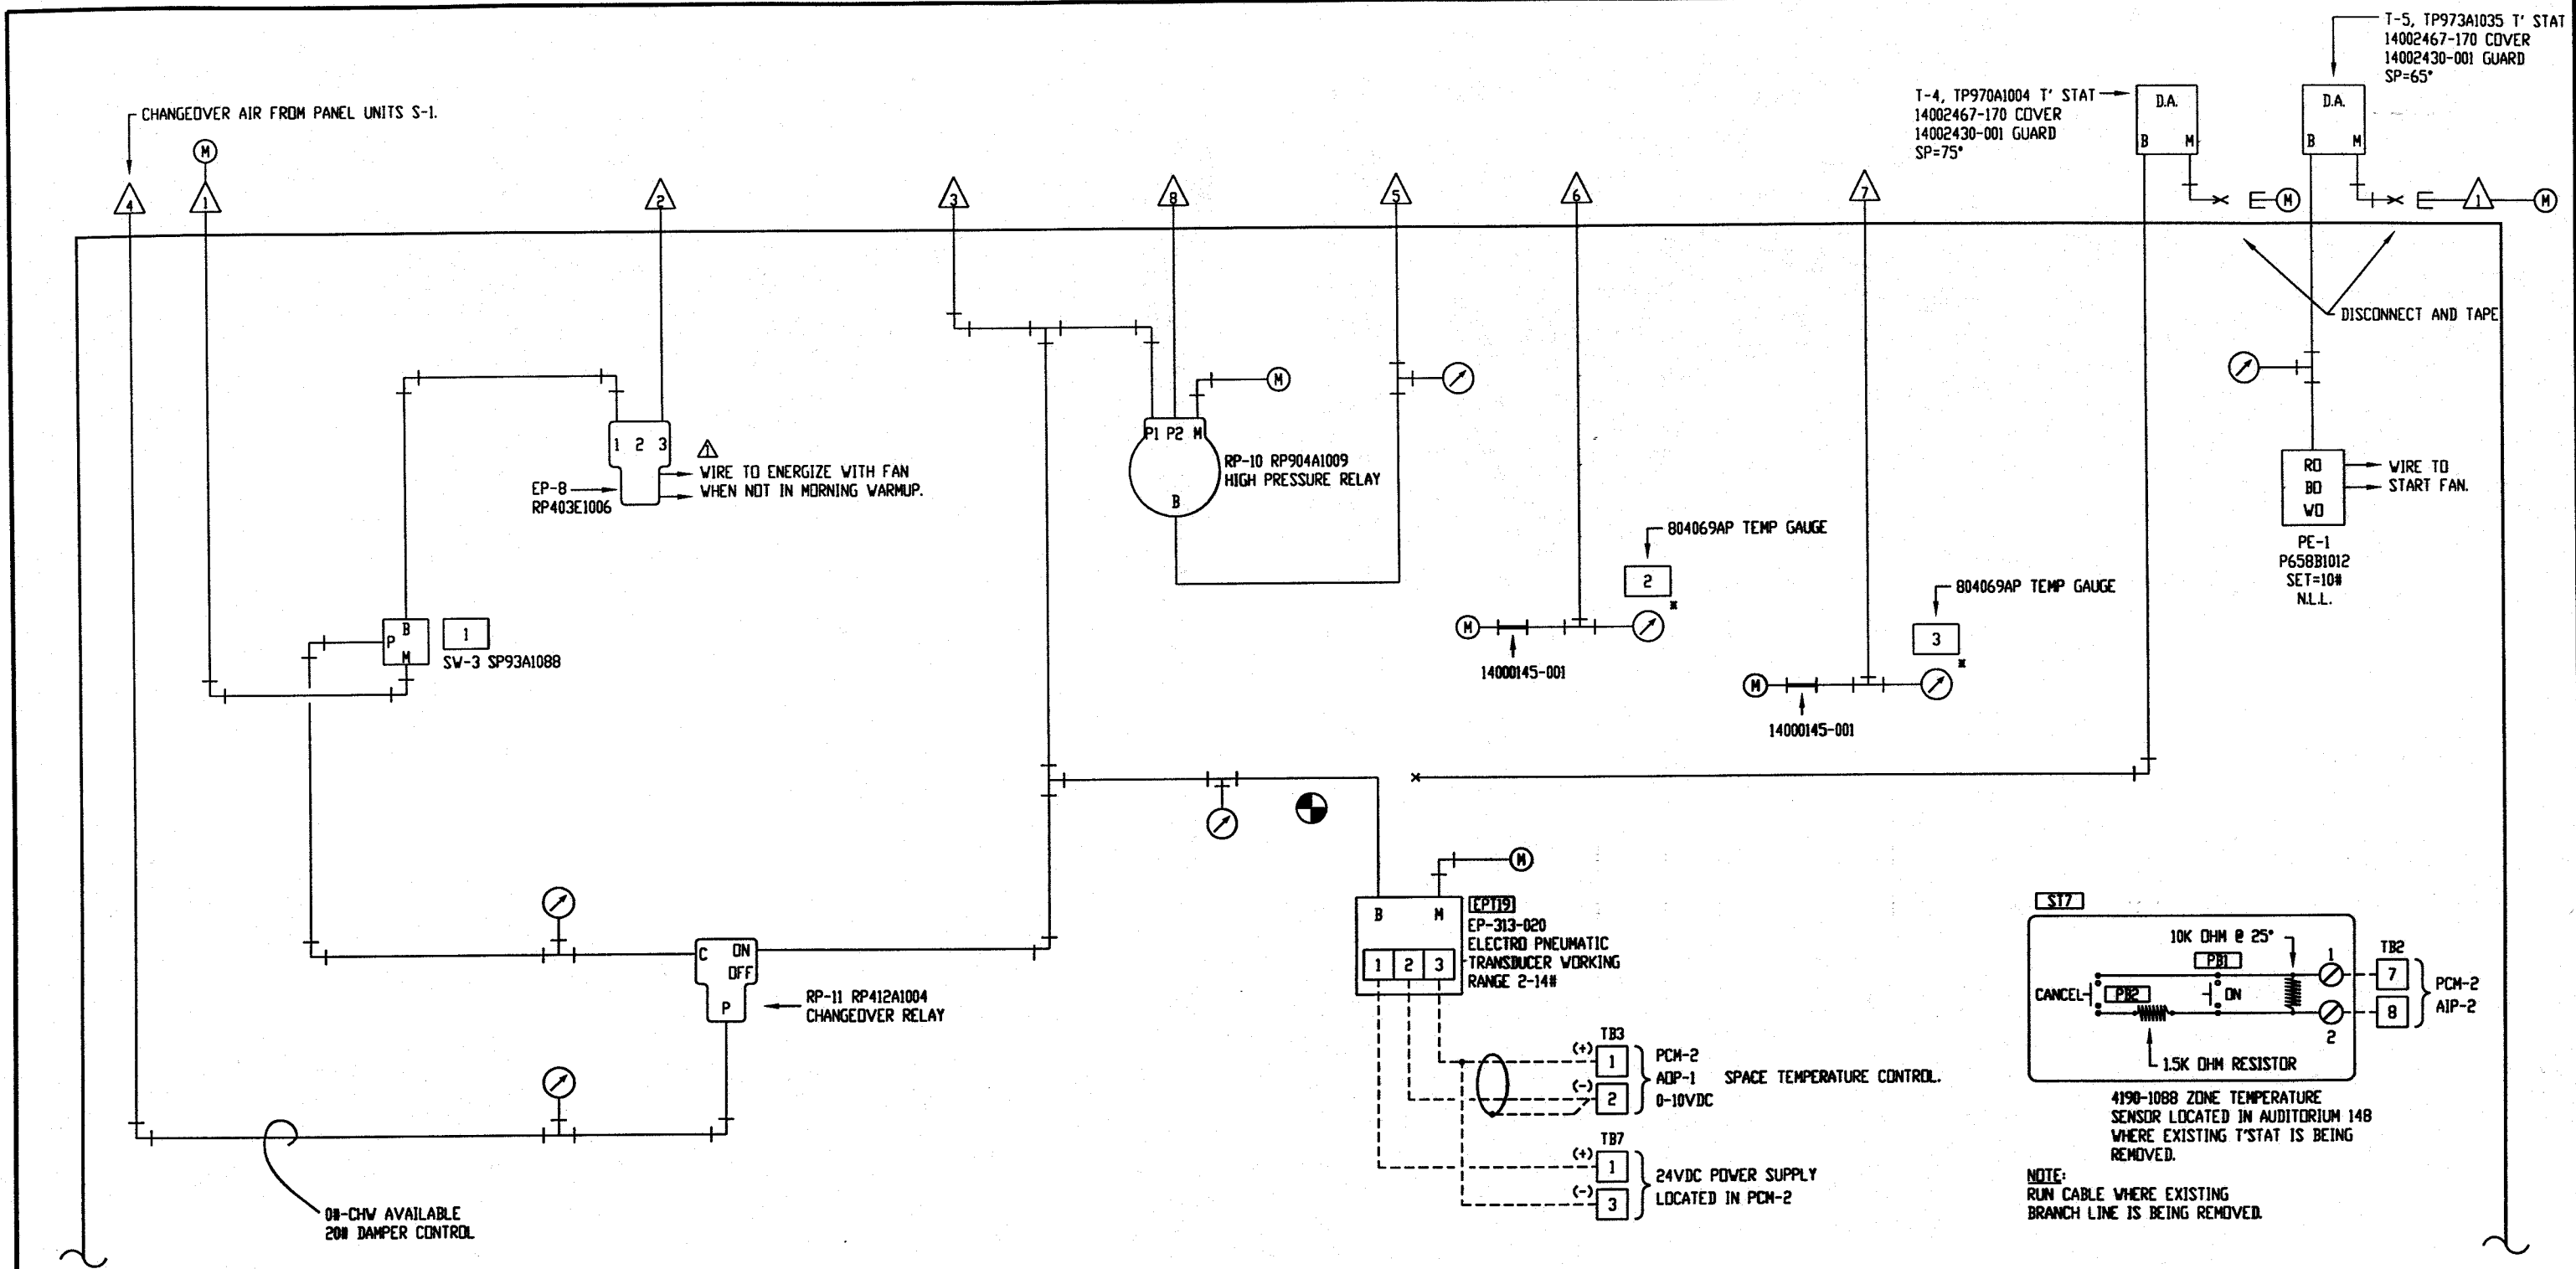

AHU-9 PANEL PNEUMATIC SCHEMATIC
- EXISTING CONTROL PANEL -

LEGEND

- THIS COLOR IS INDICATING EXISTING, TO REMAIN AS IS.
- THIS COLOR IS INDICATING TO BE REMOVED.
- THIS COLOR IS INDICATING TO BE ABANDONED IN PLACE.
- THIS COLOR IS INDICATING NEW TO BE ADDED.
- (M) MAIN AIR
- * INDICATES GAUGE MOUNTED ON PANEL FACE.
- ⊕ CONNECT TO EXISTING

- 1 MIN. DA DAMPER POSITION
- 2 SUPPLY AIR TEMP.
- 3 RETURN AIR TEMP.


THE DOCUMENTATION HEREIN IS THE EXCLUSIVE PROPERTY OF LAYNE TRANE, CHARLOTTE, N.C. REPRODUCTION AND/OR DISTRIBUTION TO OTHER THAN AUTHORIZED PARTIES IS PROHIBITED.

TRANE
LAYNE TRANE
801 PRESSLEY RD
CHARLOTTE, N.C. 28217
704 525 3155

REFERENCE DRAWING	NO.	REVISION-LOCATION	DATE	BY
	Δ	AS-BUILT	4/9/99	CVF

SALES ENGR. CCR	PROJ. MGR. CVF	APPL. ENGR. CVF	DRAWN BY DPC	DATE: 4/2/98
PROJECT NAME				CONTRACT NUMBER
UNCC-McEniry Charlotte, North Carolina				ICS-98014
				DRAWING NUMBER
				SHEET 48 OF 51

NOTE: ALL PRESSURE GAUGES 305909, 0 TO 30# RANGE EXCEPT AS NOTED.

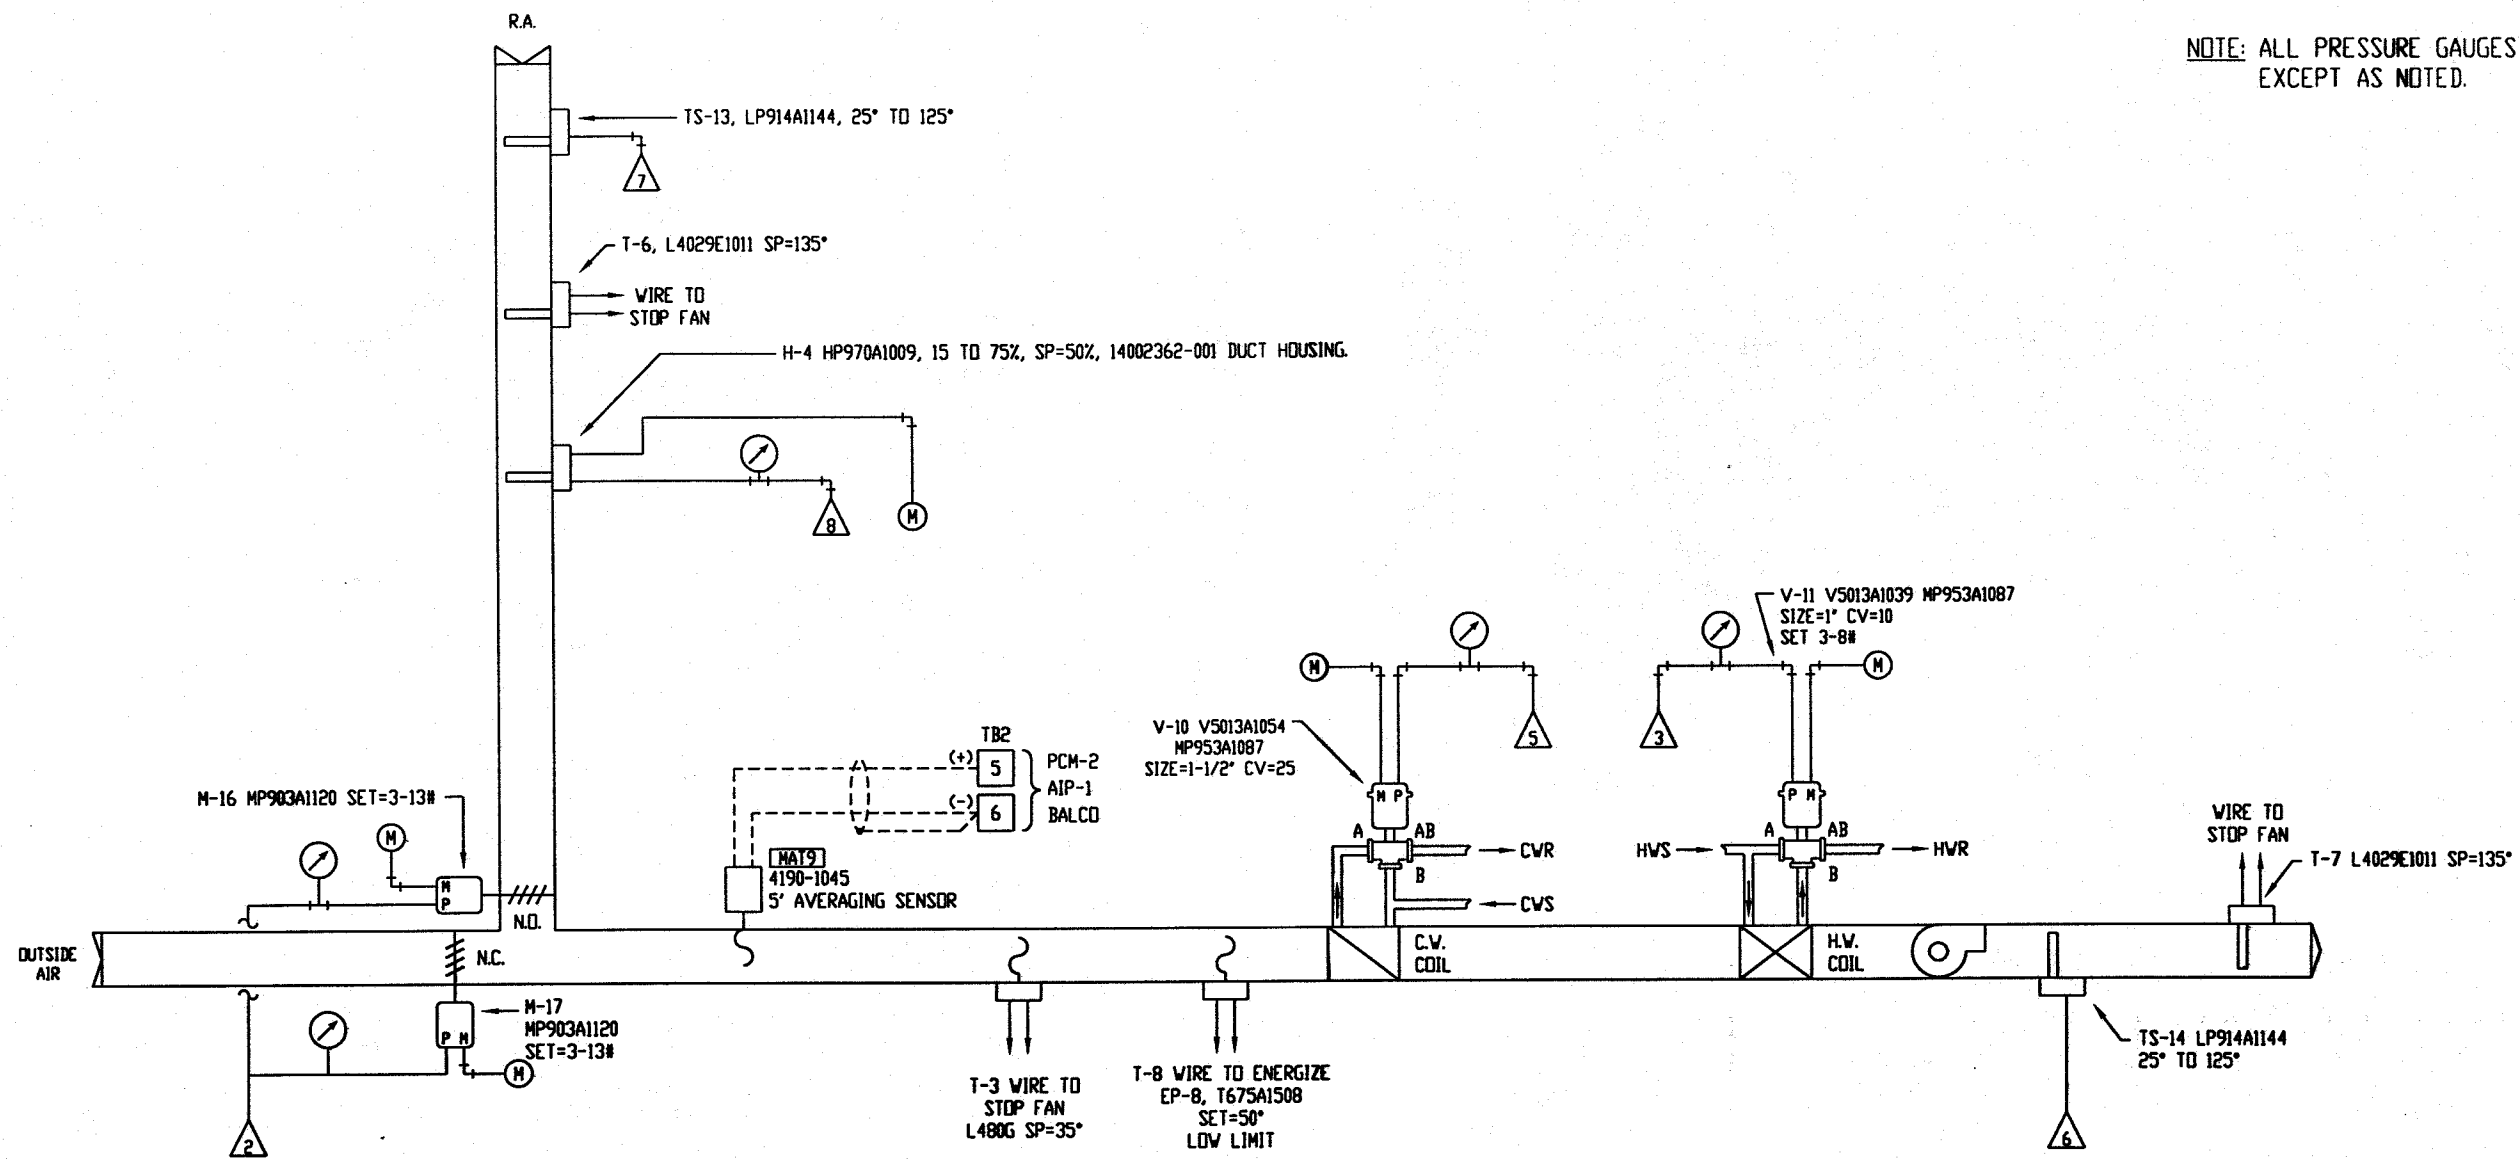

AHU-9 AIR FLOW SCHEMATIC

LEGEND	
■	THIS COLOR IS INDICATING EXISTING, TO REMAIN AS IS.
■	THIS COLOR IS INDICATING TO BE REMOVED.
■	THIS COLOR IS INDICATING TO BE ABANDONED IN PLACE.
■	THIS COLOR IS INDICATING NEW TO BE ADDED.
(M)	MAIN AIR
*	INDICATES GAUGE MOUNTED ON PANEL FACE.
⊕	CONNECT TO EXISTING

THE DOCUMENTATION HEREIN IS THE EXCLUSIVE PROPERTY OF LAYNE TRANE, CHARLOTTE, N.C. REPRODUCTION AND/OR DISTRIBUTION TO OTHER THAN AUTHORIZED PARTIES IS PROHIBITED.

<p>TRANE LAYNE TRANE 801 PRESSLEY RD CHARLOTTE, N.C. 28217 704 525 3155</p>		REFERENCE DRAWING	NO.	REVISION-LOCATION	DATE	BY											
		<table border="1"> <tr> <td>SALES ENGR. CLR</td> <td>PROJ. MGR. CVF</td> <td>APPL. ENGR. CVF</td> <td>DRAWN BY DPC</td> <td>DATE: 4/2/98</td> <td>CONTRACT NUMBER 1CS-98014</td> </tr> <tr> <td colspan="5">PROJECT NAME UNCC-McEniry Charlotte, North Carolina</td> <td>DRAWING NUMBER SHEET 49 OF 51</td> </tr> </table>						SALES ENGR. CLR	PROJ. MGR. CVF	APPL. ENGR. CVF	DRAWN BY DPC	DATE: 4/2/98	CONTRACT NUMBER 1CS-98014	PROJECT NAME UNCC-McEniry Charlotte, North Carolina			
SALES ENGR. CLR	PROJ. MGR. CVF	APPL. ENGR. CVF	DRAWN BY DPC	DATE: 4/2/98	CONTRACT NUMBER 1CS-98014												
PROJECT NAME UNCC-McEniry Charlotte, North Carolina					DRAWING NUMBER SHEET 49 OF 51												

DEVICE ID	BCU DIP SWITCH SETTINGS							
	S2-1	S2-2	S2-3	S2-4	S2-5	S2-6	S2-7	S2-8
05	OFF	ON	OFF	ON	ON	ON	ON	ON

BCU ADDRESSES

UNIT	UCM ADDRESS	UNIVERSAL PCM SWI DIP SWITCH SETTINGS						
		1	2	3	4	5	6	7
UPCM-1	32	OFF	OFF	OFF	OFF	OFF	ON	OFF
UPCM-2	33	ON	OFF	OFF	OFF	OFF	ON	OFF
UPCM-3	34	OFF	ON	OFF	OFF	OFF	ON	OFF
UPCM-4	35	ON	ON	OFF	OFF	OFF	ON	OFF
UPCM-5	36	OFF	OFF	ON	OFF	OFF	ON	OFF

UPCM ADDRESSES

- BCU-5 LINK-1 -

UNIT #	UCM ADDRESS	PCM DIP SWITCH SETTINGS							
		S2-1	S2-2	S2-3	S2-4	S2-5	S2-6	S2-7	S2-8
PCM-1	1	OFF	ON	ON	ON	ON	ON	OFF	OFF
PCM-2	2	ON	OFF	ON	ON	ON	ON	OFF	OFF
PCM-3	3	OFF	OFF	ON	ON	ON	ON	OFF	OFF
PCM-4	4	ON	ON	OFF	ON	ON	ON	OFF	OFF
PCM-5	5	OFF	ON	OFF	ON	ON	ON	OFF	OFF
PCM-6	6	ON	OFF	OFF	ON	ON	ON	OFF	OFF

PCM ADDRESSES

- BCU-5 LINK-2 -

LEGEND	
_____	INDICATES FACTORY WIRING
-----	INDICATES FIELD WIRING

THE DOCUMENTATION HEREIN IS THE EXCLUSIVE PROPERTY OF LAYNE TRANE, CHARLOTTE, N.C. REPRODUCTION AND/OR DISTRIBUTION TO OTHER THAN AUTHORIZED PARTIES IS PROHIBITED.



LAYNE TRANE
801 PRESSLEY RD
CHARLOTTE, N.C. 28217
704 525 3155

REFERENCE DRAWING	NO.	REVISION-LOCATION	DATE	BY

SALES ENGR. CCR	PROJ. MGR. CVF	APPL. ENGR. CVF	DRAWN BY DPC	DATE: 5/8/98
PROJECT NAME				CONTRACT NUMBER
UNCC-McEniry Charlotte, North Carolina				ICS-98014
				DRAWING NUMBER
				SHEET 50 OF 51

Sequence of Operations

Dual Duct Units (AHU S1, S2, & S3)

The unit will run whenever a occupied signal from a time of day schedule is received, timed override request is made, or any zone temperature falls below the night setback setpoint. The time of day schedule is adjustable through the front end computer. The time of day schedule has the ability to perform optimal start and optimal stop. The timed override request is generated by pushing the "on" button on any zone sensor. The timed override period will last for two hours. The timed override amount can be changed through the front end to any desired value. The timed override request can be cancel at any time by pushing the "cancel" button on any zone thermostat. The timed override periods will be trended.

The unit will start the return fan first, then open the minimum outside air damper, and finally start the supply fan. If the outdoor air enthalpy is below the changeover setpoint, the unit will use outdoor air for cooling. When in 'free cooling' mode, the unit will modulate the return, outdoor, and relief dampers to maintain a mixed air temperature of 52 degrees. If the mixed air temperature were to fall below 45 degrees, the maximum outdoor air dampers will go fully closed. If the unit is in the 'mechanical cooling' mode, then the chilled water valve will modulate to maintain a cold deck temperature of 55 degrees. The chilled water valve will be added in the future by the owner; however, the programming will already be in place. Until the chilled water valve is installed, when in 'mechanical cooling' then unit will have whatever cooling is available from the chilled water system. The steam valves will modulate to maintain a hot deck discharge setpoint. The hot deck discharge setpoint is reset on the following schedule. If the outdoor air temperature is 10 degrees or below the setpoint will be 120 degrees and if the outdoor air temperature is 80 degrees or above the setpoint will be 80 degrees. The setpoint will vary linearly between those two values as the outdoor air temperature changes.

The humidifier valve will modulate to maintain a minimum space relative humidity of 35 percent. If the humidity in the supply duct exceeds 95 percent, the humidifier valve will close. The unit will shut-down on a safety if the mixed air temperature falls below 40 degrees or a smoke detector in the return or supply air stream activates.

Single Zone Air Handling Units (AHU's 4,5,6,7,8, and 9)

The unit will run whenever a occupied signal from a time of day schedule is received, timed override request is made, or any zone temperature falls below the night setback setpoint. The time of day schedule is adjustable through the front end computer. The time of day schedule has the ability to perform optimal start and optimal stop. The timed override request is generated by pushing the "on" button on any zone sensor. The timed override period will last for two hours. The timed override amount can be changed through the front end to any desired value. The timed override request can be cancel at any time by pushing the "cancel" button on any zone thermostat. The timed override periods will be trended.

If the outdoor air enthalpy is below the changeover setpoint, the unit will use outdoor air for cooling. When in 'free cooling' mode, the unit will modulate the return and outdoor dampers to maintain space temperature at setpoint if a cooling load is present. If the mixed air temperature were to fall below 45 degrees, the outdoor air damper will go to its minimum position. If the unit is in the 'mechanical cooling' mode, then the chilled water valve will modulate to maintain the space temperature at setpoint if a cooling load is present. The hot water valve will modulate to maintain the space temperature at setpoint if a heating load is present.

The humidifier valve will modulate to maintain the return air relative humidity at 50 percent. If the humidity exceeds 50 percent, the chilled water valve will modulate open to dehumidify the air the hot water valve will modulate open to reheat the air.

The unit will shut-down on a safety if the mixed air temperature falls below 40 degrees, a smoke detector in the return or supply air stream activates or the high limit sensor in the supply air stream trips.

Animal Laboratory Unit (AHU 10)

The unit will run whenever a occupied signal from a time of day schedule is received, timed override request is made, or any zone temperature falls below the night setback setpoint. The time of day schedule is adjustable through the front end computer. The time of day schedule has the ability to perform optimal start and optimal stop. The timed override request is generated by pushing the "on" button on any zone sensor. The timed override period will last for two hours. The timed override amount can be changed through the front end to any desired value. The timed override request can be cancel at any time by pushing the "cancel" button on any zone thermostat. The timed override periods will be trended.

The unit will open the outside air damper first then start the supply fan. The chilled water valve will modulate to maintain the discharge air temperature at 55 degrees. The steam valve will modulate to maintain the heating coil discharge temperature at 52 degrees. The unit will shut-down on a safety if the mixed air temperature falls below 40 degrees or the high limit sensor in the supply air stream trips.

Chiller Plant

If any air handling unit is running and the outdoor air enthalpy is above 18 btu/lb then the chiller plant will be enabled. If the outdoor air enthalpy falls below 17 btu/lb then the changeover relay will be energized enabling air handling units to use outdoor air for cooling and disabling chiller plant operations.

The chillers will lead/lag weekly. The lead chiller will start when the chiller plant is enabled. The chiller will not run until chilled and condenser water flow has been proven. The inlet vanes on the chiller will modulate to maintain a chilled water return temperature of 55 degrees. If the lead chillers vanes are open at 85 percent or greater for 10 continuous minutes, the lag chiller will start. The lead chiller will unload it vanes to 40 percent. Both chillers will hold their vanes at 40 percent for 3 minutes to equalize load, then both of the chillers vanes will modulate together to maintain the lead chillers return water temperature at 55 degrees. If the vanes on both chillers are at 40 percent or less for 10 continuous minutes, the lag chiller will be stopped and the lead chiller will assume the load.

The cooling tower fan will stage both of its stages to maintain a condenser water entering temperature at the lead chiller of 75 degrees.

Steam Plant

If any air handling unit is running and the outdoor air temperature is below 75 degrees, the steam or hot water valve on any unit is open greater than 5 percent, or the outdoor air temperature is below 35 degrees the boiler and hot water pump will run. The steam valves on the hot water converter will modulate to maintain the hot water supply temperature at setpoint. The hot water supply setpoint will vary between 180 degrees when the outdoor air temperature is 0 degrees or less and 90 degrees when the outdoor air temperature is 70 degrees or greater. The setpoint will vary linearly as the outdoor air temperature changes.

Installation Notes:

1. No work shall be done outside of the mechanical rooms while school is in session.
2. No unit, chiller, or boiler shall be down during exam week.
3. Run all wire in conduit. Run conduit only in approved areas due to asbestos.
4. Devices removed are to be returned to the owner.
5. Schedule all unit down times with owner.
6. Run wiring for space thermostats and humidity sensors inside of the wall. Wire mold to be used only when approved by owner.
7. Bring to the attention of the owner any existing wiring or pneumatic tubing that may be a safety or operational concern.

Checkout Notes:

1. No checkout to occur while school is in session.
2. Changeover one complete unit at a time. Do not start checkout on a second unit until the first unit is fully operational in the automatic mode.
3. Schedule any down time with the owner. Any animal lab unit work should be scheduled with the owner.
4. All existing devices being utilized shall be checked for proper operation. Bring to the attention of the owner any device that may be a safety or operational concern.

LEGEND	
————	INDICATES FACTORY WIRING
-----	INDICATES FIELD WIRING

THE DOCUMENTATION HEREIN IS THE EXCLUSIVE PROPERTY OF LAYNE TRANE, CHARLOTTE, N.C. REPRODUCTION AND/OR DISTRIBUTION TO OTHER THAN AUTHORIZED PARTIES IS PROHIBITED.



TRANE
LAYNE TRANE
801 PRESSLEY RD
CHARLOTTE, N.C. 28217
704 525 3155

REFERENCE DRAWING		NO.	REVISION-LOCATION	DATE	BY

SALES ENGR.	PROJ. MGR.	APPL. ENGR.	DRAWN BY	DATE: 5/11/98
CCR	CVF	CVF	DPC	
PROJECT NAME				CONTRACT NUMBER
UNCC-McEniry				ICS-98014
Charlotte, North Carolina				DRAWING NUMBER
				SHEET 51 OF 51



McENIRY HVAC MODERNIZATION

ISSUED FOR CONSTRUCTION

SCO # 18-19463-01





Charlotte, North Carolina

DRAWN BY: JLC
CHECKED BY: JLC
DATE: 01/17/2019
REVISIONS:
1 01/30/19 ADDENDUM #2



COMMISSION NUMBER: 218.063

DRAWING TITLE:
AUDITORIUM ENLARGED MECHANICAL ROOMS

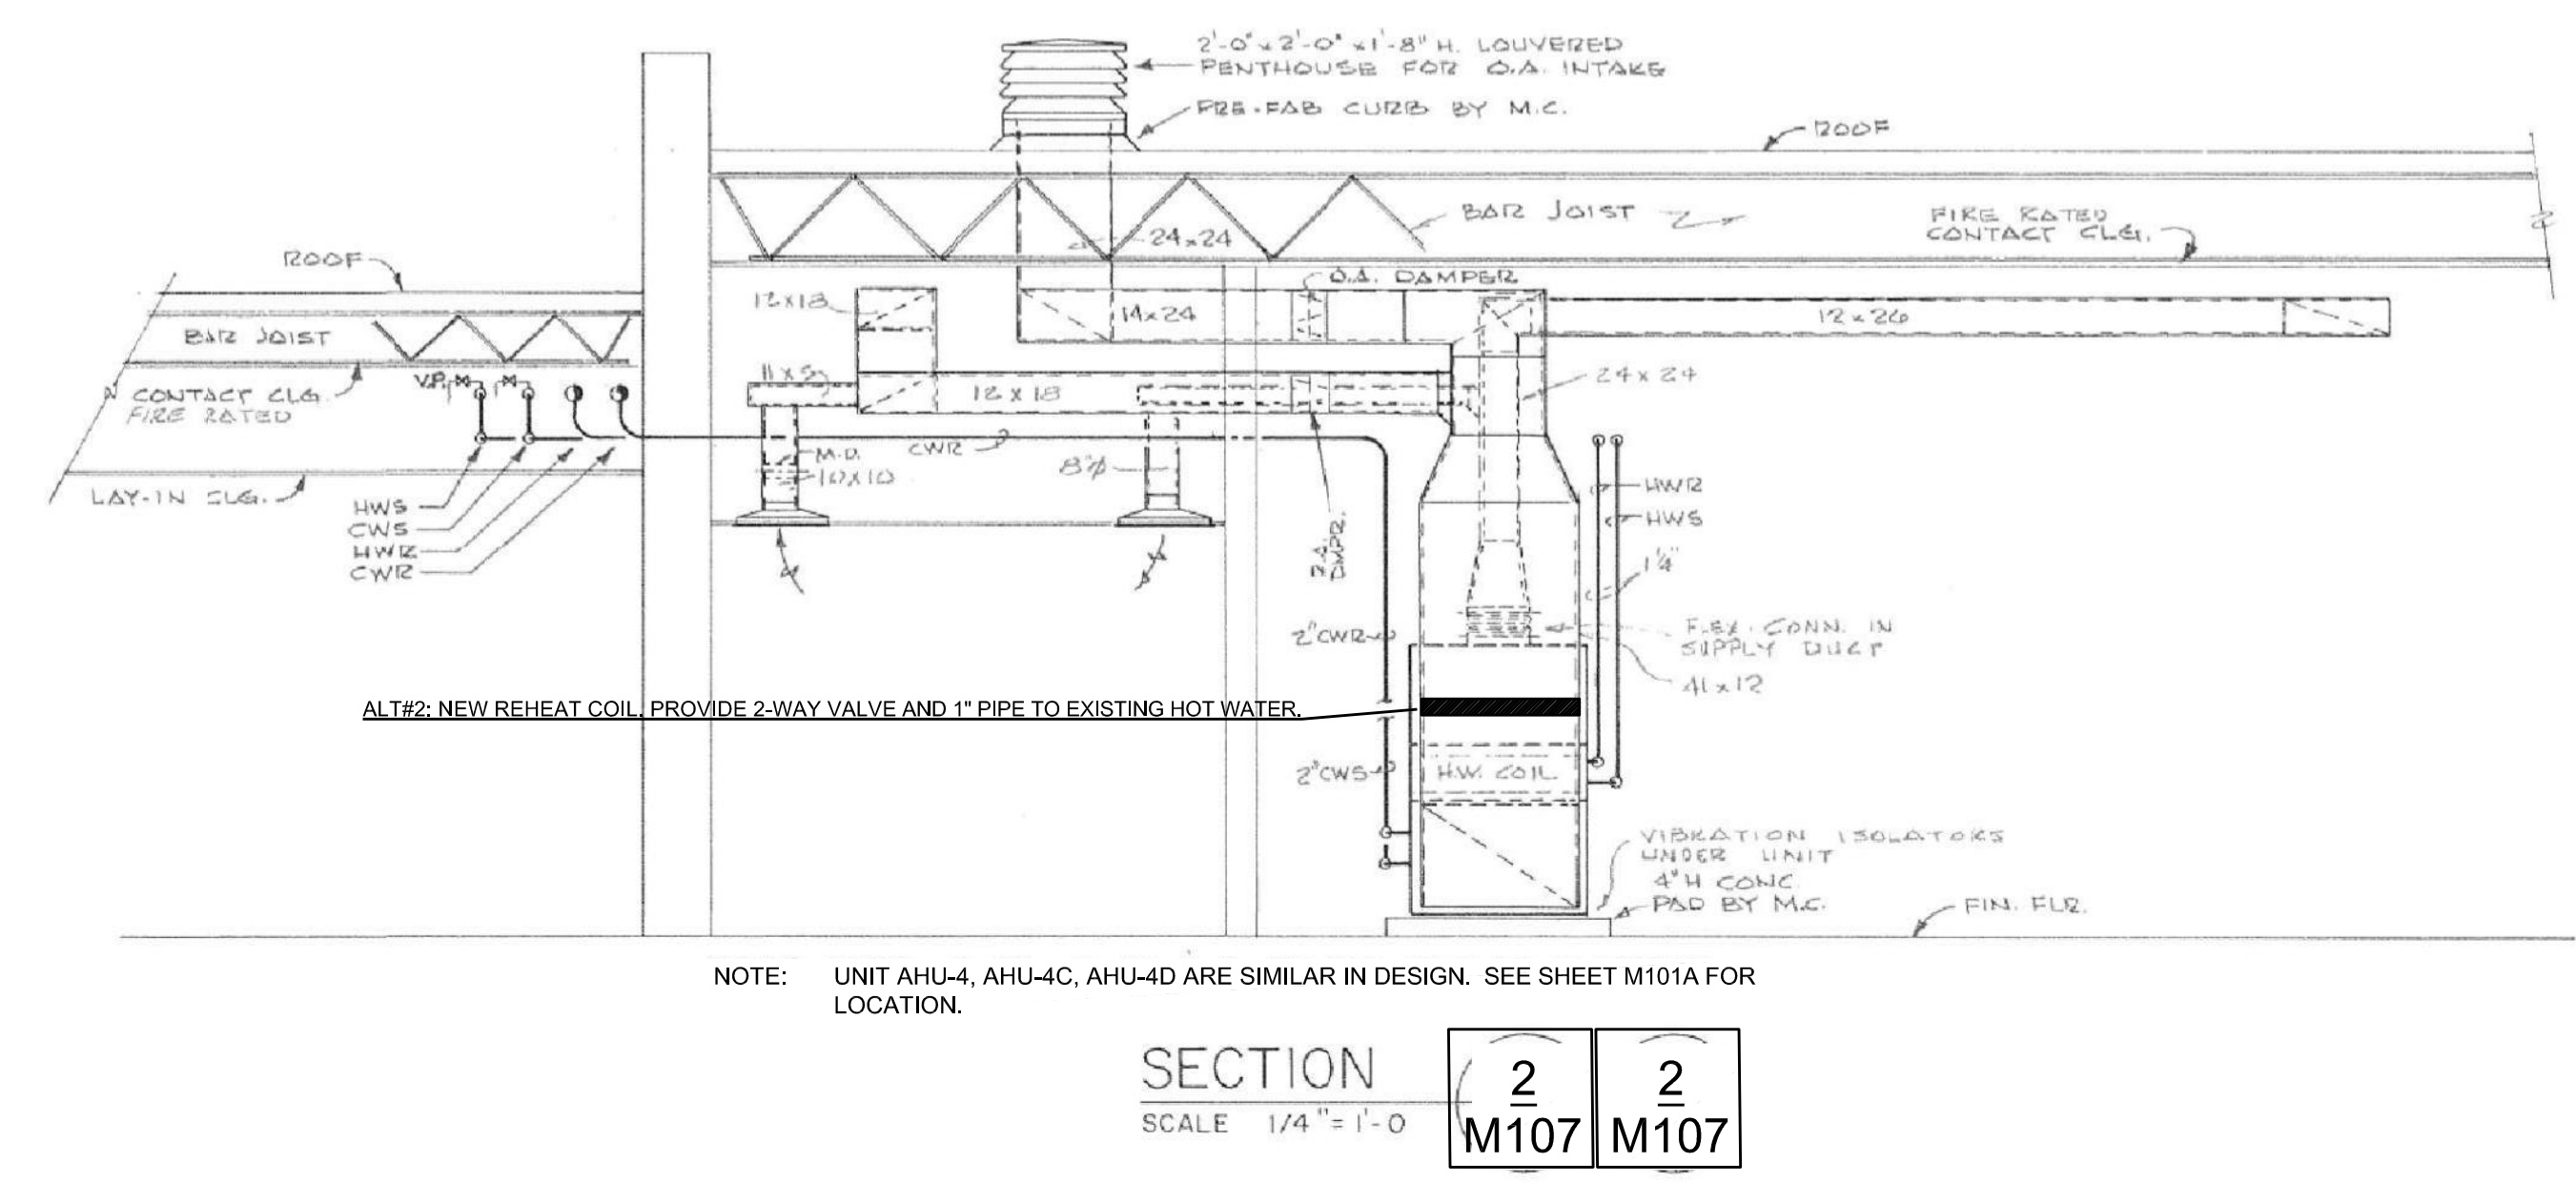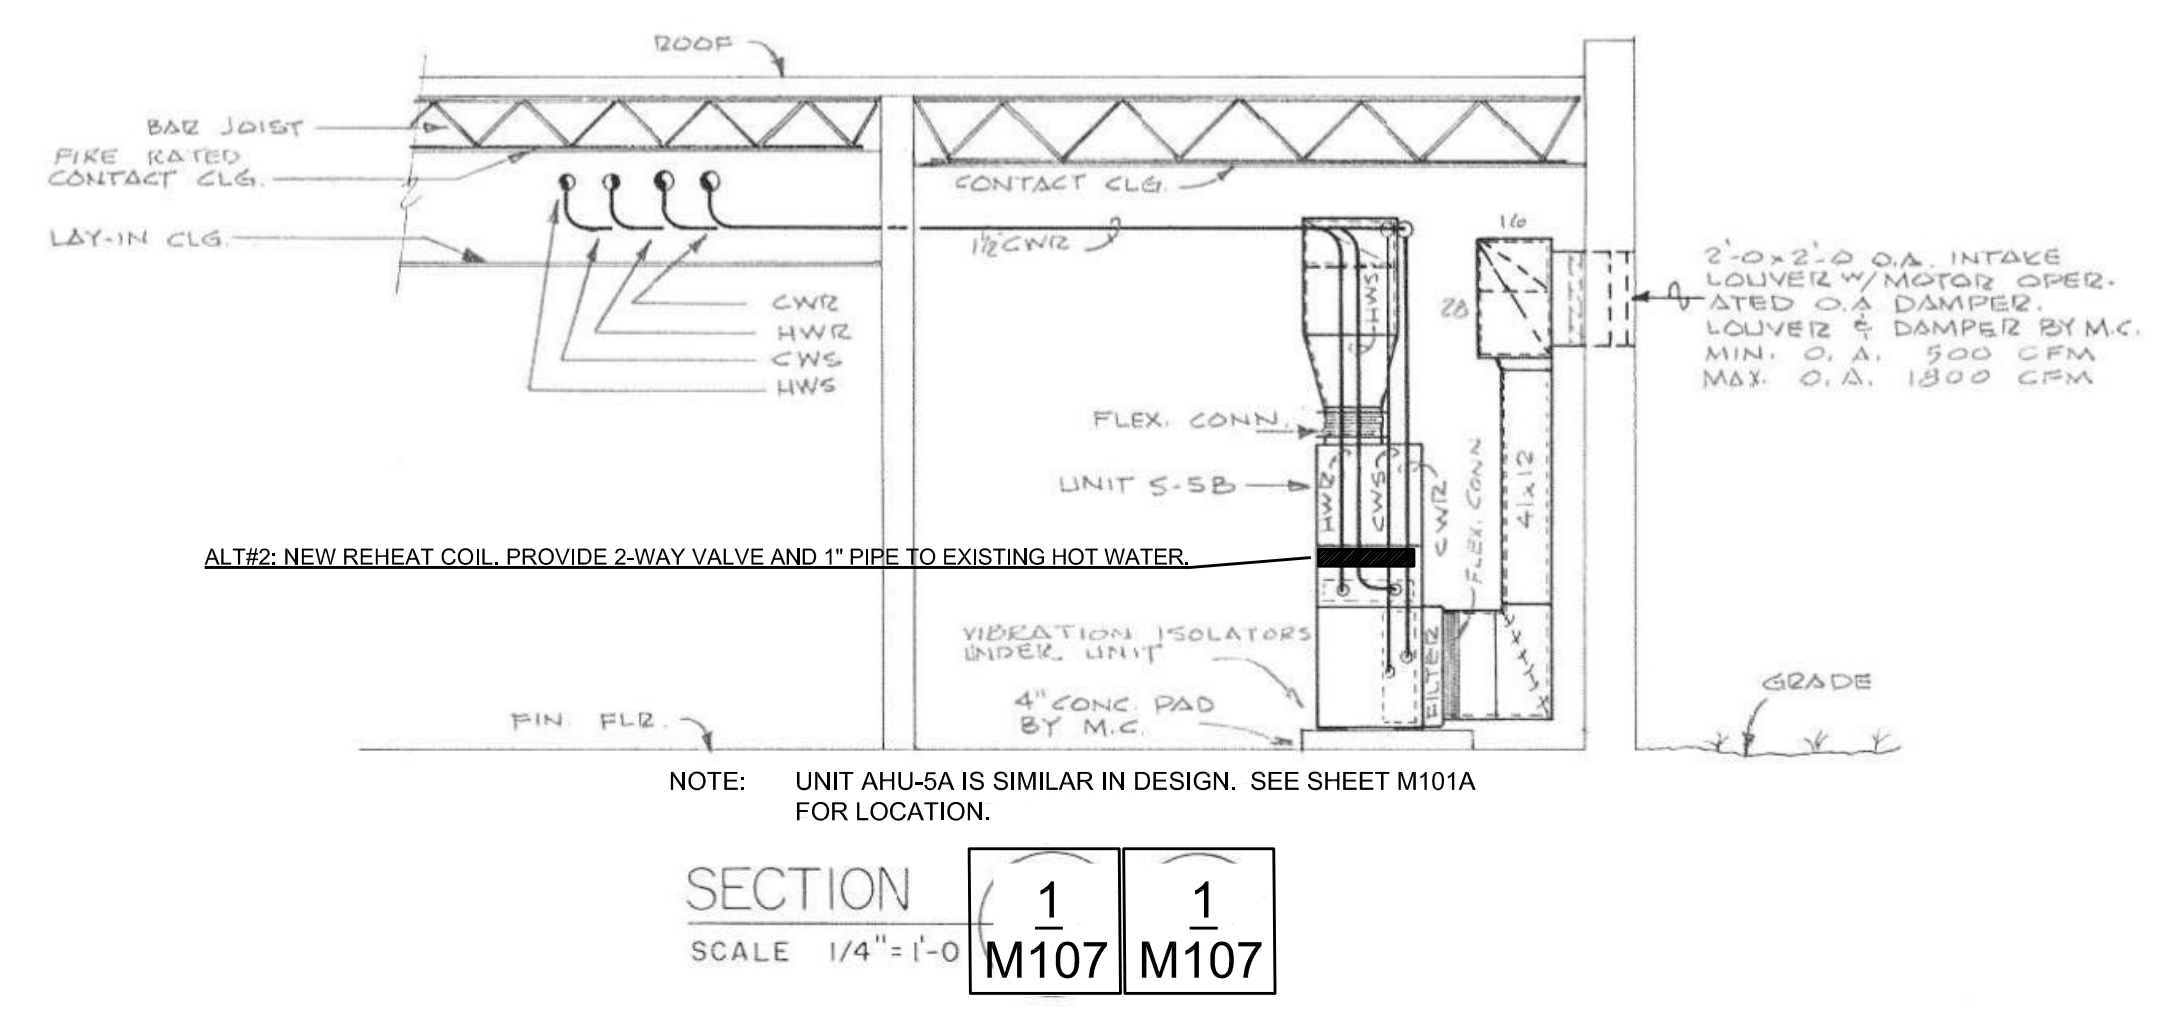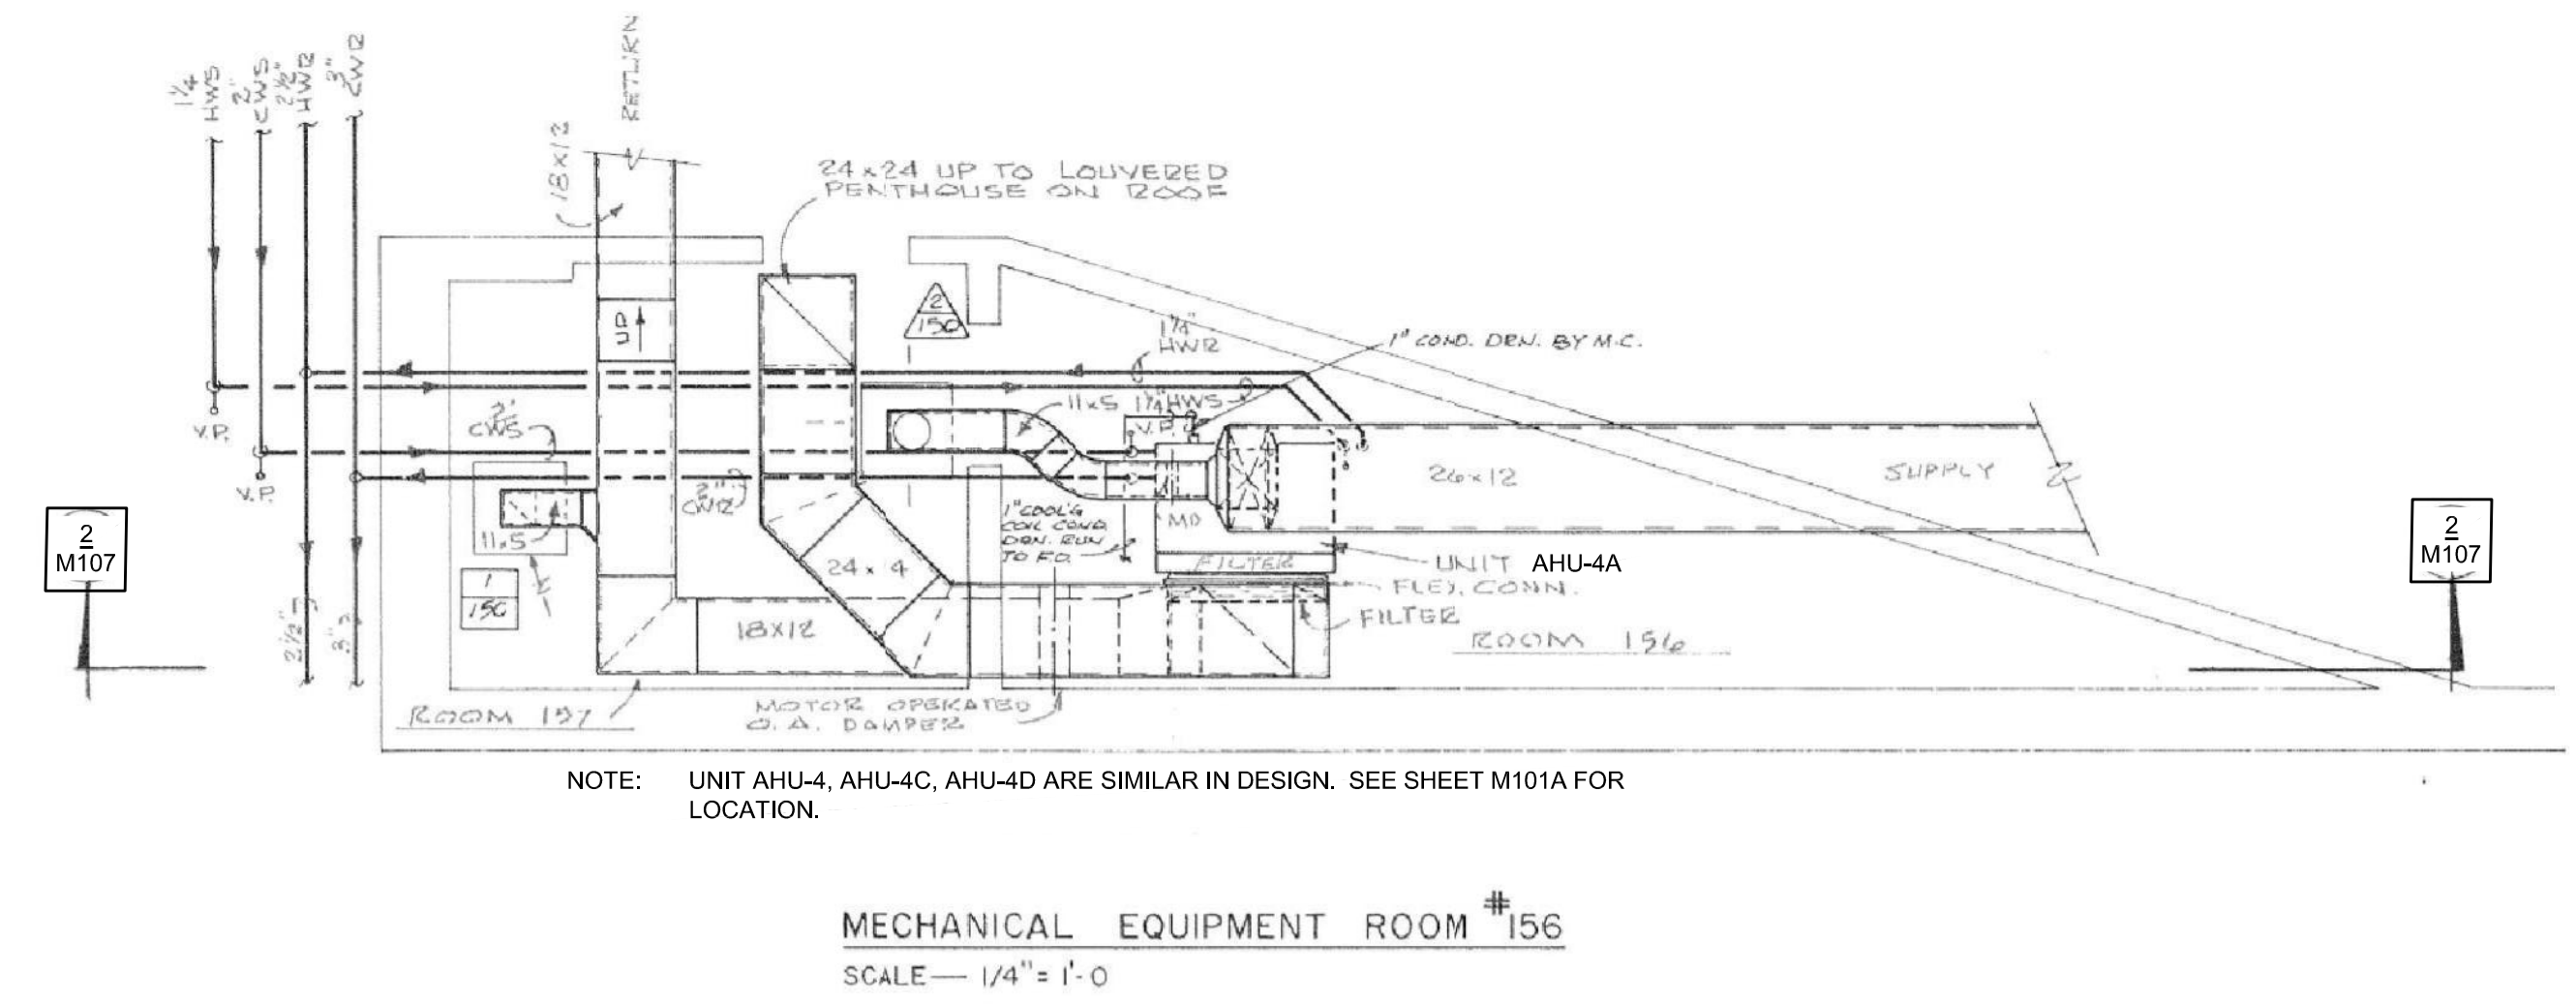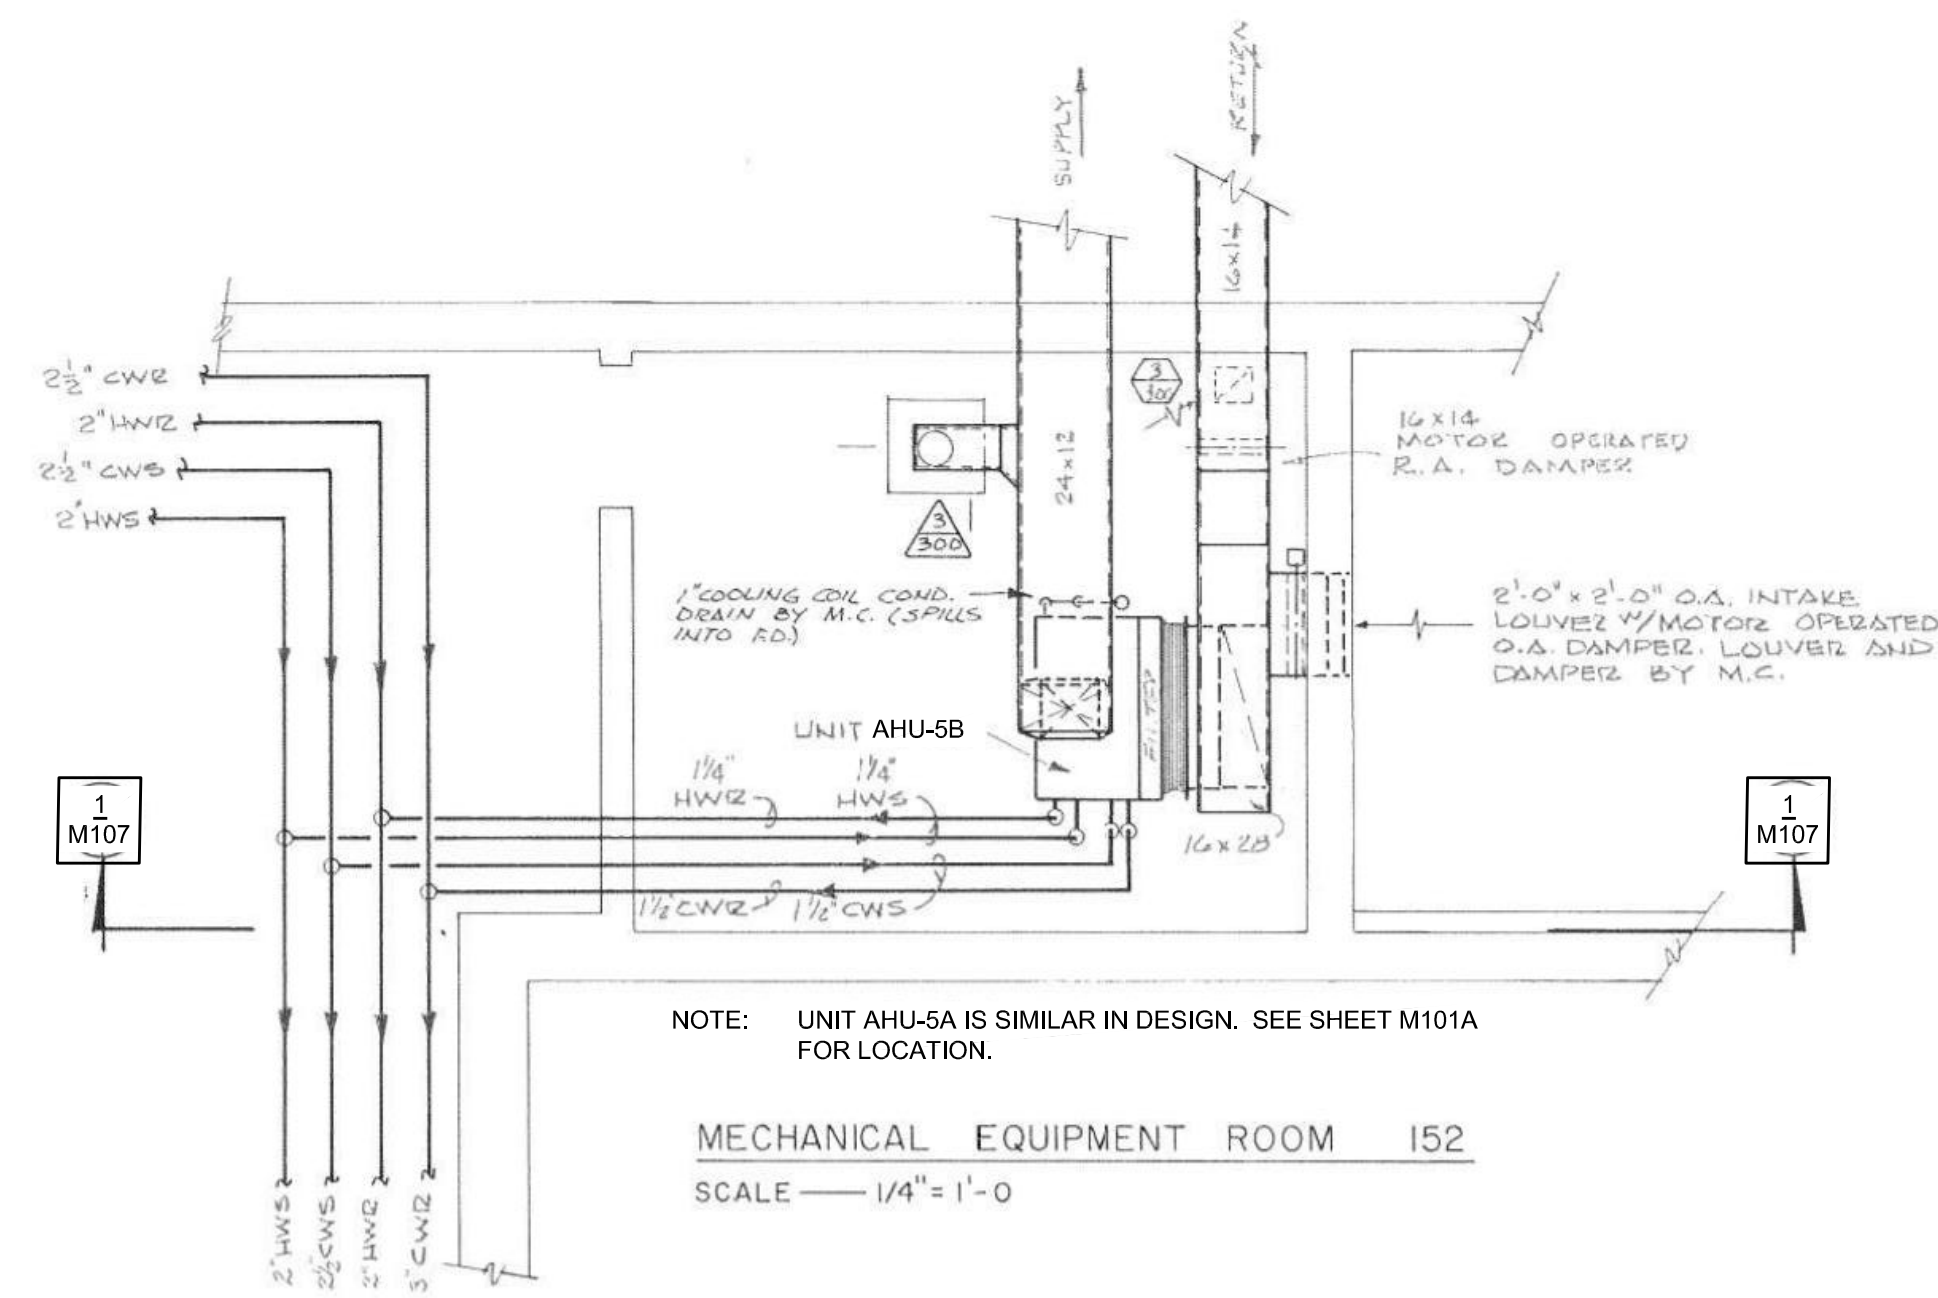




McENIRY HVAC MODERNIZATION

ISSUED FOR CONSTRUCTION

SCO # 18-19463-01

Charlotte, North Carolina

DRAWN BY: JLC
CHECKED BY: JLC
DATE: 01/17/2019
REVISIONS:
1 01/30/19 ADDENDUM #2

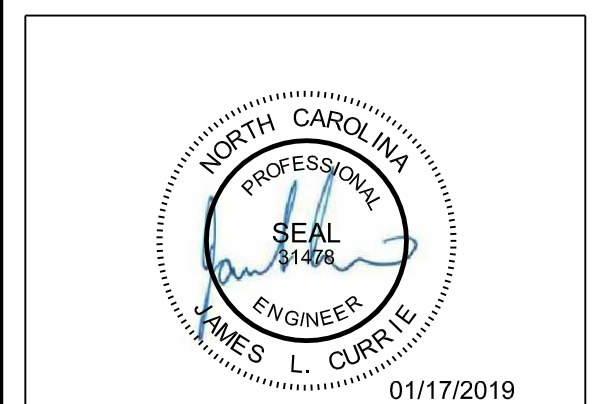

COMMISSION NUMBER: 218.063

DRAWING TITLE:
EXISTING EQUIPMENT SCHEDULES FOR REFERENCE

DRAWING NUMBER:
M006

EXISTING AIR HANDLING UNIT SCHEDULE

GENERAL			FAN DATA											COOLING COIL DATA											REHEATING COIL DATA (ALTERNATE #2 ONLY)											PRE-HEAT COIL DATA											BASIS OF DESIGN				
TAG	AREA SERVED	LOCATION	MIN. O.A. CFM	UNIT TYPE	CFM	ESP (IN.)	TSP (IN.)	FAN TYPE	WHEEL DIA.	FAN R.P.M.	O.V. F.P.M.	DRIVE TYPE	BHP	MIN. HP (1)	VOLTS/PHASE	CFM	MAX. FACE VEL. (FPM)	ENT. AIR °DB	°WB	L.V.G. AIR °DB	°WB	COIL CAP. (MBH) SENS./TOT.	MIN. NO. OF ROWS	MAX. APD (°W.G.)	GPM	EWT (°F)	LWT (°F)	MAX. WPD (FT.)	CFM	MAX. FACE VELOCITY	E.A.T. (°F)	L.A.T. (°F)	MINIMUM COIL CAP. (MBH)	GPM	EWT (°F)	LWT (°F)	MIN. NO. OF ROWS	MAX. APD (°W.G.)	MAX. WPD (FT.)	CFM	MAX. FACE VELOCITY	E.A.T. (°F)	L.A.T. (°F)	MINIMUM COIL CAP. (MBH)	GPM	EWT (°F)	LWT (°F)	MIN. ROWS	MAX. APD (°W.G.)	MAX. WPD (FT.)	BASIS OF DESIGN
AHU 4A/B/C/D	AUDITORIUM	SEE SHEET M101A	300	SZ VAV	2,000	0.75	1.75	FC	12"	1040	1300	BELT	1.25	2	460/3	2,000	380	86.5	72	52	51.5	74.5/135.5	4	0.75	28.5	44	54	15.0	2,000	380	40	80	949	12	180	140	2	0.20	4	2,000	380	40	60	43.5	3	180	150	1	.12	2.6	TRANE LPCC006
AHU 5A/B	CLASSROOM	SEE SHEET M101A	240	SZ VAV	1,800	0.75	1.80	FC	12"	1000	1300	BELT	0.9	1.5	460/3	1,800	350	82.5	68.7	55	54	53.4/84.2	4	0.75	18.1	44	54	12.0	1,800	350	40	80	896	11	180	140	2	0.20	4	1,800	350	40	60	40.0	2.9	180	150	1	.16	.88	TRANE LPCC006

NOTES:

- ALL MOTORS SHALL BE PREMIUM EFFICIENCY ECM MOTOR WITH SPEED INPUT FROM BAS.
- EQUIVALENT UNITS AS MANUFACTURED BY TRANE OR EQUAL BY CARRIER, DAKAN OR COMFORTAIR.
- UNITS SHALL BE PROVIDED WITH 65% EFFICIENCY, PLEATED FILTER WITH 1" THROWAWAY PRE-FILTER (30% EFFICIENCY).
- ALL AIR HANDLING UNITS SHALL HAVE INTERNAL VIBRATION ISOLATION.
- REFER TO "ELECTRICAL CONNECTION TYPE SCHEDULE" FOR WIRING DETAILS.
- UNIT TYPES: SZ = SINGLE ZONE
- AHU SHALL BE PROVIDED WITH VFD OR ECM MOTOR AS PART OF ALTERNATE #2.
- UNITS SHALL BE DOUBLE WALL CONSTRUCTION ALL COMPONENTS.
- UNITS SHALL HAVE STAINLESS STEEL DRAIN PANS.

EXISTING PUMP SCHEDULE

MARK	TYPE	SERVICE	GPM	FT. HEAD	RPM	ELECTRICAL				CONTROL	PUMP MODEL
						BHP	HP	VOLTS	Ø		
PCHWP-1	BASE MOUNTED END SUCTION	PRIMARY CHW	1350	-	1750	-	-	460	3	CV	-
PCHWP-2	BASE MOUNTED END SUCTION	PRIMARY CHW	1350	-	1750	-	-	460	3	CV	-
SCHWP-1	BASE MOUNTED END SUCTION	SECOND. CHW	1350	-	1750	-	-	460	3	VFD	-
SCHWP-2	BASE MOUNTED END SUCTION	SECOND. CHW	1350	-	1750	-	-	460	3	VFD	-
CWP-5	BASE MOUNTED HORIZ. SPLIT CASE	COND. PUMP	1500	69	1750	35	40	460	3	CV	B&G 6X8X13 H5C
CWP-6	BASE MOUNTED HORIZ. SPLIT CASE	COND. PUMP	1500	-	1750	-	-	460	3	CV	-

NOTES: * INFORMATION NOT AVAILABLE AT TIME. FIELD VERIFY FROM NAMEPLATE.



PHOTO OF EXISTING CWP-5 TO BE REPLACED BELOW TOWER

EXISTING WATER-COOLED CHILLER SCHEDULE


UNIT DESIGNATION	CH-1	CH-2
NOMINAL TONS	550	550
MANUFACTURER	YORK	-
MODEL NUMBER	YMC2-S1934AB	-
REFRIGERANT TYPE	R-134a	-
REFRIGERANT CHARGE (LBS.)	1396	-
OPERATING WEIGHT (LBS.)	25,102	-
EVAPORATOR:		
ENTERING WATER TEMP. (°F)	52	52
LEAVING WATER TEMP. (°F)	42	42
FLOW RATE (GPM)	1320	1320
PASSES	2	2
PRESSURE DROP (FT.)	17.5	17.5
FOULING FACTOR	0.0001	0.0001
WORKING FLUID	WATER	WATER
CONDENSER:		
ENT. WATER TEMP. (°F)	85	85
L.V.G. WATER TEMP. (°F)	95	95
FLOW RATE (GPM)	1650	1650
PASSES	2	2
PRESSURE DROP (FT.)	10.3	10.3
FOULING FACTOR	0.00025	0.00025
WORKING FLUID	WATER	WATER
ELECTRICAL DATA		
UNIT VOLTAGE/PHASE	460/3	460/3
MCA/MOCP	522/800	-
PRIMARY L.R.A.	417	-
MAX. KW/TON	0.573	-
MAX N.P.L.V. KW/TON	0.329	-
NOTES		
1. Provide 3/4" Armaflex Factory Insulation on all cold parts.		
2. Chiller shall turn down to 20% at constant 85F condenser water temp w/o hot gas bypass.		
3. Provide VFD starter and factory installed IEEE 519 filter. Performance ratings shall include filter.		
4. Chiller shall be provided with chiller controller and tied into existing building automation system.		
5. See specifications for owner witness test requirements.		
6. 5 year extended warranty on unit, including parts, labor and refrigerant.		
7. Soft interlock chiller w/ primary pump through flow or pressure switch.		
8. Approved Manufacturers: York, Daikin, Smart.		

EXISTING SINGLE DUCT CONSTANT VOLUME TERMINAL UNIT SCHEDULE

MARK	UNIT TYPE (3)	CFM RANGE		MODEL NO.	BOX INLET	TERMINAL UNIT (MINIMUM CFM)	REHEAT COIL				REMARKS (NOTES)		
		MIN.	MAX.				CFM	MBH	GPM	# ROWS			
VAV-05	VV	50	100	30RW-5	⊠	⊠	50	3	0.5	1	112	1/2"	-
VAV-05	VV	85	165	30RW-5	⊠	⊠	85	4.3	0.5	1	101	1/2"	-
VAV-05	VV	90	175	30RW-5	⊠	⊠	90	3	0.5	1	101	1/2"	-
VAV-05	VV	90	180	30RW-5	⊠	⊠	90	4.5	0.5	1	112	1/2"	-
VAV-08	VV	100	200	30RW-8	⊠	⊠	100	4.8	0.5	1	99	1/2"	-
VAV-08	VV	120	240	30RW-8	⊠	⊠	120	5.5	0.5	1	96	1/2"	-
VAV-08	VV	155	300	30RW-8	⊠	⊠	155	7.7	0.5	1	101	1/2"	-

TERMINAL UNIT PERFORMANCE:
⊠ REFER TO PLANS FOR TERMINAL UNIT MAXIMUM CFM.
⊡ REFER TO PLANS FOR TERMINAL UNIT MINIMUM CFM (SAME AS MAXIMUM CFM FOR CONSTANT VOLUME DUAL DUCT UNITS).

- REMARKS (NOTES):**
- CONTRACTOR SHALL FIELD VERIFY EXISTING CONDITIONS AT EACH TERMINAL UNIT PRIOR TO ORDERING UNIT. TERMINAL UNIT PHYSICAL SIZE, INCLUDING CLEARANCES @ CONTROLS AND ACCESS AS RECOMMENDED BY MANUFACTURERS, SHALL BE FABRICATED TO FIT INTO AVAILABLE SPACE. CONTROL BOXES MAY NEED TO BE REMOTELY LOCATED. CONTRACTOR TO ALTER EXISTING DUCTWORK, CONDUITS AND/OR OTHER OBSTRUCTIONS AS REQUIRED TO ACCOMMODATE NEW UNIT AND ASSOCIATED CONNECTION SIZES AND CONFIGURATION.
 - MAXIMUM WIDTH OF SINGLE DUCT CAV TERMINAL UNITS SHALL INCLUDE 12" CLEARANCE ON DAMPER OPERATOR CONTROL SIDE FOR ACCESS. THIS ACCESS SPACE MUST BE MAINTAINED. ACTUAL WIDTH OF UNIT CAN BE NO MORE THAN 24" LESS THAN INDICATED. NOTE - THERE WILL BE NO EXCEPTIOS.
 - UNIT TYPES ARE AS FOLLOWS:
CV = SINGLE DUCT CONSTANT AIR VOLUME
 - UNITS SHALL BE NAILOR MODEL 3101 OR EQUAL BY METALAIR, ENVIROTEC, OR TRANE - SEE NOTES 2 & 5 REGARDING MAXIMUM SIZES.
 - MAXIMUM LENGTH DIMENSION "L" INCLUDES INLET DUCT COLLARS.
 - MAXIMUM ALLOWABLE NC LEVEL @ 1.0" SP IS 30.

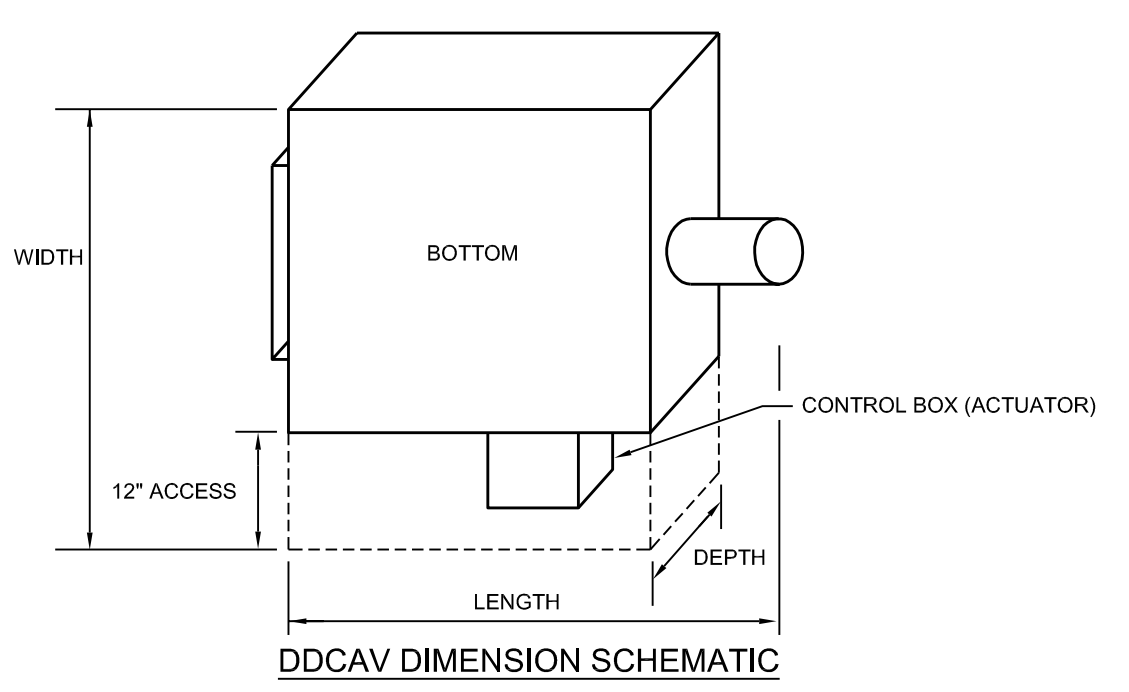

SECTION 01 23 00 – ALTERNATES

PART 1 - GENERAL

1.1 SUMMARY

- A. This Section includes administrative and procedural requirements for alternates.
- B. The contractor shall review all addenda, drawings, and specifications to fully appraise the extent of each alternate.

1.2 DEFINITIONS

- A. **Alternate:** An amount proposed by bidders and stated on the Bid Form for certain work defined in the Bidding Requirements that may be added to or deducted from the Base Bid amount if Owner decides to accept a corresponding change either in the amount of construction to be completed or in the products, materials, equipment, systems, or installation methods described in the Contract Documents.
 - 1. The cost or credit for each alternate is the net addition to or deduction from the Contract Sum to incorporate alternate into the Work. No other adjustments are made to the Contract Sum.

1.3 PROCEDURES

- A. **Coordination:** Modify or adjust affected adjacent work as necessary to completely integrate work of the alternate into Project.
 - 1. Include as part of each alternate, miscellaneous devices, accessory objects, and similar items incidental to or required for a complete installation whether or not indicated as part of alternate.
- B. **Notification:** Immediately following award of the Contract, notify each party involved, in writing, of the status of each alternate. Indicate if alternates have been accepted, rejected, or deferred for later consideration. Include a complete description of negotiated modifications to alternates.
- C. **Execute accepted alternates** under the same conditions as other work of the Contract.
- D. **Schedule:** A Schedule of Alternates is included at the end of this Section. Specification Sections referenced in schedule contain requirements for materials necessary to achieve the work described under each alternate.

PART 2 - PRODUCTS (Not Used)

PART 3 - EXECUTION

3.1 SCHEDULE OF ALTERNATES

- A. Alternate 1: Provide Add Cost to Base Bid for:
 - 1. Removal and replacement of the five terminal units in the auditorium prefunction area lobby. This will include low pressure duct removal and replacement as well as reinsulation of ductwork.

2. Cost to internally clean cold/hot deck medium pressure in Lobby, reseal joints, pressure test ducts and install new external insulation.
 3. Replace controls and valve actuators for existing AHU-4a, AHU-4b, AHU-4c, AHU-4d, AHU-5a, AHU-5b.
- B. Alternate 2: Provide Add Cost to Base Bid for:
1. Removal and replacement of existing six (6) auditorium air handling units. Refer to sheet M006 for schedules and as reflected on sheet M107 for details.
 2. Installation of new reheat coil for each air handler listed above.
 3. Replace existing condenser water pump CWP-5.
 4. Repair existing heat tape at cooling towers. Replace thermostat and reconnect to power.
 5. Replace float and makeup water controller at cooling tower CT-1.
 6. Reconnect power to sump heater at CT-1 and replace basin thermostat.

END OF SECTION 01 23 00

FORM OF PROPOSAL

McEniry HVAC Renovation

Contract: _____

University of North Carolina at Charlotte

Bidder: _____

SCO-ID #18-19463-01

Date: _____

The undersigned, as bidder, hereby declares that the only person or persons interested in this proposal as principal or principals is or are named herein and that no other person than herein mentioned has any interest in this proposal or in the contract to be entered into; that this proposal is made without connection with any other person, company or parties making a bid or proposal; and that it is in all respects fair and in good faith without collusion or fraud. The bidder further declares that he has examined the site of the work and the contract documents relative thereto, and has read all special provisions furnished prior to the opening of bids; that he has satisfied himself relative to the work to be performed. The bidder further declares that he and his subcontractors have fully complied with NCGS 64, Article 2 in regards to E-Verification as required by Section 2.(c) of Session Law 2013-418, codified as N.C. Gen. Stat. § 143-129(j).

The Bidder proposes and agrees if this proposal is accepted to contract with the UNC Charlotte in the form of contract specified below, to furnish all necessary materials, equipment, machinery, tools, apparatus, means of transportation and labor necessary to complete the construction of McEniry HVAC Renovation in full in complete accordance with the plans, specifications and contract documents, to the full and entire satisfaction of the State of North Carolina, the requirements of McCracken & Lopez, P.A. and The University of North Carolina at Charlotte with a definite understanding that no money will be allowed for extra work except as set forth in the General Conditions and the contract documents, for the sum of:

SINGLE PRIME CONTRACT:

Base Bid: _____ Dollars(\$)

General Subcontractor:
_____ Lic _____

Plumbing Subcontractor:
_____ Lic _____

Mechanical Subcontractor:
_____ Lic _____

Electrical Subcontractor:
_____ Lic _____

GS143-128(d) requires all single prime bidders to identify their subcontractors for the above subdivisions of work. A contractor whose bid is accepted shall not substitute any person as subcontractor in the place of the subcontractor listed in the original bid, except (i) if the listed subcontractor's bid is later determined by the contractor to be non-responsible or non-responsive or the listed subcontractor refuses to enter into a contract for the complete performance of the bid work, or (ii) with the approval of the awarding authority for good cause shown by the contractor.

ALTERNATES:

Should any of the alternates as described in the contract documents be accepted, the amount written below shall be the amount to be "added to" or "deducted from" the base bid. (List "Add (+)" or "Deduct (-)" as appropriate.)

Alternate 1: Provide Add Cost to Base Bid for:

1. Removal and replacement of the five terminal units in the auditorium prefunction area lobby. This will include low pressure duct removal and replacement as well as re-insulation of ductwork.
2. Cost to internally clean cold/hot deck medium pressure in Lobby, reseal joints, pressure test ducts and install new external insulation.
3. Replace controls and valve actuators for AHU-4a, 4b, 4c, 4d, 5a, 5b.

Dollars(\$)

Alternate 2: Provide Add Cost to Base Bid for:

1. Removal and replacement of existing six (6) auditorium air handling units. Refer to sheet M006 for schedules and as reflected on sheet M107 for details. Include reconnection of power wiring and smoke detection at AHU-4a/b/c/d.
2. Installation of new reheat coil for each air handler listed above.
3. Replace existing condenser water pump CWP-5. Cost should include disconnect and reconnect of power and controls.
4. Repair existing heat tape at cooling towers. Replace thermostat and reconnect to power.
5. Replace float and makeup water controller at cooling tower CT-1.
6. Reconnect power to sump heater at CT-1 and replace basin thermostat.

Dollars(\$)

UNIT PRICES

None

ALLOWANCES

None

MINORITY BUSINESS PARTICIPATION REQUIREMENTS

Provide with the bid - Under GS 143-128.2(c) the undersigned bidder shall identify **on its bid** (Identification of Minority Business Participation Form) the minority businesses that it will use on the project with the total dollar value of the bids that will be performed by the minority businesses. **Also** list the good faith efforts (Affidavit **A**) made to solicit minority participation in the bid effort.

NOTE: A contractor that performs all of the work with its own workforce may submit an Affidavit (**B**) to that effect in lieu of Affidavit (**A**) required above. The MB Participation Form must still be submitted even if there is zero participation.

After the bid opening - The Owner will consider all bids and alternates and determine the lowest responsible, responsive bidder. Upon notification of being the apparent low bidder, the bidder shall then file within 72 hours of the notification of being the apparent lowest bidder, the following:

An Affidavit (**C**) that includes a description of the portion of work to be executed by minority businesses, expressed as a percentage of the total contract price, which is equal to or more than the 10% goal established. This affidavit shall give rise to the presumption that the bidder has made the required good faith effort and Affidavit **D** is not necessary;

* **OR** *

If less than the 10% goal, Affidavit (**D**) of its good faith effort to meet the goal shall be provided. The document must include evidence of all good faith efforts that were implemented, including any advertisements, solicitations

and other specific actions demonstrating recruitment and selection of minority businesses for participation in the contract.

Note: Bidders must always submit **with their bid** the Identification of Minority Business Participation Form listing all MB contractors, vendors and suppliers that will be used. If there is no MB participation, then enter none or zero on the form. Affidavit A **or** Affidavit B, as applicable, also must be submitted with the bid. Failure to file a required affidavit or documentation with the bid or after being notified apparent low bidder is grounds for rejection of the bid.

Proposal Signature Page

The undersigned further agrees that in the case of failure on his part to execute the said contract and the bonds within ten (10) consecutive calendar days after being given written notice of the award of contract, the certified check, cash or bid bond accompanying this bid shall be paid into the funds of the owner's account set aside for the project, as liquidated damages for such failure; otherwise the certified check, cash or bid bond accompanying this proposal shall be returned to the undersigned.

Respectfully submitted this day of _____

(Name of firm or corporation making bid)

WITNESS:

(Proprietorship or Partnership)

By: _____
Signature

Name: _____
Print or type

Title _____
(Owner/Partner/Pres./V.Pres)

Address _____

ATTEST:

By: _____

Title: _____
(Corp. Sec. or Asst. Sec. only)

License No. _____

Federal I.D. No. _____

Email Address: _____

(CORPORATE SEAL)

Addendum received and used in computing bid:

Addendum No. 1 _____ (check)

Addendum No. 2 _____ (check)