

# Bid Addendum 01



## CLARK NEXSEN

1523 Elizabeth Ave, Suite 300  
Charlotte, NC 28204

Project: UNC Charlotte Science Building:  
Early Package 1  
Existing Building Heating Conversions

Date: November 20, 2017

COMM #: SCO ID #: 16-14335-02B  
Code: 46626 Item: 301  
Clark Nexsen #: 6222

Prepared by: Mike Romot, AIA, LEED BD+C

*This ADDENDUM is to be a part of the contract documents and modifies and takes precedence over the original bid documents, as noted below and in any attached documents. Original items of the plans and specifications that have been modified, amended, voided or suspended through previous addendums, shall remain in effect. It is the responsibility of the Bidder to notify and/or distribute this ADDENDUM to those sub-bidders who have received prints or digital files. The Bidder is to acknowledge receipt of this ADDENDUM in the space provided on the Bid Form.*

### GENERAL INFORMATION

- All work associated with the Atkins Library Building, Kennedy Building and McMillan Greenhouse is removed from this bid package. The utilities crossing Craver Road, 5'-0" beyond the curb (both North and South) of Craver Road, is by others and is not a part of this contract. All chilled water piping is by others and is not a part of this contract.

### DRAWING MODIFICATIONS

- Revise sheet GI001 TITLE SHEET as follows:
  - Under the "Scope Summary" chart remove these scope items:
    - 1. Atkins Library Building
    - 4. Kennedy Building
    - 6. McMillan Greenhouse
- Delete the following drawings sheets in their entirety from the drawing set and remove reference to them from the sheet index:
  - GI100 ATKINS LIBRARY CODE SUMMARY
  - GI400 KENNEDY CODE SUMMARY
  - GI600 MCMILLAN GREENHOUSE CODE SUMMARY
  - ME004 STEAM DIAGRAMS
  - ME008 CONTROLS
  - ME100 ATKINS MECHANICAL-ELECTRICAL PLANS
  - ME400 KENNEDY MECHANICAL-ELECTRICAL PLANS
  - ME600 MCMILLAN MECHANICAL-ELECTRICAL PLANS

# Bid Addendum 01



- Replace the following sheets with the attached revised sheets:
  - C-100 DEMO AND EROSION CONTROL PLAN
  - C-200 LAYOUT PLAN
  - C-300 GRADING PLANS
  - C-400 UTILITY PLANS
  - C-401 UTILITY DETAILS
  - ME001 MECHANICAL LEGENDS AND NOTES
  - ME006 ELECTRICAL SCHEDULES AND DETAILS
  - ME200 CAMERON MECHANICAL ELECTRICAL PLANS
  - MES01 MECHANICAL-ELECTRICAL SITE PLAN AND DETAILS
  
- Revise sheet ME003 as follows:
  - Alter the Pump Schedule by deleting in their entirety, pumps P-5 and P-6.
  - Alter the Expansion Tank Schedule by deleting in its entirety, expansion tank ET-1
  - Alter the Air Separator Schedule by deleting in its entirety, expansion tank AS-1
  - Alter the pipe insulation thicknesses schedule so the thickness for steam piping 1-1/2 inch and greater is 3", not 2".
  - Delete the following equipment schedules in their entirety:
    - Hot Water Unit Heater Schedule
    - Steam Unit Heater Schedule
    - Boiler Feedwater Assembly Schedule
    - Blowdown Separator Schedule
    - Steam Boiler Schedule
    - Natural Gas Condensing Type Boiler Schedule
    - Fan Schedule
  
- Revise sheet ME010 as follows:
  - Add "General Notes" from Sheet ME011.
  - Add "Controls Contractor Coordination" from Sheet ME011.

## PROJECT MANUAL MODIFICATIONS

- Modify 000110 – Table of Contents as follows:
  - 003126 Hazardous Materials - Delete the following reports:
    - NESHAP Asbestos Survey Report – Atkins Mechanical Rooms and Atkins Stacks.
    - NESHAP Asbestos Survey Report – Kennedy Mechanical Room, IT Services Offices, and Hallway Corridor.
    - NESHAP Asbestos Survey Report – McMillan Greenhouse Mechanical Room.
  - 042200 Concrete Unit Masonry – Delete section.
  
- Modify 000115 – List of Drawing Sheets deleting drawings listed in the "Drawing Modifications" portion of this addendum.

# Bid Addendum 01



- Delete the following specification sections:
  - 000107 Seals Page: Delete unsigned page only.
  - 042200 Concrete Unit Masonry
  - 233423 HVAC Power Ventilators
  - 235216 Condensing Boilers
  - 235223 Steam Boiler Vertical Multiport
  - 235223.13 Steam Boiler Vertical
  - 238239.16 Propeller Unit Heaters

## **REQUEST FOR SUBSTITUTION or APPROVED EQUAL PRODUCT MANUFACTURERS**

*Manufacturers below, not previously listed in the Construction Documents, have been approved to participate in the project based on submitted data. Being added to the list of approved manufacturers does not relieve the manufacturer or their product(s) from meeting the minimal performance requirements set forth in the Bid Documents.*

- No requests now.

## **QUESTIONS AND ANSWERS**

1. **Hot Water Valves** (Drawing Sheet C-400): Provide specifications and details on hand holes for 10" heating hot water valves shown at the temporary boiler trailers.

Response: The requirements for the below grade valves are described on drawing ME001. The drawings state to provide valves below grade with extensions and donut and valve box. Typical valve box detail has been added on drawing C-401.

2. **Heat Trace at Temporary Trailers** (Detail 3/MES01): Will heat tracing be needed for hot water piping above grade at temporary trailers locations? If so, please provide watts for heat tape.

Response: Heat tracing is not required for the heating water pipe.

3. **Flushing** (Drawing Sheet ME001): With the method of flushing specified will this not cause the inner piping to corrode before set into service? On earlier projects, at UNCC, the mechanical contractor installed the piping system and hydro flushed then new piping system before connecting to existing systems.

Response: Per UNCC personnel, flush system per UNCC Guidelines and per the drawings as described on drawing sheet ME001.

4. **HHWS/R Piping** (Detail. 1/MES01):

# Bid Addendum 01



- a. **Main Walkway:** Detail shows connecting new 10" HHWS/R piping, at 36" grade, to existing 6" HHWS/R that shows no grade.
- b. **McEniry Connection:** Detail shows connecting new 6" HHWS/R piping, at a 36" grade, to existing 6" HHWS/R that shows no grade.
- c. **Cameron Connection:** Detail shows connecting new 4" HHWS/R piping, at a 36" grade, to existing 6" HHWS/R that shows no grade. Please provide a detail of what type of connections required.
- d. **Over Pipe Connection/ Under Pipe Connection:**
  - i. Over Pipe Connection will require a vent.
  - ii. Under pipe connection will require a drain.

Response: The pipe connections will need to be field coordinated after the exact depth of the existing piping and any other existing utilities within close vicinity are identified. The preference is to use a over-pipe connection with an air vent in lieu of a under-pipe connection with a drain.

5. **A/C Unit (Drawing Sheet C-050):** Picture shows an outdoor A/C unit at location of new underground hot water piping to be installed. There is no mention of relocating this A/C unit. During the walk-thru there was mention of relocating the underground hot water piping. Provide information of what will be needed. Relocate A/C unit or relocate underground piping so subcontractors can estimate accordingly.


Response: The underground piping enters Cameron in a storage room. There should be sufficient linear wall space to locate the pipes and not disturb the existing AC unit. The exact location of where the pipes shall enter the building will need to be coordinated during the construction phase of the project.

## ATTACHMENTS

- o C-100 DEMO AND EROSION CONTROL PLAN
- o C-200 LAYOUT PLAN
- o C-300 GRADING PLANS
- o C-400 UTILITY PLANS
- o C-401 UTILITY DETAILS
- o ME001 MECHANICAL LEGENDS AND NOTES
- o ME006 ELECTRICAL SCHEDULES AND DETAILS
- o MES01 MECHANICAL-ELECTRICAL SITE PLAN AND DETAILS


**END OF BID ADDENDA 01**



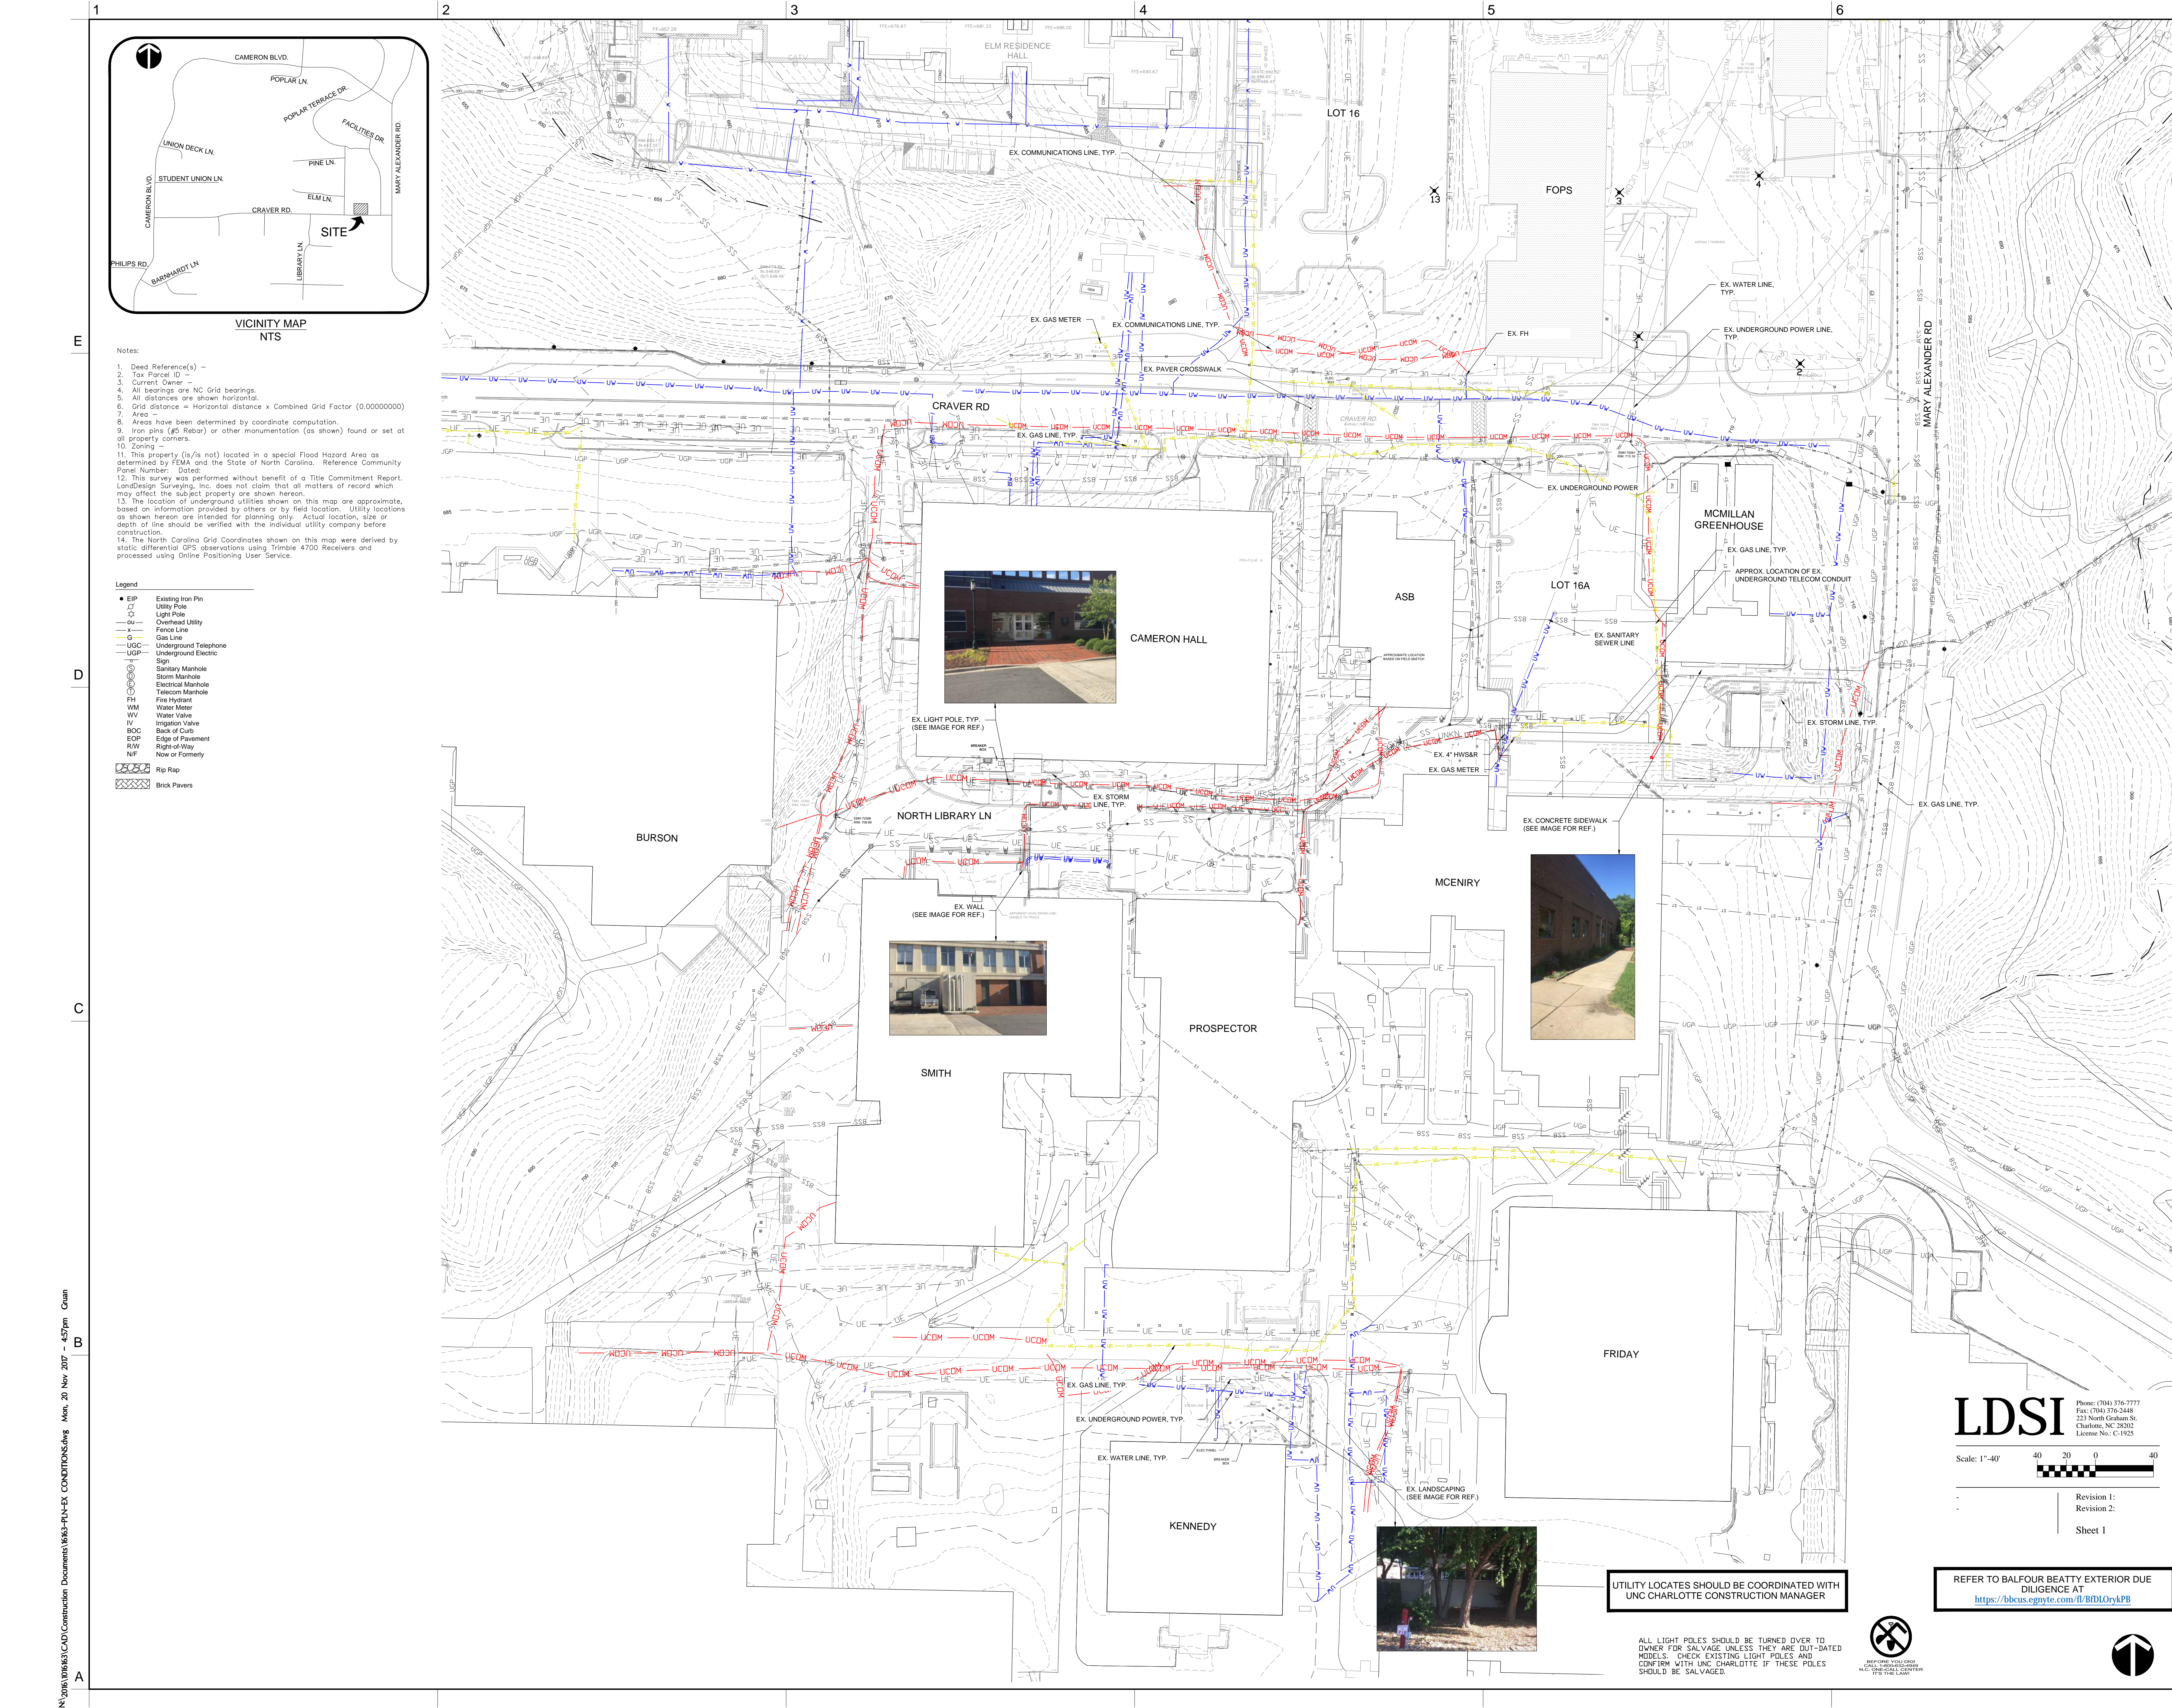

- Notes:
1. Deed Reference(s) -
  2. Tax Parcel ID -
  3. Current Owner -
  4. All bearings are NC Grid bearings.
  5. All distances are shown horizontal.
  6. Grid distance = Horizontal distance x Combined Grid Factor (0.00000000)
  7. Area =
  8. Areas have been determined by coordinate computation.
  9. Iron pins (#8 Rebar) or other monumentation (as shown) found or set at all property corners.
  10. Zoning -
  11. This property (is/is not) located in a special Flood Hazard Area as determined by FEMA and the State of North Carolina. Reference Community Panel Number: Dated:
  12. This survey was performed without benefit of a Title Commitment Report. LandDesign Surveying, Inc. does not claim that all matters of record which may affect the subject property are shown hereon.
  13. The location of underground utilities shown on this map are approximate, based on information provided by others or by field location. Utility locations as shown hereon are intended for planning only. Actual location, size or depth of line should be verified with the individual utility company before construction.
  14. The North Carolina Grid Coordinates shown on this map were derived by static differential GPS observations using Trimble 4700 Receivers and processed using Online Positioning User Service.

- Legend
- EIP Existing Iron Pin
  - UP Utility Pole
  - LP Light Pole
  - OU Overhead Utility
  - FL Fence Line
  - G Gas Line
  - UGC Underground Telephone
  - UGP Underground Electric
  - SM Sign
  - SM Sanitary Manhole
  - SM Storm Manhole
  - SM Electrical Manhole
  - SM Telecom Manhole
  - FH Fire Hydrant
  - WM Water Meter
  - WV Water Valve
  - IV Irrigation Valve
  - BOC Back of Curb
  - EOP Edge of Pavement
  - R/W Right-of-Way
  - NF Now or Formerly
  - Rip Rip Rap
  - Brick Bricks



**UNC CHARLOTTE**

Sciences Building - Existing Building Heating Conversions


9201 University City Boulevard  
Charlotte, NC 28223

---

SCO ID Number: 16-14355-02B  
Code: 46626  
Item: 301

---

DESIGNER



**CLARK NEXSEN**

1523 Elizabeth Avenue, Suite 300  
Charlotte, NC 28204  
704.377.8800


---

CONSULTANT

223 N Graham Street Charlotte, NC 28202  
V: 704.333.0325 F: 704.332.3246  
www.LandDesign.com

---

SEALS

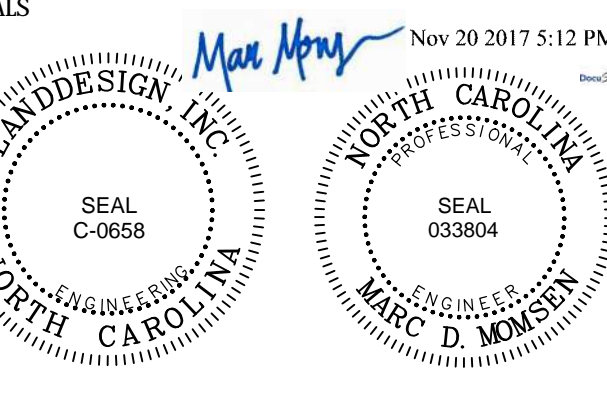

NC Corporate Engineering License # C-0658

SUBMITTAL

05 November 2017

Bid Documents

---

REVISIONS

NO.	DATE	DESCRIPTION

---

SHEET

**EX CONDITIONS**

---

**C-050**

---


DESIGN: MDM  
DRAWN: GR  
REVIEW: MDM

CN 6222

N:\2016\1016\63\CAD\Construction Documents\16163-PLN-EX CONDITIONS.dwg Mon, 20 Nov 2017 - 4:57pm Grant

**LDSI** Phone: (704) 376-7777  
Fax: (704) 376-2448  
223 North Graham St.  
Charlotte, NC 28202  
License No. C-1925

Scale: 1"=40'

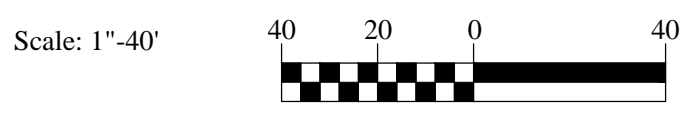


Revision 1:  
Revision 2:  
Sheet 1


UTILITY LOCATES SHOULD BE COORDINATED WITH UNC CHARLOTTE CONSTRUCTION MANAGER

REFER TO BALFOUR BEATTY EXTERIOR DUE DILIGENCE AT <https://bbcus.egnys.com/#!/BID/OrkPB>

ALL LIGHT POLES SHOULD BE TURNED OVER TO OWNER FOR SALVAGE UNLESS THEY ARE OUT-DATED MODELS. CHECK EXISTING LIGHT POLES AND CONFIRM WITH UNC CHARLOTTE IF THESE POLES SHOULD BE SALVAGED.

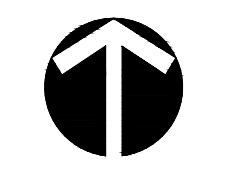



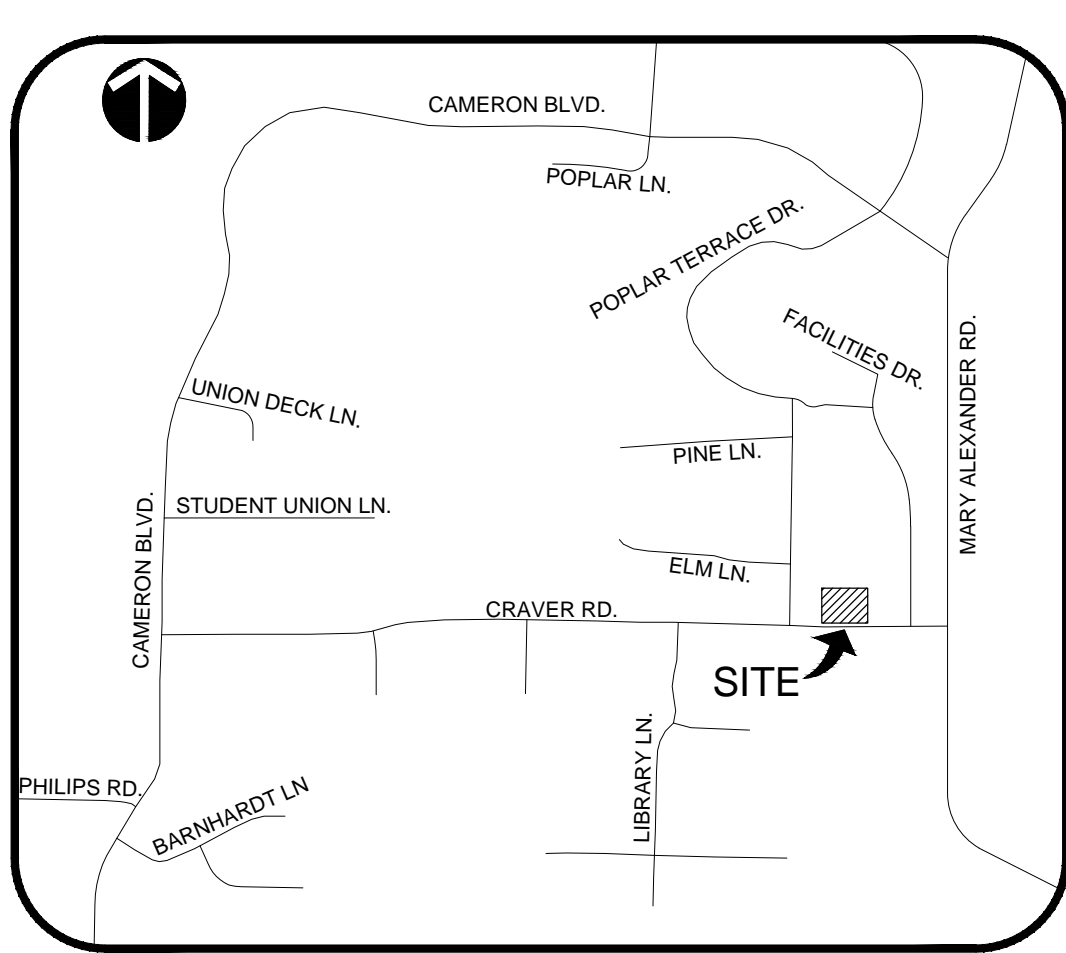


VICINITY MAP NTS

GENERAL NOTES:

- 1. ALL PROPERTY AFFECTED BY THIS WORK SHALL BE RESTORED TO A CONDITION EQUAL TO OR BETTER THAN THE EXISTING UNLESS OTHERWISE SPECIFICALLY EXEMPTED BY THESE PLANS. CONTRACTOR TO CLEANUP, RESTORE, AND REPLANT WORK AREAS UPON COMPLETION.
2. THE CONTRACTOR IS CAUTIONED THAT THE LOCATION AND/OR ELEVATION OF EXISTING UTILITIES AS SHOWN ON THESE PLANS ARE BASED ON RECORDS OF THE VARIOUS UTILITY COMPANIES...
3. THE CONTRACTOR SHALL IMMEDIATELY REPORT TO THE OWNER AND ENGINEER ANY DISCREPANCIES FOUND BETWEEN ACTUAL FIELD CONDITIONS AND CONSTRUCTION DOCUMENTS...
4. PRIOR TO BEGINNING CONSTRUCTION THE CONTRACTOR IS RESPONSIBLE TO VERIFY THAT ALL REQUIRED PERMITS AND APPROVALS HAVE BEEN OBTAINED FROM ALL REGULATORY AUTHORITIES...
5. THE CONTRACTOR SHALL BE RESPONSIBLE FOR DAMAGE TO ANY EXISTING ITEM AND/OR MATERIAL INSIDE OR OUTSIDE THE CONSTRUCTION LIMITS.
6. CONTRACTOR SHALL MAINTAIN THE SITE IN A MANNER SO THAT WORKERS AND PUBLIC ARE PROTECTED FROM INJURY.
7. LANDSCAPE SHALL NOT BE IN CONTROL OR CHARGE OF, AND SHALL NOT BE RESPONSIBLE FOR ACTUAL CONSTRUCTION MEANS, METHODS, TECHNIQUES, PROCEDURES, OR SAFETY PRECAUTIONS IN CONNECTION WITH THE WORK, OR FOR THE ACTS OR OMISSIONS OF CONTRACTORS OR ANY OTHER PERSONS NOT UNDER THE EMPLOYMENT OF LANDSCAPE.

DEMOLITION NOTES:

- 1. CONTRACTOR SHALL SUBMIT DEMOLITION SCHEDULE TO OWNER PRIOR TO PROCEEDING WITH DEMOLITION ACTIVITIES.
2. EXTENT OF SITE CLEARING IS SHOWN ON DRAWINGS. SITE DEMOLITION WORK INCLUDES, BUT IS NOT LIMITED TO:
2.1. PAVEMENT SIDEWALKS/CROSSWALKS
2.2. SITE UTILITIES
2.3. LANDSCAPING
2.4. HARDSCAPE
3. CONDUCT SITE DEMOLITION OPERATIONS TO ENSURE MINIMUM INTERFERENCE WITH ROADS, STREETS, WALKS, AND OTHER ADJACENT OCCUPIED OR USED FACILITIES. DO NOT CLOSE OR OBSTRUCT STREETS, WALKS OR OTHER OCCUPIED OR USED FACILITIES WITHOUT PERMISSION FROM AUTHORITIES HAVING JURISDICTION.
4. RESTORE DAMAGED IMPROVEMENTS TO THEIR ORIGINAL CONDITION, AS ACCEPTABLE TO PARTIES HAVING JURISDICTION.
5. REMOVE WASTE MATERIALS AND UNSUITABLE AND EXCESS TOPSOIL FROM PROPERTY AND DISPOSE OF OFF-SITE IN A LEGAL MANNER.
6. LOCATE EXISTING ABOVE GROUND AND UNDERGROUND UTILITIES IN AREAS OF WORK. IF UTILITIES ARE TO REMAIN IN PLACE, PROVIDE ADEQUATE MEANS OF SUPPORT AND PROTECTION DURING DEMOLITION OPERATION.
7. SHOULD UNCHARTERED, OR INCORRECTLY CHARTERED PIPING OR OTHER UTILITIES BE ENCOUNTERED DURING DEMOLITION, CONSULT PROJECT ENGINEER AND UTILITY OWNER FOR IMMEDIATE ACTION.
8. DEMOLISH AND COMPLETELY REMOVE FROM SITE MATERIAL INDICATED ON PLAN OR NOTES TO BE REMOVED.
9. PROTECT STRUCTURES, UTILITIES, SIDEWALKS, PAVEMENTS, AND OTHER FACILITIES FROM DAMAGE CAUSED BY SETTLEMENT, LATERAL MOVEMENT, UNDERMINING, WASHOUT AND OTHER HAZARDS CREATED BY THE DEMOLITION OPERATION.
10. CONTRACTOR SHALL RESTORE ALL DISTURBED AREAS TO EXISTING CONDITIONS OR BETTER. FURTHERMORE, CONTRACTOR SHALL PROVIDE TO ENGINEER PHOTOGRAPH OF PRE-CONSTRUCTION CONDITIONS AND POST-CONSTRUCTION CONDITIONS AS NOTED ON PLANS.
11. CONTRACTOR SHALL MAINTAIN STORMWATER MANAGEMENT SYSTEM DURING CONSTRUCTION TO ENSURE NO DAMAGE TO ADJACENT PROPERTIES OCCURS DURING STORM EVENTS.
12. CONTRACTOR TO REMOVE ALL VISIBLE OR REASONABLY IDENTIFIABLE MATERIAL, EQUIPMENT, ETC. FROM THE SITE IF NOT NEEDED FOR NEW CONSTRUCTION.
13. SURVEY DATUM IS FROM THE BOUNDARY AND TOPOGRAPHIC SURVEY PROVIDED BY LDSI SURVEYORS.
14. THE LOCATION OF ALL UTILITIES SHOWN ON THE PLANS HAVE BEEN DETERMINED FROM AVAILABLE INFORMATION AND ARE GIVEN FOR THE CONVENIENCE OF THE CONTRACTOR, THE ENGINEER AND OWNER ASSUME NO RESPONSIBILITY FOR INACCURACY.
15. ALL DEMOLITION AND CONSTRUCTION SHALL COMPLY WITH APPLICABLE BUILDING CODES AND LOCAL RESTRICTIONS. THE CONTRACTOR MUST COMPLY WITH ALL OF THE CONTRACTOR REGISTRATION REQUIREMENTS OF ALL GOVERNING AUTHORITIES.
16. PRIOR TO THE COMMENCEMENT OF DEMOLITION, THE CONTRACTOR IS TO COORDINATE FULLY WITH UNC CHARLOTTE ON THE EXACT LOCATION OF ALL UNDERGROUND UTILITIES PRIOR TO EXCAVATION. UNC CHARLOTTE WILL LOCATE ALL UNDERGROUND UTILITIES.
17. MINIMUM DEPTH FOR REMOVAL OF ALL OBJECTS SHALL BE TWO (2) FEET BELOW GRADE. THE CONTRACTOR IS RESPONSIBLE FOR PROPER DISPOSAL OF ALL WASTE MATERIAL.
18. ALL PAVING REMOVAL AND DEMOLITION SHALL BE PERFORMED AS SHOWN ON THE PLANS OR AS DIRECTED BY THE ENGINEER OR OWNER.
19. RELOCATION OR REMOVAL OF OVERHEAD OR UNDERGROUND UTILITIES SHALL BE COORDINATED WITH THE APPROPRIATE UTILITY COMPANY.
20. CONTRACTOR SHALL REMOVE ALL EXISTING LIGHT POLES IN THE DEMOLITION AREA AT THE OWNERS DIRECTION.
21. ALL PROPOSED PAVEMENT CUTS SHALL BE SAW CUT ONLY.
22. CONTRACTOR SHALL PROVIDE A MINIMUM OF 72 HOURS ADVANCE NOTICE TO THE OWNER PRIOR TO STARTING DEMOLITION ACTIVITIES.
23. CONTRACTOR TO REMOVE, STORE AND REINSTALL ALL HARDSCAPE WITHIN LIMITS OF PIEDMONT NATURAL GAS WORK. PNG WILL COORDINATE WITH PAVING CONTRACTOR AND CONSTRUCTION MANAGER.

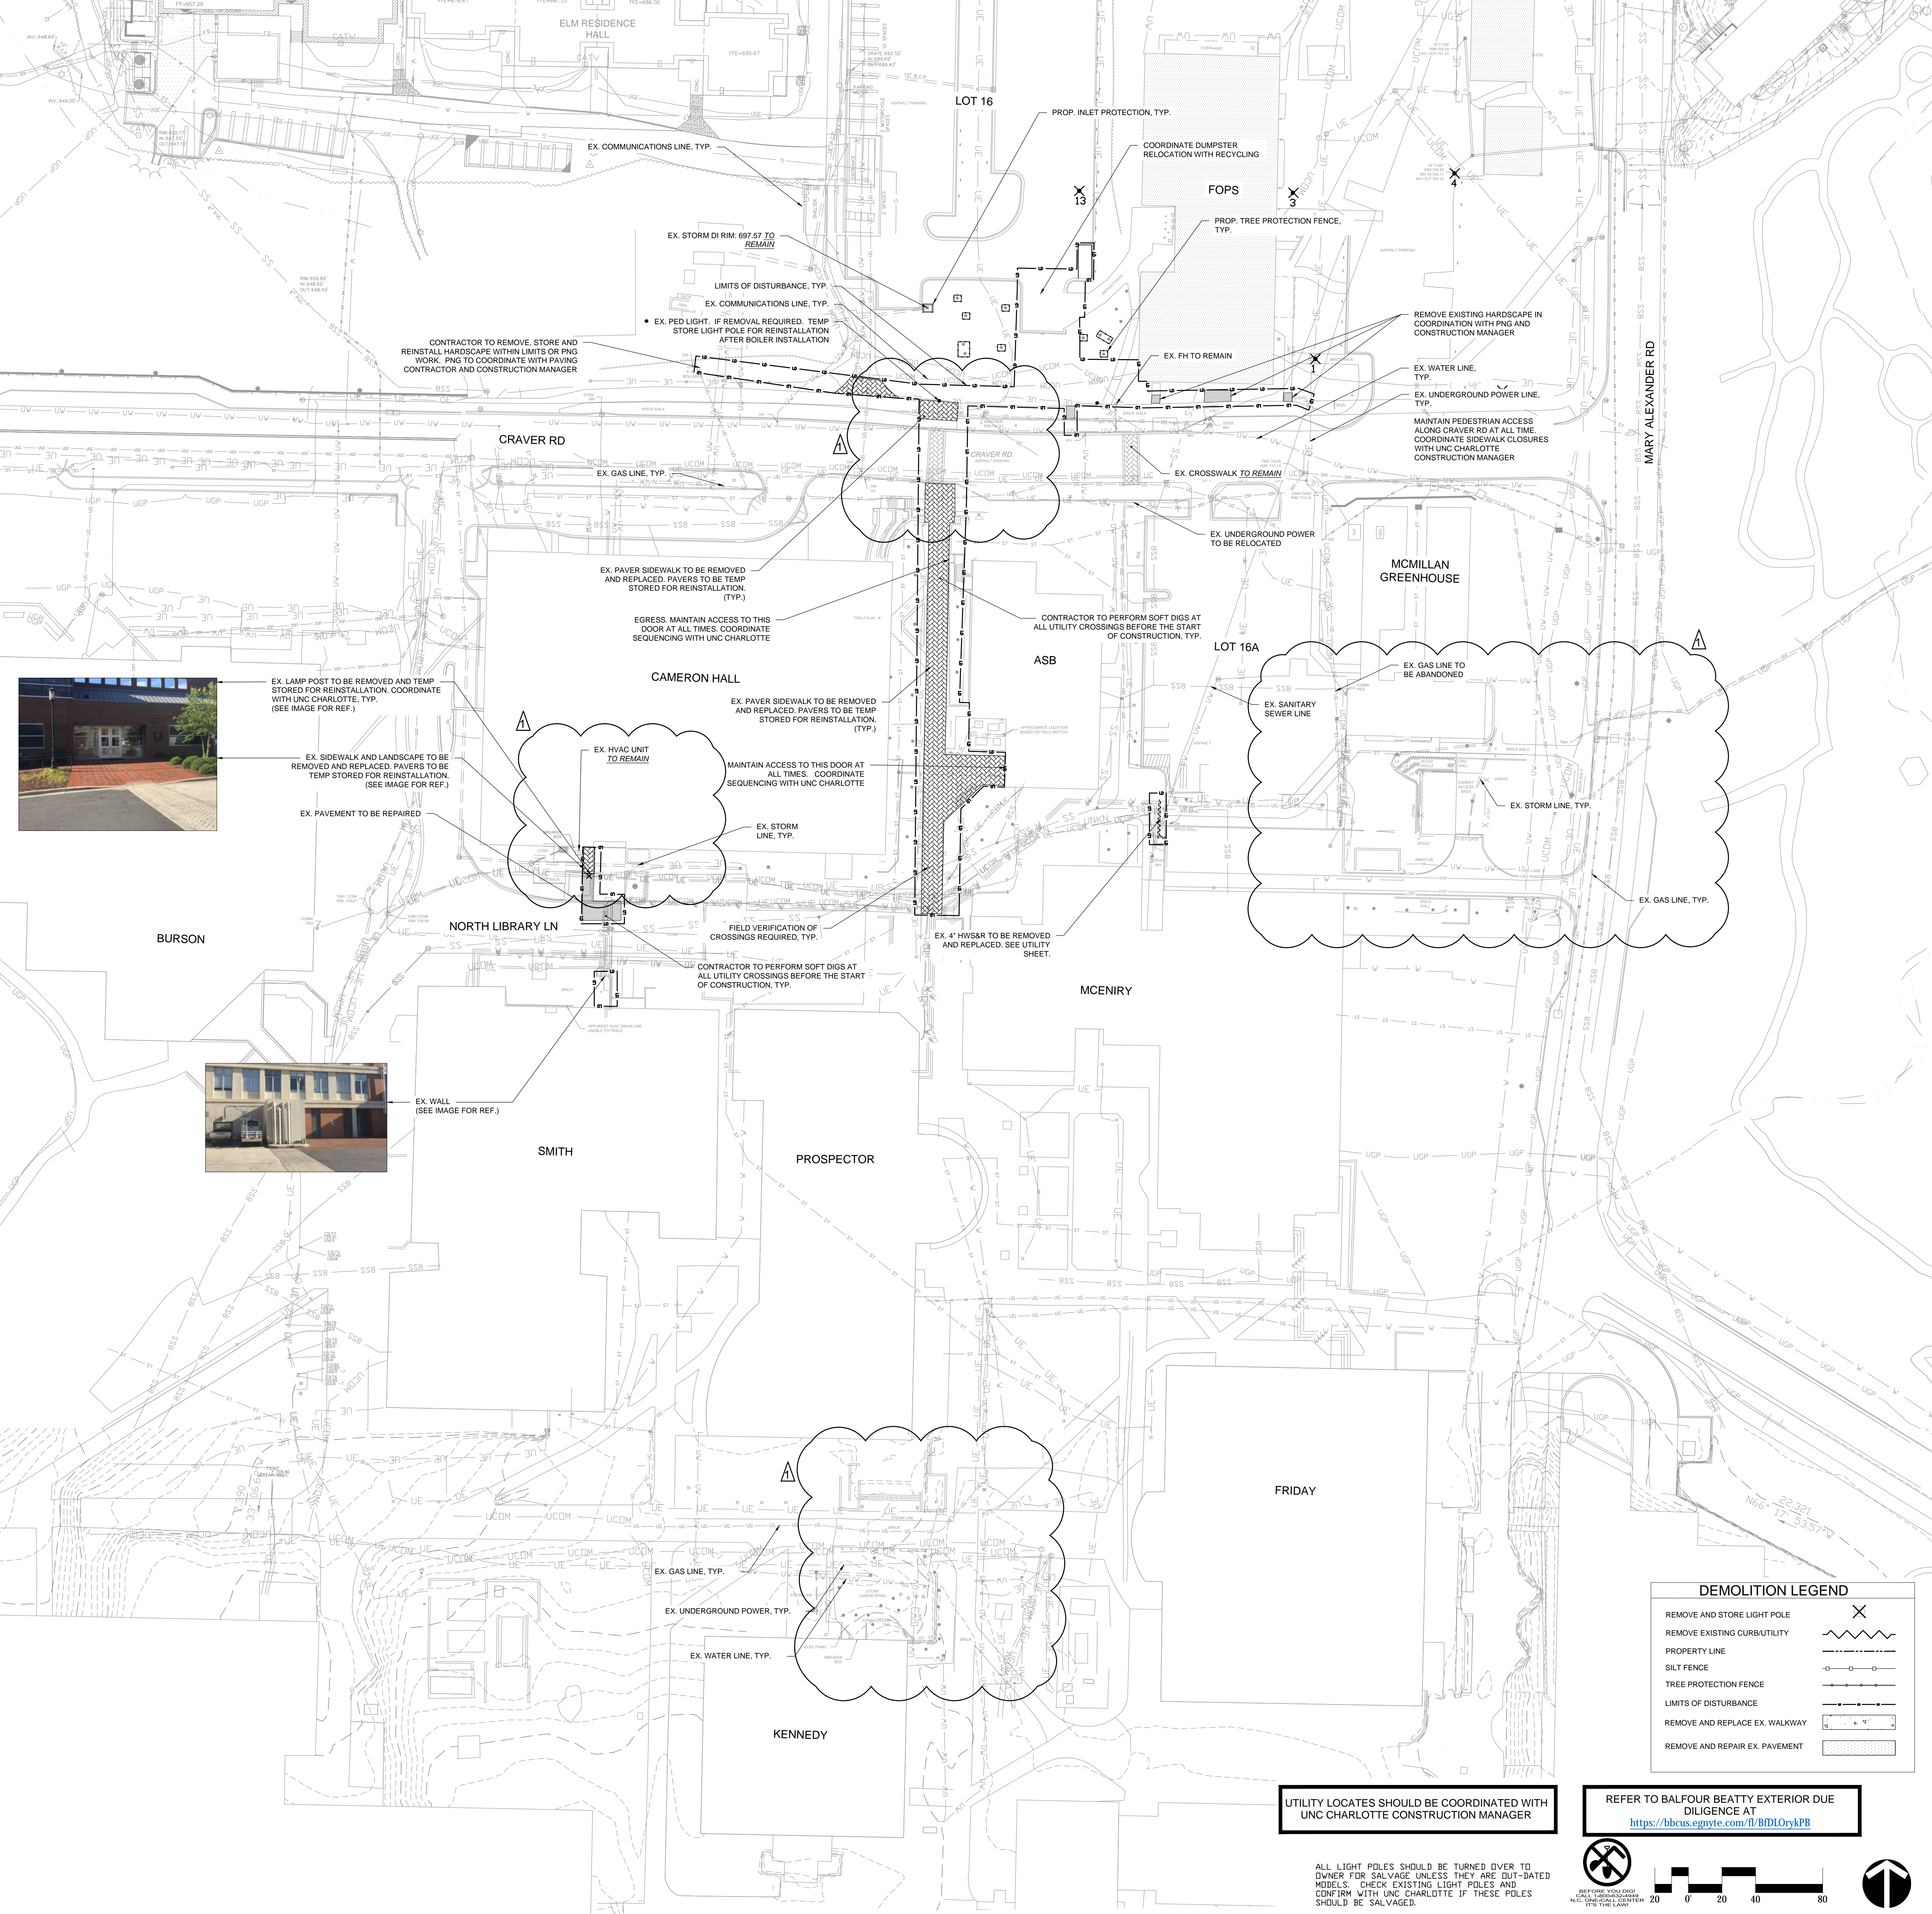


DEMOLITION LEGEND table with symbols for: REMOVE AND STORE LIGHT POLE, REMOVE EXISTING CURB/UTILITY, PROPERTY LINE, SILT FENCE, TREE PROTECTION FENCE, LIMITS OF DISTURBANCE, REMOVE AND REPLACE EX. WALKWAY, REMOVE AND REPAIR EX. PAVEMENT.

UTILITY LOCATES SHOULD BE COORDINATED WITH UNC CHARLOTTE CONSTRUCTION MANAGER

REFER TO BALFOUR BEATTY EXTERIOR DUE DILIGENCE AT https://bbcs.enr.com/4/8/D10rKPB

ALL LIGHT POLES SHOULD BE TURNED OVER TO OWNER FOR SALVAGE UNLESS THEY ARE OUT-DATED MODELS. CHECK EXISTING LIGHT POLES AND CONFIRM WITH UNC CHARLOTTE IF THESE POLES SHOULD BE SALVAGED.

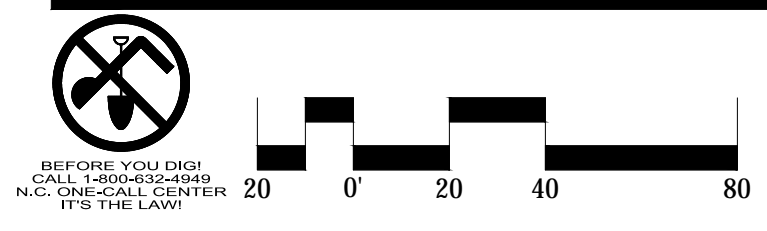

UNC CHARLOTTE Sciences Building - Existing Building Heating Conversions 9201 University City Boulevard Charlotte, NC 28223

SCO ID Number: 16-14355-02B Code: 46626 Item: 301

CLARK NEXSEN 1523 Elizabeth Avenue, Suite 300 Charlotte, NC 28204 704.377.8800

LandDesign 223 N Graham Street Charlotte, NC 28202 V: 704.333.0325 F: 704.332.3246 www.LandDesign.com

SEALS: LAND DESIGN, INC. (Seal of Max Hays, Nov 20 2017 5:12 PM) and NORTH CAROLINA PROFESSIONAL ENGINEERS (Seal of Marc D. Mowbray, 033804)


NC Corporate Engineering License #: C-0658 SUBMITTAL 05 November 2017 Bid Documents

REVISIONS table with columns for revision number, date, and description.

DEMOLITION AND EROSION CONTROL PLAN


C-100 DESIGN: MCM DRAWN: GR REVIEW: MCM CN 6222



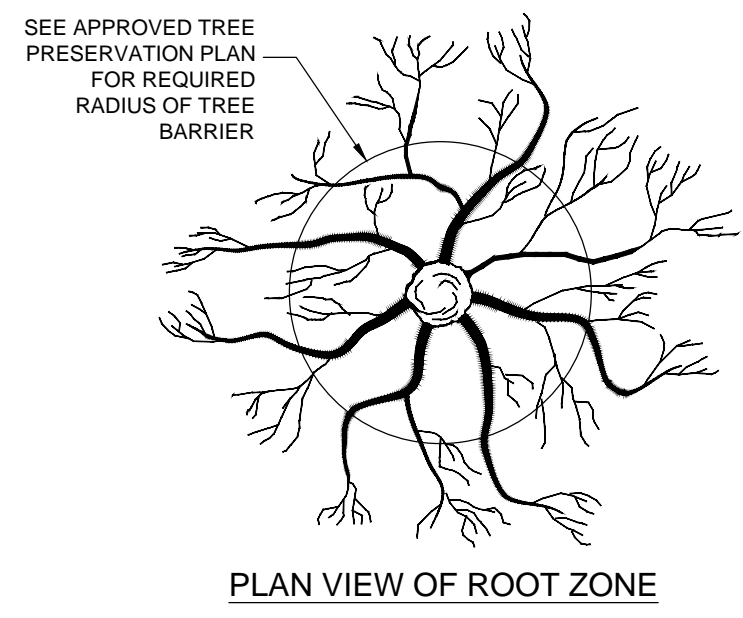

PLAN VIEW OF ROOT ZONE

- NOTES:**
1. REMOVE ALL BARRIERS UPON COMPLETION OF PROJECT.
  2. LANDSCAPING PLANS SHALL SHOW THE LOCATIONS OF ALL TREE PROTECTION FENCES.

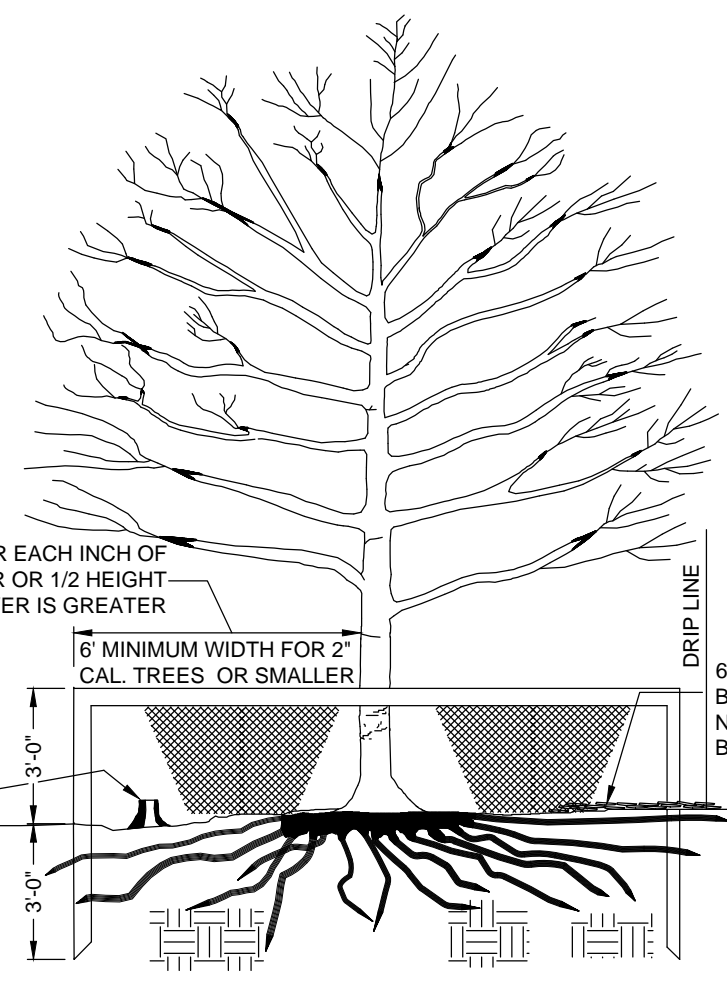


FOR PRUNING SEE INTERNATIONAL SOCIETY OF ARBORICULTURE SPECS.

DEAD TREES AND SCRUB OR UNDER GROWTH SHALL BE CUT FLUSH WITH ADJACENT GRADE. NO GRUBBING ALLOWED UNDER DRIP LINE.

2" MIN. STANDARDS + 1" MIN. RAILS OR ORANGE SAFETY FENCING MAY BE USED.

**TREE PROTECTION DETAIL**  
PLAN AND SECTION

NOT TO SCALE

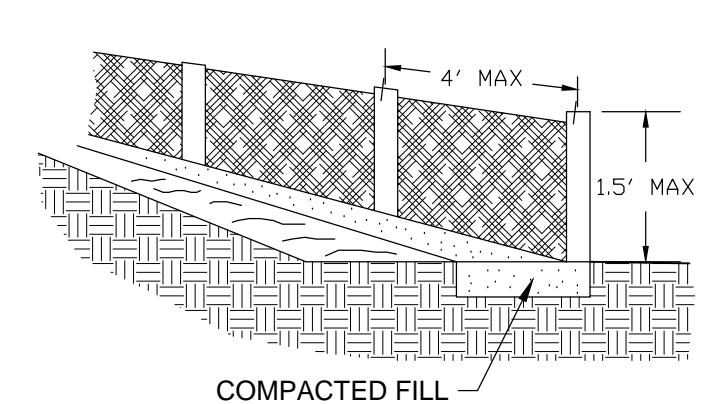

MAXIMUM SLOPE LENGTH AND SLOPE FOR WHICH SEDIMENT FENCE IS APPLICABLE



SLOPE	SLOPE LENGTH (FT)
<2%	100
2 TO 5%	75
5 TO 10%	50
10 TO 20%	25
>20%	15

SPECIFICATIONS FOR SEDIMENT FENCE FABRIC

PHYSICAL PROPERTY	REQUIREMENTS
FILTERING EFFICIENCY	85% (MIN.)
TENSILE STRENGTH AT 20% (MAX.) ELONGATION	STANDARD STRENGTH: 30 LB./LIN. INCH (MIN.) EXTRA STRENGTH: 50 LB./LIN. IN (MIN.)
SLURRY FLOW RATE	0.3 GAL/SQ. FT/MIN (MIN.)


**SILT FENCE**

NOT TO SCALE

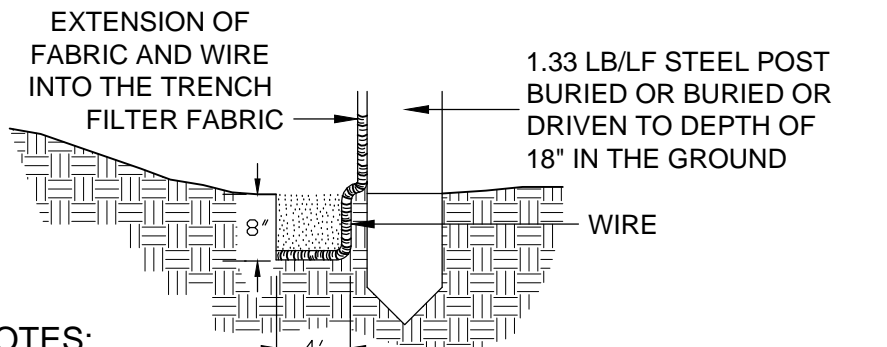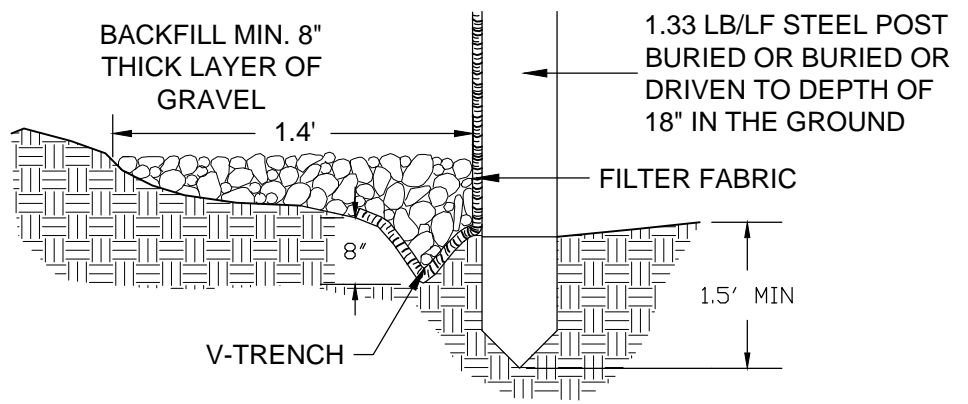

**GENERAL NOTES:**

1. DRAINAGE AREA SHALL BE LESS THAN 1/4 ACRE PER 100 FEET OF FENCE.
2. DEPTH OF WATER BEHIND FENCE SHALL NOT EXCEED 1.5 FEET.
3. FOR REINFORCEMENT OF FABRIC, USE 1/4 GAUGE MESH WITH 6\"/>

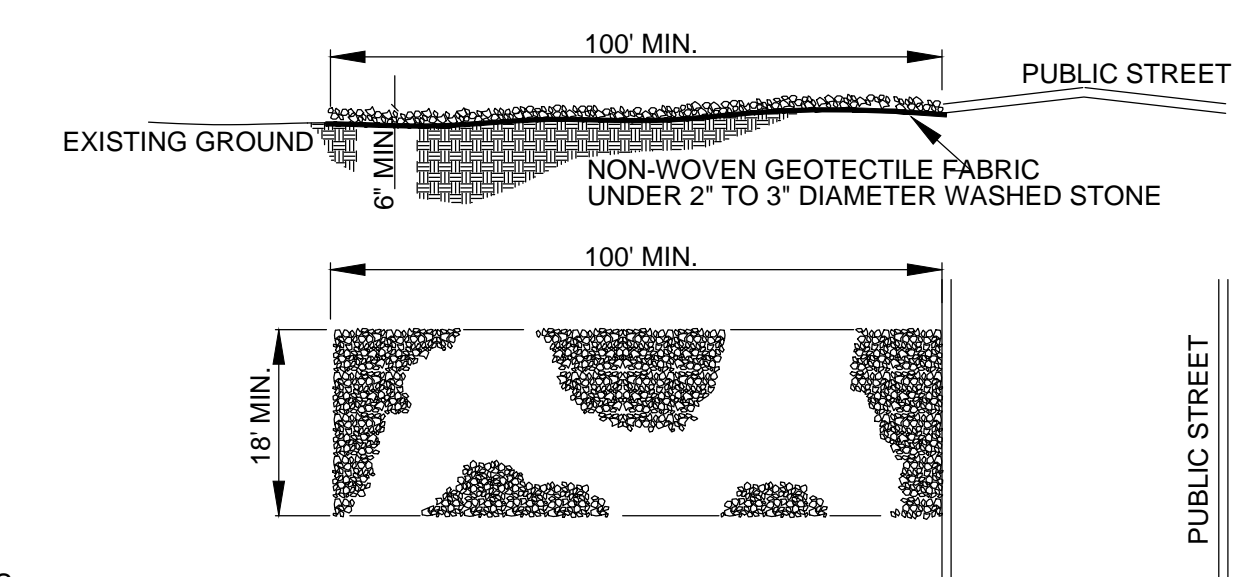


**NOTES:**

1. A STABILIZED ENTRANCE PAD OF 2\"/>

**STABILIZED CONSTRUCTION ENTRANCE**

NOT TO SCALE

1. UNIFORMLY GRADE A SHALLOW DEPRESSION APPROACHING THE INLET.
2. DRIVE 5-FOOT STEEL POSTS 2 FEET INTO THE GROUND SURROUNDING THE INLET. SPACE POSTS EVENLY AROUND THE PERIMETER OF THE INLET, A MAXIMUM OF 4 FEET APART.
3. SURROUND THE POSTS WITH WIRE MESH HARDWARE CLOTH. SECURE THE WIRE MESH TO THE STEEL POSTS AT THE TOP, MIDDLE, AND BOTTOM. PLACING A 2-FOOT FLAP OF THE WIRE MESH UNDER THE GRAVEL FOR ANCHORING IS RECOMMENDED.
4. PLACE CLEAN GRAVEL (NC DOT #5 OR #57 STONE) ON A 3:1 SLOPE WITH A HEIGHT OF 16 INCHES AROUND THE WIRE, AND SMOOTH TO AN EVEN GRADE.
5. ONCE THE CONTRIBUTING DRAINAGE AREA HAS BEEN STABILIZED, REMOVE ACCUMULATED SEDIMENT, AND ESTABLISH FINAL GRADING ELEVATIONS.
6. COMPACT THE AREA PROPERLY AND STABILIZED IT WITH GROUND COVER.

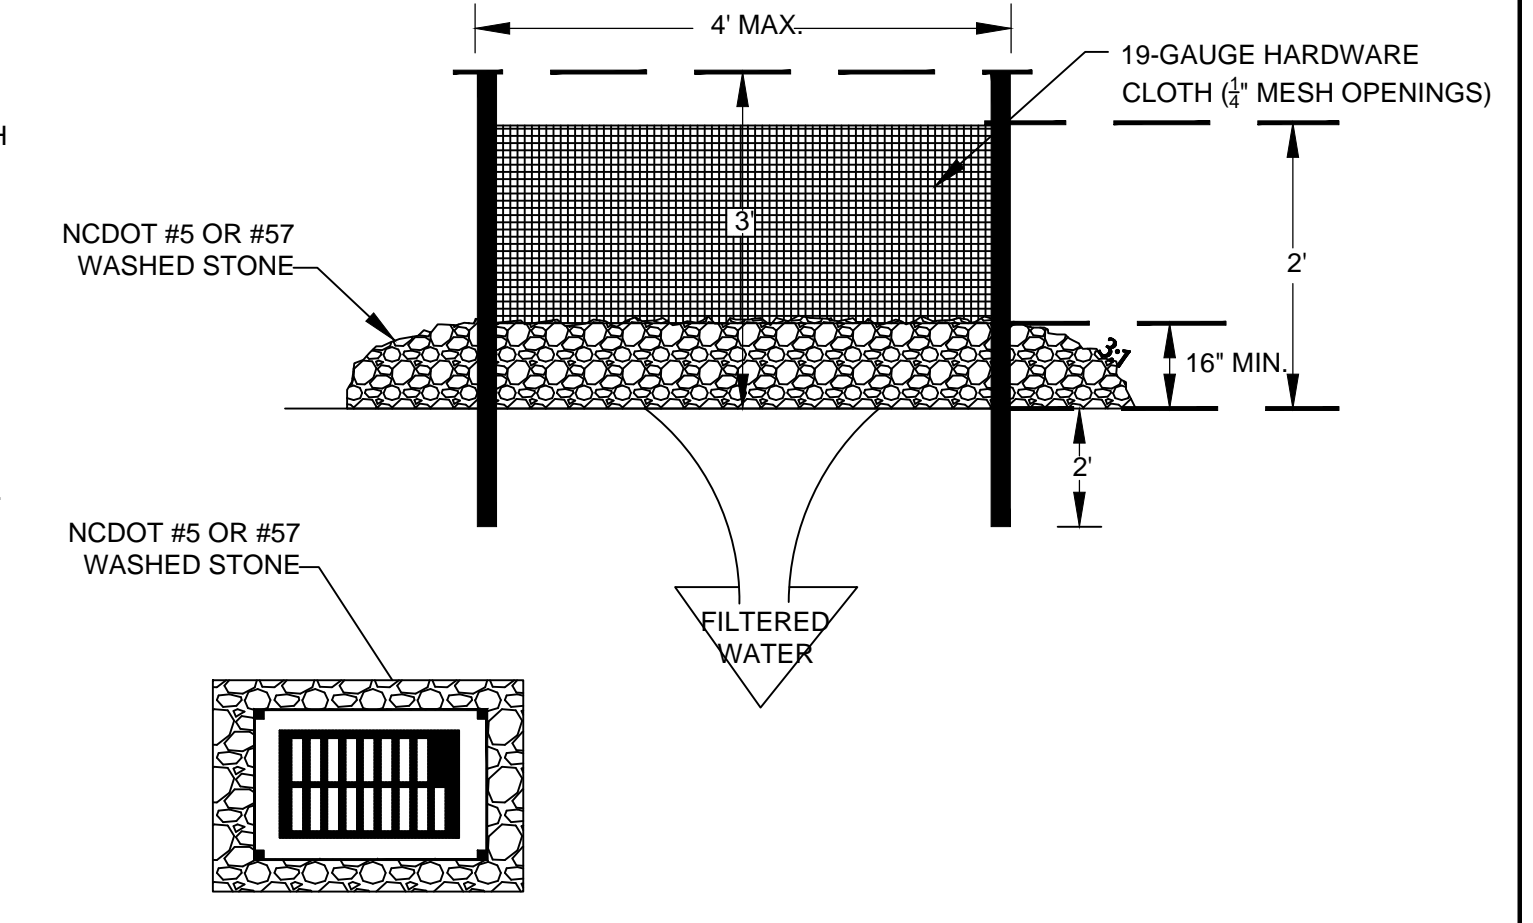

**HARDWARE CLOTH AND GRAVEL INLET PROTECTION**

NOT TO SCALE



**Sciences Building - Existing Building Heating Conversions**


9201 University City Boulevard  
Charlotte, NC 28223

SCO ID Number: 16-14355-02B  
Code: 46626  
Item: 301

DESIGNER  
**CLARK NEXSEN**  
1523 Elizabeth Avenue, Suite 300  
Charlotte, NC 28204  
704.377.8800

**LandDesign**  
223 N Graham Street Charlotte, NC 28202  
V: 704.333.0325 F: 704.332.3246  
www.LandDesign.com

CONSULTANT

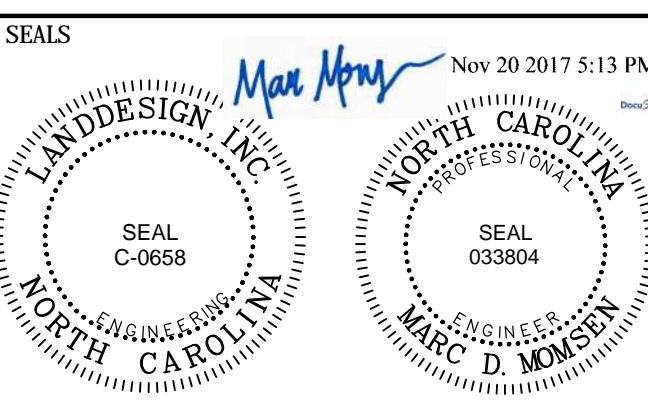

NC Corporate Engineering License # C-0658

SUBMITTAL  
05 November 2017

**Bid Documents**


REVISIONS


SHEET  
**EROSION CONTROL DETAILS**  
**C-101**


DESIGNER: MCM  
DRAWN: GR  
REVIEW: MCM  
CN 6222

N:\2016\10\16\63\CAD\Construction Documents\16-14355-DTL-EC.dwg Men, 20 Nov 2017 - 4:39pm Guan



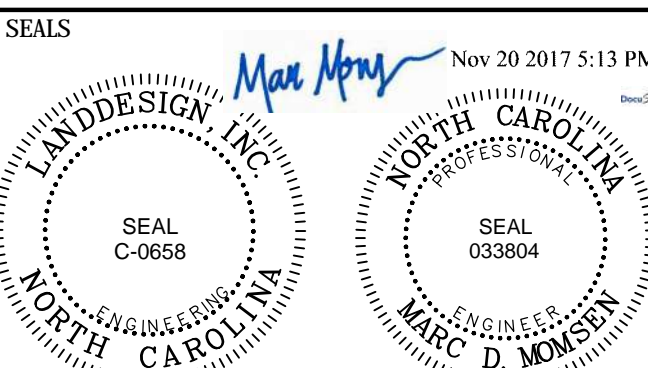

NO.	DATE	DESCRIPTION
1	11/20/2017	ADDENDUM #1

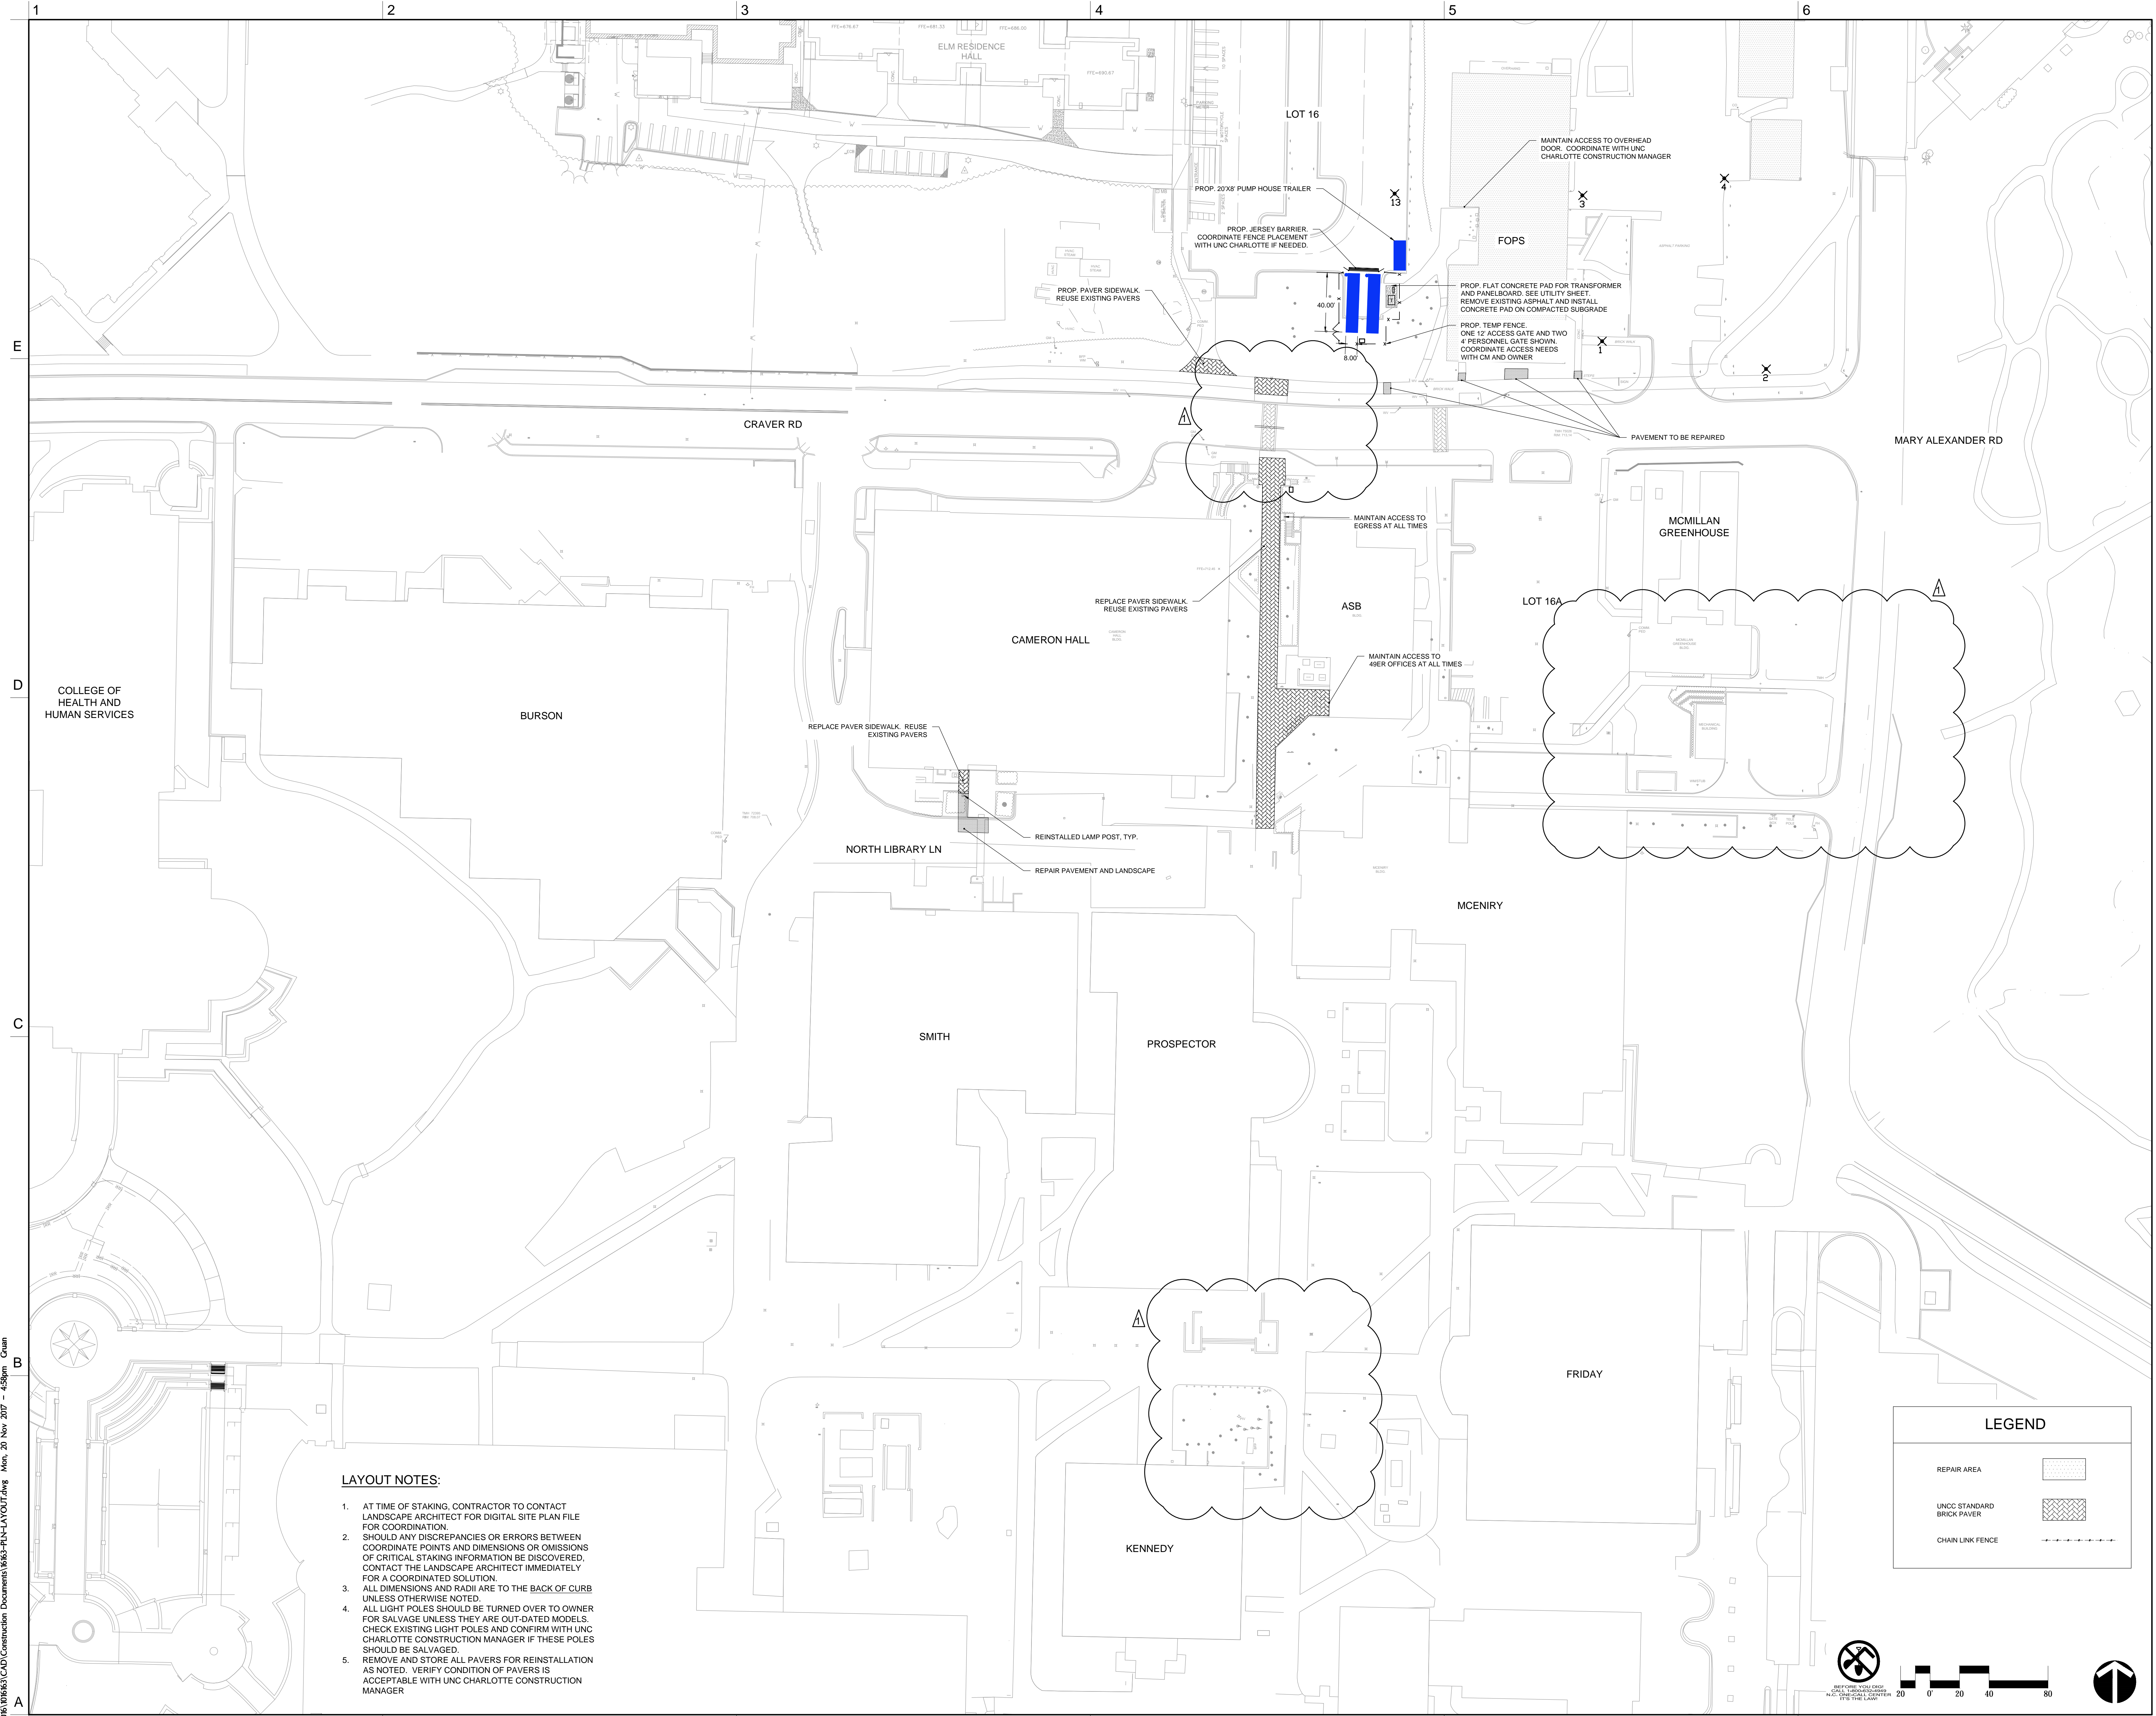


**LAYOUT NOTES:**

1. AT TIME OF STAKING, CONTRACTOR TO CONTACT LANDSCAPE ARCHITECT FOR DIGITAL SITE PLAN FILE FOR COORDINATION.
2. SHOULD ANY DISCREPANCIES OR ERRORS BETWEEN COORDINATE POINTS AND DIMENSIONS OR OMISSIONS OF CRITICAL STAKING INFORMATION BE DISCOVERED, CONTACT THE LANDSCAPE ARCHITECT IMMEDIATELY FOR A COORDINATED SOLUTION.
3. ALL DIMENSIONS AND RADII ARE TO THE BACK OF CURB UNLESS OTHERWISE NOTED.
4. ALL LIGHT POLES SHOULD BE TURNED OVER TO OWNER FOR SALVAGE UNLESS THEY ARE OUT-DATED MODELS. CHECK EXISTING LIGHT POLES AND CONFIRM WITH UNC CHARLOTTE CONSTRUCTION MANAGER IF THESE POLES SHOULD BE SALVAGED.
5. REMOVE AND STORE ALL PAVERS FOR REINSTALLATION AS NOTED. VERIFY CONDITION OF PAVERS IS ACCEPTABLE WITH UNC CHARLOTTE CONSTRUCTION MANAGER.


**LEGEND**

- REPAIR AREA
- UNCC STANDARD BRICK PAVEMENT
- CHAIN LINK FENCE

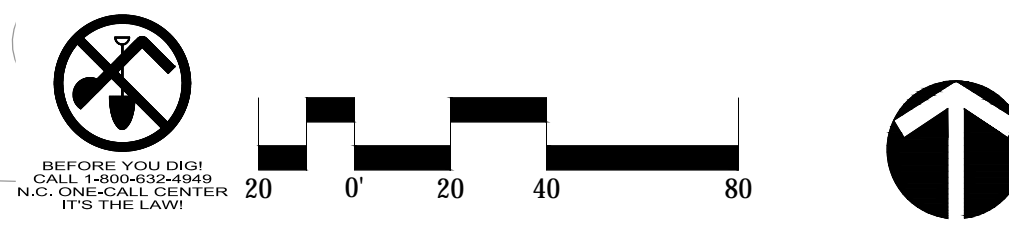


N:\2016\10\16\63\CAD\Construction Documents\63-3-PIN-LAYOUT.dwg Mon, 20 Nov 2017 - 4:58pm Grant




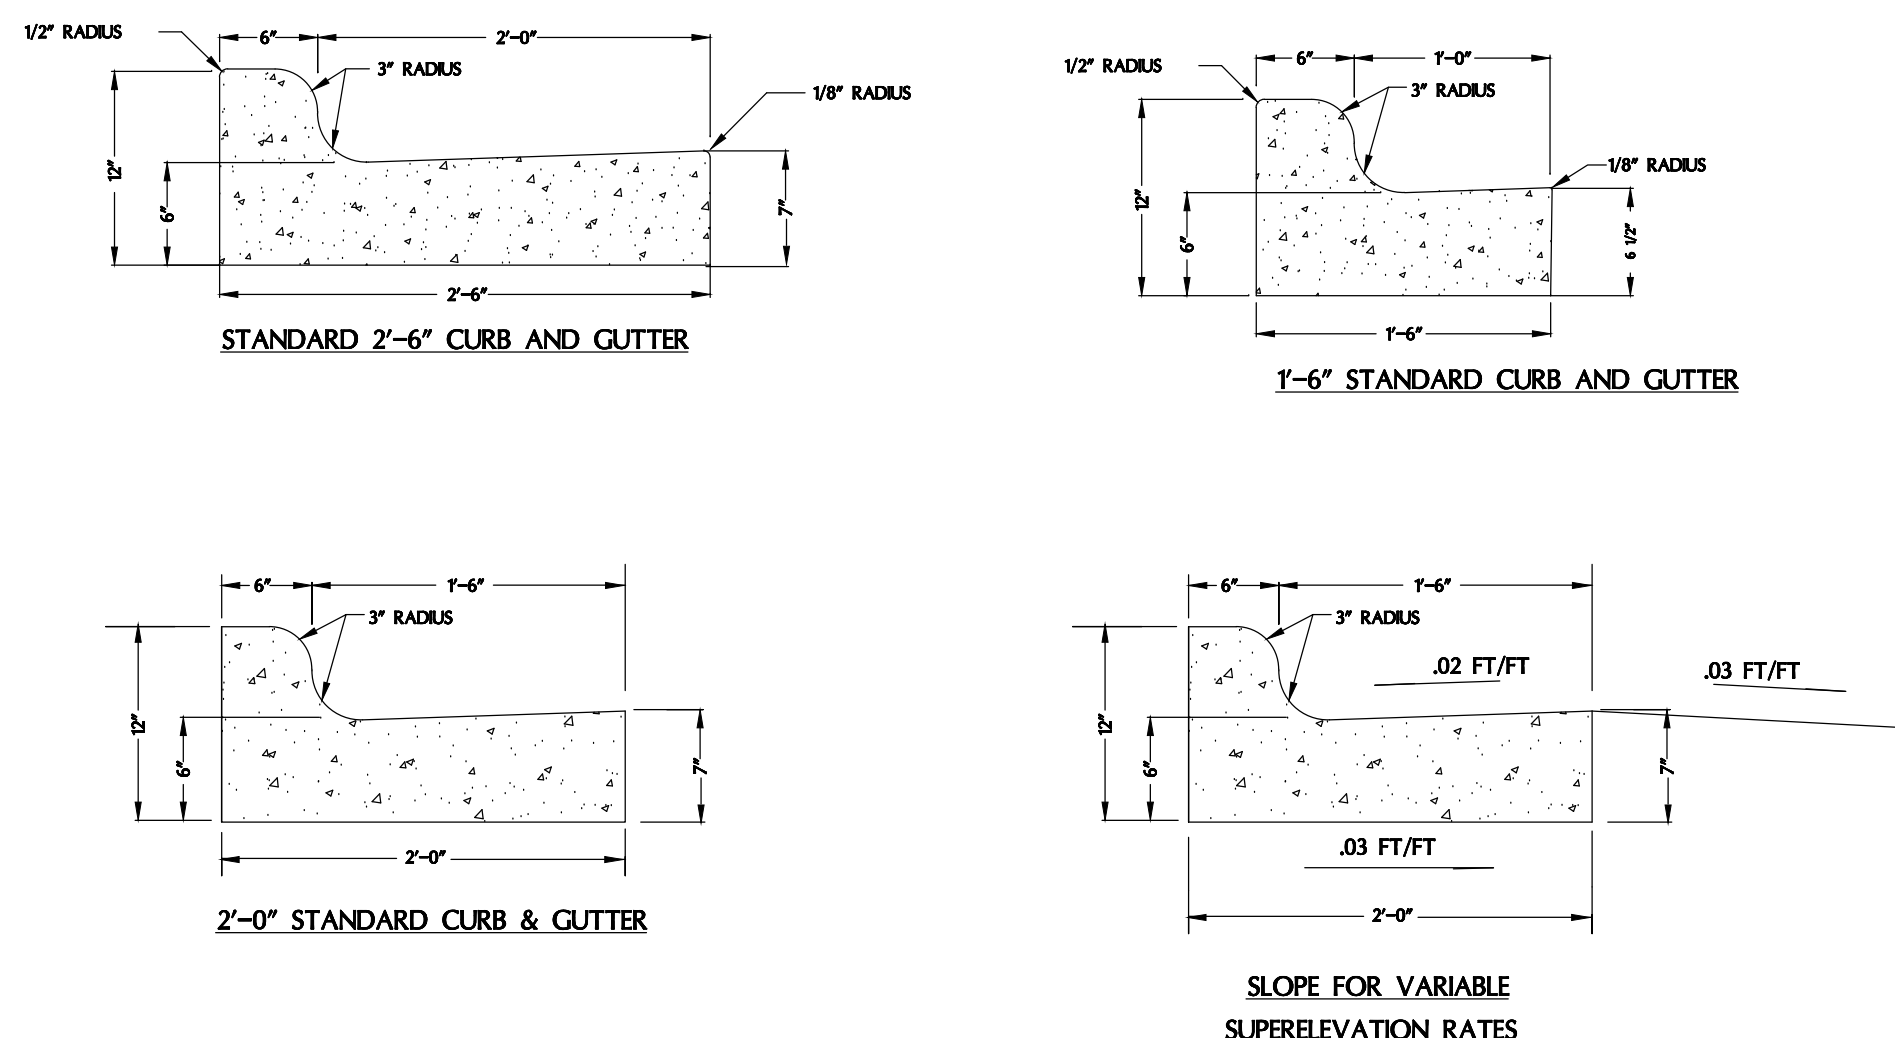


**STANDARD CURB AND GUTTER**  
SECTION NOT TO SCALE

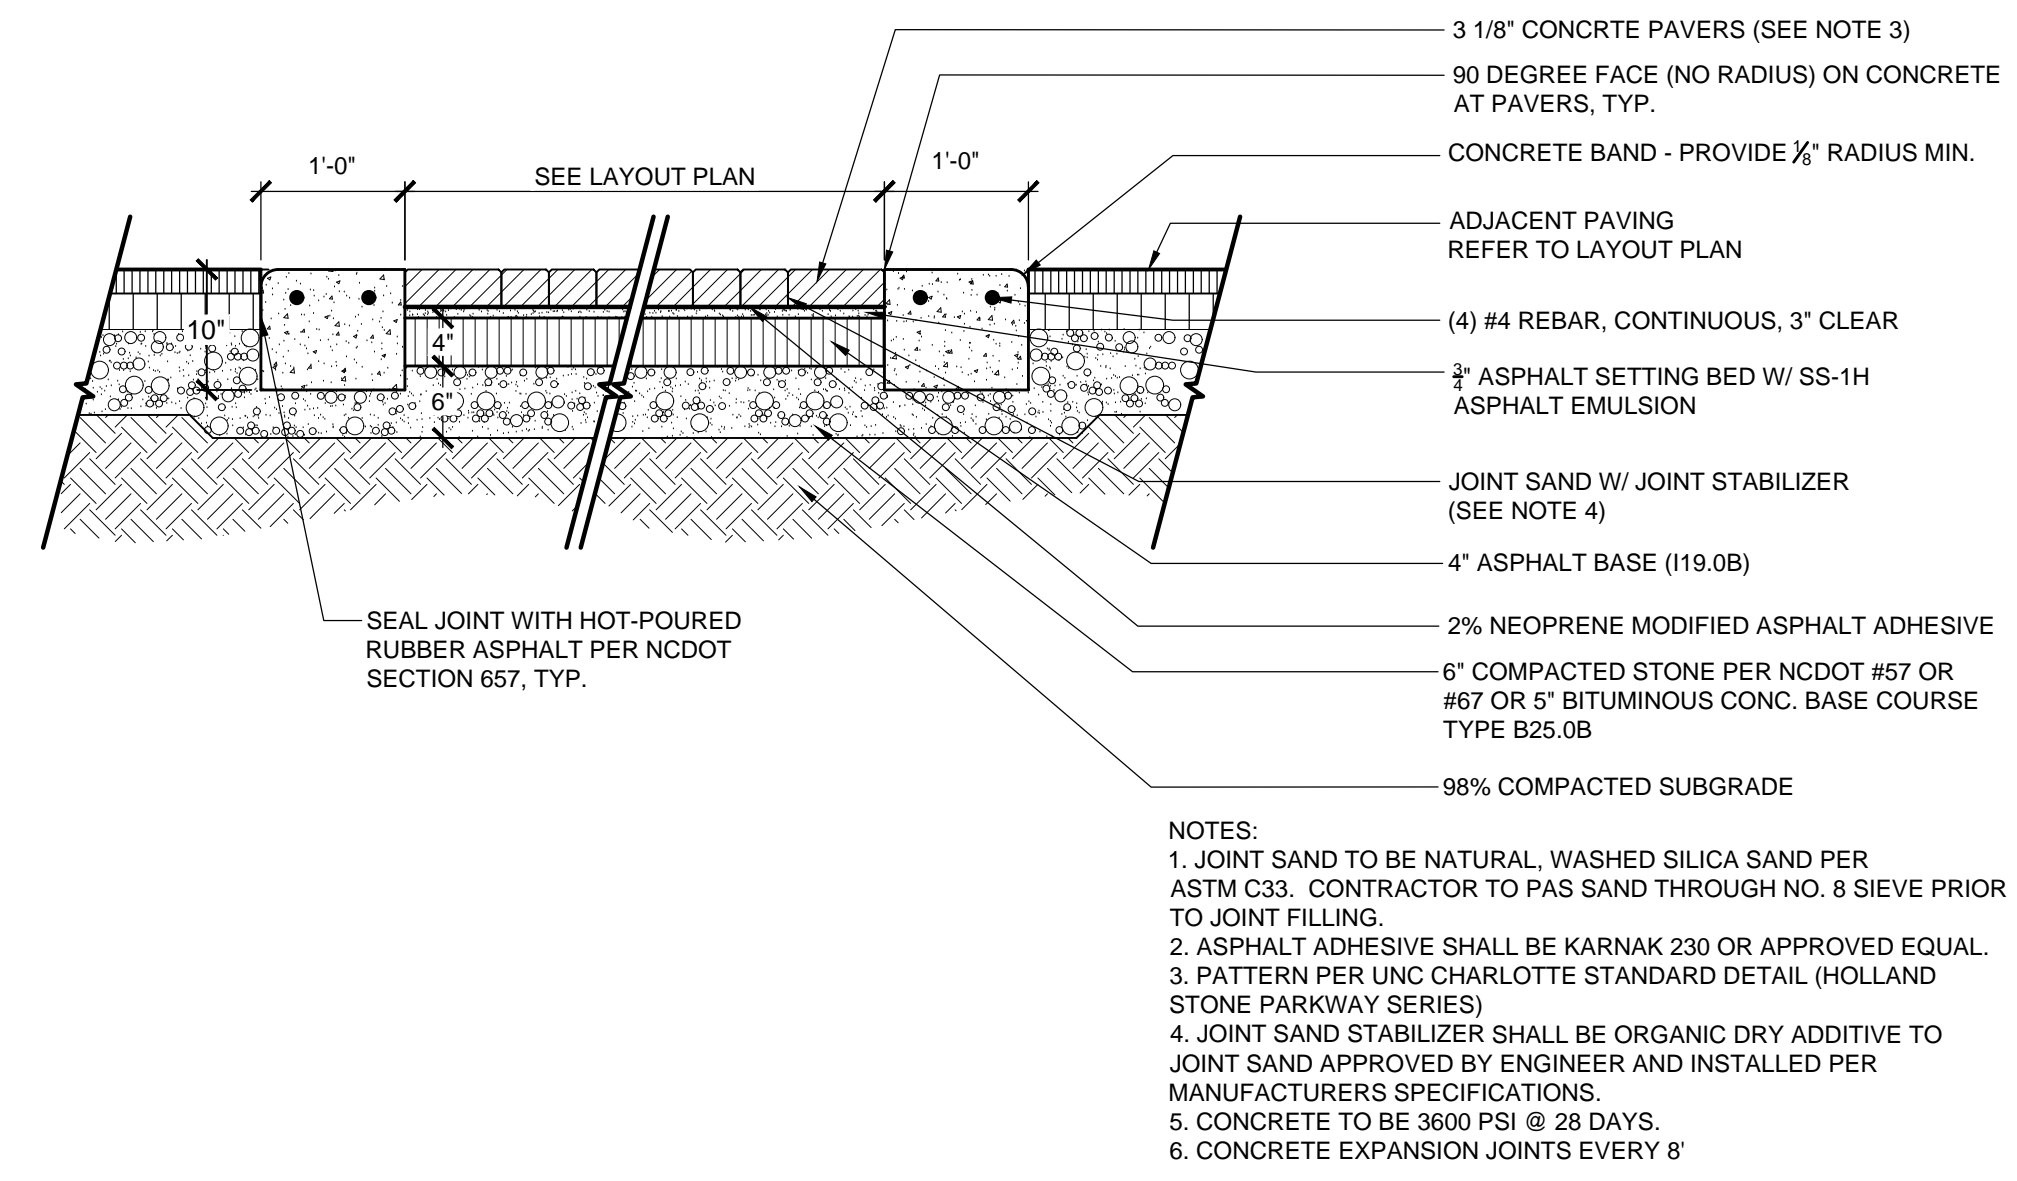


**PAVER CROSSWALK**  
SECTION NOT TO SCALE

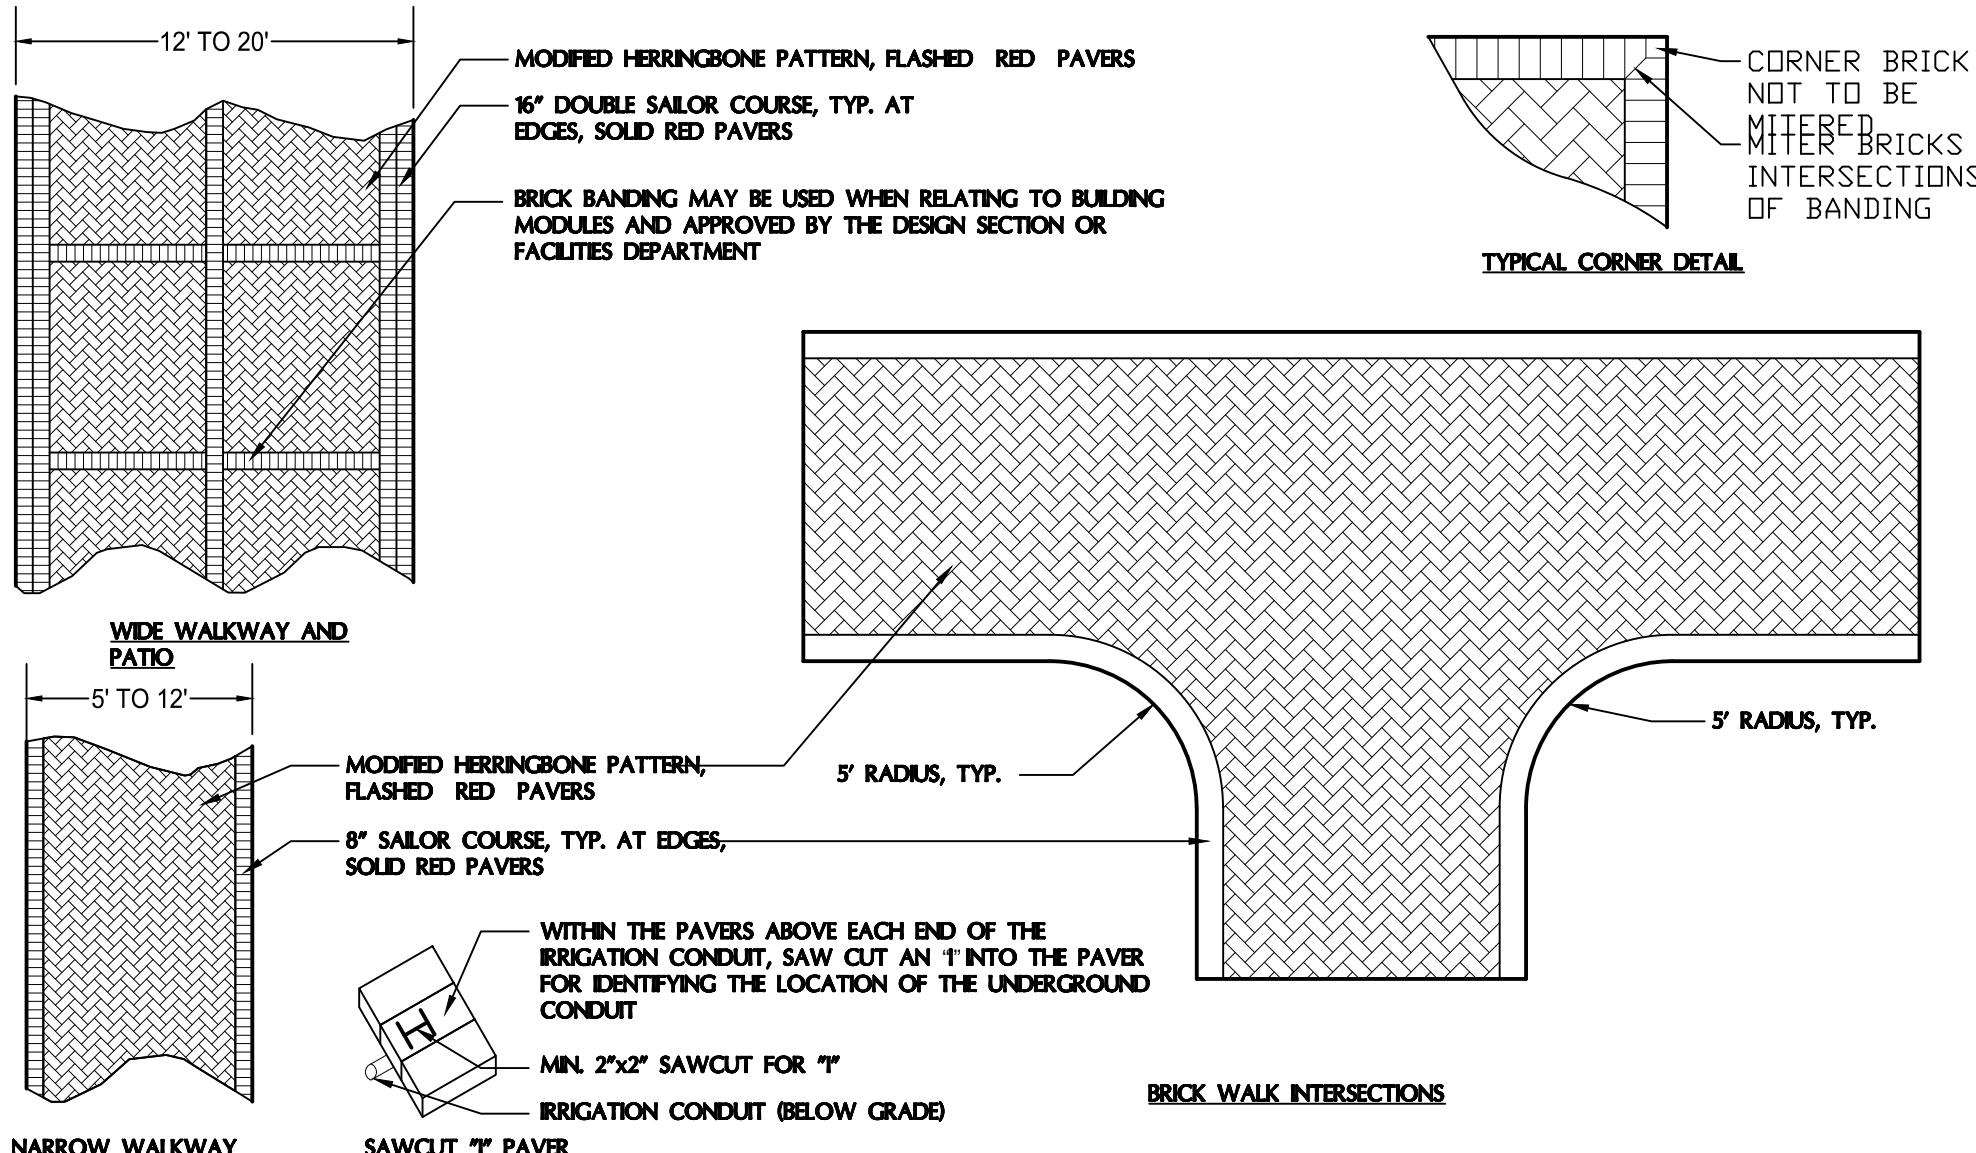


**BRICK WALKWAY PATTERNS**  
PLAN NOT TO SCALE

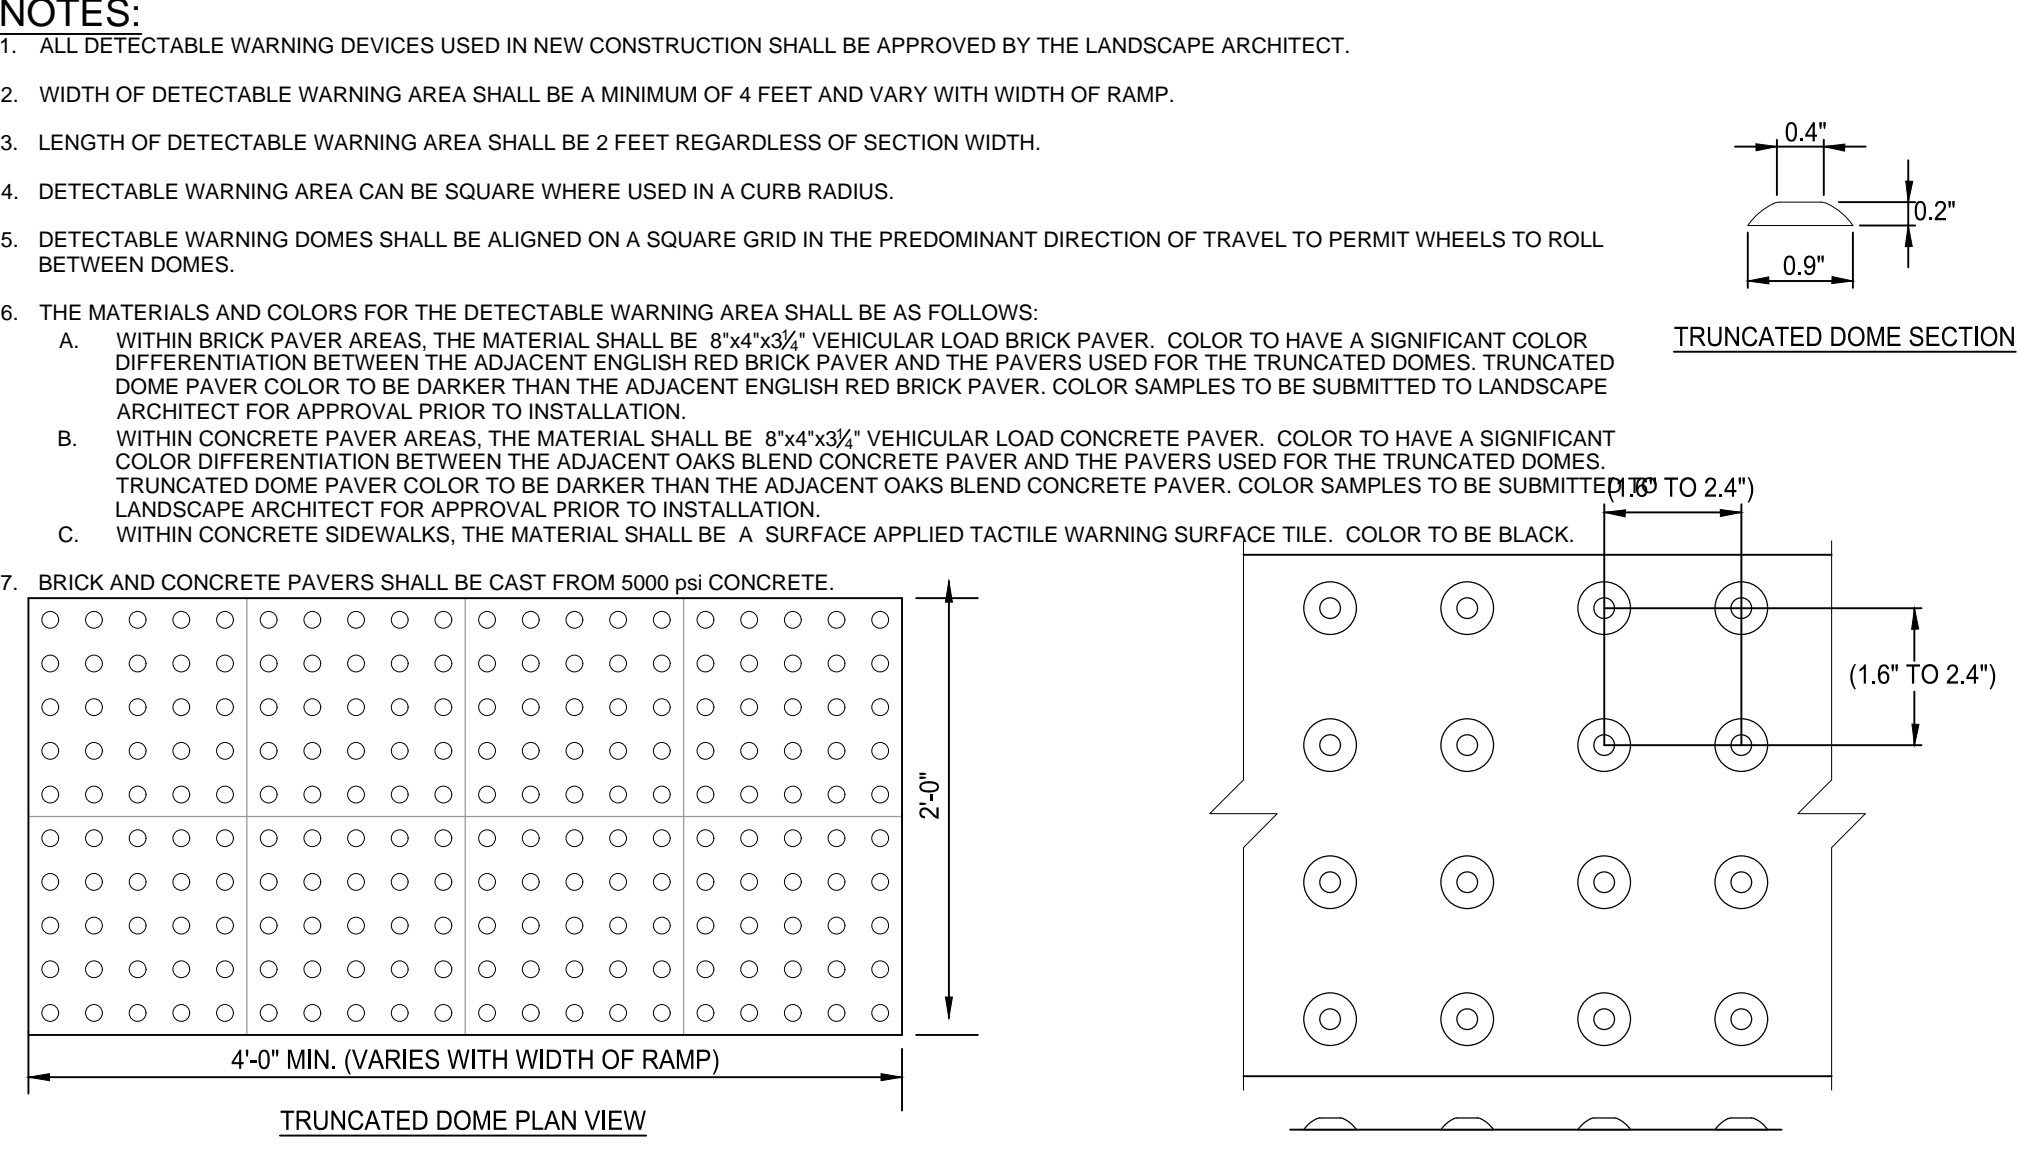


**ACCESSIBLE RAMP - TRUNCATED DOMES**  
PLAN AND SECTION NOT TO SCALE

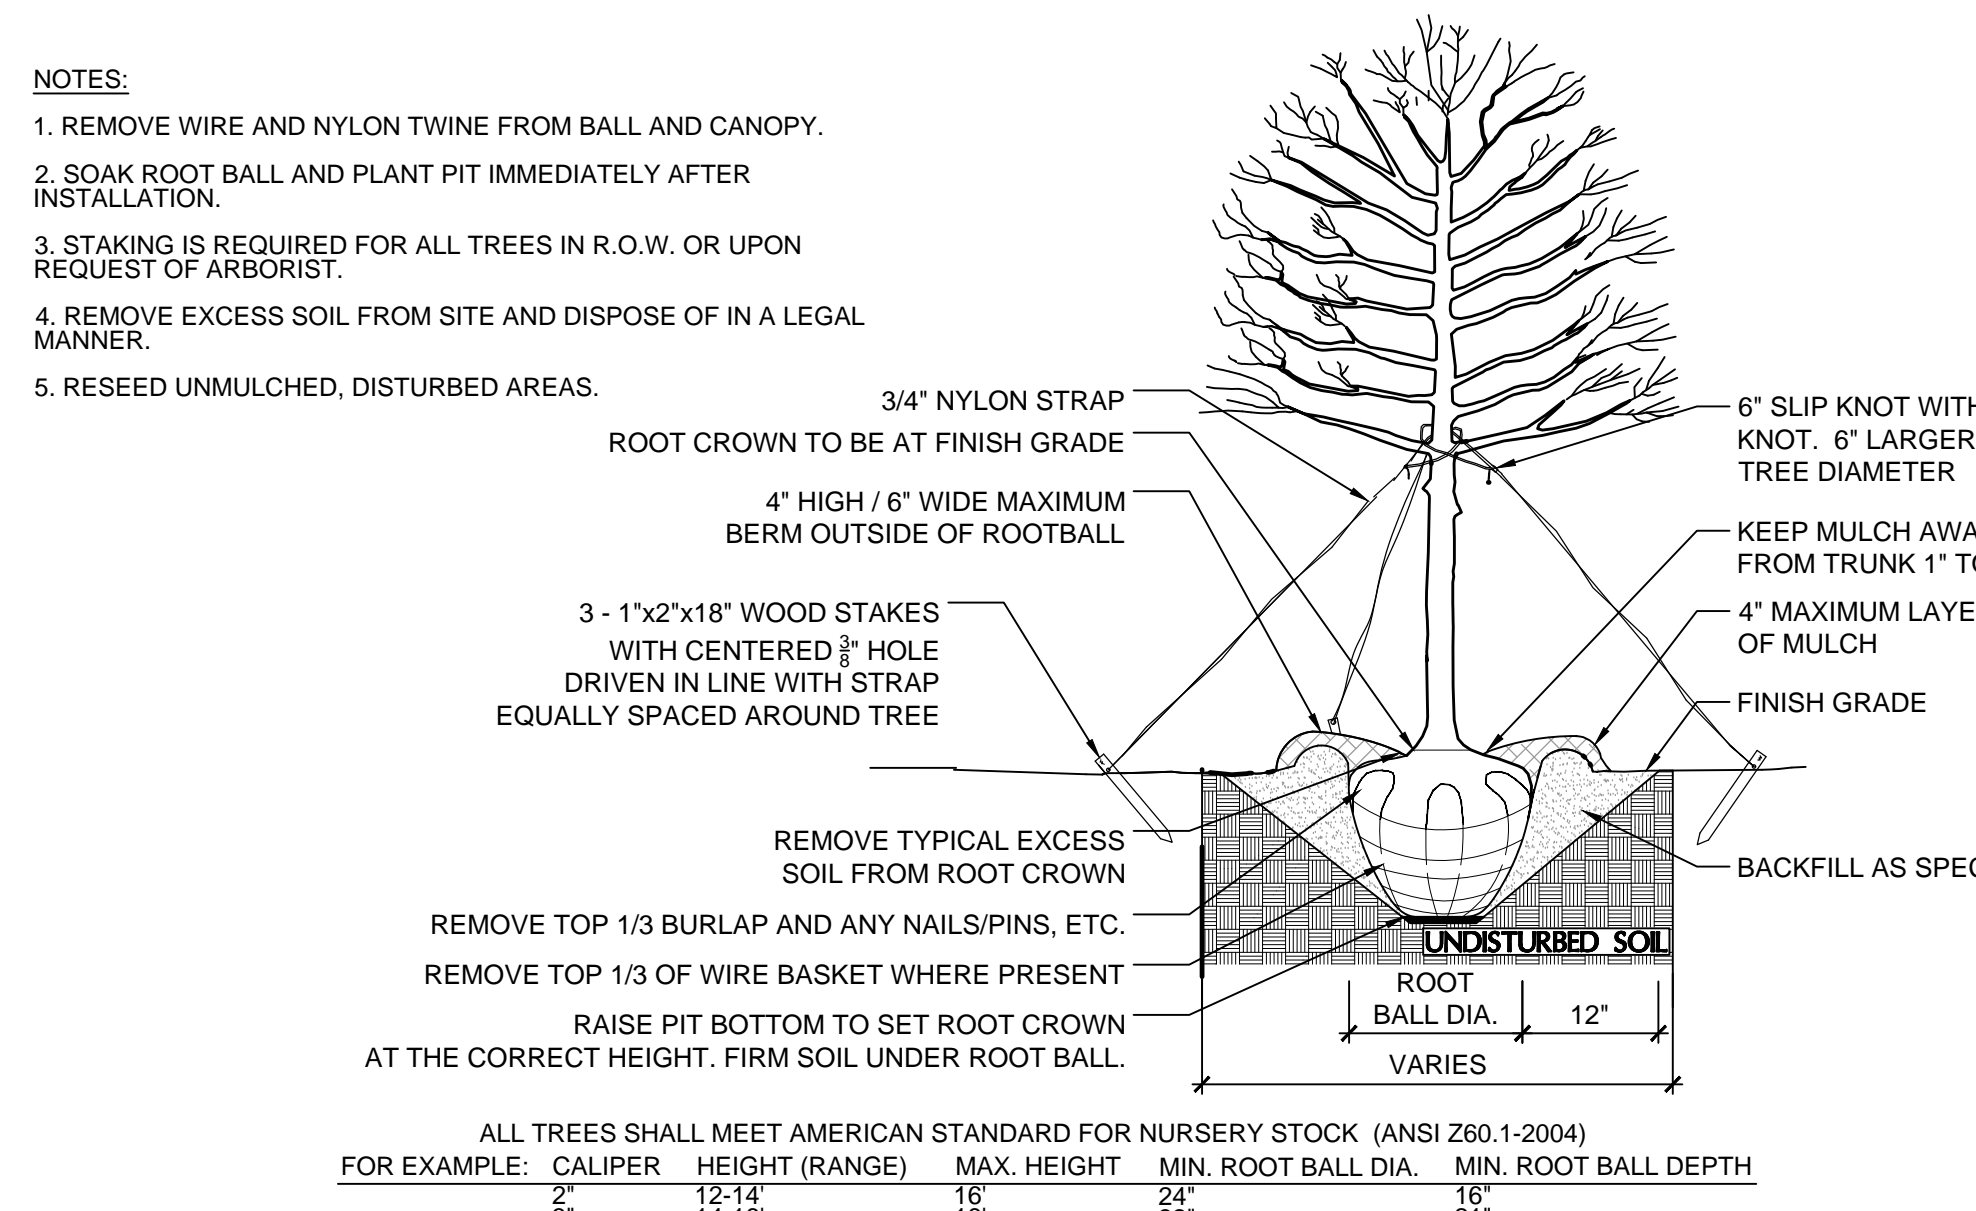

**TREE PLANTING**  
FOR SINGLE AND MULTI-STEM TREES NOT TO SCALE

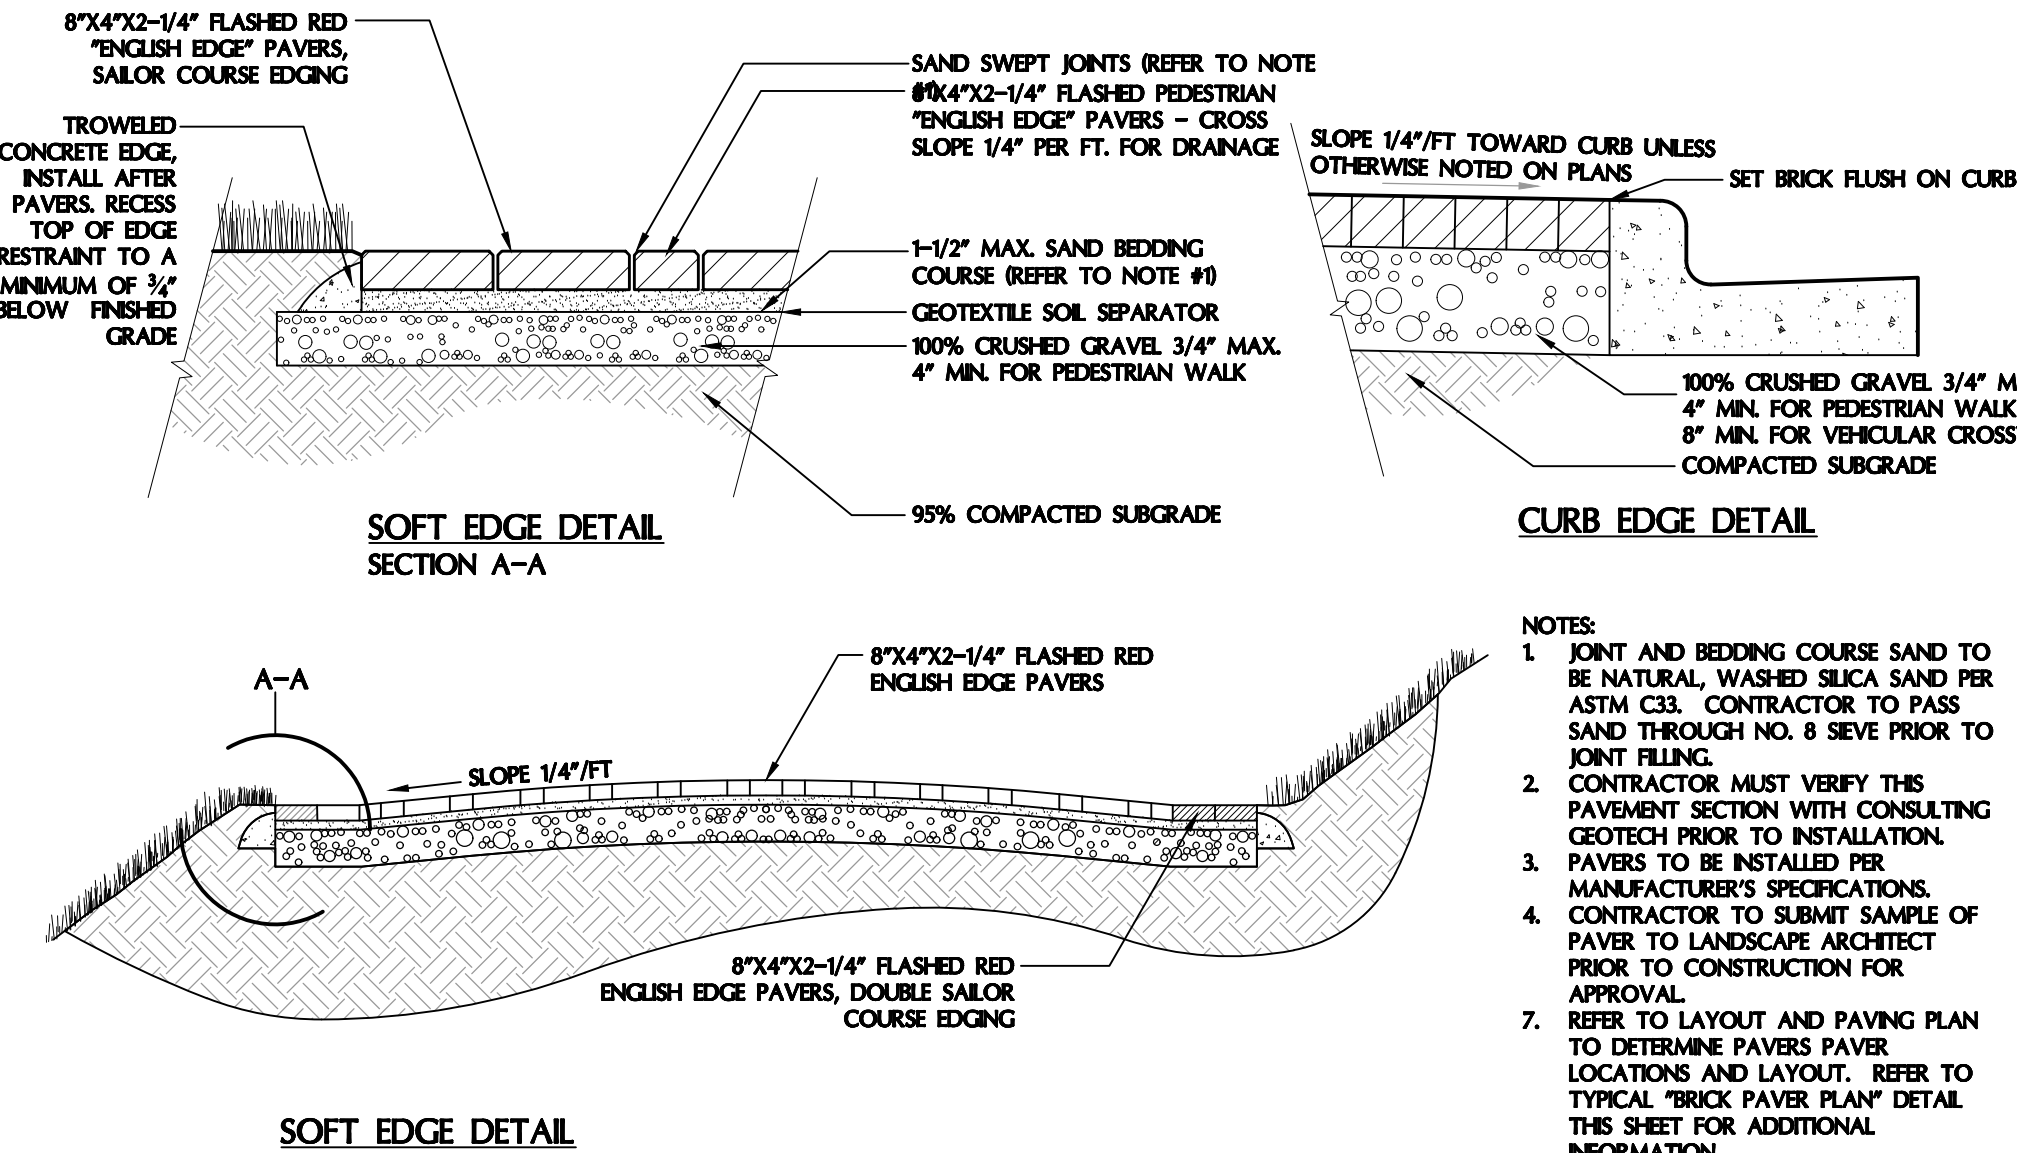

**BRICK PAVER**  
SECTION NOT TO SCALE

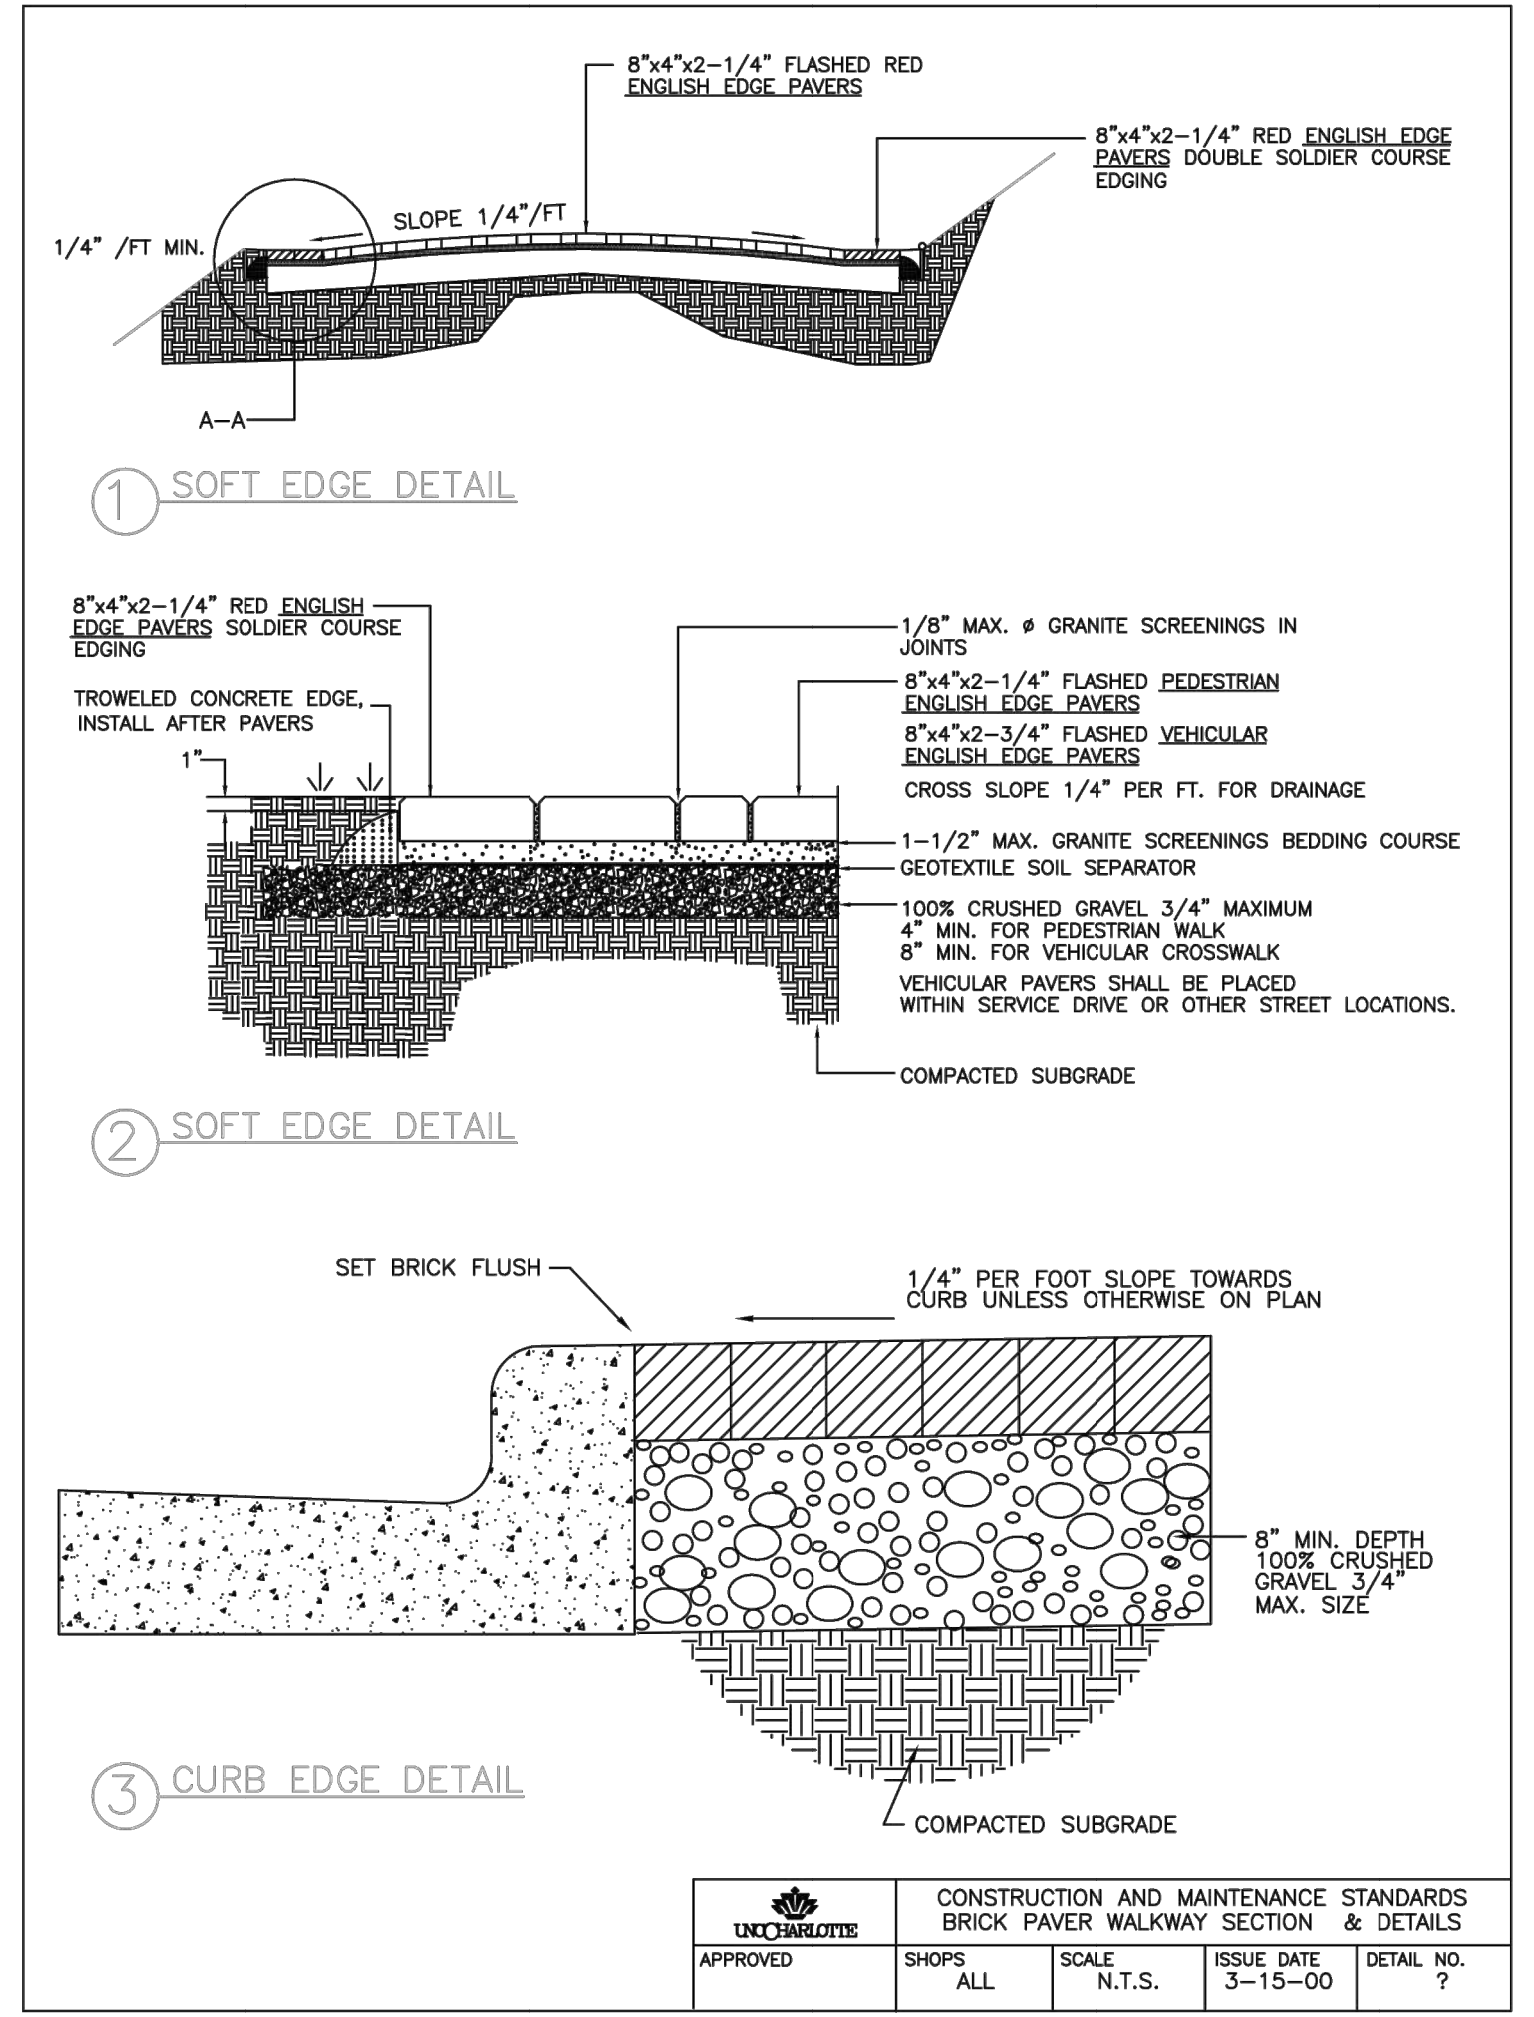


**BRICK PAVER SIDEWALK**  
NOT TO SCALE

REVISIONS


NO.	DESCRIPTION	DATE

N:\2016\10\16\63\CAD\Construction Documents\63-DTL-SITE.dwg Mon, 20 Nov 2017 4:56pm Crain



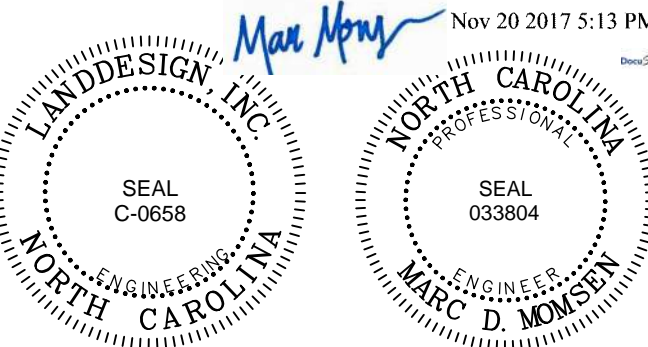

NO.	DATE	DESCRIPTION
1	11/20/2017	ADDENDUM #1

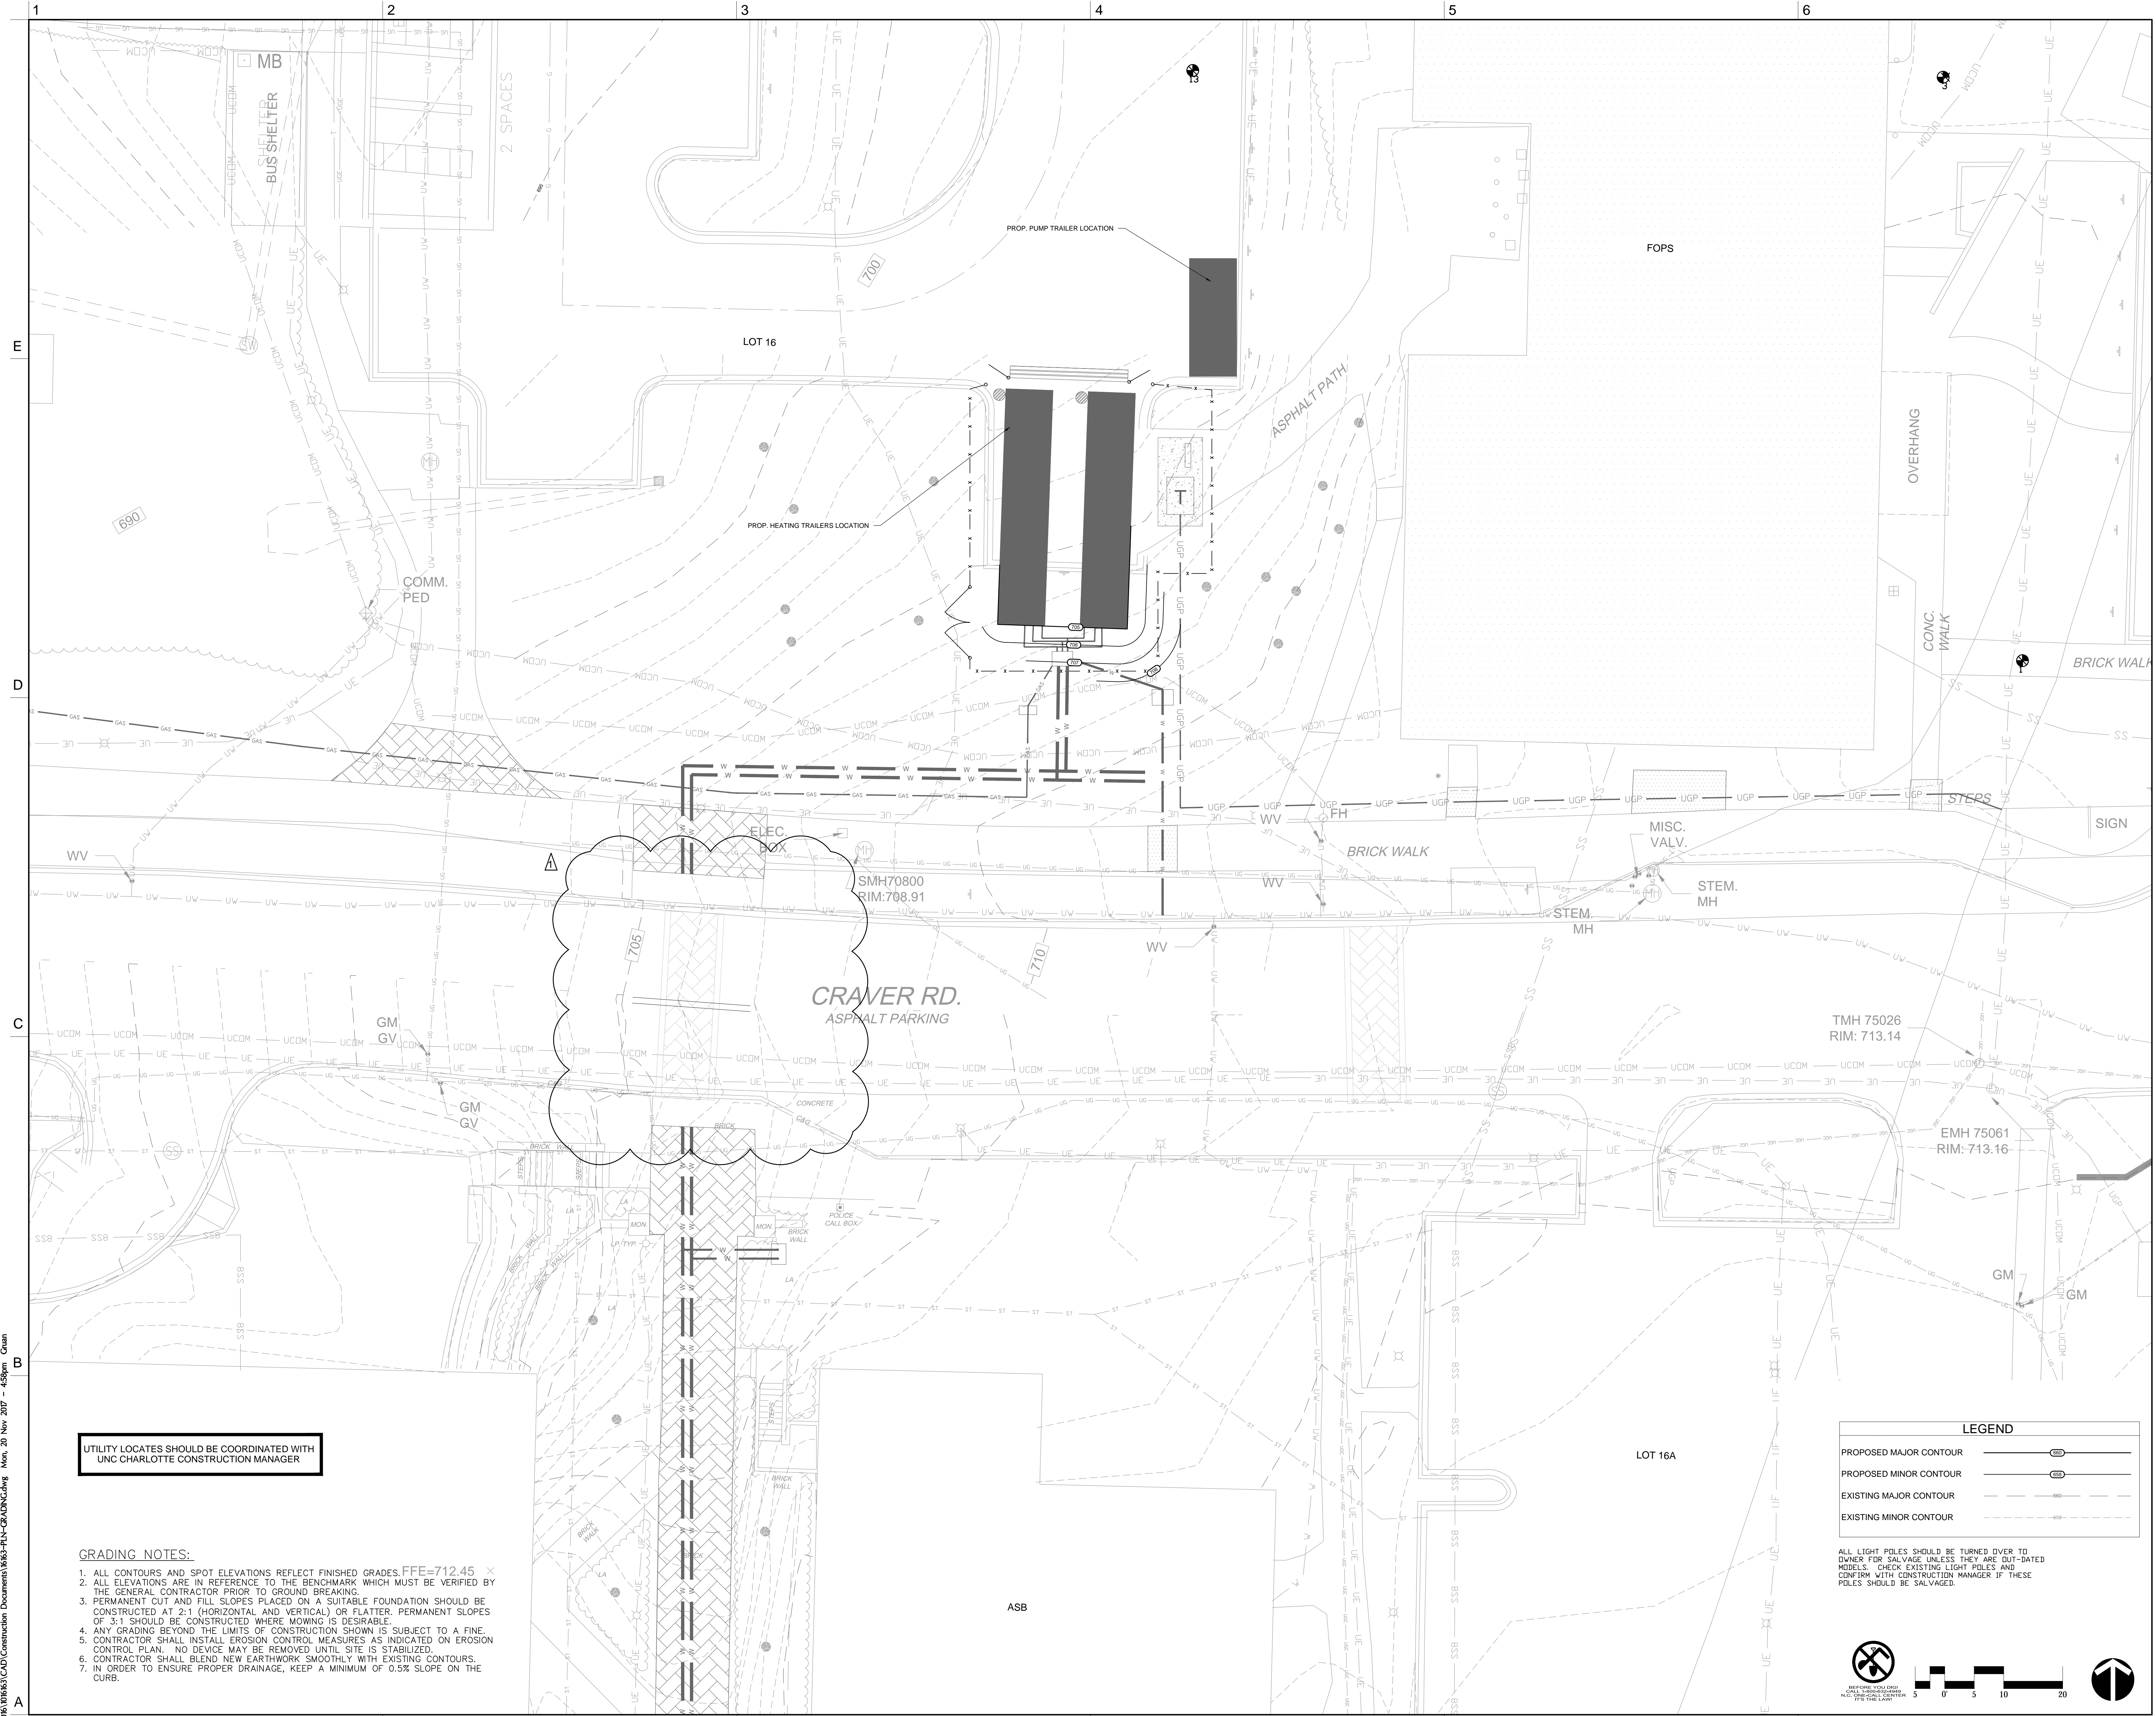

UTILITY LOCATES SHOULD BE COORDINATED WITH  
UNC CHARLOTTE CONSTRUCTION MANAGER

- GRADING NOTES:**
1. ALL CONTOURS AND SPOT ELEVATIONS REFLECT FINISHED GRADES. FFE=712.45 X
  2. ALL ELEVATIONS ARE IN REFERENCE TO THE BENCHMARK WHICH MUST BE VERIFIED BY THE GENERAL CONTRACTOR PRIOR TO GROUND BREAKING.
  3. PERMANENT CUT AND FILL SLOPES PLACED ON A SUITABLE FOUNDATION SHOULD BE CONSTRUCTED AT 2:1 (HORIZONTAL AND VERTICAL) OR FLATTER. PERMANENT SLOPES OF 3:1 SHOULD BE CONSTRUCTED WHERE MOUING IS DESIRABLE.
  4. ANY GRADING BEYOND THE LIMITS OF CONSTRUCTION SHOWN 'S' SUBJECT TO A FINE.
  5. CONTRACTOR SHALL INSTALL EROSION CONTROL MEASURES AS INDICATED ON EROSION CONTROL PLAN. NO DEVICE MAY BE REMOVED UNTIL SITE IS STABILIZED.
  6. CONTRACTOR SHALL BLEND NEW EARTHWORK SMOOTHLY WITH EXISTING CONTOURS.
  7. IN ORDER TO ENSURE PROPER DRAINAGE, KEEP A MINIMUM OF 0.5% SLOPE ON THE CURB.



**LEGEND**

- PROPOSED MAJOR CONTOUR
- PROPOSED MINOR CONTOUR
- EXISTING MAJOR CONTOUR
- EXISTING MINOR CONTOUR

ALL LIGHT POLES SHOULD BE TURNED OVER TO OWNER FOR SALVAGE UNLESS THEY ARE OUT-DATED MODELS. CHECK EXISTING LIGHT POLES AND CONFIRM WITH CONSTRUCTION MANAGER IF THESE POLES SHOULD BE SALVAGED.

N:\2016\10\16\63\CAD\Construction Documents\16-14355-02B-PUN-CRADING.dwg Mon, 20 Nov 2017 - 4:58pm Guan



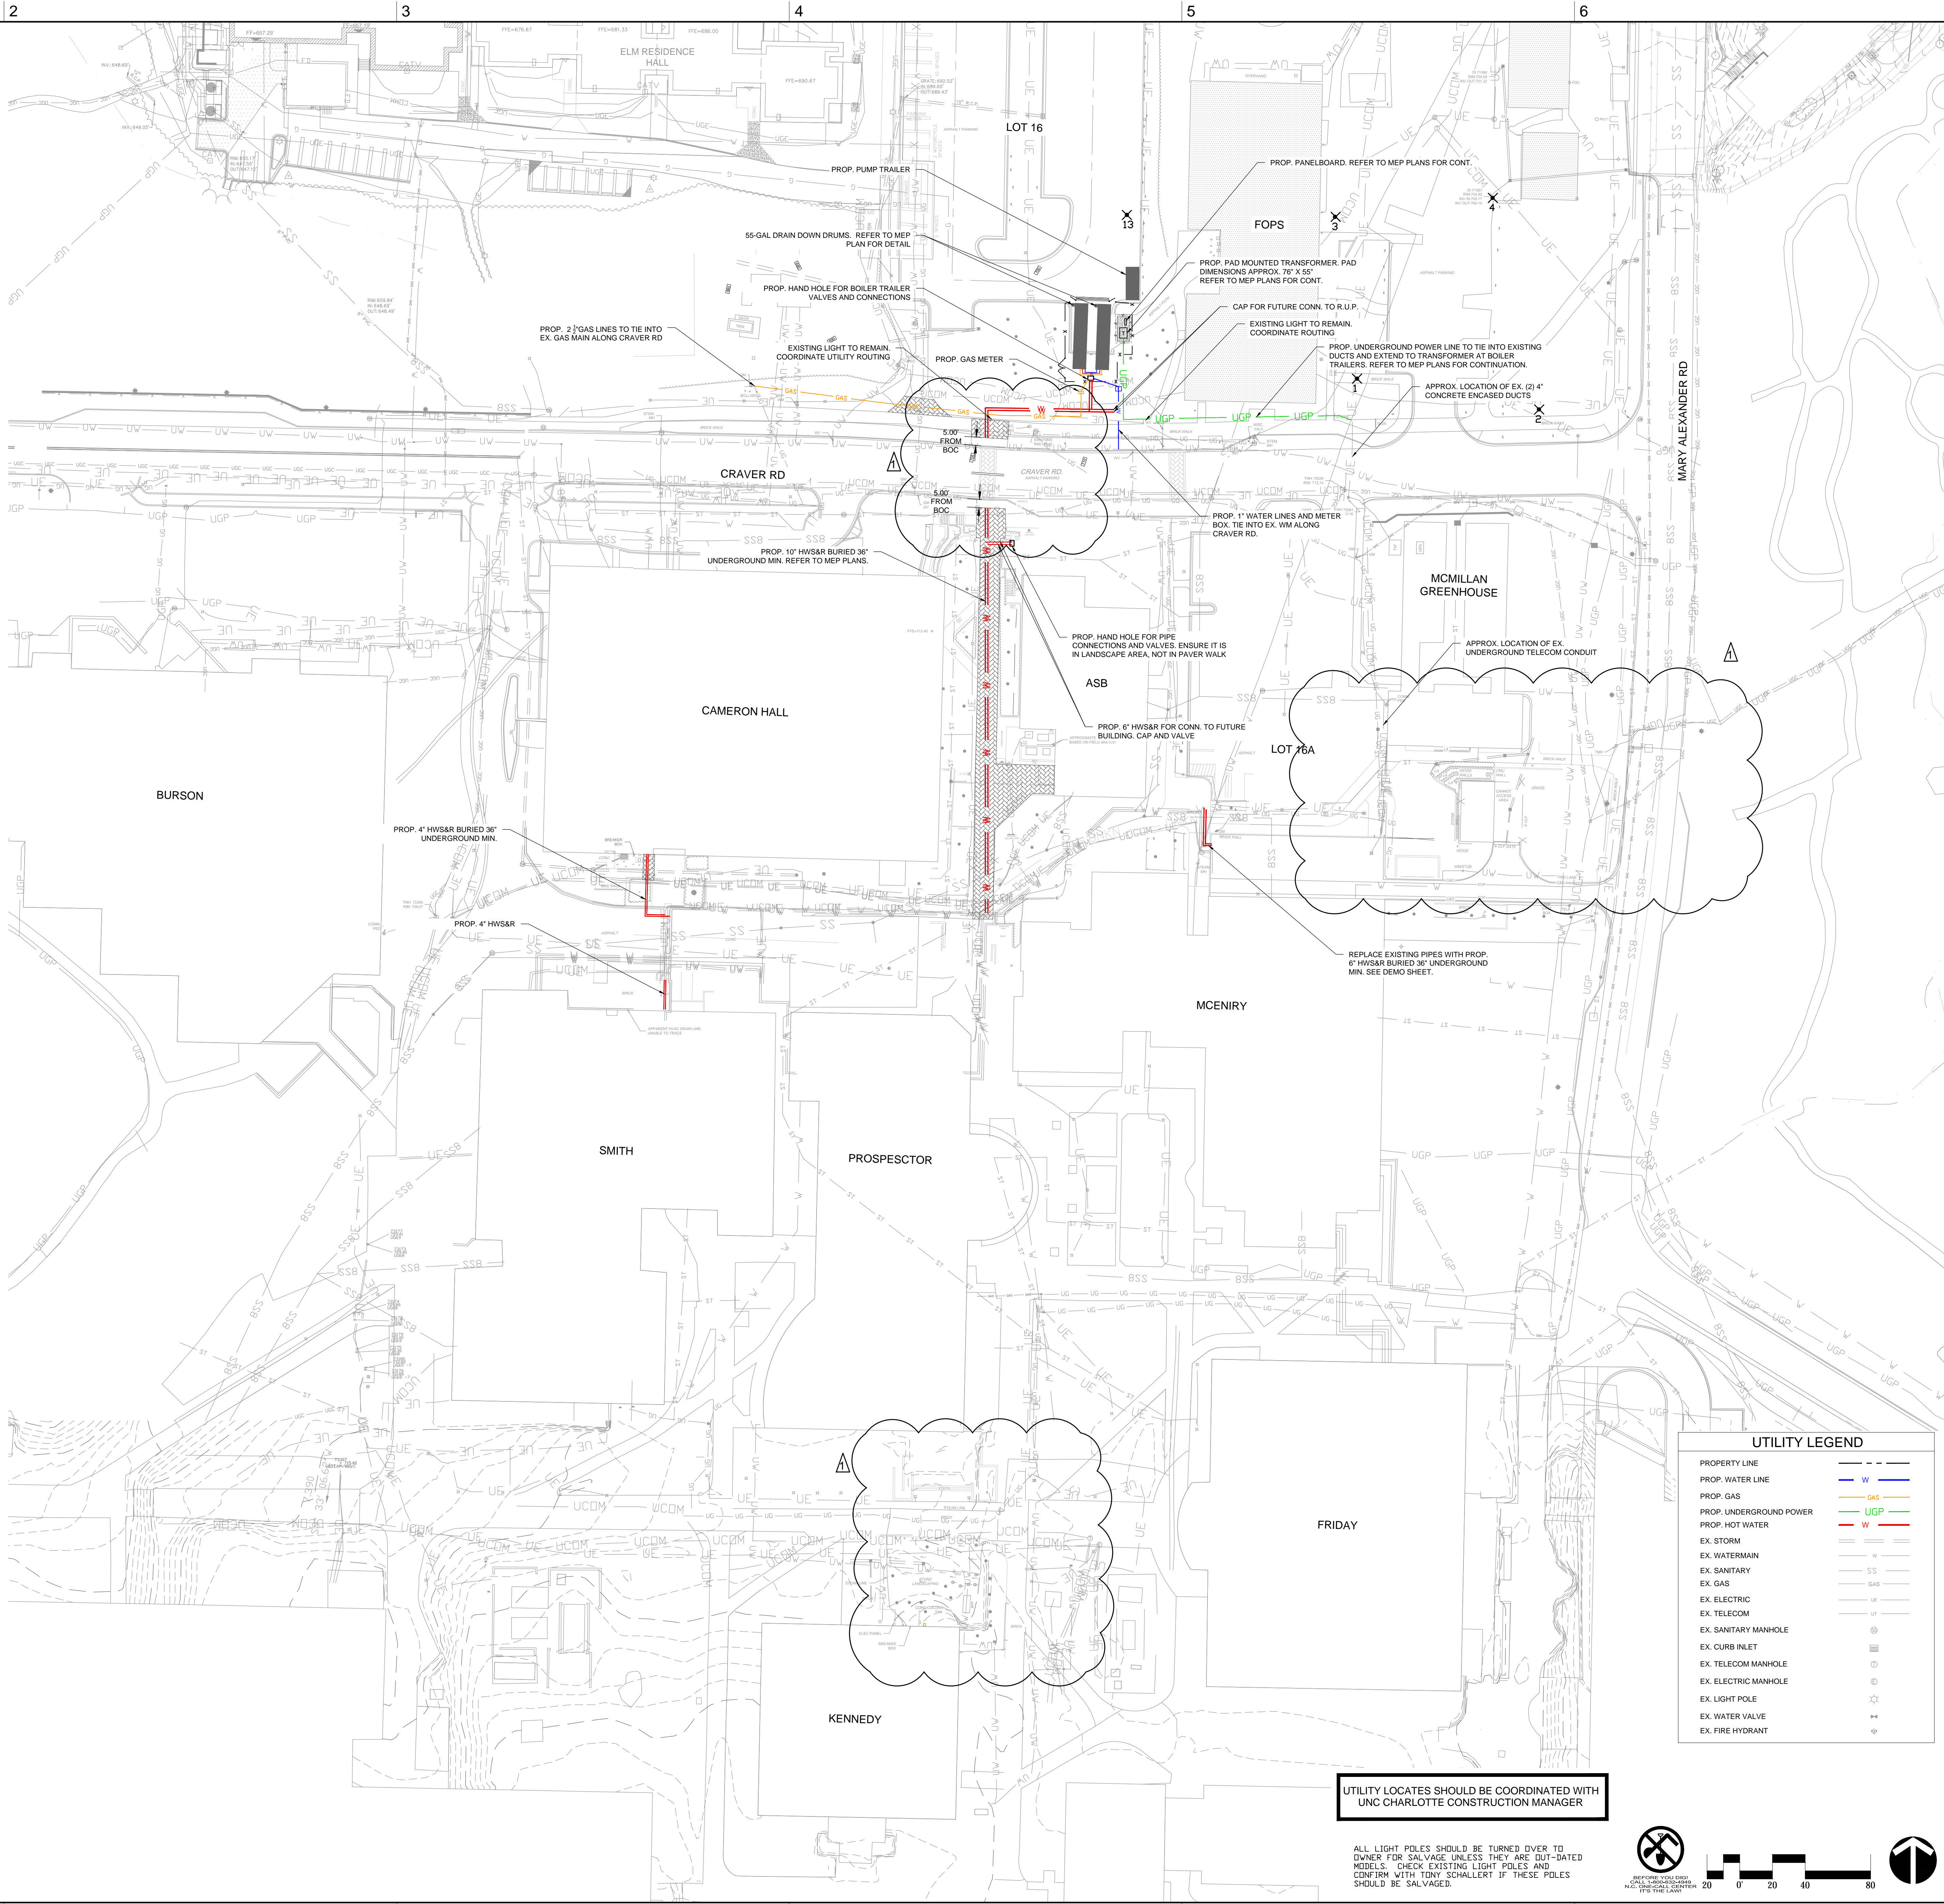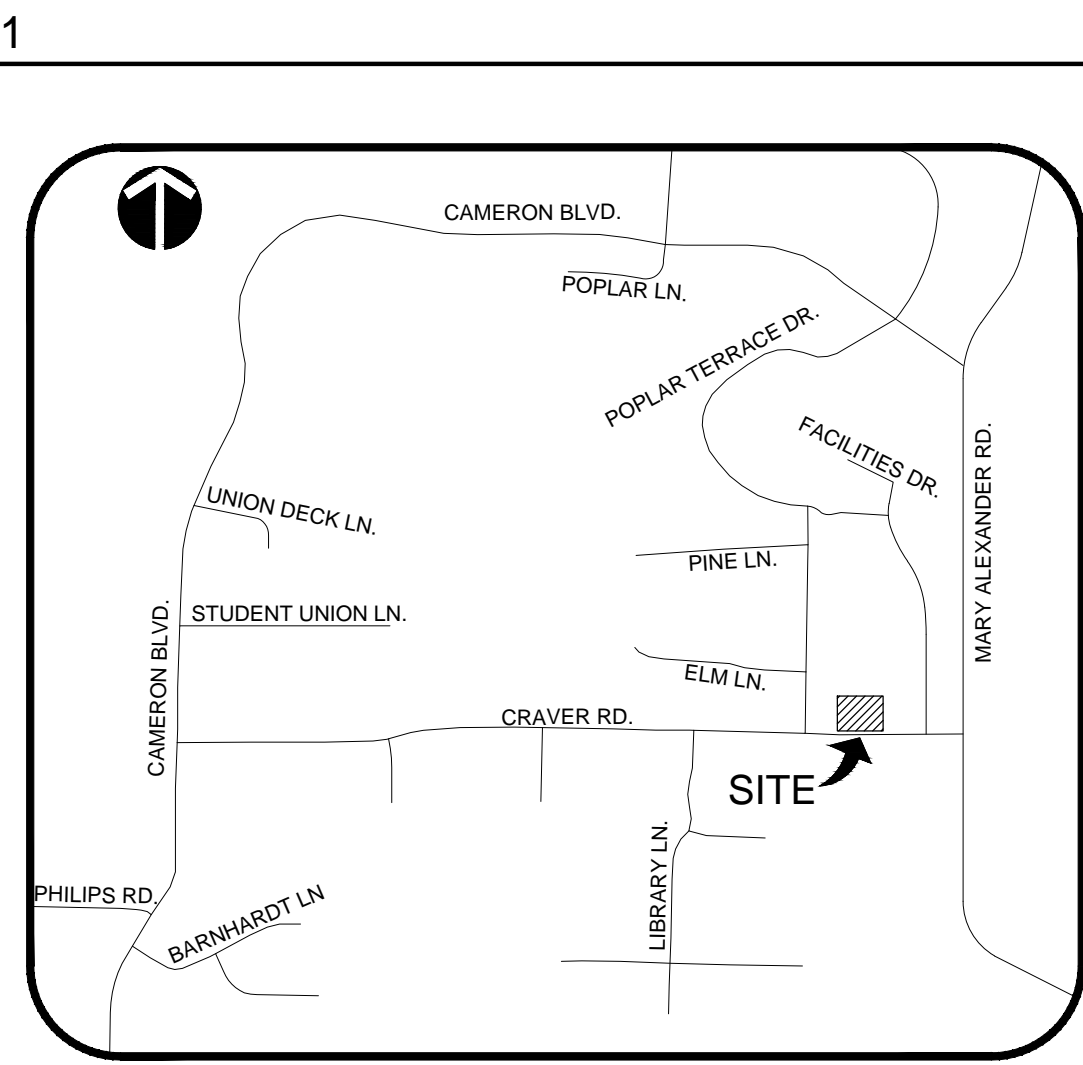

**GENERAL NOTES:**

- REFER TO NCDDO DESIGN MANUAL (WATER AND SEWER POLICIES, PROCEDURES, STANDARDS, AND SPECIFICATIONS) FOR ALL NECESSARY DETAILS, MATERIALS, AND SPECIFICATIONS.
- VERIFY ALL EXISTING UTILITY CONFLICT AREAS TO DETERMINE TOP/BOTTOM OF PIPE. IF ACTUAL ELEVATIONS ARE DIFFERENT FROM THOSE SHOWN ON THIS PLAN, CONTACT THE ENGINEER (LANDDESIGN, INC. : 704-333-0325) BEFORE COMMENCING WITH CONSTRUCTION.
- POTABLE DOMESTIC WATER METERING SHALL BE BY TURBINE OR ROTATING DISK METER WITH MAGNETIC DRIVE. METERS TO BE LOCATED IN MECHANICAL ROOM, EASILY ACCESSIBLE, READ IN HUNDREDS OF CUBIC FEET, AND PROVIDE OUTPUT TO BUILDING AUTOMATION.
- NON-SEWERED WATER (CONSUMED BUT NOT RETURNED TO THE SEWER, E.G. IRRIGATION, COOLING TOWER MAKEUP, ETC.) SHOULD BE METERED AT ITS SOURCE METER SHOULD BE LOCATED IN MECHANICAL ROOM, EASILY ACCESSIBLE, READ IN HUNDREDS OF CUBIC FEET AND PROVIDE OUTPUT TO BUILDING AUTOMATION.
- NATURAL GAS METERING SHALL COMPLY WITH ALL REQUIREMENTS OF PIEDMONT NATURAL GAS, AND INTERFACE TO THE BUILDING AUTOMATION SYSTEM.
- ROOF DRAIN LEADERS ABOVE GRADE SHALL BE GALVANIZED STEEL OR CAST IRON PIPING WITH HOUB OR BELL AND SPIGOT JOINTS WITH COMPRESSION GASKETS. ALL ROOF DRAIN PIPING BELOW GRADE SHALL BE CAST IRON PIPING WITH BELL AND SPIGOT JOINTS WITH COMPRESSION GASKETS.
- COORDINATION OF DIVISIONS OF WORK: CARE IS REQUIRED IN PREPARATION OF DOCUMENTS TO ASSURE NO OVERLAPPING AND NO GAPS BETWEEN THE WORK FOR THE VARIOUS CONTRACTS. EACH CONTRACTOR SHALL BE REQUIRED TO PERFORM EXCAVATION, TRENCHING, AND BACKFILL FOR HIS INSTALLATIONS. MATERIALS AND COMPACTION OF FILL MATERIALS SHALL MEET THE REQUIREMENTS STIPULATED IN DIVISION 2. REGARDLESS OF WHO PERFORMS THIS WORK, THE REQUIREMENTS OF DIVISIONS 15 AND 16 THE REQUIREMENTS OF EARTHWORK MAY BE BEST SPECIFIED BY MAKING REFERENCE TO DIVISION 2.
- MANHOLES: MANHOLE FRAME, COVER, AND GRATE CASTINGS SHALL INCLUDE THE NAME AND LOCATION OF THE MANUFACTURER. COVERS SHALL HAVE CAST IDENTIFICATION MARKINGS OF "STORM DRAIN," "SANITARY," "STEAM," "ELECTRICAL," "TELEPHONE," ETC. AS APPROPRIATE. MASONRY MANHOLES SHALL BE PARGE COATED INSIDE AND OUT. MANHOLES ARE CONSIDERED CONFINED SPACES AND APPROPRIATE SAFETY MEASURES SHOULD BE TAKEN WHEN ENTERING THEM.
- CONTACT LANDDESIGN INC. AT 704-333-0325 IF ANY PIPE CROSSING VERIFICATION IS DIFFERENT THAN WHAT IS SPECIFIED ON THE PLAN.


**TRACER NOTES**

- MECHANICAL IDENTIFICATION**
  - Warning Tape: Acid- and alkali-resistant polyethylene film warning tape manufactured for marking and identifying underground utilities, 6 inches wide and 4 mils thick, continuously inscribed with a description of the utility, colored as follows:
    - Red: Electric.
    - Yellow: Gas, oil, steam, and dangerous materials.
    - Orange: Telephone and other communications.
    - Blue: Water systems.
    - Green: Sewer systems.
  - 2012 NC Gas Code, section 404.15.3 Tracer: An insulated copper tracer wire or other approved conductor shall be installed adjacent to underground nonmetallic piping. Access shall be provided to the tracer wire or the tracer wire shall terminate aboveground at the end of the nonmetallic piping. The tracer wire size shall not be less than 18AWG and the insulation type suitable for direct burial.
  - All pipe, including lawn irrigation lines, and metallic pipe with compression gasket fittings installed underground shall have a tracer wire installed along the length of the pipe. The wire shall be taped to the bottom of the pipe at a maximum of 10' intervals and not allowed to "float freely" within the backfill.
- TRACER WIRE**
  - Tracer wire shall be single-conductor, 12 gauge minimum, copper single-conductor wire with type "UF" (Underground Fused) insulation, and shall be continuous along the pipeline passing through the inside of each valve box. A #12 AWG or heavier (smaller AWG number) solid insulated (RHW, THW, or polyethylene insulation is recommended), copper wire shall be taped to pipe at 10 foot intervals. Do not wrap wire around pipe. The wire must be one continuous, unbroken length. Col tracer wire at meter location and street end with enough wire to extend a minimum of two feet above grade.
  - TRACER WIRE BOXES: Plastic gas and water services longer than 1000 feet in length from curb valve to meter riser must have tracer wire boxes installed in accordance with UNC Charlotte standards.
  - All underground piping and utilities (both metallic and non-metallic), except copper pipe, shall have a separate copper tracer wire and non-metallic warning tape installed above the utility line.
  - The tracer wire shall be traced for continuity prior to backfill. Immediately upon completion of backfill and compaction and once again during final utility location-but at the end of the project. This also will include landscape irrigation mains to the points of the valves. All above ground utility features such as vaults, manholes, valves, handholes, etc to be PROP. early labeled. Contractor shall provide an inventory of all installed outdoor utility features including type and model.
  - Identification Tape: The 1st stage of identification shall be a buried warning tape. This tape shall provide an early warning at shallow depth excavation. The tape shall be 6" wide, and buried approximately 15" to 30" above the service pipe, but a minimum of 10" below finished grade. It shall consist of multiple layers of polyethylene with an overall thickness of 3" to 5" mils. It shall be installed continuous from valve box to valve box or manhole to manhole, and shall terminate just outside of valve box or manhole wall. The black colored lettering on the warning tape shall be abrasion resistant and be imprinted on a color-coded background that conforms to APWA color code standards. The lettering on the tape should name the utility it is protecting. (i.e. Caution Buried Sewer Line Below).
  - TRACER WIRE: The 2nd stage of identification shall be a buried tracer wire. This tracer wire shall provide spatial identification, be fully detectable from above grade utility locators, and be able to provide a depth reference point to top of pipe.

UTILITY LEGEND	
PROPERTY LINE	---
PROP. WATER LINE	— W —
PROP. GAS	— GAS —
PROP. UNDERGROUND POWER	— UGP —
PROP. HOT WATER	— W —
EX. STORM	— S —
EX. WATERMAIN	— W —
EX. SANITARY	— SS —
EX. GAS	— GAS —
EX. ELECTRIC	— E —
EX. TELECOM	— T —
EX. SANITARY MANHOLE	⊙
EX. CURB INLET	⊙
EX. TELECOM MANHOLE	⊙
EX. ELECTRIC MANHOLE	⊙
EX. LIGHT POLE	⊙
EX. WATER VALVE	⊙
EX. FIRE HYDRANT	⊙

UTILITY LOCATES SHOULD BE COORDINATED WITH UNC CHARLOTTE CONSTRUCTION MANAGER

ALL LIGHT POLES SHOULD BE TURNED OVER TO OWNER FOR SALVAGE UNLESS THEY ARE OUT-DATED MODELS. CHECK EXISTING LIGHT POLES AND CONFIRM WITH TONY SCHALLERT IF THESE POLES SHOULD BE SALVAGED.

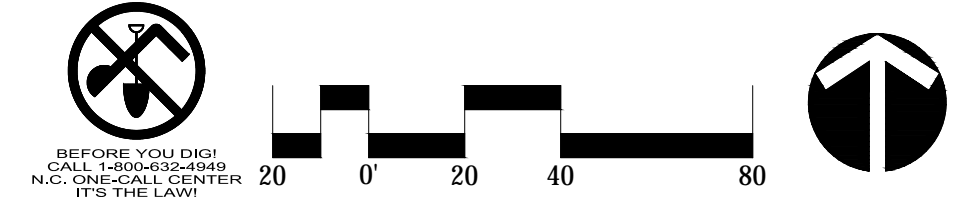

SCO ID Number: 16-14355-02B  
 Code: 46626  
 Item: 301

**CLARK NEXSEN**  
 1523 Elizabeth Avenue, Suite 300  
 Charlotte, NC 28204  
 704.377.8800

**LandDesign**  
 223 N Graham Street Charlotte, NC 28202  
 V: 704.333.0325 F: 704.332.3246  
 www.LandDesign.com

CONSULTANT






SEALS

NC Corporate Engineering License #: C-0658  
 SUBMITTED  
 05 November 2017  
 Bid Documents

REVISIONS

NO.	DATE	DESCRIPTION
1	11/20/2017	ADDENDUM #1



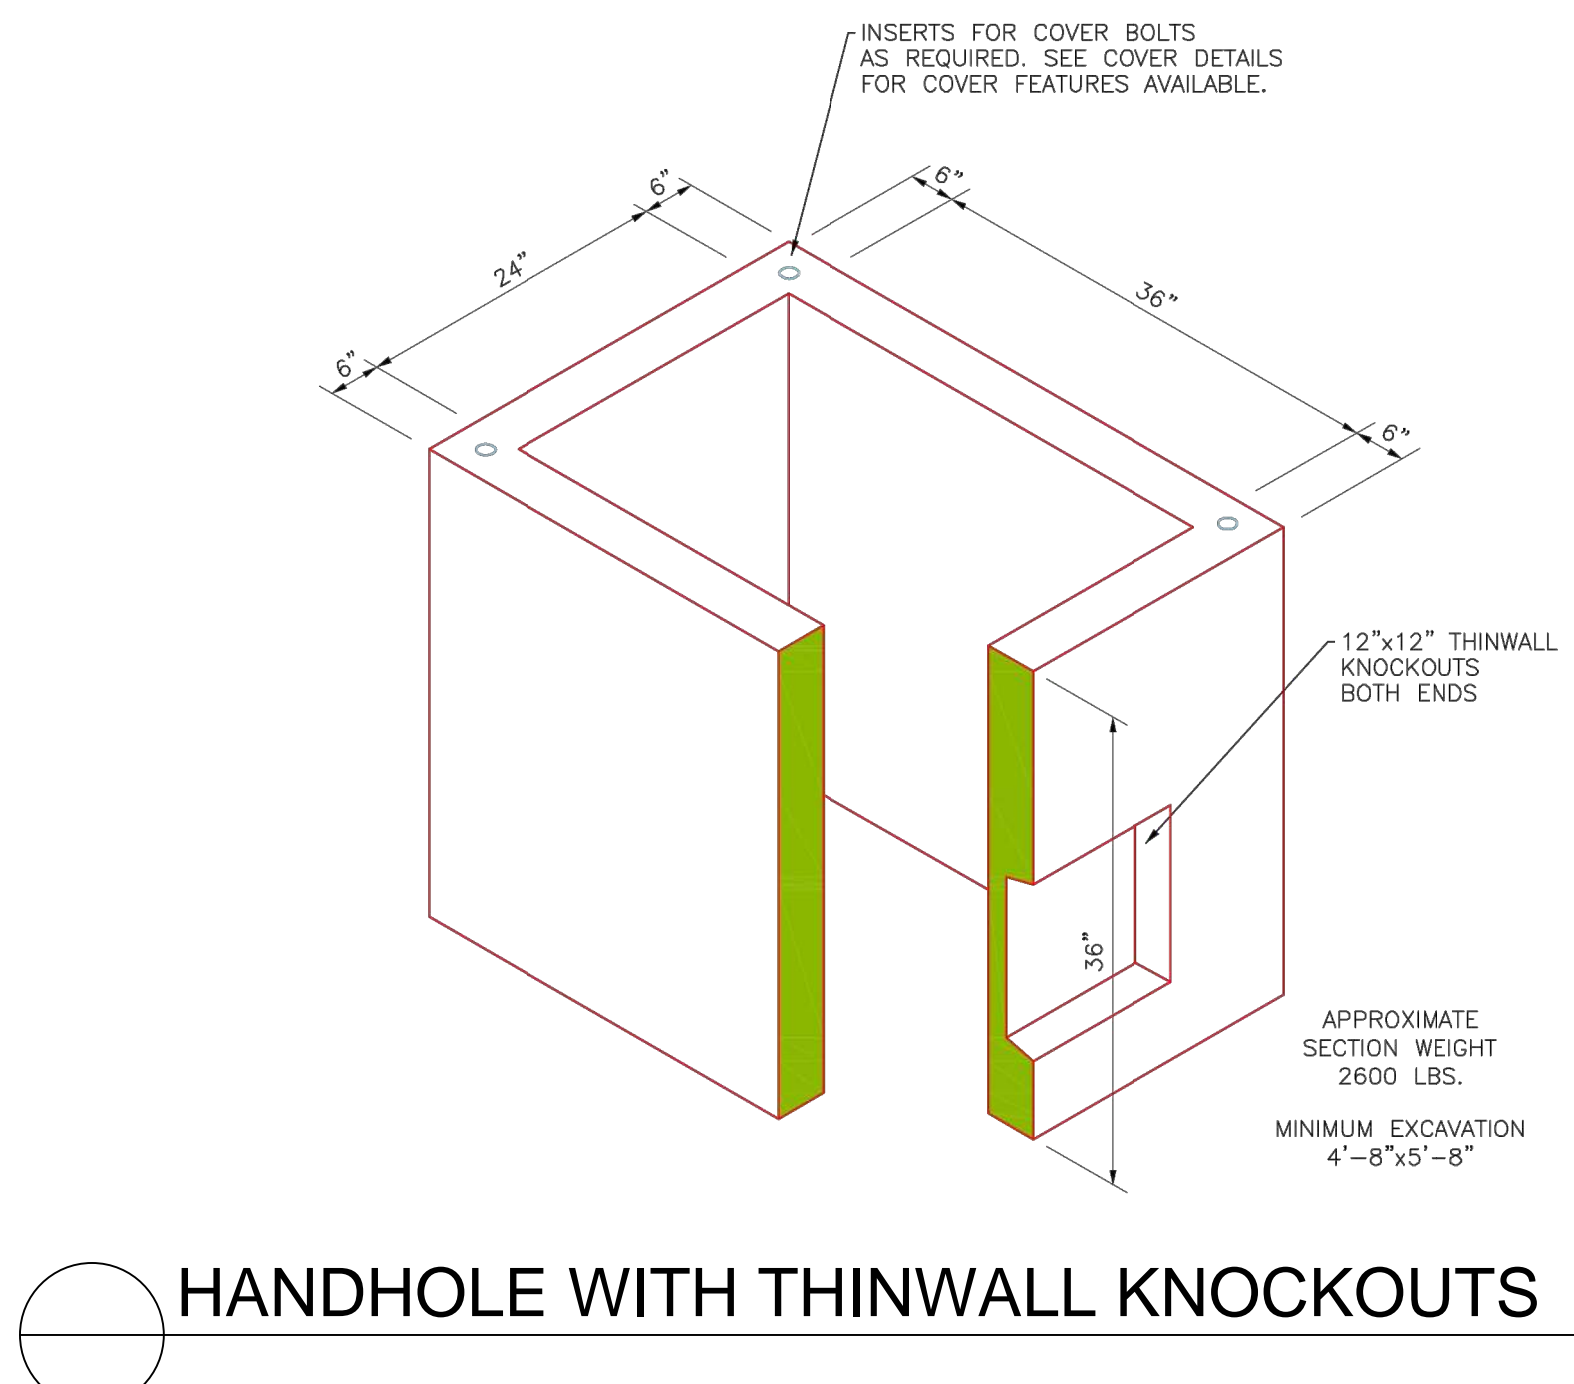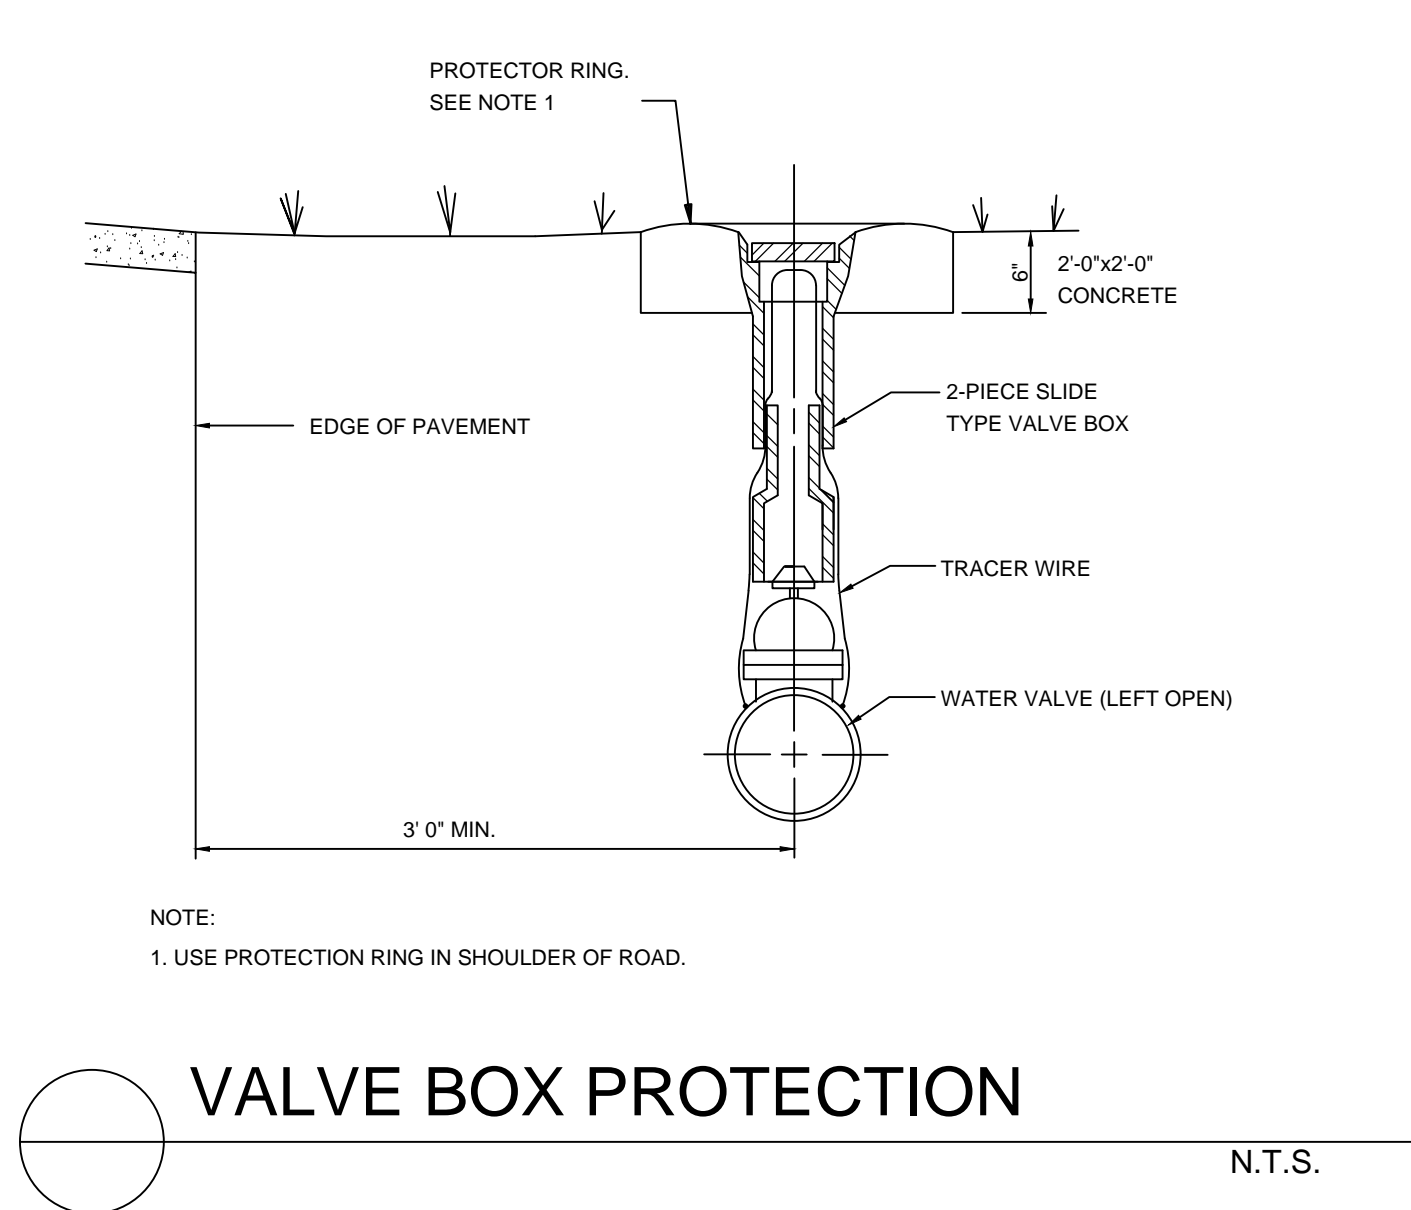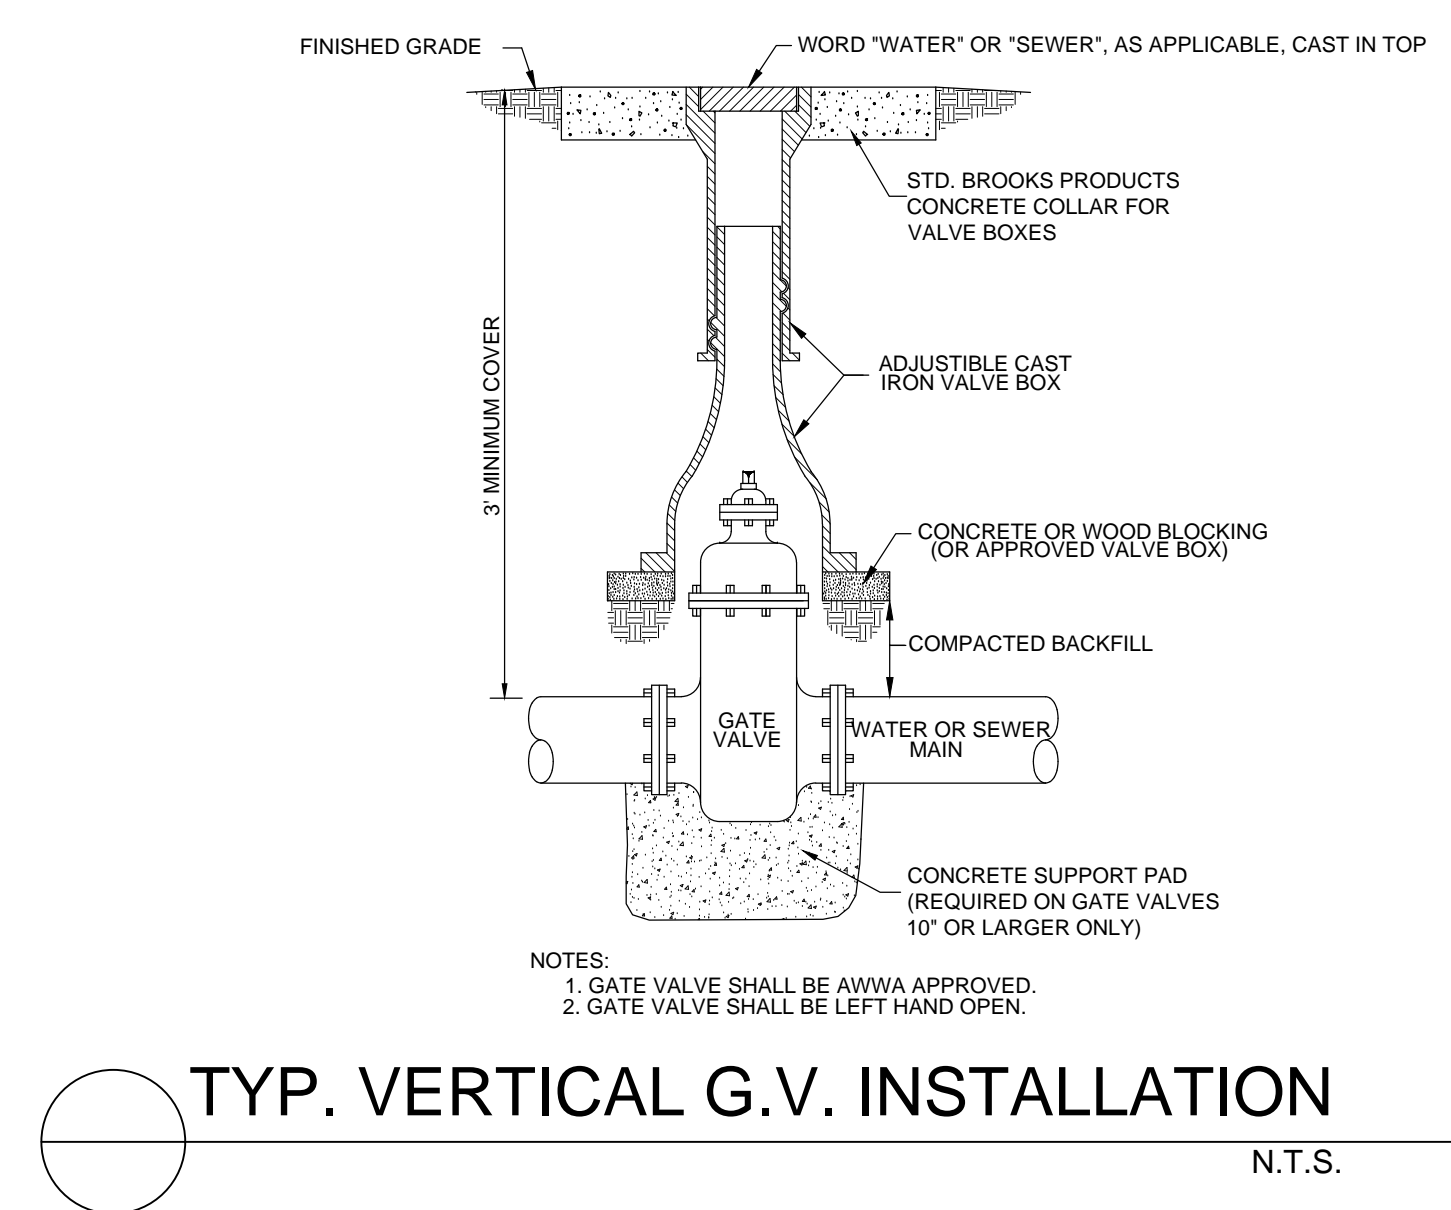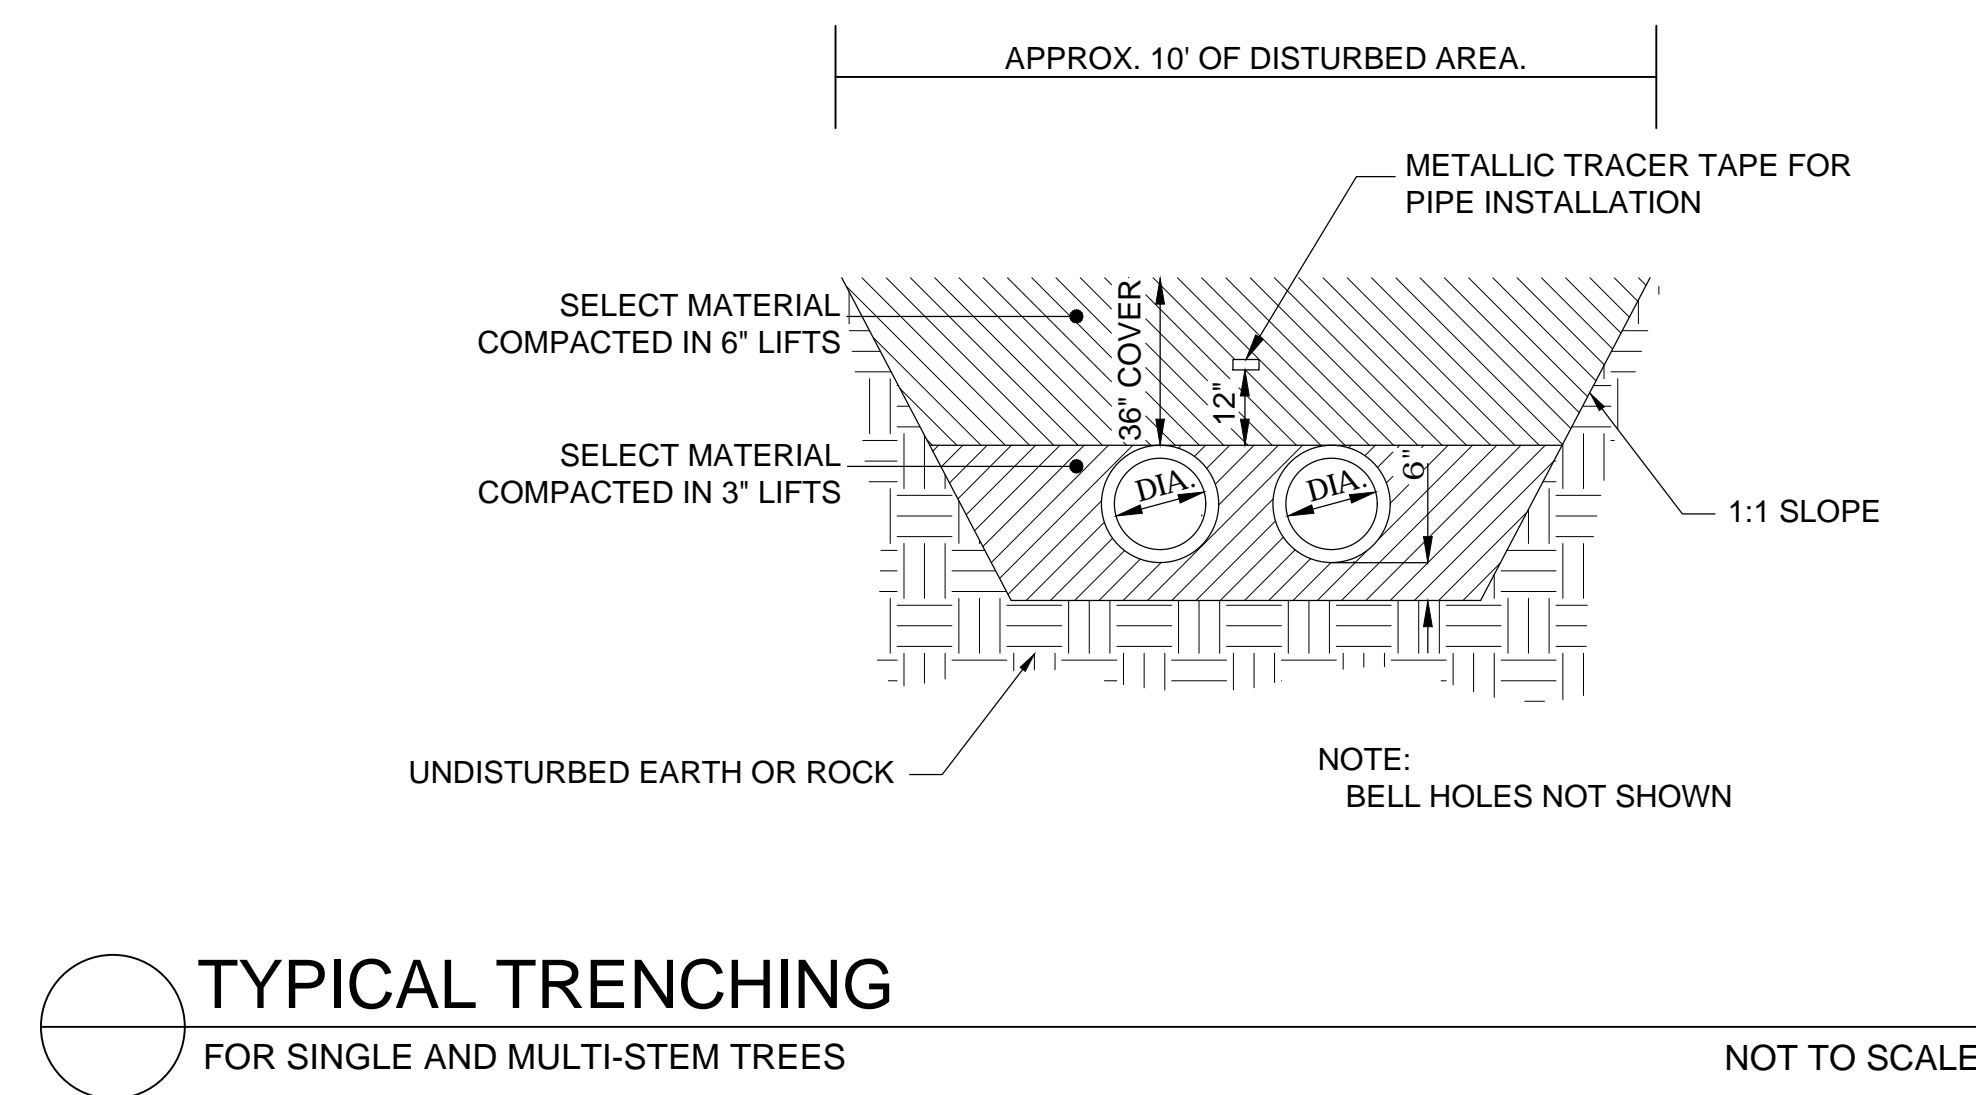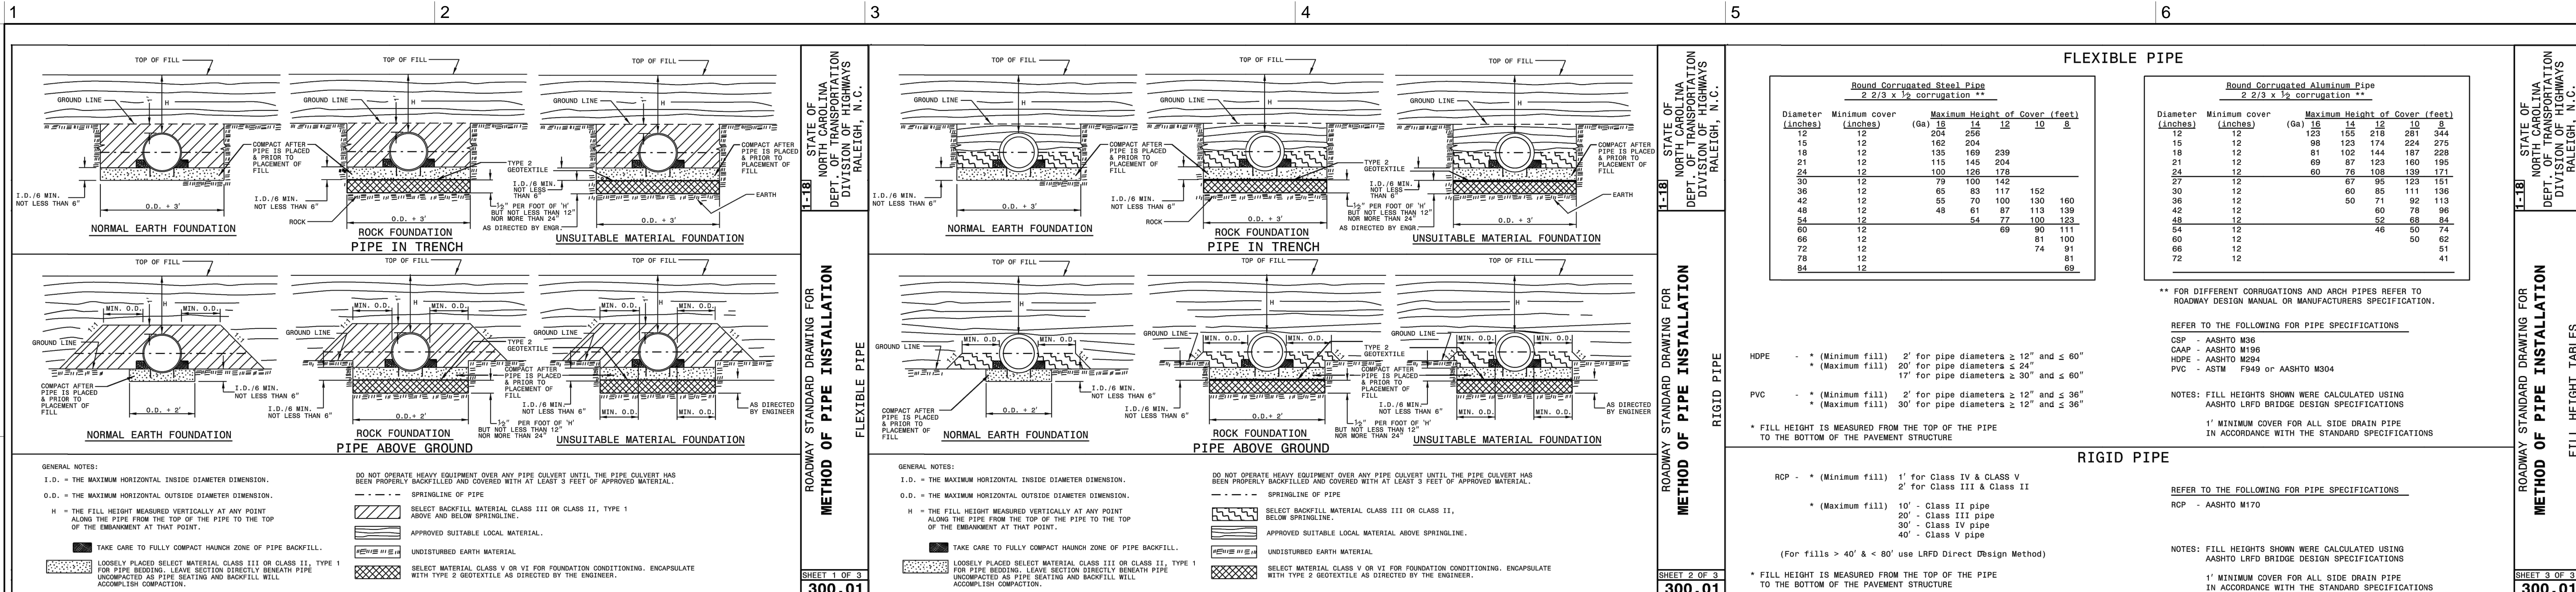

**UNC CHARLOTTE**  
Sciences Building - Existing  
Building Heating Conversions  
9201 University City Boulevard  
Charlotte, NC 28223

SCO ID Number: 16-14355-02B  
Code: 46626  
Item: 301

DESIGNER  
CLARK Nexsen  
1523 Elizabeth Avenue, Suite 300  
Charlotte, NC 28204  
704.377.8800

**LandDesign**  
223 N Graham Street Charlotte, NC 28202  
V: 704.333.0325 F: 704.332.3246  
www.LandDesign.com

CONSULTANT

SEALS

LAND DESIGN, INC. SEAL C-0658  
NORTH CAROLINA PROFESSIONAL ENGINEERS SEAL 033804  
MARC D. MONTGOMERY

NC Corporate Engineering License #: C-0658  
SUBMITTAL  
05 November 2017  
**Bid Documents**

REVISIONS

1	11/20/2017	ADDENDUM #1
---	------------	-------------

SEAL

UTILITY DETAILS

**C-401**

DESIGN: MCM  
DRAWN: GR  
REVIEW: MCM

CN 6222

N:\2016\10\16\63\CAD\Construction Documents\63-PLAN-UTILITY.dwg Mon, 20 Nov 2017 4:59pm C:\win



### SEISMIC PERFORMANCE CRITERIA (NAT. GAS SYSTEMS)

WHERE APPLICABLE, NATURAL GAS PIPING, EQUIPMENT, AND SERVICES ARE TO BE SEISMICALLY RESTRAINED IN ACCORDANCE WITH THE 2012 EDITION OF THE NORTH CAROLINA STATE BUILDING CODES, CHAPTER 13 OF ASCE 7, AND AS DIRECTED BY THE BUILDING'S STRUCTURAL ENGINEER OF RECORD. DESIGN OF THE RESTRAINT SYSTEM SHALL BE PERFORMED BY THE MANUFACTURER OF THE RESTRAINT DEVICES. DESIGN OF THE RESTRAINT SYSTEM AND ALL SUBMITTAL DATA TO INCLUDE SEISMIC CALCULATIONS CERTIFIED BY A PROFESSIONAL ENGINEER LICENSED IN THE STATE OF NORTH CAROLINA AND EMPLOYED BY THE RESTRAINT MANUFACTURER. SEISMIC RESTRAINT DEVICES TO BE INDEPENDENTLY TESTED TO ENSURE PUBLISHED RATINGS. ALL ASSEMBLIES SHALL HAVE AN ANCHORAGE PRE-APPROVAL "R" NUMBER FROM OSHPD.

ACCEPTABLE MANUFACTURERS:

- 1) MASON INDUSTRIES, 2) KINETICS NOISE CONTROL, 3) ISOLATION TECHNOLOGY INC., OR APPROVED EQUAL.

SEISMIC PERFORMANCE CRITERIA:

SEISMIC USE GROUP: II  
COMPONENT IMPORTANCE FACTOR (I<sub>p</sub>): 1.5  
SEISMIC DESIGN CATEGORY: C

### SEISMIC PERFORMANCE CRITERIA (MECHANICAL SYSTEMS)

BASED ON THE 2012 EDITION OF THE NORTH CAROLINA STATE BUILDING CODES, SECTION 9.6 OF ASCE 7, AND THE FOLLOWING SEISMIC PERFORMANCE CRITERIA, SEISMIC RESTRAINTS FOR THE MECHANICAL EQUIPMENT AND SYSTEMS ARE NOT REQUIRED.

SEISMIC PERFORMANCE CRITERIA:

SEISMIC USE GROUP: II  
COMPONENT IMPORTANCE FACTOR (I<sub>p</sub>): 1.0  
SEISMIC DESIGN CATEGORY: C

#### LEGEND

- CONNECT TO EXISTING
- DEMO TO THIS POINT

#### PIPING

- CD COOLING COIL CONDENSATE DRAIN
- HWS HEATING HOT WATER SUPPLY
- HWR HEATING HOT WATER RETURN
- LPS LOW PRESSURE STEAM
- LPC LOW PRESSURE CONDENSATE
- HPS HIGH PRESSURE STEAM
- HPC HIGH PRESSURE CONDENSATE
- PC PUMPED CONDENSATE
- (NAME)E EXISTING PIPING
- XX(NAME)XX PIPING TO BE REMOVED
- ELBOW UP
- TEE DOWN
- TEE UP
- GENERAL PIPELINE STRAINER WITH DRAIN VALVE AND CAP
- FLANGE
- UNION
- PIPE FLEXIBLE CONNECTION
- BUTTERFLY VALVE
- GATE VALVE
- GLOBE VALVE
- BALL VALVE
- GAUGE VALVE
- CALIBRATED BALANCING VALVE
- SPRING CHECK VALVE
- SWING CHECK VALVE
- 2-WAY MODULATING CONTROL VALVE
- THERMOMETER IN THERMOWELL
- PRESSURE GAUGE
- FLOW SENSOR
- FLOW SWITCH
- AUTOMATIC AIR VENT
- MANUAL AIR VENT
- THERMOSTATIC AIR VENT
- P/T PRESSURE/TEMPERATURE TEST PLUG (P/T)
- CONCENTRIC REDUCER
- ECCENTRIC REDUCER
- DIRECTION OF FLOW
- WATER FLOW METER
- PRESSURE RELIEF OR SAFETY VALVE
- PRESSURE REDUCING VALVE

#### DIRECT BURIED PIPING SPECIFICATION

UNDERGROUND DISTRIBUTION PIPING SHALL BE BY ONE OF THE FOLLOWING MANUFACTURERS: 1)PERMA-PIPE, 2)ROVANCO, 3)THERMACORE. THE BASIS OF DESIGN IS QUICK-THERM, AS MANUFACTURED BY PERMA-PIPE. THE SERVICE PIPE SHALL BE DOMESTIC STEEL ONLY, WITH MILL CERTIFICATION CERTIFICATES DELIVERED WITH THE TRUCK. THE PIPE SHALL BE STANDARD WEIGHT ASTM A53 GRADE B SCHEDULE 40 CARBON STEEL. THE EXTERIOR OF THE CARRIER PIPE SHALL BE FACTORY COATED WITH 2-4 MILS ZINC RICH PAINT TO A SHOT BLASTED NEAR WHITE FINISH PER SSPC-10-63T. ALL JOINTS SHALL BE BUTT-WELDED FOR 2 1/2" AND LARGER, AND SOCKET OR BUTT-WELDED FOR 2" AND SMALLER, WHERE POSSIBLE. STRAIGHT SECTIONS SHALL BE SUPPLIED IN 40-FOOT RANDOM LENGTHS WITH PIPING EXPOSED AT EACH END FOR FIELD JOINT FABRICATION. THE PRE-INSULATED PIPE SUPPLIER SHALL FURNISH A COATING DATA SHEET FROM COATING MANUFACTURER WITH SUBMITTAL.

#### INSULATION

THE SERVICE PIPE INSULATION SHALL BE POLYURETHANE FOAM WITH 2 LB./FT3 MINIMUM DENSITY, 90% MINIMUM CLOSED CELL CONTENT, MINIMUM COMPRESSIVE STRENGTH OF 40 PSI AND INITIAL THERMAL CONDUCTIVITY OF 0.18 BTU IN/HR./FT2/O.F. THE INSULATION SHALL COMPLETELY FILL THE ANNULAR SPACE BETWEEN THE SERVICE PIPE AND JACKET AND SHALL BE BONDED TO BOTH. SYSTEMS USING OPEN CELL INSULATION OR A NON-BONDED DESIGN SHALL NOT BE ALLOWED. THE POLYURETHANE FOAM INSULATION SHALL BE TESTED BY THE MANUFACTURER FOR MECHANICAL AND THERMAL TO ASSURE COMPLIANCE WITH THE ABOVE VALUES. ALL TEST SAMPLES WILL BE TAKEN FROM PRODUCTION MATERIAL, IDENTIFIED, TAGGED AND TESTED IN ACCORDANCE WITH THE STANDARDS BELOW. TEST REPORTS SHOWING RESULTS WILL BE FURNISHED TO THE ENGINEER FOR APPROVAL. DATA SUPPLIED BY THE POLYURETHANE FOAM CHEMICAL SUPPLIER IS NOT ACCEPTABLE. THE PIPE INSULATION SHALL HAVE A METALLIC (ALUMINUM) DIFFUSION BARRIER WRAPPED AROUND ALL STRAIGHT SECTIONS OF PIPE PRIOR TO OUTER HOPE JACKET. THERMO LASTIC DIFFUSION BARRIERS WILL NOT BE ALLOWED, ONLY METALLIC (ALUMINUM) MANUFACTURERS THAT CANNOT SUPPLY DIFFUSION BARRIER SHALL PROVIDE AS A MINIMUM SDR 32 HDPE JACKET MATERIAL.

#### FIELD JOINTS

THE SERVICE PIPE SHALL BE HYDROSTATICALLY TESTED TO 150 PSIG OR 1 1/2 TIMES THE DESIGN PRESSURES WHICHEVER IS GREATER. INSULATION SHALL THEN BE POURED IN PLACE INTO THE FIELD JOINT AREA. ALL FIELD-APPLIED INSULATION SHALL BE PLACED ONLY IN STRAIGHT SECTIONS OF PIPE, AND THEN WRAPPED WITH ALUMINUM DIFFUSION MATERIAL PRIOR TO INSTALLING THE SHRINK WRAP. THE INSTALLER SHALL SEAL THE FIELD JOINT AREA WITH A DUAL SHRINK WRAP SYSTEM OF A 24" WIDE HEAT SHRINKABLE ADHESIVE BACKED SLEEVE OVER LAPPED WITH A 36" WIDE SHRINKABLE ADHESIVE BACKED SLEEVE. BACKFILLING SHALL NOT BEGIN UNTIL THE HEAT SHRINK SLEEVE HAS COOLED TO 100 DEGREES F. ALL INSULATION AND JACKETING MATERIALS FOR THE FIELD JOINT SHALL BE FURNISHED BY MANUFACTURE. ALL FIELD JOINT AREAS MUST BE VISUALLY INSPECTED AFTER FOAMING OF JOINTS TO INSURE THE JOINT AREA IS VOID FREE. NO SLEEVES OR SHRINK-WRAP SHALL BE APPLIED WITHOUT VISUAL INSPECTION.

#### PROTECTIVE JACKET

THE OUTER CASING PROTECTIVE JACKET SHALL BE EXTRUDED BLACK HIGH-DENSITY POLYETHYLENE (HDPE) PER ASTM D3350. THE JACKET SHALL BE MANUFACTURED TO A MINIMUM THICKNESS OF SDR 32.5. THE JACKET THROUGHOUT THE ENTIRE SYSTEM SHALL INCORPORATE ELECTRIC FUSION, BUTT FUSION, OR EXTRUSION WELDING AT ALL FITTINGS, JOINT CLOSURES OR OTHER POINTS OF CONNECTION PROHIBITING THE INGRESSION OF WATER. JACKETS MADE FROM PVC, TAPE MATERIALS, OR THIN WALLED POLYETHYLENE SHALL NOT BE ALLOWED.

MOISTURE BARRIER END SEALS SHALL BE FACTORY APPLIED, SEALED TO THE JACKET AND CARRIER PIPE. END SEALS SHALL BE CERTIFIED AS HAVING PASSED A 20 FOOT HEAD PRESSURE TEST. END SEALS SHALL BE HIGH TEMPERATURE MASTIC COMPLETELY SEALING THE EXPOSED END OF INSULATION. FIELD APPLIED END SEALS SHALL BE INSTALLED AT ANY FIELD CUT TO THE PIPING BEFORE CONTINUING INSTALLATION.

#### BEDDING AND BACKFIELD

A 4-INCH LAYER OF SAND OF FINE GRAVEL SHALL BE PLACED AND TAMPED IN THE TRENCH TO PROVIDE UNIFORM BEDDING FOR THE SYSTEM. THE ENTIRE TRENCH SHALL BE EVENLY BACKFILLED WITH SIMILAR MATERIAL AS THE BEDDING IN 6-INCH COMPACTED LAYERS TO MINIMUM HEIGHT OF 6 INCHES ABOVE THE TOP OF THE INSULATED PIPING SYSTEM. THE REMAINING TRENCH SHALL BE EVENLY AND CONTINUOUSLY BACKFILLED IN UNIFORM LAYERS WITH SUITABLE EXCAVATED SOIL.

#### BACKFILL

PIPING SHALL MEET H-20 HIGHWAY LOADING WITH 24-INCHES OF BACKFILL PROVIDED ON TOP OF PIPE. BEDDING FOR THE PIPE, THE ENTIRE TRENCH WIDTH SHALL BE EVENLY BACKFILLED WITH A SIMILAR MATERIAL AS THE BEDDING IN 6 INCH COMPACTED LAYERS. THE REMAINING TRENCH SHALL BE EVENLY AND CONTINUOUSLY BACKFILLED AND COMPACTED IN UNIFORM LAYERS WITH SUITABLE EXCAVATED SOIL.

#### WARNING TAPE

PROVIDE WARNING TAPE.

#### FLUSHING:

FLUSHING OF 4-INCH PIPE AND LARGER SHALL UTILIZE HIGH-PRESSURE "HYDRO-JET" PROCESS. COORDINATE THE LIMITATIONS AND REQUIREMENTS OF HYDRO-JET PROCESS WITH THE FLUSHING SUBCONTRACTOR SUCH THAT THE PIPING IS INSTALLED IN A SEQUENCE AND MANNER THAT ALLOWS EVERY SECTION OF NEW PIPE TO BE CLEANED AND FLUSHED. LIMITATIONS MAY INCLUDE MAXIMUM LENGTH OF PIPE SECTION, MAXIMUM NUMBER / AND OR DEGREE OF BENDS IN THE PIPE SECTION, MAXIMUM SLOPE OF THE PIPE SECTION, EQUIPMENT AND EXCAVATION ACCESS REQUIREMENTS, AND THE MINIMUM SIZE OF THE OPENINGS REQUIRED IN THE PIPING TO ALLOW FOR INSERTION AND RETRACTION OF THE CLEANING HEAD.

#### VALVES:


BUTTERFLY VALVES SHALL BE OF THE POSITIVE SHUT-OFF TYPE. ALL WATER VALVES TO OPERATE BY TURNING THE SQUARE NUT CLOCK-WISE (RIGHT) TO CLOSE AND COUNTER-CLOCKWISE (LEFT) TO OPEN. PROVIDE ALL VALVES BELOW GRADE WITH EXTENSIONS AND DONUT AND VALVE BOX.

#### SHOP DRAWINGS:

FOR UNDERGROUND HEATING WATER SUPPLY DISTRIBUTION PIPING, SIGNED AND SEALED BY A QUALIFIED PROFESSIONAL ENGINEER.  
1. CALCULATE REQUIREMENTS FOR EXPANSION COMPENSATION FOR UNDERGROUND PIPING.  
2. SHOW EXPANSION COMPENSATORS, OFFSETS, AND LOOPS WITH APPROPRIATE MATERIALS TO ALLOW PIPING MOVEMENT IN THE REQUIRED LOCATIONS. SHOW ANCHORS AND GUIDES THAT RESTRAIN PIPING MOVEMENT WITH CALCULATED LOADS, AND SHOW CONCRETE THRUST BLOCK DIMENSIONS.  
3. SHOW PIPE SIZES, LOCATIONS, AND ELEVATIONS. SHOW PIPING IN TRENCH WITH DETAILS SHOWING CLEARANCES BETWEEN PIPING, AND SHOW INSULATION THICKNESS.

COORDINATION DRAWINGS: SHOW PIPE SIZES, LOCATIONS, AND ELEVATIONS. SHOW OTHER PIPING IN SAME TRENCH AND CLEARANCES FROM DISTRIBUTION PIPING. INDICATE INTERFACE AND SPATIAL RELATIONSHIP BETWEEN MANHOLES, PIPING, AND PROXIMATE STRUCTURES.  
PROFILE DRAWINGS: SHOW SYSTEM PIPING IN ELEVATION. DRAW PROFILES AT HORIZONTAL SCALE OF NOT LESS THAN 1 INCH EQUALS 50 FEET (1:50) AND AT VERTICAL SCALE OF NOT LESS THAN 1 INCH EQUALS 5 FEET (1:50). INDICATE MANHOLES AND PIPING. SHOW TYPES, SIZES, MATERIALS, AND ELEVATIONS OF OTHER UTILITIES CROSSING DISTRIBUTION PIPING.

THE PIPING SYSTEM LAYOUT SHALL BE ANALYZED BY THE PIPING SYSTEM MANUFACTURER TO DETERMINE THE STRESSES AND DISPLACEMENTS OF THE SERVICE PIPE. THE PIPING SYSTEM DESIGN AND MANUFACTURE SHALL BE IN STRICT CONFORMANCE WITH ASME B31.1, LATEST EDITION.

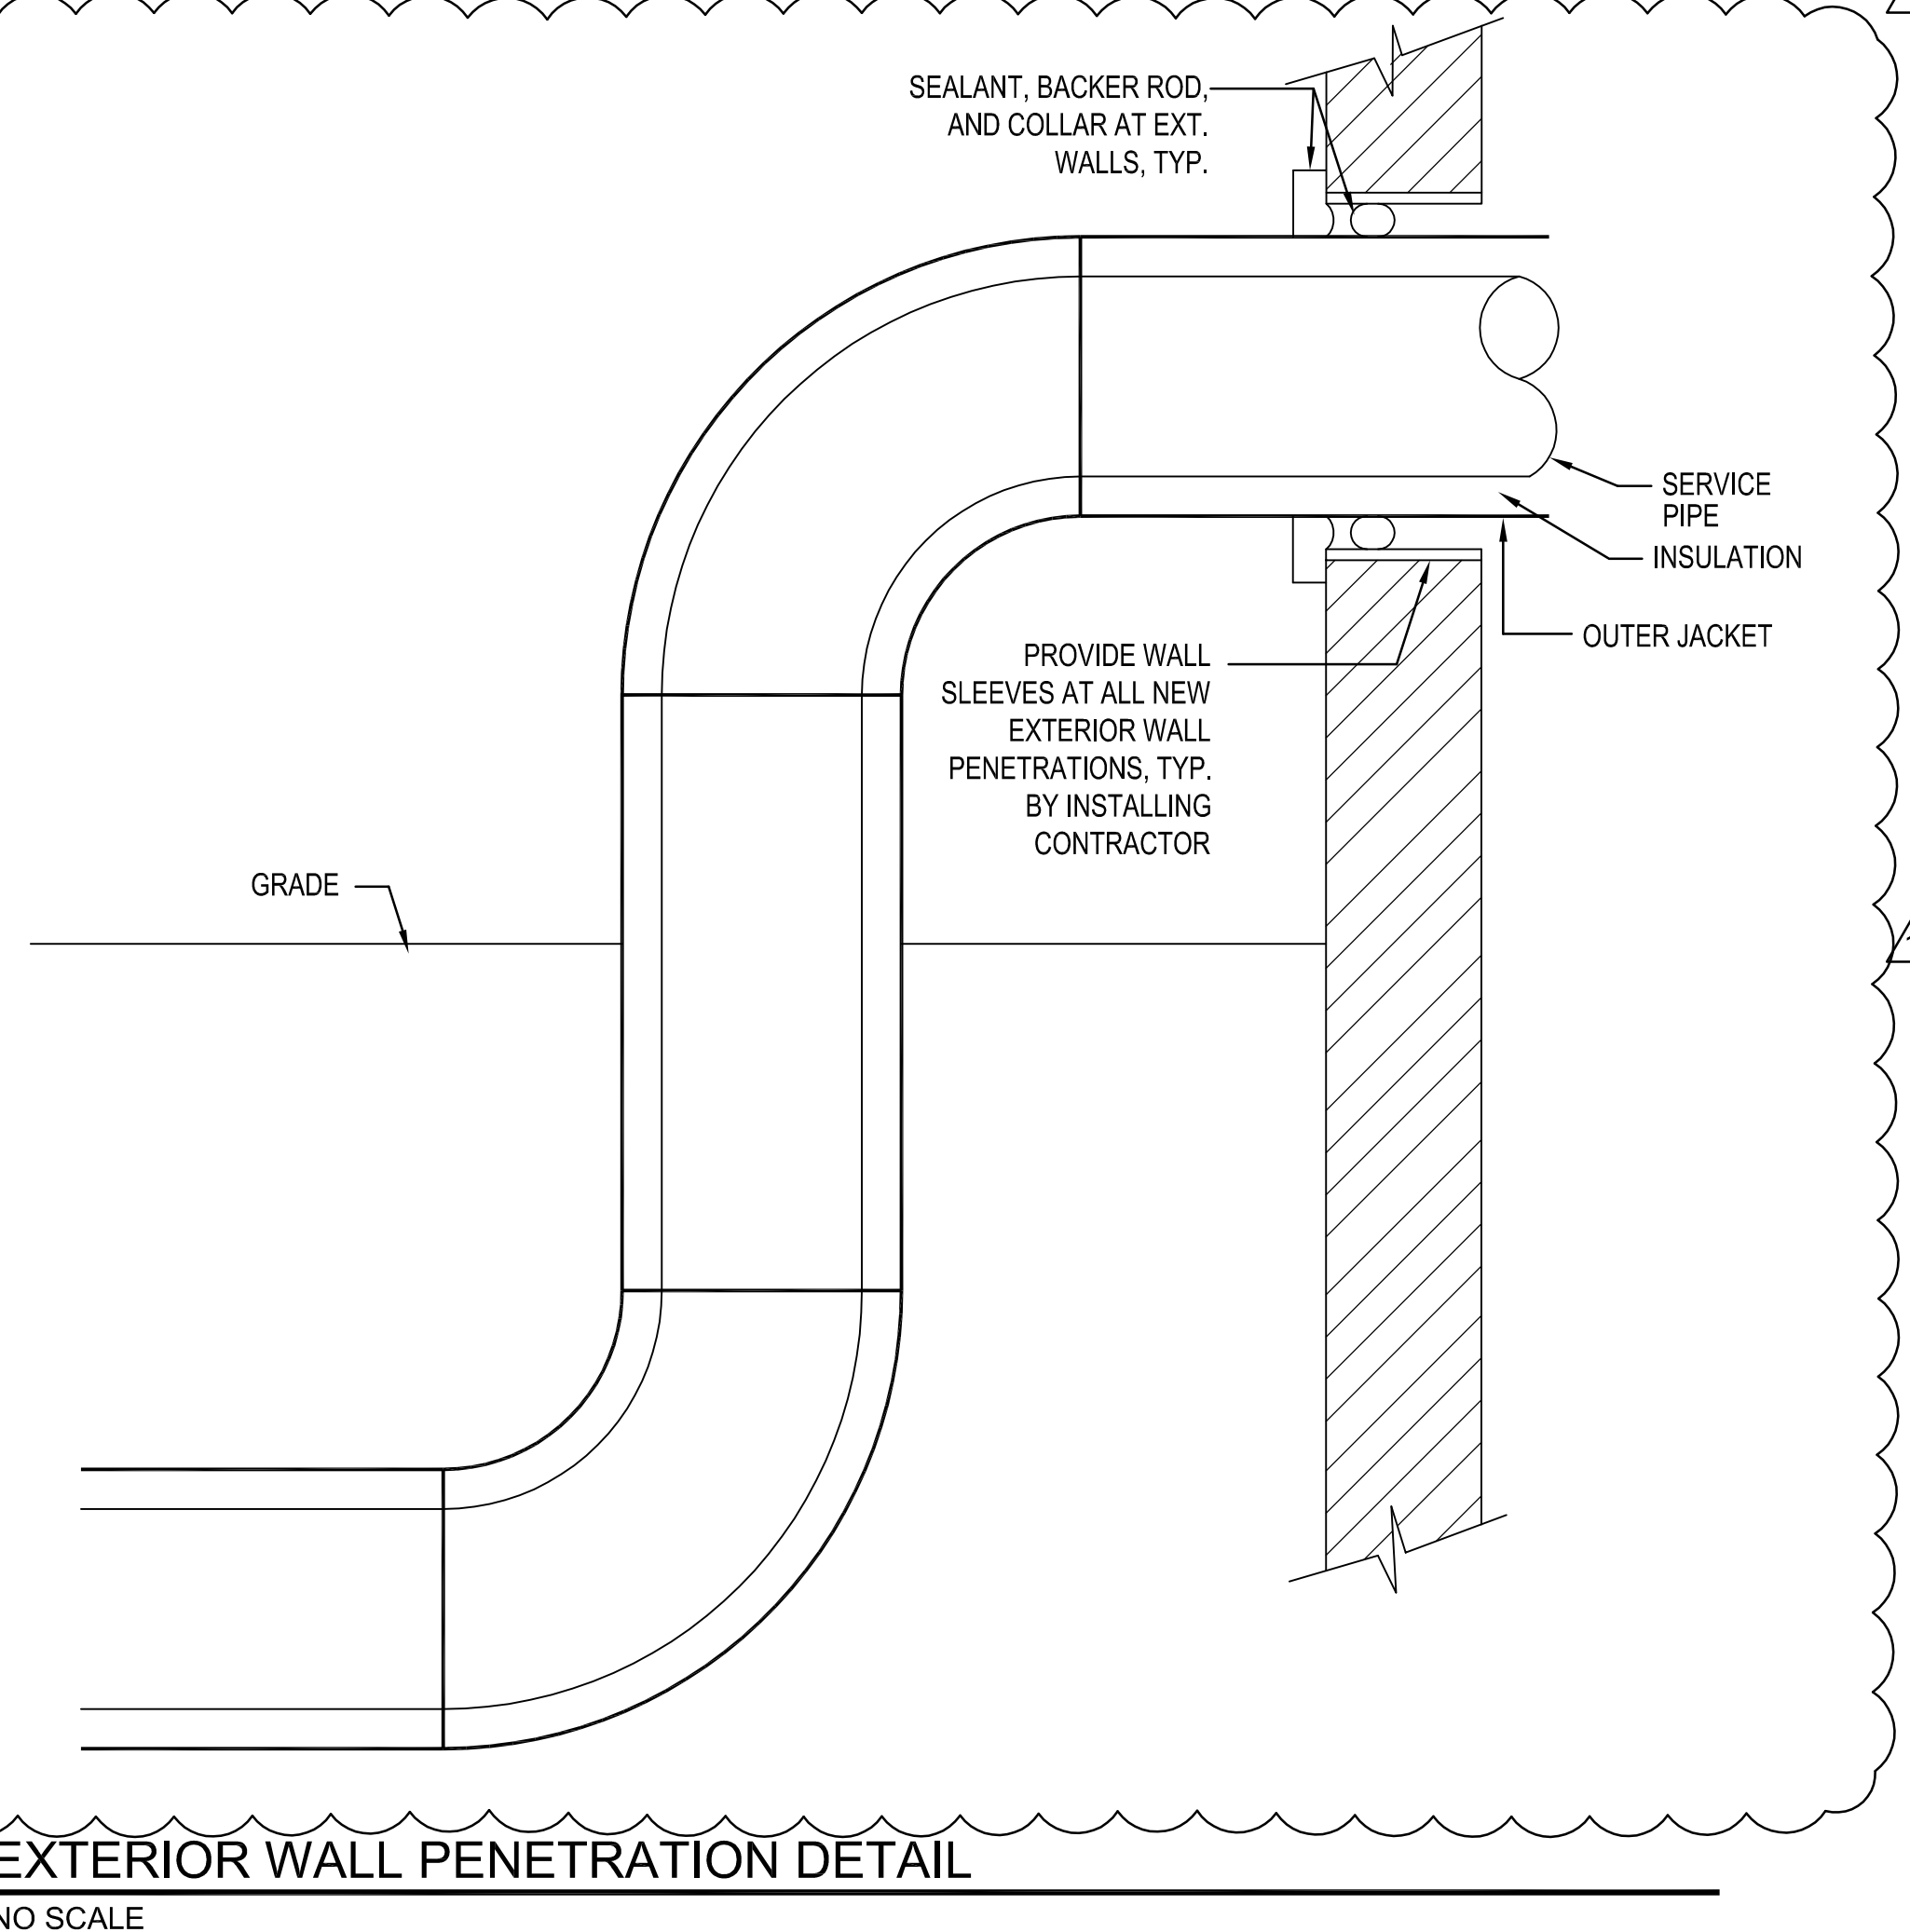

#### GENERAL

- 1. ALL MECHANICAL EQUIPMENT AND INSTALLATIONS SHALL YIELD COMPLETE OPERATIONAL SYSTEMS THAT CONFORM TO THE REQUIREMENTS OF THE APPLICABLE LOCAL ORDINANCES AND CODES INCLUDING BUT NOT LIMITED TO THE NORTH CAROLINA BUILDING CODE, NORTH CAROLINA MECHANICAL CODE, NORTH CAROLINA ENERGY CONSERVATION CODE AND UNDERWRITERS LABORATORIES (OR ETL).
- 2. THE CONTRACT DOCUMENTS ARE BASED ON EQUIPMENT OF SPECIFIC MANUFACTURERS. IF THE CONTRACTOR SUBMITS OR PROPOSES TO USE EQUIPMENT OTHER THAN THAT USED ON THE CONTRACT DOCUMENTS THEN THE CONTRACTOR SHALL BE RESPONSIBLE FOR ANY DESIGN AND INSTALLATION REVISIONS AT NO ADDITIONAL COST TO THE PROJECT. REVISIONS INCLUDE BUT ARE NOT LIMITED TO, CHANGES IN EQUIPMENT DIMENSIONS OR WEIGHT, ACCESS REQUIREMENTS, ORIENTATION AND CONNECTIONS, AND ELECTRICAL REQUIREMENTS.
- 3. EQUIPMENT OF A SIMILAR TYPE SHALL BE THE PRODUCT OF A SINGLE MANUFACTURER.
- 4. DO NOT SCALE DRAWINGS. DRAWINGS ARE DIAGRAMMATIC.
- 5. CONTRACTORS ARE TO PREPARE AND SUBMIT COORDINATION DRAWINGS IN ACCORDANCE WITH DIVISION 1 AND SPECIFIC REQUIREMENTS IN SELECTED SECTIONS OF DIVISION 23 OF THE SPECIFICATIONS.
- 6. INSTALLATION OF PIPING, DUCTWORK, AND EQUIPMENT SHALL NOT BE STARTED PRIOR TO SUBMISSION AND APPROVAL OF THE CONTRACTOR DEVELOPED COORDINATION DRAWINGS THAT INCLUDE, BUT ARE NOT LIMITED TO, SHOWING PLUMBING, FIRE SUPPRESSION, HVAC, ARCHITECTURAL, STRUCTURAL, ELECTRICAL POWER, LIGHTING AND CONTROL AND TELECOM WORK. ANY WORK INSTALLED PRIOR TO THE APPROVAL OF THE COORDINATION DRAWINGS MAY NEED TO BE REMOVED, RELOCATED, OR ADJUSTED WITH NO IMPACT ON THE PROJECT SCHEDULE OR PROJECT COST.
- 7. SHOP DRAWINGS SHALL BE SUBMITTED TO AND APPROVED BY THE ARCHITECT BEFORE ANY MECHANICAL EQUIPMENT IS ORDERED, PURCHASED, RELEASED, OR FABRICATED. SHOP DRAWINGS AND SUBMITTALS SHALL INCLUDE PRODUCT INFORMATION FOR ALL EQUIPMENT SPECIFIED OR SCHEDULED ON THE DRAWINGS. COORDINATION DRAWINGS SHALL BE COMPLETED AND REVIEWED PRIOR TO THE PURCHASING OF ANY EQUIPMENT.
- 8. ALL MECHANICAL EQUIPMENT AND MATERIALS SHALL BE INSTALLED ACCORDING TO MANUFACTURER'S RECOMMENDATIONS AND INSTALLATION INSTRUCTIONS USING MANUFACTURER RECOMMENDED ACCESSORIES AND ASSOCIATED MATERIALS.
- 9. ALL EQUIPMENT AND MATERIALS INSTALLED IN AIR PLENUMS SHALL BE COMPLIANT WITH THE REQUIREMENTS FOR PLENUM INSTALLATIONS.
- 10. BEFORE THE PROJECT IS CONSIDERED SUBSTANTIALLY COMPLETE, THE ENTIRE HVAC SYSTEM SHALL BE TESTED, ADJUSTED, AND BALANCED IN ACCORDANCE WITH AABC OR NEBS STANDARDS. TO DELIVER THE AIR AND WATER FLOW QUANTITIES SHOWN ON THE DRAWINGS. A CERTIFIED TEST AND BALANCE REPORT SHALL BE SUBMITTED TO, AND APPROVED BY THE ENGINEER. FURNISH AND INSTALL ADJUSTMENT AND BALANCING DEVICES, (DAMPERS, VALVES, AND SHEAVES) AS REQUIRED AT NO ADDITIONAL COST TO THE PROJECT.
- 11. PERMANENTLY MARK FINAL SETTINGS ON BALANCING DEVICES.
- 12. ALL MECHANICAL EQUIPMENT AND SYSTEMS SHALL BE GUARANTEED FOR A PERIOD OF TWELVE MONTHS AFTER ACCEPTANCE BY OWNER.
- 13. FURNISH AND INSTALL DUCTWORK AND PIPE TRANSITIONS REQUIRED AT EQUIPMENT CONNECTIONS.
- 14. CONTRACTOR SHALL COORDINATE THE INSTALLATION OF ALL MECHANICAL EQUIPMENT, DUCTWORK, ETC. TO FIT WITHIN THE SPACE ALLOWED BY THE ARCHITECTURAL AND STRUCTURAL CONDITIONS. CUTTING OR OTHERWISE ALTERING ANY STRUCTURAL MEMBERS SHALL NOT BE PERMITTED WITHOUT WRITTEN PERMISSION FROM THE ARCHITECT.
- 15. LOCATE ALL EQUIPMENT TO PRODUCE UNOBSTRUCTED ACCESS TO EQUIPMENT ACCESS PANELS, CONTROLS, AND VALVING.
- 16. FURNISH AND INSTALL ACCESS DOORS AND PANELS IN NON-ACCESSIBLE CEILINGS AND IN WALL STRUCTURES TO YIELD ADEQUATE SPACE FOR MAINTENANCE OF EQUIPMENT AND BALANCING

OF SYSTEMS. ACCESS DOORS AND PANELS SHALL BE INSTALLED WHERE SHOWN ON THE DRAWINGS OR AS NECESSARY TO PRODUCE ACCESS TO DAMPERS, VALVES, ETC. COORDINATE EXACT LOCATION OF ALL ACCESS PANELS AND DOORS WITH THE ARCHITECT DURING THE SHOP DRAWING PROCESS.

- 17. INSTALL ALL TEMPERATURE, PRESSURE, AND FLOW MEASURING DEVICES IN ACCESSIBLE LOCATIONS WHERE THE MANUFACTURER'S RECOMMENDED MINIMUM LENGTHS OF STRAIGHT PIPE ARE PROVIDED UPSTREAM AND DOWNSTREAM OF THE DEVICE.

#### ELECTRICAL COORDINATION


- 18. CONTRACTOR SHALL COORDINATE ELECTRICAL CHARACTERISTICS AND REQUIREMENTS OF ALL MECHANICAL EQUIPMENT WITH THE ELECTRICAL DRAWINGS AND ELECTRICAL CONTRACTOR BEFORE ANY PRODUCT INFORMATION OR SHOP DRAWINGS ARE SUBMITTED AND BEFORE ANY EQUIPMENT IS ORDERED. THE ELECTRICAL CHARACTERISTICS (VOLTAGE, PHASE, OVERLOAD PROTECTION, ETC.) OF THE EQUIPMENT FURNISHED SHALL BE COMPATIBLE WITH THE ELECTRICAL CHARACTERISTICS SHOWN ON THE DRAWINGS. ON SHOP DRAWING SUBMITTALS THE MECHANICAL CONTRACTOR SHALL STATE THAT THE ELECTRICAL CHARACTERISTICS OF ALL EQUIPMENT HAS BEEN COORDINATED WITH THE ELECTRICAL CONTRACT DOCUMENTS AND THE ELECTRICAL CONTRACTOR.
- 19. ALL MECHANICAL EQUIPMENT REQUIRING ELECTRICAL POWER SHALL BE INSTALLED WITH DISCONNECT SWITCHES AND STARTERS WHETHER THEY ARE AN INTEGRAL COMPONENT OF THE MANUFACTURER'S EQUIPMENT OR NOT. COORDINATE SWITCH TYPE (FUSED OR NON-FUSED) WITH EQUIPMENT CHARACTERISTICS, MANUFACTURER'S RECOMMENDATIONS, ELECTRICAL DRAWINGS, AND ELECTRICAL CONTRACTOR.
- 20. ALL REQUIRED CONTROL WIRING FOR HVAC AND PLUMBING, INCLUDING POWER WIRING REQUIRED FOR CONTROL PANELS, ACTUATORS, DEVICES, ETC., SHALL BE INCLUDED AS PART OF THE MECHANICAL WORK. WIRING, INCLUDING THAT IN HVAC PLENUM SPACES, SHALL BE INSTALLED ACCORDING TO CODE REQUIREMENTS.
- 21. UNLESS NOTED OTHERWISE, STARTERS, TRANSFORMERS, CONTROLS, AND CONTROL WIRING REQUIRED FOR ALL MECHANICAL SYSTEMS SHALL BE FURNISHED AND INSTALLED BY THE MECHANICAL CONTRACTOR. SEE ELECTRICAL SPECIFICATIONS FOR WIRING REQUIREMENTS.

#### PROTECTION OF RATED ASSEMBLIES

- 22. ALL PIPE PASSING THROUGH FIRE-RATED AND SMOKE-RATED ASSEMBLIES SHALL BE FIRE-STOPPED AS REQUIRED TO PRODUCE A RATED ASSEMBLY. FIRE BARRIER PRODUCTS SHALL BE AS MANUFACTURED BY 3M CO., HILTI INC., OR OTHER APPROVED MANUFACTURER. ACCEPTABLE PRODUCTS ARE HILTI FS-ONE, CP 606, CP648 WRAP STRIP, OR CP680 CAST-IN DEVICE SYSTEMS, OR AS RECOMMENDED BY THE MANUFACTURER FOR A PARTICULAR APPLICATION OR AN EQUIVALENT SYSTEM AS APPROVED BY LOCAL CODE OFFICIALS.

#### HYDRONIC PIPING AND FLUES

- 23. SLOPE ALL HORIZONTAL STEAM AND STEAM CONDENSATE PIPING AND GAS FLUE PIPING MINIMUM 1/4-INCHES PER FOOT.
- 24. INSTALL MANUAL AIR VENTS AT HIGH POINTS OF ALL CIRCULATING WATER PIPING SYSTEMS.
- 25. PIPING AT PUMPS AND EQUIPMENT SHALL BE SUPPORTED SO THAT NO PIPING OR ACCESSORY LOAD IS CARRIED BY THE PUMP, EQUIPMENT, OR FLEX CONNECTORS.
- 26. FOR ALL HYDRONIC AND STEAM PIPING, THE MINIMUM PIPE SIZE SHALL BE 3/4-INCHES DIAMETER. LONG RADIUS ELBOWS SHALL BE USED, AND UNLESS INDICATED OTHERWISE, PIPING SHALL BE INSTALLED BENEATH DUCTWORK.
- 27. PIPING SHALL BE INSTALLED SO THAT ALL VALVES, STRAINERS, TRAPS UNIONS, TRAPS, FLANGES, AND OTHER APPURTENANCES REQUIRING ACCESS ARE ACCESSIBLE.
- 28. VALVES AND SPECIALTIES SHALL BE LINE SIZE UNLESS INDICATED OTHERWISE. VALVES SHALL BE INSTALLED IN LOCATIONS SO THAT THE VALVES REMAIN IN SERVICE WHEN THE EQUIPMENT OR PIPING IS REMOVED.
- 29. VALVES SHALL HAVE POSITION INDICATORS. BALANCING VALVES SHALL HAVE ADJUSTABLE MEMORY STOPS.
- 30. AT EQUIPMENT CONNECTIONS LOCATE PIPING TRANSITIONS BETWEEN EQUIPMENT AND VALVES AND STRAINERS.
- 31. ALL PIPING ABOVE GRADE SHALL BE SUPPORTED BY THE BUILDING STRUCTURE AND SHALL NOT REST ON CEILING TILES OR THE CEILING SUPPORT STRUCTURE. PIPING HUNG FROM JOISTS SHALL BE HUNG FROM THE TOP CHORDS OF THE JOISTS.
- 32. ISOLATION VALVES SHALL BE INCLUDED AND INSTALLED IN ALL PIPES CONNECTED TO EACH PIECE OF EQUIPMENT AND PIPING ACCESSORY FOR WHICH MAINTENANCE OR REPLACEMENT OF THE EQUIPMENT OR ACCESSORY WOULD REQUIRE SYSTEM SHUT-DOWN.

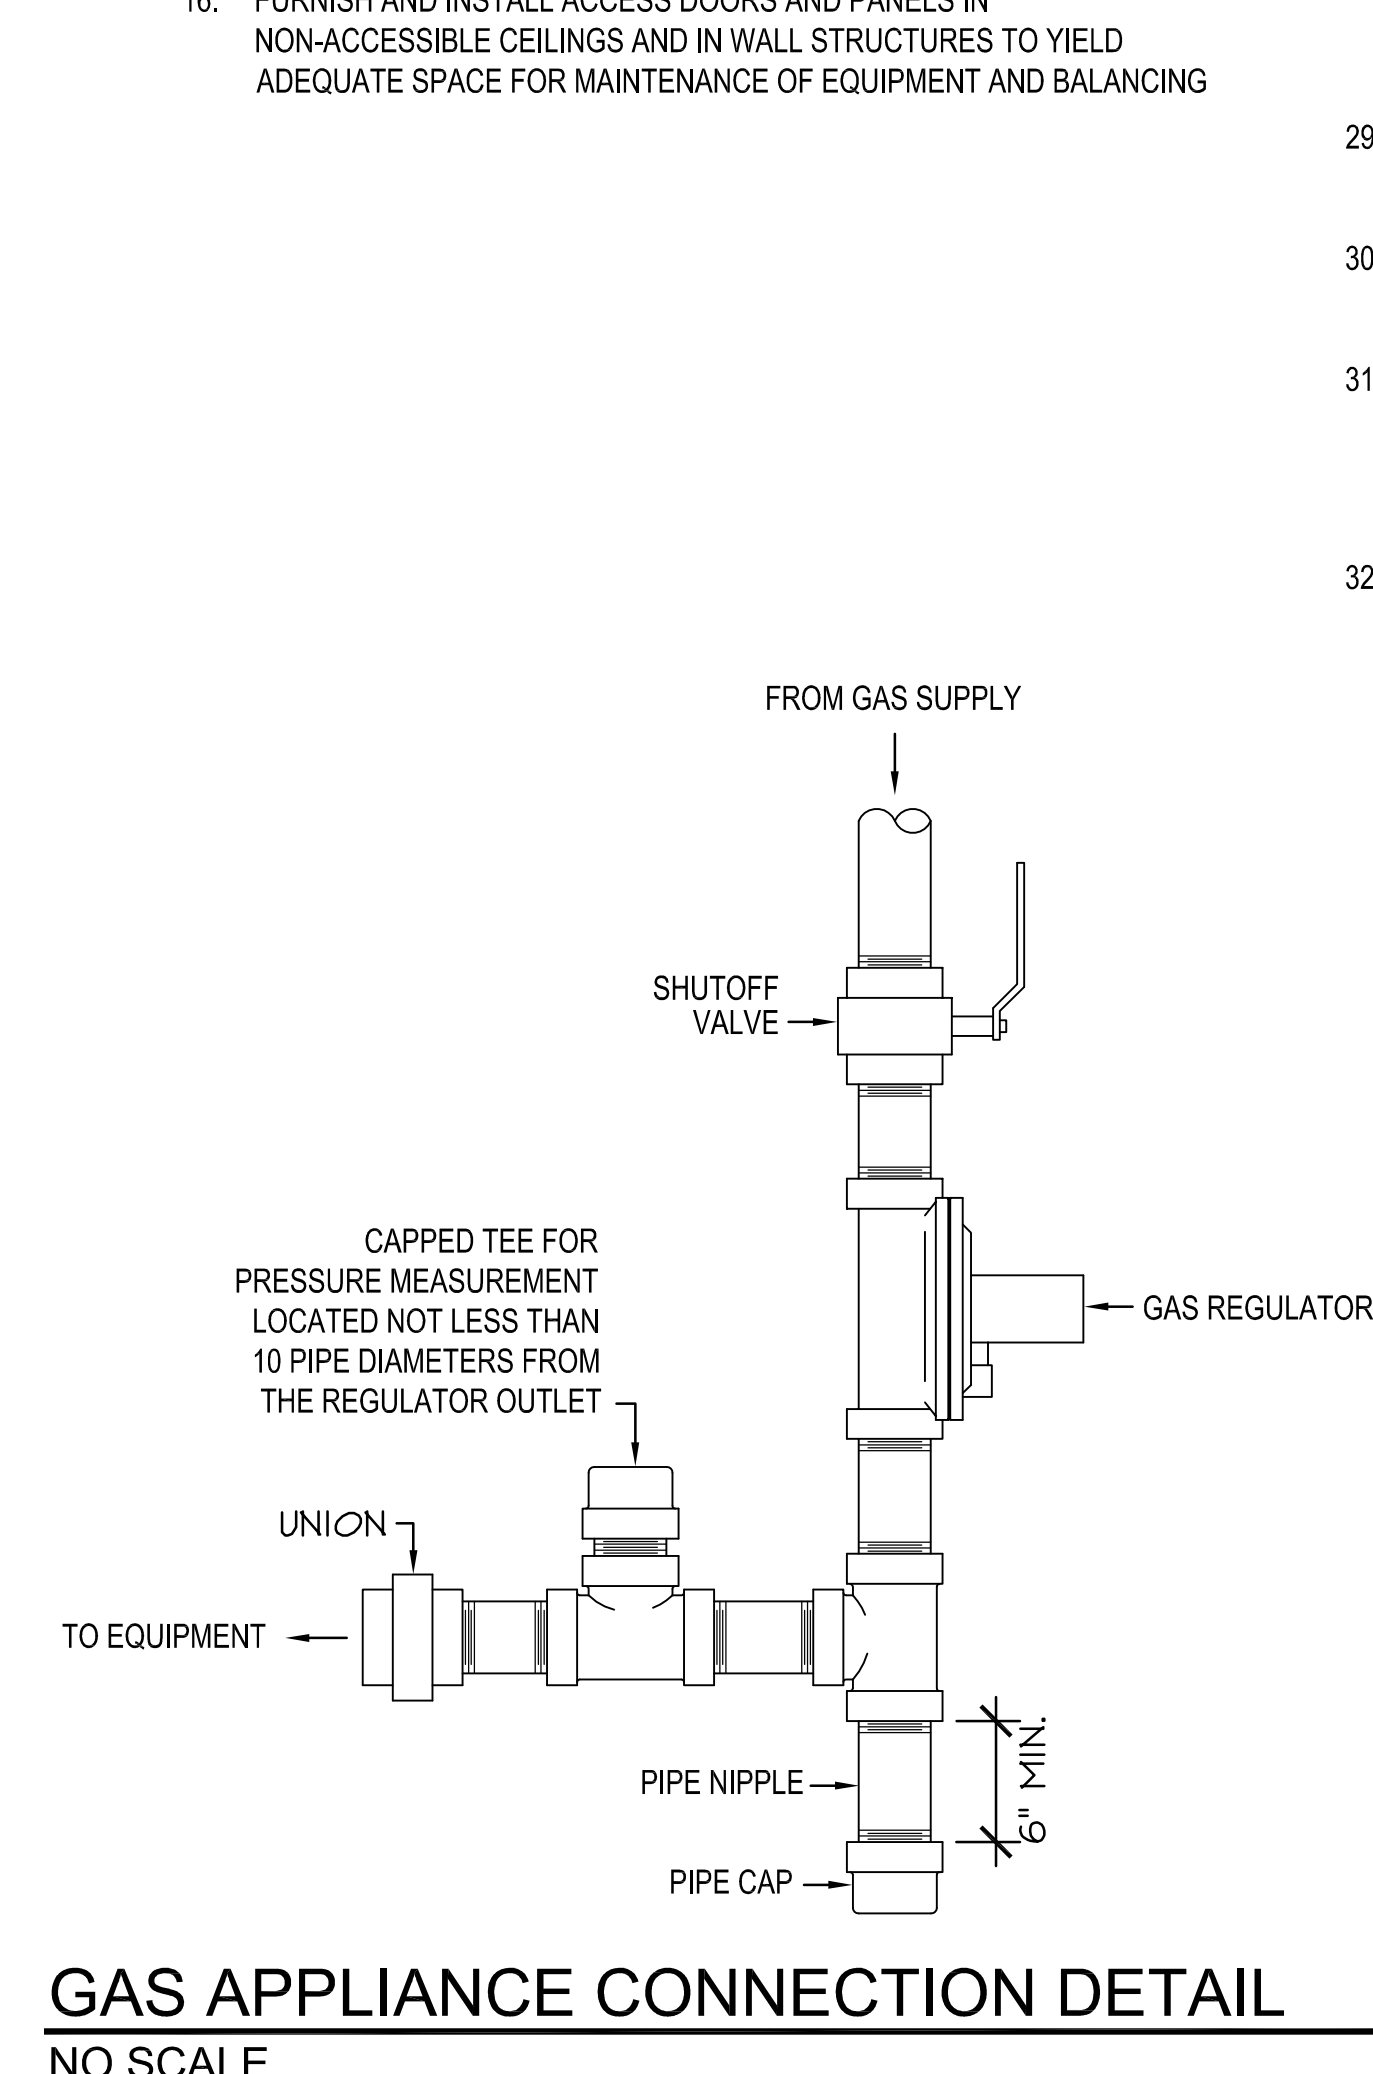

UNC CHARLOTTE  
Sciences Building - Existing  
Building Heating Conversions  
9201 University City Boulevard  
Charlotte, NC 28223

SCO ID Number: 16-14355-02B  
Code: 46626  
Item: 301  
DESIGNER  
CLARK NEXSEN

1523 Elizabeth Avenue, Suite 300  
Charlotte, NC 28204  
704.377.8800  
CLARK NEXSEN INC.  
50680  
NC Corporate Engineering License #: C-1028

CONSULTANT  
SEALS  
SUBMITTAL

20 November 2017  
Bid Documents

REVISIONS  
11/20/17 ADDENDUM #1


MECHANICAL LEGENDS AND NOTES  
ME001  
DESIGN CNE  
DRAWING CNE  
REVIEW DAC  
CN 6222



PANEL TB1 SCHEDULE															
CKT. NO.	LOAD DESCRIPTION	800 AMP MCB			480Y/277 VOLTS			3PH, 4W, 3N			SURFACE MOUNTED			SE RATED	NEMA 3R
		COND. SIZE	WIRE SIZE	BKR TRIP	AMPS	KVA	PH	KVA	AMPS	BKR TRIP	WIRE SIZE	COND. SIZE	LOAD DESCRIPTION		
1	PBR-1	1-1/2	1	125	95.0	26.3	A	21.3	77.0	125	1	1-1/2	P-7		2
3	PBR-2	1-1/2	1	125	95.0	26.3	A	21.3	77.0	125	1	1-1/2	P-8		4
5	EUH-1	3/4	12	15	4.0	1.1	A	3.1	1.1						6
7	BUSSED SPACE				4.0	1.1	A	3.1	1.1						8
9	BUSSED SPACE				4.0	1.1	A	3.1	1.1						10
TOTAL AMPS (CONN. LOAD)					A: 348.1			B: 348.1			C: 348.1				
TOTAL AMPS (FEEDTHRU)					A: 348.1			B: 348.1			C: 348.1				
TOTAL AMPS (CONN. LOAD + FEED-THRU)					A: 348.1			B: 348.1			C: 348.1				


PANEL 05HM2 SCHEDULE															
CKT. NO.	LOAD DESCRIPTION	100 AMP MLO			480Y/277 VOLTS			3PH, 4W, 3N			SURFACE MOUNTED			SE RATED	NEMA 3R
		COND. SIZE	WIRE SIZE	BKR TRIP	AMPS	KVA	PH	KVA	AMPS	BKR TRIP	WIRE SIZE	COND. SIZE	LOAD DESCRIPTION		
1	P-1	3/4	12	15	4.8	1.3	A	3.6	1.3						2
3					4.8	1.3	A	3.6	1.3						4
5					4.8	1.3	A	3.6	1.3						6
7	P-2	3/4	12	15	4.8	1.3	A	3.6	1.3						8
9					4.8	1.3	A	3.6	1.3						10
11					4.8	1.3	A	3.6	1.3						12
13	P-3	3/4	12	20	11.0	3.0	A	8.3	3.0						14
15					11.0	3.0	A	8.3	3.0						16
17	P-4	3/4	12	20	11.0	3.0	A	8.3	3.0						18
19					11.0	3.0	A	8.3	3.0						20
21					11.0	3.0	A	8.3	3.0						22
23					11.0	3.0	A	8.3	3.0						24
25	BUSSED SPACE				11.0	3.0	A	8.3	3.0						26
27	BUSSED SPACE				11.0	3.0	A	8.3	3.0						28
29	BUSSED SPACE				11.0	3.0	A	8.3	3.0						30
TOTAL AMPS (CONN. LOAD)					A: 31.6			B: 31.6			C: 31.6				
TOTAL AMPS (FEEDTHRU)					A: 31.6			B: 31.6			C: 31.6				
TOTAL AMPS (CONN. LOAD + FEED-THRU)					A: 31.6			B: 31.6			C: 31.6				

EXISTING PANEL DATA				
BUILDING	PANEL NAME	VOLTAGE	MANUFACTURER	TYPE
CAMERON	BP	208Y/120V	WESTINGHOUSE	POW-R-LINE C, PRL1
FRIDAY	M	208Y/120V	WESTINGHOUSE	810B
MCENIRY	LMC	208Y/120V	SQUARE D	NGOOD
SMITH	R125	208Y/120V	SQUARE D	NO
	MSB	480Y/277V	SQUARE D	QED2 SWITCHBOARD

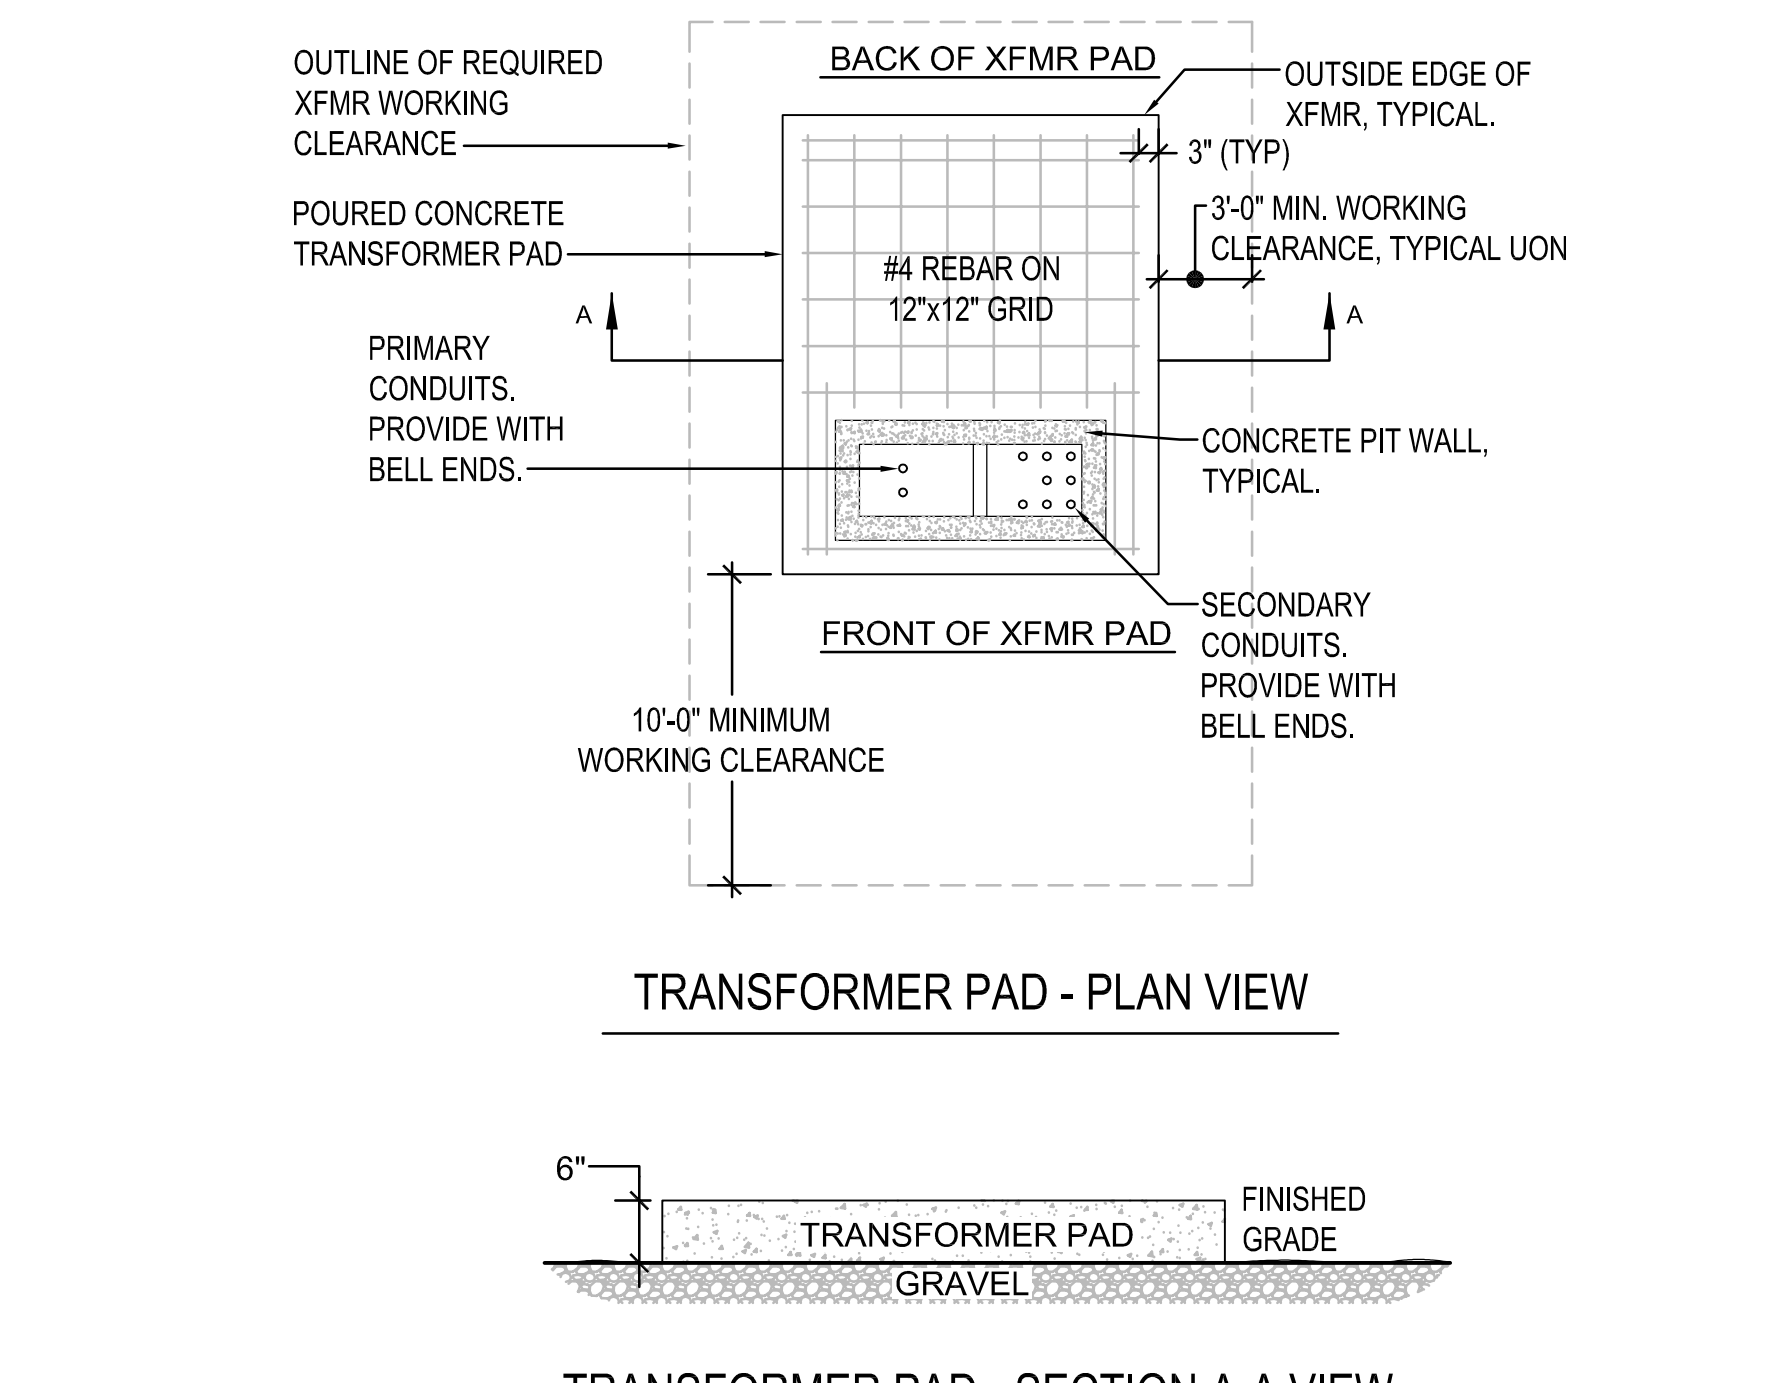


- TRANSFORMER PAD NOTES**
- TRANSFORMER PADS SHALL BE INSTALLED IN A LOCATION TO REMAIN READILY ACCESSIBLE FOR LINE TRUCKS.
  - SOIL UNDERNEATH PADS SHALL BE FREE OF ROOTS AND OTHER ORGANIC MATERIALS AND BE THOROUGHLY TAMPED TO PREVENT WASHING. EXERCISE CARE IN BACKFILLING AND GRADING AROUND PAD.
  - REINFORCE WITH #4 REBARS ON A 12" x 12" GRID TIED SECURELY 3" ABOVE BASE ON CLEAN CONCRETE OR BRICK SUPPORTS. END OF REBARS TO BE 3" FROM OUTSIDE EDGE OF PAD.
  - CONCRETE TO BE 5-12% AIR-ENTRAINED WITH A MINIMUM 28 DAY STRENGTH OF 3000 PSI. MIXTURE TO BE 1:2:4 PROPORTIONS OF CEMENT, SAND AND GRAVEL. USE NO MORE THAN 6 GALLONS OF WATER PER SACK OF CONCRETE.
  - TOP SURFACE TO BE LEVEL SMOOTH AND BEVELED APPROXIMATELY 3/8".
  - SERVICE CONDUIT SHALL BE LOCATED IN THE EXTREME RIGHT SIDE OF THE SECONDARY COMPARTMENT.
  - FOR SPECIAL CIRCUMSTANCES CONTACT THE UNIVERSITY'S ELECTRICAL DEPARTMENT MANAGER.
  - ACTUAL PAD DIMENSIONS VARY BY MANUFACTURER. CONTRACTOR SHALL COORDINATE REQUIRED PAD DIMENSIONS WITH MANUFACTURER OF TRANSFORMER PROVIDED.
  - PAD SHALL EXTEND 6" BEYOND FOOTPRINT OF TRANSFORMER PROVIDED.

**3 SERVICE TRANSFORMER PAD DETAIL**  
NO SCALE

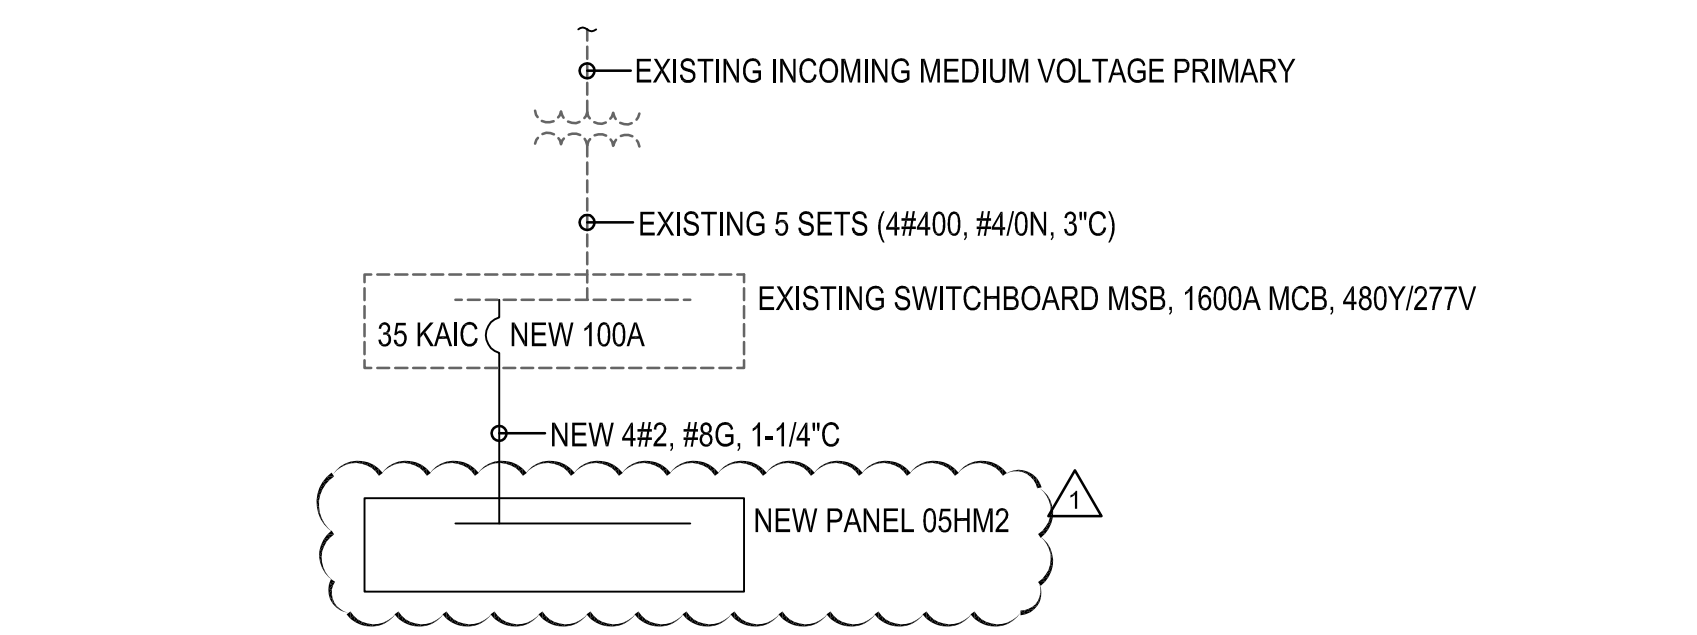

**5 NEW-TO-EXISTING DUCTBANK TIE-IN DETAIL**  
NO SCALE

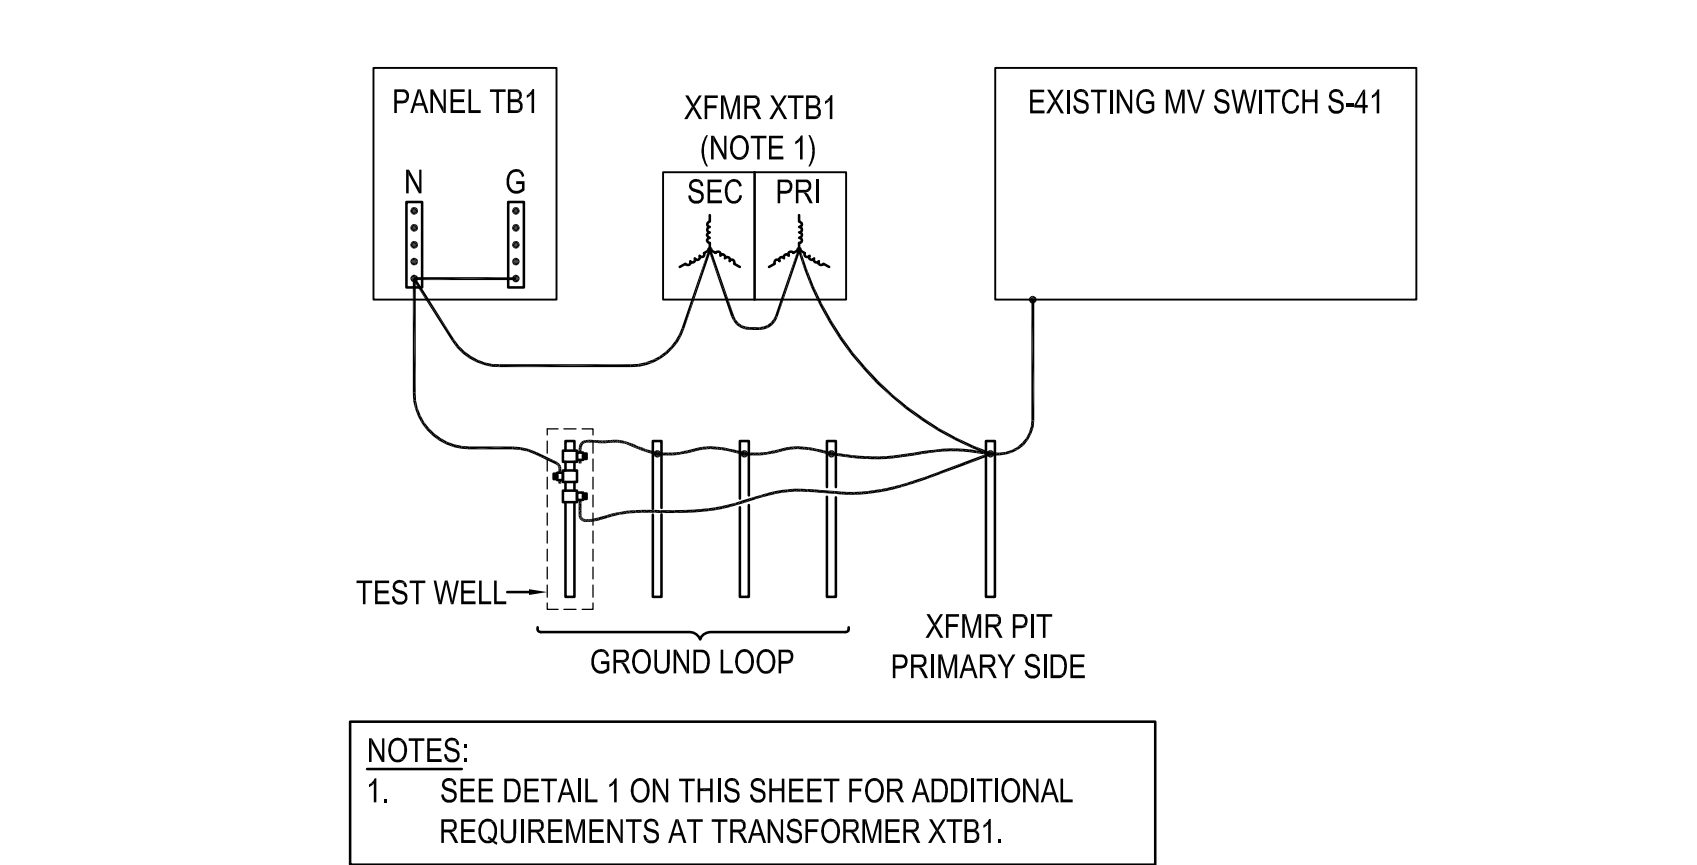


**2 SERVICE GROUNDING DETAIL - PORTABLE BOILER ROOMS**  
NO SCALE

EQUIPMENT CONNECTION SCHEDULE													
TAG	DESCRIPTION	LOCATION	EQUIPMENT RATINGS					STARTER	DISCONNECT DATA (NOTE 1)				
			HP / WATTS	VOLT	PH	FLA	KVA		OCPD	TYPE	TYPE	RATING	OCPD
PBR-1	PORTABLE BOILER ROOM	EXTERIOR (SEE SITE PLAN)	---	480	3	95.0	78.98	125	---	MANUF	MANUF	MANUF	
PBR-2	PORTABLE BOILER ROOM	EXTERIOR (SEE SITE PLAN)	---	480	3	95.0	78.98	125	---	MANUF	MANUF	MANUF	
P-7	BOILER PUMP	EXTERIOR (SEE SITE PLAN)	60 HP	480	3	77.0	64.02	125	VFD	MANUF	MANUF	MANUF	
P-8	BOILER PUMP	EXTERIOR (SEE SITE PLAN)	60 HP	480	3	77.0	64.02	125	VFD	MANUF	MANUF	MANUF	
P-1	LEADSTANDBY IN-LINE CENTRIFUGAL PUMP	SMITH (SEE PLANS)	3 HP	480	3	4.8	3.99	15	CTLR	MANUF	MANUF	MANUF	
P-2	LEADSTANDBY IN-LINE CENTRIFUGAL PUMP	SMITH (SEE PLANS)	3 HP	480	3	4.8	3.99	15	CTLR	MANUF	MANUF	MANUF	
P-3	LEADSTANDBY IN-LINE CENTRIFUGAL PUMP	SMITH (SEE PLANS)	7.5 HP	480	3	11.0	9.15	20	CTLR	MANUF	MANUF	MANUF	
P-4	LEADSTANDBY IN-LINE CENTRIFUGAL PUMP	SMITH (SEE PLANS)	7.5 HP	480	3	11.0	9.15	20	CTLR	MANUF	MANUF	MANUF	
EUH-1	ELECTRIC UNIT HEATER	PUMP HOUSE TRAILER	3.3 KW	480	3	4.0	3.30	15	MRS	MANUF	MANUF	MANUF	

**SCHEDULE ABBREVIATIONS**  
MANUF: PROVIDE IN ACCORDANCE WITH MANUFACTURER'S RECOMMENDATION  
VFD: VARIABLE FREQUENCY DRIVE  
MRS: MOTOR RATED SWITCH  
CTLR: LEADSTANDBY PUMP CONTROLLER  
OCPD: OVERCURRENT PROTECTIVE DEVICE


**SCHEDULE NOTES:**  
1. EQUIPMENT DISCONNECTS SHALL BE PROVIDED AND INSTALLED WITHIN SIGHT OF EQUIPMENT SERVED BY DISCONNECT SWITCH. SEE DETAIL 3 ON SHEET ME001 FOR ADDITIONAL INSTRUCTIONS.

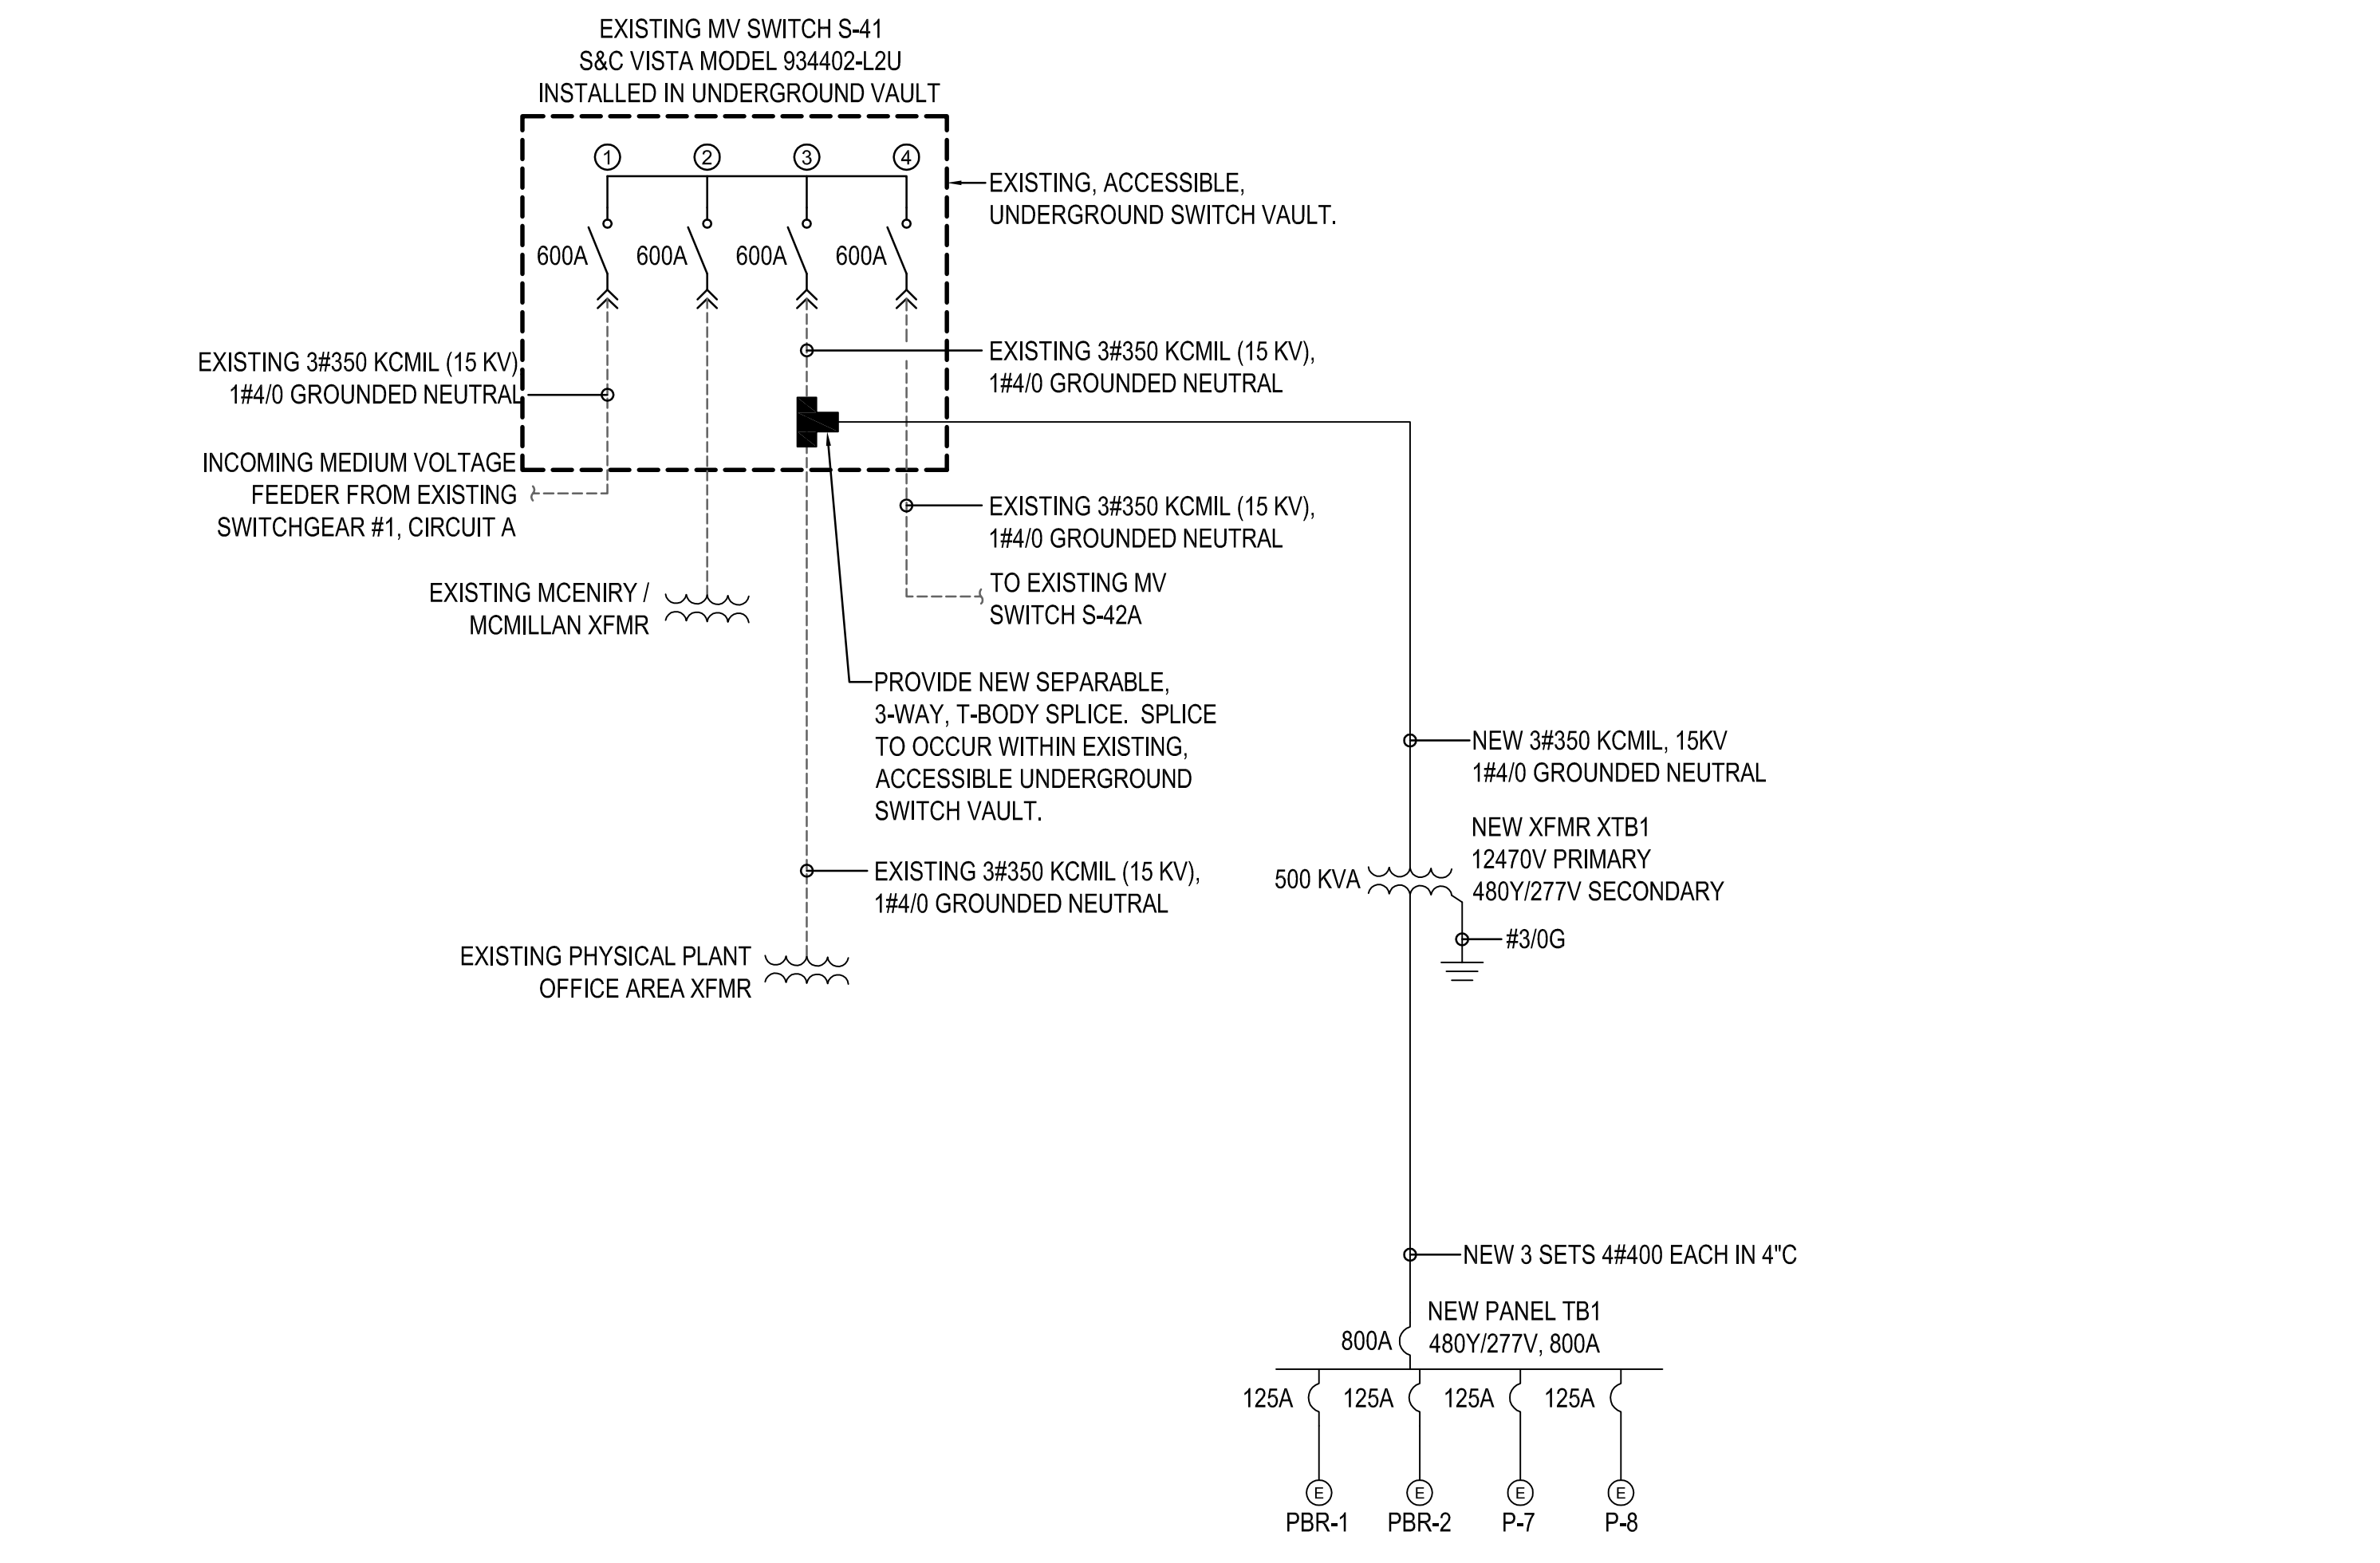



**4 SINGLE-LINE MV AND 600V POWER DISTRIBUTION DIAGRAM**  
NO SCALE

**SERVICE XFMR GROUNDING NOTES**

- THE PRIMARY NEUTRAL CONDUCTOR SHALL BE BONDED CONTINUOUSLY TO THE PRIMARY CONDUIT (IF METALLIC), THE GROUND ROD, THE XFMR TANK GROUND PAD IN THE PRIMARY COMPARTMENT, AND THE HO/XO NEUTRAL BUSHING.
- THE ELBOWS AND THE PRIMARY CABLE SHIELD SHALL BE GROUNDED TO THE NEUTRAL CONDUCTOR.
- A #4 COPPER GROUND WIRE SHALL BE BONDED TO THE HO/XO BUSHING, TO THE GROUND PAD IN THE SECONDARY COMPARTMENT, TO THE SECONDARY CONDUIT (IF METALLIC), AND TO THE GROUND ROD.
- GROUND STRAP MUST CONNECT THE HO/XO BUSHING TO THE TRANSFORMER TANK.
- A SUITABLE FLEXIBLE #6 COPPER ARRESTER LEAD SHALL BE INSTALLED FROM EACH ARRESTER DIRECTLY TO THE GROUND ROD (NOT SHOWN).
- THE PRIMARY AND SECONDARY CONDUITS SHALL EXTEND TWELVE INCHES ABOVE FINISHED GRADE IN PIT.
- IF THE RESISTANCE OF THE GROUND ROD EXCEEDS 5 OHMS, INSTALL AN ADDITIONAL GROUND ROD AT LEAST 10' AWAY. INTERCONNECT THE TWO USING #4 COPPER GROUND WIRE.
- COMPLETE INSTALLATION SHALL BE IN COMPLIANCE WITH THE NATIONAL ELECTRICAL SAFETY CODE, ANSI C2.
- PERFORM ALL TERMINATIONS, CONNECTIONS AND GROUNDING IN THE PAD AND PROVIDE GROUND RODS.

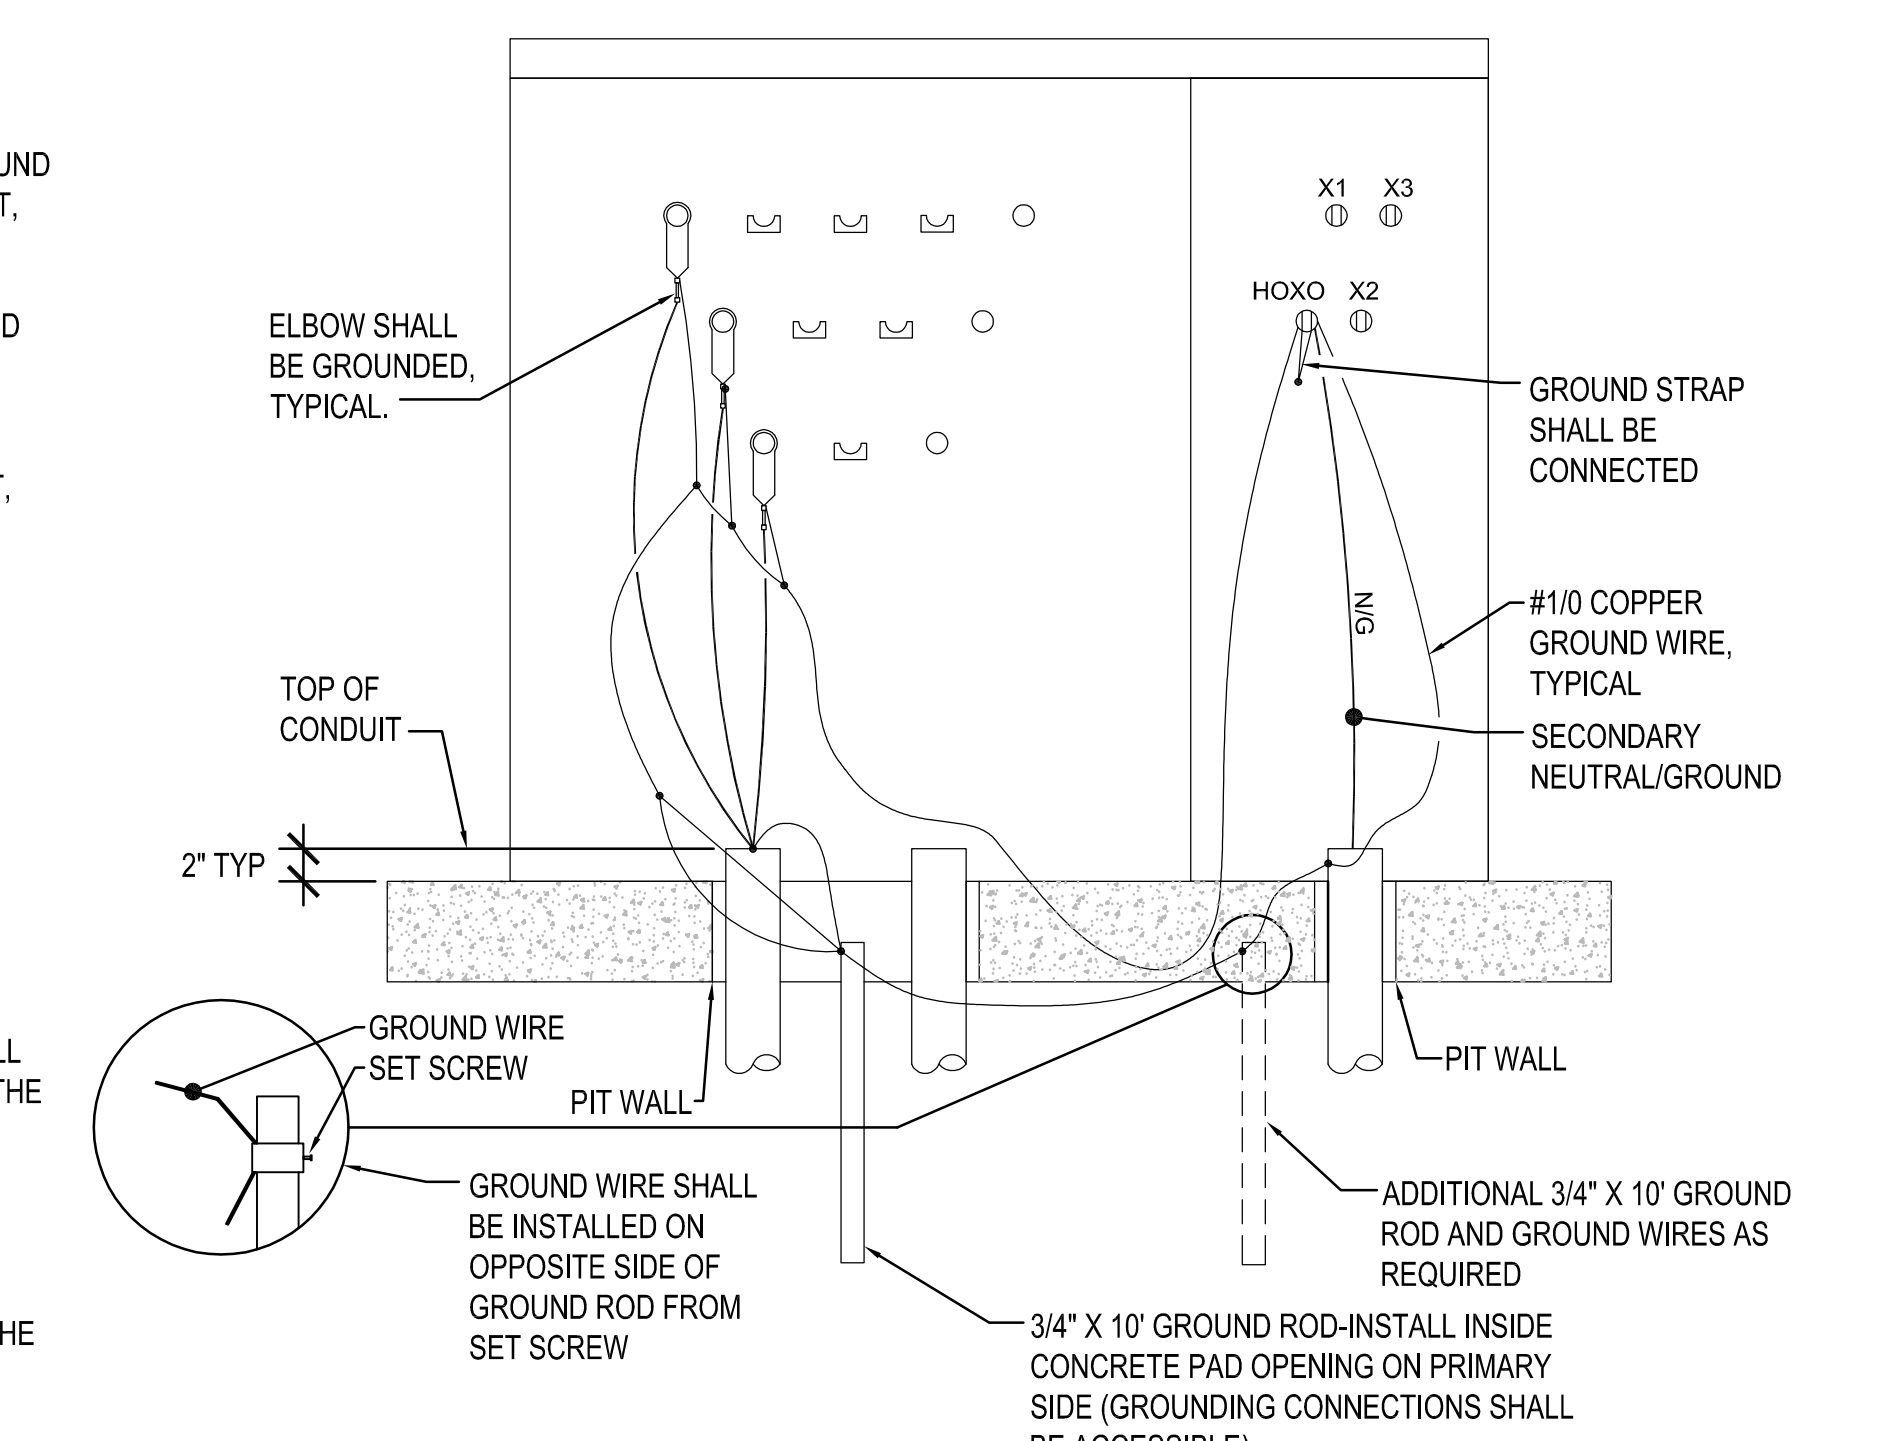

**1 SERVICE XFMR GROUNDING DETAIL**  
NO SCALE

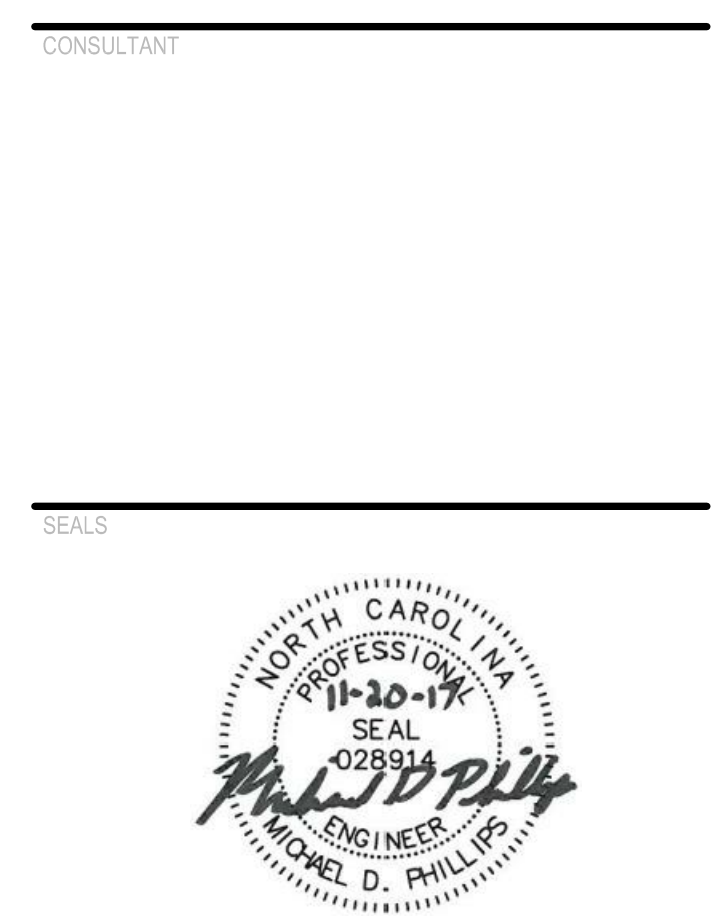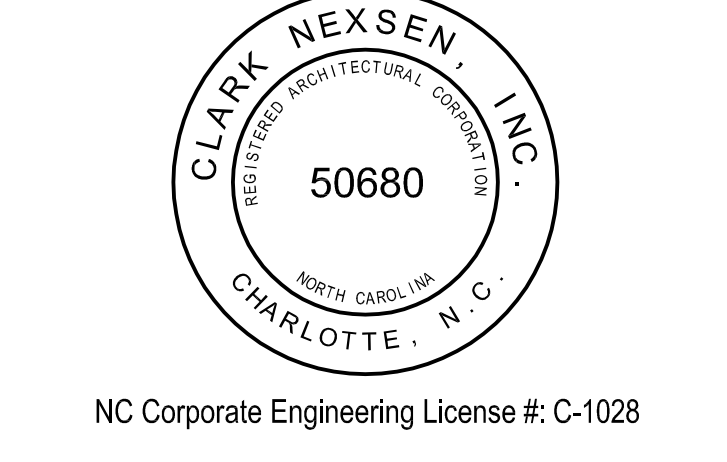


REVISIONS
11/20/17 ADDENDUM #1








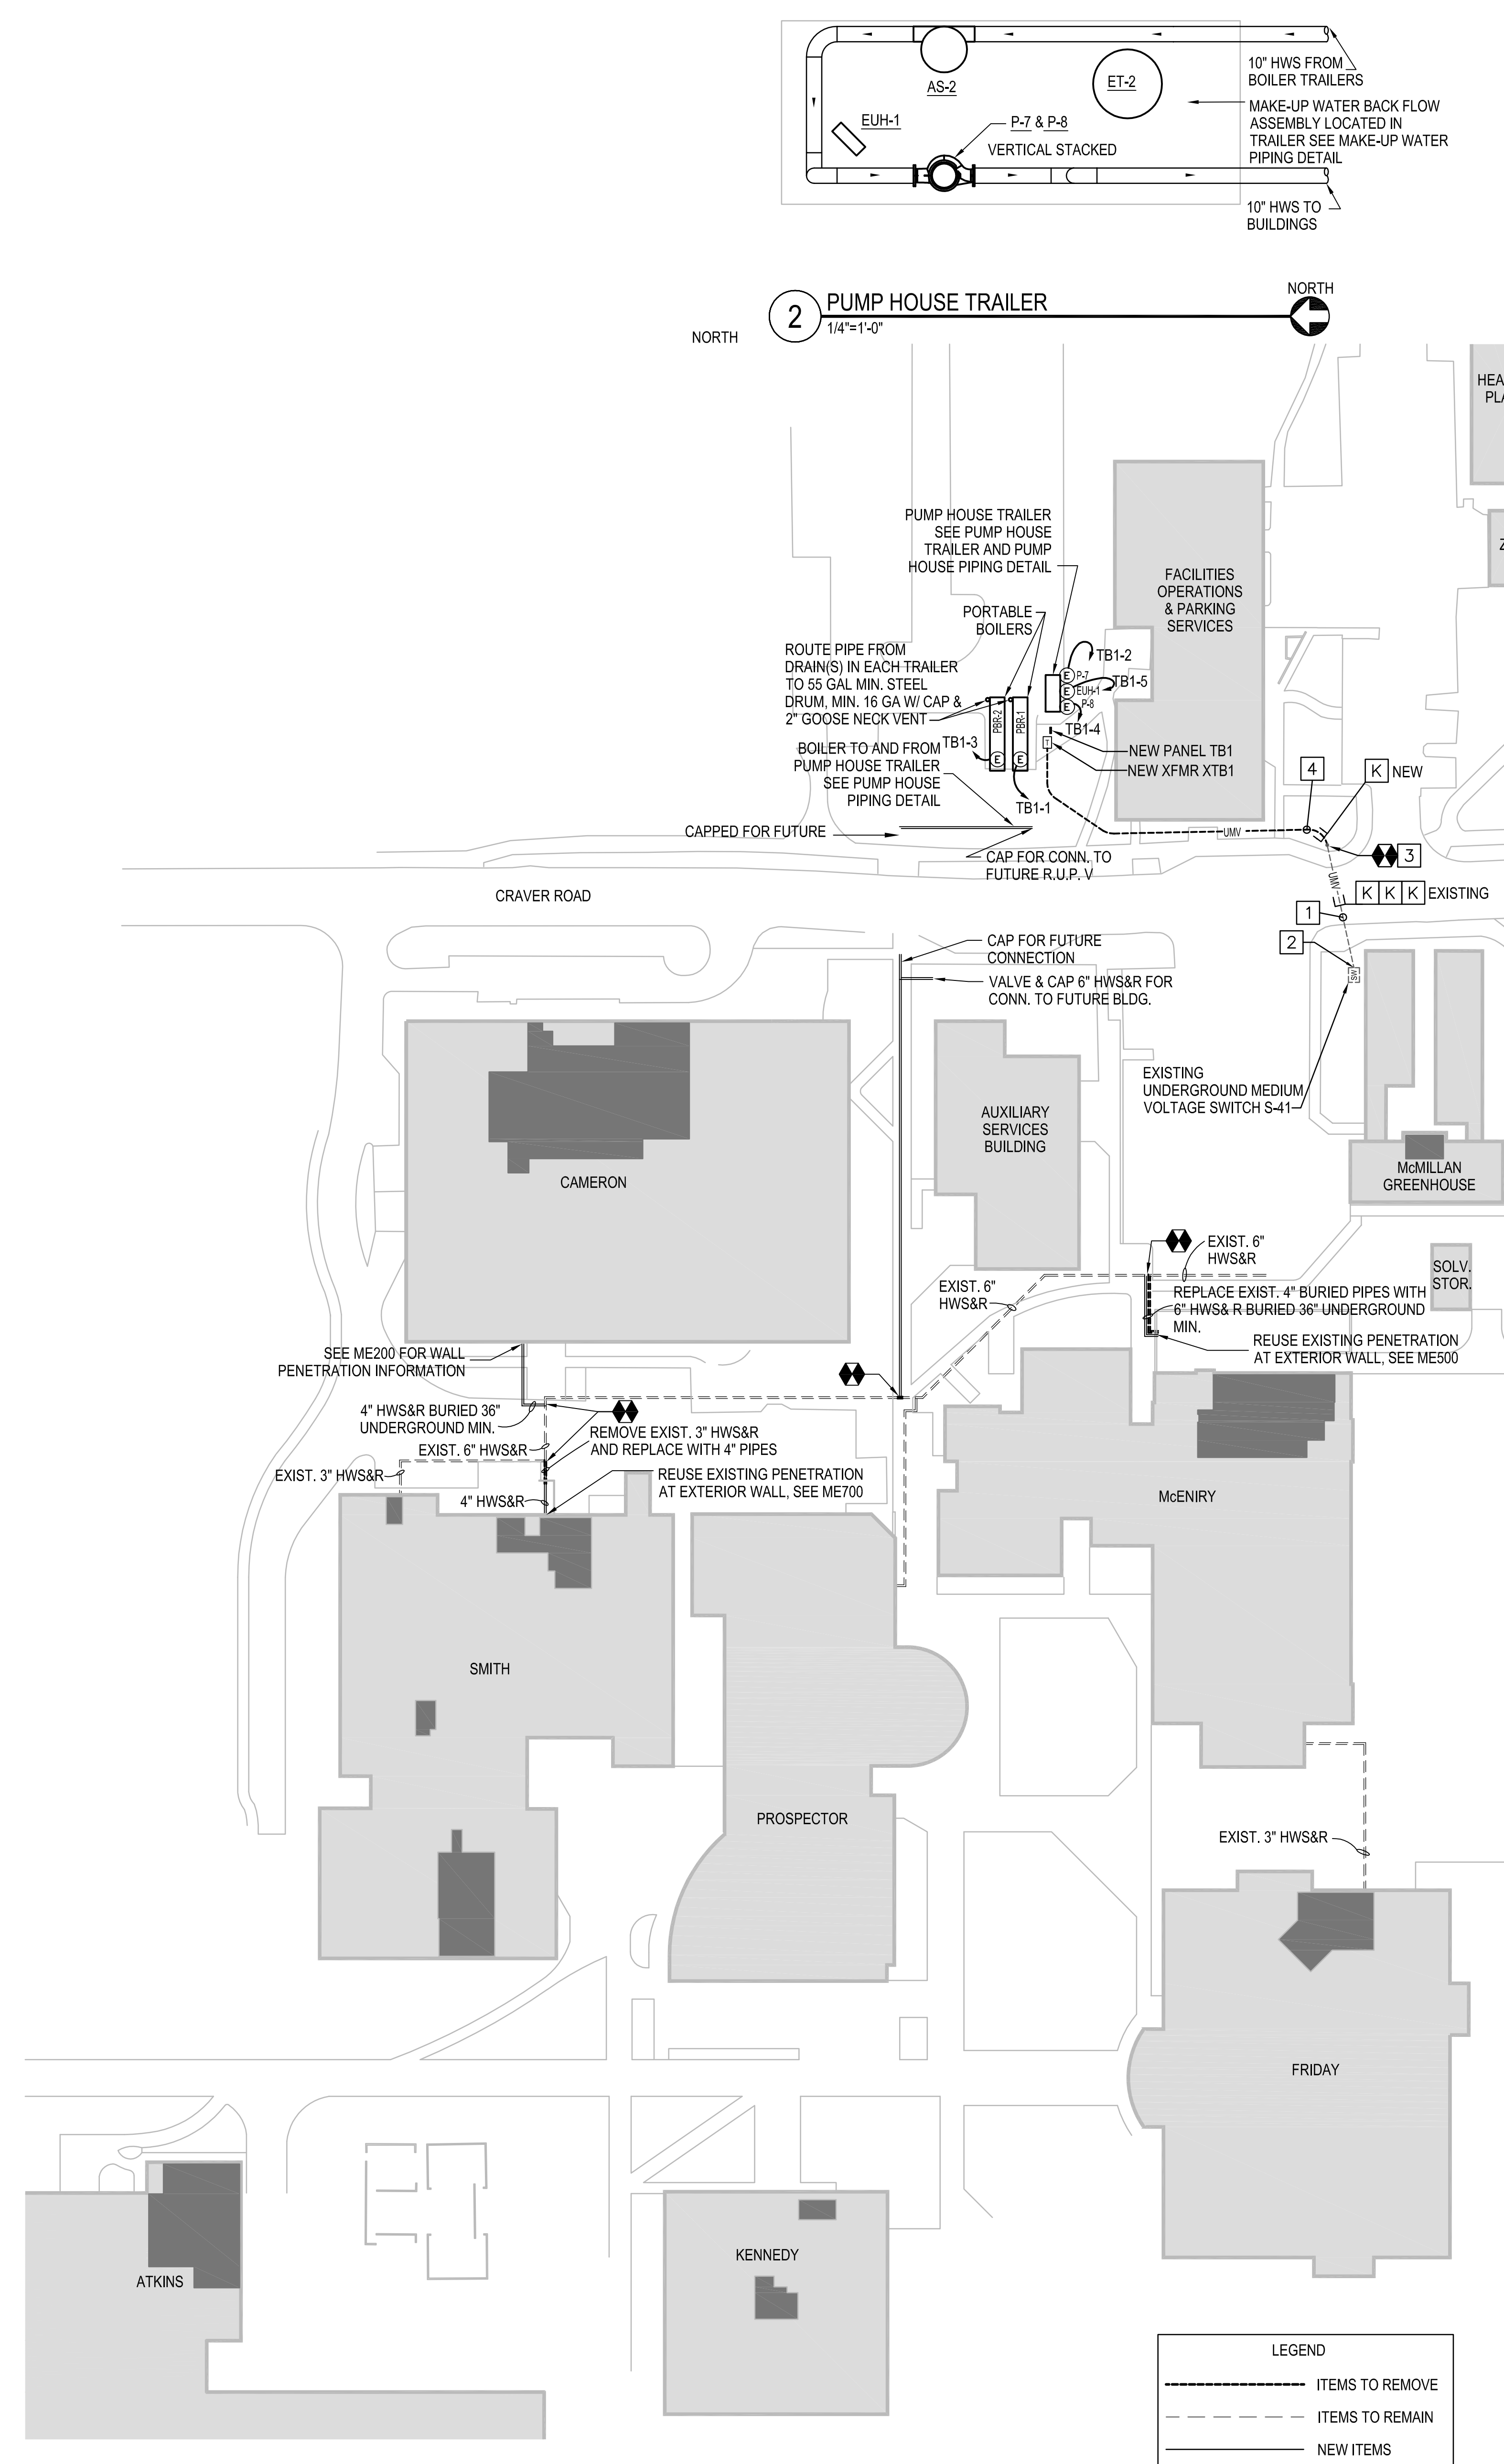

1 MECHANICAL AND ELECTRICAL SITE PLAN  
1" = 50'-0"

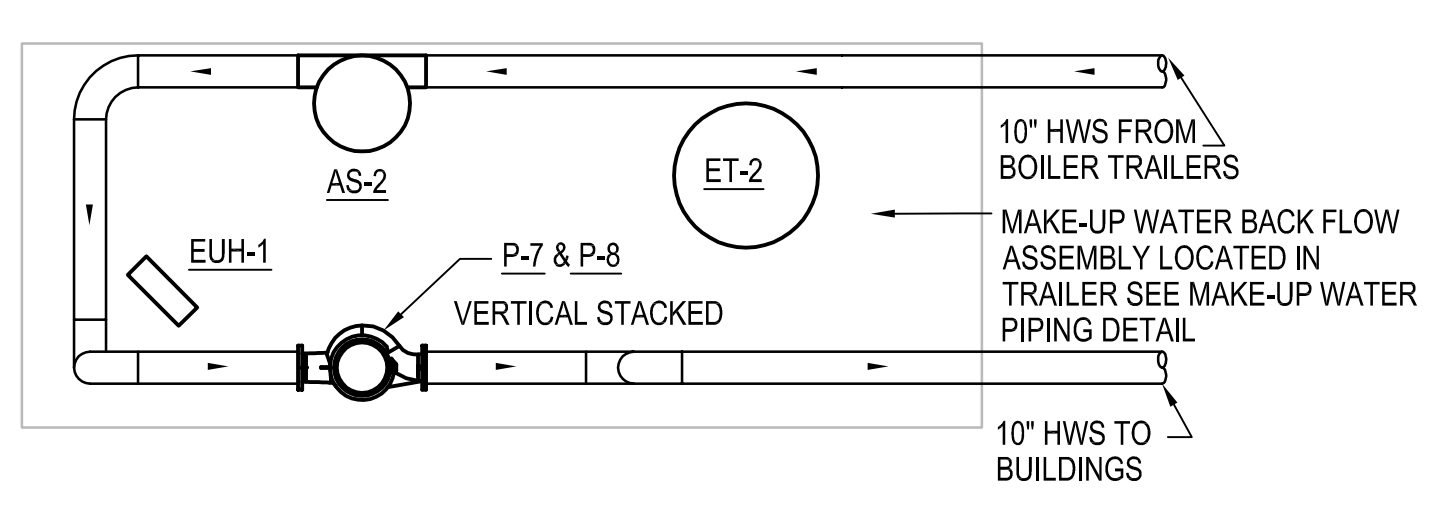

2 PUMP HOUSE TRAILER  
1/4" = 1'-0"

DUCTBANK CONDUIT SCHEDULE		
TAG	DESCRIPTION	NOTES
K	15 KV 4" WAY	SEE SINGLE-LINE DIAGRAM ON SHEET ME002 FOR EQUIPMENT RATINGS, CONDUIT SIZES AND CONDUCTOR SIZES.

GENERAL NOTES

- CONTRACTOR TO EXERCISE CAUTION WHEN EXCAVATING NEW ELECTRICAL UNDERGROUND INSTALLATION TO AVOID DAMAGING EXISTING UNDERGROUND UTILITIES. COORDINATE WITH UNC CHARLOTTE PRIOR TO DIGGING. DAMAGE TO EXISTING UTILITIES SHALL BE REPAIRED AT CONTRACTOR EXPENSE.

TAGGED NOTES


- EXISTING CONCRETE ENCASED DUCTBANK WITH (3) 4-INCH DUCTS. COORDINATE WITH UNC CHARLOTTE HIGH VOLTAGE DEPARTMENT FOR LOCATION OF DUCTBANK TERMINATION POINTS AT EACH END.
- EXISTING DUCTBANK TERMINATED BELOW GRADE OUTSIDE EXISTING SWITCH VAULT. EXTEND DUCTBANK TO EXISTING UNDERGROUND MEDIUM VOLTAGE SWITCH VAULT.
- EXISTING DUCTBANK TERMINATED BELOW GRADE AT THIS APPROXIMATE LOCATION. TIE NEW DUCTBANK INTO EXISTING DUCTBANK. UTILIZE ONE EXISTING 4-INCH CONDUIT FROM SWITCH VAULT. OTHER EXISTING CONDUITS TO BE CAPPED AND ABANDONED. SEE DETAIL 5 ON SHEET ME006 FOR NEW-TO-EXISTING DUCTBANK TIE-IN REQUIREMENTS.
- EXTEND NEW DUCTBANK TO NEW TRANSFORMER XT B1.

SCOPE OF WORK

THE SCOPE OF WORK INCLUDES PROVIDING A TEMPORARY HEATING SYSTEM TO SERVE EXISTING BUILDINGS THAT WILL BE FED FROM A NEW HEATING WATER REGIONAL UTILITY PLANT (RUP 5) IN THE FUTURE THE EXISTING HEATING PLANT THAT SERVES THE EXISTING BUILDINGS IS BEING DEMOLISHED TO ACCOMMODATE A NEW SCIENCE BUILDING.


THE TEMPORARY HEATING SYSTEM SHALL BE COMPRISED OF TWO ON-SITE TRAILERS EACH CONTAINING A GAS FIRED BOILER, AND MAKE-UP WATER CONNECTION IN THE PUMP HOUSE WILL BE AN AIR SEPARATOR, AN EXPANSION TANK, TWO VARIABLE FLOW DISTRIBUTION PUMPS.

THE SCOPE OF WORK ALSO INCLUDES THE CONVERSION OF SOME BUILDINGS FROM STEAM TO HEATING WATER.

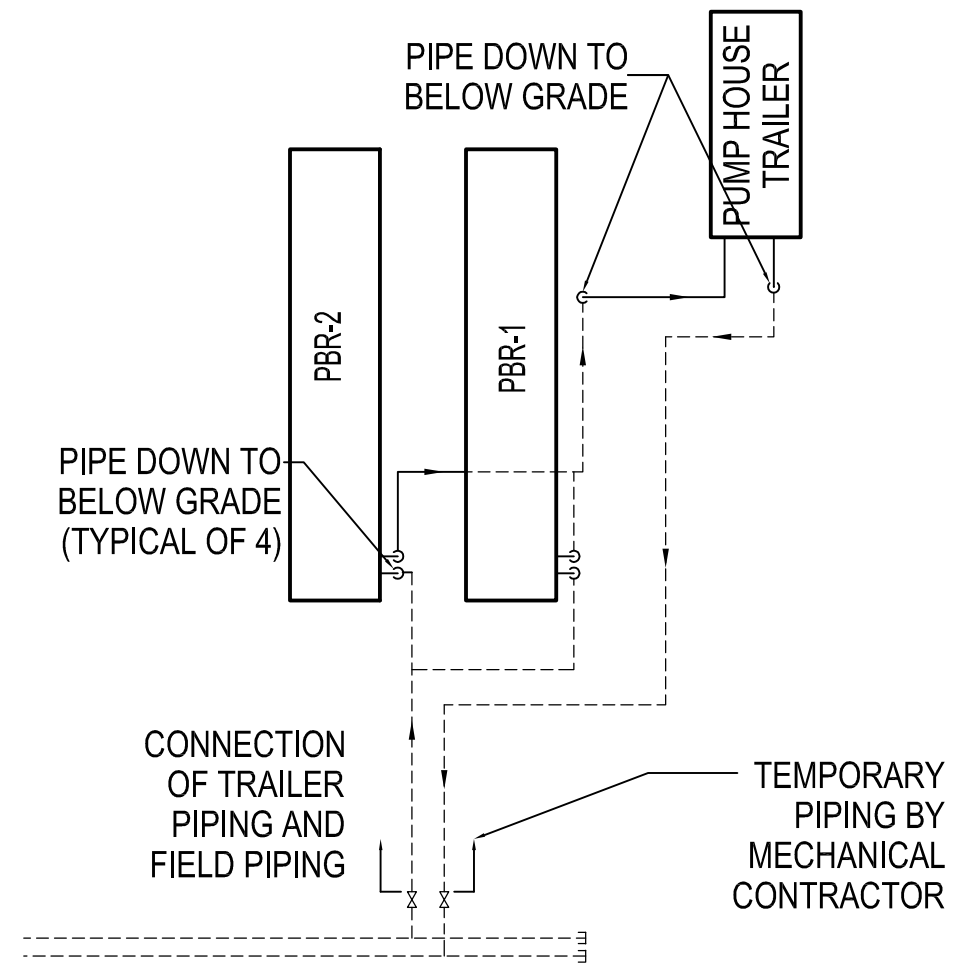


3 PUMP HOUSE TRAILER PIPING DETAIL  
NO SCALE

- NOTES:
- CONNECTED LOAD: 29,290 CFH @ 2.0 PSIG SUPPLY
  - APPROXIMATE TOTAL DEVELOPED LENGTH = 40 LF.
  - PIPE SIZES WERE BASED ON THE SIZING CRITERIA FOR SCHEDULE 40 STANDARD STEEL PIPE WITH A PRESSURE DROP OF 1.0 PSIG.
  - BOND GAS PIPING IN ACCORDANCE WITH THE NEC.

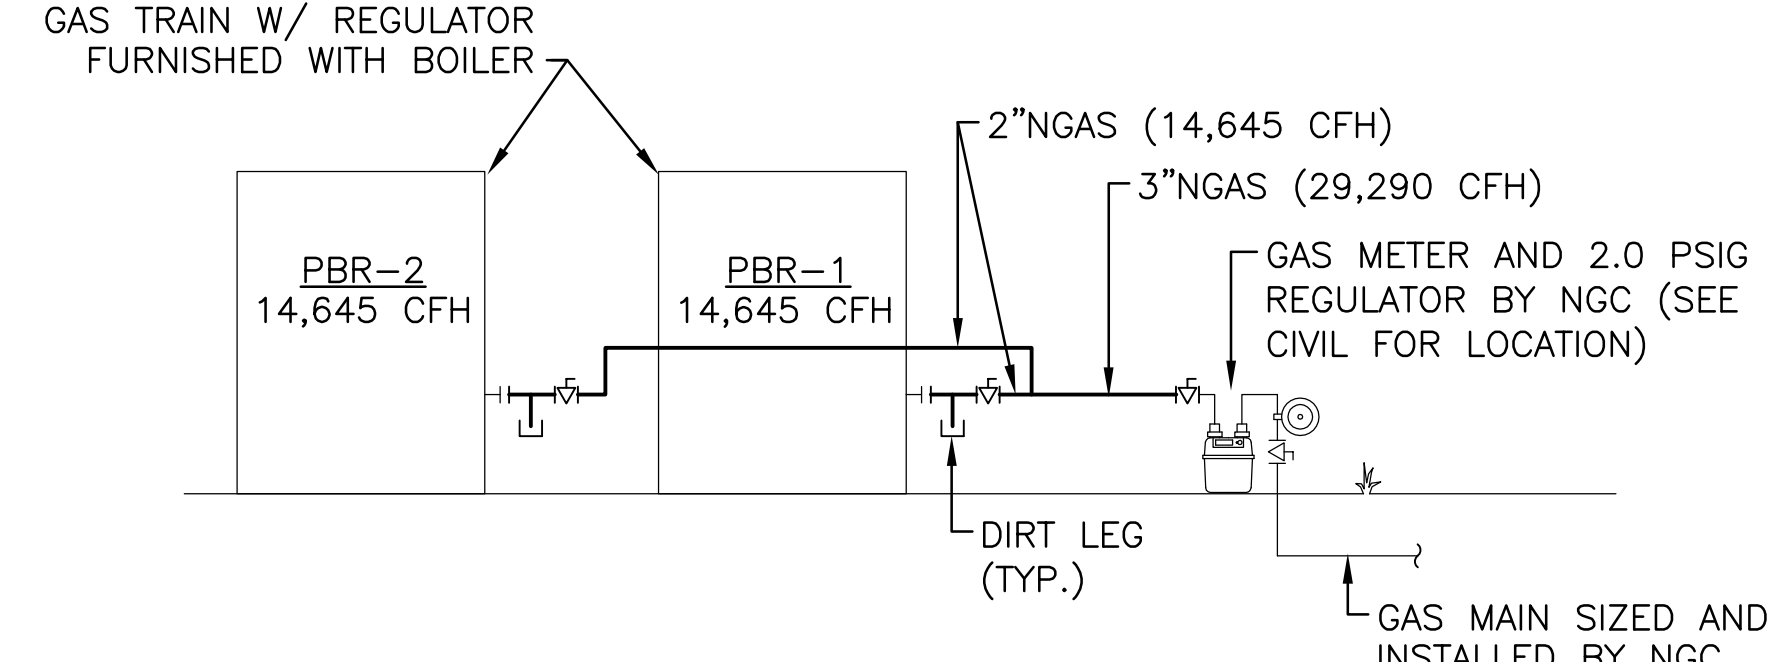

TEMPORARY BOILER GAS RISER DIAGRAM  
NO SCALE

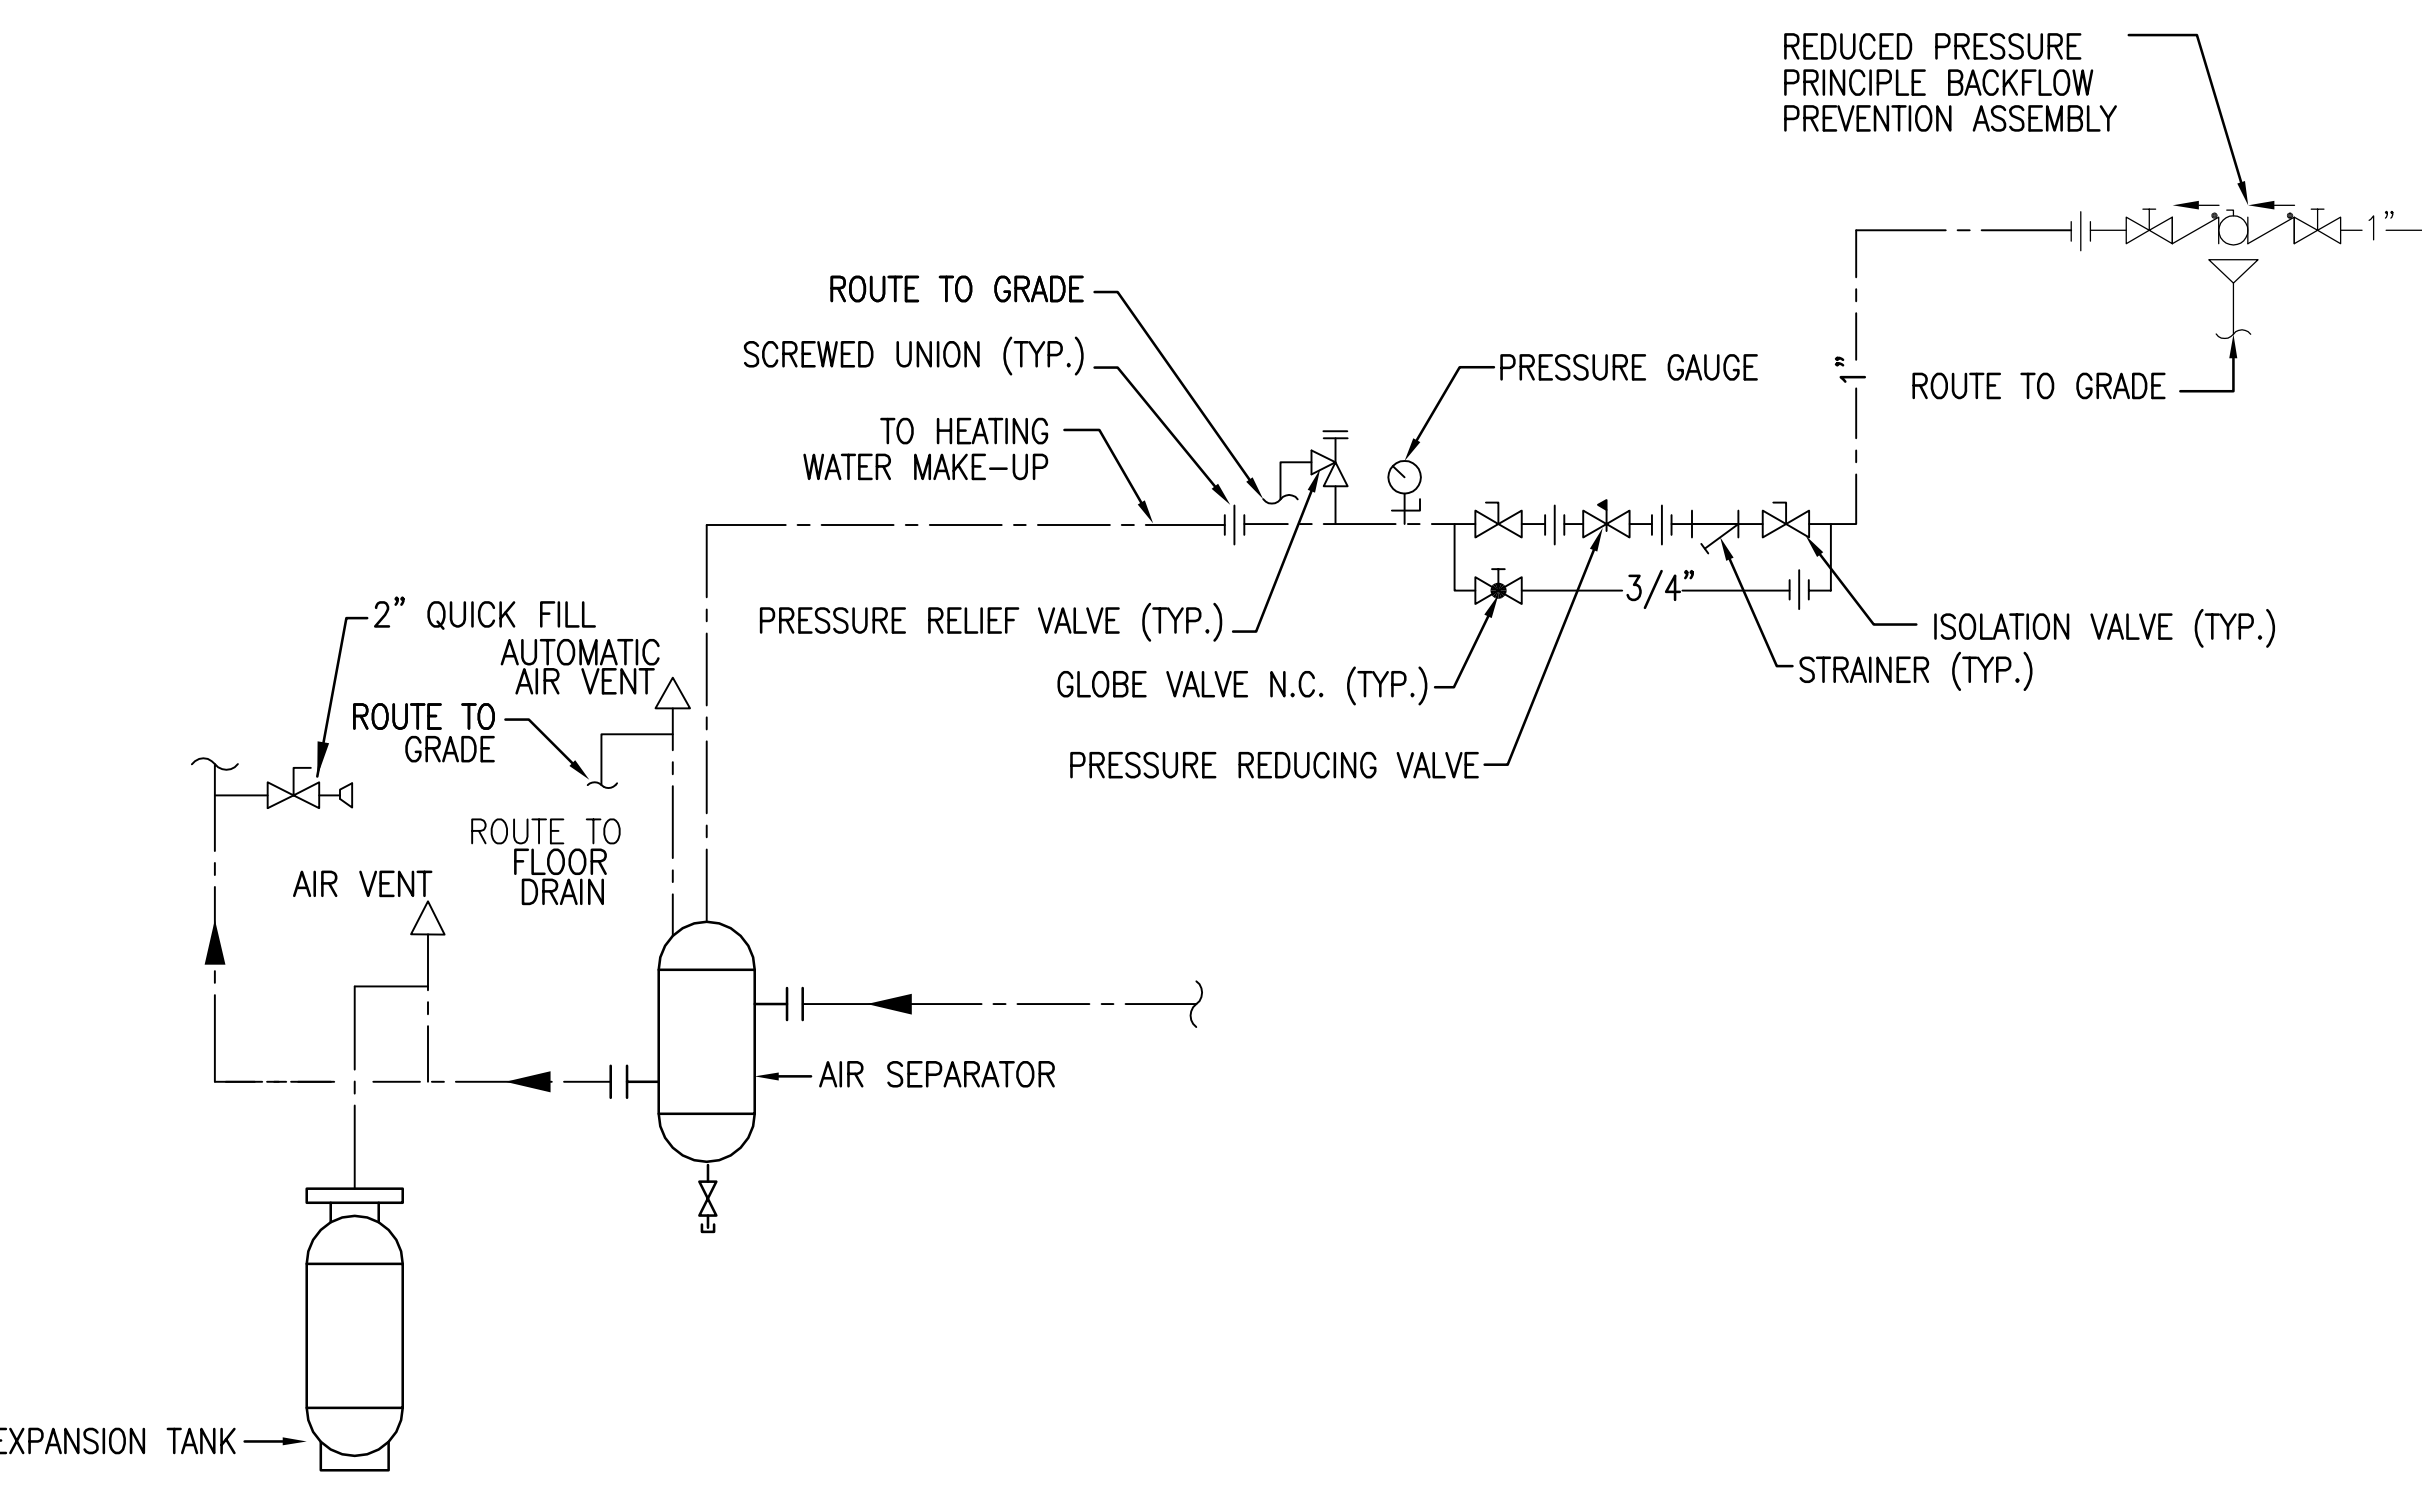

NOTE: PRESSURE REDUCING VALVE SETTING, IN FEET WATER COLUMN, TO BE EQUAL TO 12 FEET WATER COLUMN PLUS THE ELEVATION DIFFERENCE, IN FEET, BETWEEN THE VALVE AND THE HIGHEST POINT OF THE HYDRONIC SYSTEM IT SERVES

MAKE-UP WATER PIPING DETAIL  
NO SCALE




SCO ID Number: 16-14355-02B  
Code: 46626  
Item: 301

CLARK NEXSEN  
1523 Elizabeth Avenue, Suite 300  
Charlotte, NC 28204  
704.377.6800



NC Corporate Engineering License #: C-1028

CONSULTANT

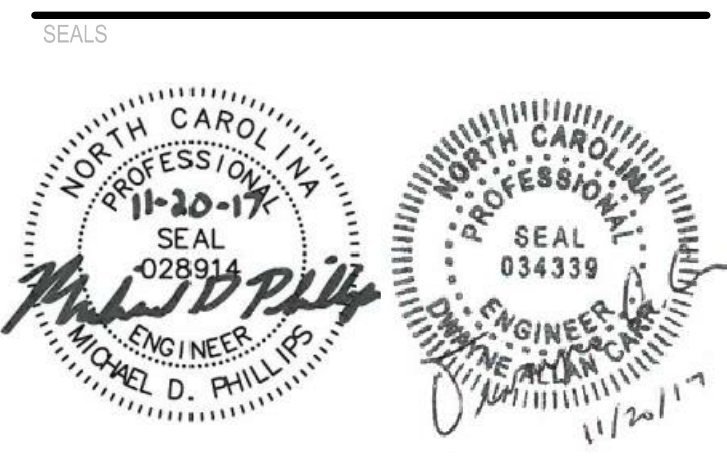

SUBMITTAL

20 November 2017  
Bid Documents

REVISIONS  
11/20/17 ADDENDUM #1

MECHANICAL-ELECTRICAL SITE PLAN & DETAILS

MES01

DESIGN: CNE  
DRAWN: CNE  
REVIEW: DAC  
CN 6222