

University of North Carolina at Charlotte, North Carolina
SANITARY SEWER REPAIR AND REPLACEMENT (SOUTH VILLAGE)

To: All Holders of Contract Documents

Subject: Addendum No. 3

Please make the following revisions/changes to the contract documents:

Contract Documents

1. REVISE the Advertisement for Bid, bid due date to April 16, 2026. Note the bid opening will be held in FMPPS Room 119.
2. REVISE the Notice to Bidders, bid due date to April 16, 2026.


Contract Drawings

1. Sheet C-108. Existing 6" DIP water line (fire service) added to plans.

Attachments to Addendum 3.

1. Sheet C-108.



END OF ADDENDUM 3

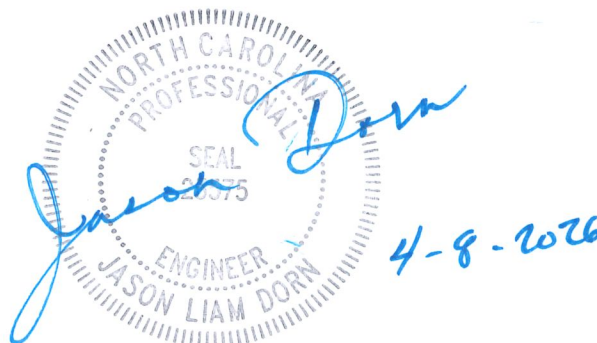

UNC CHARLOTTE
SANITARY SEWER REPAIR AND REPLACEMENT
(SOUTH VILLAGE)
SITE RESTORATION
SCOTT HALL

- GENERAL NOTES**
- ALL DISTURBED AREAS ARE TO BE RESTORED TO PRE-CONSTRUCTION CONDITIONS, UNLESS INDICATED OTHERWISE.
 - MISCELLANEOUS ELEVATIONS AND DIMENSIONS ASSOCIATED WITH SCOTT HALL BUILDING FOOTINGS FROM RECORD DRAWING ENTITLED "FOUNDATION PLAN & BORING LOGS RESIDENCE HALL '72" DATED 7/12/1971.
 - RESTORE STOCKPILED RIP RAP ON FINISHED EMBANKMENT. SUPPLEMENT WITH ADDITIONAL RIP RAP AS DIRECTED BY THE ENGINEER.

- RIPRAP SLOPE NOTES:**
- REUSE STOCKPILED RIPRAP AND PROVIDE SUPPLEMENTAL STONE TO ACHIEVE COMPLETE COVERAGE PER NCDOT SECTION 1042 AND TABLE 1042-1 FOR THE CLASS SHOWN ON THE PLANS. UNLESS NOTED OTHERWISE, USE RIP RAP, CLASS B (MIN 5 IN., MIDRANGE 8 IN., MAX 12 IN.).
 - PROVIDE GEOTEXTILE, TYPE 2 IN ACCORDANCE WITH NCDOT SECTION 1056 AND TABLE 1056-1 (WOVEN OR NONWOVEN; PROPERTIES PER AASHTO M288). OVERLAP SEAMS 18 IN. MIN (24 IN. ON SLOPES > 2:1). STAKE OR BALLAST TO PREVENT DISPLACEMENT, AND PROTECT FROM UV PRIOR TO COVER. PATCH ANY DAMAGE WITH A LAP \geq 3 FT IN ALL DIRECTIONS.
 - INSTALLATION:
 - GRADE AND COMPACT THE SLOPE TO LINE/GRADE; REMOVE PROTRUSIONS.
 - PLACE GEOTEXTILE SMOOTHLY, ANCHORING TOP EDGE AND KEYING AT THE TOE.
 - PLACE RIPRAP TO A COMPACTED THICKNESS OF 12 IN. (CLASS B).
 - EMBED A TOE KEY EQUAL TO THE STONE THICKNESS (MIN) BELOW FINISHED GRADE.
 - PLACE STONE IN A WELL-GRADED, DENSE LAYER WITHOUT SEGREGATION; FILL VOIDS WITH SPALLS; NO MACHINE COMPACTION.
 - EXTEND RIPRAP TO/OVER THE SHOULDER BREAK WHERE APPLICABLE AND TIE INTO ADJACENT TREATMENTS.

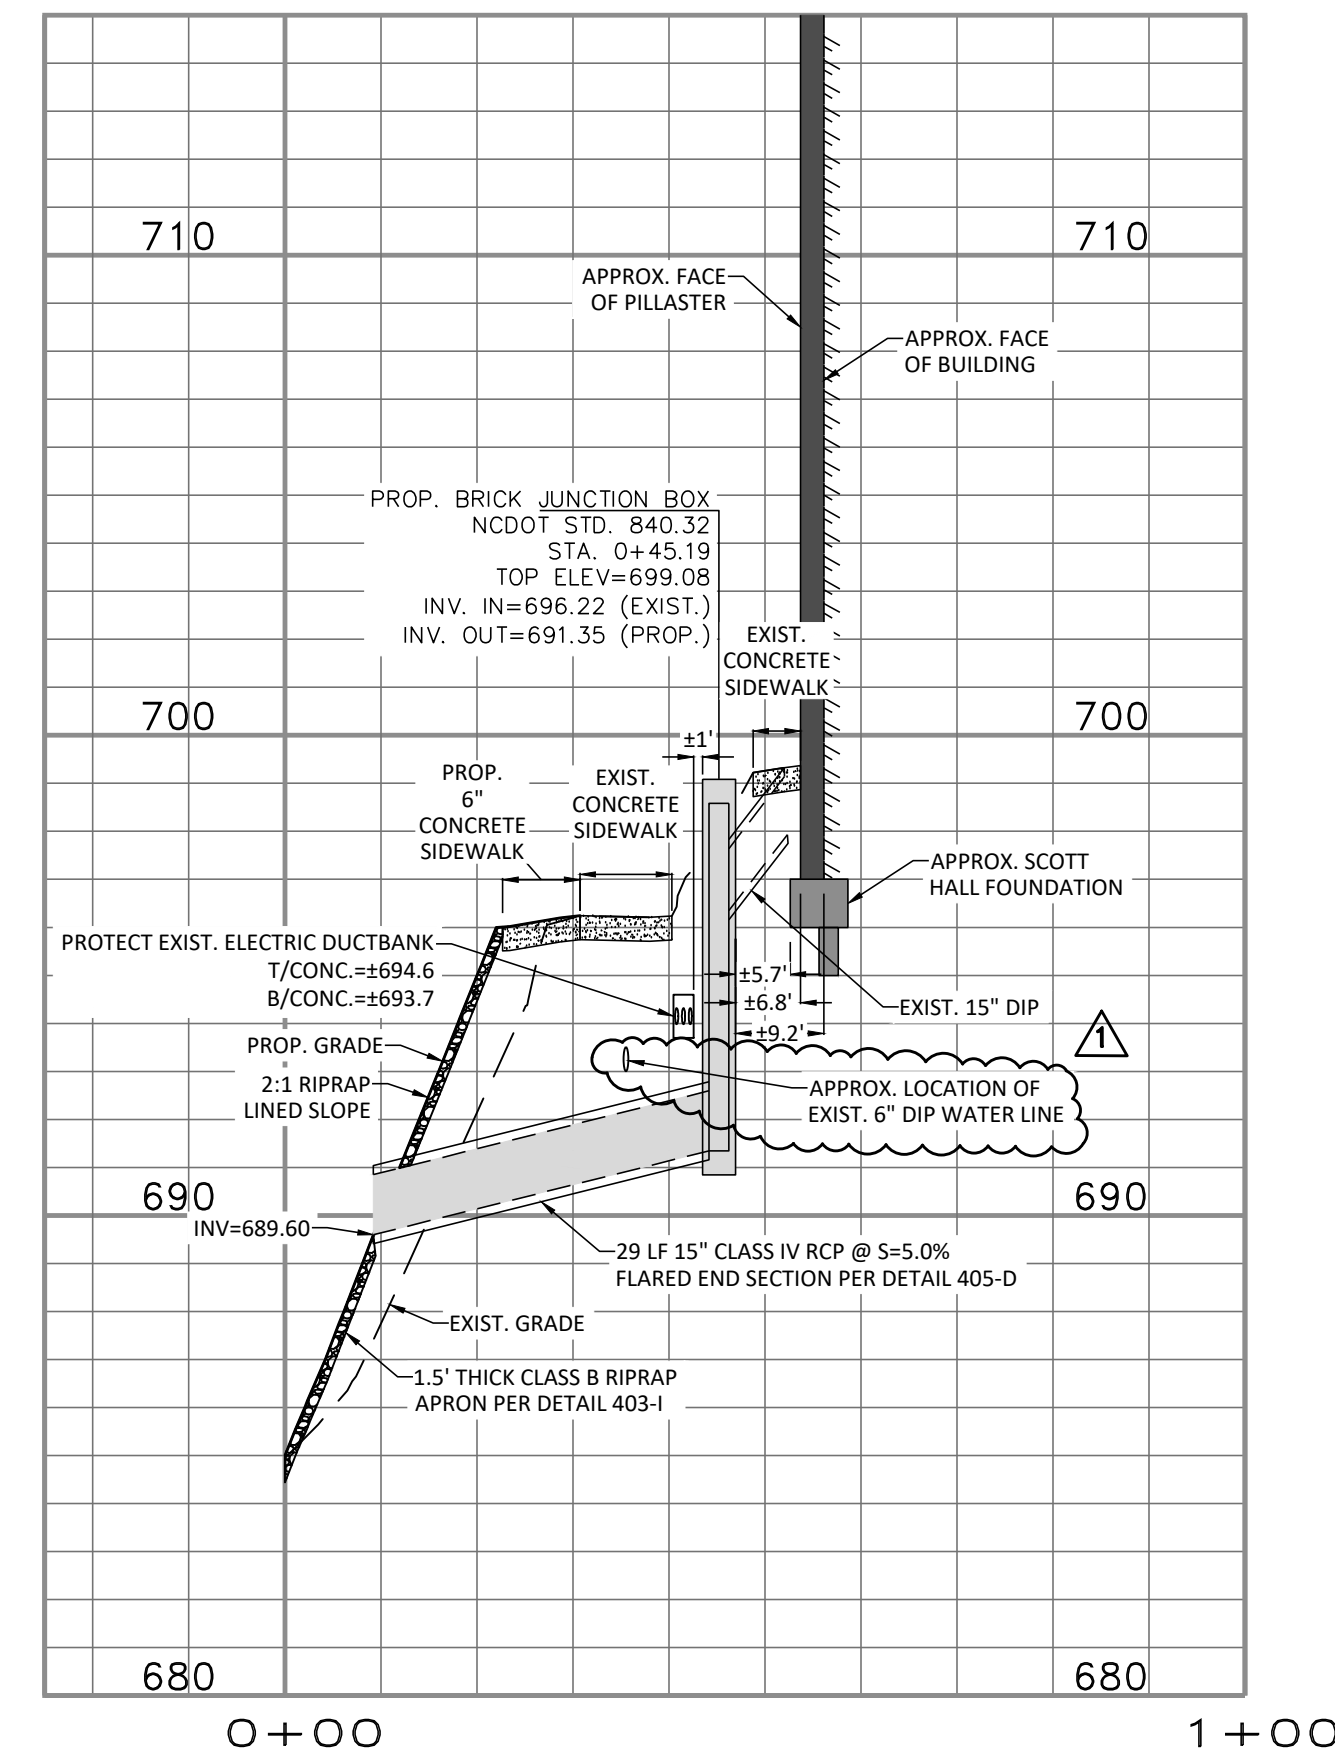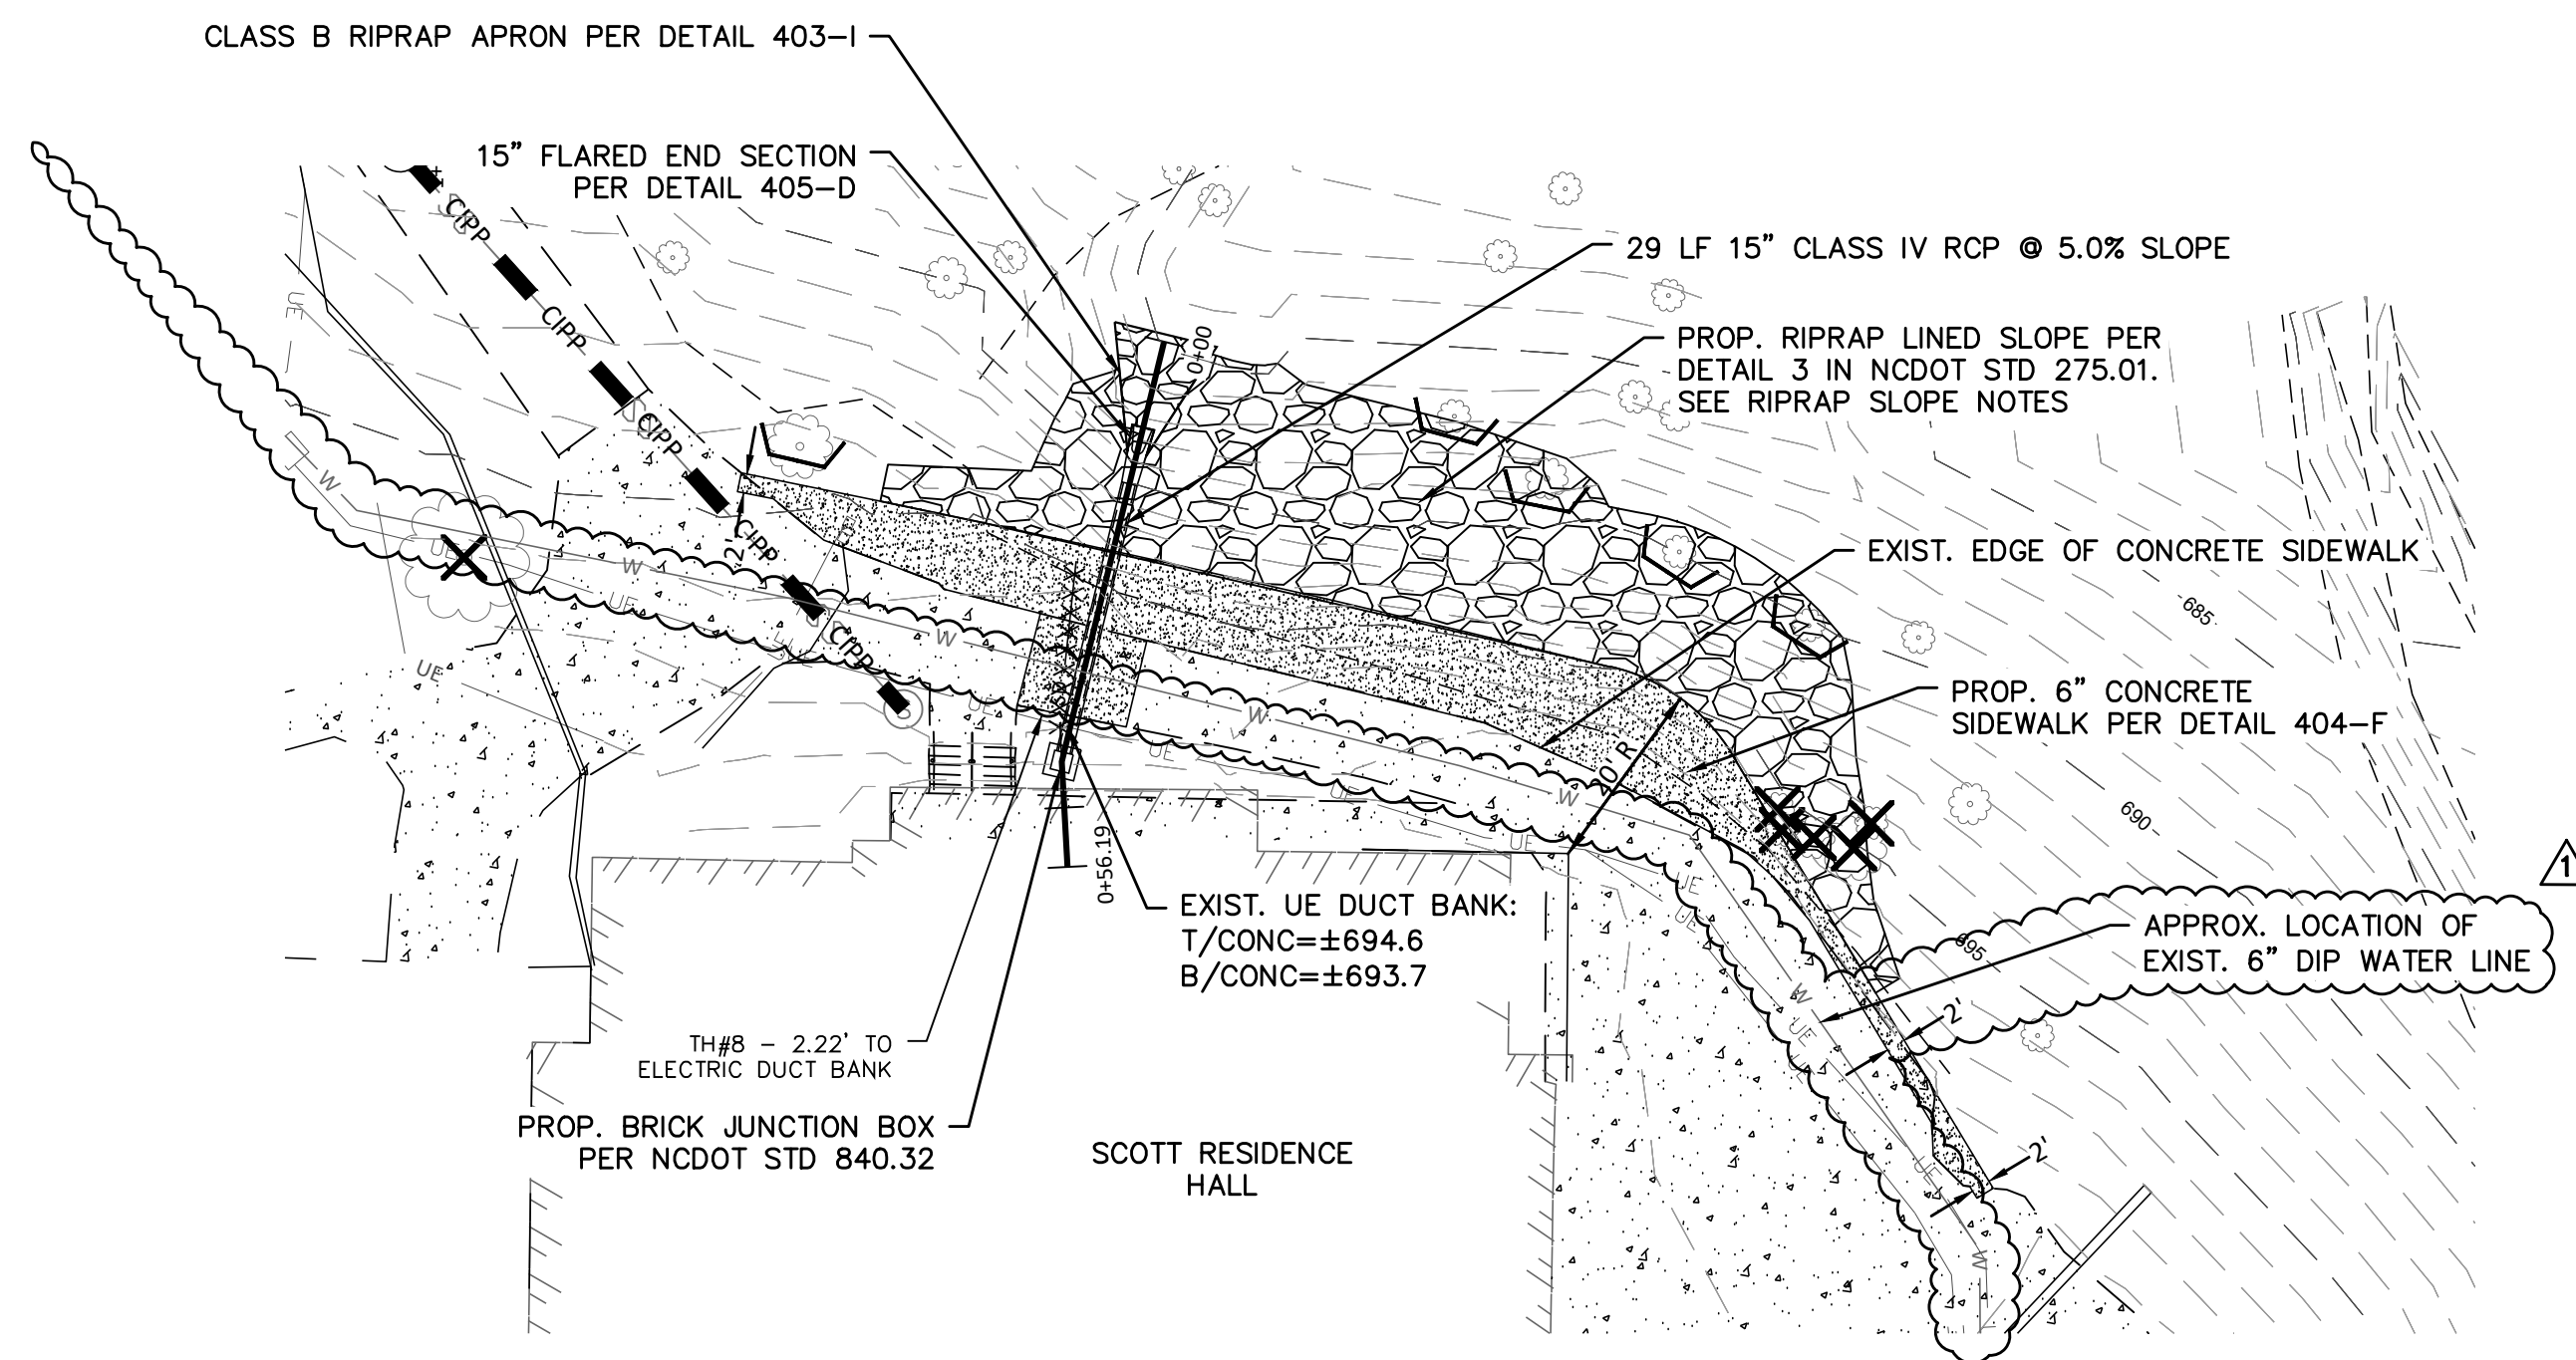

DATE	PER UNIVERSITY COMMENTS
4/7/26	

Apprvd:	04/07/26
Date:	04/07/26
Chkd:	JLD
Drwn:	RMC
Scale:	1" = 20'
Project No.:	#2024-060
Sheet:	C108

