



Building Addendum #1

University of North Carolina at Charlotte
Facilities Operations and Parking Services Complex
Building Phase

Date: 09/07/17

The following items are hereby incorporated into the above referenced Project:

BIDDERS MANUAL

1. Part 1 – Advertisement for Bids:

- a. Change paragraph at bottom of page 1 of the Advertisement for bids to read: “Sealed proposals will be received at the Student Union Building, Room 200, on the University of North Carolina at Charlotte Campus on **Wednesday, September 27, 2017 at 2:00pm** and immediately thereafter publicly opened. For directions see <http://facilities.uncc.edu/maps>. Paid parking is available at the Cone Visitor Parking Deck.

2. Part 2 – Bid Forms

- a. Bid form has been issued with this addendum. See attached.

3. Part 3 – Instruction to Bidders:

- a. Section 1.05 – replace first paragraph with, “Sealed proposals clearly marked with Bid Package number will be received at the Student Union Building, Room 200, on the University of North Carolina at Charlotte Campus, Charlotte, North Carolina up to **2:00 pm, Wednesday, September 27, 2017**. All bids will be opened and read aloud starting after the cutoff time at 2:00 pm. Bidders who will not attend the Bid Opening need to ensure their sealed bids are delivered no later than 1:00 p.m. on September 27, 2017 to the following:”

4. Part 4 – Bidders Manual:

- a. Administrative Requirements
 - i. Item #13: Delete and replace with: “All trade contractors will be enrolled in New Atlantic Contracting’s sub default insurance program in lieu of Payment and Performance bonds.”
- b. BP 7A
 - i. Trade contractor to include flexible membrane flashing lap over air barrier as indicated (i.e. sheet A-551). See LS3P Addendum No. 4.

QUESTIONS AND ANSWERS

No Questions and Answers.

SPECIFICATIONS & DRAWINGS:

See attached **LS3P ADDENDUM NUMBER FOUR** dated August 28, 2017.

GENERAL INFORMATION:

- **Bid Date** for the project has been changed to **Wednesday – 9/27/17 at 2:00PM** at the Student Union Building, Room 200, on campus at UNC Charlotte. Changes noted in the New Atlantic Building Addendum #1 are correct and overrule the note on LS3P Addendum No. 4.
- Deadline for Pre-bid Questions has been extended. All questions and substitution requests are due Thursday – September 14, 2017 at 3:00pm
- LS3P Addendum No. 4 notes that LS3P Addenda 1-3 were issued as part of the Early Site / Structural Package. Early Site / Structural documents have been made available for reference on New Atlantic's FTP Site.
- Pre-bid Meeting Presentation and Sign-in Sheet have been attached for reference.

END OF ADDENDUM

FORM OF PROPOSAL

*University of North Carolina at Charlotte
Facilities Operations and Parking Services Complex
Building Phase*

Bidding Contractor: _____

NC License #: _____

Date: _____

COMPLIANCE STATEMENT

I hereby acknowledge that I have read and accept the complete Bidders Manual dated August 21, 2017. I acknowledge these documents in their entirety and agree that, if awarded a subcontract, these documents will be signed and executed as-is with no modifications. The undersigned bidder proposes to furnish all labor, materials, equipment, engineering, permits, fees, taxes, insurance, scaffolding, hoisting, clean-up, safety measures, and supervision and perform all work necessary for the construction of this Trade Package, in accordance with Drawings and Specifications dated 8/21/17 (as itemized in the Bidders Manual), and the addenda noted below for consideration of the following amount:

ADDENDA	Number: _____	Dated: _____
	Number: _____	Dated: _____
	Number: _____	Dated: _____

BASE BID for Bid Package # _____

Show amount both in words and figures.

_____ Dollars.

\$ _____ . 00

ALTERNATES:

Should any of the alternates as described in the contract documents be accepted, the amount written below shall be the amount to be "added to" or "deducted from" the base bid. (Circle "Add" or "Deduct" as appropriate.)

Show amount both in words and figures.

Alternate No. 1: Provide brick façade in lieu of metal siding on the south facade of Warehouse building as detailed on the Drawings and described in the Specifications.

(Add) *(Deduct)* _____ Dollars (\$) _____

Alternate No. 2A: Provide pre-engineered metal canopy for Wash Rack as detailed on the Drawings and described in the Specifications.

(Add) *(Deduct)* _____ Dollars (\$) _____

Alternate No. 2B: Provide decorative CMU masonry walls, on two sides, and roof for Wash Rack in lieu of pre-engineered metal canopy as detailed on the Drawings and described in the Specifications.

(Add) *(Deduct)* _____ Dollars (\$) _____

Alternate No. 3: Provide decorative CMU with ribbed interior finish masonry screenwall with precast cap in lieu of chain link fence around Service Yard as detailed on the Drawings and described in the Specifications.

(Add) *(Deduct)* _____ Dollars (\$) _____

Alternate No. 4A: Provide Gravel Bus Parking as detailed on the Drawings.

(Add) *(Deduct)* _____ Dollars (\$) _____

Alternate No. 4B: Provide Concrete Bus Parking in lieu of gravel as detailed on the Drawings.

(Add) *(Deduct)* _____ Dollars (\$) _____

Alternate No. 5: Provide Sanitary Dump Station as detailed on the Drawings.

(Add) *(Deduct)* _____ Dollars (\$) _____

Alternate No. 8: Extend telecomm infrastructure along Poplar Lane as detailed on the Drawings. Scope of work includes new concrete encased duct bank from existing manhole to new Telecommunications manhole.

(Add) *(Deduct)* _____ Dollars (\$) _____

Alternate No. 9: Provide decorative CMU masonry screenwall with precast cap in lieu of decorative metal fence along south edge of complex as detailed on the Drawings and described in the Specifications.

(Add) *(Deduct)* _____ Dollars (\$) _____

Alternate No. 10: Condition shops areas as indicated on the Drawings and described in the Specifications.

(Add) *(Deduct)* _____ Dollars (\$) _____

Alternate No. 11: Install event power as indicated on the Drawings and described in the Specifications.

(Add) *(Deduct)* _____ Dollars (\$) _____

Alternate No. 12: Provide pre-engineered metal canopy for Covered Storage as detailed on the Drawings and described in the Specifications.

(Add) *(Deduct)* _____ Dollars (\$) _____

Alternate No. 13: Provide lightning protection system as described in the specifications.

(Add) *(Deduct)* _____ Dollars (\$) _____

Alternate No. P1: Provide Schlage Locksets, (no substitutions) as described in Specification Section 087100.

(Add) *(Deduct)* _____ Dollars (\$) _____

Alternate No. P2: Provide Simplex Fire Detection Systems, (no substitutions) as described in Specification Section 283111.

(Add) *(Deduct)* _____ Dollars (\$) _____

Alternate No. P3: Provide Open Option Systems, (no substitutions) as described in Specification Section 281300.

(Add) *(Deduct)* _____ Dollars (\$) _____

Alternate No. P4: Provide Hanson Brick, "Morrocroft Special" brick (no substitutions), as described in Specification Section 042000.

(Add) *(Deduct)* _____ Dollars (\$) _____

Alternate No. P5: Provide Pine Hall, English Edge Pavers, (no substitutions) as described in Specification Section 321400.

(Add) *(Deduct)* _____ Dollars (\$) _____

UNIT PRICES / QUANTITY ALLOWANCES

Unit prices quoted and accepted shall apply throughout the life of the contract, except as otherwise specifically noted. Unit prices shall be applied, as appropriate, to compute the total value of changes in the base bid quantity of the work all in accordance with the contract documents. Reference Specification Section 012200 - UNIT PRICES for more details.

UP-1: Trench Rock Excavation, Off-Site Disposal, and Replacement with Off-Site Suitable Fill.

Include the removal of trench rock including all necessary equipment, material and labor for trench rock excavation and removal off-site. Provide the replacement of trench rock with compacted off-site suitable compacted fill in accordance with Section 312316.26. See Bidder's Manual for quantities to be carried in individual trade package base bids

QUANTIFY ALLOWANCE 1: Base bid proposal to include **40 CY**, to be used at the discretion of the CMAR.

(\$/CY) Unit Price 1 = \$ _____

UP-4A1: Face Brick.

Furnish and Install (including masonry accessories) Face Brick.

QUANTIFY ALLOWANCE 4A1: Bid Package 4A Base bid proposal to include **300 SF**, to be used at the discretion of the CMAR.

(\$/SF) Unit Price 4A1 = \$ _____

UP-4A2: 4" Shotblasted CMU.

Furnish and Install (including masonry accessories) 4" Shotblasted CMU Block.

QUANTIFY ALLOWANCE 4A2: Bid Package 4A Base bid proposal to include **300 SF**, to be used at the discretion of the CMAR.

(\$/SF) Unit Price 4A2 = \$ _____

UP-9A1: Drywall Patching.

Include all materials and labor required for drywall patching.

QUANTIFY ALLOWANCE 9A1: Bid Package 9A Base bid proposal to include **40 HOURS**, to be used at the discretion of the CMAR.

(\$/HR) Unit Price 9A1 = \$ _____

UP-9B1: Ceiling Patching.

Include all materials and labor required for ceiling patching.

QUANTIFY ALLOWANCE 9B1: Bid Package 9B Base bid proposal to include **600 SF**, to be used at the discretion of the CMAR.

(\$/SF) Unit Price 9B1 = \$ _____

UP-9D1: Floor Leveling.

Include all materials and labor required for floor leveling.

QUANTIFY ALLOWANCE 9D1: Bid Package 9D Base bid proposal to include **1,500 SF**, to be used at the discretion of the CMAR.

(\$/SF) Unit Price 9D1 = \$ _____

UP-9D2: Luxury Vinyl Tile.

Furnish and Install Luxury Vinyl Tile.

QUANTIFY ALLOWANCE 9D2: Bid Package 9D Base bid proposal to include **500 SF**, to be used at the discretion of the CMAR.

(\$/SF) Unit Price 9D2 = \$ _____

UP-9E1: Touch-up Paint.

Include all materials and labor required for touch-up painting beyond normal touch up.

QUANTIFY ALLOWANCE 9E1: Bid Package 9E Base bid proposal to include **200 HOURS**, in addition to normal touch up, to be used at the discretion of the CMAR.

(\$/HR) Unit Price 9E1 = \$ _____

UP-15A1: Wet Sprinkler Heads.

Include all materials and labor required for additional wet sprinkler heads.

QUANTIFY ALLOWANCE 15A1: Bid Package 15A Base bid proposal to include **10 EA**, to be used at the discretion of the CMAR.

(\$/EA) Unit Price 15A1 = \$ _____

UP-16A1: Emergency Lighting.

Include all material and labor required for an additional 2'-0"x4'-0" emergency light, including 30' of conduit and wiring.

QUANTIFY ALLOWANCE 16A1: Bid Package 16A Base bid proposal to include **5 EA**, to be used at the discretion of the CMAR.

(\$/EA) Unit Price 16A1 = \$ _____

UP-16A2: Horn Strobe.

Include all material and labor required for an additional horn strobe, including 30' of conduit and wiring.

QUANTIFY ALLOWANCE 16A2: Bid Package 16A Base bid proposal to include **5 EA**, to be used at the discretion of the CMAR.

(\$/EA) Unit Price 16A2 = \$ _____

UP-16A3: Exit Light.

Include all material and labor required for an additional exit light, including 30' of conduit and wiring.

QUANTIFY ALLOWANCE 16A3: Bid Package 16A Base bid proposal to include **5 EA**, to be used at the discretion of the CMAR.

(\$/EA) Unit Price 16A3 = \$ _____

Proposal Signature Page

The undersigned further agrees that in the case of failure on his part to execute the said contract and the bonds within ten (10) consecutive calendar days after being given written notice of the award of contract, the certified check, cash or bid bond accompanying this bid shall be paid into the funds of the owner's account set aside for the project, as liquidated damages for such failure; otherwise the certified check, cash or bid bond accompanying this proposal shall be returned to the undersigned.

Respectfully submitted this day of _____

(Name of firm or corporation making bid)

WITNESS:

(Proprietorship or Partnership)

By: _____
Signature

Name: _____
Print or type

Title _____
(Owner/Partner/Pres./V.Pres)

Address _____

ATTEST:

By: _____

Title: _____
(Corp. Sec. or Asst. Sec. only)

License No. _____

Federal I.D. No. _____

Email Address: _____

(CORPORATE SEAL)

ADDENDUM IV

Date of Addendum: 28 August 2017

Project Name: Facilities Operations / Parking Services Complex

Building Package

SCO ID# 16-15656-02B**PROJECT INFORMATION**

- A. Owner: University of North Carolina at Charlotte.
- B. SCO ID Number: 16-15656-02B.
- C. Architect: LS3P.
- D. Architect Project Number: 9202-164730.

NOTICE TO BIDDERS

- A. This Addendum is issued to **all Pre-Qualified Subcontractors** pursuant to the **Instructions to Bidders and Conditions of the Contract**. This Addendum serves to clarify, revise, and supersede information in the Project Manual, Drawings, and previously issued Addenda. Portions of the Addendum affecting the Contract Documents will be incorporated into the Contract by enumeration of the Addendum in the Owner/Contractor Agreement.
- B. The Bidder shall acknowledge receipt of this Addendum in the appropriate space on the Bid Form.
- C. The date for receipt of bids is **unchanged by this Addendum**.
- D. **ADDENDUM I, II, AND III HAVE BEEN ISSUED IN THE EARLY SITE/STRUCTURAL PACKAGE.**

ATTACHMENTS

- A. This Addendum includes the following attached Documents and Specification Sections:
 - 1. Section 000010 – Table of Contents, dated August 28, 2017, (reissued).
 - 2. Advertisement for Bids, (new).
 - 3. Section 012300 – Alternates, dated August 28, 2107, (reissued).
 - 4. Section 019113 – Commissioning General Requirements, dated August 28, 2107, (reissued).
 - 5. Section 064023 – Interior Architectural Woodwork, dated August 28, 2107, (reissued).
 - 6. Section 093000 – Tiling, dated August 28, 2107, (reissued).
 - 7. Section 260533 – Raceway and Boxes for Electrical Systems, dated August 28, 2107, (reissued).
 - 8. Section 260548 – Vibration and Seismic Controls for Electrical Systems, dated August 28, 2107, (reissued).
 - 9. Section 262413 – Switchboards, dated August 28, 2107, (reissued).
- B. This Addendum includes the following attached Sheets:
 - 1. General Sheet G-001 – NC Building Code Summary Office/Shops & Warehouse, dated 08/28/2017, (reissued).

2. General Sheet G-002 – NC Building Code Summary Gas Storage Building and Canopies, dated 08/28/2017, (reissued).
3. General Sheet G-005 – Life Safety Site Plan, dated 08/28/2017, (reissued).
4. Civil Sheet C403 – Site Details, dated 08/28/2017, (reissued).
5. Civil Sheet C404 – Site Details, dated 08/28/2017, (reissued).
6. Civil Sheet C600 – Utility Plan, dated 08/28/17, (reissued).
7. Civil Sheet C603 – Utility Details, dated 08/28/17, (reissued).
8. Structural Sheet S-201 – Office/Shops Building Foundation Plan – For Reference Only, dated 08/28/17, (reissued).
9. Structural Sheet S-202 – Warehouse and Gas Storage Foundation Plan – For Reference Only, dated 08/28/17, (reissued).
10. Structural Sheet S-601 – Sections and Details, dated 08/28/17, (reissued).
11. Architectural Sheet A-004 – Partition Types, dated 08/28/17, (reissued).
12. Architectural Sheet A-103 - Wash Rack and Covered Storage Canopies (Alternate No. 2 & 12), dated 08/28/17, (reissued).
13. Architectural Sheet A-252 – Interior Elevations, dated 08/28/17, (reissued).
14. Architectural Sheet A-353 – Wall Sections – Office / Shops, Warehouse and Misc. Buildings, dated 08/28/2017, (reissued).
15. Architectural Sheet A-410 – Toilet Room Plans and Schedule, dated 08/28/2017, (reissued).
16. Architectural Sheet A-512 – Section Details (Exterior), dated 08/28/2017, (reissued).
17. Architectural Sheet A-551 – Roof Details, dated 08/28/2017, (reissued).
18. Architectural Sheet A-601 – Door Schedule & Door Types, dated 08/28/2017, (reissued).
19. Architectural Sheet A-603 – Frame, Louver, and Storefront Elevations, dated 08/28/2017, (reissued).
20. Fire Protection Sheet FP-001 – Fire Protection - Specifications, Notes and Schedules, dated 08/28/17, (reissued).
21. Fire Protection Sheet FP-011 – Floor Plan - Office/Shops - Fire Protection, dated 08/28/17, (reissued).
22. Fire Protection Sheet FP-012 – Floor Plan - Warehouse - Fire Protection, dated 08/28/17, (reissued).
23. Plumbing Sheet P-002 – Plumbing Schedules, dated 08/28/17, (reissued).
24. Plumbing Sheet P-003 – Plumbing Details, dated 08/28/17, (reissued).
25. Plumbing Sheet P-004 – Plumbing Details, dated 08/28/17, (reissued).
26. Plumbing Sheet P-102B – Floor Plan - Warehouse - Waste and Vent - East, dated 08/28/17, (reissued).
27. Plumbing Sheet P-201A – Floor Plan - PATs/FO - Water and Gas, dated 08/28/17, (reissued).
28. Mechanical Sheet M-005 – Mechanical Sequence of Operations, dated 08/28/17, (reissued).
29. Mechanical Sheet M-006 – Mechanical Points List, dated 08/28/17, (reissued).
30. Mechanical Sheet M-403 – Enlarged Mechanical Room Details, dated 08/28/17, (reissued).
31. Electrical Sheet E-001 – Electrical Notes, dated 08/28/17, (reissued).
32. Electrical Sheet E-002 – Electrical Details, dated 08/28/17, (reissued).
33. Electrical Sheet E-003 – Electrical Details, dated 08/28/17, (reissued).
34. Electrical Sheet E-005 – Electrical Details, dated 08/28/17, (reissued).
35. Electrical Sheet E-006 – Electrical Details, dated 08/28/17, (reissued).
36. Electrical Sheet E-009 – Electrical Site Plan – Overall, dated 08/28/17, (reissued).
37. Electrical Sheet E-101A – Floor Plan - PATs/FO - Power, dated 08/28/17, (reissued).

38. Electrical Sheet E-301A – Reflected Ceiling Plan - PATs/FO - Special Systems, dated 08/28/17, (reissued).
39. Electrical Sheet E-401C – Floor Plan - FO Shops - Power/HVAC, dated 08/28/17, (reissued).
40. Electrical Sheet E-501 – Power Riser, dated 08/28/17, (reissued).
41. Electrical Sheet E-602 – Panel Schedules, dated 08/28/17, (reissued).
42. Electrical Sheet E-603 – Panel Schedules, dated 08/28/17, (reissued).
43. Electrical Sheet E-604 – Panel Schedules, dated 08/28/17, (reissued).

REVISIONS TO DIVISION 00 PROCUREMENT AND CONTRACTING REQUIREMENTS

Item IV-1. Replace DOCUMENT 000010 – TABLE OF CONTENTS with revised Document, included in the Attachments.

Item IV-2. Add DOCUMENT – ADVERTISEMENT FOR BIDS, included in the Attachments.

REVISIONS TO DIVISIONS 02 - 49 SPECIFICATION SECTIONS

Item IV-3. Replace SECTION 012300 – ALTERNATES with revised Document, included in the Attachments.

Item IV-4. Replace SECTION 019113 – COMMISSIONING GENERAL REQUIREMENTS with revised Document, included in the Attachments.

Item IV-5. Replace SECTION 064023 – INTERIOR ARCHITECTURAL WOODWORK with revised Document, included in the Attachments.

Item IV-6. Replace SECTION 093000 – TILING with revised Document, included in the Attachments.

Item IV-7. SECTION 105500.16 - PRIVATE-DELIVERY POSTAL SPECIALTIES, Article: Make the following revisions:

- A. Article 2.1.A.1.c.1.a : Revise “Model 1: SC6048GH” to read “Model 1: SG6048GL.”
- B. Article 2.1.A.2.a.1: Revise “Size 1: Provide 50 compartments...” to read “Size 1: Provide 60 compartments...”

Item IV-8. SECTION 230500 – COMMON WORK RESULTS FOR HVAC, Article: Make the following revisions:

- A. Article 3.3.C.1: Revise “Substantial Completion” to read “Final Acceptance.”

Item IV-9. SECTION 232113 – HYDRONIC PIPING, Article: Make the following revisions:

- A. Article 1.7.A: Revise “Substantial Completion” to read “Final Acceptance.”

Item IV-10. SECTION 232500 – HVAC WATER TREATMENT, Article: Make the following revisions:

- A. Article 3.4.E: Revise “Substantial Completion” to read “Final Acceptance.”

Item IV-11. SECTION 238126 – SPLIT-SYSTEM AIR-CONDITIONERS, Article: Make the following revisions:

- A. Article 1.4.A: Revise “Substantial Completion” to read “Final Acceptance.”

Item IV-12. Replace SECTION 260533 – RACEWAY AND BOXES FOR ELECTRICAL SYSTEMS with revised Document, included in the Attachments.

Item IV-13. Replace SECTION 260548 – VIBRATION AND SEISMIC CONTROLS FOR ELECTRICAL SYSTEMS with revised Document, included in the Attachments.

Item IV-14. Replace SECTION 262413 – SWITCHBOARDS with revised Document, included in the Attachments.

Item IV-15. SECTION 321313 – CONCRETE PAVEMENT, Article: Make the following revisions:

- A. Article 3.12.D: Revise “Substantial Completion” to read “Final Acceptance.”

Item IV-16. SECTION 321400 – UNIT PAVERS, Article: Make the following revisions:

- A. Article 1.6.B.1: Revise “Substantial Completion” to read “Final Acceptance.”

REVISIONS TO DRAWING SHEETS

Item IV-17. Replace SHEET G-001 – NC BUILDING CODE SUMMARY OFFICE/SHOPS & WAREHOUSE with revised Sheet G-001, included in the Attachments.

Item IV-18. Replace SHEET G-002 – NC BUILDING CODE SUMMARY GAS STORAGE BUILDING AND CANOPIES with revised Sheet G-002, included in the Attachments.

Item IV-19. Replace SHEET G-005 – LIFE SAFETY SITE PLAN with revised Sheet G-005, included in the Attachments.

Item IV-20. Replace SHEET C403 – SITE DETAILS with revised Sheet C403, included in the Attachments.

Item IV-21. Replace SHEET C404 – SITE DETAILS with revised Sheet C404, included in the Attachments.

Item IV-22. Replace SHEET C600 – UTILITY PLAN with revised Sheet C600, included in the Attachments.

Item IV-23. Replace SHEET C603 – UTILITY DETAILS with revised Sheet C603, included in the Attachments.

Item IV-24. Replace SHEET S-201 – OFFICE/SHOPS BUILDING FOUNDATION PLAN – FOR REFERENCE ONLY with revised Sheet S-201, included in the Attachments.

Item IV-25. Replace SHEET S-202 – WAREHOUSE AND GAS STORAGE FOUNDATION PLAN – FOR REFERENCE ONLY with revised Sheet S-202, included in the Attachments.

Item IV-26. Replace SHEET S-601 – SECTIONS AND DETAILS with revised Sheet S-601, included in the Attachments.

Item IV-27. Replace SHEET A-004 – PARTITION TYPES with revised Sheet A-004, included in the Attachments.

Item IV-28. Replace SHEET A-103 - WASH RACK AND COVERED STORAGE CANOPIES (ALTERNATE NO. 2 & 12), with revised Sheet A-103, included in the Attachments.

Item IV-29. Replace SHEET A-252 – INTERIOR ELEVATIONS with revised Sheet A-252, included in the Attachments.

Item IV-30. Replace SHEET A-353 – WALL SECTIONS – OFFICE / SHOPS, WAREHOUSE AND MISC. BUILDINGS with revised Sheet A-353, included in the Attachments.

Item IV-31. Replace SHEET A-410 – TOILET ROOM PLANS AND SCHEDULE with revised Sheet A-410, included in the Attachments.

Item IV-32. Replace SHEET A-512 – SECTION DETAILS (EXTERIOR) with revised Sheet A-512, included in the Attachments.

Item IV-33. Replace SHEET A-551 – ROOF DETAILS with revised Sheet A-551, included in the Attachments.

Item IV-34. Replace SHEET A-601 – DOOR SCHEDULE & DOOR TYPES with revised Sheet A-601, included in the Attachments.

Item IV-35. Replace SHEET A-603 – FRAME, LOUVER, AND STOREFRONT ELEVATIONS with revised Sheet A-603, included in the Attachments.

Item IV-36. Replace SHEET FP-001 – FIRE PROTECTION - SPECIFICATIONS, NOTES AND SCHEDULES with revised Sheet FP-001, included in the Attachments.

Item IV-37. Replace SHEET FP-011 – FLOOR PLAN - OFFICE/SHOPS - FIRE PROTECTION with revised Sheet FP-011, included in the Attachments.

Item IV-38. Replace SHEET FP-012 – FLOOR PLAN - WAREHOUSE - FIRE PROTECTION with revised Sheet FP-012, included in the Attachments.

Item IV-39. Replace SHEET P-002 – PLUMBING SCHEDULES with revised Sheet P-002, included in the Attachments.

Item IV-40. Replace SHEET P-003 – PLUMBING DETAILS with revised Sheet P-003, included in the Attachments.

Item IV-41. Replace SHEET P-004 – PLUMBING DETAILS with revised Sheet P-004, included in the Attachments.

Item IV-42. Replace SHEET P-102B – FLOOR PLAN - WAREHOUSE - WASTE AND VENT - EAST with revised Sheet P-102B, included in the Attachments.

Item IV-43. Replace SHEET P-201A – FLOOR PLAN - PATS/FO - WATER AND GAS with revised Sheet P-201A, included in the Attachments.

Item IV-44. Replace SHEET M-005 – MECHANICAL SEQUENCE OF OPERATIONS with revised Sheet M-005, included in the Attachments.

Item IV-45. Replace SHEET M-006 – MECHANICAL POINTS LIST with revised Sheet M-006, included in the Attachments.

Item IV-46. Replace SHEET M-403 – ENLARGED MECHANICAL ROOM DETAILS with revised Sheet M-403, included in the Attachments.

Item IV-47. Replace SHEET E-001 – ELECTRICAL NOTES with revised Sheet E-001, included in the Attachments.

Item IV-48. Replace SHEET E-002 – ELECTRICAL DETAILS with revised Sheet E-002, included in the Attachments.

Item IV-49. Replace SHEET E-003 – ELECTRICAL DETAILS with revised Sheet E-003, included in the Attachments.

Item IV-50. Replace SHEET E-005 – ELECTRICAL DETAILS with revised Sheet E-005, included in the Attachments.

Item IV-51. Replace SHEET E-006 – ELECTRICAL DETAILS with revised Sheet E-006, included in the Attachments.

Item IV-52. Replace SHEET E-009 – ELECTRICAL SITE PLAN - OVERALL with revised Sheet E-009, included in the Attachments.

Item IV-53. Replace SHEET E-101A – FLOOR PLAN - PATS/FO - POWER with revised Sheet E-101A, included in the Attachments.

Item IV-54. Replace SHEET E-301A – REFLECTED CEILING PLAN - PATS/FO - SPECIAL SYSTEMS with revised Sheet E-301A, included in the Attachments.

Item IV-55. Replace SHEET E-401C – FLOOR PLAN - FO SHOPS - POWER/HVAC with revised Sheet E-401C, included in the Attachments.

Item IV-56. Replace SHEET E-501 – POWER RISER with revised Sheet E-501, included in the Attachments.

Item IV-57. Replace SHEET E-602 – PANEL SCHEDULES with revised Sheet E-602, included in the Attachments.

Item IV-58. Replace SHEET E-603 – PANEL SCHEDULES with revised Sheet E-603, included in the Attachments.

Item IV-59. Replace SHEET E-604 – PANEL SCHEDULES with revised Sheet E-604, included in the Attachments.

END OF ADDENDUM IV

**TABLE OF CONTENTS
FOR
FACILITIES OPERATIONS /
PARKING SERVICES COMPLEX
UNC CHARLOTTE
CHARLOTTE, NORTH CAROLINA**

(*Sections listed in *ITALICS* are included for Reference Only)

Cover Sheet
Project Directory and Seals Page
Table of Contents

VOLUME ONE

**DIVISION 00 – PROCUREMENT AND CONTRACTING REQUIREMENTS
ADVERTISEMENT FOR BIDS**

Notice to Bidders
General Conditions of the Contract (SCO Form OC-15CM Second Edition, January 2013)
Supplementary General Conditions of the Contract
Guidelines for Recruitment and Selection for Minority Businesses for Participation in State Construction
 Appendix E – MBE Documentation for Contract Payments
SCO MBE Participation Forms
 Affidavit A – List of Good Faith Efforts
 Affidavit B – Intent to Perform Contract with Own Workforce
 Affidavit C – Portion of the Work to be Performed by HUB Certified/Minority Business
 Affidavit D – Good Faith Efforts
Sale and Use Tax Report for State and County
003100 Available Information
 Geotechnical Report
 Hazardous Material Analysis

DIVISION 01 – GENERAL REQUIREMENTS

010000 General Requirements
011000 Summary
012100 Allowances
012200 Unit Prices
012300 Alternates
012500 Substitution Procedures
012600 Contract Modification Procedures
013100 Project Management and Coordination
013200 Construction Progress Documentation
013233 Photographic Documentation
013300 Submittal Procedures

	Digital Data Letter Agreement
014000	Quality Requirements
015000	Temporary Facilities and Controls
	Project Identification Signage
015600	Construction Cleaning
016000	Product Requirements
017300	Execution
017700	Closeout Procedures
017823	Operation and Maintenance Data
	Digital Management Exchange Guidelines (DMEG) for
	Facility Operations and Maintenance
017839	Project Record Documents
017900	Demonstration and Training
019113	Commissioning General Requirements

DIVISION 02 – EXISTING CONDITIONS

*024116 *Demolition*

DIVISION 03 - CONCRETE

*031000	<i>Concrete Formwork</i>
*032000	<i>Concrete Reinforcement</i>
*033000	<i>Cast-In-Place Concrete</i>
*033500	<i>Concrete Finishes</i>
033543	Polished Concrete Finishing
*033700	<i>Concrete Curing</i>

DIVISION 04 - MASONRY

042000	Unit Masonry
047200	Cast Stone Masonry

DIVISION 05 - METALS

*051200	<i>Structural Steel</i>
*052100	<i>Open Web Joists</i>
*053100	<i>Metal Roof Decking</i>
054000	Cold-Formed Metal Framing
054010	Cold-Formed Steel Trusses
*055213	<i>Pipe and Tube Railings</i>

DIVISION 06 - WOOD, PLASTICS, AND COMPOSITES

061000	Rough Carpentry
061600	Sheathing
064023	Interior Architectural Woodwork
066400	Plastic Paneling

DIVISION 07 - THERMAL AND MOISTURE PROTECTION

071113	Bituminous Dampproofing
--------	-------------------------

071326	Self-Adhering Sheet Waterproofing
072100	Thermal Insulation
072726	Fluid-applied Membrane Air Barriers
074113	Metal Roof Panels
076200	Sheet Metal Flashing and Trim
077200	Roof Accessories
077253	Snow Guards
078413	Penetration Firestopping
078446	Fire-Resistive Joint Systems
079200	Joint Sealants

DIVISION 08 - OPENINGS

081113	Hollow Metal Doors and Frames
081416	Flush Wood Doors
083113	Access Doors and Frames
083323	Overhead Coiling Doors
084113	Aluminum-Framed Entrances and Storefronts
087100	Door Hardware
087113	Automatic Door Operators
088000	Glazing
088300	Mirrors
089119	Fixed Louvers

DIVISION 09 - FINISHES

092216	Non-Structural Metal Framing
092400	Cement Plastering
092900	Gypsum Board
093000	Tiling
095113	Acoustical Panel Ceilings
096513	Resilient Base and Accessories
096519	Resilient Tile Flooring
096813	Tile Carpeting
096823	Static Control Tile Carpeting
099113	Exterior Painting
099123	Interior Painting
099600	High-Performance Coatings

DIVISION 10 - SPECIALTIES

101100	Visual Display Units
101423	Panel Signage
101426	Post and Panel/Pylon Signage
102113.19	Plastic Toilet Compartments
102600	Wall and Door Protection
102800	Toilet and Bath Accessories
104400	Fire Protection Specialties
105113	Metal Lockers

105143 Chain Link Storage Partitions
105500.16 Private-Delivery Postal Specialties

DIVISION 11 - EQUIPMENT

111313 Loading Dock Bumpers
111319 Stationary Loading Dock Equipment
113100 Residential Appliances

DIVISION 12 - FURNISHINGS

122113 Horizontal Louver Blinds

DIVISION 13 – SPECIAL CONSTRUCTION

133419 Metal Building Systems

VOLUME TWO

DIVISION 21 – FIRE SUPPRESSION

210500 Fire Protection System General
211313 Wet-Pipe Sprinkler Systems
211316 Dry-Pipe Sprinkler Systems
213000 Electric-Drive, Centrifugal Fire Pumps

DIVISION 22 – PLUMBING

220500 Plumbing General
220503 Plumbing Pipe, Tube and Fittings
220523 General-Duty Valves for Plumbing Piping
220529 Hangers and Supports for Plumbing Piping and Equipment
220553 Identification for Plumbing Piping and Equipment
220700 Plumbing Insulation
220800 Commissioning of Plumbing Systems

DIVISION 23 – HEATING, VENTILATION, AND AIR CONDITIONING (HVAC)

230500 Common Work Results for HVAC
230513 Common Motor Requirements for HVAC Equipment
230516 Expansion Fittings and Loops for HVAC Piping
230519 Meters and Gages for HVAC Piping
230523 General-Duty Valves for HVAC Piping
230529 Hangers and Supports for HVAC Piping and Equipment
230548 Vibration Controls for HVAC Piping and Equipment
230553 Identification for HVAC Piping and Equipment
230593 Testing, Adjusting, and Balancing for HVAC
230700 HVAC Insulation
230800 Commissioning of Mechanical Systems
230900 Instrumentation and Control for HVAC
232113 Hydroponic Piping

232114	Underground Pre-Insulated Hydroponic Piping
232123	Hydroponic Pumps
232300	Refrigerant Piping
232500	HVAC Water Treatment
233113	Metal Ducts
233300	Air Duct Accessories
233423	HVAC Power Ventilators
233600	Air Terminal Units
233713	Diffusers, Registers, and Grilles
233723	HVAC Gravity Ventilators
235216	Condensing Boilers
236426	Air Cooled Chillers
237323	Indoor Air Handling Units
238126	Split-System Air-Conditioners
238219	Fan Coil Units

DIVISION 25 – INTEGRATED AUTOMATION

250800	Commissioning of Integrated Automation Systems
--------	--

DIVISION 26 - ELECTRICAL

260500	Common Work Results for Electrical
260513	Medium-Voltage Cables
260519	Low-Voltage Electrical Power Conductors and Cables
260526	Grounding and Bonding for Electrical Systems
260529	Hangers and Supports for Electrical Systems
260533	Raceways and Boxes for Electrical Systems
260543	Underground Ducts and Raceways for Electrical Systems
260548	Vibration and Seismic Controls for Electrical Systems
260553	Identification for Electrical Systems
260800	Commissioning of Electrical Systems
260923	Lighting Control Devices
261200	Medium-Voltage Transformers
262200	Low-Voltage Transformers
262413	Switchboards
262416	Panelboards
262726	Wiring Devices
262813	Fuses
262816	Enclosed Switches and Circuit Breakers
263600	Transfer Switches
264113	Lightning Protection for Structures
264313	Transient-Voltage Suppression for Low-Voltage Electrical Power Circuits
265100	Interior Lighting
265119	LED Interior Lighting

DIVISION 27 - COMMUNICATIONS

270526	Grounding and Bonding for Communications Systems
--------	--

270536	Cable Trays for Communication Systems
270544	Sleeves and Sleeve Seals for Communications Pathways and Cabling
271100	Communications Equipment Room Fittings

DIVISION 28 – ELECTRONIC SAFETY AND SECURITY

280528	Pathways for Electronic Safety and Security
281300	Access Control
283111	Digital, Addressable Fire-Alarm System

DIVISION 31 - EARTHWORK

310000	Earthwork
*311000	<i>Site Clearing</i>
*312316.13	<i>Trench Excavation and Backfill</i>
312316.26	Rock Excavation
312319	Dewatering
*312500	<i>Erosion Control</i>
313116	Termite Control

DIVISION 32 – EXTERIOR IMPROVEMENTS

321216	Asphalt Paving
321313	Concrete Paving
321373	Pavement Joint Sealants
321400	Unit Pavers
323119	Decorative Metal Fence

DIVISION 33 – UTILITIES

*330000	<i>Utility Services</i>
*331000	<i>Water Distribution</i>
*333000	<i>Sanitary Sewer</i>
*334000	<i>Storm Drainage</i>

DIVISION 34 – TRANSPORTATION

340000	Transportation
--------	----------------

END OF TABLE OF CONTENTS



ADVERTISEMENT FOR BIDS

UNC Charlotte Facilities Operations and Parking Services Complex Building Phase

New Atlantic Contracting, Construction Manager, will accept sealed bids for Building phase of the UNC Charlotte, Facilities Operations and Parking Services Complex project from Pre-Qualified Contractors for the following Bid Packages:

- 2B SITE FENCING
- 3B POLISHED CONCRETE
- 4A MASONRY
- 6A ARCHITECTURAL CASEWORK & COUNTERTOPS
- 7A WATERPROOFING / AIR BARRIER / JOINT SEALANTS
- 7B ROOFING & GUTTERS
- 8A DOORS, FRAMES, & HARDWARE
- 8B OVERHEAD DOORS & LOADING DOCK EQUIPMENT
- 8C STOREFRONT / GLASS & GLAZING
- 9A GYPSUM BOARD ASSEMBLIES
- 9B ACOUSTICAL CEILINGS
- 9C TILE
- 9D FLOORING (CARPET & RESILIENT)
- 9E PAINTING
- 10A SPECIALTIES (TOILET ACCESSORIES & PARTITIONS, FEC, APPLIANCES)
- 10B SIGNAGE
- 10C METAL LOCKERS
- 12A WINDOW TREATMENTS
- 13A PRE-ENGINEERED BUILDINGS
- 15A FIRE PROTECTION
- 15B PLUMBING
- 15C HVAC
- 16A ELECTRICAL

Sealed proposals will be received at the Cone University Center Building, Lucas Room (#341), on the University of North Carolina at Charlotte Campus on **Tuesday, September 19, 2017 at 2:00pm** and immediately thereafter publicly opened. For directions see <http://facilities.uncc.edu/maps>. Paid parking is available at the Cone Visitor Parking Deck.

For those not attending the bid opening, sealed proposals may also be submitted via hand delivery or courier delivery no later than **1:00PM** on the bid opening day to:

Mailed Bids:

Attn: Ms. Joyce Clay
The University of North Carolina at Charlotte
Facilities Management – Capital Project
9201 University City Boulevard
Charlotte, NC 28223-0001

Or

Hand Delivered:

Attn: Ms. Joyce Clay – 2nd Floor Capital Projects - (704) 687-0615
Facilities Management/Campus Police Building (#55 on the campus map)
9151 Cameron Boulevard
Charlotte, NC 28223

New Atlantic Contracting invites all Minority contractors and suppliers to participate in the bidding process.

A pre-bid meeting will be held at 10:30am on August 29, 2017 at the Cone Center Building Rm 111.

The meeting is also to identify preferred brand alternates and their performance standards that the owner will consider for approval on this project.

Per G.S. 133-3, on Tuesday, August 29, 2017 at 10:30am UNC Charlotte would like to hereby serve public notice of formal notification of preferred brand alternates. Any and all persons shall use this time to state concerns or reservation of any preferred alternates.

- **Door Hardware** - Provide Schlage Locksets, (no substitutions) as described in Specification Section 087100.
- **Fire Alarm** – Provide Simplex Fire Detection Systems, (no substitutions) as described in Specification Section 283111.
- **Access Control** – Provide Open Option Systems, (no substitutions) as described in Specification Section 281300
- **Unit Masonry** – Provide Hanson Brick, “Morrocroft Special” brick (no substitutions), as described in Specification Section 042000
- **Unit Pavers** – Provide Pine Hall, English Edge Pavers, (no substitutions) as described in Specification Section 321400.

Justification of any approvals will be made available to the public in writing no later than seven (7) days prior to bid date.

Contract Documents may be purchased from the following locations:

- ⇒ **Triad Area:** Sharpe Co., P: (336) 724-2871, 1020 Burke Street, Winston-Salem, NC 27101
- ⇒ **Charlotte Area:** Sharpe Co., P: (800) 688-0629, 532 S. New Hope Road, Charlotte, NC 28217

Complete plans, specifications and contract documents will be open for inspection at:

1. Construction Manager - New Atlantic Contracting, Inc., 2635 Reynolda Rd, Winston-Salem, NC 27106, Phone: (336) 759-7440.
2. Designer – LS3P, 227 W Trade Street, Suite 700, Charlotte, NC 28208, Phone: (704) 371-7845

3. Owner – UNC Charlotte, Facilities Management/Police Building, 2nd floor – Capital Projects, 9151 Cameron Blvd, Charlotte, NC 28223, Phone: (704) 687-0615

Digital copies of the plans, specifications and contract documents are available at the following;

1. New Atlantic Contracting website – www.new-atlantic.net
 - a. Click “Subcontractor Portal” – open the “Estimating” folder
2. Construct Connect at content@constructconnect.com, (800) 364-2059
3. North Carolina Offices of Dodge Data & Analytics – (800) 393-6343 – <http://dodgeprojects.construction.com/>
4. Metrolina Minority Contractors Association (MMCA) – mmca@mmcaofcharlotte.org, (877) 526-6205

For further information contact Grady Dwiggin at 336-759-7440 or gdwiggin@new-atlantic.net

NOTE: Bids will be accepted from pre-qualified bidders only. The bidder shall include with the bid proposal the form Identification of Minority Business Participation identifying the minority business participation it will use on the project and shall include either Affidavit **A** or Affidavit **B** as applicable. Forms and instructions are included within the Proposal Form in the Bid Documents. Failure to complete these forms is grounds for rejection of bid. (GS143-128.2C Effective 1/1/2002).

New Atlantic Contracting is an Equal Opportunity Employer.

SECTION 012300 - ALTERNATES

PART 1 - GENERAL

1.1 SUMMARY

- A. This Section includes administrative and procedural requirements for alternates.

1.2 DEFINITIONS

- A. Alternate: An amount proposed by bidders and stated on the Bid Form for certain work defined in the Bidding Requirements that may be added to or deducted from the Base Bid amount if Owner decides to accept a corresponding change either in the amount of construction to be completed or in the products, materials, equipment, systems, or installation methods described in the Contract Documents.
1. The cost or credit for each alternate is the net addition to or deduction from the Contract Sum to incorporate alternate into the Work. No other adjustments are made to the Contract Sum.
- B. Base Bid: The amount for which the bidder proposes to perform the Work, not including that work for which Alternate bids are also submitted.

1.3 PROCEDURES

- A. Coordination: Modify or adjust affected adjacent work as necessary to completely integrate work of the alternate into Project.
1. Include as part of each Alternate, miscellaneous devices, accessory objects, and similar items incidental to or required for a complete installation whether or not indicated as part of alternate.
- B. Notification: Immediately following award of the Contract, notify each party involved, in writing, of the status of each alternate. Indicate if alternates have been accepted, rejected, or deferred for later consideration. Include a complete description of negotiated modifications to alternates.
- C. Execute accepted alternates under the same conditions as other work of the Contract.
- D. Schedule: A Schedule of Alternates is included at the end of this Section. Specification Sections referenced in schedule contain requirements for materials necessary to achieve the work described under each alternate.

PART 2 - PRODUCTS (Not Used)

PART 3 - EXECUTION

3.1 SCHEDULE OF ALTERNATES

- A. Alternate No. 1: Provide brick façade in lieu of metal siding on the south facade of Warehouse building as detailed on the Drawings and described in the Specifications.
- B. Alternate No. 2A: Provide pre-engineered metal canopy for Wash Rack as detailed on the Drawings and described in the Specifications.
- C. Alternate No. 2B: Provide decorative CMU masonry walls, on two sides, and roof for Wash Rack in lieu of pre-engineered metal canopy as detailed on the Drawings and described in the Specifications.

- D. Alternate No. 3: Provide decorative CMU with ribbed interior finish masonry screenwall with precast cap in lieu of chain link fence around Service Yard as detailed on the Drawings and described in the Specifications.
- E. Alternate No. 8: Extend telecomm infrastructure along Poplar Lane as detailed on the Drawings. Scope of work includes new concrete encased duct bank from existing manhole to new Telecommunications manhole.
- F. Alternate No. 9: Provide decorative CMU masonry screenwall with precast cap in lieu of decorative metal fence along south edge of complex as detailed on the Drawings and described in the Specifications.
- G. Alternate No. 10: Condition shops areas as indicated on the Drawings and described in the Specifications.
- H. Alternate No. 11: Install event power as indicated on the Drawings and described in the Specifications.
- I. Alternate No. 12: Provide pre-engineered metal canopy for Covered Storage as detailed on the Drawings and described in the Specifications.
- J. Alternate No. 13: Provide lightning protection system as described in the specifications.
- K. Alternate No. 4A: Provide Gravel Bus Parking as detailed on the Drawings.**
- L. Alternate No. 4B: Provide Concrete Bus Parking in lieu of gravel as detailed on the Drawings.**
- M. Alternate No. 5: Provide Sanitary Dump Station as detailed on the Drawings.**

3.2 SCHEDULE OF OWNER PREFERRED ALTERNATES: State the amount to be added to the base bid to provide the Work required to provide the following Owner preferred items in lieu of base bid items specified:

- A. Alternate No. P1: Provide Schlage Locksets, (no substitutions) as described in Specification Section 087100.
- B. Alternate No. P2: Provide Simplex Fire Detection Systems, (no substitutions) as described in Specification Section 283111.
- C. Alternate No. P3: Provide Open Option Systems, (no substitutions) as described in Specification Section 281300.
- D. Alternate No. P4: Provide Hanson Brick, “Morrocroft Special” brick (no substitutions), as described in Specification Section 042000.
- E. Alternate No. P5: Provide Pine Hall, English Edge Pavers, (no substitutions) as described in Specification Section 321400.

END OF SECTION 012300

SECTION 019113 – COMMISSIONING GENERAL REQUIREMENTS

PART 1 - GENERAL

1.1 RELATED DOCUMENTS

- A. Contract Drawings and provisions of the Contract, including General and Supplementary Conditions and other Division 01 Specification Sections apply to this Section.
- B. Section 220800 – Commissioning of Plumbing Systems
- C. Section 230800 – Commissioning of Mechanical Systems
- D. Section 250800 – Commissioning of Integrated Automation Systems
- E. Section 260800 – Commissioning of Electrical Systems
- F. Commissioning Plan

1.2 DESCRIPTION OF WORK

- A. An independent third party Commissioning Agent has been retained to lead the project participants through the commissioning process. The section below is provided for informational purposes and to inform the contractor of the extent of the commissioning process and the involvement required. The Commissioning Agent is RMF Engineering, Inc.
- B. The purpose of the construction phase commissioning is to provide the Owner and Operators of the facility with a high level of assurance that each commissioned system has been installed in the prescribed manner and operates within the performance guidelines set forth in the design intent. The Commissioning Agent shall provide the Owner with an unbiased, objective view of the system's installation, operation, and performance. This commissioning process shall not take away or reduce the responsibility of the System Design Professional(s) or installing contractors to provide a finished product. Commissioning is intended to enhance the quality of system start-up and aid in the orderly transfer of systems to beneficial use by the owner. The Commissioning Agent will be a member of the construction team, cooperating and coordinating all commissioning activities with the Owner, Design Professionals, Construction Manager or General Contractor, Subcontractors, Manufacturers and Equipment Suppliers.

1.3 DEFINITIONS

- A. Commissioning Agent: The Commissioning Agent is a third party consulting company interested in providing quality control to the project and quality assurance to the Owner. The Commissioning Agent provides a non-biased perspective of issues. The goal of the Commissioning Agent is to discover equipment and system issues early and resolve them quickly for an overall smooth construction process and to keep costs down for both the Owner and Contractor(s).

- B. Commissioning Team: The Commissioning Team is a group of individuals selected by each company to represent that company for direct involvement in the commissioning activities during the construction phase of the project. A minimum of one individual must be included to represent every company. Companies include but are not limited to; Commissioning Agent, Owner, Architect, System Design Engineer, Construction Manager or General Contractor, and all Sub-Contracting Companies.
- C. System Design Professional(s): The System Design Professional(s) are the designers and design firm representatives for the mechanical, electrical, plumbing, telecommunications and other systems outside of the scope of the Architect. Typically, the System Design Professional(s) do not include structural and civil design representatives unless structural or civil systems are specifically included within, or are associated with the systems being commissioned.
- D. Contractor(s): The term Contractor(s) utilized herein refers to the primary contracting party responsible for the specific item being referenced. Contractor(s) may refer to one or more of the general contractors, construction managers, sub-contractors and/or vendors whom are responsible for the construction or other provisions regarding any of the systems to be commissioned as outlined within Specification 019113 Section 1.5 - Systems to be Included in Commissioning. Contracting parties outside of the scope of the systems being commissioned are not included.
- E. Subcontractors: The term Subcontractors utilized herein refers to the any and all subcontracting companies or vendors whom are responsible for the construction or other provisions regarding any of the systems to be commissioned as outlined within Specification 019113 Section 1.5 - Systems to be Included in Commissioning. Subcontracting parties outside of the scope of the systems being commissioned are not included.

1.4 ROLES AND RESPONSIBILITIES

A. Owner

1. The commissioning roles and responsibilities of the Owner are outlined within the Commissioning Plan. The Owner is not contractually obligated to complete any tasks defined within the Commissioning Plan. Rather, the roles and responsibilities defined within the Commissioning Plan are in the best interest of the Owner and are highly recommended for the successful completion of Commissioning.
2. If the Owner's Project Requirements have been outlined and documented, the Owner shall provide a copy of this document to the Commissioning Agent. This document shall set the goals towards which each of the commissioning tools implemented will drive the final product.
3. The Owner shall be required to review many Commissioning Forms prior to their completion. The Owner must verify that the forms are constructed and being utilized in the most effective way for their own benefit. Commissioning documentation should only provide information which will be useful to the Owner and their Operations and Maintenance throughout the construction process and in the future.

B. Commissioning Agent

1. Schedule the Construction Phase Commissioning Kick-Off meeting within 90 days of the award of the contract, at some convenient location and at a time suitable to the Contractor and System Design Professional(s). This meeting shall be for the purpose of reviewing the complete commissioning program and establishing tentative schedules for system orientation and inspections, O&M submittals, training sessions, system flushing and testing, job completion, test, adjust and balance (TAB) work, and verification and functional performance testing.
2. Prepare the Commissioning Plan after the Commissioning Kick-Off meeting. Include list of all contractors for commissioning events by name, firm and trade specialty.
3. Coordinate the integration of Commissioning Activities into the Construction Schedule. The Commissioning Agent shall hold a meeting with the Owner, System Design Professional(s) and all Contractors for the explicit purpose of integrating each Commissioning Activity into the Construction Schedule. See Specification 019113 Section 2.1 – Project Schedule for details.
4. Review all documentation regarding changes to the Contract Documents or Clarifications. These include Meeting Minutes, Addendums, RFI's, Change Orders, ASI's, etc. for their effect on Commissioning. The Commissioning Agent shall receive a copy of all submittals pertaining to the systems being commissioned from the Contractor(s). The Commissioning Agent shall review all submittals for approval. Commissioning submittal review shall be coordinated with the System Design Professional(s) review to avoid redundancy. Submittal approval by the Commissioning Agent shall not supersede any submittal comments or rejection by the System Design Professional(s) and vice versa.
5. Review submittals associated with systems to be commissioned (e.g. equipment, ductwork, piping, automatic controls, and TAB procedures, etc.) for their affect on the commissioning process and the final performance of the HVAC system.
6. The Commissioning Agent shall receive a copy of all controls submittals from the Contractor(s). The Commissioning Agent shall perform an explicit review of these submittals to verify their compliance with the design sequence of events and Owner's Project Requirements.
7. Provide Pre-Functional Checklists for the purposes of verifying proper installation. Checklists shall be based upon submitted documentation and updates to the Construction Documents.
8. The Commissioning Agent shall conduct approximately 12 Commissioning Meetings throughout the construction phase. Meetings shall be held more frequently as Commissioning Activities increase. Meetings are typically held monthly until systems are prepared for verification testing. The Commissioning Agent shall prepare minutes for every Commissioning Meeting and distribute copies to all attendees and other interested parties.
9. Attend select Coordination Meetings, aside from Commissioning Meetings, held between the Owner, System Design Professional(s) and Contractor(s).
10. The Commissioning Agent shall conduct periodic inspections of work in progress and shall generate and distribute a report for each inspection. The Commissioning Agent shall also perform select site visits for the explicit purpose of witnessing duct and piping pressure test procedures. The Commissioning Agent shall perform select site visits for the explicit purpose of witnessing piping system cleaning and flushing procedures. All issues and discrepancies found during these inspections shall be listed on a Commissioning Issues Log, maintained by the Commissioning Agent.
11. Submit detailed installation checklists entitled Pre-Functional Checklists. These checklists shall be developed by the Commissioning Agent specific to the project and

- shall be required to be completed by the installing contractors. The Commissioning Agent is required only to spot-check these checklists upon completion of the installations.
12. Submit detailed Functional Performance Test procedures for review and acceptance by the Commissioning Team. These tests are specifically custom designed by the Commissioning Agent for verifying each system operates per the design intent and meets both the Basis of Design (BOD) and the Owner's Project Requirements (OPR.)
 13. Provide and install calibrated data loggers to monitor and record data as required by the Functional Performance Tests.
 14. Upon receipt of notification from the System Design Professional(s) that the mechanical systems have been completed and are operational, the Commissioning Agent shall proceed to verify on a random basis the TAB report and operation of the control systems in accordance with the Commissioning Specification. The Commissioning Agent shall recommend acceptance of the Final Test, Adjustment and Balance Report.
 15. Oversee Functional Performance Testing which shall be performed by the installing contractors. All issues and discrepancies found during Functional Performance Testing shall be listed on the Commissioning Issues Log, maintained by the Commissioning Agent.
 16. The Commissioning Agent shall not perform any site visits for the purpose of witnessing Functional Performance Testing until the installing contractor has verified that the system is ready for Functional Performance Testing and made proper notice to the Commissioning Agent with appropriate lead time.
 17. Witness repeated conducting of Functional Performance Tests if deficiencies are found during the original testing. The Commissioning Agent will invoice the Owner for additional time required for any retesting, and the Owner at his discretion may deduct this cost from the CM's Application for Payment. It is the Contractors' responsibility to properly de-bug systems and verify successful system performance prior to inviting the Commissioning Agent to witness the test.
 18. Prepare the Final Commissioning Report. Submit completed Functional Performance Tests as part of Final Report to the owner. Recommend acceptance of the Final Product, by the Owner, based upon the results of Commissioning.
 19. Repeat Functional Performance Tests to accommodate seasonal tests.

C. Construction Manager / General Contractor

1. Read, understand and follow the Commissioning Plan as a guideline for the Commissioning Process implemented into this construction project.
2. Include commissioning requirements in the mechanical subcontracts, electrical subcontracts, and all other subcontracts relating to the systems to be commissioned as outlined within Specification 019113 Section 1.5 - Systems to be Included in Commissioning. Ensure full cooperation of all contracting, manufacturing and testing parties required to participate in commissioning.
3. Include cost for commissioning requirements in the contract price. Include specific line items within the Schedule of Values according to Specification 019113 Section 2.2 – Schedule of Values.
4. Provide copies of the Project Schedule to the Commissioning Agent as outlined within Specification 019113 Section 2.1 – Project Schedule. Update the overall project schedule to reflect all Commissioning Activities. Ensure cooperation by subcontractors in coordinating the inclusion of subcontractor activities related to commissioning into the overall Project schedule.

5. Provide all submittals to the Commissioning Agent as outlined within Specification 019113 Section 2.3 – Submittals.
6. Ensure acceptable representation, with the means and authority to prepare and coordinate execution of the entire commissioning program as described in the contract documents.
7. Provide a representative to regularly attend every Commissioning Meeting. Ensure all Subcontractors also provide a representative at each Commissioning Meeting. These representatives are to remain the same individual throughout the construction project unless termination with the representing company occurs or their replacement is approved by the Owner and Commissioning Agent.
8. Coordinate all scheduled commissioning activities with the Commissioning Agent. The Contractor(s) must apprise the Commissioning Agent of various construction activities. These activities include but are not limited to: System Start-up, Equipment Start-up, Duct Pressure Tests, Pipe Pressure Tests, Pipe Flushing and Cleaning, Completion of Pre-Functional Checklists, readiness for Functional Performance Testing and System Completion.
9. Remedy all contractual deficiencies as outlined within the Commissioning Issues Log. The Commissioning Agent shall issue an updated deficiency log throughout construction based upon site visits, Pre-Functional Checklist completion, Commissioning Meeting topics and Functional Performance Test results.
10. Maintain a master copy of all PFC's. There are several methods for keeping these documents organized which is the responsibility of the Construction Manager/General Contractor. Reference the Commissioning Plan for examples of methods previously utilized to keep these documents organized. The Construction Manager/General Contractor must verify all PFC's and FPT's are complete. Sign all completed PFC's and FPT's prior to inviting the Commissioning Agent to witness and sign-off on these documents.
11. Evaluate performance deficiencies identified in the completed FPT's for non-conformance with contract documents. Remedy all contractual deficiencies identified in through Functional Performance Testing and other verification tests.
12. The Commissioning Agent shall not have any direct authority to order construction changes or make any project alterations without the written approval of the Owner or System Design Professional. Any changes or project alterations made by a Contractor(s) without such written approval shall be the responsibility of that Contractor(s).

D. Subcontractors

1. Subcontractor responsibilities are outlined within respective Commissioning Specification Sections.
 - a. Plumbing Subcontractor responsibilities are outlined in Section 220800 – Commissioning of Plumbing Systems
 - b. Mechanical Subcontractor responsibilities are outlined in Section 230800 – Commissioning of HVAC Systems.
 - c. Controls Subcontractor responsibilities are outlined in Section 250800 – Commissioning of Integrated Automation Systems
 - d. Electrical Subcontractor responsibilities are outlined in Section 260800 – Commissioning of Electrical Systems.
 - e. All Subcontractors are additionally responsible for all requirements outlined within this Specification Section 019113 – Commissioning General Requirements.

2. Provide a representative at each Commissioning Meeting. These representatives are to remain the same individual throughout the construction project unless termination with the representing company occurs or their replacement is approved by the Owner and Commissioning Agent. The Subcontractor(s) must attend the Commissioning "Card Trick" Meeting as defined within Specification 019113 Section 1.7 – Schedule and provide all schedule activities and durations within their scope.
3. All Subcontractors must follow the same procedure for the completion of Pre-Functional Checklists as organized by the Construction Manger/General Contractor.
4. The Commissioning Agent shall not have any direct authority to order construction changes or make any project alterations without the written approval of the Owner or System Design Professional. Any changes or project alterations made by any Contractor(s) without such written approval shall be the responsibility of that Contractor(s).

1.5 SYSTEMS TO BE INCLUDED IN COMMISSIONING

- A. For the systems listed, all requirements specified within the Commissioning Specifications Sections 019113, 220800, 230800, 250800, and 260800 shall apply including but not limited to:
 1. All system related documentation shall be tracked within forms provided by the Commissioning Agent.
 2. All required equipment and component submittals shall be copied to the Commissioning Agent per Specification 019113 Section 2.3 – Submittals.
 3. All system related documentation shall be copied by the Contractor and provided to the Commissioning Agent for inclusion into the Commissioning Record Documents.
 4. All systems shall be inspected by the Commissioning Agent while under construction and all issues discovered by the Commissioning Agent shall be corrected or otherwise addressed by the contractor.
 5. All systems shall have Pre-Functional Checklists and Functional Performance Tests provided by the Commissioning Agent and completed by the Contractor(s) as per Specification 019113 Sections 2.4 – Pre-Functional Checklists and 2.6 – Functional Performance Tests.
- B. The following systems, equipment and components shall be commissioned:

<u>Primary System</u>	<u>Sub-System</u>
Chilled Water System	Water Cooled Chillers Primary Pumps Secondary Pumps Piping Systems and Accessories ²
Ventilation Air System	Office/Admin Air Handling Unit Office VAV Terminal Units Warehouse Core Air Handling Unit Warehouse Core Terminal Units Warehouse Storage Single Zone Air Handling Unit Shop Ventilation and Specialty Exhaust
Hot Water System	Condensing Natural Gas Boilers Primary Hot Water Pumps

<u>Primary System</u>	<u>Sub-System</u>
	Secondary Hot Water Pumps Piping System and Accessories ²
Domestic Water	Domestic Water Booster Pump Domestic Hot Water System
Electrical System	Medium Voltage Distribution with Campus Loop 1500 KVA 480/277 Transformer 750 KW Emergency Power Generator Paralleling Switchgear Main Switch Boards Panel Boards Interior Lighting Control/Occupancy Sensors

²Strainers, Expansion Tanks, Air Separators, Duct Detectors, Dampers, etc.

1.6 COORDINATION

- A. General coordination is required by the Owner, Architect, System Design Professional(s), Contractor(s) and the Commissioning Agent to maintain an efficient commissioning process.
- B. The Architect, System Design Professional(s) and Contractor(s) shall submit to the Commissioning Agent a copy of all construction documents, addenda, change orders, overall project schedule, and any approved submittals, shop drawings, value engineering proposals and training plan related to commissioned systems.
- C. The Commissioning Authorities primary responsibility is to the Owner, and as such, shall regularly apprise the Contractor and the Owner of progress, pending problems and/or disputes, and shall provide regular status updates on progress with each system.
- D. The Commissioning Agent shall coordinate the schedule of commissioning activities with the construction schedule with assistance from the Owner, Architect, System Design Professional(s) and Contractor(s).
- E. The Contractor(s) must apprise the Commissioning Agent of various construction activities. These activities include: System Start-up, Duct Pressure Tests, Pipe Pressure Tests, Pipe Flushing and Cleaning, Completion of Pre-Functional Checklists, readiness for Functional Performance Testing and System Completion.

1.7 SCHEDULE

- A. Commissioning of systems shall proceed per the criteria established in the specific sections that follow, with activities to be performed on a timely basis. Site visits which are specifically scheduled for the purpose of demonstrating system functionality shall be coordinated by the Contractor(s) such that all required parties are present during the visit. The Contractor(s) shall be responsible for demonstrating system functionality during these scheduled periods.

- B. All Commissioning activities which require the presence of the Commissioning Agent shall be scheduled such that the Commissioning Agent is made aware of the required site visit with a minimum of two weeks (14 days) notice.
- C. Upon the discovery of deficient items during inspection or testing, the Contractor(s) shall be notified via distribution of an updated Commissioning Issues Log. Additional visits to the site for re-inspection or re-testing shall be scheduled as required. Prior to these additional visits, related deficiencies shall be rectified by the responsible party. The Contractor(s) shall be responsible for ensuring that all required corrective actions are performed in a timely manor in order to maintain the project schedule.
- D. Contractor schedules and scheduling is the responsibility of the Contractor(s). The Commissioning Agent shall provide commissioning scheduling information to the Construction Manager or General Contractor for incorporation into the main CPM schedule for review and planning activities.
- E. The Commissioning Agent shall hold a meeting with the Owner, System Design Professional(s) and all Contractors for the explicit purpose of integrating each Commissioning Activity into the Construction Schedule. Contractor(s) shall be required to be prepared with construction activities and durations as they enter this meeting. Activities shall be any which are related to the Commissioning of Systems as Identified in Specification 019113 Section 1.5 – Systems to be Included in Commissioning and shall include but not be limited to the following: Building Envelope Enclosure, Equipment Installations, Equipment Start-up, Duct Pressure Tests, Pipe Pressure Tests, Pipe Flushing and Cleaning, Construction Clean-up, System Start-up, Test and Balance, System Completion, etc.
- F. Prior to ~~substantial completion~~ **Final Acceptance**, all Functional Performance Tests must be successfully completed and documented by the Commissioning Agent, such that each tested system has proven full and efficient functionality.

1.8 RELATED WORK SPECIFIED ELSEWHERE

- A. Commissioning requires support from the contractors. The commissioning process does not relieve any contractors from their obligations to complete all portions of work in a satisfactory manner prior to commissioning any system.
- B. Refer to Sections 220800, 230800, 250800, and 260800 for contractor responsibilities relative to the commissioning process.

PART 2 - PRODUCTS

2.1 PROJECT SCHEDULE

- A. Contractor(s) shall submit two copies of a complete project schedule to the Commissioning Agent. The Contractor(s) must submit the schedule no later than two weeks after the Commissioning Kick-Off Meeting.

- B. Contractor(s) shall be required to incorporate all Commissioning Activities into the overall project schedule.

2.2 SCHEDULE OF VALUES

- A. The Contractor(s) shall include within the Schedule of Values, specific line items to reflect Commissioning progress. For each system to be commissioned as outlined in Specification 019113 Section 1.5 – Systems to be Included in Commissioning, a line item shall be listed in the Schedule of Values for the following:
 - 1. Pre-Functional Checklist
 - 2. System Start-Up
 - 3. Functional Performance Test
 - 4. Equipment/System Training
- B. The Contractor(s) shall submit two copies of the Schedule of Values to the Commissioning Agent for review. The Commissioning Agent shall review and comment on line items relevant to commissioning and systems to be commissioned. Any comments by the Commissioning Agent will be forwarded to the System Design Professional(s) for review and inclusion.

2.3 SUBMITTALS

- A. Contractor(s) shall submit two copies of all equipment and component submittals to the Commissioning Agent for each of the Systems to Be Commissioned as outlined within this specification section. Any comments by the Commissioning Agent will be forwarded to the System Design Professional(s) for review and inclusion.
- B. Manufacturer's Product Data: The Contractor(s) shall provide to the Commissioning Agent all product data as required within each individual specification section.
- C. Coordination Drawings: The Contractor(s) shall provide to the Commissioning Agent all Coordination Drawings as required within each individual specification section.
- D. Manufacturer's Installation Instructions: The Contractor(s) shall provide to the Commissioning Agent a minimum of one copy of installation instructions for every piece of equipment and accessory included as part of a commissioned system.
- E. Manufacturer's Controls Calibration Instructions: The Contractor(s) shall provide to the Commissioning Agent a minimum of one copy of calibration instructions for each type of control device to be installed. Submit only control device calibration instructions for devices which have been approved by the System Design Professional(s).
- F. The Contractor(s) shall submit a copy of the Record Documents to the Commissioning Agent for review. The Commissioning Agent shall forward comments to the Owner, Architect, System Design Professionals and Contractor(s). The Commissioning Agent shall recommend approval of the Record Documentation.

- G. The Contractor(s) shall submit a copy of all Warranties to the Commissioning Agent for review. The Commissioning Agent shall forward comments to the Owner, Architect, System Design Professionals and Contractor(s). The Commissioning Agent shall recommend approval of the Warranties.
- H. The Contractor(s) shall submit a copy of all Operations and Maintenance Manuals to the Commissioning Agent for review. The Commissioning Agent shall forward comments to the Owner, Architect, System Design Professionals and Contractor(s). The Commissioning Agent shall recommend approval of the O&M Manuals.
- I. The Contractor(s) shall submit a copy of all final Training Documentation to the Commissioning Agent for review. The Commissioning Agent shall forward comments to the Owner, Architect, System Design Professionals and Contractor(s). The Commissioning Agent shall recommend approval of the Training based upon the documentation provided.

2.4 PRE-FUNCTIONAL CHECKLISTS

- A. Pre-Functional Checklists (PFC) shall be issued by the Commissioning Agent to the Commissioning Team. Each member of the Commissioning Team representing a project contractor shall receive a minimum of one copy of every PFC issued by the Commissioning Agent. The PFC's shall consist of a series of installation checklist items, required to be completed by the installing contractors. Each PFC is customized for each type of equipment or system component.
- B. A series of checklist items must be completed for every single piece of equipment and system component included within the systems being commissioned as outlined in Specification 019113 Section 1.5 – Systems to be Included in Commissioning.
- C. It is the contractor's responsibility to estimate the extent and depth of the PFC requirements, based upon the level of involvement required to install each individual piece of equipment or system component. Each contractor shall be responsible for providing a cost associated with Pre-Functional Checklists based upon this extent and depth.
 - 1. The number of checklist items for each piece of equipment or system component shall range from approximately 10 checklist items up to approximately 30 checklist items with respect to the level of involvement required by the contractors. For example, a PFC of only 10 checklist items would represent a piece of equipment which requires only to be connected to an inlet and outlet pipe such as a strainer or other pipe accessory. A PFC of 30 checklist items is more involved and requires in depth installation and adjustment by multiple contractors, such as a Variable Volume Terminal Reheat Box.
 - 2. All checklist items on a PFC are static installation requirements. Proper storage and installation methods may be included within the PFC checklists. Operational checklist items and test, adjustment and balance items shall NOT be included. PFC's may include checklist items requiring submittals to be completed which indicate operational characteristics have been verified. These submittals shall only be included within a PFC if they are a requirement of the contract documents.
 - 3. Equipment PFC's shall list for comparison the manufacturer's data of the equipment as per the design, approved submittal and the installed equipment. These items are initially blank on the forms provided to the contractors by the Commissioning Agent. The Contractors are responsible for obtaining this information and filling in these blanks.

- a. Design: The manufacturer's data shall be filled in by the contractor according to the design criteria outlined within the design specifications or equipment schedules.
 - b. Submitted: The manufacturer's data shall be filled in by the contractor according to the product submittal, submitted by the contractor and approved of by the design representative
 - c. Installed: The manufacturer's data shall be filled in by the contractor according to the actual piece of equipment installed in the field nameplate data.
4. The contractor shall remain responsible for completing all manufacturer's data. PFC manufacturer's data are not considered checklist items and are not included in the range of installation checklist items defined in Specification 019113 Section 2.4 – Pre-Functional Checklists, Sub-section D-1 above (06150-2.4-D-1.)
 5. PFC's shall not require an extension of the project schedule. PFC's require no additional installation work above and beyond the scope of the contract documents. PFC checklist items shall be checked-off as equipment is being installed according to the project schedule. PFC's shall be completed in conjunction with the completion of equipment installations.
- D. PFC's are multi-discipline and therefore must be partially completed by multiple contractors. The division of each PFC is the contractor's responsibility. Division of project work is determined by the CM and subcontractors and is not within the jurisdiction of the Commissioning Agent. Therefore, the division of work outlined within each PFC is generalized and has not taken into account the true scope of each individual sub-contracting company. Each contractor must review every PFC to determine their own obligation to the installation checklist items described therein.
- E. PFC's shall include full calibration documentation of all field calibrated devices as required by the specifications of equipment or controls.
- F. In the event, the Commissioning Agent has omitted a piece of equipment or system component from its applicable PFC form, which is included within the systems to be commissioned. The sub-contractor shall remain responsible for completing a column of checklist items within the appropriate PFC form for that particular piece of equipment or system component. The contractor may bring the omitted item to the attention of the Commissioning Team or Commissioning Agent, whom may in turn provide an additional form for the omitted item. The contractor shall otherwise copy an existing blank PFC form and alter the equipment or system component designation at the top of one column of checklist items to represent the omitted item. The contractor shall then complete the column of checklist items and include the form within the master PFC.
- G. The CM shall be responsible for maintaining a master PFC for each PFC provided by the Commissioning Agent. The master PFC shall be completed in black fine-point ink unless kept electronically via PDF. All marks must be permanent and legible. Each PFC checklist item shall be verified by the responsible contractor and checked-off on the master copy of the respective PFC. Sub-contractors may utilize their personal copies of each PFC's in the field to verify installations and then transfer all checks, notes and initials to the master PFC. Otherwise, sub-contractors may check-off items directly on the master PFC, while in the field. Contractors shall not assemble pages from multiple copies of a PFC, which have been completed by multiple sub-contractors, to create a single PFC representing the master PFC.

- H. Each PFC checklist item shall be checked by the responsible contractor. The specific individual person who checks off any single item on a PFC shall legibly scribe their personal three-letter initials in the space provided adjacent to the item checkbox. Upon completion of any contractor's portion of checklist items, the responsible manager or field superintendent for that company shall sign their full signature in all required places indicated on the PFC. The day's date shall be scribed next to the signature. Typically, the only signature space shall be on the title page of each PFC.
- I. The CM shall be responsible to verify any general contracting items, for which the sub-contractors are not responsible. The CM shall be responsible for determining these checklist items within each PFC and completing them in kind.
- J. The CM shall be responsible to verify all sub-contractors complete each checklist item for which they are responsible. The CM may complete any outstanding checklist items which have not been completed by the sub-contractors, understanding that by checking and initialing any blank item, the CM accepts responsibility for the truthful state of that installation item.
- K. Checklist items within a PFC shall not require any additional work or installation above and beyond that which is called for in the project construction documents or manufacturer's installation requirements. Items above and beyond the scope outlined within the construction documents or manufacturer's installation requirements may be brought to the attention of the Commissioning Team or Commissioning Agent and will likely be removed from the PFC checklist requirements.
- L. Prior to proceeding with any particular system Functional Performance Test, all PFC's associated with equipment or system components which fall under the scope of that particular system, shall be 100% complete and approved by the Commissioning Agent.
- M. The Commissioning Agent shall require the following for the approval of each Pre-Functional Checklist: Each checklist item shall be checked or noted otherwise. Each checklist item shall bear a three-letter initial next to it if an initial space is provided. Each piece of manufacturer's data shall be complete and accurate. Each device calibration checklist shall be complete. Every space on each PFC which requires a signature shall bear the appropriate signature. All marks shall be black and legible according to the Owner or Commissioning Agent.

2.5 START-UP AND TEST REPORTS

- A. Contractor(s) shall submit copies of all start-up reports for systems to be commissioned, test reports and any additional reports relating to work performed by subcontractors and manufacturers as required by the project specifications. Reports shall be submitted with the appropriate Pre-Functional Checklists. Reports shall include but are not limited to: equipment start-up, weld tests, pressure tests, system flushing, system cleaning, chemical treatment, equipment repair, feeder tests, grounding tests, electrical equipment tests, gauge calibration, etc.

2.6 FUNCTIONAL PERFORMANCE TESTS

- A. Functional Performance Tests (FPT's) shall be issued by the Commissioning Agent to the Commissioning Team. Each member of the Commissioning Team representing a project contractor shall receive a minimum of one copy of every FPT issued by the Commissioning Agent. Each system FPT shall consist of a multitude of operational procedures which shall encompass all operational procedures for which that system is required to be capable of performing per the contract documents. Each FPT is customized for each system according to the specifications, contract drawings and equipment submittals.
- B. A Functional Performance Test must be completed for each of the systems to be commissioned as outlined in Specification 019113 Section 1.5 – Systems to be Included in Commissioning.
- C. It is the contractor's responsibility to estimate the extent and depth of the FTP requirements, based upon the level of involvement required to perform each individual sequence of operations. Each contractor shall be responsible for providing a cost associated with Functional Performance Testing based upon this extent and depth.
1. Functional Performance Tests shall be composed of a very detailed series of step-by-step procedures required to be performed by the installing contractors in order to prove the sequence of operations has been properly met according to the construction documents.
 2. FPT's shall include functional test procedures for each operational piece of equipment within a system. Each piece of equipment shall be individually tested for correct operation and load capabilities according to the contract documents. These shall be tested by both the remote BAS control system as well as any localized controls. Local controls may range from a fully programmable control panel down to a simple disconnect switch. Equipment which has been adjusted by the TAB contractor shall be tested against the information provided by the TAB Contractor within the TAB Report. Certain parameters may be required for Functional Performance Testing which are not fully encompassed within the Test, Adjustment and Balance scope if these parameters are essential for verifying equipment operational characteristics or performance.
 3. Every sequence of operation shall be tested as identified within the contract documents. Various sequence requirements are outlined within the project specifications and several requirements are outlined within the contract drawings. Sequences tested shall verify equipment integration and overall system performance. Items identified during system testing include correct order of operations and system efficiencies. System sequence of operations testing shall test every sequence of operations for every case-scenario possible. Each sequence of operations shall be tested for each piece of redundant equipment. Each sequence of operations which has a reverse process shall be tested through the reverse process. Sequence of operations test shall encompass all controls devices as well as all major equipment.
 4. Each auxiliary system requirement shall be tested as identified within the contract documents. Various auxiliary requirements are outlined within the project specifications and several requirements are outlined within the contract drawings. Auxiliaries tested shall verify system alarms, notifications and operation of auxiliary equipment. Equipment failures shall be tested to verify system response. Sub-systems to large systems which have not been functionally tested elsewhere shall be tested, such as a refrigerant pump-out system to a chilled water system.
- D. The contractor must account for performing each Functional Performance Test two (2) times:

1. Upon receipt of each Functional Performance Test, the contractor shall be responsible for reviewing all steps and procedures within, to verify each test is congruent to the applicable system as installed. The contractor is responsible for updating the Commissioning Team and Commissioning Agent of any and all changes within the project which may have an effect on the sequence of operations of any system as it is tested by Functional Performance Test. It is important that the Final Functional Performance Tests, performed in the field and witnessed by the Commissioning Agent are in-fact finalized drafts which encompass all changes made to the systems.
 2. The contractor shall be responsible for performing all steps within a Functional Performance Test prior to issuing a formal request for the Commissioning Agent to witness functional testing. The contractor shall utilize the Functional Performance Tests as received from the Commissioning Agent to internally verify all sequences are fully operational. Upon successful completion of each Functional Performance Test, the contractor may request the presence of the Commissioning Agent to witness the test. The Commissioning Agent shall then witness each test in its entirety.
- E. Redundant Equipment: A Functional Performance Test shall be provided to test every piece of redundant equipment. The contractor shall be responsible for testing every unit to verify correct operation. All redundant equipment shall not necessarily be retested and witnessed by the Commissioning Agent. The Commissioning Agent will select a certain percentage of redundant equipment to be tested. These units shall be chosen at random by the Commissioning Agent, during functional testing. A failure of a certain percentage (typically 10%) or greater of the redundant equipment tested shall indicate improper installation and performance and shall result in system failure. Terminal Reheat Boxes are an example of redundant equipment which are typically tested by random sampling.

2.7 TAB VERIFICATION

- A. Tab Verification shall not be included within the scope of Commissioning and is not a requirement of the Contractor(s).
- B. The Test, Adjustment and Balance Report is to be spot-checked by the Commissioning Agent. The TAB Contractor shall be required to repeat measurements selected at random by the Commissioning Agent to confirm the accuracy of the submitted report. See Specification 23 08 00 – Commissioning of Mechanical Systems for detailed TAB Contractor requirements. TAB Verifications shall be included within the scope of the Functional Performance Testing. Repeated measurements shall be taken using the original instruments utilized by the TAB Contractor.

2.8 TEST EQUIPMENT

- A. All industry standard test equipment required for performing the specified tests shall be indicated by the Commissioning Agent within the testing protocol documents and provided by the contractors. Any proprietary vendor specific test equipment shall be provided by that vendor or manufacturer.
- B. Any portable or hand-held setup / calibration devices required to initialize the control system shall be made available by the control vendor (at no cost) to the Commissioning Agent.

- C. The instrumentation provided by the contractor shall meet the following standards:
1. Be of sufficient quality and accuracy to test and/or measure system performance within the tolerances required.
 2. Be calibrated at the manufacturer's recommended intervals with calibration tags permanently affixed to the instrument
 3. Be maintained in good repair and operating condition throughout the duration of use on this project.
 4. Be immediately replaced if dropped and/or damaged in any way during use on this project.

PART 3 - EXECUTION

3.1 COMMISSIONING PLAN AND SCHEDULE

- A. The Contractor(s) shall submit to the Commissioning Agent a copy of the overall project schedule. The Contractor(s) shall be responsible for submitting updated copies of this schedule to the Commissioning Agent.
- B. The Commissioning Agent will, in coordination with the Commissioning Team, develop a general commissioning schedule with the ideal time frame for implementation of the various commissioning tasks. The Commissioning Schedule will be reviewed with the Owner, the System Design Professional(s) and Construction Manager or General Contractor for integration into the overall project construction schedule. All commissioning tasks as well as critical milestone dates will be tracked on the master project schedule.
- C. The Construction Manager/General Contractor and Contractor(s) shall be responsible for providing periodic updates to the commissioning tasks within the master schedule, identifying areas where commissioning is falling behind schedule.
- D. After the pre-construction meeting, a Commissioning Kick-Off Meeting will be held and attended by all Contractor(s) involved in the commissioning process. A commissioning plan will be distributed at this meeting to the Construction Manager or General Contractor, System Design Professional(s), and prime contractors outlining the specific commissioning process for this project and the names and contact information, to be determined at this meeting, of all commissioning team members. A final plan will be issued soon after the meeting listing all team contact information.

3.2 CONSTRUCTION OBSERVATION

- A. The Architect and System Design Professional(s) shall make standard construction inspection site visits as required by their respective contracts with the Owner.
- B. Construction observation by the Commissioning Agent is required as part of the commissioning and coordination process. A specific number of scheduled site visits will be provided during construction and prior to Functional Performance Testing. Functional Performance Testing shall not be for the purposes of installation inspection and shall be scheduled separately.

3.3 TEST AND BALANCE

- A. See Specification 230800 Section 1.5 – Roles and Responsibilities for the requirements of the Test, Adjustment and Balance Contractor as related to Commissioning.

3.4 PRE-FUNCTIONAL CHECKLISTS AND FUNCTIONAL PERFORMANCE TEST PROCEDURES

- A. Pre-functional checklists and functional performance testing will be provided by the Commissioning Agent after equipment submittal and start-up information is provided by the contractors to the Commissioning Agent. The contractors shall use only PFC and FPT forms provided by the Commissioning Agent. PFC and FPT forms are required to be completed by the Contractor(s) and approved by the Commissioning Agent.

3.5 PRE-FUNCTIONAL CHECKLISTS - OBSERVATION

- A. The pre-functional test forms shall be completed by the installing contractor, manufacturer's, and all others with related involvement with the commissioned equipment. The test forms shall be signed verifying completion by the Construction Manager or General Contractor and all related contractors and sub-contractors. The Commissioning Agent shall spot check forms to verify completion. If the spot check reveals discrepancies, the contractors will be required to redo the forms. The Commissioning Agent again spot check the forms and will invoice the Owner for additional time required for any retesting required due to failed PFC's, and the Owner at his discretion may deduct this cost from the Construction Manager or General Contractor's Application for Payment. It is the contractor's responsibility to properly install equipment and components and verify such prior to inviting the Commissioning Agent to spot check these installations.
- B. Checklists shall be completely comprehensive and to the extent necessary to enable the Commissioning Agent to assure the Owner and System Design Professional(s) that the systems are installed correctly.

3.6 FUNCTIONAL PERFORMANCE TESTING - OBSERVATION

- A. The functional performance testing shall be performed by the installing contractor. The Commissioning Agent shall direct and witness final testing. The Contractor(s) shall initiate the tests provided by the Commissioning Agent, debug the systems, and verify compliance prior to requesting the tests be witnessed by the Commissioning Agent. The Commissioning Agent, upon witness of any system functional deficiency shall require complete retesting. The Commissioning Agent will invoice the Owner for additional time required for any retesting required due to failed FPT's, and the Owner at his discretion may deduct this cost from the CM's Application for Payment. It is the contractor's responsibility to properly de-bug systems and verify successful system performance prior to inviting the Commissioning Agent to witness the test.
- B. Tests shall be completed comprehensively and to the extent necessary to enable the Commissioning Agent to assure the Owner and System Design Professional(s) that the systems do perform per the design intent.

3.7 TRAINING

- A. The Commissioning Agent shall review the Contractor(s) Training Plan for adequacy. The Contractor(s) may otherwise utilize forms provided by the Commissioning Agent to facilitate the Training Plan. Forms shall facilitate the scheduling, agendas, and Operations and Maintenance Staff review of each training session.
- B. The Contractor(s) shall be required to complete all training requirements set forth throughout the specifications. The Commissioning Agent shall verify all training requirements have been met through collection of all training documentation. The Commissioning Agent shall review the training documentation for approval.

3.8 EXCLUSIONS

- A. Responsibility for construction means and methods: The Commissioning Agent is not responsible for construction means, methods, job safety, or any construction management functions on the job site.
- B. Hands-on work by the Commissioning Agent: The contractors shall provide all services requiring tools or the use of tools to start-up, test, adjust, or otherwise bring equipment and systems into a fully operational state. The Commissioning Agent shall coordinate and observe these procedures (and may make minor adjustments), but shall not perform construction or technician services other than verification of testing, adjusting, balancing, and control functions.

3.9 PREREQUISITES TO ~~SUBSTANTIAL COMPLETION~~ **FINAL ACCEPTANCE**

- A. All commissioning of mechanical and electrical systems must be complete prior to ~~Substantial Completion~~ **Final Acceptance**. Exceptions to this are the planned control system training performed after occupancy and any required seasonal or approved deferred testing. Prerequisites include for all systems, but are not limited to:
 - 1. Completed and signed start-up and pre-functional checklist documentation
 - 2. Submission of final approved TAB report
 - 3. Completion of all functional testing
 - 4. Required training of Owner personnel completed and approved
 - 5. Submission of the approved O&M manuals
 - 6. All identified deficiencies have been corrected or are approved by the Owner for ~~substantial completion~~ **Final Acceptance**.
- B. The Owner's Project Manager will determine the date of Functional Completion after reviewing the Commissioning Agent's recommendation for ~~Substantial Completion~~ **Final Acceptance**.
- C. Commissioning activities are non-compensable and cannot be a cause for delay claims. Failure of the contractors to complete all work, including commissioning activities, in a timely manner resulting in overall project delays shall be the fault of the contractor.

END OF SECTION 019113

SECTION 064023 - INTERIOR ARCHITECTURAL WOODWORK

PART 1 - GENERAL

1.1 RELATED DOCUMENTS

- A. Drawings and general provisions of the Contract, including General and Supplementary Conditions and Division 01 Specification Sections, apply to this Section.

1.2 SUMMARY

- A. This Section includes the following:
 - 1. Plastic-laminate cabinets.
 - 2. Solid-surfacing-material countertops.
 - 3. Closet and utility shelving.

1.3 DEFINITIONS

- A. Interior architectural woodwork includes wood furring, blocking, shims, and hanging strips for installing woodwork items unless concealed within other construction before woodwork installation.

1.4 ACTION SUBMITTALS

- A. Product Data: For high-pressure decorative laminate, adhesive for bonding plastic laminate, solid-surfacing material, cabinet hardware and accessories, and finishing materials and processes.
- B. Shop Drawings: Show location of each item, dimensioned plans and elevations, large-scale details, attachment devices, and other components.
 - 1. Show details full size.
 - 2. Show locations and sizes of furring, blocking, and hanging strips, including concealed blocking and reinforcement specified in other Sections.
 - 3. Show locations and sizes of cutouts and holes for plumbing fixtures, faucets, and other items installed in architectural woodwork.
 - 4. Show veneer leaves with dimensions, grain direction, exposed face, and identification numbers indicating the flitch and sequence within the flitch for each leaf.
- C. Samples for Verification:
 - 1. Veneer leaves representative of and selected from flitches to be used for transparent-finished woodwork.
 - 2. Lumber and panel products with shop-applied opaque finish, 50 sq. in. for lumber and 8 by 10 inches for panels, for each finish system and color, with 1/2 of exposed surface finished.
 - 3. Plastic laminates, 8 by 10 inches, for each type, color, pattern, and surface finish.

4. Thermoset decorative-panels, 8 by 10 inches, for each type, color, pattern, and surface finish, with edge banding on 1 edge.
5. Solid-surfacing materials, 6 inches square.
6. Exposed cabinet hardware and accessories, one unit for each type and finish.

1.5 INFORMATIONAL SUBMITTALS

- A. Qualification Data: For Installer and/or fabricator.
- B. Product Certificates: For each type of product, signed by product manufacturer.
- C. Woodwork Quality Standard Compliance Certificates: AWI Quality Certification Program certificates.

1.6 QUALITY ASSURANCE

- A. Fabricator Qualifications: Shop that employs skilled workers who custom-fabricate products similar to those required for this Project and whose products have a record of successful in-service performance. Shop is a certified participant in AWI's Quality Certification Program.
- B. Installer Qualifications: Certified participant in AWI's Quality Certification Program.
- C. Source Limitations: Engage a qualified woodworking firm to assume undivided responsibility for production of interior architectural woodwork with sequence-matched wood veneers.
- D. Quality Standard: Unless otherwise indicated, comply with "Architectural Woodwork Standards" published jointly by the Architectural Woodwork Institute, the Architectural Woodwork Manufacturers Association of Canada and the Woodwork Institute for grades of interior architectural woodwork indicated for construction, finishes, installation and other requirements.
 1. Provide AWI Quality Certification Program certificates indicating that woodwork, including installation, complies with requirements of grades specified.
 2. The Contract Documents contain selections chosen from options in the quality standard and additional requirements beyond those of the quality standard. Comply with such selections and requirements in addition to the quality standard.
- E. Mockups: Build mockups to verify selections made under sample submittals and to demonstrate aesthetic effects and set quality standards for materials and execution.
 1. Approved mockups may become part of the completed Work if undisturbed at time of Final Acceptance.
- F. Preinstallation Conference: Conduct conference at Project site to comply with requirements in Division 01 Section "Project Management and Coordination."

1.7 DELIVERY, STORAGE, AND HANDLING

- A. Do not deliver woodwork until painting and similar operations that could damage woodwork have been completed in installation areas. If woodwork must be stored in other than installation

areas, store only in areas where environmental conditions comply with requirements specified in "Project Conditions" Article.

1.8 PROJECT CONDITIONS

- A. Environmental Limitations: Do not deliver or install woodwork until building is enclosed, wet work is complete, and HVAC system is operating and maintaining temperature and relative humidity at occupancy levels during the remainder of the construction period.
- B. Field Measurements: Where woodwork is indicated to fit to other construction, verify dimensions of other construction by field measurements before fabrication, and indicate measurements on Shop Drawings. Coordinate fabrication schedule with construction progress to avoid delaying the Work.
 - 1. Locate concealed framing, blocking, and reinforcements that support woodwork by field measurements before being enclosed, and indicate measurements on Shop Drawings.
 - 2. Established Dimensions: Where field measurements cannot be made without delaying the Work, establish dimensions and proceed with fabricating woodwork without field measurements. Provide allowance for trimming at site, and coordinate construction to ensure that actual dimensions correspond to established dimensions.

1.9 COORDINATION

- A. Coordinate sizes and locations of framing, blocking, furring, reinforcements, and other related units of Work specified in other Sections to ensure that interior architectural woodwork can be supported and installed as indicated.

PART 2 - PRODUCTS

2.1 MATERIALS

- A. General: Provide materials that comply with requirements of AWS quality standard for each type of woodwork and quality grade specified, unless otherwise indicated.
- B. Wood Species for Opaque Finish: Any closed-grain hardwood.
- C. Wood Products: Comply with the following:
 - 1. Medium-Density Fiberboard: ANSI A208.2, Grade MD, made with binder containing no urea formaldehyde.
 - 2. Veneer-Faced Panel Products (Hardwood Plywood): HPVA HP-1, made with adhesive containing no urea formaldehyde.
- D. Thermoset Decorative Panels: Medium-density fiberboard finished with thermally fused, melamine-impregnated decorative paper complying with LMA SAT-1.
 - 1. Provide PVC or polyester edge banding complying with LMA EDG-1 on components with exposed or semiexposed edges.

- E. High-Pressure Decorative Laminate: NEMA LD 3, grades as indicated or, if not indicated, as required by woodwork quality standard.
1. Basis-of-Design Product: Subject to compliance with requirements, provide high-pressure decorative laminates as scheduled on Room Finish Legend on Drawings or a comparable product by one of the following:
 - a. Formica Corporation.
 - b. Lamin-Art, Inc.
 - c. Panolam Industries International Incorporated.
 - d. Wilsonart LLC.
 2. Products: As indicated on Room Finish Legend on Drawings.
- F. Solid-Surfacing Material: Homogeneous solid sheets of filled plastic resin complying with ISSFA-2.
1. Basis-of-Design Product: Subject to compliance with requirements, provide solid-surfacing material as scheduled on Room Finish Legend on Drawings or a comparable product by one of the following:
 - a. Corian; DuPont.
 - b. Formica Corporation.
 - c. InPro Corporation.
 - d. Wilsonart LLC.
 2. Products: As indicated on Room Finish Legend on Drawings.
 3. Type: Standard type, unless Special Purpose type is indicated.
 4. Colors and Patterns: As indicated on Room Finish Legend on Drawings.

2.2 CABINET HARDWARE AND ACCESSORIES

- A. General: Provide cabinet hardware and accessory materials associated with architectural cabinets, except for items specified in Division 08 Section "Door Hardware (Scheduled by Describing Products)."
- B. Butt Hinges: 2-3/4-inch, 5-knuckle steel hinges made from 0.095-inch-thick metal, and as follows:
1. Semiconcealed Hinges for Flush Doors: BHMA A156.9, B01361; Nickel finish.
- C. Frameless Concealed Hinges (European Type): BHMA A156.9, B01602, 135 degrees of opening.
- D. Wire Pulls: As scheduled on Room Finish Legend on Drawings.
- E. Adjustable Shelf Standards and Supports: BHMA A156.9, B04071; with shelf rests, B04081 BHMA A156.9, B04102; with shelf brackets, B04112.
- F. Shelf Rests: BHMA A156.9, B04013; metal, two-pin type with shelf hold-down clip.
- G. Drawer Slides: BHMA A156.9, B05091.

1. Heavy Duty (Grade 1HD-100 and Grade 1HD-200): Side mounted; full-extension type; zinc-plated steel ball-bearing slides.
 2. Box Drawer Slides: Grade 1HD-100; for drawers not more than 6 inches high and 24 inches wide.
 3. File Drawer Slides: Grade 1HD-100; for drawers more than 6 inches high or 24 inches wide.
 4. Trash Bin Slides: Grade 1 HD-100; for trash bins not more than 20 inches high and 16 inches wide.
- H. Door Locks: BHMA A156.11, E07121.
- I. Drawer Locks: BHMA A156.11, E07041.
- J. Grommets for Cable Passage through Countertops: 2-inch OD, black, molded-plastic grommets and matching plastic caps with slot for wire passage.
1. **Basis-of-Design Product:** Subject to compliance with requirements, provide "~~OG series~~" ~~by~~ Doug Mockett & Company, Inc. **or a comparable product by one of the following:**
 - a. **Doug Mockett Company (Basis-of-Design)**
 - 1) **Product: OG series.**
 - b. **Richelieu Hardware.**
 - c. **Rockler Woodworking and Hardware**
- K. Exposed Hardware Finishes: For exposed hardware, provide finish that complies with BHMA A156.18 for BHMA finish number indicated.
- L. For concealed hardware, provide manufacturer's standard finish that complies with product class requirements in BHMA A156.9.
- 2.3 MISCELLANEOUS MATERIALS
- A. Furring, Blocking, Shims, and Hanging Strips: Softwood or hardwood lumber, kiln dried to less than 15 percent moisture content.
- B. Furring, Blocking, Shims, and Hanging Strips: Fire-retardant-treated softwood lumber, kiln dried to less than 15 percent moisture content.
- C. Anchors: Select material, type, size, and finish required for each substrate for secure anchorage. Provide nonferrous-metal or hot-dip galvanized anchors and inserts on inside face of exterior walls and elsewhere as required for corrosion resistance. Provide toothed-steel or lead expansion sleeves for drilled-in-place anchors.
- D. Adhesives, General: Adhesives shall not contain urea formaldehyde.
- E. VOC Limits for Installation Adhesives: Installation adhesives shall comply with the following limits for VOC content when calculated according to 40 CFR 59, Subpart D (EPA Method 24 and South Coast Air Quality Management District (SCAQND) – Rule 1168):
1. Wood Glues: 30 g/L.
 2. Multipurpose Construction Adhesives: 70 g/L.
 3. Contact Adhesive: 250 g/L.

F. Adhesive for Bonding Plastic Laminate: Contact cement.

1. Adhesive for Bonding Edges: Hot-melt adhesive or adhesive specified above for faces.

2.4 FABRICATION, GENERAL

A. Interior Woodwork Grade: Unless otherwise indicated, provide Custom-grade interior woodwork complying with referenced quality standard.

B. Wood Moisture Content: Comply with requirements of referenced quality standard for wood moisture content in relation to ambient relative humidity during fabrication and in installation areas.

C. Fabricate woodwork to dimensions, profiles, and details indicated. Ease edges to radius indicated for the following:

1. Corners of Cabinets and Edges of Solid-Wood (Lumber) Members 3/4 Inch Thick or Less: 1/16 inch.
2. Edges of Rails and Similar Members More Than 3/4 Inch Thick: 1/8 inch.
3. Corners of Cabinets and Edges of Solid-Wood (Lumber) Members and Rails: 1/16 inch.

D. Complete fabrication, including assembly, finishing, and hardware application, to maximum extent possible before shipment to Project site. Disassemble components only as necessary for shipment and installation. Where necessary for fitting at site, provide ample allowance for scribing, trimming, and fitting.

1. Notify Architect seven days in advance of the dates and times woodwork fabrication will be complete.
2. Trial fit assemblies at fabrication shop that cannot be shipped completely assembled. Install dowels, screws, bolted connectors, and other fastening devices that can be removed after trial fitting. Verify that various parts fit as intended and check measurements of assemblies against field measurements indicated on Shop Drawings before disassembling for shipment.

E. Shop-cut openings to maximum extent possible to receive hardware, appliances, plumbing fixtures, electrical work, and similar items, including trash disposal openings. Locate openings accurately and use templates or roughing-in diagrams to produce accurately sized and shaped openings. Sand edges of cutouts to remove splinters and burrs.

1. Seal edges of openings in wood countertops with a coat of varnish.

2.5 PLASTIC-LAMINATE CABINETS

A. Grade: Custom.

B. Type of Construction: Frameless.

C. Cabinet and Door and Drawer Front Interface Style: Flush overlay.

D. Reveal Dimension: As indicated.

- E. Laminate Cladding for Exposed Surfaces: High-pressure decorative laminate complying with the following requirements:
1. Horizontal Surfaces Other Than Tops: Grade HGS.
 2. Postformed Surfaces: Grade HGP.
 3. Vertical Surfaces: Grade VGS.
 4. Edges: PVC tape, 0.018-inch minimum thickness, matching laminate in color, pattern, and finish.
- F. Materials for Semiexposed Surfaces:
1. Surfaces Other Than Drawer Bodies: High-pressure decorative laminate, Grade VGS.
 - a. Edges of Plastic-Laminate Shelves: PVC tape, 0.018-inch minimum thickness, matching laminate in color, pattern, and finish.
 - b. For semiexposed backs of panels with exposed plastic-laminate surfaces, provide surface of high-pressure decorative laminate, Grade VGS.
 2. Drawer Sides and Backs: Medium density fiberboard or hardwood plywood.
 3. Drawer Bottoms: Medium density fiberboard or hardwood plywood.
- G. Concealed Backs of Panels with Exposed Plastic Laminate Surfaces: High-pressure decorative laminate, Grade BKL.
- H. Provide dust panels of 1/4-inch plywood or tempered hardboard above compartments and drawers, unless located directly under tops.

2.6 SOLID-SURFACING-MATERIAL COUNTERTOPS

- A. Grade: Custom.
- B. Solid-Surfacing-Material Thickness: 1/2 inch.
- C. Colors, Patterns, and Finishes: Provide materials and products that result in colors of solid-surfacing material complying with the following requirements:
1. As indicated on Interior Finishes Legend on Drawings.
- D. Fabricate tops in one piece, unless otherwise indicated. Comply with solid-surfacing-material manufacturer's written recommendations for adhesives, sealers, fabrication, and finishing.
1. Fabricate tops with shop-applied edges of materials and configuration indicated.
 2. Fabricate tops with loose backsplashes for field application.
- E. Install integral sink bowls in countertops in shop.
- F. Drill holes in countertops for plumbing fittings in shop.

2.7 CLOSET AND UTILITY SHELVING

- A. Grade: Custom.
- B. Shelf Material: 3/4-inch thermoset decorative panels.

- C. Cleats: 3/4-inch solid lumber.
- D. Wood Species: Any closed-grain hardwood.

PART 3 - EXECUTION

3.1 PREPARATION

- A. Before installation, condition woodwork to average prevailing humidity conditions in installation areas.
- B. Before installing architectural woodwork, examine shop-fabricated work for completion and complete work as required, including removal of packing and backpriming.

3.2 INSTALLATION

- A. Grade: Install woodwork to comply with requirements for the same grade specified in Part 2 for fabrication of type of woodwork involved.
- B. Assemble woodwork and complete fabrication at Project site to comply with requirements for fabrication in Part 2, to extent that it was not completed in the shop.
- C. Install woodwork level, plumb, true, and straight. Shim as required with concealed shims. Install level and plumb (including tops) to a tolerance of 1/8 inch in 96 inches.
- D. Scribe and cut woodwork to fit adjoining work, refinish cut surfaces, and repair damaged finish at cuts.
- E. Anchor woodwork to anchors or blocking built in or directly attached to substrates. Secure with countersunk, concealed fasteners and blind nailing as required for complete installation. Use fine finishing nails or finishing screws for exposed fastening, countersunk and filled flush with woodwork and matching final finish if transparent finish is indicated.
- F. Standing and Running Trim: Install with minimum number of joints possible, using full-length pieces (from maximum length of lumber available) to greatest extent possible. Do not use pieces less than 60 inches long, except where shorter single-length pieces are necessary.
 - 1. Fill gaps, if any, between top of base and wall with plastic wood filler, sand smooth, and finish same as wood base if finished.
 - 2. Install wall railings on indicated metal brackets securely fastened to wall framing.
 - 3. Install standing and running trim with no more variation from a straight line than 1/8 inch in 96 inches.
- G. Cabinets: Install without distortion so doors and drawers fit openings properly and are accurately aligned. Adjust hardware to center doors and drawers in openings and to provide unencumbered operation. Complete installation of hardware and accessory items as indicated.
 - 1. Install cabinets with no more than 1/8 inch in 96-inch sag, bow, or other variation from a straight line.
 - 2. Maintain veneer sequence matching of cabinets with transparent finish.

3. Fasten wall cabinets through back, near top and bottom, at ends and not more than 16 inches o.c. with No. 10 wafer-head sheet metal screws through metal backing or metal framing behind wall finish.
- H. Countertops: Anchor securely by screwing through corner blocks of base cabinets or other supports into underside of countertop.
1. Align adjacent solid-surfacing-material countertops and form seams to comply with manufacturer's written recommendations using adhesive in color to match countertop. Carefully dress joints smooth, remove surface scratches, and clean entire surface.
 2. Install countertops with no more than 1/8 inch in 96-inch sag, bow, or other variation from a straight line.
 3. Secure backsplashes to tops with concealed metal brackets at 16 inches o.c. and to walls with adhesive.
 4. Calk space between backsplash and wall with sealant specified in Division 07 Section "Joint Sealants."
- I. Touch up finishing work specified in this Section after installation of woodwork. Fill nail holes with matching filler where exposed.
- J. Refer to Division 09 Sections for final finishing of installed architectural woodwork not indicated to be shop finished.

3.3 ADJUSTING AND CLEANING

- A. Repair damaged and defective woodwork, where possible, to eliminate functional and visual defects; where not possible to repair, replace woodwork. Adjust joinery for uniform appearance.
- B. Clean, lubricate, and adjust hardware.
- C. Clean woodwork on exposed and semiexposed surfaces. Touch up shop-applied finishes to restore damaged or soiled areas.

END OF SECTION 064023

SECTION 093000 - TILING

PART 1 - GENERAL

1.1 RELATED DOCUMENTS

- A. Drawings and general provisions of the Contract, including General and Supplementary Conditions and Division 01 Specification Sections, apply to this Section.

1.2 SUMMARY

A. Section Includes:

1. Porcelain tile.
2. Waterproof membrane.
3. Crack isolation membrane.
4. Tile backing panels.
5. Metal edge strips.

B. Related Sections:

1. Section 079200 "Joint Sealants" for sealing of expansion, contraction, control, and isolation joints in tile surfaces.
2. Section 092900 "Gypsum Board" for cementitious backer units and water-resistant backer board.

1.3 DEFINITIONS

- A. General: Definitions in the ANSI A108 series of tile installation standards and in ANSI A137.1-2012 apply to Work of this Section unless otherwise specified.
- B. ANSI A108 Series: ANSI A108.01, ANSI A108.02, ANSI A108.1A, ANSI A108.1B, ANSI A108.1C, ANSI A108.4, ANSI A108.5, ANSI A108.6, ANSI A108.8, ANSI A108.9, ANSI A108.10, ANSI A108.11, ANSI A108.12, ANSI A108.13, ANSI A108.14, ANSI A108.15, ANSI A108.16, and ANSI A108.17, which are contained in "American National Standard Specifications for Installation of Ceramic Tile."
- C. Module Size: Actual tile size plus joint width indicated.
- D. Face Size: Actual tile size, excluding spacer lugs.

1.4 PERFORMANCE REQUIREMENTS

- A. Dynamic Coefficient of Friction: For tile installed on walkway surfaces, provide products that meet the requirements of ANSI A 137.1-2012 testing method, the DCOF AcuTest.

1. Minimum Threshold: 0.42 for level interior spaces expected to be walked upon when wet.

1.5 ACTION SUBMITTALS

- A. Product Data: For each type of product indicated.
- B. Sustainable Design Submittals:
 1. Product Data: For adhesives, indicating VOC content.
 2. Adhesives shall have a VOC content of 65 g/L or less.
 3. Laboratory Test Reports: For adhesives, indicating compliance with requirements for low-emitting materials.
 4. Laboratory Test Reports: For sealers, indicating compliance with requirements for low-emitting materials.
- C. Shop Drawings: Show locations of each type of tile and tile pattern. Show widths, details, and locations of expansion, contraction, control, locations and field verified locations of drains, and isolation joints in tile substrates and finished tile surfaces.
- D. Samples for Verification:
 1. Full-size units of each type and composition of tile and for each color and finish required, including tile base.
 2. Assembled samples mounted on a rigid panel, with grouted joints, for each type and composition of tile and for each color and finish required. Make samples at least 12 inches square, but not fewer than 4 tiles. Use grout of type and in color or colors approved for completed Work.
 3. Full-size units of each type of trim and accessory for each color and finish required.
 4. Metal edge strips in 6-inch lengths.

1.6 INFORMATIONAL SUBMITTALS

- A. Qualification Data: For qualified Installer.
- B. Master Grade Certificates: For each shipment, type, and composition of tile, signed by tile manufacturer and Installer.
- C. Product Certificates: For each type of product, signed by product manufacturer.
- D. Material Test Reports: For each tile-setting and -grouting product.

1.7 MAINTENANCE MATERIAL SUBMITTALS

- A. Furnish extra materials that match and are from same production runs as products installed and that are packaged with protective covering for storage and identified with labels describing contents.

1. Tile and Trim Units: Furnish quantity of full-size units equal to 2 percent of amount installed for each type, composition, color, pattern, and size indicated.
2. Grout: Furnish quantity of grout equal to 2 percent of amount installed for each type, composition, and color indicated.

1.8 QUALITY ASSURANCE

- A. Source Limitations for Tile: Obtain tile of each type and color or finish from one source or producer.
 1. Obtain tile of each type and color or finish from same production run and of consistent quality in appearance and physical properties for each contiguous area.
- B. Source Limitations for Setting and Grouting Materials: Obtain ingredients of a uniform quality for each mortar, adhesive, and grout component from one manufacturer and each aggregate from one source or producer.
- C. Source Limitations for Other Products: Obtain each of the following products specified in this Section from a single manufacturer for each product:
 1. Waterproof membrane.
 2. Crack isolation membrane.
 3. Joint sealants.
 4. Cementitious backer units.
 5. Metal edge strips.
- D. Mockups: Build mockups to verify selections made under sample submittals and to demonstrate aesthetic effects and set quality standards for materials and execution.
 1. Build mockup of each type of floor tile installation.
 2. Build mockup of each type of wall tile installation.
 3. Approved mockups may become part of the completed Work if undisturbed at time of Final Acceptance.
- E. Preinstallation Conference: Conduct conference at Project site.
 1. Review requirements in ANSI A108.01 for substrates and for preparation by other trades.

1.9 DELIVERY, STORAGE, AND HANDLING

- A. Deliver and store packaged materials in original containers with seals unbroken and labels intact until time of use. Comply with requirements in ANSI A137.1 for labeling tile packages.
- B. Store tile and cementitious materials on elevated platforms, under cover, and in a dry location.
- C. Store aggregates where grading and other required characteristics can be maintained and contamination can be avoided.

- D. Store liquid materials in unopened containers and protected from freezing.
- E. Handle tile that has temporary protective coating on exposed surfaces to prevent coated surfaces from contacting backs or edges of other units. If coating does contact bonding surfaces of tile, remove coating from bonding surfaces before setting tile.

1.10 PROJECT CONDITIONS

- A. Environmental Limitations: Do not install tile until construction in spaces is complete and ambient temperature and humidity conditions are maintained at the levels indicated in referenced standards and manufacturer's written instructions.

PART 2 - PRODUCTS

2.1 PRODUCTS, GENERAL

- A. ANSI Ceramic Tile Standard: Provide tile that complies with ANSI A137.1 for types, compositions, and other characteristics indicated.
 - 1. Provide tile complying with Standard grade requirements unless otherwise indicated.
- B. ANSI Standards for Tile Installation Materials: Provide materials complying with ANSI A108.02, ANSI standards referenced in other Part 2 articles, ANSI standards referenced by TCA installation methods specified in tile installation schedules, and other requirements specified.
- C. Factory Blending: For tile exhibiting color variations within ranges, blend tile in factory and package so tile units taken from one package show same range in colors as those taken from other packages and match approved Samples.
- D. Mounting: For factory-mounted tile, provide back- or edge-mounted tile assemblies as standard with manufacturer unless otherwise indicated.
 - 1. Where tile is indicated for installation in wet areas, do not use back- or edge-mounted tile assemblies unless tile manufacturer specifies in writing that this type of mounting is suitable for installation indicated and has a record of successful in-service performance.
- E. Factory-Applied Temporary Protective Coating: Where indicated under tile type, protect exposed surfaces of tile against adherence of mortar and grout by precoating with continuous film of petroleum paraffin wax, applied hot. Do not coat unexposed tile surfaces.

2.2 TILE PRODUCTS

- A. Tile Type: Porcelain floor tile.

1. Basis-of-Design Product: Subject to compliance with requirements, provide Basis-of-Design products as scheduled on Room Finish Legend on Drawings or comparable product by one of the following:
 - a. American Marazzi Tile, Inc.
 - b. American Olean; Division of Dal-Tile International Inc.
 - c. Crossville, Inc.
 - d. Daltile; Division of Dal-Tile International Inc. (Basis-of-Design).
 - e. Florida Tile Industries, Inc.
 - f. Florim USA.
 - g. Stone Source LLC.
 - h. Trinity Surfaces (Basis-of-Design).
2. Composition: Porcelain.
3. Module Size: As indicated on Room Finish Legend on Drawings.
4. Tile Color and Pattern: As indicated on Room Finish Legend on Drawings.
5. Grout Color: As selected by Architect from manufacturer's full range.
6. Trim Units: Coordinated with sizes and coursing of adjoining flat tile where applicable and matching characteristics of adjoining flat tile. Provide shapes as follows:
 - a. Base Cove: Cove, module size as indicated on Room Finish Legend on Drawings.

B. Tile Type: Porcelain wall tile.

1. Basis-of-Design Product: Subject to compliance with requirements, provide Basis-of-Design products as scheduled on Room Finish Legend on Drawings or comparable product by one of the following:
 - a. American Olean; Division of Dal-Tile International Inc.
 - b. Crossville, Inc.
 - c. Daltile; Division of Dal-Tile International Inc. (Basis-of-Design).
 - d. Florida Tile Industries, Inc.
 - e. Mosaic Tile Company.
2. Module Size: As indicated on Room Finish Legend on Drawings.
3. Tile Color and Pattern: As indicated on Room Finish Legend on Drawings.
4. Grout Color: As selected by Architect from manufacturer's full range.
5. Mounting: Factory, back mounted.

2.3 THRESHOLDS

- A. General: Fabricate to sizes and profiles indicated or required to provide transition between adjacent floor finishes.
1. Bevel edges at 1:2 slope, with lower edge of bevel aligned with or up to 1/16 inch above adjacent floor surface. Finish bevel to match top surface of threshold. Limit height of threshold to 1/2 inch or less above adjacent floor surface.

- B. Marble Thresholds: ASTM C 503/C 503M, with a minimum abrasion resistance of 12 according to ASTM C 1353 or ASTM C 241/C 241M and with honed finish.

1. Description: Uniform, fine- to medium-grained white stone with gray veining.

2.4 WATERPROOF MEMBRANE

- A. General: Manufacturer's standard product, selected from the following, that complies with ANSI A118.10 and is recommended by the manufacturer for the application indicated. Include reinforcement and accessories recommended by manufacturer.

- B. Polyethylene Sheet: Polyethylene faced on both sides with fleece webbing; 0.008-inch nominal thickness.

1. Products: Subject to compliance with requirements, provide the following:

- a. Schluter Systems L.P.; KERDI.
b. Or approved equal.

- C. Fabric-Reinforced, Fluid-Applied Membrane: System consisting of liquid-latex rubber or elastomeric polymer and continuous fabric reinforcement.

1. Basis-of-Design Product: Subject to compliance with requirements, provide Laticrete or a comparable product by one of the following:

- a. ARDEX Engineered Cements.
b. Custom Building Products.
c. Laticrete International, Inc. (Basis-of-Design).
1) Product: 9235 Waterproofing Membrane.
d. MAPEI Corporation.

2.5 CRACK ISOLATION MEMBRANE

- A. General: Manufacturer's standard product, selected from the following, that complies with ANSI A118.12 for standard performance and is recommended by the manufacturer for the application indicated. Include reinforcement and accessories recommended by manufacturer.

- B. Polyethylene Sheet: Polyethylene faced on both sides with fleece webbing; 0.008-inch nominal thickness.

1. Products: Subject to compliance with requirements, provide the following:

- a. Schluter Systems L.P.; KERDI.
b. Or approved equal.

- C. Corrugated Polyethylene/Uncoupling Membrane: Corrugated polyethylene with dovetail-shaped corrugations and with anchoring webbing on the underside; 3/16-inch nominal thickness.

1. Products: Subject to compliance with requirements, provide the following:

- a. ARDEX Americas; ARDEX IU 740 Flexbone.
- b. Schluter Systems L.P.; DITRA.
- c. **Or approved equal.**

D. Fabric-Reinforced, Fluid-Applied Membrane: System consisting of liquid-latex rubber or elastomeric polymer and fabric reinforcement.

1. Products: Subject to compliance with requirements, provide one of the following:

- a. Boiardi Products; a QEP company; Elastiment 344 Reinforced Waterproofing and Anti-Fracture/Crack Suppression Membrane.
- b. Bonsal American; an Oldcastle company; B 6000 Waterproof Membrane with Glass Fabric.
- c. Bostik, Inc.; Hydroment Blacktop 90210.
- d. Custom Building Products; 9240 Waterproofing and Anti-Fracture Membrane.
- e. Laticrete International, Inc.; Laticrete 9235 Waterproof Membrane.
- f. MAPEI Corporation; Mapelastich HPG with MAPEI Fiberglass Mesh.
- g. Mer-Kote Products, Inc.; Hydro-Guard 2000.
- h. Summitville Tiles, Inc.; S-9000.

2.6 SETTING MATERIALS

A. Dry-Set Portland Cement Mortar (Thin Set): ANSI A118.1.

1. Manufacturers: Subject to compliance with requirements, provide products by one of the following:

- a. Custom Building Products.
- b. Laticrete International, Inc.
- c. MAPEI Corporation.
- d. TEC; a subsidiary of H. B. Fuller Company.

2. For wall applications, provide mortar that complies with requirements for nonsagging mortar in addition to the other requirements in ANSI A118.1.

2.7 GROUT MATERIALS

A. Sand-Portland Cement Grout: ANSI A108.10, composed of white or gray cement and white or colored aggregate as required to produce color indicated.

1. Manufacturers: Subject to compliance with requirements, provide products by one of the following:

- a. ARDEX Engineered Cements.
- b. Custom Building Products.
- c. Laticrete International, Inc.

- d. MAPEI Corporation.
- e. TEC; a subsidiary of H. B. Fuller Company.

2.8 ELASTOMERIC SEALANTS

- A. General: Provide sealants, primers, backer rods, and other sealant accessories that comply with the following requirements and with the applicable requirements in Section 079200 "Joint Sealants."
- B. Colors: Provide colors of exposed sealants to match colors of grout in tile adjoining sealed joints unless otherwise indicated.
- C. One-Part, Mildew-Resistant Silicone Sealant: ASTM C 920; Type S; Grade NS; Class 25; Uses NT, G, A, and, as applicable to nonporous joint substrates indicated, O; formulated with fungicide, intended for sealing interior ceramic tile joints and other nonporous substrates that are subject to in-service exposures of high humidity and extreme temperatures.
- D. Multipart, Pourable Urethane Sealant for Use T: ASTM C 920; Type M; Grade P; Class 25; Uses T, M, A, and, as applicable to joint substrates indicated, O.

2.9 MISCELLANEOUS MATERIALS

- A. Trowelable Underlayments and Patching Compounds: Latex-modified, portland cement-based formulation provided or approved by manufacturer of tile-setting materials for installations indicated.
- B. Metal Edge Strips: Angle or L-shape, height to match tile and setting-bed thickness, aluminum, designed specifically for flooring applications; aluminum exposed-edge material.
 - 1. Basis-of-Design: **Subject to compliance with requirements**, provide products by Schluter as indicated on Room Finish Legend on Drawings **or a comparable product by one of the following**:
 - a. **Blanke Corporation.**
 - b. **Ceramic Tool Company, Inc.**
 - c. **Schluter Systems L.P. (Basis-of-Design).**
- C. Temporary Protective Coating: Either product indicated below that is formulated to protect exposed surfaces of tile against adherence of mortar and grout; compatible with tile, mortar, and grout products; and easily removable after grouting is completed without damaging grout or tile.
 - 1. Petroleum paraffin wax, fully refined and odorless, containing at least 0.5 percent oil with a melting point of 120 to 140 deg F per ASTM D 87.
 - 2. Grout release in form of manufacturer's standard proprietary liquid coating that is specially formulated and recommended for use as temporary protective coating for tile.
- D. Tile Cleaner: A neutral cleaner capable of removing soil and residue without harming tile and grout surfaces, specifically approved for materials and installations indicated by tile and grout manufacturers.

- E. Grout Sealer: Manufacturer's standard product for sealing grout joints and that does not change color or appearance of grout.

2.10 MIXING MORTARS AND GROUT

- A. Mix mortars and grouts to comply with referenced standards and mortar and grout manufacturers' written instructions.
- B. Add materials, water, and additives in accurate proportions.
- C. Obtain and use type of mixing equipment, mixer speeds, mixing containers, mixing time, and other procedures to produce mortars and grouts of uniform quality with optimum performance characteristics for installations indicated.

PART 3 - EXECUTION

3.1 EXAMINATION

- A. Examine substrates, areas, and conditions where tile will be installed, with Installer present, for compliance with requirements for installation tolerances and other conditions affecting performance of installed tile.
 - 1. Verify that substrates for setting tile are firm, dry, clean, free of coatings that are incompatible with tile-setting materials including curing compounds and other substances that contain soap, wax, oil, or silicone; and comply with flatness tolerances required by ANSI A108.01 for installations indicated.
 - 2. Verify that concrete substrates for tile floors installed with thin-set mortar comply with surface finish requirements in ANSI A108.01 for installations indicated.
 - a. Verify that surfaces that received a steel trowel finish have been mechanically scarified.
 - b. Verify that protrusions, bumps, and ridges have been removed by sanding or grinding.
 - 3. Verify that installation of grounds, anchors, recessed frames, electrical and mechanical units of work, and similar items located in or behind tile has been completed.
 - 4. Verify that joints and cracks in tile substrates are coordinated with tile joint locations; if not coordinated, adjust joint locations in consultation with Architect.
- B. Proceed with installation only after unsatisfactory conditions have been corrected.

3.2 PREPARATION

- A. Fill cracks, holes, and depressions in concrete substrates for tile floors installed with thin-set mortar with trowelable leveling and patching compound specifically recommended by tile-setting material manufacturer.

- B. Where indicated, prepare substrates to receive waterproofing by applying a reinforced mortar bed that complies with ANSI A108.1A and is sloped 1/4 inch per foot toward drains.
- C. Blending: For tile exhibiting color variations, verify that tile has been factory blended and packaged so tile units taken from one package show same range of colors as those taken from other packages and match approved Samples. If not factory blended, either return to manufacturer or blend tiles at Project site before installing.
- D. Field-Applied Temporary Protective Coating: If indicated under tile type or needed to prevent grout from staining or adhering to exposed tile surfaces, precoat them with continuous film of temporary protective coating, taking care not to coat unexposed tile surfaces.

3.3 TILE INSTALLATION

- A. Comply with TCA's "Handbook for Ceramic Tile Installation" for TCA installation methods specified in tile installation schedules. Comply with parts of the ANSI A108 Series "Specifications for Installation of Ceramic Tile" that are referenced in TCA installation methods, specified in tile installation schedules, and apply to types of setting and grouting materials used.
 - 1. For the following installations, follow procedures in the ANSI A108 Series of tile installation standards for providing 95 percent mortar coverage:
 - a. Tile floors in wet areas.
 - b. Tile floors in laundries.
 - c. Tile floors composed of tiles 8 by 8 inches or larger.
 - d. Tile floors composed of rib-backed tiles.
- B. Extend tile work into recesses and under or behind equipment and fixtures to form complete covering without interruptions unless otherwise indicated. Terminate work neatly at obstructions, edges, and corners without disrupting pattern or joint alignments.
- C. Accurately form intersections and returns. Perform cutting and drilling of tile without marring visible surfaces. Carefully grind cut edges of tile abutting trim, finish, or built-in items for straight aligned joints. Fit tile closely to electrical outlets, piping, fixtures, and other penetrations so plates, collars, or covers overlap tile.
- D. Provide manufacturer's standard trim shapes where necessary to eliminate exposed tile edges.
- E. Jointing Pattern: Lay tile in grid pattern unless otherwise indicated. Lay out tile work and center tile fields in both directions in each space or on each wall area. Lay out tile work to minimize the use of pieces that are less than half of a tile. Provide uniform joint widths unless otherwise indicated.
 - 1. For tile mounted in sheets, make joints between tile sheets same width as joints within tile sheets so joints between sheets are not apparent in finished work.
 - 2. Where adjoining tiles on floor, base, walls, or trim are specified or indicated to be same size, align joints.

3. Where tiles are specified or indicated to be whole integer multiples of adjoining tiles on floor, base, walls, or trim, align joints unless otherwise indicated.
- F. Joint Widths: Unless otherwise indicated, install tile with the joint widths the narrowest joint recommended in writing by the tile manufacturer.
- G. Lay out tile wainscots to dimensions indicated or to next full tile beyond dimensions indicated.
- H. Expansion Joints: Provide expansion joints and other sealant-filled joints, including control, contraction, and isolation joints, where indicated on approved Shop Drawings. Form full depth joints during installation of setting materials, mortar beds, and tile. Do not saw-cut joints after installing tiles. Provide expansion joints as follows:
 1. Where joints occur in concrete substrates, locate joints in tile surfaces directly above them and of equal or greater widths.
 2. Where tilework abuts restraining surfaces such as perimeter walls, curbs, columns, and ceilings.
 3. Where there is a change in substrate material.
 4. Interior Tilework: 20 to 25 feet in each direction.
 5. Above ground concrete substrates: 8 to 12 feet in each direction.
 6. Interior tilework exposed to direct sunlight: 8 to 12 feet in each direction.
 7. Interior tilework exposed to moisture: 8 to 12 feet in each direction.
- I. Metal Edge Strips: Install where exposed edge of tile flooring meets carpet, wood, or other flooring that finishes flush with or below top of tile and no threshold is indicated.
- J. Grout Sealer: Apply grout sealer to grout joints according to grout-sealer manufacturer's written instructions. As soon as grout sealer has penetrated grout joints, remove excess sealer and sealer from tile faces by wiping with soft cloth.

3.4 WATERPROOFING INSTALLATION

- A. Install waterproofing to comply with ANSI A108.13 and manufacturer's written instructions to produce waterproof membrane of uniform thickness and bonded securely to substrate.
- B. Do not install tile or setting materials over waterproofing until waterproofing has cured and been tested to determine that it is watertight.

3.5 CLEANING AND PROTECTING

- A. Cleaning: On completion of placement and grouting, clean all ceramic tile surfaces so they are free of foreign matter.
 1. Remove latex-portland cement grout residue from tile as soon as possible.
 2. Clean grout smears and haze from tile according to tile and grout manufacturer's written instructions but no sooner than 10 days after installation. Use only cleaners recommended by tile and grout manufacturers and only after determining that cleaners are safe to use by testing on samples of tile and other surfaces to be cleaned. Protect metal surfaces and

plumbing fixtures from effects of cleaning. Flush surfaces with clean water before and after cleaning.

3. Remove temporary protective coating by method recommended by coating manufacturer and that is acceptable to tile and grout manufacturer. Trap and remove coating to prevent drain clogging.
- B. Protect installed tile work with kraft paper or other heavy covering during construction period to prevent staining, damage, and wear. If recommended by tile manufacturer, apply coat of neutral protective cleaner to completed tile walls and floors.
- C. Prohibit foot and wheel traffic from tiled floors for at least seven days after grouting is completed.
- D. Before final inspection, remove protective coverings and rinse neutral protective cleaner from tile surfaces.

3.6 INTERIOR TILE INSTALLATION SCHEDULE

- A. Interior Floor Installations, Concrete Subfloor:
 1. Tile Installation F113: Thin-set mortar; TCNA F113.
 - a. Tile Type: Unglazed ceramic and unglazed porcelain paver tile.
 - b. Thin-Set Mortar: Latex-portland cement mortar.
 - c. Grout: Polymer-modified sanded grout.
 2. Tile Installation F125A: Thin-set mortar on crack isolation membrane; TCNA F125A.
 - a. Tile Type: Unglazed ceramic or unglazed porcelain paver tile.
 - b. Thin-Set Mortar: Latex-portland cement mortar.
 - c. Grout: Polymer-modified sanded grout.
- B. Interior Wall Installations, Metal Studs or Furring:
 1. Tile Installation W243: Thin-set mortar on gypsum board; TCNA W243:
 - a. Tile Type: Ceramic wall base.
 - b. Thin-Set Mortar: Latex-portland cement mortar.
 - c. Grout: Polymer-modified sanded grout.

END OF SECTION 093000

SECTION 260533 - RACEWAY AND BOXES FOR ELECTRICAL SYSTEMS

PART 1 - GENERAL

1.1 RELATED DOCUMENTS

- A. Drawings and general provisions of the Contract, including General and Supplementary Conditions and Division 01 Specification Sections, apply to this Section.

1.2 SUMMARY

- A. This Section includes raceways, fittings, boxes, enclosures, and cabinets for electrical wiring.
- B. Related Sections include the following:
 - 1. Division 26 Section "Underground Ducts and Raceways for Electrical Systems" for exterior ductbanks, manholes, and underground utility construction.
- C. Raceways shall be metal except as specifically noted, or where non-metallic raceway is permitted by these specifications. A Green Grounding conductors shall be provided in all conduit except for telecommunications, data and audio conduits.
 - 1. Use heavy wall metal conduit (RMC) or intermediate metal conduit (IMC) for any conduit exposed below a height of 60".
 - 2. Electric metallic tubing (EMT) is permitted for most other general applications except for:
 - a. Where tubing, couplings, elbows and fittings would be in direct contact with the earth or underground (in/below slab-on-grade or in earth).
 - b. Any location outdoors where the tubing, etc., would be exposed to the elements.
 - c. Where exposed to severe corrosive influence and/or physical damage.
- D. Use flexible conduit for appropriate applications. Use galvanized type for dry locations and liquid-tight type for wet locations, or as noted. Flexible conduit shall be minimum 1/2" diameter. Liquid-tight flexible metal conduit shall be used for final connection to all motors, transformers, and other rotating or vibrating equipment. Flexible metal conduit shall be used for final connection to fluorescent lighting fixtures mounted in or on suspended ceilings, and similar applications with a maximum of 6' length. **MC cable shall NOT be allowed to be used as a wiring method for branch circuits.**
- E. Non-metallic raceway shall be minimum Schedule 40 PVC. In general, non-metallic raceway will be permitted for use underground or in poured concrete (including panel feeders, branch circuits, etc.), provided all 90 degree Ells up out of the floor are heavy wall rigid metal conduit

(RMC), no exception. Non-metallic raceways will not be permitted for any exposed work or for raceways in ceiling spaces, etc.

- F. No raceway may be exposed in any finished space unless specifically so approved, in written form, prior to rough-in. Raceways exposed in finished spaces shall be of an appropriate type "wiremold" type surface raceway or approved equal. In the event of an accepted alternate that requires exposed conditions in a finished space, devices and fixtures shall be located to minimize exposure of raceway and maintain all required clearances, coverage, etc. Devices, fixture, etc. shall be positioned aesthetically/orthogonal to the orientation of the room.
- G. Minimum metal conduit size shall be 3/4" (interior) and 1" (exterior) for premises wiring system. Exception shall be 1/2" for switch legs, control circuits, signal wiring and applications for flexible metal conduits not exceeding four circuit conductors.
- H. **Where installing conduit on exterior surface of exterior walls, mount conduit minimum 1/4-inch from wall with clamp-backs or strut.**

1.3 DEFINITIONS

- A. EMT: Electrical metallic tubing.
- B. ENT: Electrical nonmetallic tubing, not allowed on this project.
- C. EPDM: Ethylene-propylene-diene terpolymer rubber.
- D. FMC: Flexible metal conduit.
- E. IMC: Intermediate metal conduit.
- F. LFMC: Liquidtight flexible metal conduit.
- G. LFNC: Liquidtight flexible nonmetallic conduit, not allowed on this project.
- H. NBR: Acrylonitrile-butadiene rubber.
- I. RNC: Rigid nonmetallic conduit.

1.4 SUBMITTALS

- A. Product Data: For surface raceways, wireways and fittings, floor boxes, hinged-cover enclosures, and cabinets.
- B. Shop Drawings: For the following raceway components. Include plans, elevations, sections, details, and attachments to other work.
 - 1. Custom enclosures and cabinets.
 - 2. For handholes and boxes for underground wiring, including the following:

- a. Duct entry provisions, including locations and duct sizes.
 - b. Frame and cover design.
 - c. Grounding details.
 - d. Dimensioned locations of cable rack inserts, and pulling-in and lifting irons.
 - e. Joint details.
- C. Manufacturer Seismic Qualification Certification: Submit certification that enclosures and cabinets and their mounting provisions, including those for internal components, will withstand seismic forces defined in Division 26 Section "Vibration and Seismic Controls for Electrical Systems." Include the following:
1. Basis for Certification: Indicate whether withstand certification is based on actual test of assembled components or on calculation.
 - a. The term "withstand" means "the cabinet or enclosure will remain in place without separation of any parts when subjected to the seismic forces specified and the unit will retain its enclosure characteristics, including its interior accessibility, after the seismic event."
 2. Dimensioned Outline Drawings of Equipment Unit: Identify center of gravity and locate and describe mounting and anchorage provisions.
 3. Detailed description of equipment anchorage devices on which the certification is based and their installation requirements.
- D. Qualification Data: For professional engineer and testing agency.
- E. Source quality-control test reports.

1.5 QUALITY ASSURANCE

- A. Electrical Components, Devices, and Accessories: Listed and labeled as defined in NFPA 70, Article 100, by a testing agency acceptable to authorities having jurisdiction, and marked for intended use.
- B. Comply with NFPA 70.

PART 2 - PRODUCTS -

2.1 METAL CONDUIT AND TUBING

- A. Manufacturers: Subject to compliance with requirements, provide products by one of the following:
 1. AFC Cable Systems, Inc.
 2. Alflex Inc.
 3. Allied Tube & Conduit; a Tyco International Ltd. Co.
 4. Anamet Electrical, Inc.; Anaconda Metal Hose.

5. Electri-Flex Co.
 6. Manhattan/CDT/Cole-Flex.
 7. Maverick Tube Corporation.
 8. O-Z Gedney; a unit of General Signal.
 9. Wheatland Tube Company.
- B. Rigid Steel Conduit: ANSI C80.1.
- C. IMC: ANSI C80.6..5.
- D. PVC-Coated Steel Conduit: PVC-coated IMC.
1. Comply with NEMA RN 1.
 2. Coating Thickness: 0.040 inch, minimum.
- E. EMT: ANSI C80.3.
- F. FMC: Zinc-coated steel.
- G. LFMC: Flexible steel conduit with PVC jacket.
- H. Fittings for Conduit (Including all Types and Flexible and Liquidtight), EMT, and Cable: NEMA FB 1; listed for type and size raceway with which used, and for application and environment in which installed.
1. Conduit Fittings for Hazardous (Classified) Locations: Comply with UL 886.
 2. Fittings for EMT: Steel, compression type.
 3. Coating for Fittings for PVC-Coated Conduit: Minimum thickness, 0.040 inch, with overlapping sleeves protecting threaded joints.
- I. Joint Compound for Rigid Steel Conduit or IMC: Listed for use in cable connector assemblies, and compounded for use to lubricate and protect threaded raceway joints from corrosion and enhance their conductivity.

2.2 NONMETALLIC CONDUIT AND TUBING

- A. Manufacturers: Subject to compliance with requirements, provide products by one of the following:
1. AFC Cable Systems, Inc.
 2. Anamet Electrical, Inc.; Anaconda Metal Hose.
 3. Arnco Corporation.
 4. CANTEX Inc.
 5. CertainTeed Corp.; Pipe & Plastics Group.
 6. Condux International, Inc.
 7. ElecSYS, Inc.
 8. Electri-Flex Co.
 9. Lamson & Sessions; Carlon Electrical Products.
 10. Manhattan/CDT/Cole-Flex.

11. RACO; a Hubbell Company.
12. Thomas & Betts Corporation.

- B. ENT: Not allowed.
- C. RNC: NEMA TC 2, Type EPC-40-PVC, unless otherwise indicated.
- D. LFNC: Not allowed.
- E. Fittings for RNC: NEMA TC 3; match to conduit or tubing type and material.

2.3 OPTICAL FIBER/COMMUNICATIONS CABLE RACEWAY AND FITTINGS

- A. Manufacturers: Subject to compliance with requirements, provide products by one of the following:
 1. Arcco Corporation.
 2. Endot Industries Inc.
 3. IPEX Inc.
 4. Lamson & Sessions; Carlon Electrical Products.
- B. Description: Comply with UL 2024; flexible type, approved for plenum installation.

2.4 METAL WIREWAYS

- A. Manufacturers: Subject to compliance with requirements, provide products by one of the following:
 1. Cooper B-Line, Inc.
 2. Hoffman.
 3. Square D; Schneider Electric.
- B. Description: Sheet metal sized and shaped as indicated, NEMA 250, Type 12, unless otherwise indicated.
- C. Fittings and Accessories: Include couplings, offsets, elbows, expansion joints, adapters, hold-down straps, end caps, and other fittings to match and mate with wireways as required for complete system.
- D. Wireway Covers: Hinged type.
- E. Finish: Manufacturer's standard enamel finish.

2.5 SURFACE RACEWAYS

- A. Surface Metal Raceways: Galvanized metallic with snap-on covers. Manufacturer's standard enamel finish in color selected by Architect.

1. Manufacturers: Subject to compliance with requirements, provide products by one of the following:
 - a. Thomas & Betts Corporation.
 - b. Walker Systems, Inc.; Wiremold Company (The).
 - c. Wiremold Company (The); Electrical Sales Division.

2.6 BOXES, ENCLOSURES, AND CABINETS

- A. Manufacturers: Subject to compliance with requirements, provide products by one of the following:
 1. Cooper Crouse-Hinds; Div. of Cooper Industries, Inc.
 2. EGS/Appleton Electric.
 3. Erickson Electrical Equipment Company.
 4. Hoffman.
 5. Hubbell Incorporated; Killark Electric Manufacturing Co. Division.
 6. O-Z/Gedney; a unit of General Signal.
 7. RACO; a Hubbell Company.
 8. Robroy Industries, Inc.; Enclosure Division.
 9. Scott Fetzer Co.; Adalet Division.
 10. Spring City Electrical Manufacturing Company.
 11. Thomas & Betts Corporation.
 12. Walker Systems, Inc.; Wiremold Company (The).
 13. Woodhead, Daniel Company; Woodhead Industries, Inc. Subsidiary.
- B. Sheet Metal Outlet and Device Boxes: NEMA OS 1.
- C. Cast-Metal Outlet and Device Boxes: NEMA FB 1, ferrous alloy, Type FD, with gasketed cover.
- D. Nonmetallic Outlet and Device Boxes: NEMA OS 2.
- E. Metal Floor Boxes: Cast or sheet metal, fully adjustable, rectangular.
- F. Nonmetallic Floor Boxes: Nonadjustable, round.
- G. Small Sheet Metal Pull and Junction Boxes: NEMA OS 1.
- H. Cast-Metal Access, Pull, and Junction Boxes: NEMA FB 1, galvanized, cast iron with gasketed cover.
- I. Hinged-Cover Enclosures: NEMA 250, Type 1, with continuous-hinge cover with flush latch, unless otherwise indicated.
 1. Metal Enclosures: Steel, finished inside and out with manufacturer's standard enamel.
 2. Nonmetallic Enclosures: Plastic.

J. Cabinets:

1. NEMA 250, Type 1, galvanized-steel box with removable interior panel and removable front, finished inside and out with manufacturer's standard enamel.
2. Hinged door in front cover with flush latch and concealed hinge.
3. Key latch to match panelboards.
4. Metal barriers to separate wiring of different systems and voltage.
5. Accessory feet where required for freestanding equipment.

2.7 HANDHOLES AND BOXES FOR EXTERIOR UNDERGROUND WIRING

A. Description: Comply with SCTE 77.

1. Color of Frame and Cover: See drawings.
2. Configuration: Units shall be designed for flush burial and have open bottom, unless otherwise indicated.
3. Cover: Weatherproof, secured by tamper-resistant locking devices and having structural load rating consistent with enclosure.
4. Cover Finish: Nonskid finish shall have a minimum coefficient of friction of 0.50.
5. Cover Legend: Molded lettering, as indicated for each service.
6. Conduit Entrance Provisions: Conduit-terminating fittings shall mate with entering ducts for secure, fixed installation in enclosure wall.
7. Handholes 12 inches wide by 24 inches long and larger shall have inserts for cable racks and pulling-in irons installed before concrete is poured.

B. Polymer-Concrete Handholes and Boxes with Polymer-Concrete Cover: Molded of sand and aggregate, bound together with polymer resin, and reinforced with steel or fiberglass or a combination of the two.

1. Basis-of-Design Product: Subject to compliance with requirements, provide the product indicated on Drawings or a comparable product by one of the following:
 - a. Armorcast Products Company.
 - b. Carson Industries LLC.
 - c. CDR Systems Corporation.
 - d. NewBasis.

C. Fiberglass Handholes and Boxes with Polymer-Concrete Frame and Cover: Sheet-molded, fiberglass-reinforced, polyester-resin enclosure joined to polymer-concrete top ring or frame.

1. Basis-of-Design Product: Subject to compliance with requirements, provide the product indicated on Drawings or a comparable product by one of the following:
 - a. Armorcast Products Company.
 - b. Carson Industries LLC.
 - c. Christy Concrete Products.
 - d. Synertech Moulded Products, Inc.; a division of Oldcastle Precast.

- D. Fiberglass Handholes and Boxes: Molded of fiberglass-reinforced polyester resin, with covers of polymer concrete.
1. Basis-of-Design Product: Subject to compliance with requirements, provide the product indicated on Drawings or a comparable product by one of the following:
 - a. Carson Industries LLC.
 - b. Christy Concrete Products.
 - c. Nordic Fiberglass, Inc.

2.8 SLEEVES FOR RACEWAYS

- A. Steel Pipe Sleeves: ASTM A 53/A 53M, Type E, Grade B, Schedule 40, galvanized steel, plain ends.
- B. Cast-Iron Pipe Sleeves: Cast or fabricated "wall pipe," equivalent to ductile-iron pressure pipe, with plain ends and integral waterstop, unless otherwise indicated.
- C. Sleeves for Rectangular Openings: Galvanized sheet steel with minimum 0.052- or 0.138-inch thickness as indicated and of length to suit application.
- D. Coordinate sleeve selection and application with selection and application of firestopping specified in Division 07 Section "Penetration Firestopping."

2.9 SLEEVE SEALS

- A. Basis-of-Design Product: Subject to compliance with requirements, provide the product indicated on Drawings or a comparable product by one of the following:
 1. Advance Products & Systems, Inc.
 2. Calpico, Inc.
 3. Metraflex Co.
 4. Pipeline Seal and Insulator, Inc.
- B. Description: Modular sealing device, designed for field assembly, to fill annular space between sleeve and cable.
 1. Sealing Elements: EPDM interlocking links shaped to fit surface of cable or conduit. Include type and number required for material and size of raceway or cable.
 2. Pressure Plates: Carbon steel. Include two for each sealing element.
 3. Connecting Bolts and Nuts: Carbon steel with corrosion-resistant coating of length required to secure pressure plates to sealing elements. Include one for each sealing element.

2.10 SOURCE QUALITY CONTROL FOR UNDERGROUND ENCLOSURES

- A. Handhole and Pull-Box Prototype Test: Test prototypes of handholes and boxes for compliance with SCTE 77. Strength tests shall be for specified tier ratings of products supplied.
 - 1. Tests of materials shall be performed by a independent testing agency.
 - 2. Strength tests of complete boxes and covers shall be by either an independent testing agency or manufacturer. A qualified registered professional engineer shall certify tests by manufacturer.
 - 3. Testing machine pressure gages shall have current calibration certification complying with ISO 9000 and ISO 10012, and traceable to NIST standards.

PART 3 - EXECUTION

3.1 RACEWAY INSTALLATION

- A. Underground runs, except under concrete floor slabs, shall have a minimum of 24" cover. Backfill shall be made in 6" layers – tamping each layer to a density of 95% of maximum possible.
- B. Raceways run external to building foundation walls, with the exception of branch circuit raceways, shall be encased with a minimum of 3" of concrete on all sides. Encased raceways shall have a minimum cover of 18", except for raceways containing circuits with voltages above 600 volts, which shall have a minimum cover of 30".
- C. All underground raceways shall be identified by underground line marking tape located directly above the raceway at 6" to 8" below finished grade. Tape shall be permanent, bright colored, continuous printed, metal compounded for direct burial not less than 6" wide and 4 mils thick. Printed legend on tape shall indicate general type of underground line below.

3.2 RACEWAY APPLICATION

- A. Outdoors: Apply raceway products as specified below, unless otherwise indicated:
 - 1. Exposed Conduit: Rigid steel conduit
 - 2. Concealed Conduit, Aboveground: IMC (including elbows that turn up from below grade).
 - 3. Underground Conduit: RNC, Type EPC- 80-PVC, direct buried.
 - 4. Connection to Vibrating Equipment (Including Transformers and Hydraulic, Pneumatic, Electric Solenoid, or Motor-Driven Equipment): LFMC.
 - 5. Boxes and Enclosures, Aboveground: NEMA 250, Type 4.
 - 6. Application of Handholes and Boxes for Underground Wiring:
 - a. Handholes and Pull Boxes in Driveway, Parking Lot, and Off-Roadway Locations, Subject to Occasional, Nondeliberate Loading by Heavy Vehicles: Polymer concrete, SCTE 77, Tier 15 structural load rating.

- b. Handholes and Pull Boxes in Sidewalk and Similar Applications with a Safety Factor for Nondeliberate Loading by Vehicles: Polymer-concrete units, SCTE 77, Tier 8 structural load rating.
 - c. Handholes and Pull Boxes Subject to Light-Duty Pedestrian Traffic Only: Fiberglass-reinforced polyester resin, structurally tested according to SCTE 77 with 3000-lbf vertical loading.
- B. Comply with the following indoor applications, unless otherwise indicated:
1. Exposed, Not Subject to Physical Damage: EMT.
 2. Exposed, Not Subject to Severe Physical Damage: EMT.
 3. Exposed and Subject to Severe Physical Damage: Rigid steel conduit. Includes raceways in the following locations:
 - a. Loading dock.
 - b. Corridors used for traffic of mechanized carts, forklifts, and pallet-handling units.
 - c. Mechanical rooms.
 4. Concealed in Ceilings and Interior Walls and Partitions: EMT.
 5. Connection to Vibrating Equipment (Including Transformers and Hydraulic, Pneumatic, Electric Solenoid, or Motor-Driven Equipment): FMC, except use LFMC in damp or wet locations.
 6. Damp or Wet Locations: IMC.
 7. Raceways for Optical Fiber or Communications Cable in Spaces Used for Environmental Air: Plenum-type, optical fiber/communications cable raceway.
 8. Raceways for Optical Fiber or Communications Cable Risers in Vertical Shafts: Riser-type, optical fiber/communications cable raceway.
 9. Raceways for Concealed General Purpose Distribution of Optical Fiber or Communications Cable: General-use, optical fiber/communications cable raceway.
 10. Boxes and Enclosures: NEMA 250, Type 1, except use NEMA 250, Type 4, nonmetallic in damp or wet locations.
- C. Minimum Raceway Size: 3/4-inch trade size.
- D. Raceway Fittings: Compatible with raceways and suitable for use and location.
1. Rigid and Intermediate Steel Conduit: Use threaded rigid steel conduit fittings, unless otherwise indicated.
 2. PVC Externally Coated, Rigid Steel Conduits: Use only fittings listed for use with that material. Patch and seal all joints, nicks, and scrapes in PVC coating after installing conduits and fittings. Use sealant recommended by fitting manufacturer.

3.3 INSTALLATION

- A. Comply with NECA 1 for installation requirements applicable to products specified in Part 2 except where requirements on Drawings or in this Article are stricter.

- B. Keep raceways at least 6 inches away from parallel runs of flues and steam or hot-water pipes. Install horizontal raceway runs above water and steam piping.
- C. Complete raceway installation before starting conductor installation.
- D. Support raceways as specified in Division 26 Section "Hangers and Supports for Electrical Systems."
- E. Arrange stub-ups so curved portions of bends are not visible above the finished slab.
- F. Install no more than the equivalent of three 90-degree bends in any conduit run except for communications conduits, for which fewer bends are allowed.
- G. Conceal conduit and EMT within finished walls, ceilings, and floors, unless otherwise indicated.
- H. Raceways Embedded in Slabs:
 - 1. Run conduit larger than 1-inch trade size, parallel or at right angles to main reinforcement. Where at right angles to reinforcement, place conduit close to slab support.
 - 2. Arrange raceways to cross building expansion joints at right angles with expansion fittings.
- I. Threaded Conduit Joints, Exposed to Wet, Damp, Corrosive, or Outdoor Conditions: Apply listed compound to threads of raceway and fittings before making up joints. Follow compound manufacturer's written instructions.
- J. Raceway Terminations at Locations Subject to Moisture or Vibration: Use insulating bushings to protect conductors, including conductors smaller than No. 4 AWG.
- K. Install pull wires in empty raceways. Use polypropylene or monofilament plastic line with not less than 200-lb tensile strength. Leave at least 12 inches of slack at each end of pull wire.
- L. Raceways for Optical Fiber and Communications Cable: Install raceways, metallic and nonmetallic, rigid and flexible, as follows:
 - 1. 3/4-Inch Trade Size and Smaller: Install raceways in maximum lengths of 50 feet.
 - 2. 1-Inch Trade Size and Larger: Install raceways in maximum lengths of 75 feet.
 - 3. Install with a maximum of two 90-degree bends or equivalent for each length of raceway unless Drawings show stricter requirements. Separate lengths with pull or junction boxes or terminations at distribution frames or cabinets where necessary to comply with these requirements.
- M. Install raceway sealing fittings at suitable, approved, and accessible locations and fill them with listed sealing compound. For concealed raceways, install each fitting in a flush steel box with a blank cover plate having a finish similar to that of adjacent plates or surfaces. Install raceway sealing fittings at the following points:

1. Where conduits pass from warm to cold locations, such as boundaries of refrigerated spaces.
 2. Where otherwise required by NFPA 70.
- N. Expansion-Joint Fittings for RNC: Install in each run of aboveground conduit that is located where environmental temperature change may exceed 30 deg F, and that has straight-run length that exceeds 25 feet.
1. Install expansion-joint fittings for each of the following locations, and provide type and quantity of fittings that accommodate temperature change listed for location:
 - a. Outdoor Locations Not Exposed to Direct Sunlight: 125 deg F temperature change.
 - b. Outdoor Locations Exposed to Direct Sunlight: 155 deg F temperature change.
 - c. Indoor Spaces: Connected with the Outdoors without Physical Separation: 125 deg F temperature change.
 - d. Attics: 135 deg F temperature change.
 2. Install fitting(s) that provide expansion and contraction for at least 0.00041 inch per foot of length of straight run per deg F of temperature change.
 3. Install each expansion-joint fitting with position, mounting, and piston setting selected according to manufacturer's written instructions for conditions at specific location at the time of installation.
- O. Flexible Conduit Connections: Use maximum of 72 inches of flexible conduit for recessed and semirecessed lighting fixtures, equipment subject to vibration, noise transmission, or movement; and for transformers and motors.
1. Use LFMC in damp or wet locations subject to severe physical damage.
 2. Use LFMC in damp or wet locations not subject to severe physical damage.
- P. Recessed Boxes in Masonry Walls: Saw-cut opening for box in center of cell of masonry block, and install box flush with surface of wall.
- Q. Set metal floor boxes level and flush with finished floor surface.
- R. Set nonmetallic floor boxes level. Trim after installation to fit flush with finished floor surface.
- 3.4 INSTALLATION OF UNDERGROUND CONDUIT
- A. Direct-Buried Conduit:
1. Excavate trench bottom to provide firm and uniform support for conduit. Prepare trench bottom as specified in Division 31 Section "Earth Moving" for pipe less than 6 inches in nominal diameter.
 2. Install backfill as specified in Division 31 Section "Earth Moving."
 3. After installing conduit, backfill and compact. Start at tie-in point, and work toward end of conduit run, leaving conduit at end of run free to move with expansion and contraction as temperature changes during this process. Firmly hand tamp backfill around conduit to

- provide maximum supporting strength. After placing controlled backfill to within 12 inches of finished grade, make final conduit connection at end of run and complete backfilling with normal compaction as specified in Division 31 Section "Earth Moving."
4. Install manufactured duct elbows for stub-ups at poles and equipment and at building entrances through the floor, unless otherwise indicated. Encase elbows for stub-up ducts throughout the length of the elbow.
 5. Install manufactured rigid steel conduit elbows for stub-ups at poles and equipment and at building entrances through the floor.
 - a. Couple steel conduits to ducts with adapters designed for this purpose, and encase coupling with 3 inches of concrete.
 - b. For stub-ups at equipment mounted on outdoor concrete bases, extend steel conduit horizontally a minimum of 60 inches from edge of equipment pad or foundation. Install insulated grounding bushings on terminations at equipment.
 6. All underground raceways shall be identified by underground line marking tape located directly above the raceway at 6 to 8 inches below finished grade. Tape shall be permanent, bright-colored, continuous printed, plastic tape compounded for direct burial not less than 6 inches wide and 4 mils thick. Printed legend shall be indicative of general type of underground line below.

3.5 INSTALLATION OF UNDERGROUND HANDHOLES AND BOXES

- A. Install handholes and boxes level and plumb and with orientation and depth coordinated with connecting conduits to minimize bends and deflections required for proper entrances.
- B. Unless otherwise indicated, support units on a level bed of crushed stone or gravel, graded from 1/2-inch sieve to No. 4 sieve and compacted to same density as adjacent undisturbed earth.
- C. Elevation: In paved areas, set so cover surface will be flush with finished grade. Set covers of other enclosures 1 inch above finished grade.
- D. Install handholes and boxes with bottom below the frost line, below grade.
- E. Install removable hardware, including pulling eyes, cable stanchions, cable arms, and insulators, as required for installation and support of cables and conductors and as indicated. Select arm lengths to be long enough to provide spare space for future cables, but short enough to preserve adequate working clearances in the enclosure.
- F. Field-cut openings for conduits according to enclosure manufacturer's written instructions. Cut wall of enclosure with a tool designed for material to be cut. Size holes for terminating fittings to be used, and seal around penetrations after fittings are installed.

3.6 SLEEVE INSTALLATION FOR ELECTRICAL PENETRATIONS

- A. Coordinate sleeve selection and application with selection and application of firestopping specified in Division 07 Section "Penetration Firestopping."

- B. Concrete Slabs and Walls: Install sleeves for penetrations unless core-drilled holes or formed openings are used. Install sleeves during erection of slabs and walls.
- C. Use pipe sleeves unless penetration arrangement requires rectangular sleeved opening.
- D. Rectangular Sleeve Minimum Metal Thickness:
 - 1. For sleeve cross-section rectangle perimeter less than 50 inches and no side greater than 16 inches, thickness shall be 0.052 inch.
 - 2. For sleeve cross-section rectangle perimeter equal to, or greater than, 50 inches and 1 or more sides equal to, or greater than, 16 inches, thickness shall be 0.138 inch.
- E. Fire-Rated Assemblies: Install sleeves for penetrations of fire-rated floor and wall assemblies unless openings compatible with firestop system used are fabricated during construction of floor or wall.
- F. Cut sleeves to length for mounting flush with both surfaces of walls.
- G. Extend sleeves installed in floors 2 inches above finished floor level.
- H. Size pipe sleeves to provide 1/4-inch annular clear space between sleeve and raceway unless sleeve seal is to be installed or unless seismic criteria require different clearance.
- I. Seal space outside of sleeves with grout for penetrations of concrete and masonry and with approved joint compound for gypsum board assemblies.
- J. Interior Penetrations of Non-Fire-Rated Walls and Floors: Seal annular space between sleeve and raceway, using joint sealant appropriate for size, depth, and location of joint. Refer to Division 07 Section "Joint Sealants" for materials and installation.
- K. Fire-Rated-Assembly Penetrations: Maintain indicated fire rating of walls, partitions, ceilings, and floors at raceway penetrations. Install sleeves and seal with firestop materials. Comply with Division 07 Section "Penetration Firestopping."
- L. Roof-Penetration Sleeves: Seal penetration of individual raceways with flexible, boot-type flashing units applied in coordination with roofing work.
- M. Aboveground, Exterior-Wall Penetrations: Seal penetrations using sleeves and mechanical sleeve seals. Select sleeve size to allow for 1-inch annular clear space between pipe and sleeve for installing mechanical sleeve seals.
- N. Underground, Exterior-Wall Penetrations: Install cast-iron "wall pipes" for sleeves. Size sleeves to allow for 1-inch annular clear space between raceway and sleeve for installing mechanical sleeve seals.

3.7 SLEEVE-SEAL INSTALLATION

- A. Install to seal underground, exterior wall penetrations.

- B. Use type and number of sealing elements recommended by manufacturer for raceway material and size. Position raceway in center of sleeve. Assemble mechanical sleeve seals and install in annular space between raceway and sleeve. Tighten bolts against pressure plates that cause sealing elements to expand and make watertight seal.

3.8 FIRESTOPPING

- A. Apply firestopping to electrical penetrations of fire-rated floor and wall assemblies to restore original fire-resistance rating of assembly. Firestopping materials and installation requirements are specified in Division 07 Section "Penetration Firestopping."

3.9 PROTECTION

- A. Provide final protection and maintain conditions that ensure coatings, finishes, and cabinets are without damage or deterioration at time of Completion.
 - 1. Repair damage to galvanized finishes with zinc-rich paint recommended by manufacturer.
 - 2. Repair damage to PVC or paint finishes with matching touchup coating recommended by manufacturer.

END OF SECTION 260533

SECTION 260548 - VIBRATION AND SEISMIC CONTROLS FOR ELECTRICAL SYSTEMS

PART 1 - GENERAL

1.1 RELATED DOCUMENTS

- A. Drawings and general provisions of the Contract, including General and Supplementary Conditions and Division 01 Specification Sections, apply to this Section.

1.2 SUMMARY

- A. This Section includes the following:

1. Isolation pads.
2. Spring isolators.
3. Restrained spring isolators.
4. Channel support systems.
5. Restraint cables.
6. Hanger rod stiffeners.
7. Anchorage bushings and washers.

- B. Related Sections include the following:

1. Division 26 Section "Hangers and Supports For Electrical Systems" for commonly used electrical supports and installation requirements.

1.3 DEFINITIONS

- A. The IBC: International Building Code.
- B. ICC-ES: ICC-Evaluation Service.

1.4 PERFORMANCE REQUIREMENTS

- A. Seismic-Restraint Loading:

1. Site Class as Defined in the IBC: D
2. Assigned Seismic Use Group or Building Category as Defined in the IBC: I
 - a. Component Importance Factor: 1.25
 - b. Component Response Modification Factor:
 - c. Component Amplification Factor:
3. Design Spectral Response Acceleration at Short Periods (0.2 Second):

4. Design Spectral Response Acceleration at 1.0-Second Period:

1.5 SUBMITTALS

A. Product Data: For the following:

1. Include rated load, rated deflection, and overload capacity for each vibration isolation device.
2. Illustrate and indicate style, material, strength, fastening provision, and finish for each type and size of seismic-restraint component used.
 - a. Tabulate types and sizes of seismic restraints, complete with report numbers and rated strength in tension and shear as evaluated by an agency acceptable to authorities having jurisdiction.
 - b. Annotate to indicate application of each product submitted and compliance with requirements.
3. Restrained-Isolation Devices: Include ratings for horizontal, vertical, and combined loads.

B. Delegated-Design Submittal: For vibration isolation and seismic-restraint details indicated to comply with performance requirements and design criteria, including analysis data signed and sealed by the qualified professional engineer, **Licensed in North Carolina**, responsible for their preparation.

1. Design Calculations: Calculate static and dynamic loading due to equipment weight and operation, seismic forces required to select vibration isolators and seismic restraints.
 - a. Coordinate design calculations with wind-load calculations required for equipment mounted outdoors. Comply with requirements in other Division 26 Sections for equipment mounted outdoors.
2. Indicate materials and dimensions and identify hardware, including attachment and anchorage devices.
3. Field-fabricated supports.
4. Seismic-Restraint Details:
 - a. Design Analysis: To support selection and arrangement of seismic restraints. Include calculations of combined tensile and shear loads.
 - b. Details: Indicate fabrication and arrangement. Detail attachments of restraints to the restrained items and to the structure. Show attachment locations, methods, and spacings. Identify components, list their strengths, and indicate directions and values of forces transmitted to the structure during seismic events. Indicate association with vibration isolation devices.
 - c. Preapproval and Evaluation Documentation: an agency acceptable to authorities having jurisdiction, showing maximum ratings of restraint items and the basis for approval (tests or calculations).

- C. Coordination Drawings: Show coordination of seismic bracing for electrical components with other systems and equipment in the vicinity, including other supports and seismic restraints.
- D. Welding certificates.
- E. Qualification Data: For professional engineer and testing agency.

1.6 QUALITY ASSURANCE

- A. Testing Agency Qualifications: An independent agency, with the experience and capability to conduct the testing indicated, that is a nationally recognized testing laboratory (NRTL) as defined by OSHA in 29 CFR 1910.7, and that is acceptable to authorities having jurisdiction.
- B. Comply with seismic-restraint requirements in the IBC unless requirements in this Section are more stringent.
- C. Welding: Qualify procedures and personnel according to AWS D1.1/D1.1M, "Structural Welding Code - Steel."
- D. Seismic-restraint devices shall have horizontal and vertical load testing and analysis and shall bear anchorage preapproval OPA number from OSHPD, preapproval by ICC-ES, or preapproval by another agency acceptable to authorities having jurisdiction, showing maximum seismic-restraint ratings. Ratings based on independent testing are preferred to ratings based on calculations. If preapproved ratings are not available, submittals based on independent testing are preferred. Calculations (including combining shear and tensile loads) to support seismic-restraint designs must be signed and sealed by a qualified professional engineer.
- E. Comply with NFPA 70.

PART 2 - PRODUCTS

2.1 VIBRATION ISOLATORS

- A. Basis-of-Design Product: Subject to compliance with requirements, provide the product indicated on Drawings or a comparable product by one of the following:
 - 1. Ace Mountings Co., Inc.
 - 2. Amber/Booth Company, Inc.
 - 3. California Dynamics Corporation.
 - 4. Isolation Technology, Inc.
 - 5. Kinetics Noise Control.
 - 6. Mason Industries.
 - 7. Vibration Eliminator Co., Inc.
 - 8. Vibration Isolation.
 - 9. Vibration Mountings & Controls, Inc.

- B. Pads: Arrange in single or multiple layers of sufficient stiffness for uniform loading over pad area, molded with a nonslip pattern and galvanized-steel baseplates, and factory cut to sizes that match requirements of supported equipment.
 - 1. Resilient Material: Oil- and water-resistant neoprene rubber hermetically sealed compressed fiberglass.
- C. Spring Isolators: Freestanding, laterally stable, open-spring isolators.
 - 1. Outside Spring Diameter: Not less than 80 percent of the compressed height of the spring at rated load.
 - 2. Minimum Additional Travel: 50 percent of the required deflection at rated load.
 - 3. Lateral Stiffness: More than 80 percent of rated vertical stiffness.
 - 4. Overload Capacity: Support 200 percent of rated load, fully compressed, without deformation or failure.
 - 5. Baseplates: Factory drilled for bolting to structure and bonded to 1/4-inch- thick, rubber isolator pad attached to baseplate underside. Baseplates shall limit floor load to 500 psig.
 - 6. Top Plate and Adjustment Bolt: Threaded top plate with adjustment bolt and cap screw to fasten and level equipment.
- D. Restrained Spring Isolators: Freestanding, steel, open-spring isolators with seismic or limit-stop restraint.
 - 1. Housing: Steel with resilient vertical-limit stops to prevent spring extension due to weight being removed; factory-drilled baseplate bonded to 1/4-inch- thick, neoprene or rubber isolator pad attached to baseplate underside; and adjustable equipment mounting and leveling bolt that acts as blocking during installation.
 - 2. Restraint: Seismic or limit-stop as required for equipment and authorities having jurisdiction.
 - 3. Outside Spring Diameter: Not less than 80 percent of the compressed height of the spring at rated load.
 - 4. Minimum Additional Travel: 50 percent of the required deflection at rated load.
 - 5. Lateral Stiffness: More than 80 percent of rated vertical stiffness.
 - 6. Overload Capacity: Support 200 percent of rated load, fully compressed, without deformation or failure.

2.2 SEISMIC-RESTRAINT DEVICES

- A. Basis-of-Design Product: Subject to compliance with requirements, provide the product indicated on Drawings or a comparable product by one of the following:
 - 1. Amber/Booth Company, Inc.
 - 2. California Dynamics Corporation.
 - 3. Cooper B-Line, Inc.; a division of Cooper Industries.
 - 4. Hilti Inc.
 - 5. Loos & Co.; Seismic Earthquake Division.
 - 6. Mason Industries.
 - 7. TOLCO Incorporated; a brand of NIBCO INC.

8. Unistrut; Tyco International, Ltd.
- B. General Requirements for Restraint Components: Rated strengths, features, and application requirements shall be as defined in reports by an evaluation service member of ICC-ES OSHPD an agency acceptable to authorities having jurisdiction.
 1. Structural Safety Factor: Allowable strength in tension, shear, and pullout force of components shall be at least four times the maximum seismic forces to which they will be subjected.
- C. Channel Support System: MFMA-3, shop- or field-fabricated support assembly made of slotted steel channels with accessories for attachment to braced component at one end and to building structure at the other end and other matching components and with corrosion-resistant coating; and rated in tension, compression, and torsion forces.
- D. Restraint Cables: ASTM A 603 galvanized -steel cables with end connections made of steel assemblies with thimbles, brackets, swivels, and bolts designed for restraining cable service; and with a minimum of two clamping bolts for cable engagement.
- E. Hanger Rod Stiffener: Steel tube or steel slotted-support-system sleeve with internally bolted connections to hanger rod. Do not weld stiffeners to rods.
- F. Bushings for Floor-Mounted Equipment Anchor: Neoprene bushings designed for rigid equipment mountings, and matched to type and size of anchors and studs.
- G. Bushing Assemblies for Wall-Mounted Equipment Anchorage: Assemblies of neoprene elements and steel sleeves designed for rigid equipment mountings, and matched to type and size of attachment devices.
- H. Resilient Isolation Washers and Bushings: One-piece, molded, oil- and water-resistant neoprene, with a flat washer face.
- I. Mechanical Anchor: Drilled-in and stud-wedge or female-wedge type in zinc-coated steel for interior applications and stainless steel for exterior applications. Select anchors with strength required for anchor and as tested according to ASTM E 488. Minimum length of eight times diameter.
- J. Adhesive Anchor: Drilled-in and capsule anchor system containing polyvinyl or urethane methacrylate-based resin and accelerator, or injected polymer or hybrid mortar adhesive. Provide anchor bolts and hardware with zinc-coated steel for interior applications and stainless steel for exterior applications. Select anchor bolts with strength required for anchor and as tested according to ASTM E 488.

2.3 FACTORY FINISHES

- A. Finish: Manufacturer's standard prime-coat finish ready for field painting.

- B. Finish: Manufacturer's standard paint applied to factory-assembled and -tested equipment before shipping.
 - 1. Powder coating on springs and housings.
 - 2. All hardware shall be galvanized. Hot-dip galvanize metal components for exterior use.
 - 3. Baked enamel or powder coat for metal components on isolators for interior use.
 - 4. Color-code or otherwise mark vibration isolation and seismic-control devices to indicate capacity range.

PART 3 - EXECUTION

3.1 EXAMINATION

- A. Examine areas and equipment to receive vibration isolation and seismic-control devices for compliance with requirements for installation tolerances and other conditions affecting performance.
- B. Examine roughing-in of reinforcement and cast-in-place anchors to verify actual locations before installation.
- C. Proceed with installation only after unsatisfactory conditions have been corrected.

3.2 APPLICATIONS

- A. Multiple Raceways or Cables: Secure raceways and cables to trapeze member with clamps approved for application by an agency acceptable to authorities having jurisdiction.
- B. Hanger Rod Stiffeners: Install hanger rod stiffeners where indicated or scheduled on Drawings to receive them and where required to prevent buckling of hanger rods due to seismic forces.
- C. Strength of Support and Seismic-Restraint Assemblies: Where not indicated, select sizes of components so strength will be adequate to carry present and future static and seismic loads within specified loading limits.

3.3 SEISMIC-RESTRAINT DEVICE INSTALLATION

- A. Equipment and Hanger Restraints:
 - 1. Install restrained isolators on electrical equipment.
 - 2. Install resilient, bolt-isolation washers on equipment anchor bolts where clearance between anchor and adjacent surface exceeds 0.125 inch.
 - 3. Install seismic-restraint devices using methods approved by an agency acceptable to authorities having jurisdiction providing required submittals for component.

- B. Install bushing assemblies for mounting bolts for wall-mounted equipment, arranged to provide resilient media where equipment or equipment-mounting channels are attached to wall.
- C. Attachment to Structure: If specific attachment is not indicated, anchor bracing to structure at flanges of beams, at upper truss chords of bar joists, or at concrete members.
- D. Drilled-in Anchors:
 - 1. Identify position of reinforcing steel and other embedded items prior to drilling holes for anchors. Do not damage existing reinforcing or embedded items during coring or drilling. Notify the structural engineer if reinforcing steel or other embedded items are encountered during drilling. Locate and avoid prestressed tendons, electrical and telecommunications conduit, and gas lines.
 - 2. Do not drill holes in concrete or masonry until concrete, mortar, or grout has achieved full design strength.
 - 3. Wedge Anchors: Protect threads from damage during anchor installation. Heavy-duty sleeve anchors shall be installed with sleeve fully engaged in the structural element to which anchor is to be fastened.
 - 4. Adhesive Anchors: Clean holes to remove loose material and drilling dust prior to installation of adhesive. Place adhesive in holes proceeding from the bottom of the hole and progressing toward the surface in such a manner as to avoid introduction of air pockets in the adhesive.
 - 5. Set anchors to manufacturer's recommended torque, using a torque wrench.
 - 6. Install zinc-coated steel anchors for interior and stainless-steel anchors for exterior applications.

3.4 ACCOMMODATION OF DIFFERENTIAL SEISMIC MOTION

- A. Install flexible connections in runs of raceways, cables, wireways, cable trays, and busways where they cross seismic joints, where adjacent sections or branches are supported by different structural elements, and where they terminate with connection to equipment that is anchored to a different structural element from the one supporting them as they approach equipment.

3.5 FIELD QUALITY CONTROL

- A. Testing Agency: Engage a qualified testing agency to perform tests and inspections and prepare test reports.
- B. Tests and Inspections:
 - 1. Provide evidence of recent calibration of test equipment by a testing agency acceptable to authorities having jurisdiction.
 - 2. Schedule test with Owner, through Architect, before connecting anchorage device to restrained component (unless post-connection testing has been approved), and with at least seven days' advance notice.
 - 3. Obtain Architect's approval before transmitting test loads to structure. Provide temporary load-spreading members.

4. Test at least four of each type and size of installed anchors and fasteners selected by Architect.
5. Test to 90 percent of rated proof load of device.
6. Measure isolator restraint clearance.
7. Measure isolator deflection.
8. Verify snubber minimum clearances.
9. If a device fails test, modify all installations of same type and retest until satisfactory results are achieved.

C. Remove and replace malfunctioning units and retest as specified above.

D. Prepare test and inspection reports.

3.6 ADJUSTING

A. Adjust isolators after isolated equipment is at operating weight.

B. Adjust limit stops on restrained spring isolators to mount equipment at normal operating height. After equipment installation is complete, adjust limit stops so they are out of contact during normal operation.

C. Adjust active height of spring isolators.

D. Adjust restraints to permit free movement of equipment within normal mode of operation.

END OF SECTION 260548

SECTION 262413 - SWITCHBOARDS

PART 1 - GENERAL

1.1 RELATED DOCUMENTS

- A. Drawings and general provisions of the Contract, including General and Supplementary Conditions and Division 01 Specification Sections, apply to this Section.
- B. E.C. responsible for all Breaker Testing required.
- C. Gear manufacturer shall provide a full coordination study to the Engineer for approval during submittal process. Coordination Study is to be sealed by an engineer licensed in North Carolina.
- D. A. Switchboard shall be provided with painted "schematic" bus on front of enclosure to depict actual bus arrangement inside cubicles.
- E. Provide a laminated drawing of the building electrical riser next to each switchboard in the main electrical room framed and mounted under glass.

1.2 SUMMARY

- A. Section Includes:
 - 1. Service and distribution switchboards rated 600 V and less.
 - 2. Transient voltage suppression devices.
 - 3. Disconnecting and overcurrent protective devices.
 - 4. Instrumentation.
 - 5. Control power.
 - 6. Accessory components and features.
 - 7. Identification.
 - 8. Mimic bus.

1.3 PERFORMANCE REQUIREMENTS

- A. Seismic Performance: Switchboards shall withstand the effects of earthquake motions determined according to SEI/ASCE 7.
 - 1. The term "withstand" means "the unit will remain in place without separation of any parts from the device when subjected to the seismic forces specified."

1.4 SUBMITTALS

- A. Product Data: For each type of switchboard, overcurrent protective device, transient voltage suppression device, ground-fault protector, accessory, and component indicated. Include dimensions and manufacturers' technical data on features, performance, electrical characteristics, ratings, accessories, and finishes.
- B. Shop Drawings: For each switchboard and related equipment.
1. Include dimensioned plans, elevations, sections, and details, including required clearances and service space around equipment. Show tabulations of installed devices, equipment features, and ratings.
 2. Detail enclosure types for types other than NEMA 250, Type 1.
 3. Detail bus configuration, current, and voltage ratings.
 4. Detail short-circuit current rating of switchboards and overcurrent protective devices.
 5. Include descriptive documentation of optional barriers specified for electrical insulation and isolation.
 6. Detail utility company's metering provisions with indication of approval by utility company.
 7. Detail features, characteristics, ratings, and factory settings of individual overcurrent protective devices and auxiliary components.
 8. Include time-current coordination curves for each type and rating of overcurrent protective device included in switchboards. Submit on translucent log-log graft paper; include selectable ranges for each type of overcurrent protective device.
 9. Include diagram and details of proposed mimic bus.
 10. Include schematic and wiring diagrams for power, signal, and control wiring.
 11. The engineer of record must seal and sign the manufacturers' Short-Circuit Analysis.
- C. Samples: Representative portion of mimic bus with specified material and finish, for color selection.
- D. Qualification Data: For qualified Installer.
- E. Seismic Qualification Certificates: Submit certification that switchboards, overcurrent protective devices, accessories, and components will withstand seismic forces defined in Division 26 Section "Vibration and Seismic Controls for Electrical Systems." Include the following:
1. Basis for Certification: Indicate whether withstand certification is based on actual test of assembled components or on calculation.
 2. Dimensioned Outline Drawings of Equipment Unit: Identify center of gravity and locate and describe mounting and anchorage provisions.
 3. Detailed description of equipment anchorage devices on which the certification is based and their installation requirements.
- F. Field Quality-Control Reports:
1. Test procedures used.
 2. Test results that comply with requirements.

3. Results of failed tests and corrective action taken to achieve test results that comply with requirements.

G. Operation and Maintenance Data: For switchboards and components to include in emergency, operation, and maintenance manuals. In addition to items specified in Division 01 Section "Operation and Maintenance Data," include the following:

1. Routine maintenance requirements for switchboards and all installed components.
2. Manufacturer's written instructions for testing and adjusting overcurrent protective devices.
3. Time-current coordination curves for each type and rating of overcurrent protective device included in switchboards. Submit on translucent log-log graft paper; include selectable ranges for each type of overcurrent protective device.

1.5 QUALITY ASSURANCE

- A. Installer Qualifications: An employer of workers qualified as defined in NEMA PB 2.1 and trained in electrical safety as required by NFPA 70E.
- B. Testing Agency Qualifications: Member company of NETA or an NRTL.
 1. Testing Agency's Field Supervisor: Currently certified by NETA to supervise on-site testing.
- C. Source Limitations: Obtain switchboards, overcurrent protective devices, components, and accessories from single source from single manufacturer.
- D. Product Selection for Restricted Space: Drawings indicate maximum dimensions for switchboards including clearances between switchboards and adjacent surfaces and other items. Comply with indicated maximum dimensions.
- E. Electrical Components, Devices, and Accessories: Listed and labeled as defined in NFPA 70, by a qualified testing agency, and marked for intended location and application.
- F. Comply with NEMA PB 2.
- G. Comply with NFPA 70.
- H. Comply with UL 891.

1.6 DELIVERY, STORAGE, AND HANDLING

- A. Deliver switchboards in sections or lengths that can be moved past obstructions in delivery path.
- B. Remove loose packing and flammable materials from inside switchboards and install temporary electric heating (250 W per section) to prevent condensation.
- C. Handle and prepare switchboards for installation according to NEMA PB 2.1.

1.7 PROJECT CONDITIONS

- A. Installation Pathway: Remove and replace access fencing, doors, lift-out panels, and structures to provide pathway for moving switchboards into place.
- B. Environmental Limitations:
 - 1. Do not deliver or install switchboards until spaces are enclosed and weathertight, wet work in spaces is complete and dry, work above switchboards is complete, and temporary HVAC system is operating and maintaining ambient temperature and humidity conditions at occupancy levels during the remainder of the construction period.
 - 2. Rate equipment for continuous operation under the following conditions unless otherwise indicated:
 - a. Ambient Temperature: Not exceeding 104 deg F (40 deg C).
 - b. Altitude: Not exceeding 6600 feet (2000 m).
- C. Service Conditions: NEMA PB 2, usual service conditions, as follows:
 - 1. Ambient temperatures within limits specified.
 - 2. Altitude not exceeding 6600 feet (2000 m).
- D. Interruption of Existing Electric Service: Do not interrupt electric service to facilities occupied by Owner or others unless permitted under the following conditions and then only after arranging to provide temporary electric service according to requirements indicated:
 - 1. Notify Architect no fewer than seven days in advance of proposed interruption of electric service.
 - 2. Indicate method of providing temporary electric service.
 - 3. Do not proceed with interruption of electric service without Architect's written permission.
 - 4. Comply with NFPA 70E.

1.8 COORDINATION

- A. Coordinate layout and installation of switchboards and components with other construction that penetrates walls or is supported by them, including electrical and other types of equipment, raceways, piping, encumbrances to workspace clearance requirements, and adjacent surfaces. Maintain required workspace clearances and required clearances for equipment access doors and panels.
- B. Coordinate sizes and locations of concrete bases with actual equipment provided. Cast anchor-bolt inserts into bases. Concrete, reinforcement, and formwork requirements are specified in Division 03.

1.9 WARRANTY

- A. Special Warranty: Manufacturer's standard form in which manufacturer agrees to repair or replace transient voltage suppression devices that fail in materials or workmanship within specified warranty period.
1. Warranty Period: Five years from date of Substantial Completion of work.

1.10 EXTRA MATERIALS

- A. Furnish extra materials that match products installed and that are packaged with protective covering for storage and identified with labels describing contents.
1. Potential Transformer Fuses: Equal to 10 percent of quantity installed for each size and type, but no fewer than two of each size and type.
 2. Control-Power Fuses: Equal to 10 percent of quantity installed for each size and type, but no fewer than two of each size and type.
 3. Fuses and Fusible Devices for Fused Circuit Breakers: Equal to 10 percent of quantity installed for each size and type, but no fewer than three of each size and type.
 4. Fuses for Fused Switches: Equal to 10 percent of quantity installed for each size and type, but no fewer than three of each size and type.
 5. Fuses for Fused Power-Circuit Devices: Equal to 10 percent of quantity installed for each size and type, but no fewer than three of each size and type.
 6. Indicating Lights: Equal to 10 percent of quantity installed for each size and type, but no fewer than one of each size and type.

PART 2 - PRODUCTS

2.1 MANUFACTURED UNITS

- A. Basis-of-Design Product: Subject to compliance with requirements, provide product indicated on Drawings or comparable product by one of the following:
1. Eaton Electrical Inc.; Cutler-Hammer Business Unit.
 2. General Electric Company; GE Consumer & Industrial - Electrical Distribution.
 3. Siemens Energy & Automation, Inc.
 4. Square D; a brand of Schneider Electric.
- B. Front-Connected, Front-Accessible Switchboards:
1. Main Devices: Fixed, individually mounted.
 2. Branch Devices: Panel mounted.
 3. Sections front and rear aligned.
- C. Nominal System Voltage: as indicated on the drawings.
- D. Main-Bus Continuous: silver plated copper of the ampacity as indicated on the drawings.

- E. Seismic Requirements: Fabricate and test switchboards according to IEEE 344 to withstand seismic forces defined in Division 26 Section "Vibration and Seismic Controls for Electrical Systems."
- F. Indoor Enclosures: Steel, NEMA 250, Type 1.
- G. Enclosure Finish for Indoor Units: Factory-applied finish in manufacturer's standard gray finish over a rust-inhibiting primer on treated metal surface.
- H. Barriers: Between adjacent switchboard sections.
- I. Insulation and isolation for main bus of main section and main and vertical buses of feeder sections.
- J. Cubical Space Heaters: Factory-installed electric space heaters of sufficient wattage in each vertical section to maintain enclosure temperature above expected dew point.
 - 1. Space-Heater Control: Thermostats to maintain temperature of each section above expected dew point.
 - 2. Space-Heater Power Source: Transformer, factory installed in switchboard.
- K. Customer Metering Compartment: A separate customer metering compartment and section with front hinged door, for indicated metering, and current transformers for each meter. Current transformer secondary wiring shall be terminated on shorting-type terminal blocks. Include potential transformers having primary and secondary fuses with disconnecting means and secondary wiring terminated on terminal blocks.
- L. Bus Transition and Incoming Pull Sections: Matched and aligned with basic switchboard.
- M. Removable, Hinged Rear Doors and Compartment Covers: Secured by captive thumb screws, for access to rear interior of switchboard.
- N. Hinged Front Panels: Allow access to circuit breaker, metering, accessory, and blank compartments.
- O. Pull Box on Top of Switchboard:
 - 1. Adequate ventilation to maintain temperature in pull box within same limits as switchboard.
 - 2. Set back from front to clear circuit-breaker removal mechanism.
 - 3. Removable covers shall form top, front, and sides. Top covers at rear shall be easily removable for drilling and cutting.
 - 4. Bottom shall be insulating, fire-resistive material with separate holes for cable drops into switchboard.
 - 5. Cable supports shall be arranged to facilitate cabling and adequate to support cables indicated, including those for future installation.
- P. Buses and Connections: Three phase, four wire unless otherwise indicated.

1. Phase- and Neutral-Bus Material: silver plated hard-drawn copper of 98 percent conductivity, copper feeder circuit-breaker line connections.
 2. Load Terminals: Insulated, rigidly braced, runback bus extensions, of same material as through buses, equipped with compression connectors for outgoing circuit conductors. Provide load terminals for future circuit-breaker positions at full-ampere rating of circuit-breaker position.
 3. Ground Bus: 1/4-by-2-inch- hard-drawn copper of 98 percent conductivity, equipped with compression connectors for feeder and branch-circuit ground conductors. For busway feeders, extend insulated equipment grounding cable to busway ground connection and support cable at intervals in vertical run.
 4. Main Phase Buses and Equipment Ground Buses: Uniform capacity for entire length of switchboard's main and distribution sections. Provide for future extensions from both ends.
 5. Neutral Buses: 100 percent of the ampacity of phase buses unless otherwise indicated, equipped with compression connectors for outgoing circuit neutral cables. Brace bus extensions for busway feeder neutral bus.
 6. Isolation Barrier Access Provisions: Permit checking of bus-bolt tightness.
- Q. Future Devices: Equip compartments with mounting brackets, supports, bus connections, and appurtenances at full rating of circuit-breaker compartment.
- R. Bus-Bar Insulation: Factory-applied, flame-retardant, tape wrapping of individual bus bars or flame-retardant, spray-applied insulation. Minimum insulation temperature rating of 105 deg C.
- S. Fungus Proofing: Permanent fungicidal treatment for overcurrent protective devices and other components including instruments and instrument transformers.

2.2 DISCONNECTING AND OVERCURRENT PROTECTIVE DEVICES

- A. Molded-Case Circuit Breaker (MCCB): Comply with UL 489, fully rated to interrupt the short-circuit current available at terminals. Series ratings are not allowed.
1. Thermal-Magnetic Circuit Breakers: Inverse time-current element for low-level overloads, and instantaneous magnetic trip element for short circuits. Adjustable magnetic trip setting for circuit-breaker frame sizes 250 A and larger.
 2. Adjustable Instantaneous-Trip Circuit Breakers: Magnetic trip element with front-mounted, field-adjustable trip setting.
 3. Electronic trip circuit breakers with rms sensing; field-replaceable rating plug or field-replicable electronic trip; and the following field-adjustable settings:
 - a. Instantaneous trip.
 - b. Long- and short-time pickup levels.
 - c. Long- and short-time time adjustments.
 - d. Ground-fault pickup level, time delay, and I^2t response.
 4. Current-Limiting Circuit Breakers: Frame sizes 400 A and smaller; let-through ratings less than NEMA FU 1, RK-5.

5. Integrally Fused Circuit Breakers: Thermal-magnetic trip element with integral limiter-style fuse listed for use with circuit breaker; trip activation on fuse opening or on opening of fuse compartment door.
 6. GFCI Circuit Breakers: Single- and two-pole configurations with Class A ground-fault protection (6-mA trip).
 7. Ground-Fault Equipment Protection (GFEP) Circuit Breakers: Class B ground-fault protection (30-mA trip).
 8. Molded-Case Circuit-Breaker (MCCB) Features and Accessories:
 - a. Standard frame sizes, trip ratings, and number of poles.
 - b. Lugs: Compression style, suitable for number, size, trip ratings, and conductor material.
 - c. Application Listing: Appropriate for application; Type SWD for switching fluorescent lighting loads; Type HID for feeding fluorescent and high-intensity discharge (HID) lighting circuits.
 - d. Ground-Fault Protection: Integrally mounted relay and trip unit with adjustable pickup and time-delay settings, push-to-test feature, and ground-fault indicator.
 - e. Zone-Selective Interlocking: Integral with electronic trip unit; for interlocking ground-fault protection function.
 - f. Communication Capability: Din-rail-mounted communication module with functions and features compatible with power monitoring and control system specified in Division 26 Section "Electrical Power Monitoring and Control."
 - g. Shunt Trip: 120-V trip coil energized from separate circuit, set to trip at 75 percent of rated voltage.
 - h. Undervoltage Trip: Set to operate at 35 to 75 percent of rated voltage without intentional time delay.
 - i. Auxiliary Contacts: Two SPDT switches with "a" and "b" contacts; "a" contacts mimic circuit-breaker contacts, "b" contacts operate in reverse of circuit-breaker contacts.
 - j. Key Interlock Kit: Externally mounted to prohibit circuit-breaker operation; key shall be removable only when circuit breaker is in off position.
- B. Insulated-Case Circuit Breaker (ICCB): 100 percent rated, sealed, insulated-case power circuit breaker with interrupting capacity rating to meet available fault current.
1. Fixed circuit-breaker mounting.
 2. Two-step, stored-energy closing.
 3. Standard-function, microprocessor-based trip units with interchangeable rating plug, trip indicators, and the following field-adjustable settings:
 - a. Instantaneous trip.
 - b. Long- and short-time time adjustments.
 - c. Ground-fault pickup level, time delay, and I^2t response.
 4. Zone-Selective Interlocking: Integral with electronic trip unit; for interlocking ground-fault protection function.
 5. Remote trip indication and control.
 6. Communication Capability: Integral communication module with functions and features compatible with power monitoring and control system specified in Division 26 Section "Electrical Power Monitoring and Control."

7. Key Interlock Kit: Externally mounted to prohibit circuit-breaker operation; key shall be removable only when circuit breaker is in off position.
 8. Control Voltage: 120-V ac. Retain one of first two paragraphs below.
- C. Breakers 600A or larger shall be a solid state trip type.

2.3 INSTRUMENTATION

- A. Instrument Transformers: IEEE C57.13, NEMA EI 21.1, and the following:
1. Potential Transformers: IEEE C57.13; 120 V, 60 Hz, tapped secondary; disconnecting type with integral fuse mountings. Burden and accuracy shall be consistent with connected metering and relay devices.
 2. Current Transformers: IEEE C57.13; 5 A, 60 Hz, secondary; wound type; double secondary winding and secondary shorting device. Burden and accuracy shall be consistent with connected metering and relay devices.
 3. Control-Power Transformers: Dry type, mounted in separate compartments for units larger than 3 kVA.
 4. Current Transformers for Neutral and Ground-Fault Current Sensing: Connect secondary wiring to ground overcurrent relays, via shorting terminals, to provide selective tripping of main and tie circuit breaker. Coordinate with feeder circuit-breaker, ground-fault protection.
- B. Multifunction Digital-Metering Monitor: Microprocessor-based unit suitable for three- or four-wire systems and with the following features:
1. Switch-selectable digital display of the following values with maximum accuracy tolerances as indicated: All values to be in true RMS.
 - a. Phase Currents, Each Phase: Plus or minus 1 percent.
 - b. Phase-to-Phase Voltages, Three Phase: Plus or minus 1 percent.
 - c. Phase-to-Neutral Voltages, Three Phase: Plus or minus 1 percent.
 - d. Megawatts: Plus or minus 2 percent.
 - e. Megavars: Plus or minus 2 percent.
 - f. Power Factor: Plus or minus 2 percent.
 - g. Frequency: Plus or minus 0.5 percent.
 - h. Accumulated Energy, Megawatt Hours: Plus or minus 2 percent; accumulated values unaffected by power outages up to 72 hours.
 - i. Megawatt Demand: Plus or minus 2 percent; demand interval programmable from five to 60 minutes.
 - j. Phase current Demand.
 - k. VA Demand.
 - l. VAR demand
 - m. Contact devices to operate remote impulse-totalizing demand meter.
 - n. 4 output relays and 4 isolated analog outputs that can replace transducers
 - o. The Power Meter shall have built-in data communications to allow Multi-point communication to multiple computer workstations, programmable controllers, and

other host devices, at a minimum data rate of 9600 baud. The Power Meter shall be able to communicate with the Owners Tridium Niagara Software through the Network Area Controller, NAC, Panel for building management and/or other monitoring functions. The Power Meter shall be compatible with Modbus RTU Communications.

- p. The Power Meter shall be able to perform Harmonic Analysis with trigger trace memory, waveform capture, event recorder and data logger.

- 2. Mounting: Display and control unit flush or semiflush mounted in instrument compartment door.

2.4 CONTROL POWER

- A. Control Circuits: 120-V ac, supplied through secondary disconnecting devices from control-power transformer.
- B. Not Used.
- C. Not Used.
- D. Not Used.
- E. Control-Power Fuses: Primary and secondary fuses for current-limiting and overload protection of transformer and fuses for protection of control circuits.
- F. Control Wiring: Factory installed, with bundling, lacing, and protection included. Provide flexible conductors for No. 8 AWG and smaller, for conductors across hinges, and for conductors for interconnections between shipping units.

2.5 ACCESSORY COMPONENTS AND FEATURES

- A. Accessory Set: Include tools and miscellaneous items required for overcurrent protective device test, inspection, maintenance, and operation.
- B. Not Used.
- C. Not Used.
- D. Not Used.
- E. Not Used.

2.6 IDENTIFICATION

- A. Mimic Bus: Entire single-line switchboard bus work, as depicted on factory record drawing, on a photoengraved nameplate.

1. Nameplate: At least 0.032-inch- thick anodized aluminum, located at eye level on front cover of the switchboard incoming service section.
- B. Coordinate mimic-bus segments with devices in switchboard sections to which they are applied. Produce a concise visual presentation of principal switchboard components and connections.
- C. Presentation Media: Painted graphics in color contrasting with background color to represent bus and components, complete with lettered designations.
- D. Service Equipment Label: NRTL labeled for use as service equipment for switchboards with one or more service disconnecting and overcurrent protective devices.
- E. Upon completion of installation, and prior to final inspection, the contractor shall reduce in size the "as-built" single line diagram (riser), frame diagram under glass, and mount in a conspicuous place adjacent to the switchboard.

PART 3 - EXECUTION

3.1 EXAMINATION

- A. Receive, inspect, handle, and store switchboards according to NEMA PB 2.1.
- B. Examine switchboards before installation. Reject switchboards that are moisture damaged or physically damaged.
- C. Examine elements and surfaces to receive switchboards for compliance with installation tolerances and other conditions affecting performance of the Work.
- D. Proceed with installation only after unsatisfactory conditions have been corrected.

3.2 INSTALLATION

- A. Install switchboards and accessories according to NEMA PB 2.1.
- B. Equipment Mounting: Install switchboards on concrete base, 4-inch nominal thickness. Comply with requirements for concrete base specified in Division 03 Section " Miscellaneous Cast-in-Place Concrete."
 1. Install dowel rods to connect concrete base to concrete floor. Unless otherwise indicated, install dowel rods on 18-inch centers around the full perimeter of concrete base.
 2. For supported equipment, install epoxy-coated anchor bolts that extend through concrete base and anchor into structural concrete floor.
 3. Place and secure anchorage devices. Use setting drawings, templates, diagrams, instructions, and directions furnished with items to be embedded.
 4. Install anchor bolts to elevations required for proper attachment to switchboards.

- C. Temporary Lifting Provisions: Remove temporary lifting eyes, channels, and brackets and temporary blocking of moving parts from switchboard units and components.
- D. Comply with mounting and anchoring requirements specified in Division 26 Section "Vibration and Seismic Controls for Electrical Systems."
- E. Operating Instructions: Frame and mount the printed basic operating instructions for switchboards, including control and key interlocking sequences and emergency procedures. Fabricate frame of finished wood or metal and cover instructions with clear acrylic plastic. Mount on front of switchboards.
- F. Install filler plates in unused spaces of panel-mounted sections.
- G. Install overcurrent protective devices, transient voltage suppression devices, and instrumentation.
 - 1. Set field-adjustable switches and circuit-breaker trip ranges.
- H. Install spare-fuse cabinet.
- I. Comply with NECA 1.

3.3 CONNECTIONS

- A. Comply with requirements for terminating feeder bus specified in Division 26 Section "Enclosed Bus Assemblies." Drawings indicate general arrangement of bus, fittings, and specialties.
- B. Comply with requirements for terminating cable trays specified in Division 26 Section "Cable Trays for Electrical Systems." Drawings indicate general arrangement of cable trays, fittings, and specialties.

3.4 IDENTIFICATION

- A. Identify field-installed conductors, interconnecting wiring, and components; provide warning signs complying with requirements for identification specified in Division 26 Section "Identification for Electrical Systems."
- B. Switchboard Nameplates: Label each switchboard compartment with a nameplate complying with requirements for identification specified in Division 26 Section "Identification for Electrical Systems."
- C. Device Nameplates: Label each disconnecting and overcurrent protective device and each meter and control device mounted in compartment doors with a nameplate complying with requirements for identification specified in Division 26 Section "Identification for Electrical Systems."
- D. Switchboards identified for use as service equipment shall be so labeled.

3.5 FIELD QUALITY CONTROL

- A. Testing Agency: Engage a qualified testing agency to perform tests and inspections as required by the equipment manufacturer to ensure all warranties are valid.
- B. Manufacturer's Field Service: Engage a factory-authorized service representative to inspect, test, and adjust components, assemblies, and equipment installations, including connections.
- C. Perform tests and inspections.
 - 1. Manufacturer's Field Service: Engage a factory-authorized service representative to inspect components, assemblies, and equipment installations, including connections, and to assist in testing.
- D. Acceptance Testing Preparation:
 - 1. Test insulation resistance for each switchboard bus, component, connecting supply, feeder, and control circuit.
 - 2. Test continuity of each circuit.
- E. Tests and Inspections:
 - 1. Not used.
 - 2. Correct malfunctioning units on-site, where possible, and retest to demonstrate compliance; otherwise, replace with new units and retest.
 - 3. Perform the following infrared scan tests and inspections and prepare reports:
 - a. Initial Infrared Scanning: After ~~Substantial Completion~~ **Final Acceptance**, but not more than 60 days after Final Acceptance, perform an infrared scan of each switchboard. Remove front and rear panels so joints and connections are accessible to portable scanner.
 - b. Follow-up Infrared Scanning: Perform an additional follow-up infrared scan of each switchboard 11 months after date of ~~Substantial Completion~~ **Final Acceptance**.
 - c. Instruments and Equipment:
 - 1) Use an infrared scanning device designed to measure temperature or to detect significant deviations from normal values. Provide calibration record for device.
 - 4. Test and adjust controls, remote monitoring, and safeties. Replace damaged and malfunctioning controls and equipment.
 - 5. The following tests shall be performed on the service circuit breakers and the distribution circuit breakers. Testing shall be performed by a qualified factory technician at the job site. All readings shall be tabulated:
 - a. Phase tripping tolerance (within 20% of U/L requirements)
 - b. Trip time (per phase) in seconds.
 - c. Instantaneous trip (amps) per phase.

- d. Insulation resistance (in megohms) at 100 volts (phase to phase, and line to load).
- 6. The ground fault protection on the new circuit breakers (if provided) shall be performance tested in the field and properly calibrated and set in accordance with the coordination study.
- F. Switchboard will be considered defective if it does not pass tests and inspections.
- G. Prepare test and inspection reports, including a certified report that identifies switchboards included and that describes scanning results. Include notation of deficiencies detected, remedial action taken, and observations after remedial action. All tests shall be completely documented indicating time of day, date, temperature and all pertinent test information. All required documentation of readings indicated above shall be submitted to the engineer prior to, and as one of the prerequisites for final acceptance of the project.

3.6 ADJUSTING

- A. Adjust moving parts and operable components to function smoothly, and lubricate as recommended by manufacturer.
- B. Set field-adjustable circuit-breaker trip ranges as indicated.

3.7 PROTECTION

- A. Temporary Heating: Apply temporary heat, to maintain temperature according to manufacturer's written instructions, until switchboard is ready to be energized and placed into service.

3.8 DEMONSTRATION

- A. Engage a factory-authorized service representative to train Owner's maintenance personnel to adjust, operate, and maintain switchboards, overcurrent protective devices, instrumentation, and accessories, and to use and reprogram microprocessor-based trip, monitoring, and communication units.

3.9 SHORT CIRCUIT STUDY:

- a. A complete short circuit and protection coordination study with coordination plots for each medium and low voltage distribution system shall be provided. The studies shall include the power company's system and relay characteristics, the base quantities selected, impedance source data, calculation methods and tabulations, one line diagrams, impedance diagrams, conclusions and recommendations. A ground fault study shall be provided for the low voltage system, which shall include the associated zero sequence impedance diagrams. Short circuit momentary duties, when applicable, and interrupting duties shall be calculated on the basis of an assumed fault at each medium voltage switchgear line-up, low voltage switchgear line-up, switchboard, distribution panelboard, pertinent

branch circuit panelboard, generator and other significant locations throughout the systems. The short circuit tabulations shall include the fault impedances, X to R ratios, asymmetry factors, KVA symmetrical and asymmetrical fault currents. **This study is to be prepared and sealed by a professional engineer licensed in North Carolina.**

- b. The coordination plots required shall graphically indicate the coordination proposed for the several systems centered on full scale log forms. The coordination plots shall include complete titles, representative one line diagrams and legends, associated power company's relay or system characteristics, medium voltage fuses and relays, significant equipment starting characteristics, complete parameters for transformers, complete operating bands for low voltage switchgear or switchboard circuit breaker trip devices, and the associated system load protective devices. The coordination plots shall define the types of protective devices selected, together with the proposed coil taps, time dial settings and pick up settings required. The long time region of the coordination plots shall indicate a complete tap scale for each medium voltage relay, full load current and 150, 400 or 600 percent full load current transformer parameters and designate the pick ups required for the low voltage circuit breakers. The short time region shall indicate the medium voltage relay instantaneous elements, the magnetizing inrush, ANSI withstand thermal and mechanical transformer parameters, fuse manufacturing tolerance bands, and significant symmetrical and asymmetrical fault currents. Each primary protective device required for a delta-grounded wye connected transformer shall be selected so the characteristic or operating band is within the transformer parameters, and shall include a parameter equivalent to 58 percent of the ANSI withstand point to afford protection for secondary line to ground faults. The transformer damage curve shall be included for each transformer. Low voltage power circuit breakers shall provide long time, long time delay, short time, short time delay, ground fault, ground fault delay, and I^2t in/out settings with coordination plots and shall be separated from each other and the associated primary protective device by a 16 percent current margin for coordination and protection in the event of secondary line to line or line to ground fault. Medium voltage relays shall be separated by a 0.4 second time margin when the maximum three phase fault flows, to assure proper selectivity. The protective device characteristics or operating band shall reflect the actual symmetrical and asymmetrical fault currents sensed by the device.
- c. The contractor shall note that the drawings and specifications indicate the general requirements for the equipment, the medium voltage and low voltage equipment, but additional specific characteristics of equipment furnished shall be determined in accordance with the results of the short circuit and protection coordination study. The equipment design discrepancies and the proposed corrective modifications, if required, shall be submitted with the short circuit and protection coordination study with any variations clearly noted on the subsequent shop drawings. Necessary field settings, adjustments and minor modifications for conformance with the approved short circuit and protection coordination study shall be accomplished by the particular manufacturer or by the Contractor without additional expense to the Owner. However, should equipment specified be outside the parameters required by this study, a change order to modify the equipment shall be issued if the engineer's review warrants such a change. Equipment shop drawings shall not be submitted until the short circuit and protection coordination study has been reviewed by the Owner's engineer.

- d. Arc-Flash labels shall be printed per OSHA requirements and shall be installed by the contractor.

PART 3: EXECUTION

POINT SETTINGS:

- a. The Electrical Contractor shall set and calibrate all target points and settings indicated on the approved coordination study prior to energizing and testing the system.
- b. The study shall require the Electrical Contractor to provide the following information:
 1. Length, type, resistance, reactance of all cables both medium and low voltages.
 2. Fuse curves as required.
 3. Utility information.

END OF SECTION 262413

2012 APPENDIX B BUILDING CODE SUMMARY FOR ALL COMMERCIAL PROJECTS - STATE CONSTRUCTION OFFICE/SHOPS BUILDING

Name of Project: UNC Charlotte Facilities Operations/ Parking Services Complex
Address: 9201 University City Blvd., Charlotte, NC Zip Code 28223
Proposed Use: Business and shop space

LEAD DESIGN PROFESSIONAL: DESIGNER FIRM NAME LICENSE# TELEPHONE# E-MAIL
LSP3 Associates, LTD. William Scott Baker 8326 704.333.6686 scottbaker@lsp3.com

2012 EDITION OF NC CODE FOR: New Construction Addition Upfit
EXISTING: Reconstruction Alteration Repair Renovation

CONSTRUCTED: (date) ORIGINAL USE(S) (Ch. 3)
RENOVATED: (date) CURRENT USE(S) (Ch. 3) PROPOSED USE(S) (Ch. 3)

OFFICE/SHOPS BUILDING
Construction Type: I-A I-B I-IA I-IB I-III-A I-III-B I-IV I-V-A I-V-B
Sprinklers: No Partial Yes NFPA 13 NFPA 13R NFPA 13D

Gross Building Area: FLOOR EXISTING (SQ FT) NEW (SQ FT) SUB-TOTAL
1st Floor 38,578#
TOTAL 38,578#

Occupancy: ALLOWABLE AREA
Assembly A-1 A-2 A-3 A-4 A-5
Business B
Educational E

Accessory Occupancies: Assembly A-1 A-2 A-3 A-4 A-5
Business B
Educational E
Factory F-1 Moderate F-2 Low

Incidental Uses (Table 508.2.5):
Furnace room where any piece of equipment is over 400,000 Btu per hour input
Rooms with boilers where the largest piece of equipment is over 15 psi and 10 horsepower

Special Uses: 402 403 404 405 406 407 408 409 410 411 412
413 414 415 416 417 418 419 420 421 422 423 424
425 426 427

Special Provisions: 509.2 509.3 509.4 509.5 509.6 509.7 509.8 509.9
Mixed Occupancy: No Yes Separation: Other Exception: 508.3.3
Incidental Use Separation (508.2.5)

ALLOWABLE HEIGHT
ALLOWABLE (TABLE 503) INCREASE FOR SPRINKLERS SHOWN ON PLANS CODE REFERENCE

SPECIAL APPROVALS
Special approval: (Local Jurisdiction, Department of Insurance, OSC, DPI, DHHS, ICC, etc., describe below)

ALLOWABLE HEIGHT
ALLOWABLE (TABLE 503) INCREASE FOR SPRINKLERS SHOWN ON PLANS CODE REFERENCE

SPECIAL APPROVALS
Special approval: (Local Jurisdiction, Department of Insurance, OSC, DPI, DHHS, ICC, etc., describe below)

2012 APPENDIX B BUILDING CODE SUMMARY FOR ALL COMMERCIAL PROJECTS - STATE CONSTRUCTION OFFICE/SHOPS BUILDING

ENERGY REQUIREMENTS: The following data shall be considered minimum and any special attribute required to meet the energy code shall also be provided.
Climate Zone: 3 4 5
Method of Compliance: Prescriptive (Energy Code) Performance (ASHRAE 90.1) Performance (ASHRAE 90.1)

LIFE SAFETY SYSTEM REQUIREMENTS
Emergency Lighting: No Yes
Exit Signs: No Yes

LIFE SAFETY PLAN REQUIREMENTS
Life Safety Plan Sheet #: G-005 - G-007
Fire and/or smoke rated wall locations (Chapter 7)

ACCESSIBLE DWELLING UNITS (SECTION 1107)
TOTAL UNITS ACCESSIBLE UNITS TYPE A UNITS TYPE B UNITS TOTAL ACCESSIBLE UNITS

ACCESSIBLE PARKING (SECTION 1106)
LOT OR PARKING AREA TOTAL # OF PARKING SPACES # OF ACCESSIBLE SPACES PROVIDED TOTAL # ACCESSIBLE SPACES PROVIDED

STRUCTURAL DESIGN
Importance Factors: Wind (w) 1.0 Snow (s) 1.0 Seismic (e) 1.0

SEISMIC DESIGN CATEGORY: A B C D
Provide the following Seismic Design Parameters: Occupancy Category Table 1604.5 D1

PLUMBING FIXTURE REQUIREMENTS (TABLE 2902.1)
USE WATERCLOSETS URINALS LAVATORIES SHOWERS/ TUBS DRINKING FOUNTAINS





2012 APPENDIX B BUILDING CODE SUMMARY FOR ALL COMMERCIAL PROJECTS - STATE CONSTRUCTION OFFICE/SHOPS BUILDING

Name of Project: UNC Charlotte Facilities Operations/ Parking Services Complex
Address: 9201 University City Blvd., Charlotte, NC Zip Code 28223
Proposed Use: Warehouse storage and business

LEAD DESIGN PROFESSIONAL: DESIGNER FIRM NAME LICENSE# TELEPHONE# E-MAIL
LSP3 Associates, LTD. William Scott Baker 8326 704.333.6686 scottbaker@lsp3.com

2012 EDITION OF NC CODE FOR: New Construction Addition Upfit
EXISTING: Reconstruction Alteration Repair Renovation

CONSTRUCTED: (date) ORIGINAL USE(S) (Ch. 3)
RENOVATED: (date) CURRENT USE(S) (Ch. 3) PROPOSED USE(S) (Ch. 3)

WAREHOUSE BUILDING
Construction Type: I-A I-B I-IA I-IB I-III-A I-III-B I-IV I-V-A I-V-B
Sprinklers: No Partial Yes NFPA 13 NFPA 13R NFPA 13D

Gross Building Area: FLOOR EXISTING (SQ FT) NEW (SQ FT) SUB-TOTAL
1st Floor 22,465#
TOTAL 22,465#

Occupancy: ALLOWABLE AREA
Assembly A-1 A-2 A-3 A-4 A-5
Business B
Educational E

Accessory Occupancies: Assembly A-1 A-2 A-3 A-4 A-5
Business B
Educational E
Factory F-1 Moderate F-2 Low

ACCESSIBLE DWELLING UNITS (SECTION 1107)
TOTAL UNITS ACCESSIBLE UNITS TYPE A UNITS TYPE B UNITS TOTAL ACCESSIBLE UNITS

ACCESSIBLE PARKING (SECTION 1106)
LOT OR PARKING AREA TOTAL # OF PARKING SPACES # OF ACCESSIBLE SPACES PROVIDED TOTAL # ACCESSIBLE SPACES PROVIDED

STRUCTURAL DESIGN
Importance Factors: Wind (w) 1.0 Snow (s) 1.0 Seismic (e) 1.0

PLUMBING FIXTURE REQUIREMENTS (TABLE 2902.1)
USE WATERCLOSETS URINALS LAVATORIES SHOWERS/ TUBS DRINKING FOUNTAINS

ALLOWABLE HEIGHT
ALLOWABLE (TABLE 503) INCREASE FOR SPRINKLERS SHOWN ON PLANS CODE REFERENCE

SPECIAL APPROVALS
Special approval: (Local Jurisdiction, Department of Insurance, OSC, DPI, DHHS, ICC, etc., describe below)








































227 WEST TRADE STREET SUITE 700
CHARLOTTE, NORTH CAROLINA 28202
TEL. 704.333.6686 FAX 704.333.2926
WWW.LSP3.COM

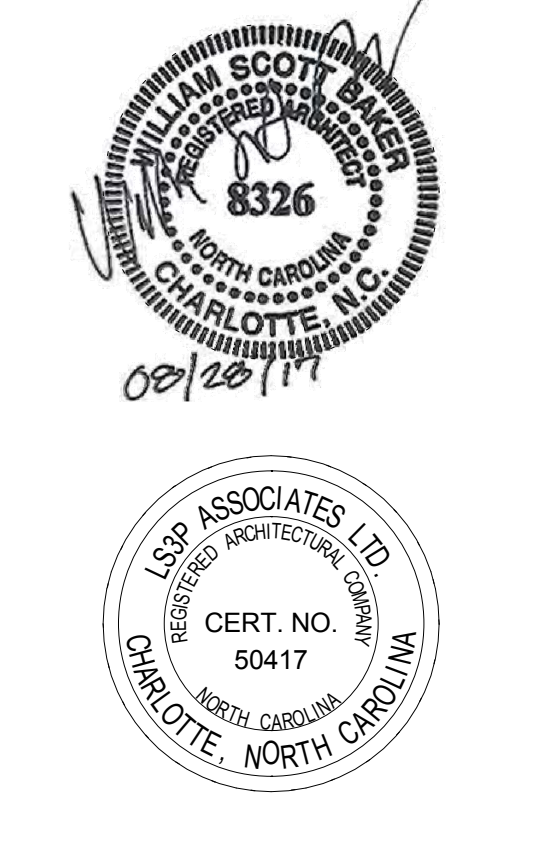

MEMBERS OF THE AMERICAN INSTITUTE OF ARCHITECTS
COPYRIGHT 2017 ALL RIGHTS RESERVED
PRINTED OR ELECTRONIC DRAWINGS AND DOCUMENTATION MAY NOT BE REPRODUCED IN ANY FORM WITHOUT WRITTEN PERMISSION FROM LSP3 ASSOCIATES LTD.

REVISIONS: No. Description Date
1 Addendum No. 4 08/28/2017

PROJECT: 9202-164730
SCO ID: 16-15656-02B
ITEM: 315 CODE: 4126
DATE: AUGUST 21, 2017
DRAWN BY: KH
CHECKED BY: SF

NC BUILDING CODE SUMMARY
OFFICE/SHOPS & WAREHOUSE

G-001

2012 APPENDIX B BUILDING CODE SUMMARY FOR ALL COMMERCIAL PROJECTS - STATE CONSTRUCTION WASH RACK

Name of Project: UNC Charlotte Facilities Operations/ Parking Services Complex
 Address: 9201 University City Blvd., Charlotte, NC Zip Code 28223
 Proposed Use: Permanent Canopy to Wash Buses/Trucks
 Owner or Authorized Agent: Brian Kugler Phone #: 704.687.0522 E-Mail: bhkugler@unc.edu
 Code Enforcement Jurisdiction: City County State

LEAD DESIGN PROFESSIONAL:

DESIGNER	FIRM	NAME	LICENSE#	TELEPHONE#	E-MAIL
Architectural	LSP Associates, LTD.	William Scott Baker	8326	704.333.6686	scottbaker@lsp.com
Civil	LandDesign	Alison Merriman	33804	704.376.7777	merriman@landdesign.com
Electrical	Optima Engineering	Brandon Miller	028297	704.338.1292	brmill@optimapa.com
Fire Alarm	Optima Engineering	Brandon Miller	028297	704.338.1292	brmill@optimapa.com
Plumbing	Optima Engineering	George Fowler	026023	704.338.1292	gfowler@optimapa.com
Mechanical	Optima Engineering	Ronald Almond	17228	704.338.1292	ralmond@optimapa.com
Sprinkler	Optima Engineering	George Fowler	026023	704.338.1292	gfowler@optimapa.com
Standpipe	Optima Engineering	George Fowler	026023	704.338.1292	gfowler@optimapa.com
Structural	SKA Consulting Engineers	Charles Cardwell	15765	704.424.9663	CCardwell@skaeang.com
Retaining Walls >5 High	SKA Consulting Engineers	Charles Cardwell	15765	704.424.9663	CCardwell@skaeang.com
Other	LandDesign	Alison Merriman	0797	704.376.7777	AMerriman@landdesign.com

2012 EDITION OF NC CODE FOR: New Construction Addition Upfit
 Reconstruction Alteration Repair Renovation
EXISTING: (date) ORIGINAL USE(S) (Ch. 3):
RENOVATED: (date) CURRENT USE(S) (Ch. 3):
PROPOSED USE(S) (Ch. 3):

BASIC BUILDING DATA

Gas Storage Building
 Construction Type: I-A I-B I-III I-IV I-V
 I-B I-III I-III-B I-V-B
Sprinklers: No Partial Yes NFPA 13 NFPA 13R NFPA 13D
Standpipes: No Yes Class: I II III Wet Dry
Fire District: No Yes (Primary) **Flood Hazard Area:** No Yes
Building Height: (feet, 19'-0")
Gross Building Area:
 FLOOR EXISTING (SQ FT) NEW (SQ FT) SUB-TOTAL
 1st Floor 2,232sf 2,232sf
 TOTAL 2,232sf

ALLOWABLE AREA

Occupancy:
 Assembly A-1 A-2 A-3 A-4 A-5
 Business
 Educational
 Factory F-1 Moderate F-2 Low
 Hazardous H-1 Detonate H-2 Deflagrate H-3 Combust H-4 Health H-5 HPM
 Institutional I-1 I-2 I-3 I-4
 I-3 Condition: 1 2 3 4 5
 Mercantile
 Residential R-1 R-2 R-3 R-4
 Storage S-1 Moderate S-2 Low High-Piled
 Parking Garage Open Enclosed Repair Garage
 Utility and Miscellaneous

Accessory Occupancies:
 Assembly A-1 A-2 A-3 A-4 A-5
 Business
 Educational
 Factory F-1 Moderate F-2 Low
 Hazardous H-1 Detonate H-2 Deflagrate H-3 Combust H-4 Health H-5 HPM
 Institutional I-1 I-2 I-3 I-4
 I-3 Condition: 1 2 3 4 5
 Mercantile
 Residential R-1 R-2 R-3 R-4
 Storage S-1 Moderate S-2 Low High-Piled
 Parking Garage Open Enclosed Repair Garage
 Utility and Miscellaneous

Incidental Uses (Table 508.2.5):
 Furnace room where any piece of equipment is over 400,000 Btu per hour input
 Rooms with boilers where the largest piece of equipment is over 15 psi and 10 horsepower
 Refrigerant machine room
 Hydrogen cutoff rooms, not classified as Group H
 Incinerator rooms
 Paint shops, not classified as Group H, located in occupancies other than Group F
 Laboratories and vocational shops, not classified as Group H, located in a Group E or I-2 occupancy
 Laundry rooms over 100 square feet
 Group I-3 cells equipped with padded surfaces
 Stationary storage battery systems having a liquid electrolyte capacity of more than 50 gallons, or a lithium-ion capacity of 1,000 pounds used for facility standby power, emergency power or uninterrupted power supplies
 Rooms containing fire pumps
 Group I-2 storage rooms over 100 square feet
 Group I-2 commercial kitchens
 Group I-2 laundries equal to or less than 100 square feet
 Group I-2 rooms or spaces that contain fuel-fired heating equipment

Special Uses: 402 403 404 405 406 407 408 409 410 411 412 413 414 415 416 417 418 419 420 421 422 423 424 425 426 427

Special Provisions: 509.2 509.3 509.4 509.5 509.6 509.7 509.8 509.9

Mixed Occupancy: No Yes Separation: _____ Exception: _____
 Incidental Use Separation (508.2.5)
 This separation is not exempt as a Non-Separated Use (see exceptions).
 Non-Separated Use (508.3)
 The required type of construction for the building shall be determined by applying the height and area limitations for each of the applicable occupancies to the entire building. The most restrictive type of construction, so determined, shall apply to the entire building.
 Separated Use (508.4) - See below for area calculations
 For each story, the area of the occupancy shall be such that the sum of the ratios of the actual floor area of each use divided by the allowable floor area for each use shall not exceed 1.

$$\frac{\text{Actual Area of Occupancy A}}{\text{Allowable Area of Occupancy A}} + \frac{\text{Actual Area of Occupancy B}}{\text{Allowable Area of Occupancy B}} + \dots \leq 1.00$$

STORY NO	DESCRIPTION AND USE	(A) BLDG AREA PER STORY (ACTUAL)	(B) TABLE 508.2.5 AREA	(C) AREA FOR OPEN SPACE INCREASE ¹	(D) AREA FOR SPRINKLER INCREASE ²	(E) ALLOWABLE AREA OR UNLIMITED ³	(F) MAXIMUM BUILDING AREA ⁴
1ST FLOOR	U CANOPY	2,232sf	8,500sf				8,500sf

1 Frontage area increases from Section 506.2 are computed thus:
 a. Perimeter which fronts a public way or open space having 20 feet minimum width, (F).
 b. Total Building Perimeter = (P).
 c. Ratio (F/P) = ____ (F/P).
 d. W = Minimum width of public way = ____ (W).
 e. Percent of frontage increase $I = 100(F/P - 0.25) \times W/30$ ____ (%).
2 The sprinkler increase per Section 506.3 is as follows:
 a. Multi-story building $I_s = 200$ percent
 b. Single story building $I_s = 300$ percent
3 Unlimited area applicable under conditions of Sections 507.
4 Maximum Building Area = total number of stories in the building x E (506.4).
5 The maximum area of open parking garages must comply with Table 406.3.5. The maximum area of air traffic control towers must comply with Table 412.1.2.

ALLOWABLE HEIGHT

ALLOWABLE (TABLE 503)	INCREASE FOR SPRINKLERS	SHOWN ON PLANS	CODE REFERENCE
Type of Construction	Type IIB	Type IIB	Table 601
Building Height in Feet	55' N/A	19'-2"	Table 503
Building Height in Stories	2 N/A	1 story	Table 503

FIRE PROTECTION REQUIREMENTS

BUILDING ELEMENT	FIRE SEPARATION DISTANCE (FEET)	RATING Req'd (W)	RATING Provided (W)	DETAIL # AND SHEET #	DESIGN # FOR ASSEMBLY	DESIGN # FOR RATED PENETRATION	DESIGN # FOR RATED JOINTS
Structural frame, including columns, girders, trusses*	10-x-30	0	0				
Bearing walls							
Exterior walls							
North	10-x-30	0	0				
East	10-x-30	0	0				
West	10-x-30	0	0				
South	10-x-30	0	0				
Interior walls							
Nonbearing walls and partitions							
Exterior walls							
North							
East							
West							
South							
Interior walls and partitions							
Floor Construction							
Including supporting beams and joists							
Roof construction							
Including supporting beams and joists							

* Indicate section number permitting reduction
 ** Alternate 23

2012 APPENDIX B BUILDING CODE SUMMARY FOR ALL COMMERCIAL PROJECTS - STATE CONSTRUCTION COVERED STORAGE

Name of Project: UNC Charlotte Facilities Operations/ Parking Services Complex
 Address: 9201 University City Blvd., Charlotte, NC Zip Code 28223
 Proposed Use: Permanent Canopy
 Owner or Authorized Agent: Brian Kugler Phone #: 704.687.0522 E-Mail: bhkugler@unc.edu
 Code Enforcement Jurisdiction: City County State

LEAD DESIGN PROFESSIONAL:

DESIGNER	FIRM	NAME	LICENSE#	TELEPHONE#	E-MAIL
Architectural	LSP Associates, LTD.	William Scott Baker	8326	704.333.6686	scottbaker@lsp.com
Civil	LandDesign	Alison Merriman	33804	704.376.7777	merriman@landdesign.com
Electrical	Optima Engineering	Brandon Miller	028297	704.338.1292	brmill@optimapa.com
Fire Alarm	Optima Engineering	Brandon Miller	028297	704.338.1292	brmill@optimapa.com
Plumbing	Optima Engineering	George Fowler	026023	704.338.1292	gfowler@optimapa.com
Mechanical	Optima Engineering	Ronald Almond	17228	704.338.1292	ralmond@optimapa.com
Sprinkler	Optima Engineering	George Fowler	026023	704.338.1292	gfowler@optimapa.com
Standpipe	Optima Engineering	George Fowler	026023	704.338.1292	gfowler@optimapa.com
Structural	SKA Consulting Engineers	Charles Cardwell	15765	704.424.9663	CCardwell@skaeang.com
Retaining Walls >5 High	SKA Consulting Engineers	Charles Cardwell	15765	704.424.9663	CCardwell@skaeang.com
Other	LandDesign	Alison Merriman	0797	704.376.7777	AMerriman@landdesign.com

2012 EDITION OF NC CODE FOR: New Construction Addition Upfit
 Reconstruction Alteration Repair Renovation
EXISTING: (date) ORIGINAL USE(S) (Ch. 3):
RENOVATED: (date) CURRENT USE(S) (Ch. 3):
PROPOSED USE(S) (Ch. 3):

BASIC BUILDING DATA

Gas Storage Building
 Construction Type: I-A I-B I-III I-IV I-V
 I-B I-III I-III-B I-V-B
Sprinklers: No Partial Yes NFPA 13 NFPA 13R NFPA 13D
Standpipes: No Yes Class: I II III Wet Dry
Fire District: No Yes (Primary) **Flood Hazard Area:** No Yes
Building Height: (feet, 19'-0")
Gross Building Area:
 FLOOR EXISTING (SQ FT) NEW (SQ FT) SUB-TOTAL
 1st Floor 2,232sf 2,232sf
 TOTAL 2,232sf

ALLOWABLE AREA

Occupancy:
 Assembly A-1 A-2 A-3 A-4 A-5
 Business
 Educational
 Factory F-1 Moderate F-2 Low
 Hazardous H-1 Detonate H-2 Deflagrate H-3 Combust H-4 Health H-5 HPM
 Institutional I-1 I-2 I-3 I-4
 I-3 Condition: 1 2 3 4 5
 Mercantile
 Residential R-1 R-2 R-3 R-4
 Storage S-1 Moderate S-2 Low High-Piled
 Parking Garage Open Enclosed Repair Garage
 Utility and Miscellaneous

Accessory Occupancies:
 Assembly A-1 A-2 A-3 A-4 A-5
 Business
 Educational
 Factory F-1 Moderate F-2 Low
 Hazardous H-1 Detonate H-2 Deflagrate H-3 Combust H-4 Health H-5 HPM
 Institutional I-1 I-2 I-3 I-4
 I-3 Condition: 1 2 3 4 5
 Mercantile
 Residential R-1 R-2 R-3 R-4
 Storage S-1 Moderate S-2 Low High-Piled
 Parking Garage Open Enclosed Repair Garage
 Utility and Miscellaneous

Incidental Uses (Table 508.2.5):
 Furnace room where any piece of equipment is over 400,000 Btu per hour input
 Rooms with boilers where the largest piece of equipment is over 15 psi and 10 horsepower
 Refrigerant machine room
 Hydrogen cutoff rooms, not classified as Group H
 Incinerator rooms
 Paint shops, not classified as Group H, located in occupancies other than Group F
 Laboratories and vocational shops, not classified as Group H, located in a Group E or I-2 occupancy
 Laundry rooms over 100 square feet
 Group I-3 cells equipped with padded surfaces
 Stationary storage battery systems having a liquid electrolyte capacity of more than 50 gallons, or a lithium-ion capacity of 1,000 pounds used for facility standby power, emergency power or uninterrupted power supplies
 Rooms containing fire pumps
 Group I-2 storage rooms over 100 square feet
 Group I-2 commercial kitchens
 Group I-2 laundries equal to or less than 100 square feet
 Group I-2 rooms or spaces that contain fuel-fired heating equipment

Special Uses: 402 403 404 405 406 407 408 409 410 411 412 413 414 415 416 417 418 419 420 421 422 423 424 425 426 427

Special Provisions: 509.2 509.3 509.4 509.5 509.6 509.7 509.8 509.9

Mixed Occupancy: No Yes Separation: _____ Exception: _____
 Incidental Use Separation (508.2.5)
 This separation is not exempt as a Non-Separated Use (see exceptions).
 Non-Separated Use (508.3)
 The required type of construction for the building shall be determined by applying the height and area limitations for each of the applicable occupancies to the entire building. The most restrictive type of construction, so determined, shall apply to the entire building.
 Separated Use (508.4) - See below for area calculations
 For each story, the area of the occupancy shall be such that the sum of the ratios of the actual floor area of each use divided by the allowable floor area for each use shall not exceed 1.

$$\frac{\text{Actual Area of Occupancy A}}{\text{Allowable Area of Occupancy A}} + \frac{\text{Actual Area of Occupancy B}}{\text{Allowable Area of Occupancy B}} + \dots \leq 1.00$$

STORY NO	DESCRIPTION AND USE	(A) BLDG AREA PER STORY (ACTUAL)	(B) TABLE 508.2.5 AREA	(C) AREA FOR OPEN SPACE INCREASE ¹	(D) AREA FOR SPRINKLER INCREASE ²	(E) ALLOWABLE AREA OR UNLIMITED ³	(F) MAXIMUM BUILDING AREA ⁴
1ST FLOOR	S-1 STORAGE	2,232sf	17,500sf				17,500sf

1 Frontage area increases from Section 506.2 are computed thus:
 a. Perimeter which fronts a public way or open space having 20 feet minimum width, (F).
 b. Total Building Perimeter = (P).
 c. Ratio (F/P) = ____ (F/P).
 d. W = Minimum width of public way = ____ (W).
 e. Percent of frontage increase $I = 100(F/P - 0.25) \times W/30$ ____ (%).
2 The sprinkler increase per Section 506.3 is as follows:
 a. Multi-story building $I_s = 200$ percent
 b. Single story building $I_s = 300$ percent
3 Unlimited area applicable under conditions of Sections 507.
4 Maximum Building Area = total number of stories in the building x E (506.4).
5 The maximum area of open parking garages must comply with Table 406.3.5. The maximum area of air traffic control towers must comply with Table 412.1.2.

ALLOWABLE HEIGHT

ALLOWABLE (TABLE 503)	INCREASE FOR SPRINKLERS	SHOWN ON PLANS	CODE REFERENCE
Type of Construction	Type IIB	Type IIB	Table 601
Building Height in Feet	55' N/A	19'-0"	Table 503
Building Height in Stories	2 N/A	1 story	Table 503

FIRE PROTECTION REQUIREMENTS

BUILDING ELEMENT	FIRE SEPARATION DISTANCE (FEET)	RATING Req'd (W)	RATING Provided (W)	DETAIL # AND SHEET #	DESIGN # FOR ASSEMBLY	DESIGN # FOR RATED PENETRATION	DESIGN # FOR RATED JOINTS
Structural frame, including columns, girders, trusses*	10-x-30	0	0				
Bearing walls							
Exterior walls							
North	10-x-30	0	0				
East	10-x-30	0	0				
West	10-x-30	0	0				
South	10-x-30	0	0				
Interior walls							
Nonbearing walls and partitions							
Exterior walls							
North							
East							
West							
South							
Interior walls and partitions							
Floor Construction							
Including supporting beams and joists							
Roof construction							
Including supporting beams and joists							

* Indicate section number permitting reduction

2012 APPENDIX B BUILDING CODE SUMMARY FOR ALL COMMERCIAL PROJECTS - STATE CONSTRUCTION GAS STORAGE BUILDING

Name of Project: UNC Charlotte Facilities Operations/ Parking Services Complex
 Address: 9201 University City Blvd., Charlotte, NC Zip Code 28223
 Proposed Use: Gas Storage
 Owner or Authorized Agent: Brian Kugler Phone #: 704.687.0522 E-Mail: bhkugler@unc.edu
 Code Enforcement Jurisdiction: City County State

LEAD DESIGN PROFESSIONAL:

DESIGNER	FIRM	NAME	LICENSE#	TELEPHONE#	E-MAIL
Architectural	LSP Associates, LTD.	William Scott Baker	8326	704.333.6686	scottbaker@lsp.com
Civil	LandDesign	Alison Merriman	33804	704.376.7777	merriman@landdesign.com
Electrical	Optima Engineering	Brandon Miller	028297	704.338.1292	brmill@optimapa.com
Fire Alarm	Optima Engineering	Brandon Miller	028297	704.338.1292	brmill@optimapa.com
Plumbing	Optima Engineering	George Fowler	026023	704.338.1292	gfowler@optimapa.com
Mechanical	Optima Engineering	Ronald Almond	17228	704.338.1292</	



MEMBERS OF THE AMERICAN INSTITUTE OF ARCHITECTS

COPYRIGHT 2017 ALL RIGHTS RESERVED
PRINTED OR ELECTRONIC DRAWINGS AND DOCUMENTATION MAY NOT BE REPRODUCED IN ANY FORM WITHOUT WRITTEN PERMISSION FROM LS3P ASSOCIATES LTD.

REVISIONS:

No.	Description	Date
1	Addendum No. 4	08/28/2017

PROJECT: 9202-164730
SCO ID: 16-15656-02B
ITEM: 315 CODE: 41526
DATE: AUGUST 21, 2017
DRAWN BY: KF
CHECKED BY: SH

LIFE SAFETY SITE PLAN

G-005


E

D

C

B



A

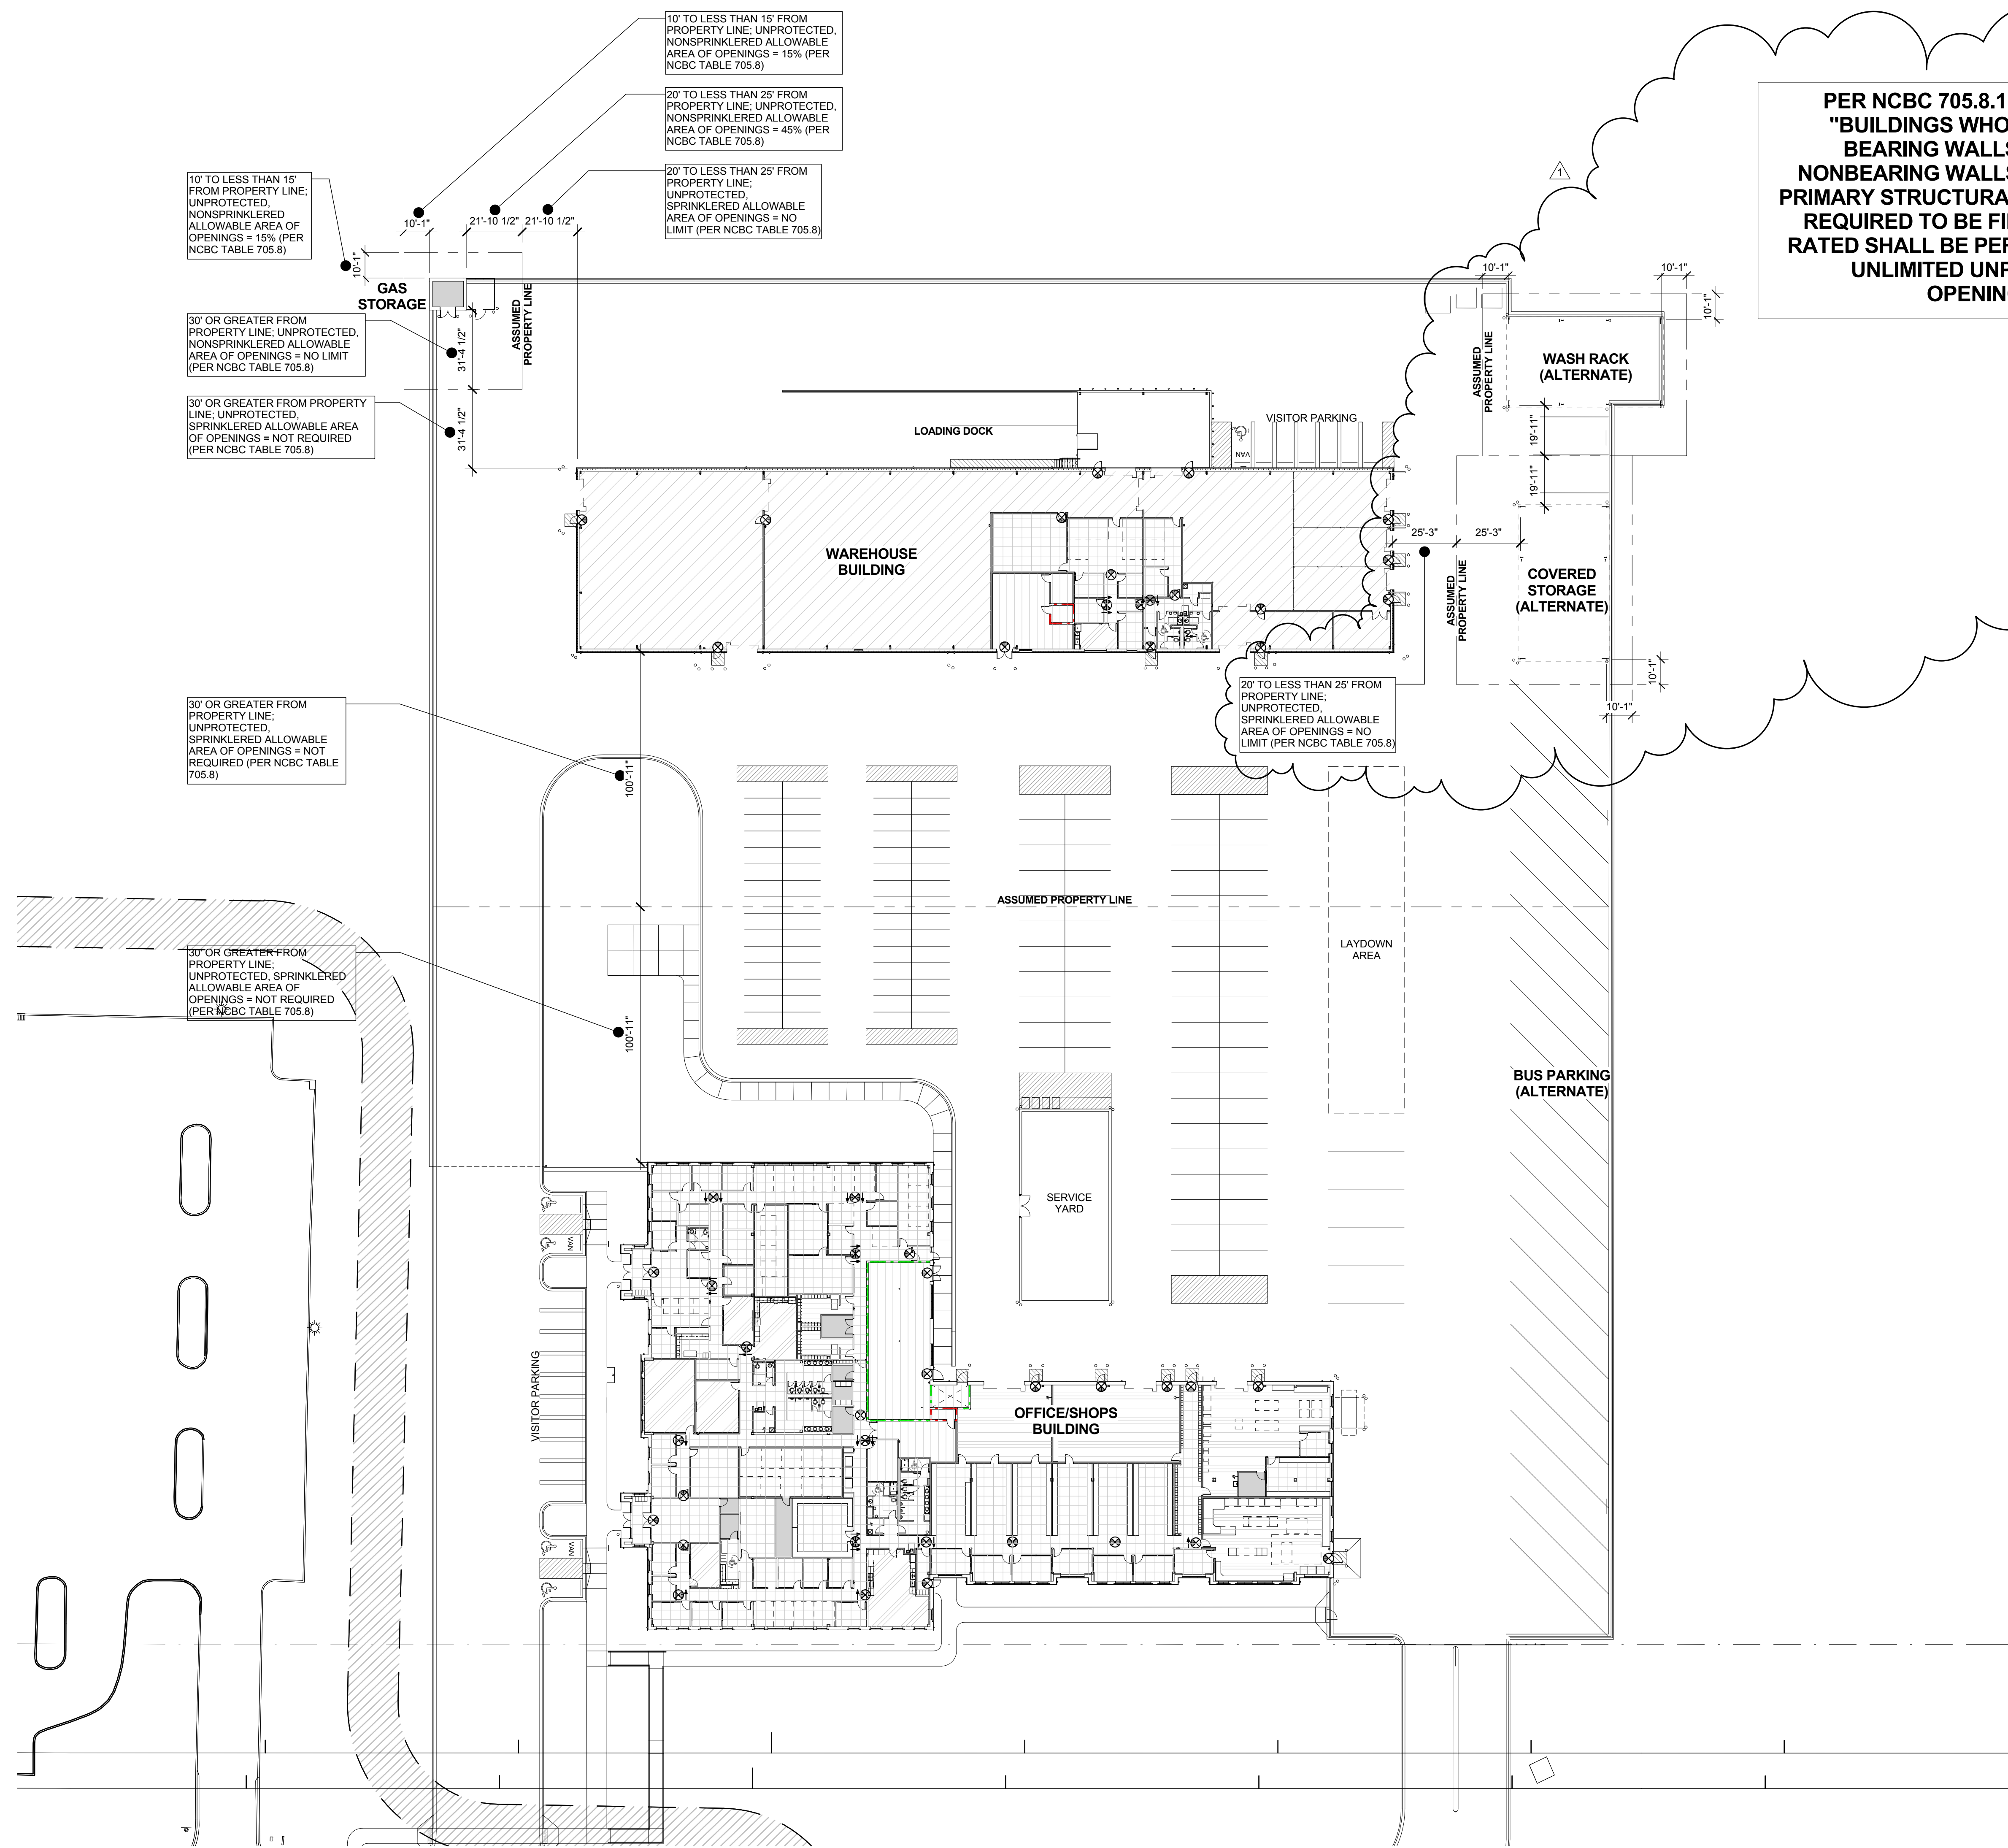

A2 LIFE SAFETY PLAN - SITE PLAN
1/32" = 1'-0"



C:\Users\sharonhuo\Documents\Acoi_UNCC Facilities Operations Complex_2016_sharonhuo.rvt
8/30/2017 8:04:55 AM

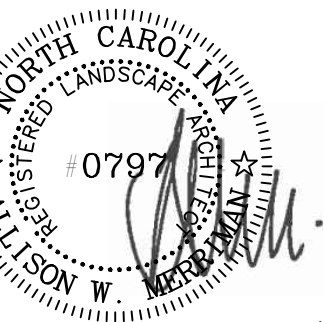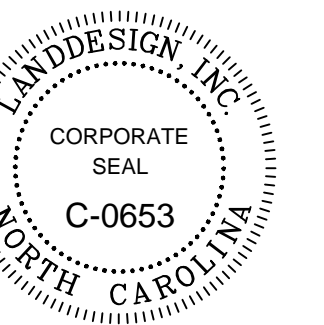

08/28/17

MEMBERS OF THE AMERICAN INSTITUTE OF ARCHITECTS

COPYRIGHT 2017 ALL RIGHTS RESERVED
PRINTED OR ELECTRONIC DRAWINGS AND DOCUMENTATION MAY NOT BE REPRODUCED IN ANY FORM WITHOUT WRITTEN PERMISSION FROM LS3P ASSOCIATES LTD.



REVISIONS:

No.	Description	Date
1	Addendum 4	8/28/2017


PROJECT: 9202-164730
SCO ID: 16-15656-02B
ITEM: 315 CODE: 41526
DATE: AUGUST 21, 2017
DRAWN BY: AEE
CHECKED BY: AWM

SITE DETAILS


C403

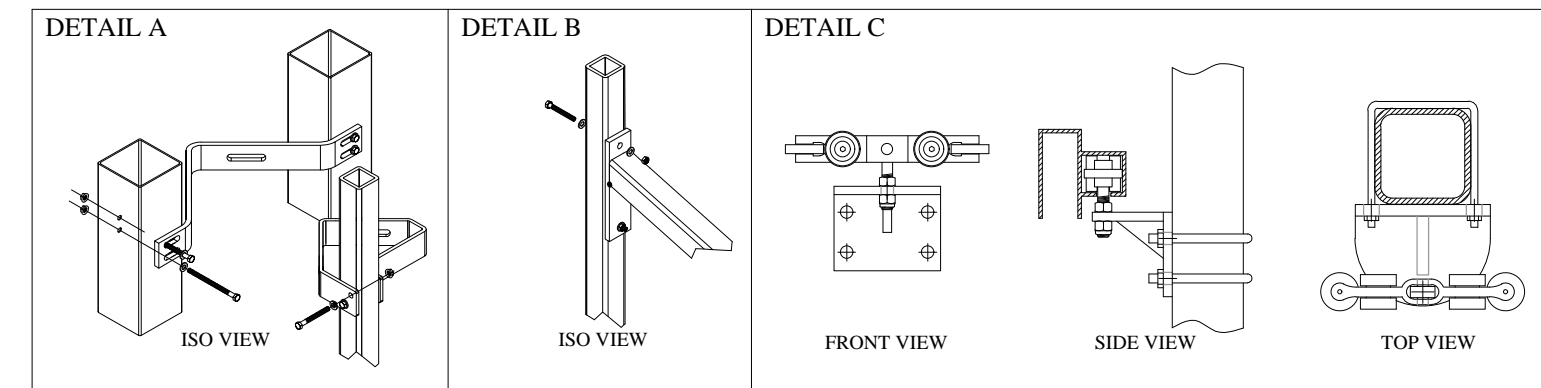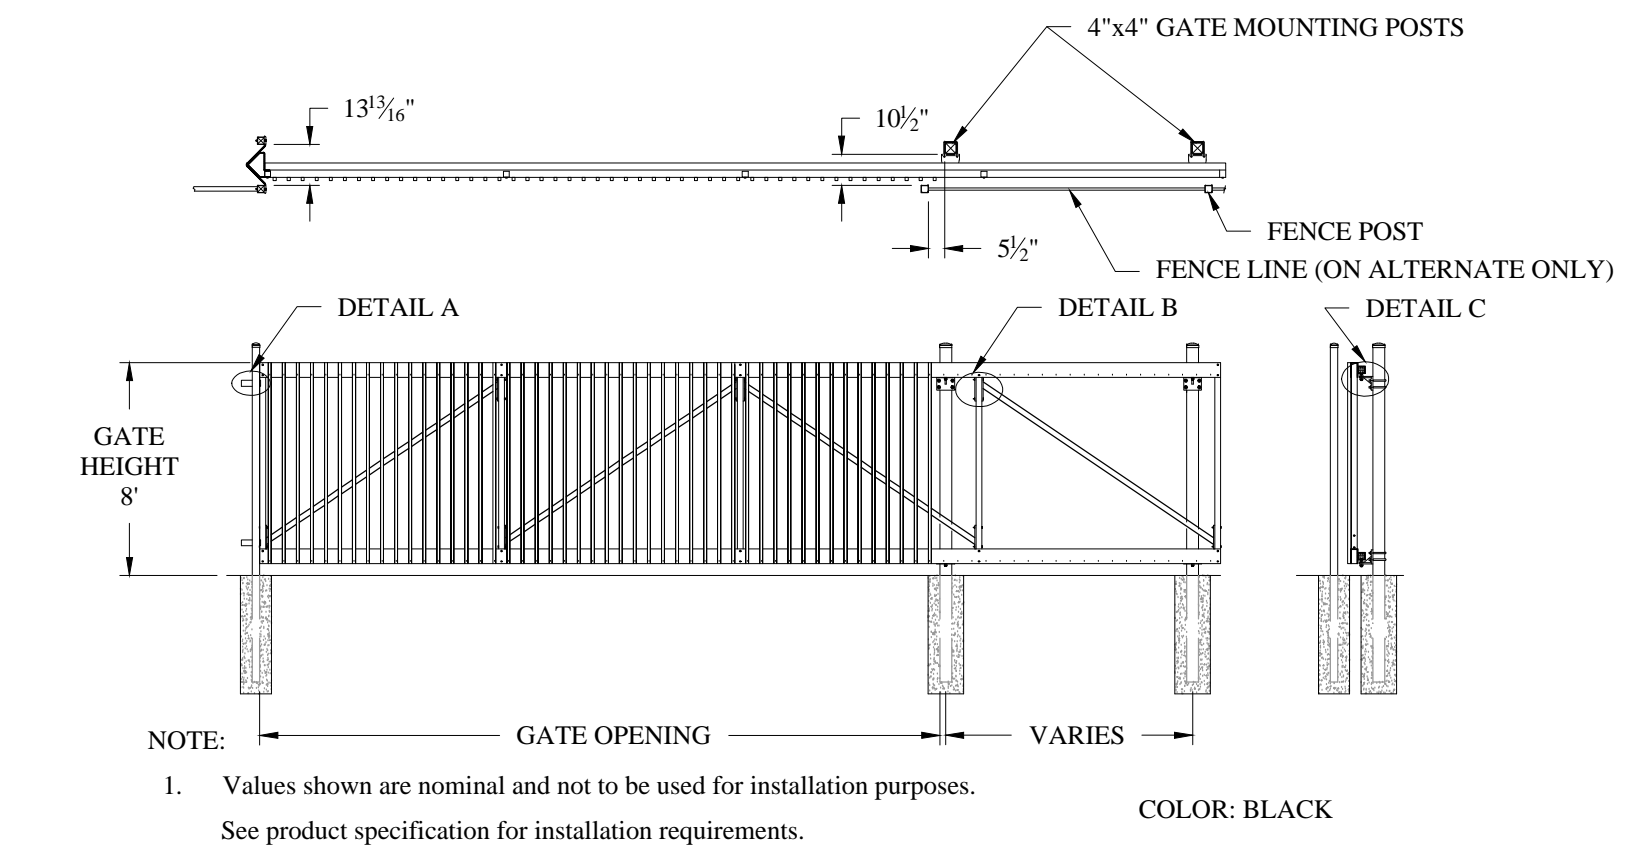


3 CANTILEVER GATE
ELEVATION & DETAILS SCALE: NTS

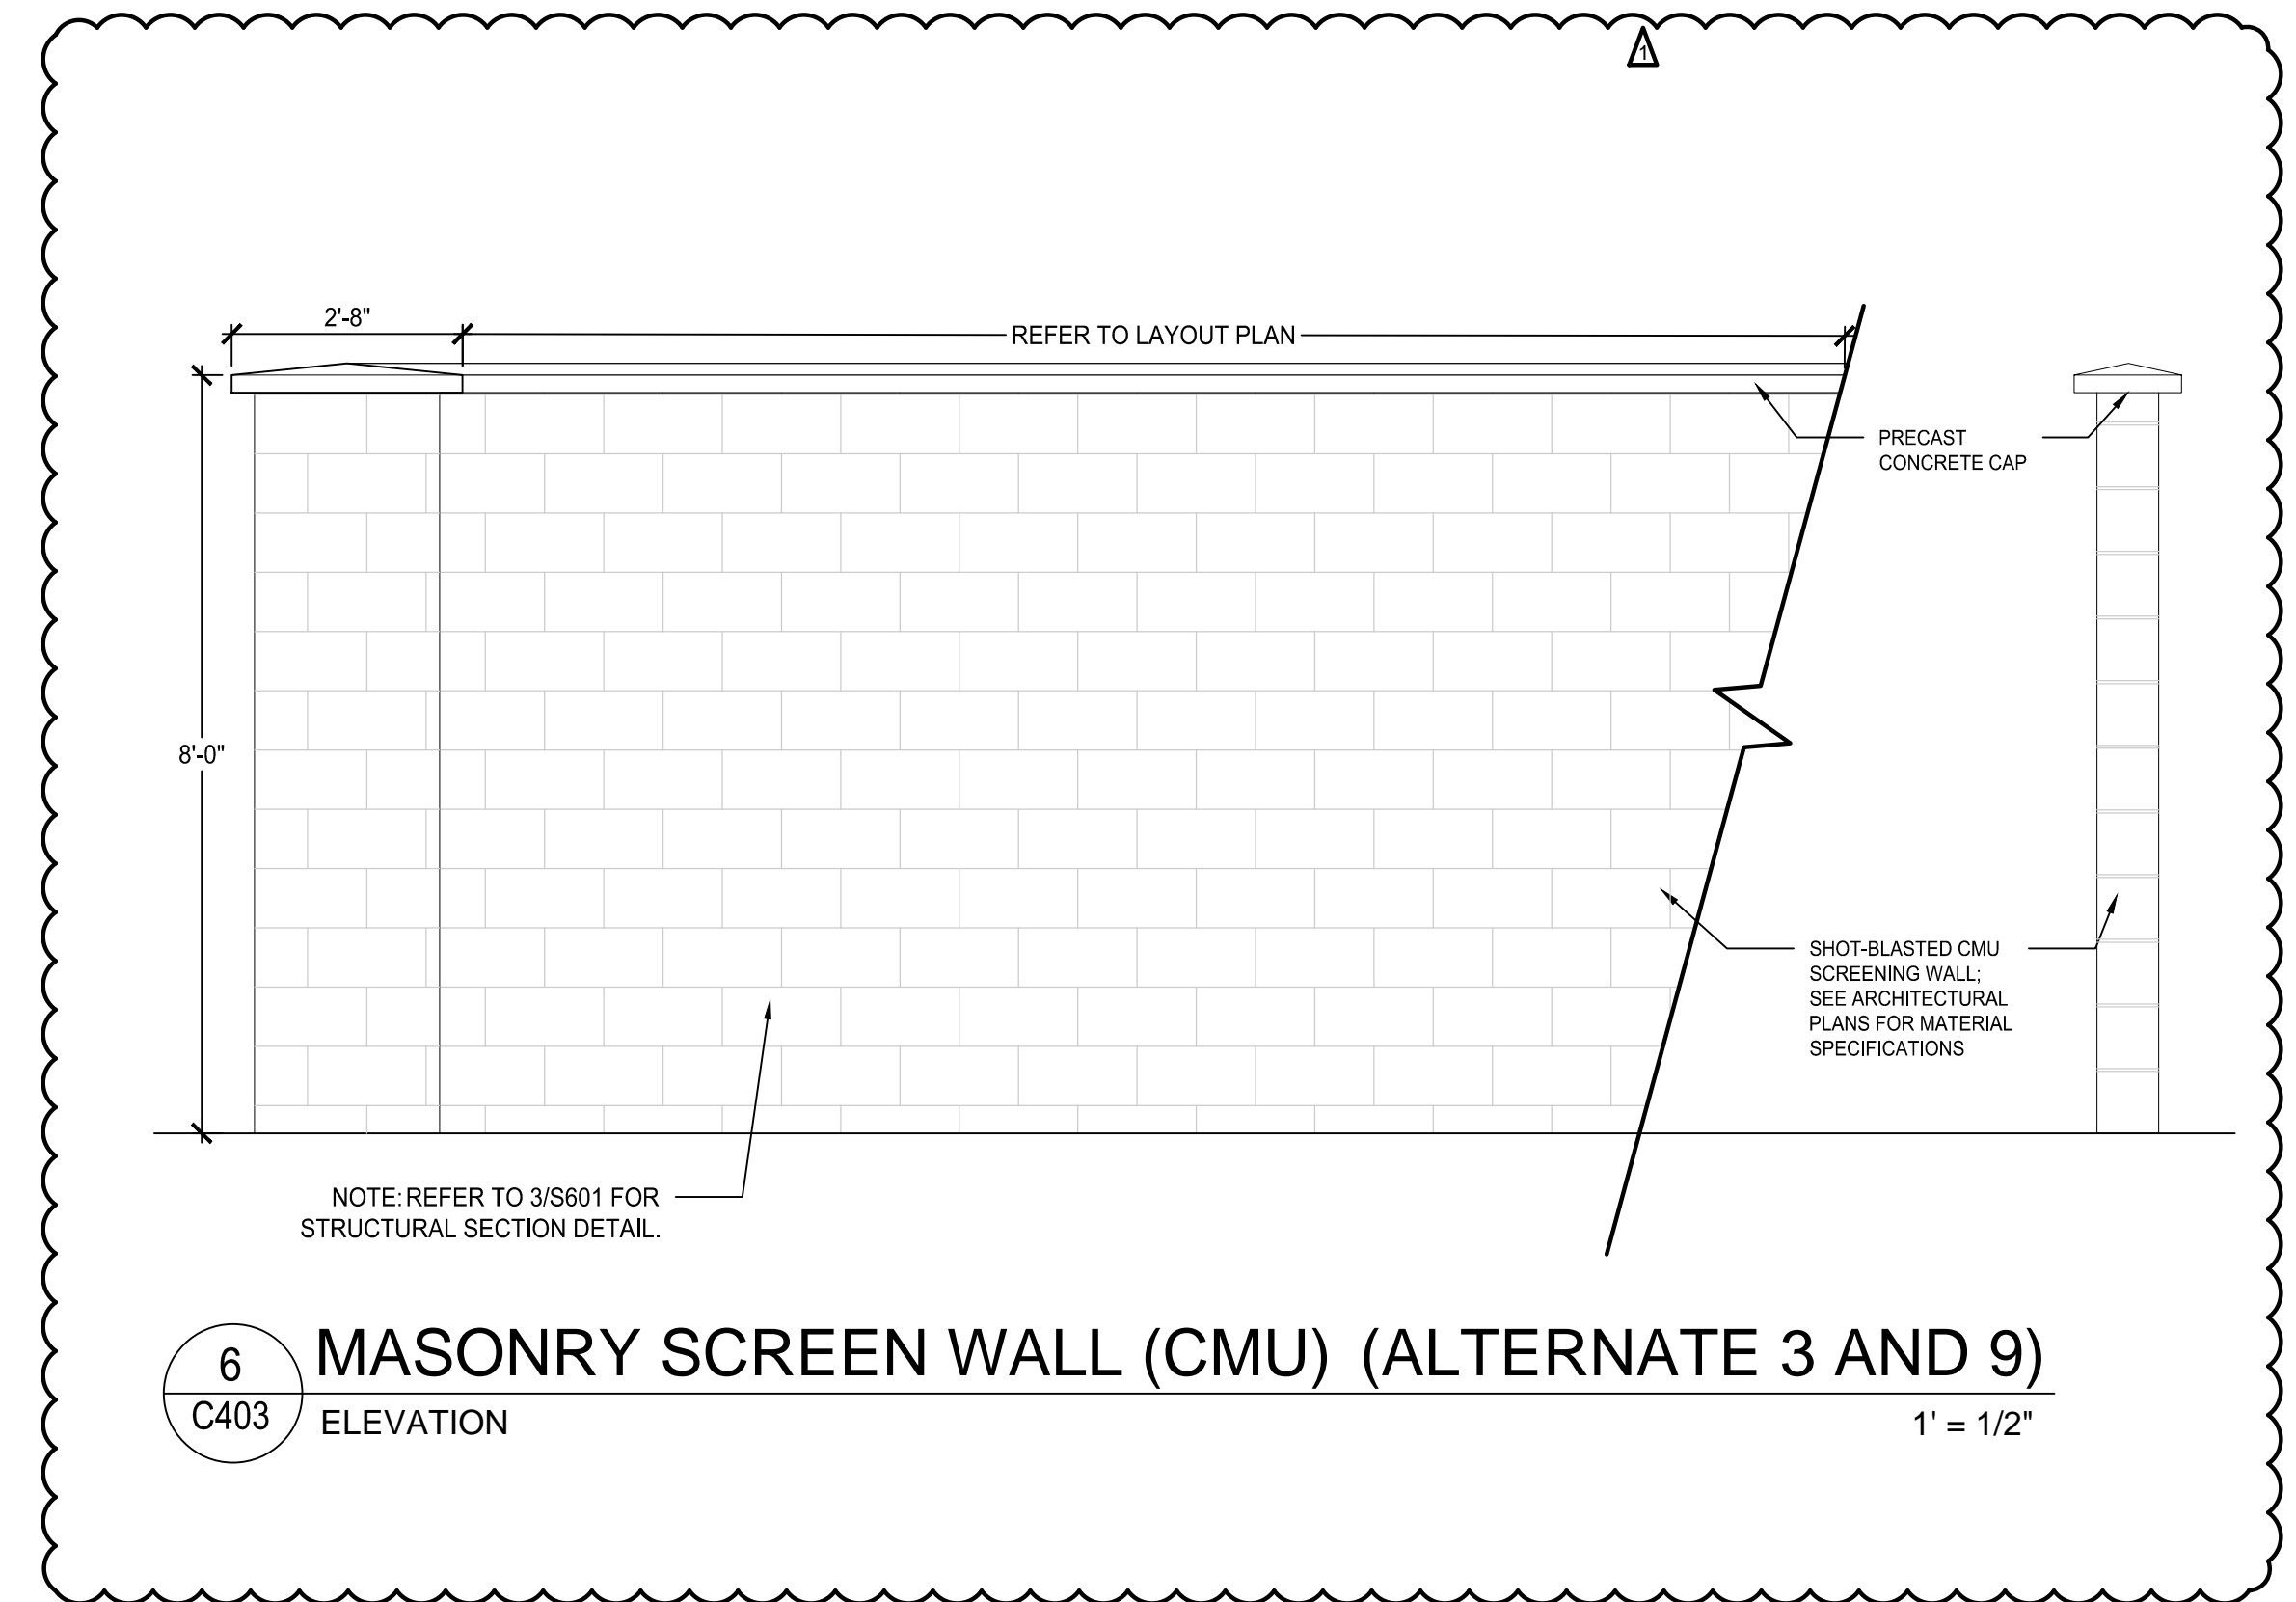


6 MASONRY SCREEN WALL (CMU) (ALTERNATE 3 AND 9)
ELEVATION SCALE: 1' = 1/2"

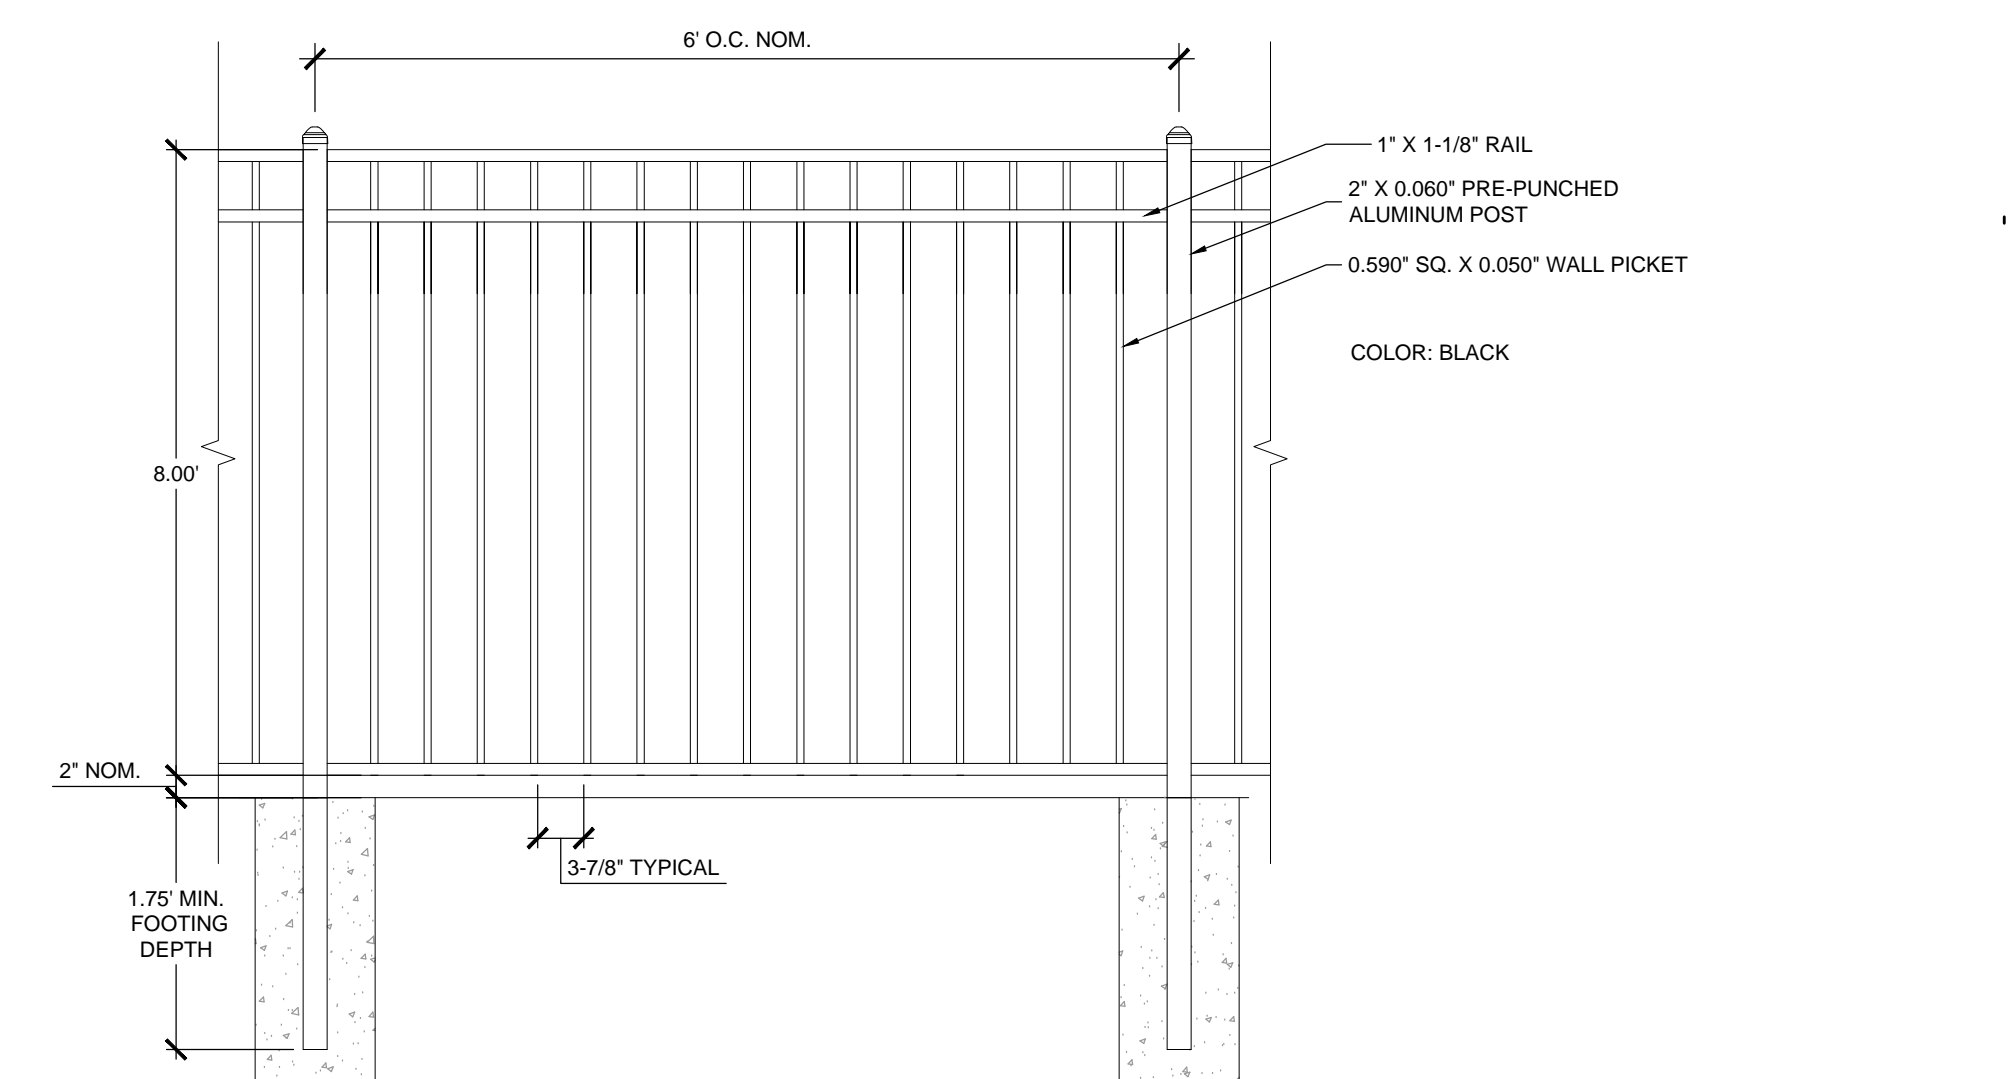

9 FENCE
ELEVATION NOT TO SCALE

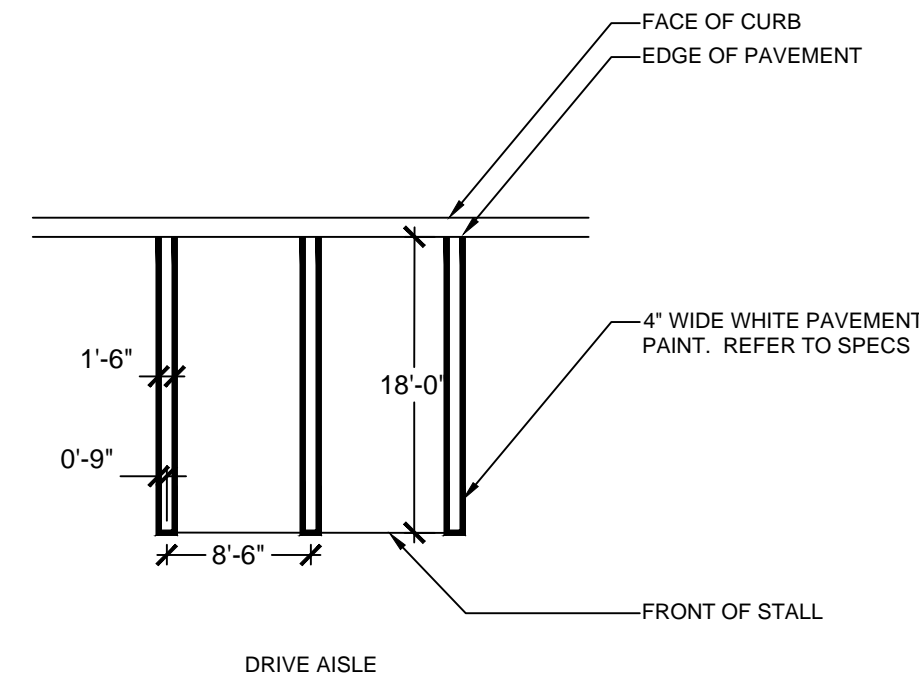


2 PARKING LOT PAVEMENT MARKING
SECTION SCALE: NTS

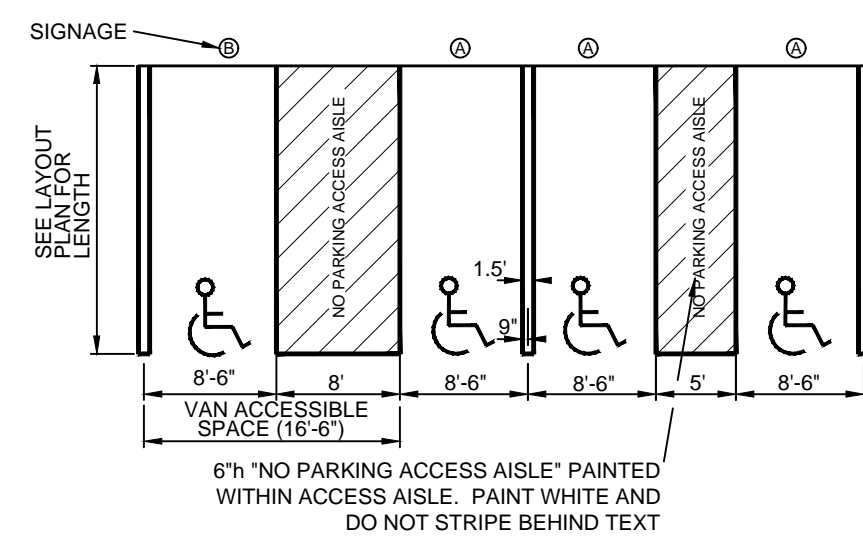


NOTES:
1. ALL ACCESSIBLE SIGNS SHALL BE MOUNTED AT 7 FEET FROM GRADE TO BOTTOM EDGE OF SIGN FACE. MOUNTING HEIGHT CAN BE REDUCED TO 5 FEET IF PLACED IN AN AREA BETWEEN SIDEWALK AND BUILDING FACE IN WHICH PEDESTRIANS ARE NOT EXPECTED TO USE.
2. PROVIDE UNIVERSITY STANDARD 2\"/>

KIT COMPONENTS:
(ALL PARTS PAINTED - BLACK GREEN MATTHEWS PAINT CO. MP21337 R91290 (SATIN FINISH AND SATIN CLEAR COAT))
1. 2 3/8\"/>

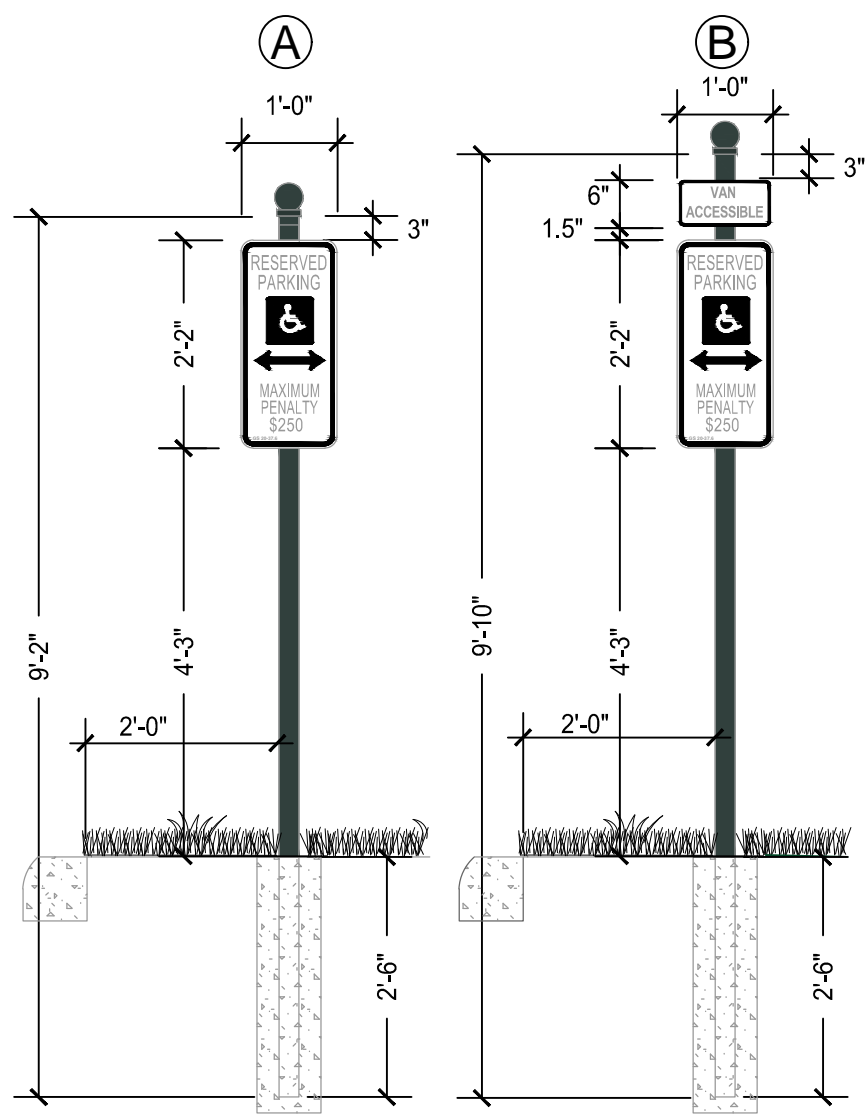

1 ACCESSIBLE PARKING AND SIGNAGE
NOT TO SCALE

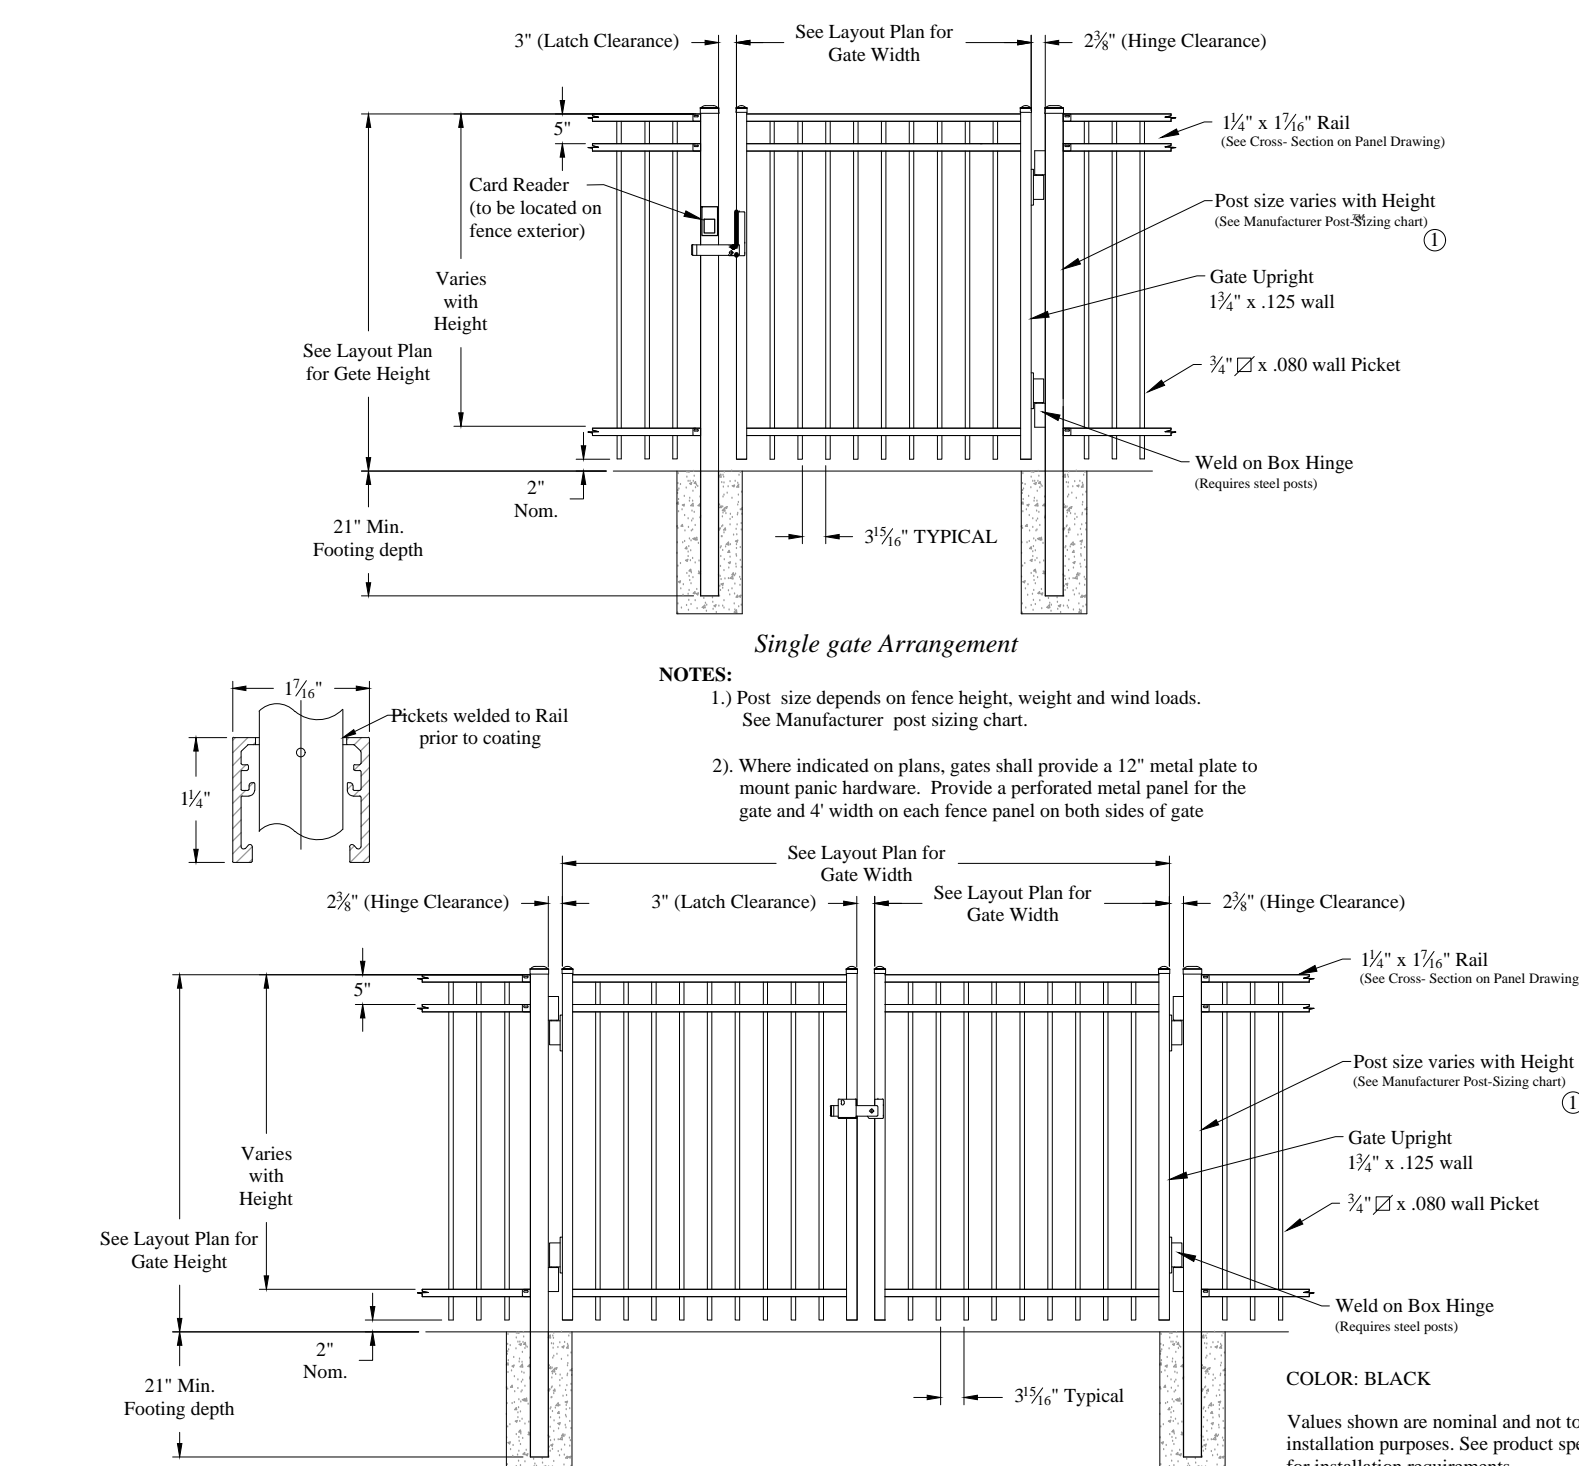

8 COMMERCIAL STRENGTH ALUMINUM GATES
ELEVATION NOT TO SCALE


E

D

C

B

A

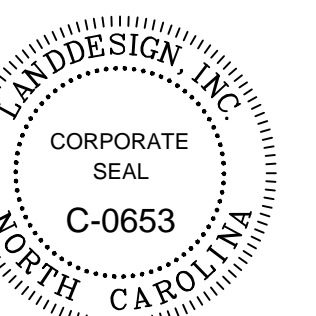

08/28/17

MEMBERS OF THE AMERICAN INSTITUTE OF ARCHITECTS

COPYRIGHT 2017 ALL RIGHTS RESERVED
PRINTED OR ELECTRONIC DRAWINGS AND DOCUMENTATION MAY NOT BE REPRODUCED IN ANY FORM WITHOUT WRITTEN PERMISSION FROM LS3P ASSOCIATES LTD.



REVISIONS:

No.	Description	Date
1	Addendum 4	8/28/2017

PROJECT: 9202-164730
SCO ID: 16-15656-02B
ITEM: 315 CODE: 41526
DATE: AUGUST 21, 2017
DRAWN BY: AEE
CHECKED BY: AWM



SITE DETAILS

C404

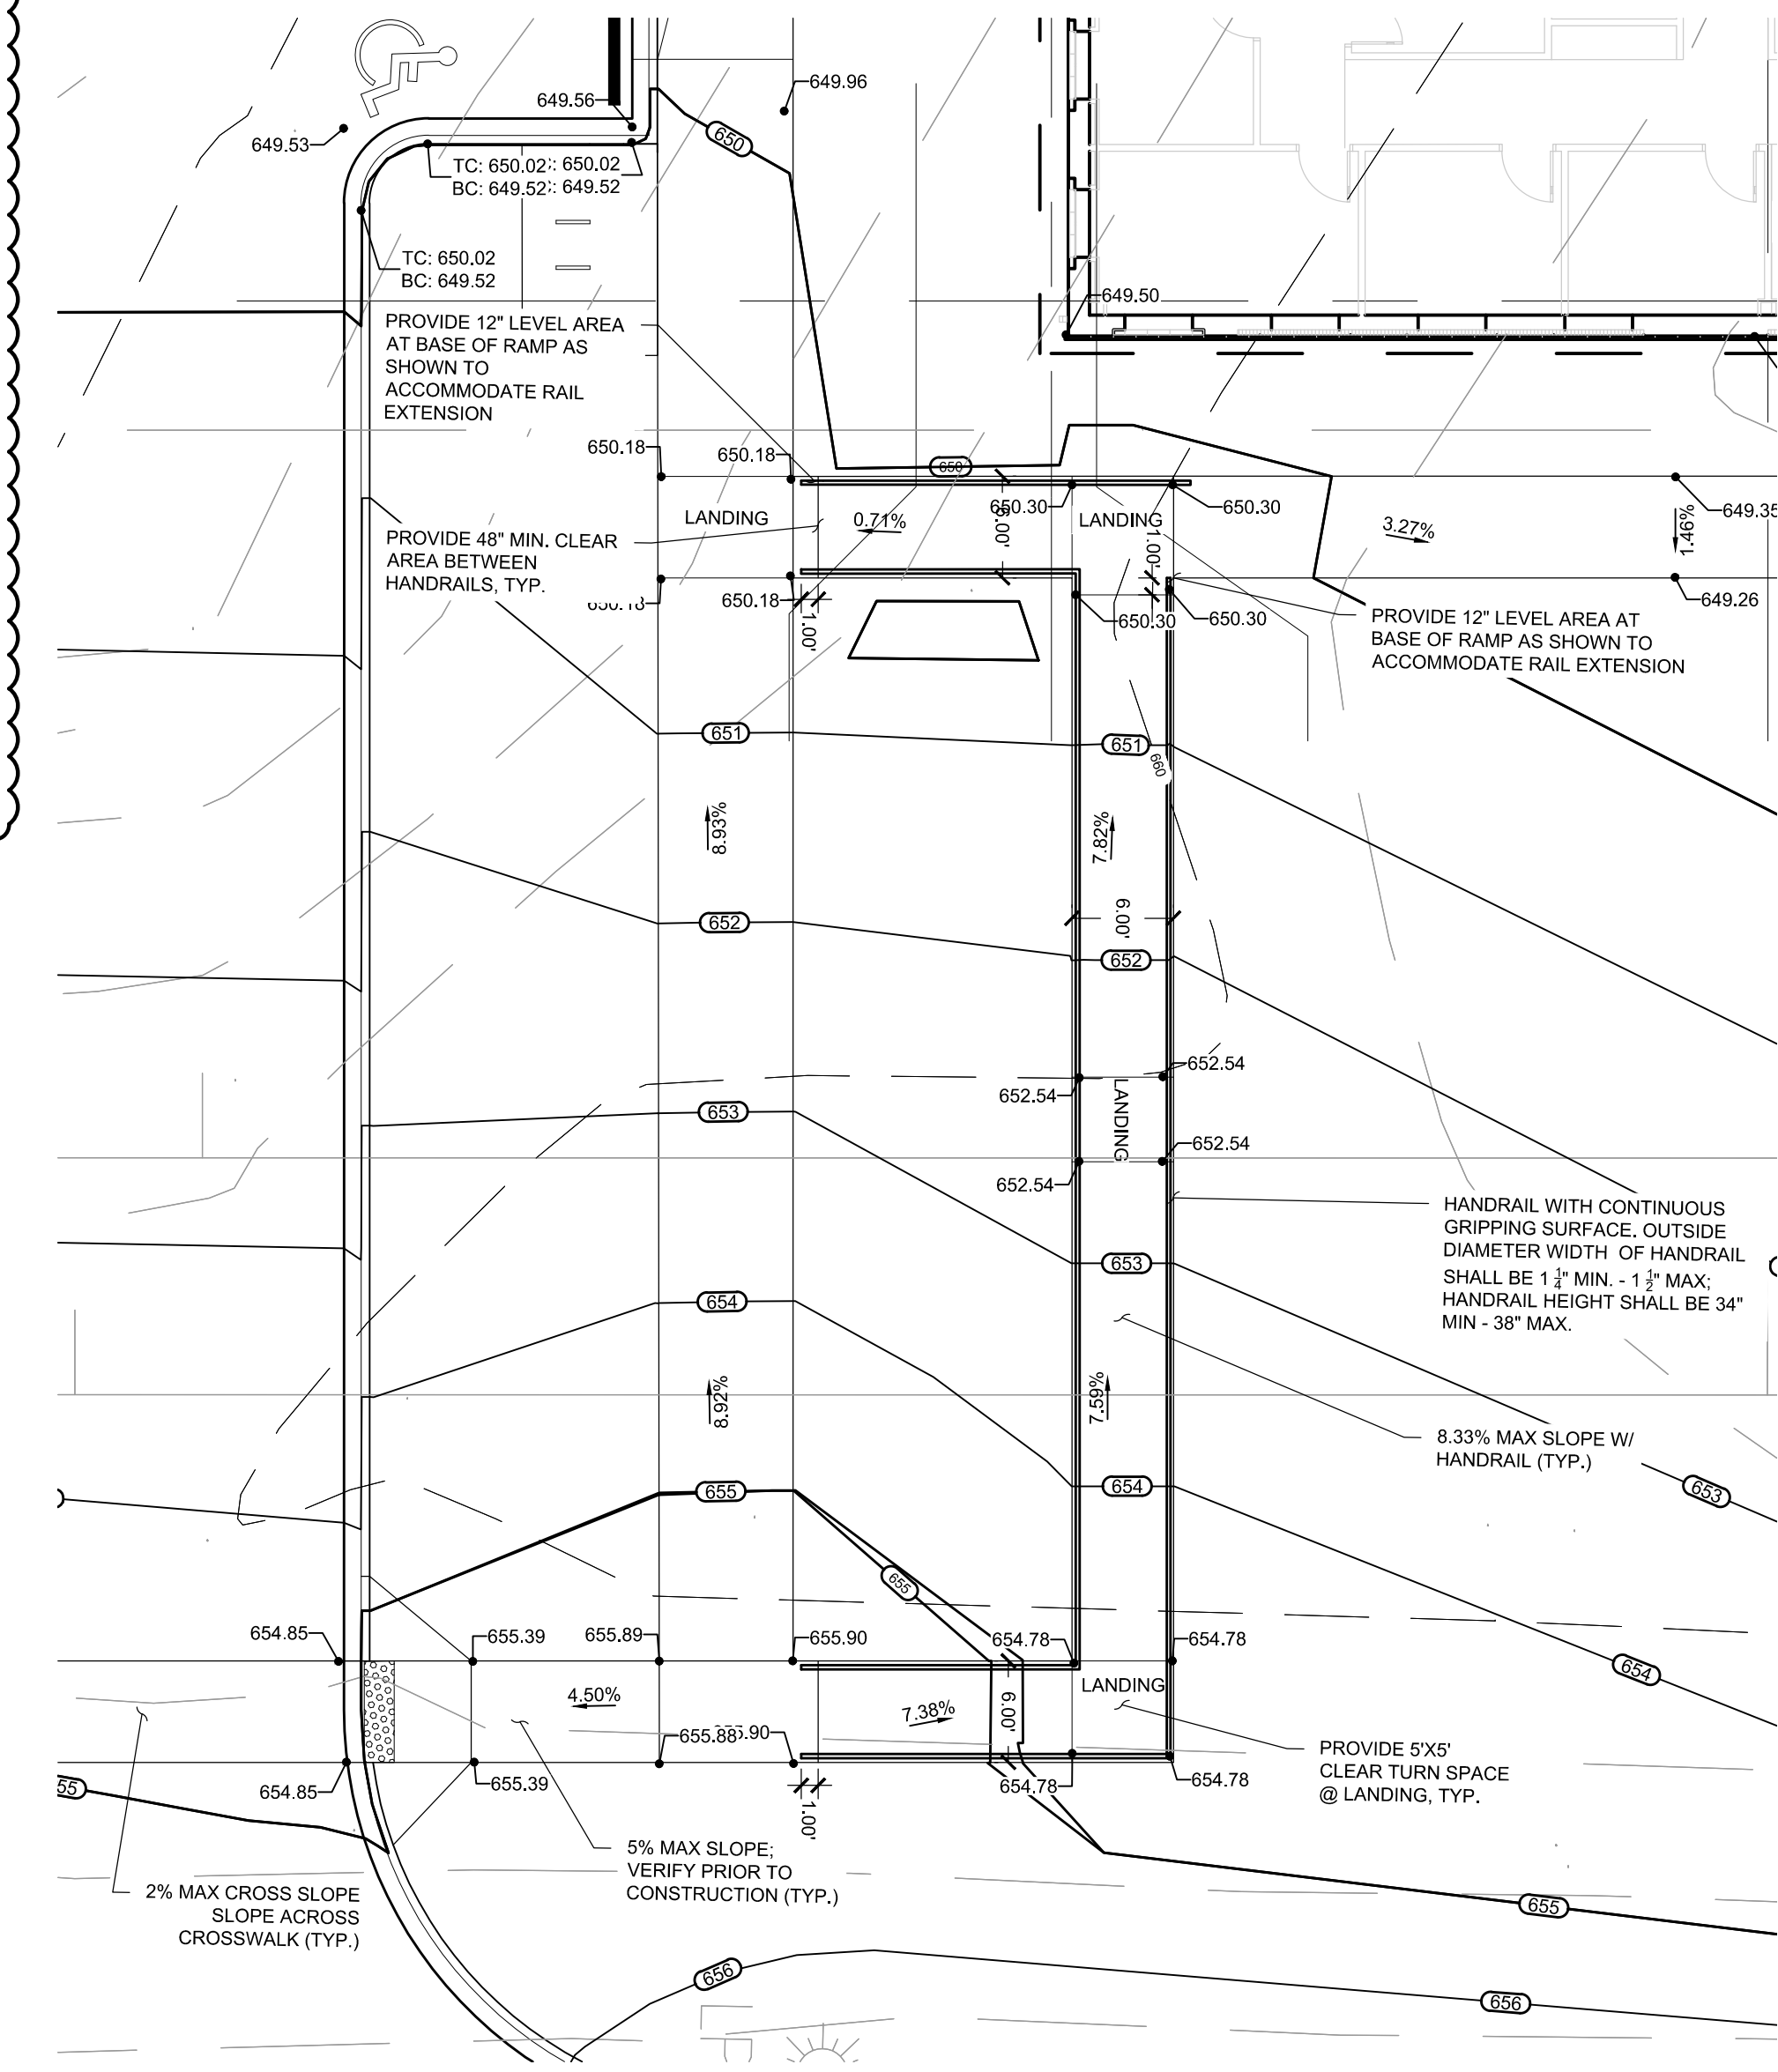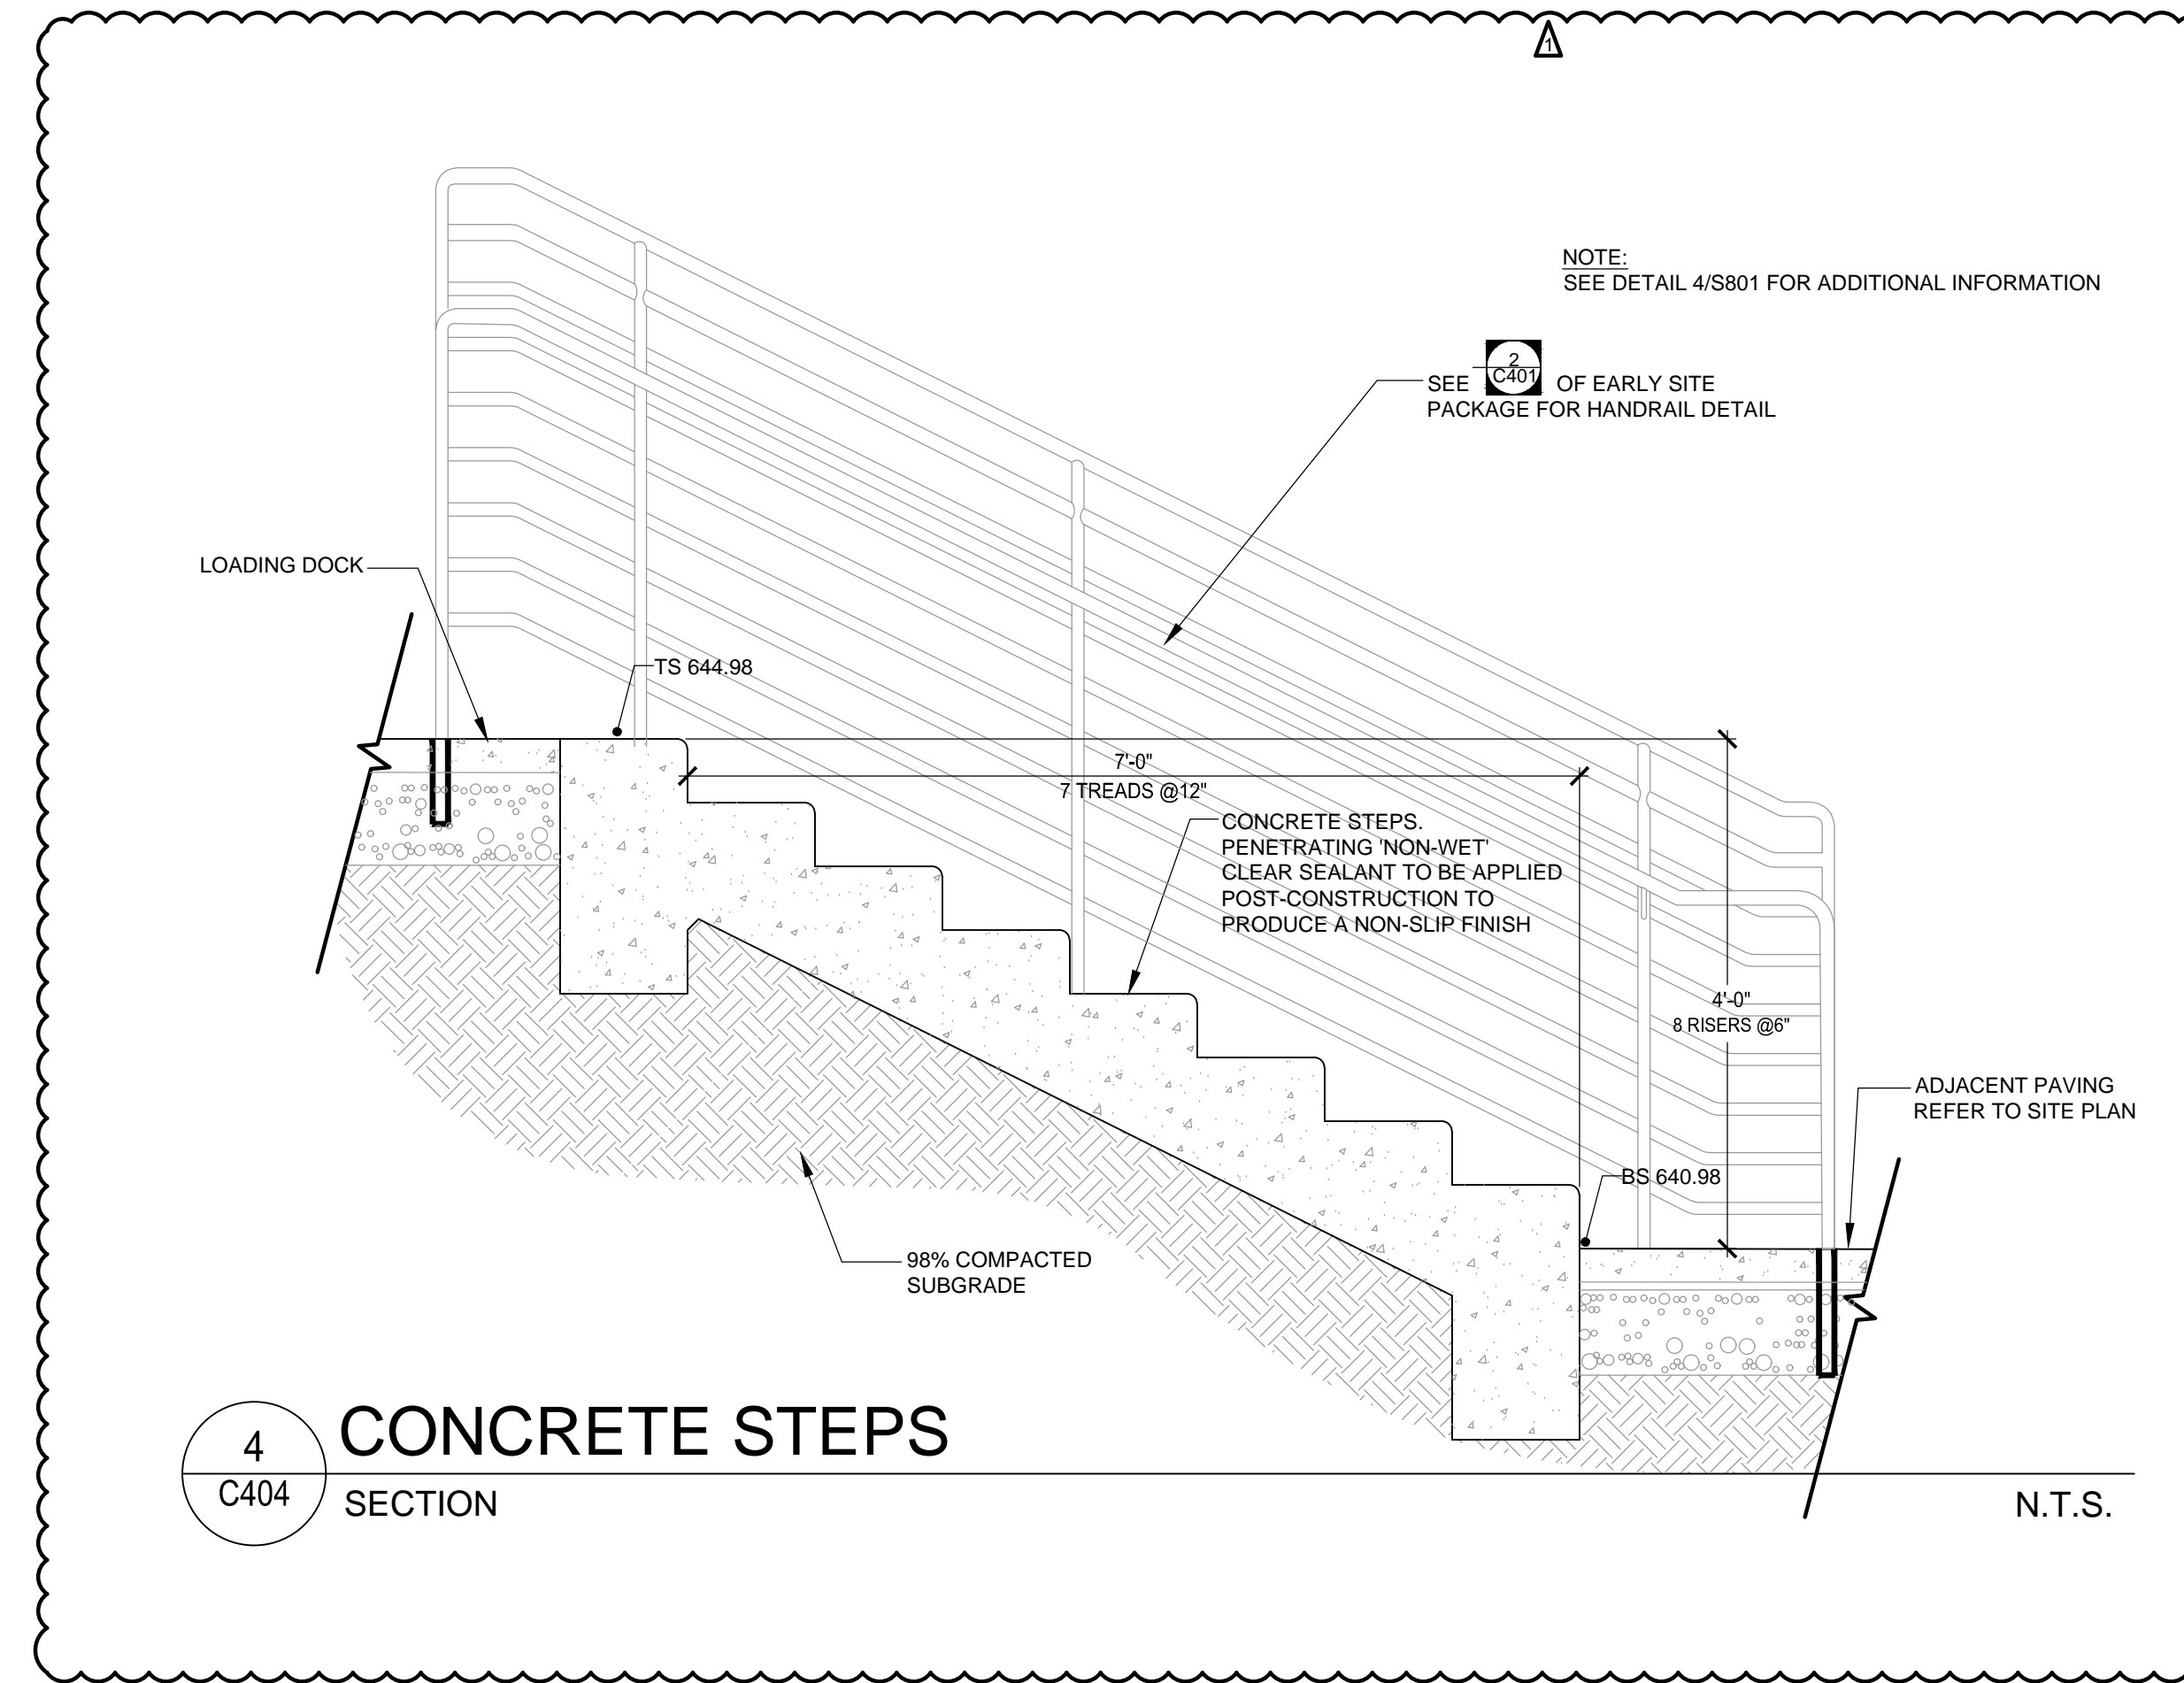


6 C404 ACCESSIBLE RAMP ENLARGEMENT PLAN

- NOTES:
1. BICYCLE RACKS SHOULD BE EMBEDDED PER MANUFACTURER'S RECOMMENDED INSTALLATION PROCEDURES.
 2. ALL DIMENSIONS SHOWN ARE MINIMUM. REFER TO CIVIL LAYOUT PLAN AND ARCHITECTURAL DETAILS FOR ADDITIONAL LAYOUT INFORMATION.
 3. LOOP TYPE BIKE RACK (2 BIKES PER RACK).
 4. BIKE RACK TO BE MOUNTED BELOW GRADE (EMBEDDED).
 5. COLOR TO BE MALAGA GREEN FROM DEVICE (UM404), PMS 5605 OR EQUAL SUCH AS TIGER DRYLAC T-AL 9012.
 6. SPACE BIKE RACKS A MIN. OF 2'-0".

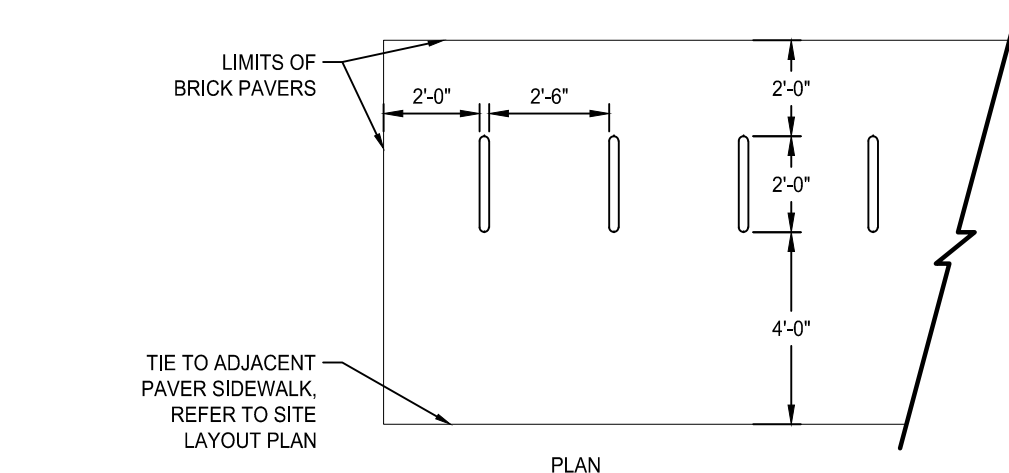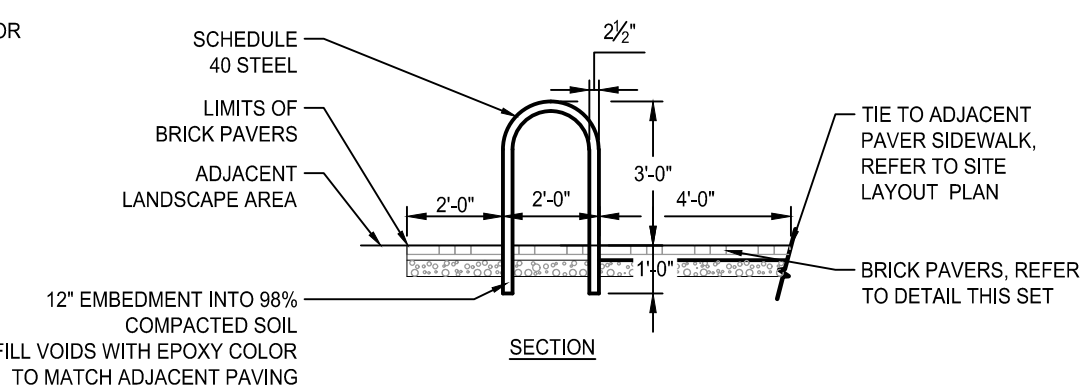


9 C404 BICYCLE RACK PLAN AND SECTION

NOT TO SCALE

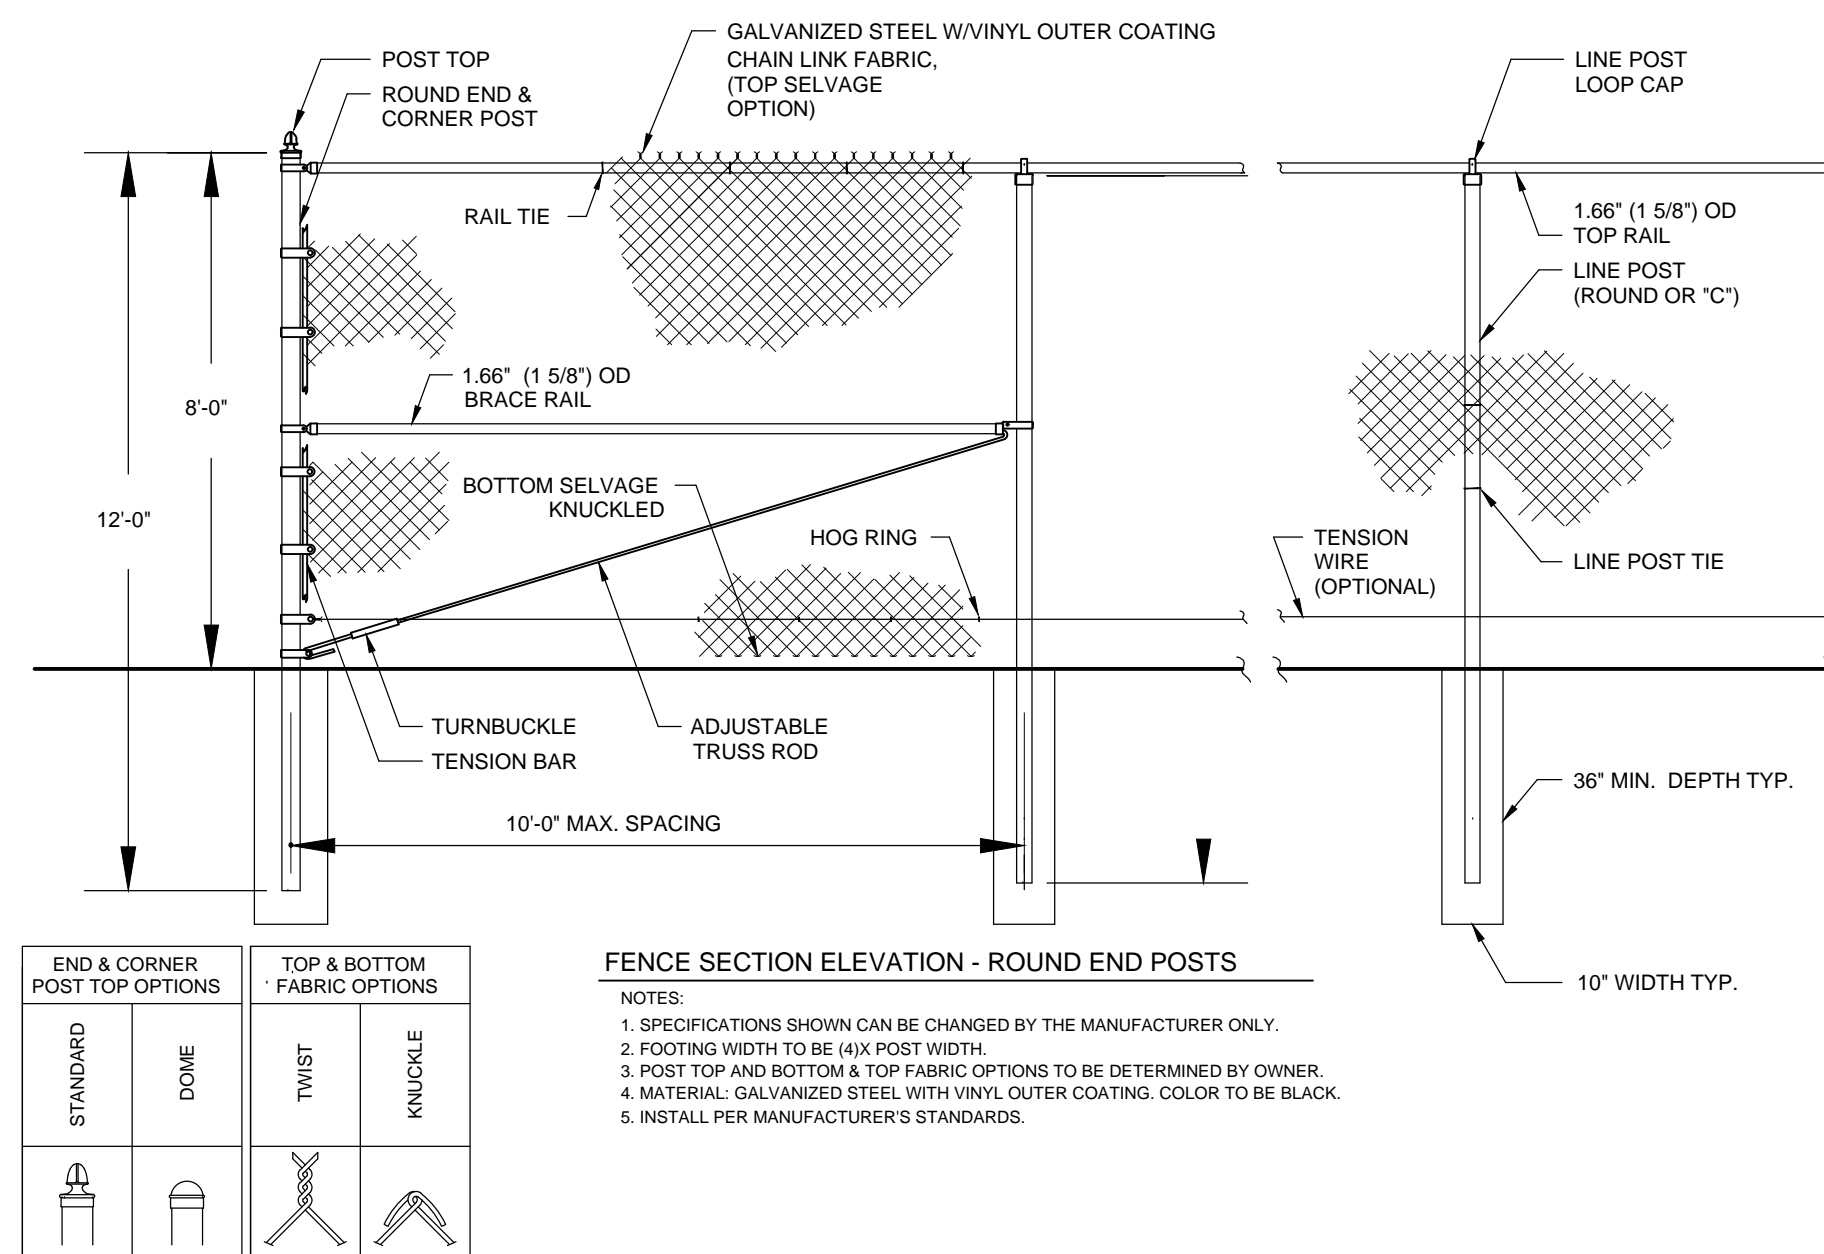


5 C404 VINYL COATED CHAIN LINK FENCE AND GATE ELEVATION

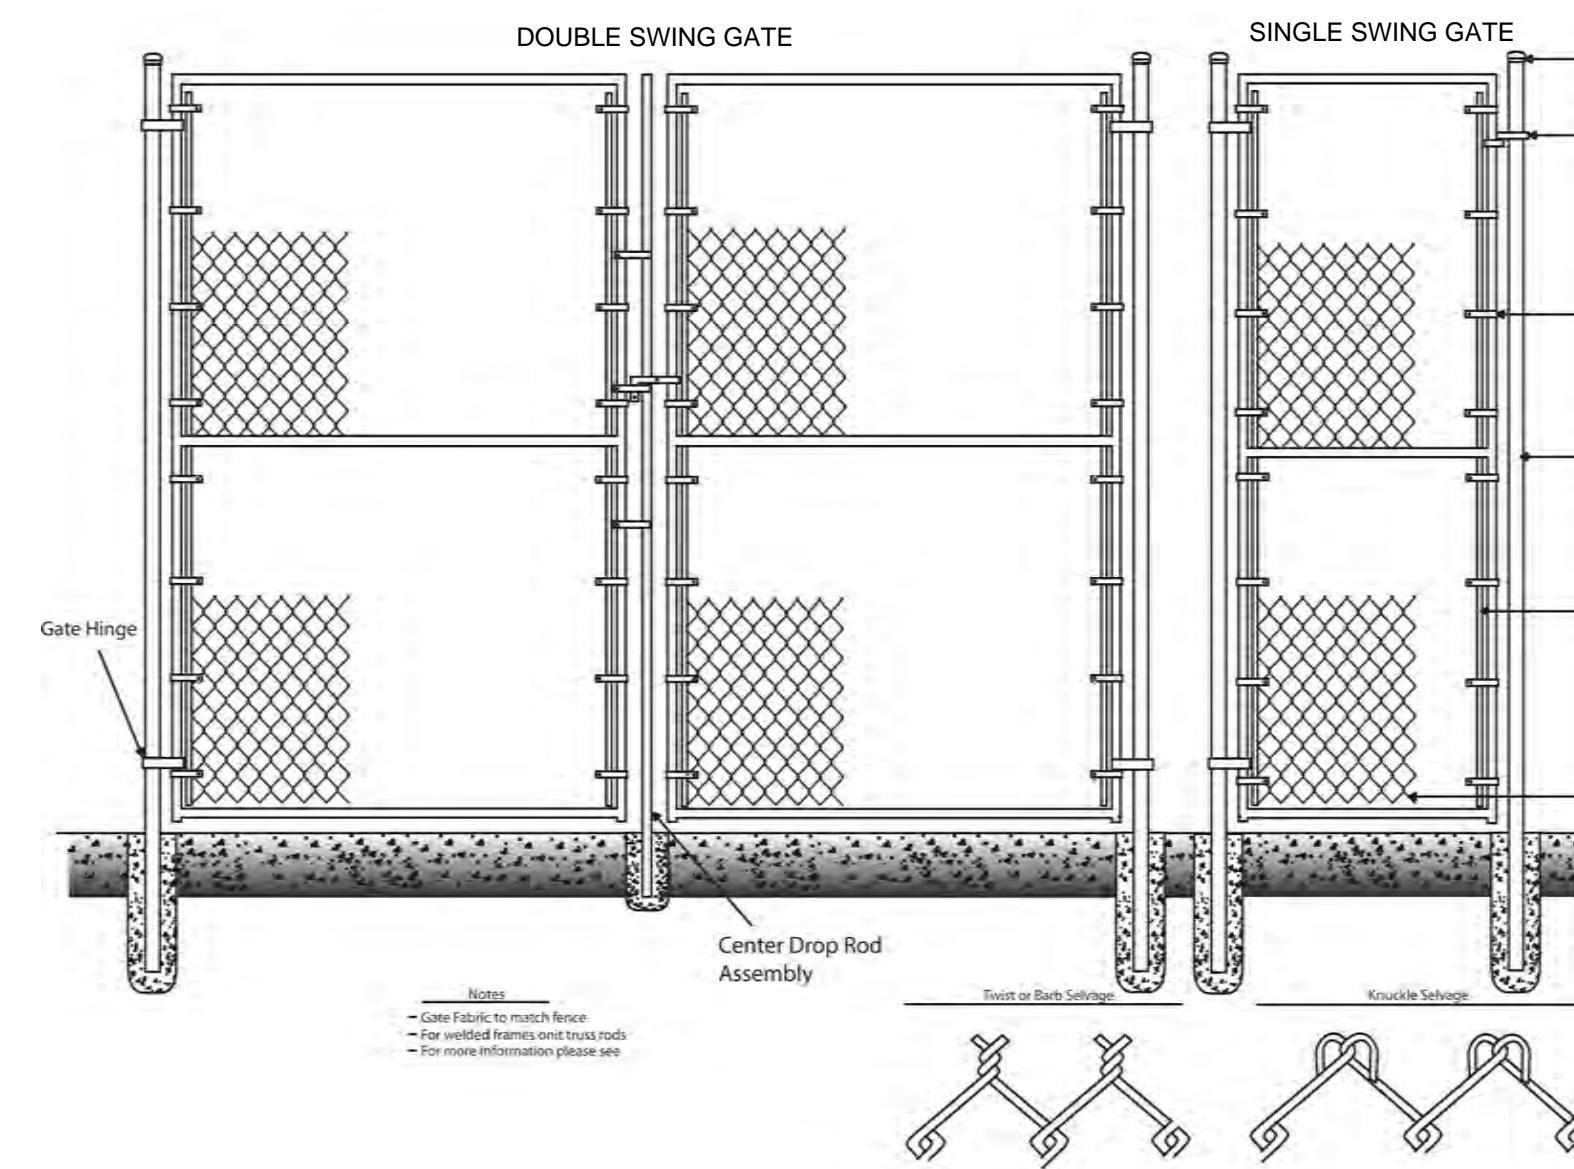


NOT TO SCALE

TRACER NOTES

- 1.1 MECHANICAL IDENTIFICATION
A. Warning Tape: Acid and alkali-resistant polyethylene film warning tape manufactured for marking and identifying underground utilities, 3 inches wide and 1/8 inch thick, continuously marked with a description of the utility, colored as follows:
1. Red: Electric.
2. Yellow: Gas, oil, steam, and dangerous materials.
3. Orange: Telephone and other communications.
4. Blue: Water systems.
5. Green: Sewer systems.
B. Detectable Warning Tape: Acid and alkali-resistant polyethylene film warning tape manufactured for marking and identifying underground utilities, a minimum of 6 inches wide and 4 mils thick, continuously marked with a description of the utility, with metallic core encased in a protective jacket for corrosion protection, detectable by metal detector when tape is buried up to 30 inches deep, colored as follows:
1. Red: Electric.
2. Yellow: Gas, oil, steam, and dangerous materials.
3. Orange: Telephone and other communications.
4. Blue: Water systems.
5. Green: Sewer systems.
C. 2012 NC Gas Code, section 404.15.3 Tracer: An insulated copper tracer wire or other approved conductor shall be installed adjacent to underground nonmetallic piping. Access shall be provided to the tracer wire or the tracer wire shall terminate at the end of the nonmetallic piping. The tracer wire size shall not be less than 18AWG and the insulation type suitable for direct burial.
D. All pipe, including lawn irrigation lines, and metallic pipe with compression gasket fittings installed underground shall have a tracer wire installed along the length of the pipe. The wire shall be taped to the bottom of the pipe at a maximum of 10' intervals and not allowed to "float freely" within the backfill.
E. TRACER WIRE
1. Tracer wire shall be single-conductor, 12 gauge minimum, copper single-conductor wire with type "UF" (Underground Feeder) insulation, and shall be continuous along the piping passing through the inside of each valve box. A #12 AWG or heavier (smaller AWG number) solid, insulated (RHW, THW, or polyethylene insulation is recommended), copper wire shall be taped to pipe at 10 foot intervals. Do not wrap wire around pipe. The wire must be one continuous, unbroken length. Coil tracer wire at meter location and street end with enough wire to extend a minimum of two feet above grade.
F. TRACER WIRE BOXES: Plastic gas and water services longer than 1000 feet in length from curb valve to meter (see note) must have tracer wire boxes installed in accordance with UNC Charlotte standards.
G. All underground piping and utilities (both metallic and non-metallic), except copper pipe, shall have a separate copper tracer wire and non-metallic warning tape installed above the utility line.
H. The tracer wire shall be traced for continuity prior to backfill, immediately upon completion of backfill and completion and once again during final utility location/build at the end of the project. This also will include landscape irrigation mains to the points of the valves. All above ground utility features such as vaults, manholes, valves, handholds, etc. to be properly labeled. Contractor shall provide an inventory of all installed outdoor utility features including type and model.
I. Identification Tape: The 1st stage of identification shall be a buried warning tape. This tape shall provide an early warning at shallow depth excavation. The tape shall be 6" wide, and buried approximately 18" to 30" above the service pipe, but a minimum of 10" below finished grade. It shall consist of multiple layers of polyethylene with an overall thickness of 3 to 5 mils. It shall be installed continuous from valve box to valve box or manhole to manhole, and shall terminate just outside of valve box or manhole wall. The black colored lettering on the warning tape shall be abrasion resistant and be imprinted on a color-coded background that conforms to APWA color code standards. The lettering on the tape should name the utility it is protecting. (i.e. Caution Buried Sewer Line Below).
J. TRACER WIRE: The 2nd stage of identification shall be a buried tracer wire. This tracer wire shall provide pipeline identification, be fully detectable from above grade utility locators, and be able to provide a depth reference point to top of pipe.

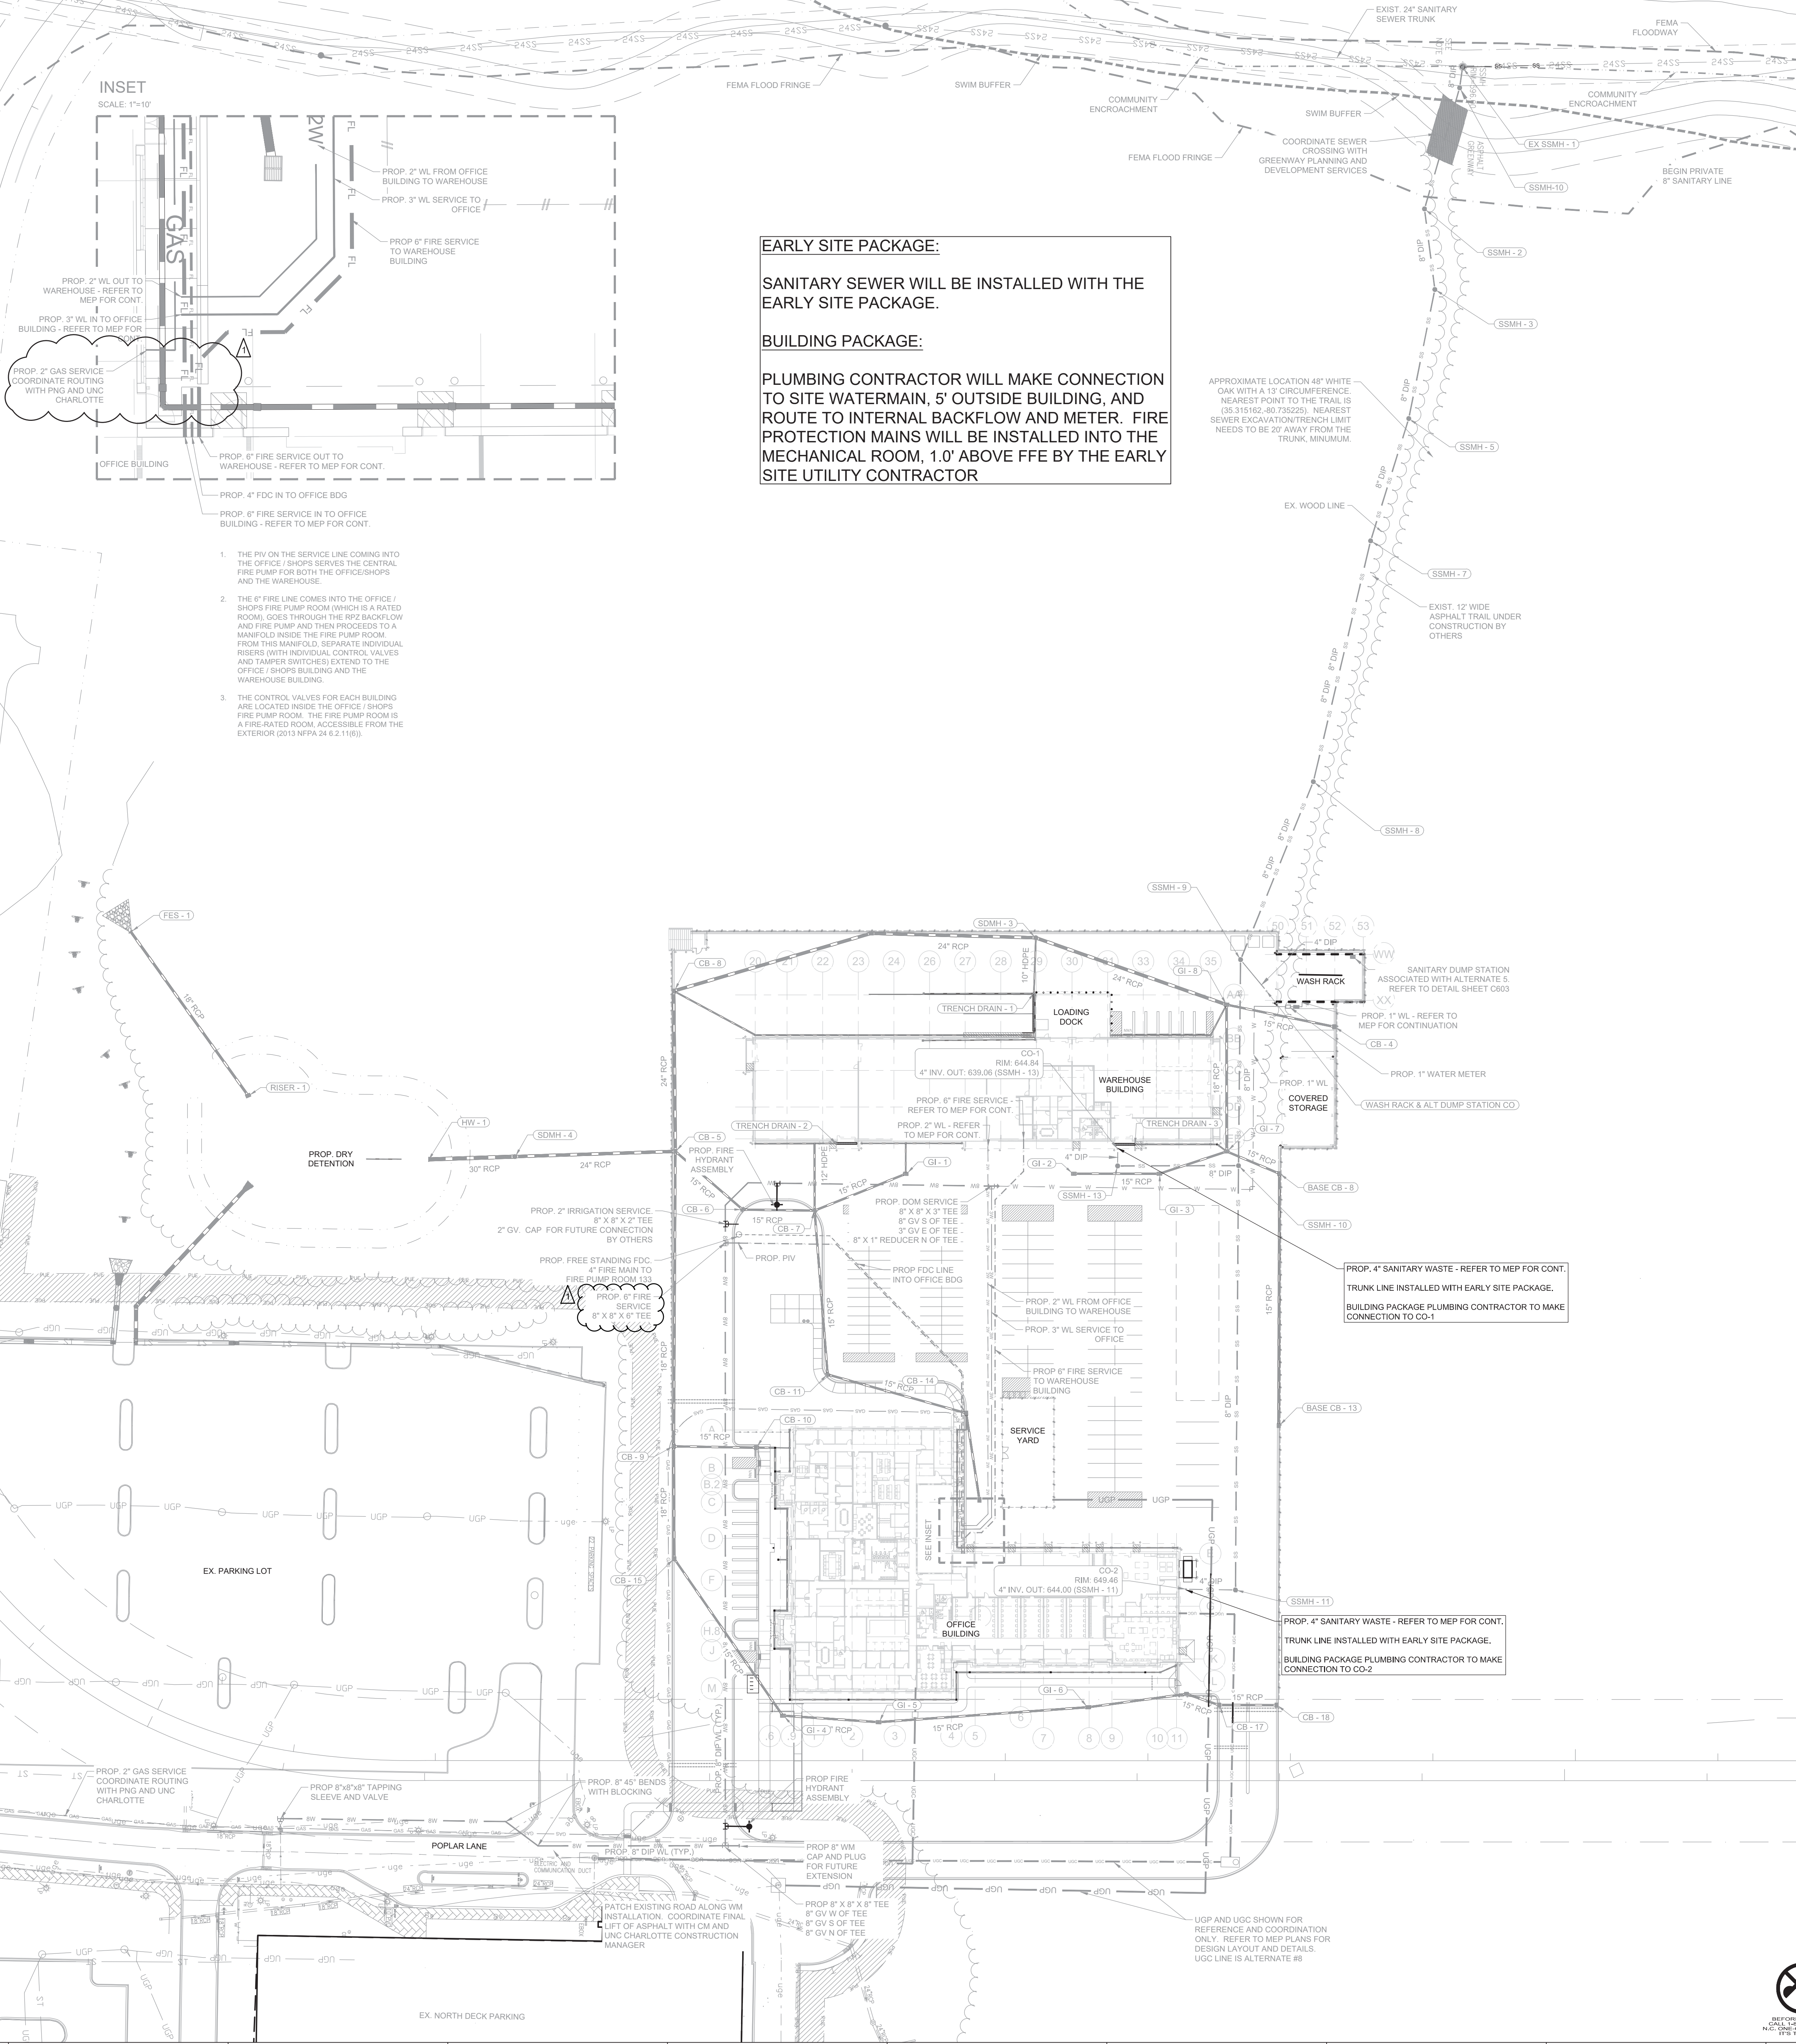

EARLY SITE PACKAGE:
SANITARY SEWER WILL BE INSTALLED WITH THE EARLY SITE PACKAGE.
BUILDING PACKAGE:
PLUMBING CONTRACTOR WILL MAKE CONNECTION TO SITE WATER MAIN, 5' OUTSIDE BUILDING, AND ROUTE TO INTERNAL BACKFLOW AND METER. FIRE PROTECTION MAINS WILL BE INSTALLED INTO THE MECHANICAL ROOM, 1.0' ABOVE FFE BY THE EARLY SITE UTILITY CONTRACTOR

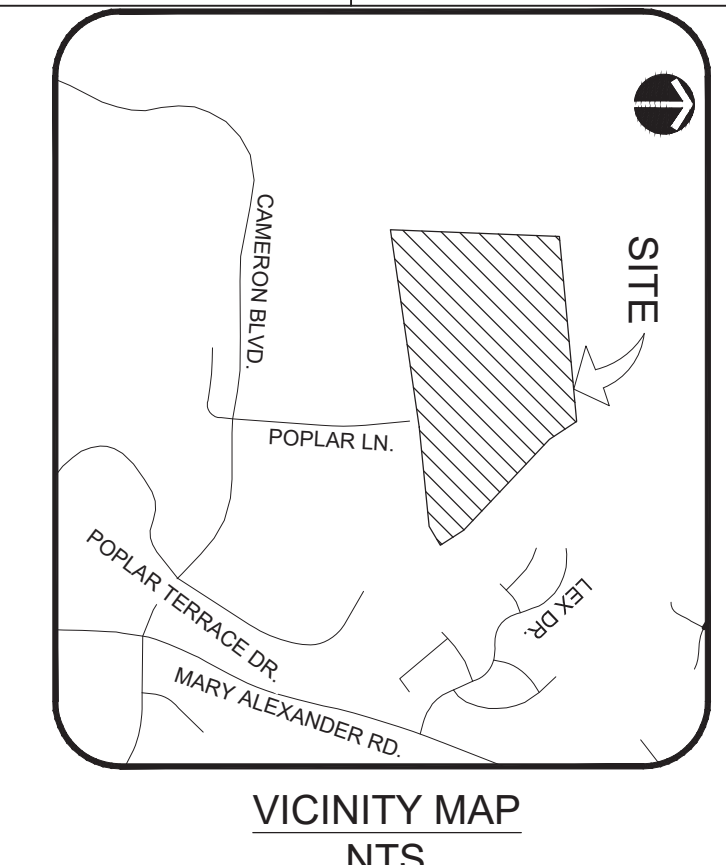

UTILITY LEGEND table with symbols for Property Line, Prop. Watermain, Prop. Sanitary, Prop. Storm, Prop. Curb Inlet, Prop. 24x24 Area Drain, Prop. Storm Manhole, Prop. Cleanout, Ex. Storm, Ex. Watermain, Ex. Sanitary, Prop. Sanitary Manhole, Ex. Gas, Ex. Electric, Ex. Telecom, Ex. Sanitary Manhole, Ex. Curb Inlet, Ex. Electric Manhole, Ex. Light Pole, Ex. Water Valve, Ex. Fire Hydrant.

GENERAL NOTES:

- 1. REFER TO NCDEQ DESIGN MANUAL (WATER AND SEWER POLICIES, PROCEDURES, STANDARDS, AND SPECIFICATIONS) FOR ALL NECESSARY DETAILS, MATERIALS, AND SPECIFICATIONS.
2. THE CONTRACTOR SHALL VERIFY LOCATION AND DEPTH OF ALL UNDERGROUND UTILITIES PRIOR TO CONSTRUCTION. LOCATIONS OF UNIVERSITY OWNED UTILITIES MUST BE COORDINATED WITH THE UNIVERSITY CONSTRUCTION MANAGER AND REQUESTED A MINIMUM 72 HOURS PRIOR TO ON-SITE ACTIVITIES. ANY DAMAGE TO EXISTING UTILITIES SHALL BE THE RESPONSIBILITY OF THE CONTRACTOR TO REPAIR. REPAIRS SHALL BE MADE WITHIN 48 HOURS OF DAMAGE. IF ACTUAL ELEVATIONS ARE DIFFERENT FROM THOSE SHOWN ON THIS PLAN, CONTACT THE ENGINEER (LANDDESIGN, INC. - 704-333-0325) BEFORE COMMENCING WITH CONSTRUCTION.
3. POTABLE DOMESTIC WATER METERING SHALL BE BY TURBINE OR ROTATING DISK METER WITH MAGNETIC DRIVE. METER TO BE LOCATED IN MECHANICAL ROOM. EASILY ACCESSIBLE READ IN HUNDREDS OF CUBIC FEET, AND PROVIDE OUTPUT TO BUILDING AUTOMATION.
4. NON-SEWERED WATER (CONSUMED BUT NOT RETURNED TO THE SEWER, E.G. IRRIGATION, COOLING TOWER MAKEUP, ETC.) SHOULD BE METERED AT ITS SOURCE. METER SHOULD BE LOCATED IN MECHANICAL ROOM, EASILY ACCESSIBLE, READ IN HUNDREDS OF CUBIC FEET AND PROVIDE OUTPUT TO BUILDING AUTOMATION.
5. NATURAL GAS METERING SHALL COMPLY WITH ALL REQUIREMENTS OF PIEDMONT NATURAL GAS, AND INTERFACE TO THE BUILDING AUTOMATION SYSTEM.
6. ROOF DRAIN LEADERS ABOVE GRADE SHALL BE GALVANIZED STEEL OR CAST IRON PIPING WITH NO HUB OR BELL AND SPOGOT JOINTS WITH COMPRESSION GASKETS. ALL ROOF DRAIN PIPING BELOW GRADE SHALL BE CAST IRON PIPING WITH BELL AND SPOGOT JOINTS WITH COMPRESSION GASKETS.
7. COORDINATION OF DIVISIONS OF WORK: CARE IS REQUIRED IN PREPARATION OF DOCUMENTS TO ASSURE NO OVERLAPPING AND NO GAPS BETWEEN THE WORK FOR THE VARIOUS CONTRACTS. EACH CONTRACTOR SHALL BE REQUIRED TO PERFORM EXCAVATION, TRENCHING, AND BACKFILL FOR HIS INSTALLATIONS. MATERIALS AND COMPACTION OF FILL MATERIALS SHALL MEET THE REQUIREMENTS STIPULATED IN DIVISION 2, REGARDLESS OF WHO PERFORMS THIS WORK. THEREFORE, IN DIVISIONS 15 AND 16 THE REQUIREMENTS OF EARTHWORK MAY BE BEST SPECIFIED BY MAKING REFERENCE TO DIVISION 2.
**9. CONTACT LANDDESIGN INC. AT 704-333-0325 IF ANY PIPE CROSSING VERIFICATION IS DIFFERENT THAN WHAT IS SPECIFIED ON THE PLAN.

BACKFLOW PREVENTION NOTES:

- 1. THERE SHALL BE NO TAPS, PIPING BRANCHES, UNAPPROVED BYPASS PIPING, HYDRANTS, FIRE DEPARTMENT CONNECTION POINTS, OR OTHER WATER-USING APPLIANCES CONNECTED TO THE SUPPLY LINE BETWEEN ANY WATER METER AND ITS REQUIRED BACKFLOW PREVENTER.
2. EACH REQUIRED BPA IS REQUIRED TO BE TESTED BY AN APPROVED CERTIFIED TESTER PRIOR TO PLACING THE WATER SYSTEM IN SERVICE.

WATER NOTES:

- 1. CONSTRUCTION SHALL BE IN ACCORDANCE WITH NCDEQ STANDARD SPECIFICATIONS.
2. THE CONTRACTOR SHALL VERIFY LOCATION AND DEPTH OF ALL UNDERGROUND UTILITIES PRIOR TO CONSTRUCTION.
3. ALL SHORING SHALL BE IN ACCORDANCE TO OSHA TRENCHING STANDARDS PART 1926, SUBPART P, AS AMENDED TO DATE.
4. ANY NECESSARY LANE CLOSURES SHALL FOLLOW GUIDELINES OUTLINED IN THE MANUAL OF UNIFORM TRAFFIC CONTROL DEVICES AND/OR C.D.O.T. WORK AREA TRAFFIC CONTROL HANDBOOK (WATCH).
5. IF THE PROPOSED WATER MAIN IS INSTALLED WITHIN 12" IN ANY DIRECTION (VERTICALLY OR HORIZONTALLY) FROM A GAS MAIN, THEN THE CONTRACTOR SHALL CALL THE APPROPRIATE GAS COMPANY AND INFORM THEM.
6. WATER MAIN TO BE INSTALLED WITH A MINIMUM OF 36" OF COVER. WATER MAIN TO BE C900 UNLESS SPECIFIED OTHERWISE.
7. RECORD DRAWINGS OF WATER MAIN TO INCLUDE ALL VALVES, TEES, BENDS AND HYDRANTS.
8. ALL WATER VALVES TO OPERATE BY TURNING THE SQUARE NUT CLOCKWISE (RIGHT) AND COUNTERCLOCKWISE (LEFT) TO OPEN, AS PER UNC CHARLOTTE REQUIREMENTS.
9. FIRE HYDRANT IS TO BE PLACED A MINIMUM OF 6' BEHIND CURB AND GUTTER OR 4' BEHIND A DITCH LINE IN CUT. WATER VALVE LOCATED A MINIMUM 40' BEHIND THE BEGINNING OF SLOPE IN FULL SECTIONS.
10. AS REQUIRED BY NFPA 13 AND 24, THE SPRINKLER SYSTEM SHALL TYPICALLY INCLUDE THE FOLLOWING:
10.1 AN ALARM CHECK VALVE WITH OUTSIDE WATER MOTOR SOING.
10.2 A 4" POST INDICATOR VALVE LOCATED A MINIMUM 40' FEET FROM BUILDING WALLS.
10.3 A FIRE DEPARTMENT CONNECTION ON THE SYSTEM SIDE OF THE WATER SUPPLY CHECK VALVE.


SEWER NOTES:

- 1. CONSTRUCTION SHALL BE IN ACCORDANCE WITH NCDEQ GRAVITY SEWER MINIMUM DESIGN CRITERIA.
2. ALL SHORING SHALL BE IN ACCORDANCE TO OSHA TRENCHING STANDARDS PART 1926, SUBPART P, AS AMENDED TO DATE.
3. IF THE PROPOSED SEWER MAIN IS INSTALLED WITHIN 12" IN ANY DIRECTION (VERTICALLY OR HORIZONTALLY) FROM A GAS MAIN, THEN THE CONTRACTOR SHALL CALL THE APPROPRIATE GAS COMPANY AND INFORM THEM.
4. SEWER LATERALS ARE TO HAVE A MINIMUM OF 1.0% SLOPE AND A NO MORE THAN A 100% MAXIMUM SLOPE.



227 WEST TRADE STREET SUITE 700
CHARLOTTE, NORTH CAROLINA 28202
TEL. 704.333.6686 FAX 704.333.2926
WWW.LS3P.COM

LandDesign
223 NORTH GRAHAM STREET
CHARLOTTE NC, 28202
(704) 333-0325

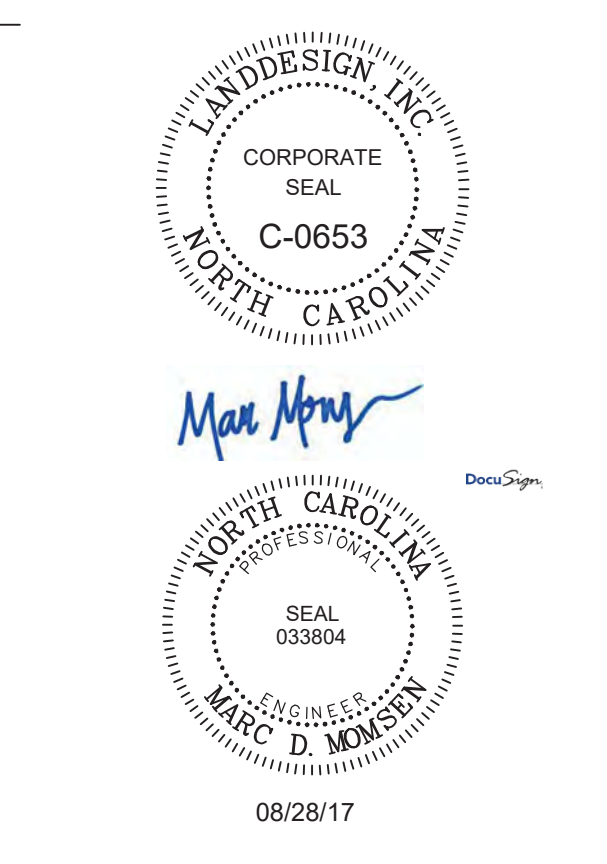

MEMBERS OF THE AMERICAN INSTITUTE OF ARCHITECTS

COPYRIGHT 2017 ALL RIGHTS RESERVED
PRINTED OR ELECTRONIC DRAWINGS AND DOCUMENTATION MAY NOT BE REPRODUCED IN ANY FORM WITHOUT WRITTEN PERMISSION FROM LS3P ASSOCIATES LTD.

REVISIONS:


Table with 3 columns: No., Description, Date. Row 1: 1, ADDENDUM 4, 08/28/17

PROJECT: 9202-164730
SCO ID: 16-15656-02B
ITEM: 315 CODE: 41526
DATE: AUGUST 21, 2017
DRAWN BY: EJM
CHECKED BY: MDM

UTILITY PLAN
C600
Scale bar showing 0, 25, 50, 100 feet. North arrow pointing up.



Max Moya Aug 28 2017 1:47 PM

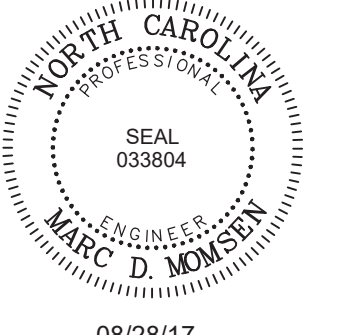

08/28/17

MEMBERS OF THE AMERICAN INSTITUTE OF ARCHITECTS

COPYRIGHT 2017 ALL RIGHTS RESERVED
PRINTED OR ELECTRONIC DRAWINGS AND DOCUMENTATION MAY NOT BE REPRODUCED IN ANY FORM WITHOUT WRITTEN PERMISSION FROM LS3P ASSOCIATES LTD.

REVISIONS:

No.	Description	Date
1	ADDENDUM 4	08/28/17

PROJECT: 9202-164730
SCO ID: 16-15656-02B
ITEM: 315 CODE: 41526
DATE: AUGUST 21, 2017
DRAWN BY: E.J.L.
CHECKED BY: MDM

UTILITY DETAILS

C603

FLOW TEST DATA						
DATE	LOCATION	FLOW TEST PERFORMED BY	PRESSURE		FLOW (GPM)	FLOW AT 20 PSI (GPM)
			STATIC (PSI)	RESIDUAL (PSI)		
7/21/2017	HYDRANT #55662 @ NE CORNER OF LOT 26 NEAR MAINTENANCE YARD NC-SCO ADJUSTED FLOW TEST	CHARLOTTE FIRE DEPARTMENT	74	67	1061	3198
			64	57	955	2878

FLOW TEST NOTES:
 1. SEE SITE UTILITY PLANS FOR EXACT LOCATION OF FIRE HYDRANTS.
 2. THE CONTRACTOR IS RESPONSIBLE FOR OBTAINING A NEW FLOW TEST ON WHICH TO BASE HIS CALCULATIONS.
 3. THE FLOW TEST USED FOR THE WORKING PLAN DESIGN SHOULD BE PERFORMED AS INDICATED IN NFPA 13 WHICH USES TWO HYDRANTS, A PRESSURE HYDRANT AND A FLOW HYDRANT. THE TWO HYDRANTS SHALL BE AS CLOSE TO THE POINT OF CONNECTION AS POSSIBLE. A COPY OF THE FLOW TEST AND TEST HYDRANT LOCATIONS SHALL BE SUBMITTED WITH THE SHOP DRAWING PACKAGE.

**TABLE B 105.1
MINIMUM REQUIRED FIRE FLOW AND FLOW DURATION FOR BUILDINGS***

FIRE-FLOW CALCULATION AREA (square feet)					FIRE FLOW (gallons per minute) ^b	FLOW DURATION (hours)
Type IA and IIA ^a	Type IIA and IIA ^a	Type IV and V-A ^a	Type IIB and IIB ^a	Type V-B ^a		
0-22,700	0-12,700	0-8,200	0-5,900	0-3,600	1,500	2
22,701-30,200	12,701-17,000	8,201-10,900	5,901-7,900	3,601-4,800	1,750	
30,201-38,700	17,001-21,800	10,901-12,900	7,901-9,800	4,801-6,200	2,000	
38,701-48,300	21,801-24,200	12,901-17,400	9,801-12,600	6,201-7,700	2,250	
48,301-59,000	24,201-33,200	17,401-21,300	12,601-15,400	7,701-9,400	2,500	3
59,001-70,900	33,201-39,700	21,301-25,500	15,401-18,400	9,401-11,300	2,750	
70,901-83,700	39,701-47,100	25,501-30,100	18,401-21,800	11,301-13,400	3,000	
83,701-97,700	47,101-54,900	30,101-35,200	21,801-25,900	13,401-15,600	3,250	
97,701-112,700	54,901-63,400	35,201-40,600	25,901-29,300	15,601-18,000	3,500	4
112,701-128,700	63,401-72,400	40,601-46,400	29,301-33,500	18,001-20,600	3,750	
128,701-145,900	72,401-82,100	46,401-52,500	33,501-37,900	20,601-23,300	4,000	
145,901-164,200	82,101-92,400	52,501-59,100	37,901-42,700	23,301-26,300	4,250	
164,201-183,400	92,401-103,100	59,101-66,000	42,701-47,700	26,301-29,300	4,500	
183,401-203,700	103,101-114,600	66,001-73,300	47,701-53,000	29,301-32,600	4,750	
203,701-225,200	114,601-126,700	73,301-81,100	53,001-58,600	32,601-36,000	5,000	
225,201-247,700	126,701-139,400	81,101-89,200	58,601-65,400	36,001-39,600	5,250	
247,701-271,200	139,401-152,600	89,201-97,700	65,401-70,600	39,601-43,400	5,500	
271,201-295,900	152,601-166,500	97,701-106,500	70,601-77,000	43,401-47,400	5,750	
295,901-Greater	166,501-Greater	106,501-115,800	77,001-83,700	47,401-51,500	6,000	
—	—	115,801-125,500	83,701-90,600	51,501-55,700	6,250	
—	—	125,501-135,500	90,601-97,900	55,701-60,200	6,500	
—	—	135,501-145,800	97,901-106,800	60,201-64,800	6,750	
—	—	145,801-156,700	106,801-113,200	64,801-69,600	7,000	
—	—	156,701-167,900	113,201-121,300	69,601-74,600	7,250	
—	—	167,901-179,400	121,301-129,600	74,601-79,800	7,500	
—	—	179,401-191,400	129,601-138,300	79,801-85,100	7,750	
—	—	191,401-Greater	138,301-Greater	85,101-Greater	8,000	

For SI: 1 square foot = 0.0929 m²; 1 gallon per minute = 3.785 L/m; 1 pound per square inch = 6.895 kPa.
 a. The minimum required fire flow shall be allowed to be reduced by 25 percent for Group R.
 b. Types of construction are based on the International Building Code.
 c. Measured at 20 psi.

**TABLE C105.1
NUMBER AND DISTRIBUTION OF FIRE HYDRANTS**

FIRE-FLOW REQUIREMENT (gpm)	MINIMUM NUMBER OF HYDRANTS	AVERAGE SPACING BETWEEN HYDRANTS ^{a, b, c} (feet)	MAXIMUM DISTANCE FROM ANY POINT ON STREET OR ROAD FRONTAGE TO A HYDRANT ^d
1,750 or less	1	500	250
2,000-2,250	2	450	225
2,500	3	450	225
3,000	3	400	225
3,500-4,000	4	350	210
4,500-5,000	5	300	180
5,500	6	300	180
6,000	6	250	150
6,500-7,000	7	250	150
7,500 or more	8 or more ^e	200	120


For SI: 1 foot = 304.8 mm; 1 gallon per minute = 3.785 L/m.
 a. Reduce by 100 feet for dead-end streets or roads.
 b. Where streets are provided with median dividers which can be crossed by fire fighters pulling hose lines, or where arterial streets are provided with four or more traffic lanes and have a traffic count of more than 30,000 vehicles per day, hydrant spacing shall average 500 feet on each side of the street and be arranged on an alternating basis up to a fire-flow requirement of 7,000 gallons per minute and 400 feet for higher fire-flow requirements.
 c. Where new water mains are extended along streets where hydrants are not needed for protection of structures or similar fire problems, fire hydrants shall be provided at spacing not to exceed 1,000 feet to provide for transportation hazards.
 d. Reduce by 50 feet for dead-end streets or roads.
 e. One hydrant for each 1,000 gallons per minute or fraction thereof.

FIRE FLOW DEVELOPMENT SUMMARY

OFFICE/SHOPS AREA: 34,000 SF (FP-011)
 WAREHOUSE AREA: 23,600 SF (FP-012)
 TOTAL AREA: 57,600 SF

CONSTRUCTION TYPE: IIB
 REQUIRED FIRE FLOW: 5,000 GPM
 75% REDUCTION FOR SPRINKLED BUILDINGS: 1,250 GPM

FIRE FLOW ANALYSIS

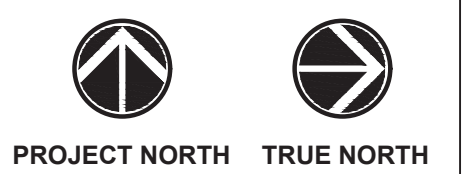

No.	Description	Date
1	ADDENDUM NO. 4	08/28/2017

Mark	Type	Base Plate	Cap Plate	Comments
A	W10X33	3/4" x 1'-2 1/4" x 4"	SEE DETAILS	


NOTE: AT BRACED FRAME COLUMN LOCATIONS USE TYPICAL DETAIL 105-801 FOR BASE PLATE AND ANCHOR BOLT REQUIREMENTS. AT ALL OTHER COLUMN LOCATIONS USE DETAIL 65-801

Mark	Length	Width	Sq Footing Thickness	TOP REINFORCING	BOTTOM REINFORCING	Comments
F30	3'-0"	3'-0"	1'-0"	(5) #5 E.W.	(4) #4 E.W.	
F40	4'-0"	4'-0"	1'-0"	(5) #5 E.W.	(5) #5 E.W.	
F50	5'-0"	5'-0"	1'-4"	(8) #6 E.W.	(8) #6 E.W.	
F50-A	5'-0"	5'-0"	1'-6"	(6) #5 E.W.	(6) #5 E.W.	
F60	6'-0"	6'-0"	1'-6"	(7) #6 E.W.	(7) #6 E.W.	
F60-A	6'-0"	6'-0"	2'-0"	(7) #6 E.W.	(7) #6 E.W.	
F70	7'-0"	7'-0"	1'-6"	(8) #6 E.W.	(8) #6 E.W.	
F80	8'-0"	8'-0"	1'-6"	(9) #6 E.W.	(9) #6 E.W.	
F100	10'-0"	10'-0"	1'-6"	(11) #6 E.W.	(11) #6 E.W.	
F507B	7'-8"	5'-0"	1'-8"	#5@2' O.C. E.W.	#5@2' O.C. E.W.	


NOTE: FOOTING DESIGNATION ON PLAN WITH "1" SHALL INCLUDE TOP REINFORCING STEEL. ALL OTHER FOOTINGS, TOP REINFORCING NOT REQUIRED.

FOUNDATION PLAN NOTES:


- SEE ARCHITECTURAL DRAWINGS FOR TOP OF FINISH FLOOR SLAB ELEVATIONS.
- UNLESS OTHERWISE NOTED, THE SLAB-ON-GRADE IS TO BE 4-INCH THICK CONCRETE SLAB REINFORCED WITH 6x6-W1.4 x W1.4 W.W.F. PLACED 1-INCH CLEAR FROM TOP. PLACE SLAB DIRECTLY ON TOP OF A VAPOR BARRIER AND OVER 4-INCHES OF CLEAN WASHED STONE. VAPOR BARRIER SHALL BE STICO WRAP 15-MILS THICK AS MANUFACTURED BY STICO INDUSTRIES (OR EQUAL).
- SLAB-ON-GRADE CONTROL JOINTS ARE INDICATED ON PLAN WITH THE SYMBOL C.J. THESE JOINTS MAY BE EITHER CONSTRUCTION JOINTS OR SAWCUT JOINTS. SEE TYPICAL DETAILS. COORDINATE ALL SLAB JOINT LOCATIONS WITH JOINTS IN ARCHITECTURAL FLOOR FINISHES TO ASSURE ALIGNMENT IS APPLICABLE.
- TOP OF ALL EXTERIOR FOOTINGS ARE TO BE A MINIMUM OF 2'-0" BELOW FINISHED EXTERIOR GRADE.
- SEE SHEET S101 FOR GENERAL NOTES AND NOTES PERTAINING TO FOUNDATION DESIGN AND CONSTRUCTION.
- SEE SHEET S801 FOR TYPICAL DETAILS.
- VERIFY LOCATION AND SIZE OF WALLS SHOWN ON THE FOUNDATION PLAN WITH ARCHITECTURAL DRAWINGS PRIOR TO CONSTRUCTION.
- FILL ALL CMU CELLS BELOW GRADE WITH CONCRETE GROUT.
- UNLESS OTHERWISE INDICATED ON PLAN OR IN DETAILS, ALL WALL FOOTINGS SHALL BE 12" DEEP, PROJECT 6" BEYOND EACH FACE OF THE WALL SUPPORTED AND SHALL BE REINFORCED WITH (3)#5 BARS CONTINUOUS LONGITUDINALLY.
- "F_" INDICATES A CONCRETE FOOTING. SEE FOOTING SCHEDULE.
- "S_" INDICATES A STEEL COLUMN. SEE COLUMN SCHEDULE.
- FOUNDATION DESIGN SHOWN FOR PREFABRICATED METAL BUILDING SHALL BE USED FOR BASE BID. FINAL DESIGN OF FOUNDATION WILL BE PROVIDED AFTER RECEIVING COLUMN ANCHOR BOLT SETTING PLAN AND FINAL COLUMN SPECIFICATIONS FROM THE CONTRACTED METAL BUILDING SUPPLIER. REFER TO METAL BUILDING SYSTEMS REACTION SECTION FOR ADDITIONAL REQUIREMENTS.
- "P_" INDICATES A CONCRETE PIER. SEE DETAILS ON S801.
- "< - >" INDICATES TOP OF CONCRETE PIER ELEVATION.
- AT SLOPED SLAB-ON-GRADE AREAS, THE MINIMUM SLAB THICKNESS SPECIFIED SHALL BE MAINTAINED. EITHER SLOPE SUBGRADE TO MAINTAIN A CONSTANT THICKNESS OR PROVIDE A THICKER SLAB AT AREAS INDICATED TO BE SLOPED TO ALLOW THE MINIMUM SLAB THICKNESS TO BE MAINTAINED AT LOW POINT.
- COORDINATE THE ELEVATIONS OF ALL FOOTINGS WITH RESPECT TO UNDERGROUND UTILITIES. STEP AS REQUIRED TO AVOID FOULING WITH UTILITIES AND TO ALLOW UTILITIES TO PASS OVER FOOTINGS. PROVIDE A STEEL SLEEVE THROUGH WALL FOR PIPE TO PASS THROUGH. REFER TO MEP AND PF DRAWINGS FOR UTILITIES AND INVERTS. SEE TYPICAL STEPPED FOOTING DETAIL.

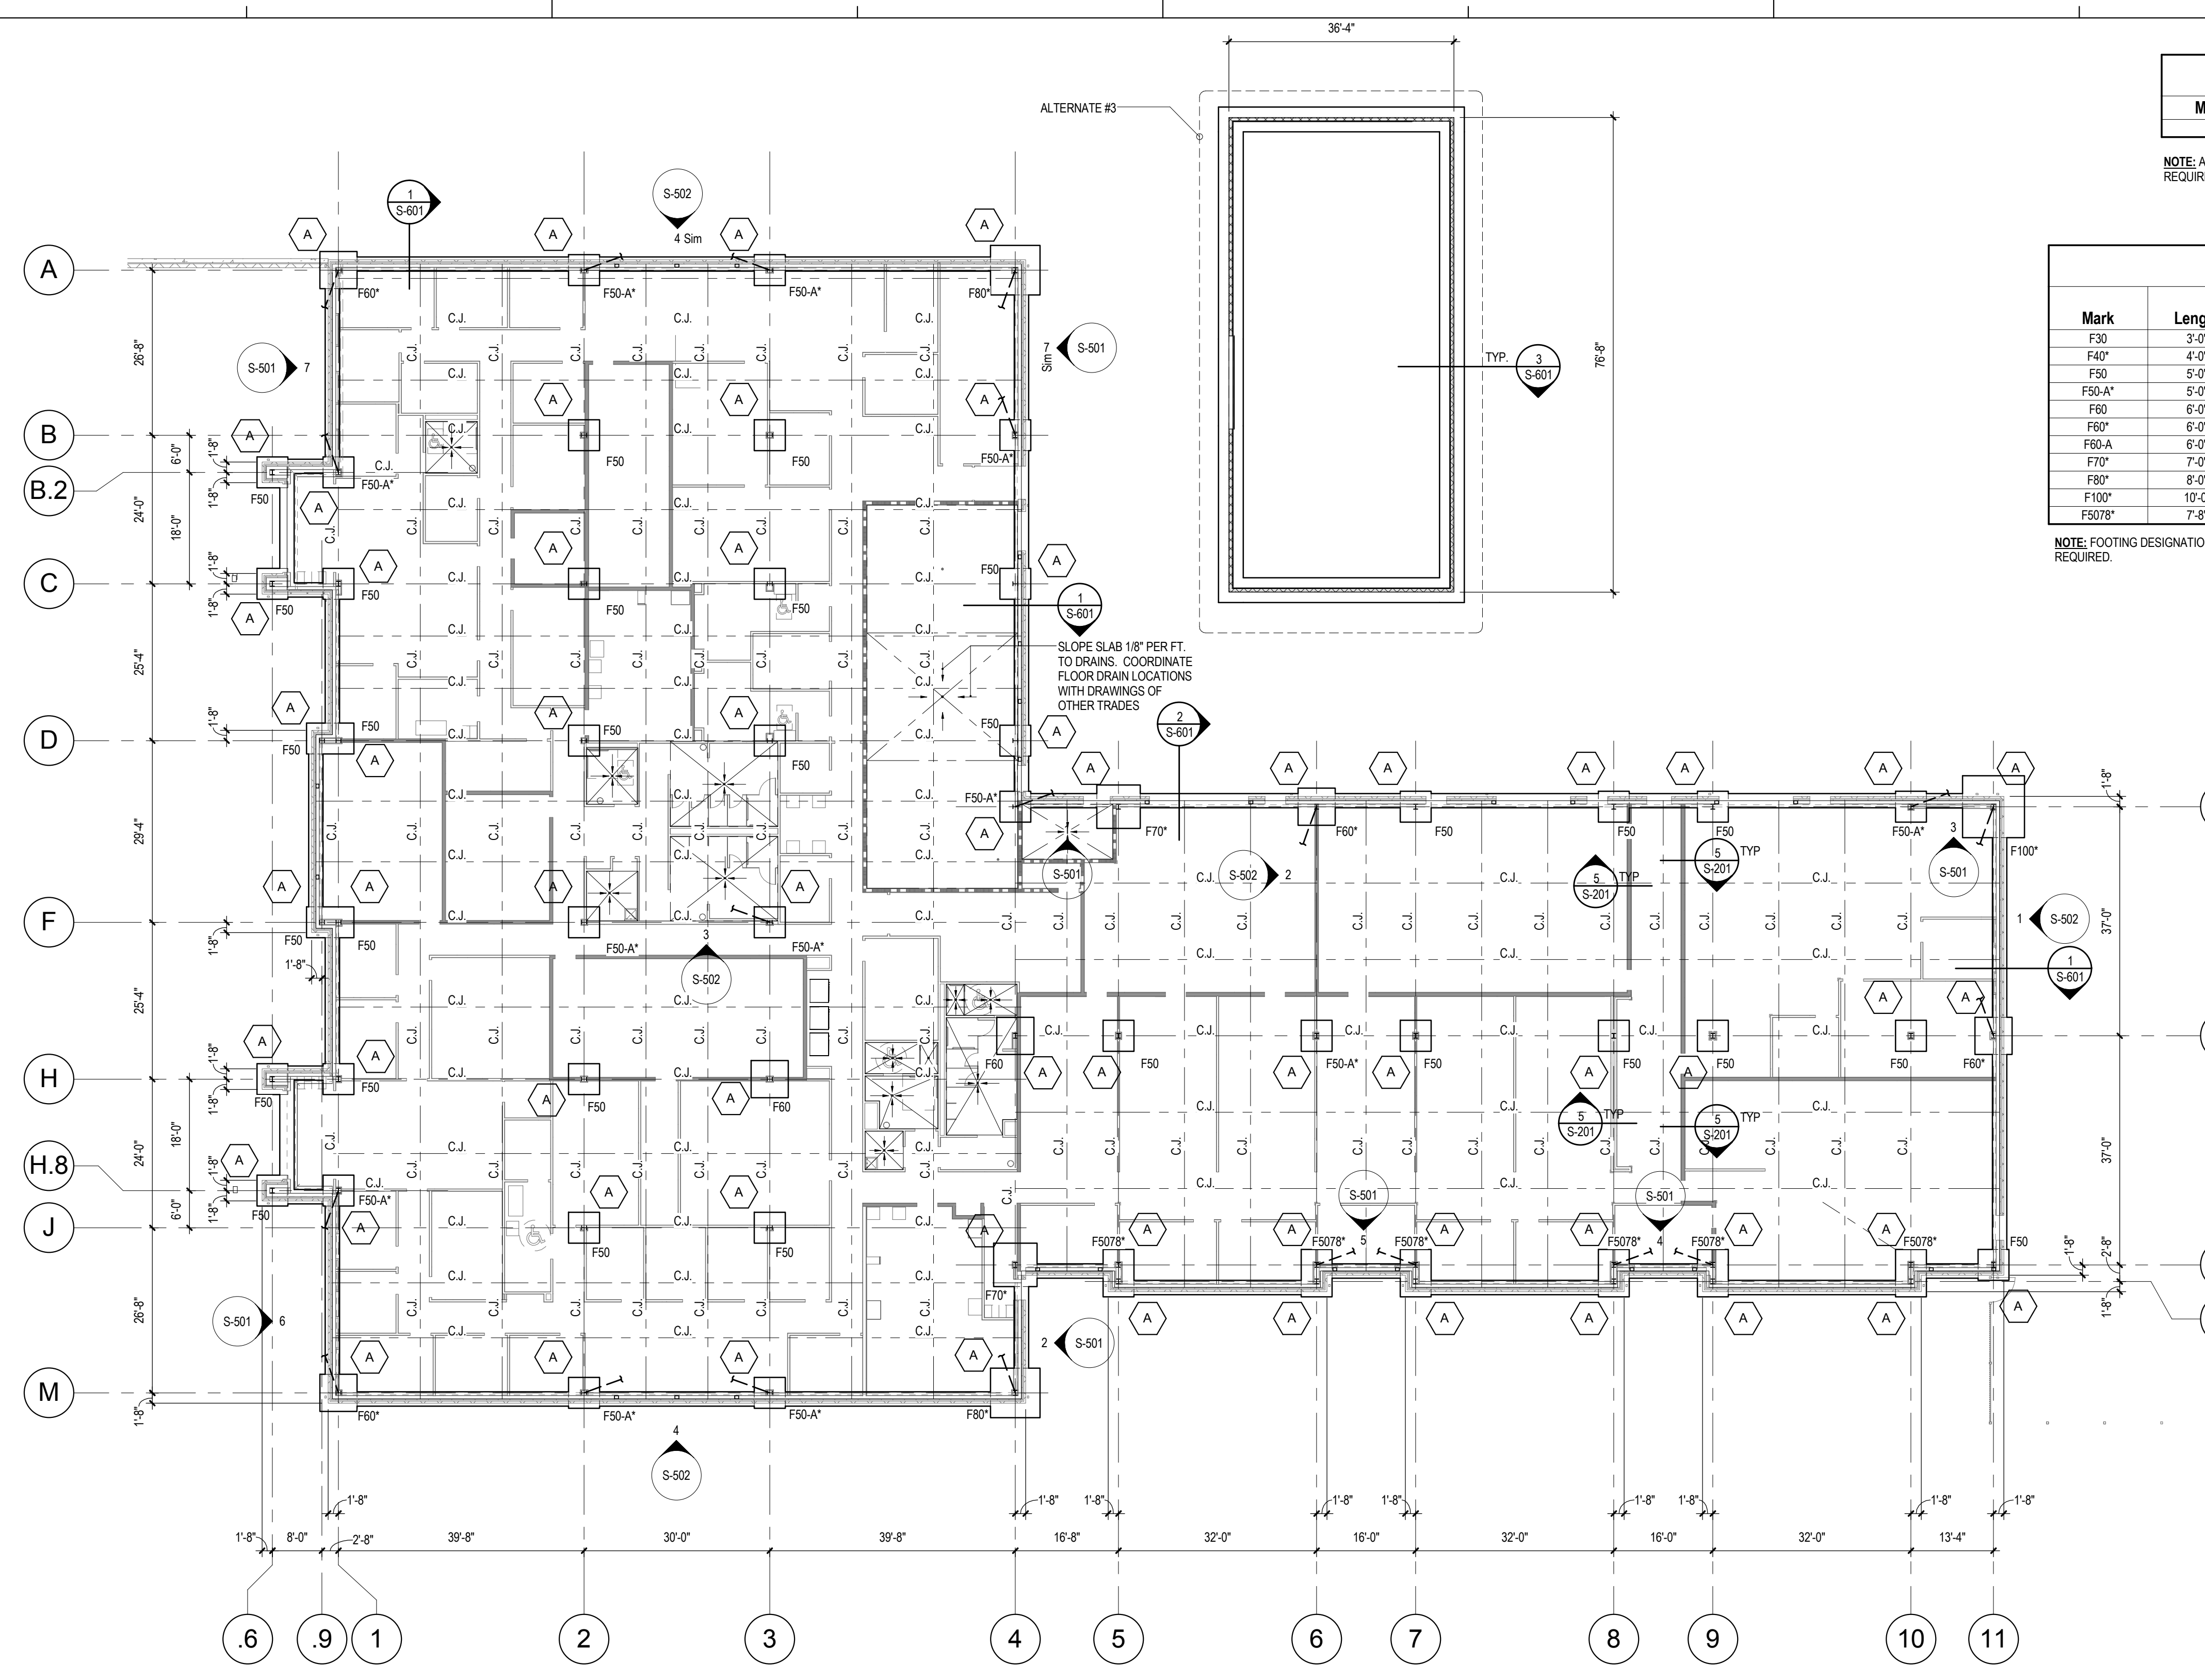


1 OFFICE/SHOPS BUILDING FOUNDATION PLAN
S-201
1/16" = 1'-0"

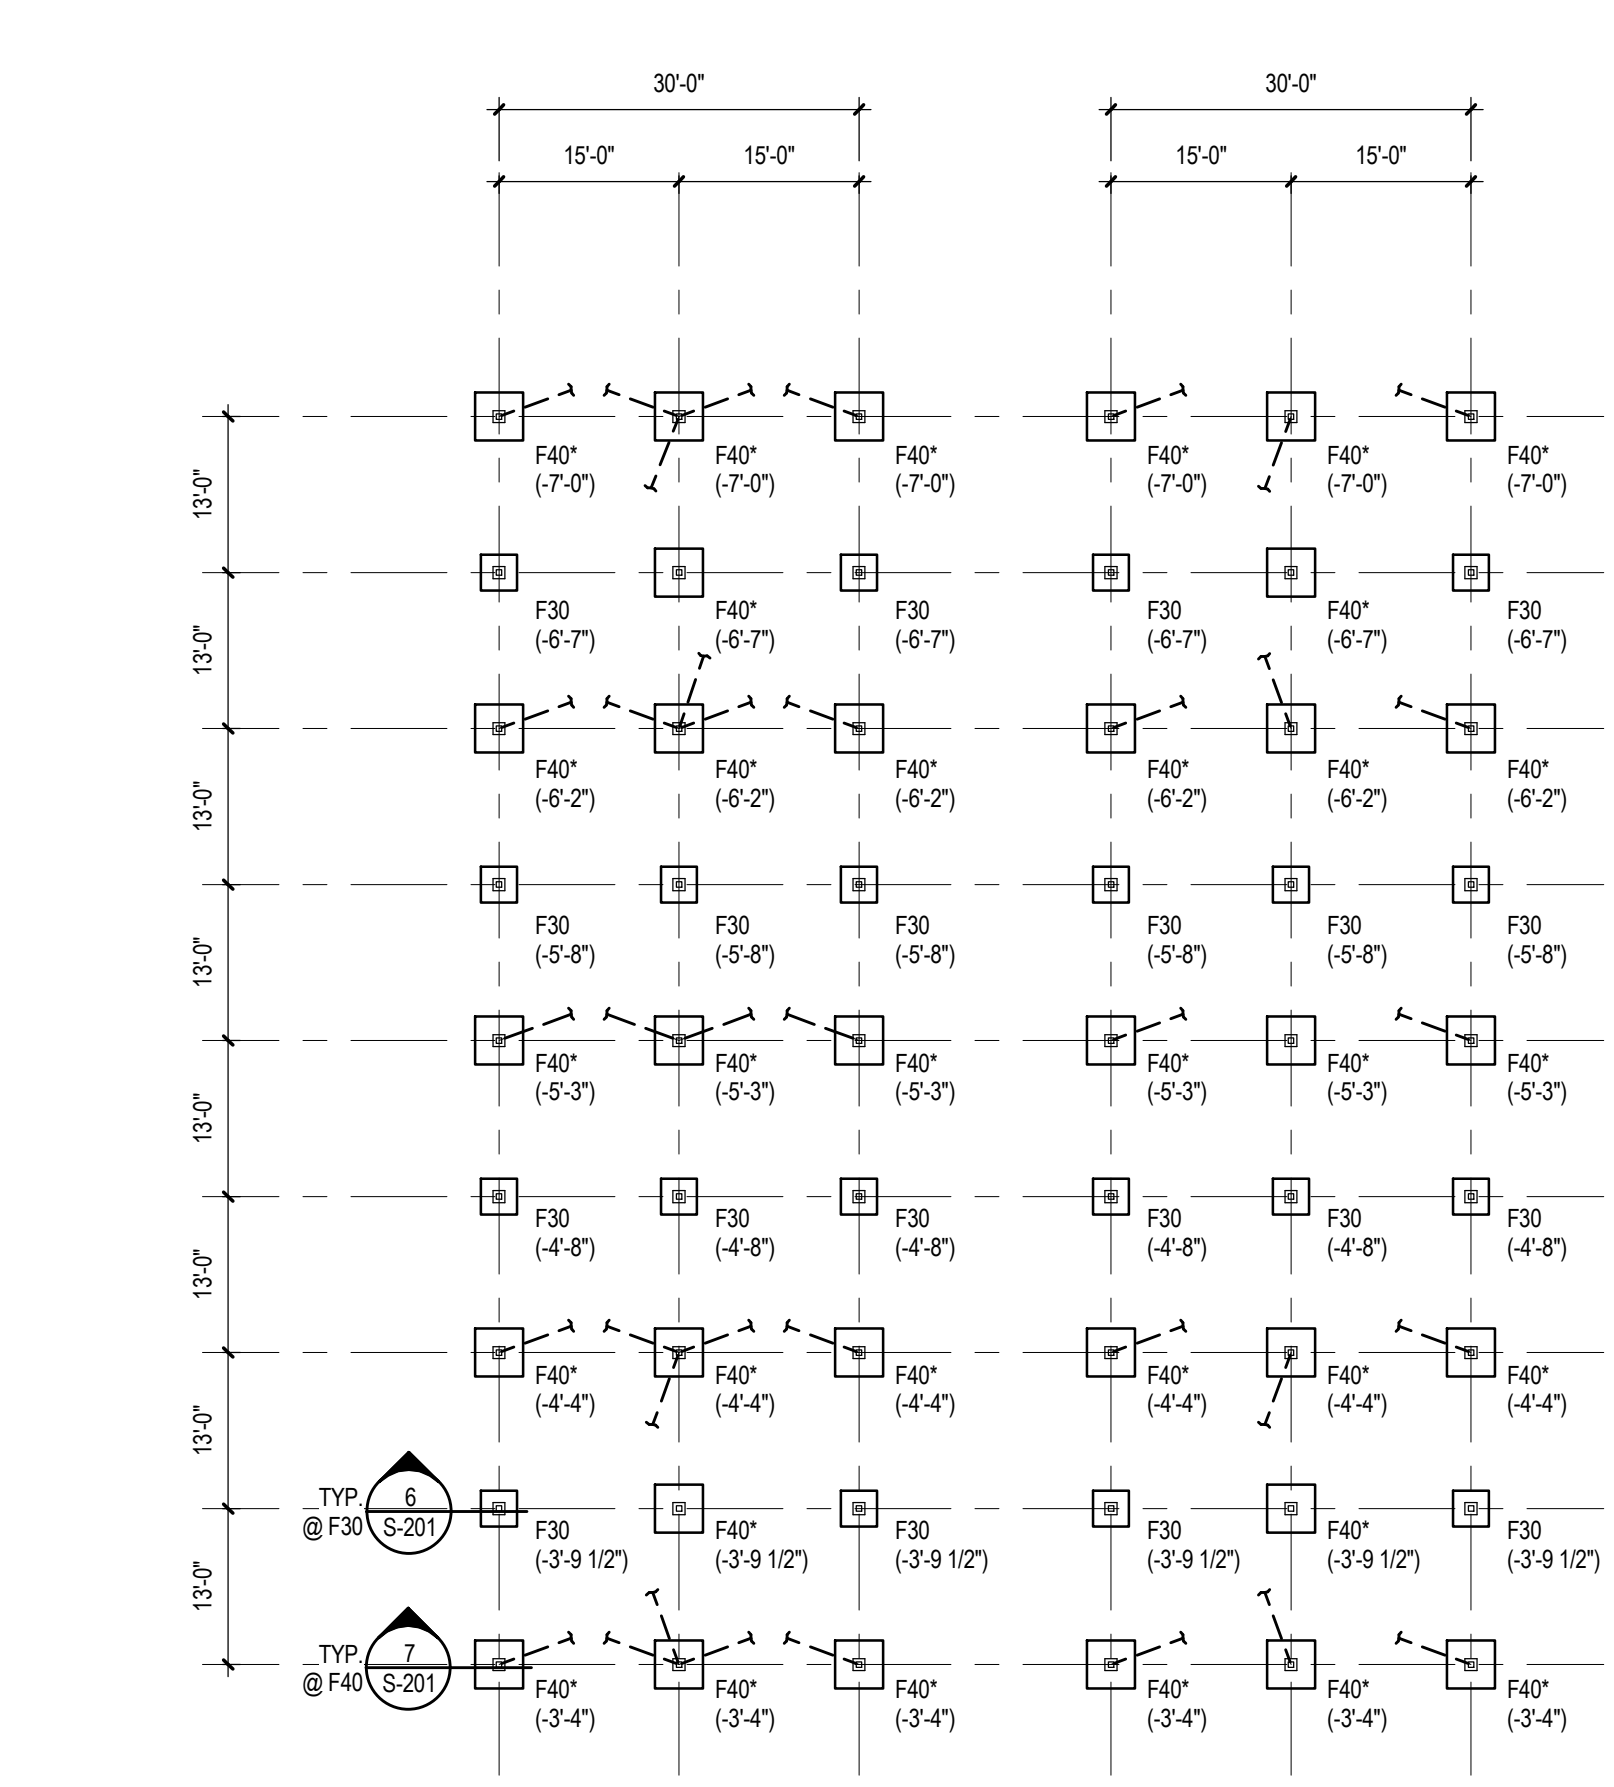


3 ELECTRIC CART CHARGING CANOPY FOUNDATION PLAN
S-201
1/16" = 1'-0"

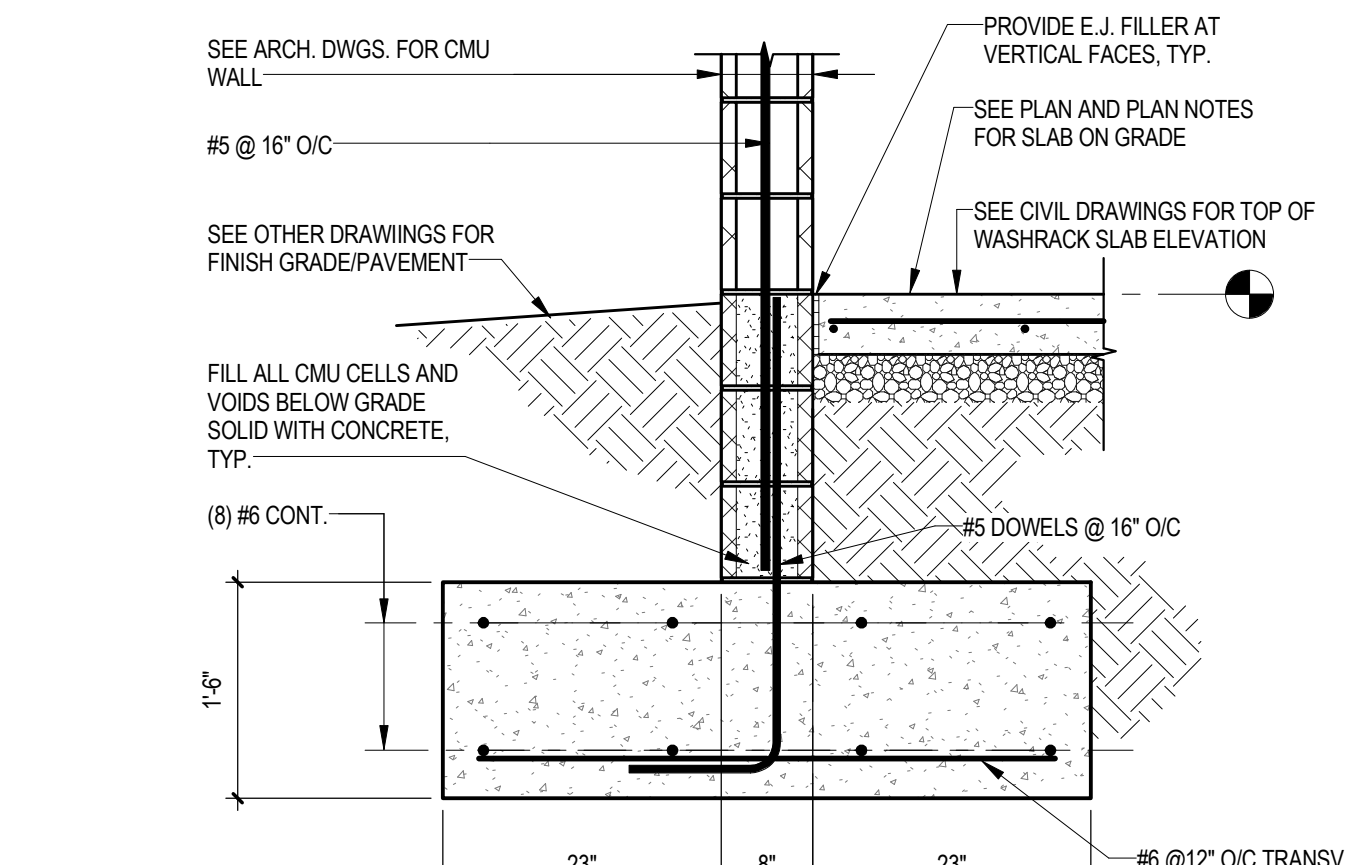


4 FOUNDATION SECTION - WASHRACK - ALTERNATE #2b
S-201
3/4" = 1'-0"

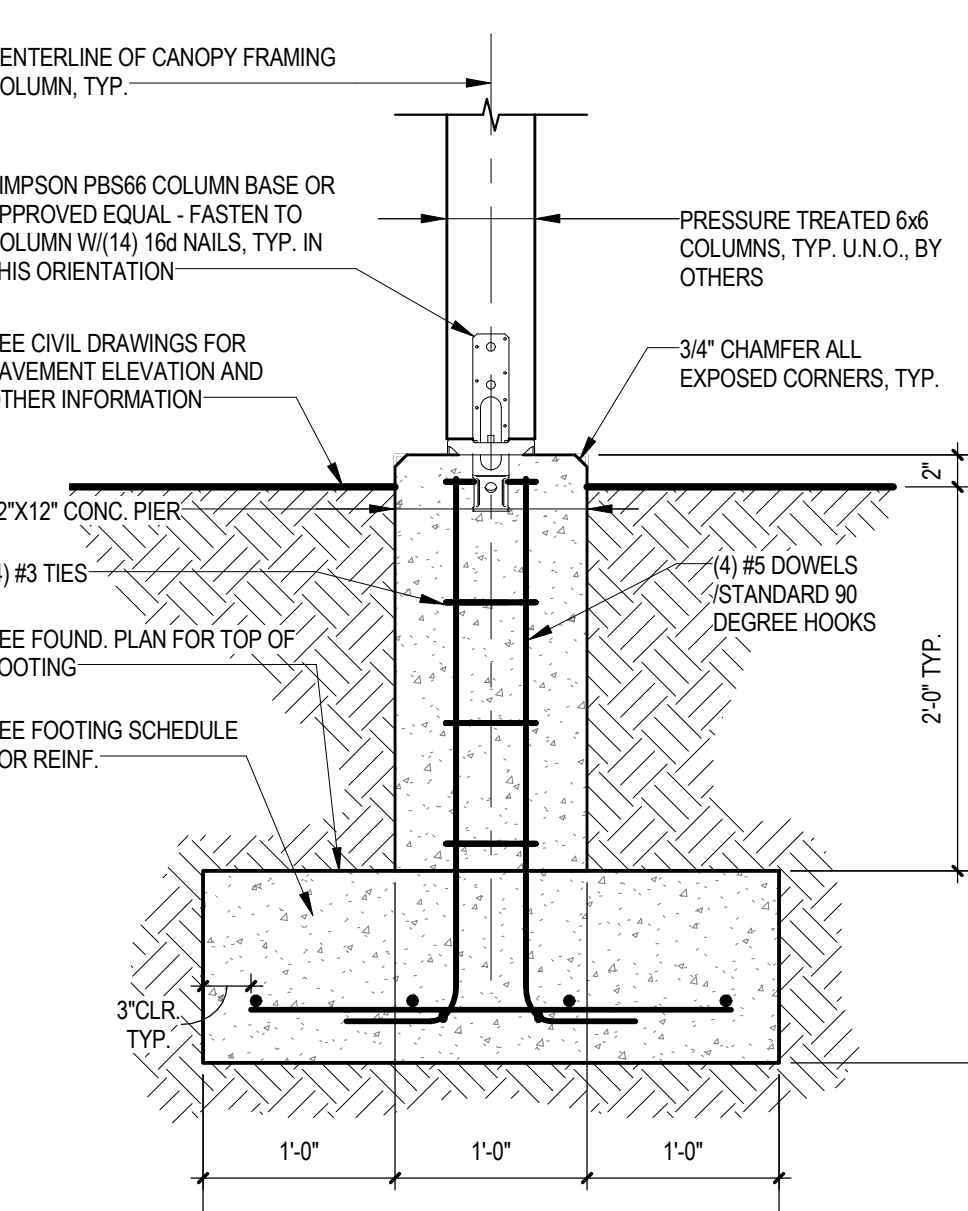


6 TYPICAL SECTION AT CANOPY FOOTING F30
S-201
1" = 1'-0"

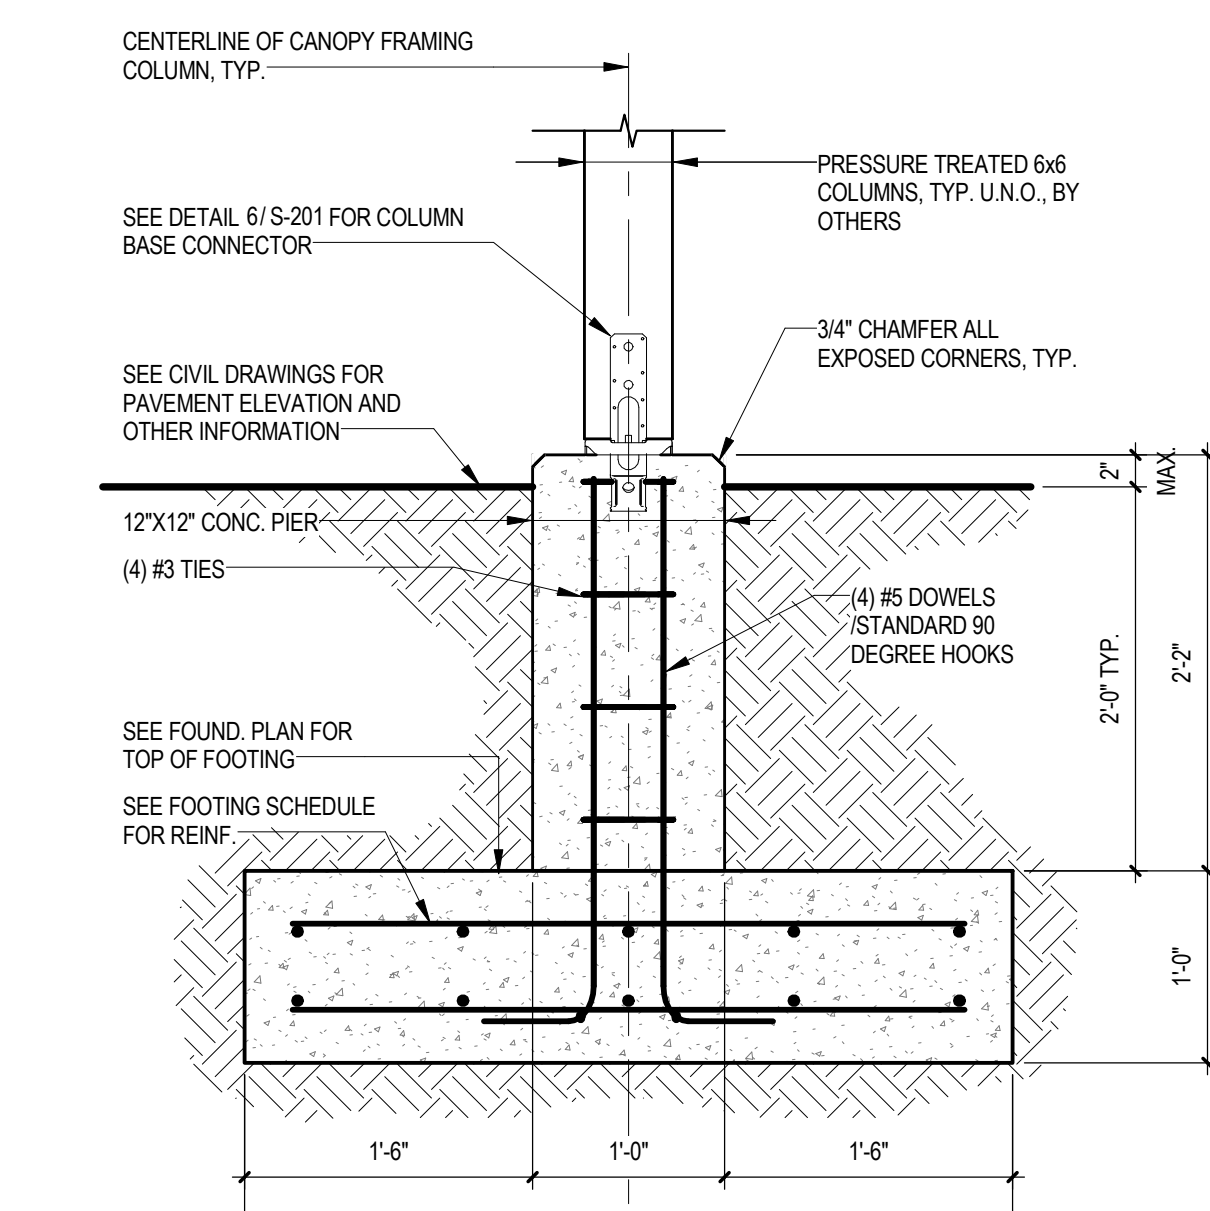


7 TYPICAL SECTION AT CANOPY FOOTING F40
S-201
1" = 1'-0"

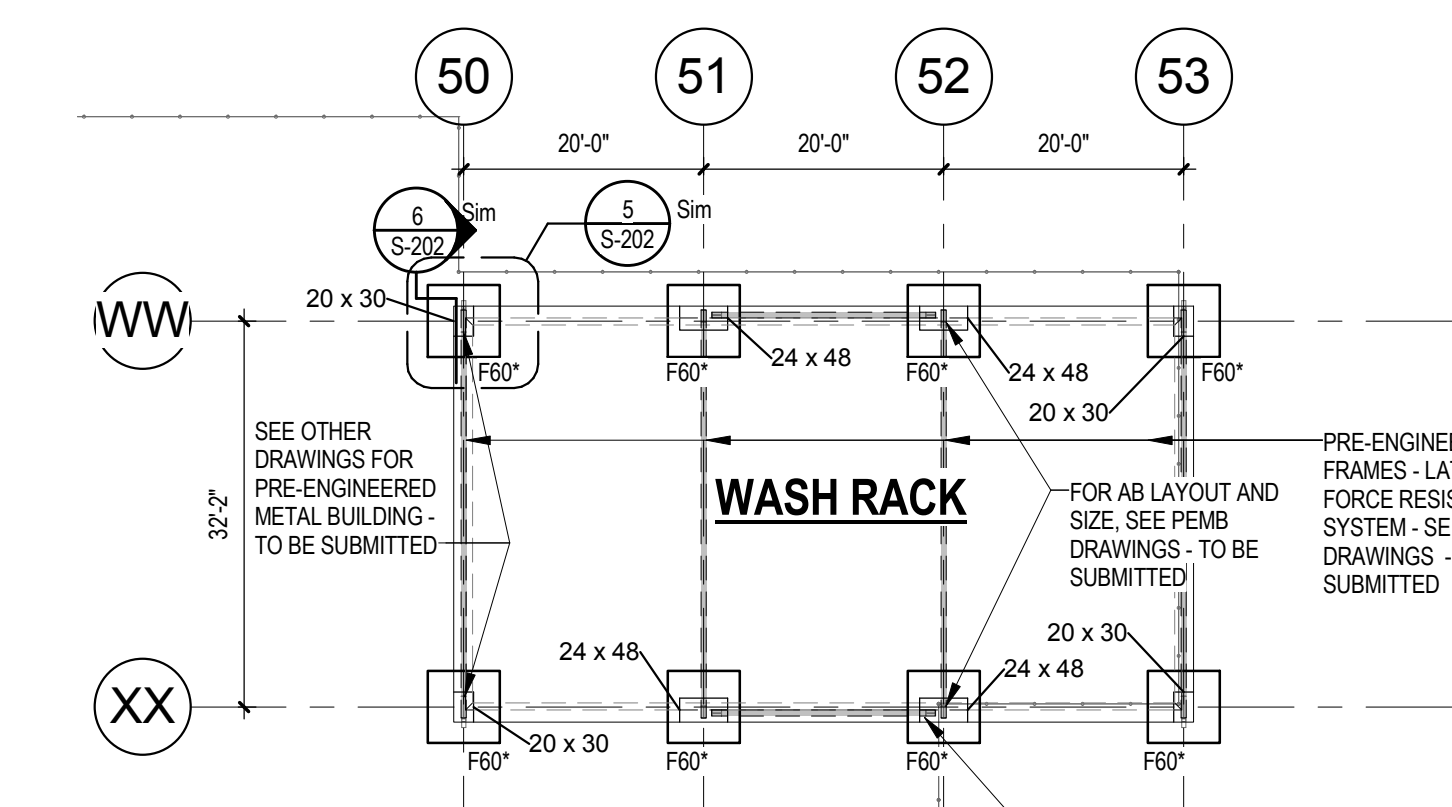


2a WASHRACK FOUNDATION - ALTERNATE #2a
S-201
1/16" = 1'-0"

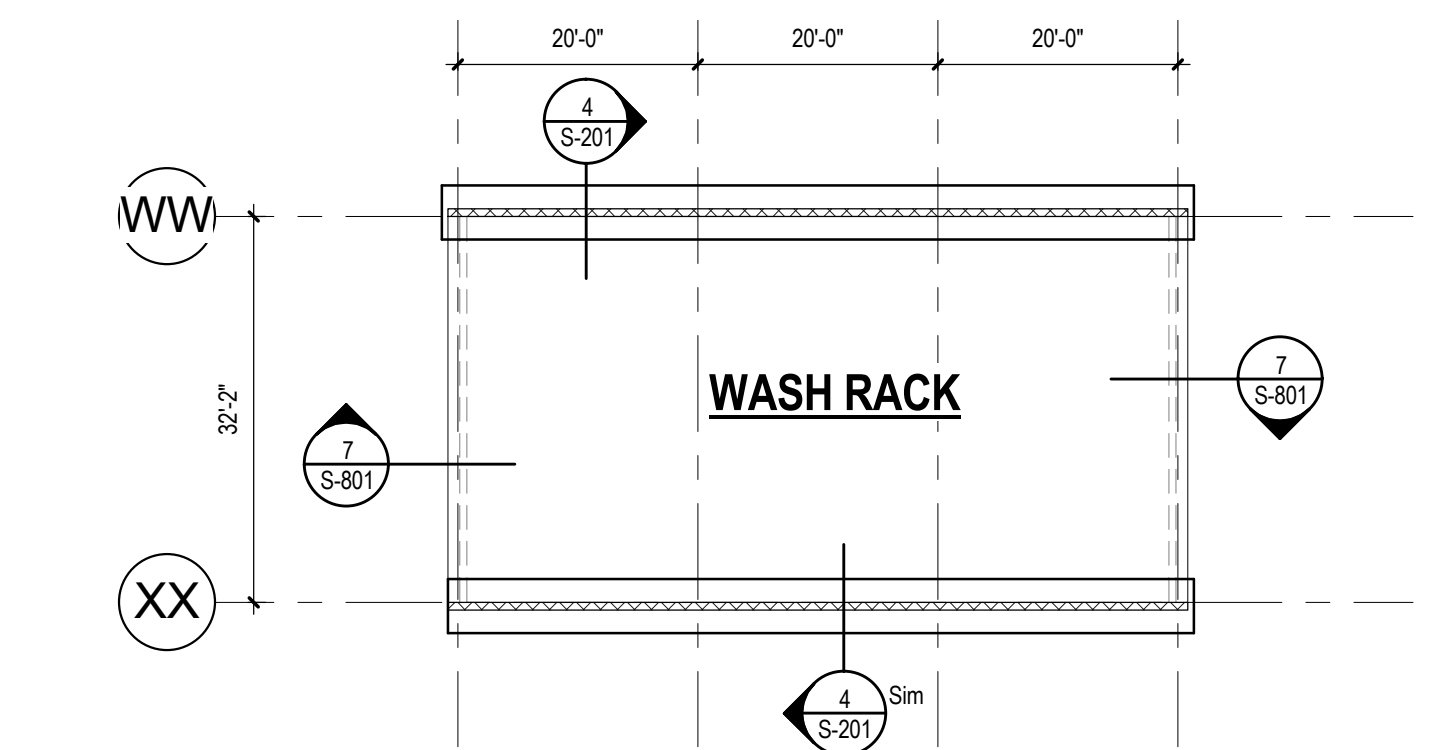


2b WASHRACK FOUNDATION - ALTERNATE #2b
S-201
1/16" = 1'-0"

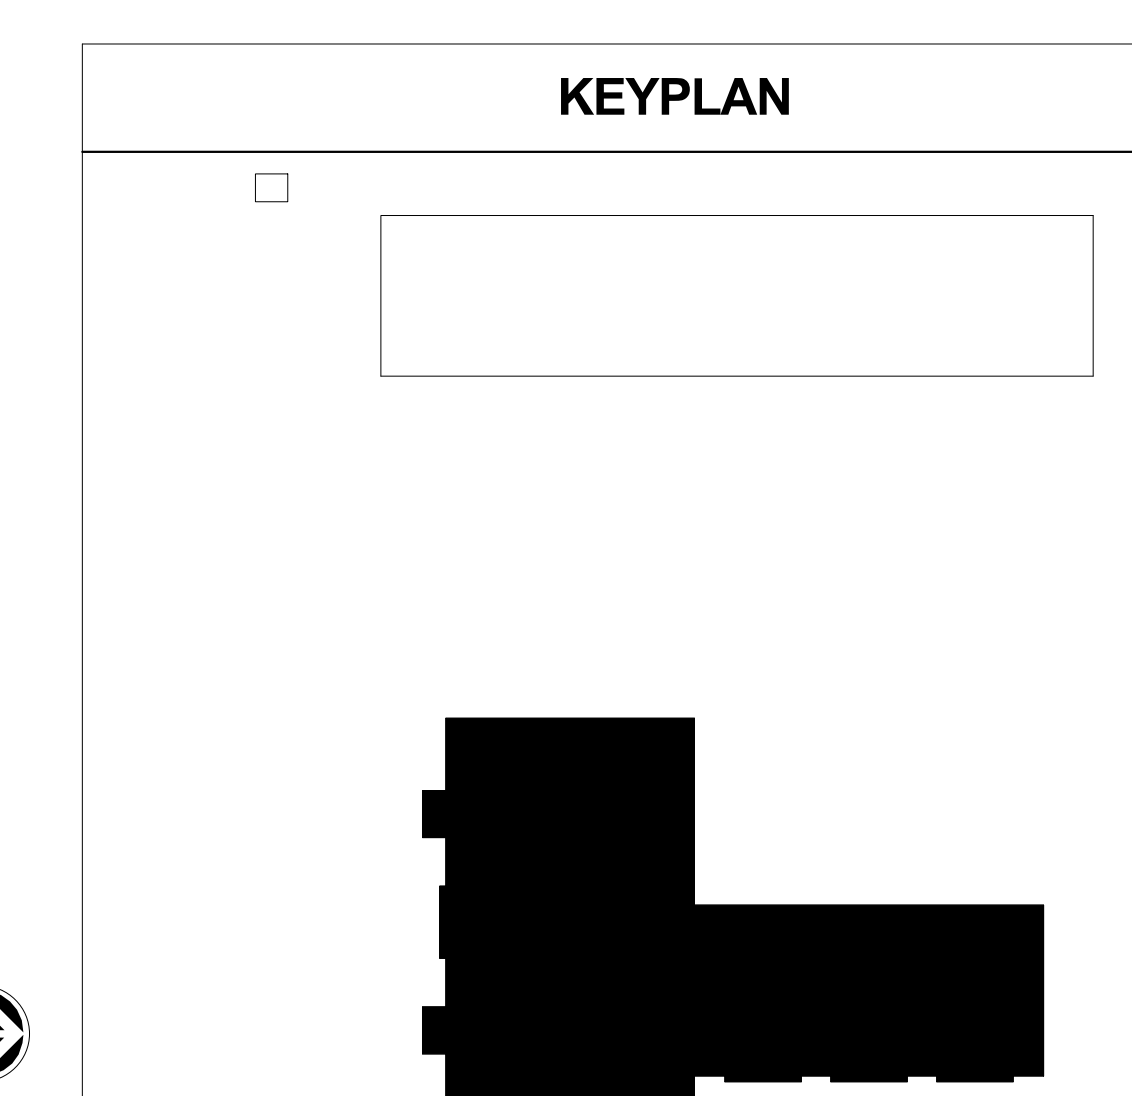


No.	Description	Date
1	ADDENDUM NO. 4	08/28/2017

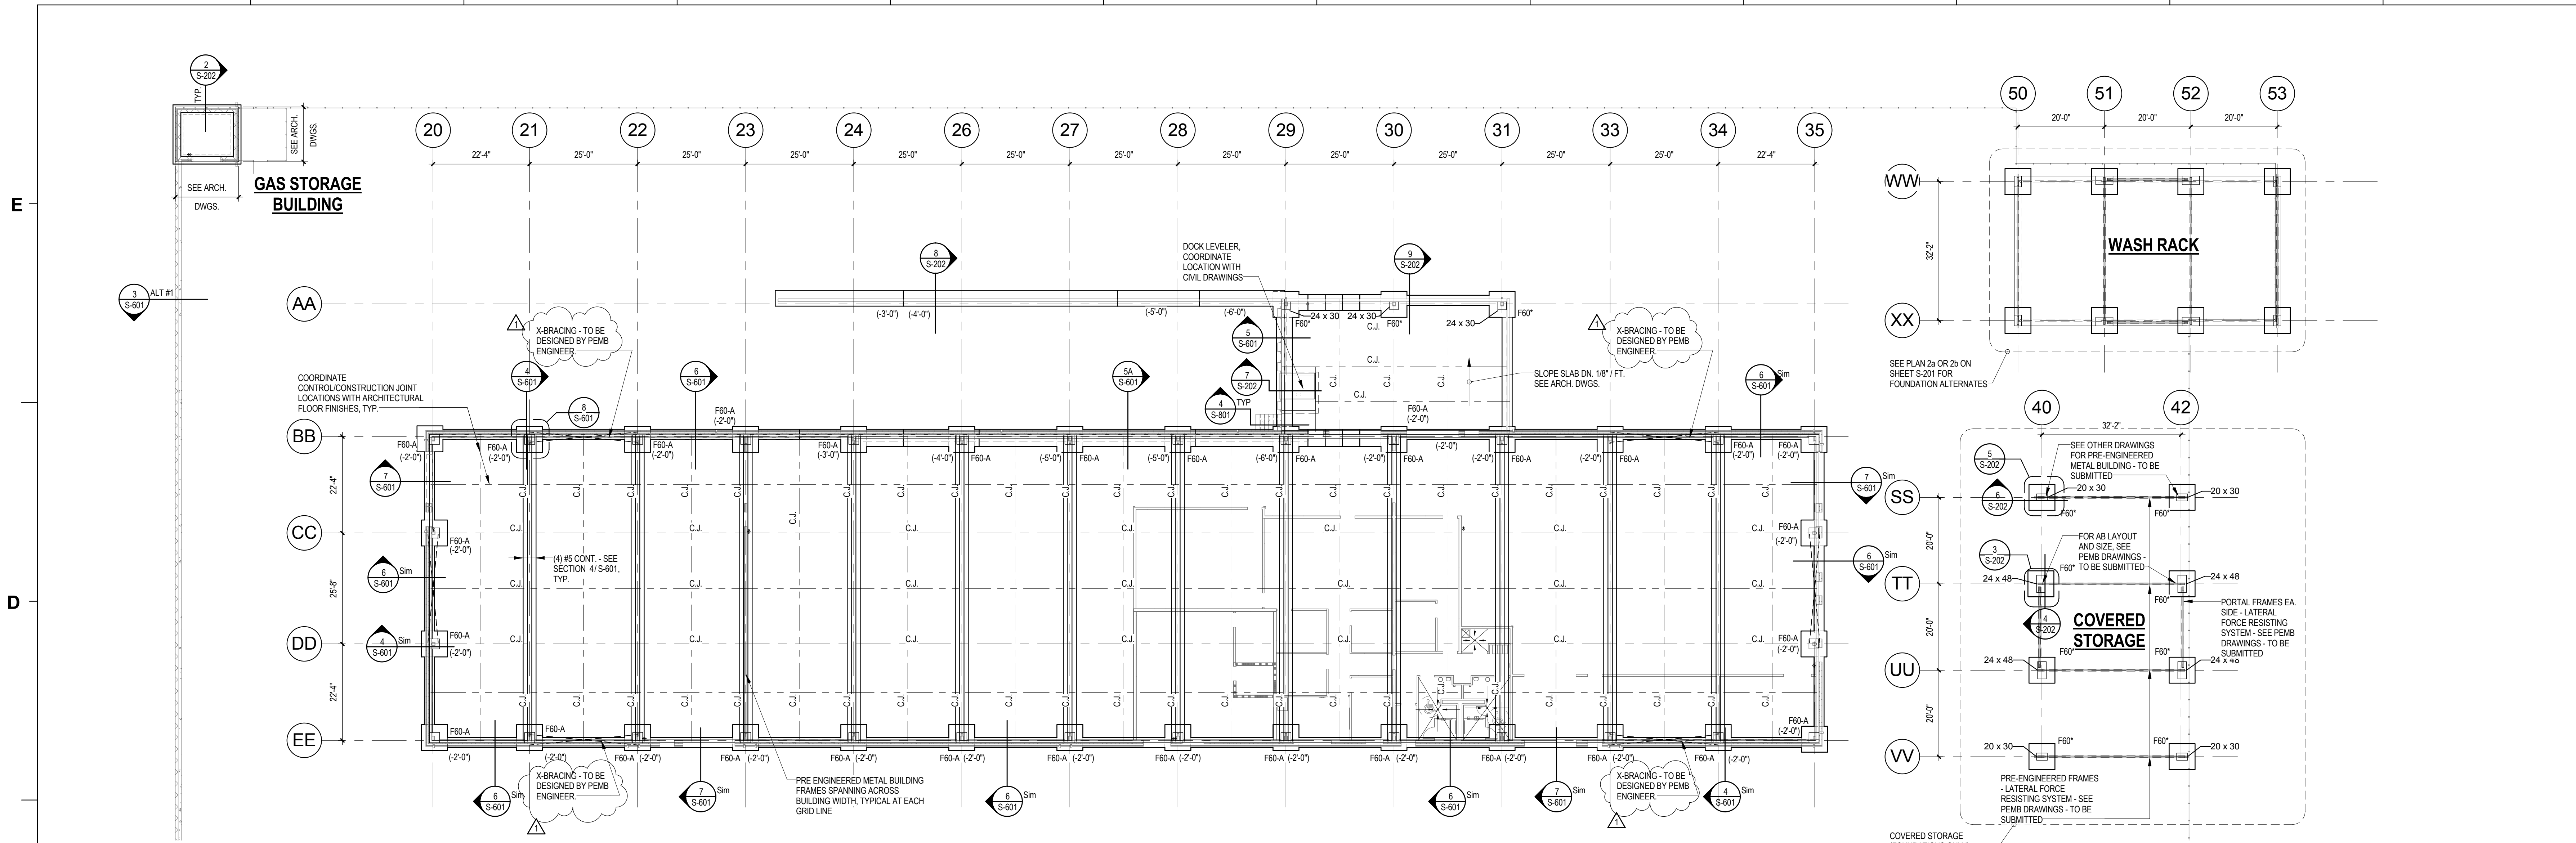


1 WAREHOUSE - PRE-ENGINEERED METAL BUILDING FOUNDATION PLAN
1/16" = 1'-0"

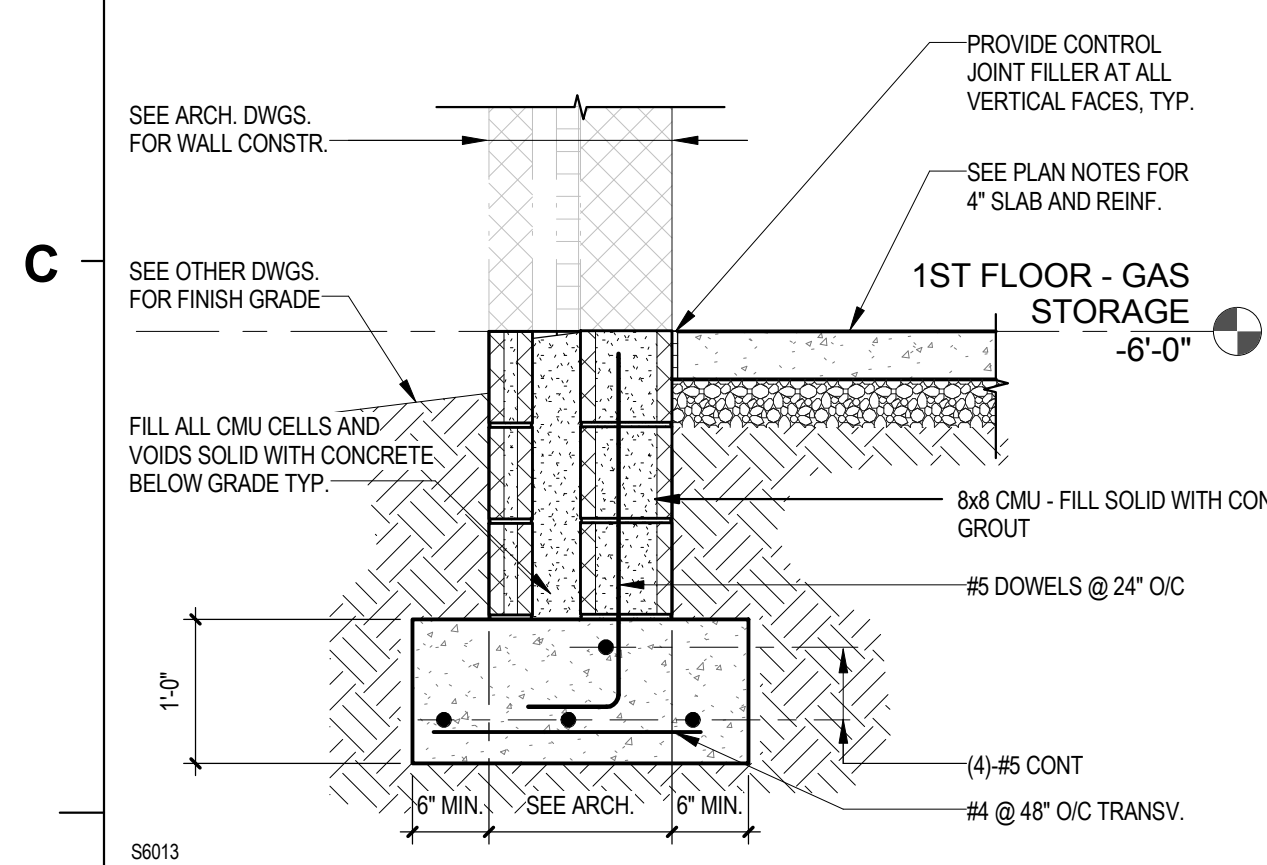


2 TYP. SECTION AT GAS STORAGE BLDG.
3/4" = 1'-0"

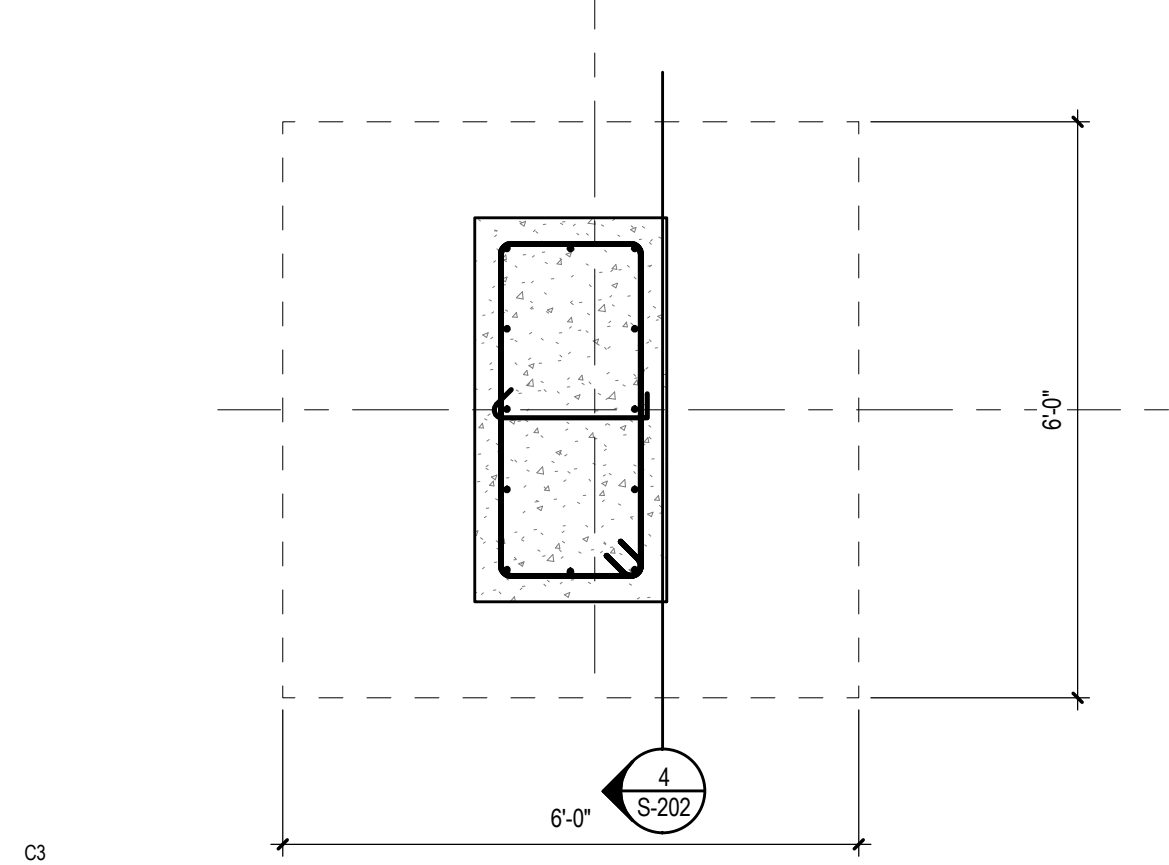


3 24"X48" CONCRETE PIER
1/2" = 1'-0"

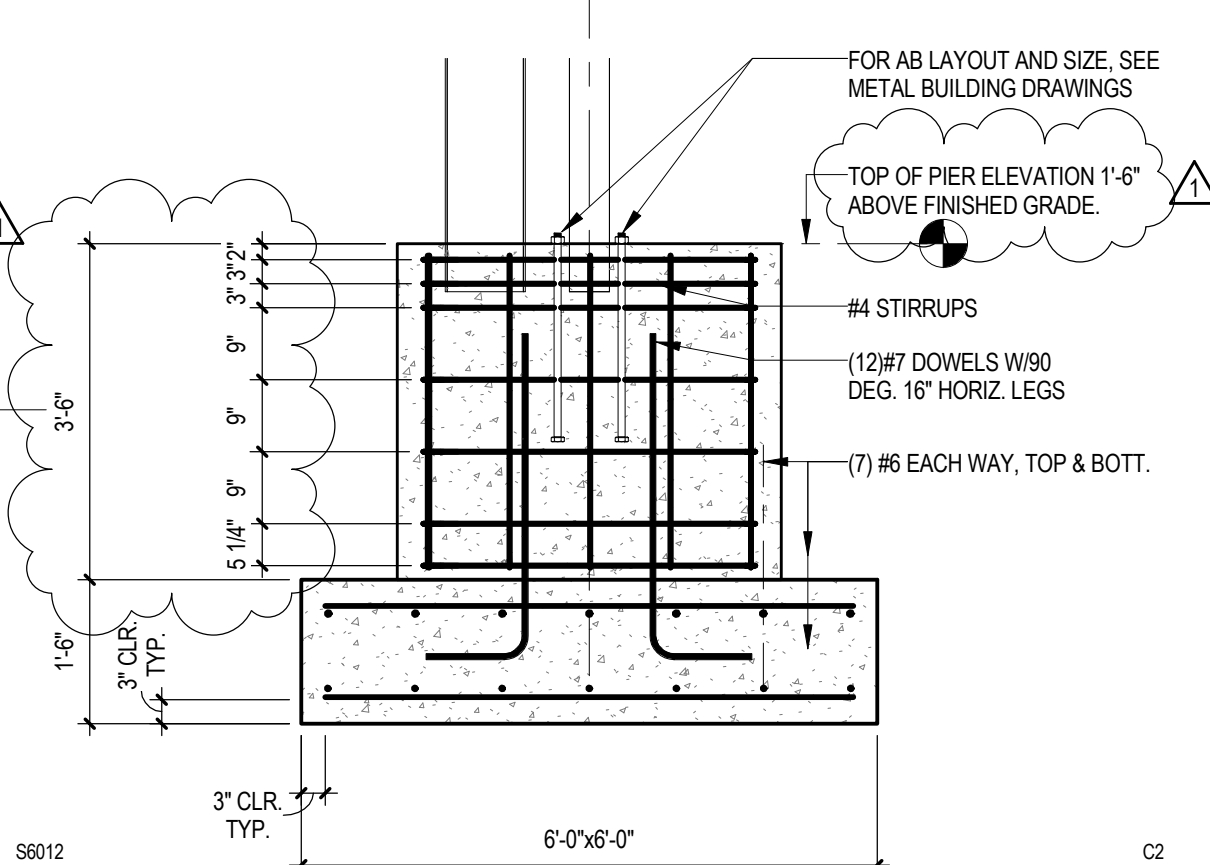

4 SECTION AT CONCRETE PIER
1/2" = 1'-0"

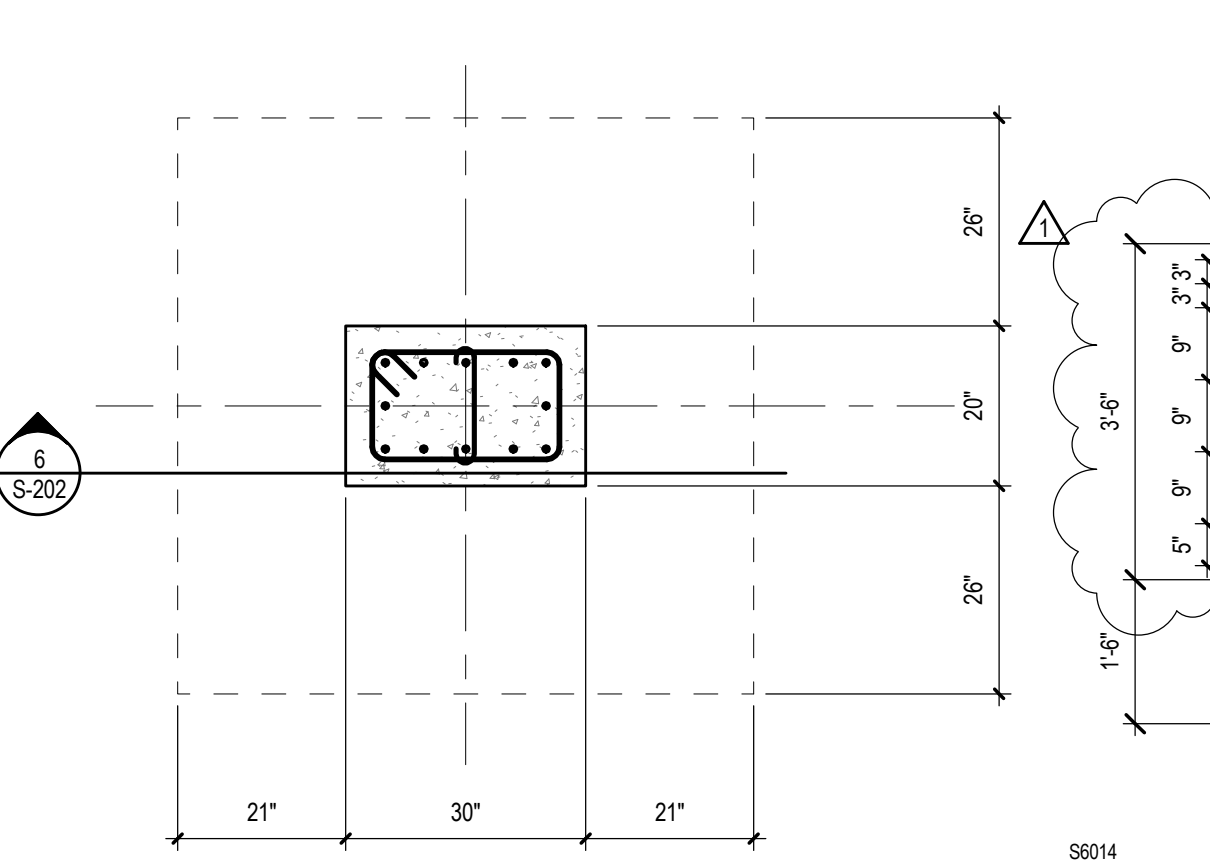

5 20"X30" CONCRETE PIER
1/2" = 1'-0"

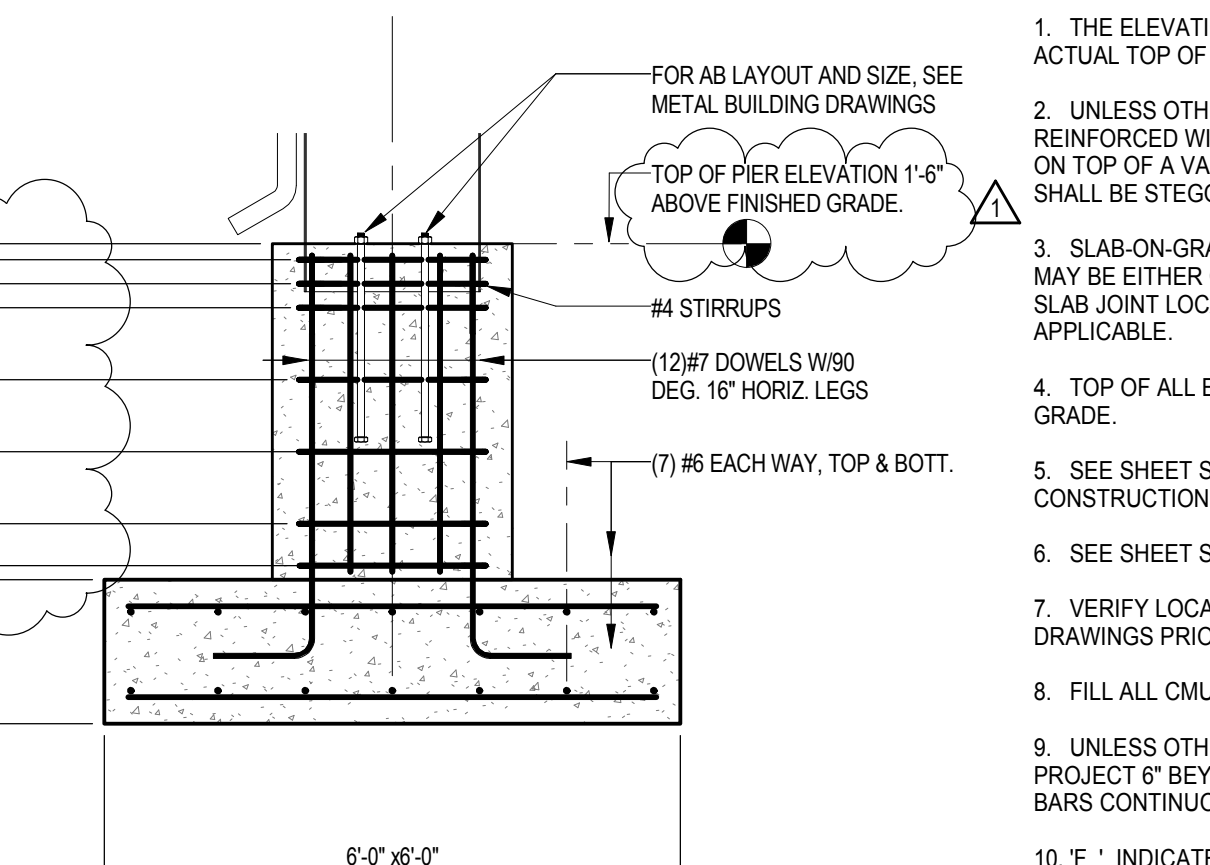

6 SECTION AT CONCRETE PIER
1/2" = 1'-0"

- FOUNDATION PLAN NOTES:**
- THE ELEVATION 0'-0" SHOWN ON PLAN IS FOR REFERENCE ONLY. SEE CIVIL DRAWINGS FOR ACTUAL TOP OF FINISH SLAB ELEVATIONS.
 - UNLESS OTHERWISE NOTED, THE SLAB-ON-GRADE IS TO BE 7-INCH THICK CONCRETE SLAB REINFORCED WITH #4 @ 16" O.C. EACH WAY. PLACED 1-INCH CLEAR FROM TOP. PLACE SLAB DIRECTLY ON TOP OF A VAPOR BARRIER AND OVER 4-INCHES OF CLEAN WASHED STONE. VAPOR BARRIER SHALL BE STEGO WRAP 15-MILS THICK AS MANUFACTURED BY STEGO INDUSTRIES (OR EQUAL).
 - SLAB-ON-GRADE CONTROL JOINTS ARE INDICATED ON PLAN WITH THE SYMBOL 'C.J.'. THESE JOINTS MAY BE EITHER CONSTRUCTION JOINTS OR SAWCUT JOINTS. SEE TYPICAL DETAILS. COORDINATE ALL SLAB JOINT LOCATIONS WITH JOINTS IN ARCHITECTURAL FLOOR FINISHES TO ASSURE ALIGNMENT IS APPLICABLE.
 - TOP OF ALL EXTERIOR FOOTINGS ARE TO BE A MINIMUM OF 2'-0" BELOW FINISHED EXTERIOR GRADE.
 - SEE SHEET S101 FOR GENERAL NOTES AND NOTES PERTAINING TO FOUNDATION DESIGN AND CONSTRUCTION.
 - SEE SHEET S801 FOR TYPICAL DETAILS.
 - VERIFY LOCATION AND SIZE OF WALLS SHOWN ON THE FOUNDATION PLAN WITH ARCHITECTURAL DRAWINGS PRIOR TO CONSTRUCTION.
 - FILL ALL CMU CELLS BELOW GRADE WITH CONCRETE GROUT.
 - UNLESS OTHERWISE INDICATED ON PLAN OR IN DETAILS, ALL WALL FOOTINGS SHALL BE 12" DEEP. PROJECT 6" BEYOND EACH FACE OF THE WALL SUPPORTED AND SHALL BE REINFORCED WITH (2)#6 BARS CONTINUOUS LONGITUDINALLY.
 - "F." INDICATES A CONCRETE FOOTING. SEE FOOTING SCHEDULE.
 - "C." INDICATES A STEEL COLUMN. SEE COLUMN SCHEDULE.
 - FOUNDATION DESIGN SHOWN FOR PREFABRICATED METAL BUILDING SHALL BE USED FOR BASE BID. FINAL DESIGN OF FOUNDATION WILL BE PROVIDED AFTER RECEIVING COLUMN ANCHOR BOLT SETTING PLAN AND FINAL COLUMN REACTIONS FROM THE CONTRACTED METAL BUILDING SUPPLIER. REFER TO METAL BUILDING SYSTEMS SPECIFICATION SECTION FOR ADDITIONAL REQUIREMENTS.
 - "P." INDICATES A CONCRETE PIER. SEE DETAILS ON S801.
 - ">" INDICATES TOP OF CONCRETE-PIER ELEVATION.
 - COORDINATE THE ELEVATIONS OF ALL FOOTINGS WITH RESPECT TO UNDERGROUND UTILITIES. STEP AS REQUIRED TO AVOID FOULING WITH UTILITIES AND TO ALLOW UTILITIES TO PASS OVER FOOTINGS. PROVIDE A STEEL SLEEVE THROUGH WALL FOR PIPE TO PASS THROUGH. REFER TO MEP AND PP DRAWINGS FOR UTILITIES AND INVERTS. SEE TYPICAL STEPPED FOOTING DETAIL.


COLUMN SCHEDULE SEE DETAILS

Mark	Type	Base Plate	Cap Plate	Comments
A	W10X33	3/4" x SIZE TO SUIT		


FOOTING SCHEDULE

Mark	Length	Width	Sq Footing Thickness	TOP REINFORCING	BOTTOM REINFORCING	Comments
F30	3'-0"	3'-0"	1'-0"			(4) #4 E.W.
F40	4'-0"	4'-0"	1'-0"	(5) #5 E.W.	(5) #5 E.W.	(5) #5 E.W.
F50	5'-0"	5'-0"	1'-4"	(6) #5 E.W.	(6) #5 E.W.	(6) #5 E.W.
F50-A	5'-0"	5'-0"	1'-6"	(6) #5 E.W.	(6) #5 E.W.	(6) #5 E.W.
F60	6'-0"	6'-0"	1'-6"	(7) #5 E.W.	(7) #5 E.W.	(7) #5 E.W.
F60*	6'-0"	6'-0"	1'-6"	(7) #5 E.W.	(7) #5 E.W.	(7) #5 E.W.
F60-A	6'-0"	6'-0"	2'-0"	(7) #5 E.W.	(7) #5 E.W.	(7) #5 E.W.
F70	7'-0"	7'-0"	1'-6"	(8) #5 E.W.	(8) #5 E.W.	(8) #5 E.W.
F80*	8'-0"	8'-0"	1'-6"	(9) #5 E.W.	(9) #5 E.W.	(9) #5 E.W.
F100*	10'-0"	10'-0"	1'-6"	(11) #5 E.W.	(11) #5 E.W.	(11) #5 E.W.
F5078*	7'-8"	5'-0"	1'-8"	#5@8" O.C. E.W.	#6@8" O.C. E.W.	


NOTE: FOOTING DESIGNATION ON PLAN WITH "*" SHALL INCLUDE TOP REINFORCING STEEL. ALL OTHER FOOTINGS, TOP REINFORCING NOT REQUIRED.

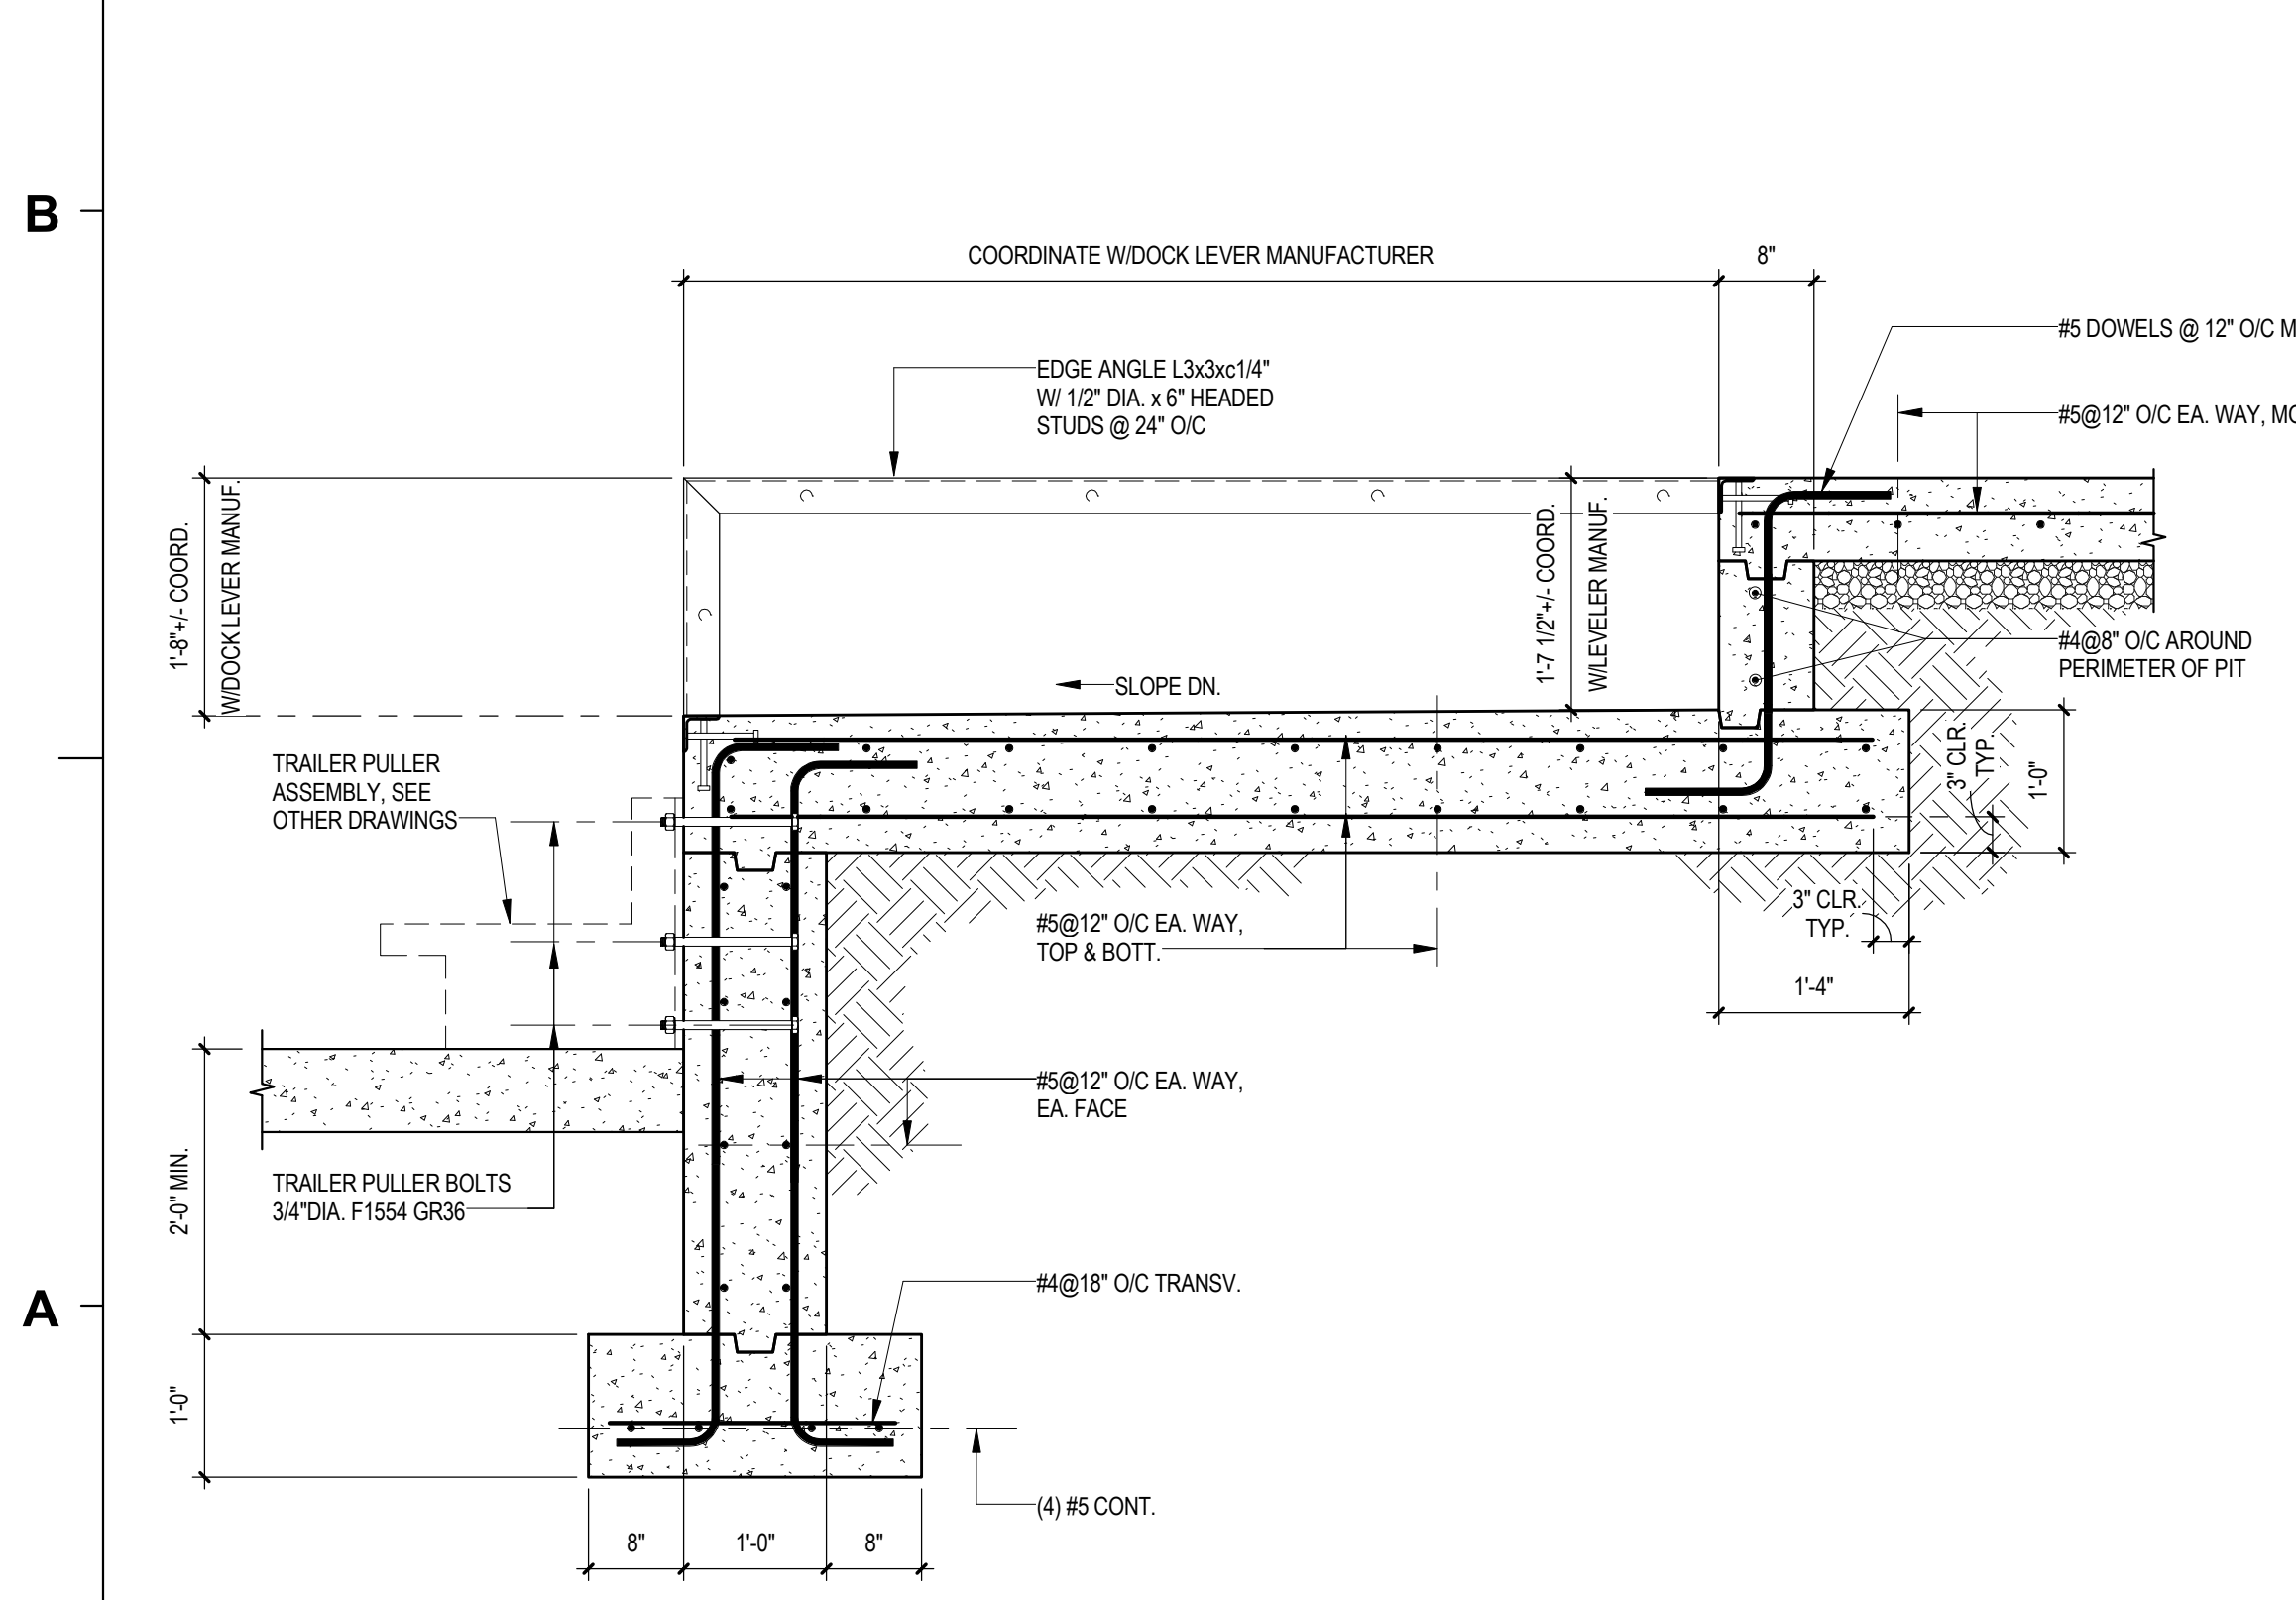


7 SECTION AT DOCK LEVELER
3/4" = 1'-0"

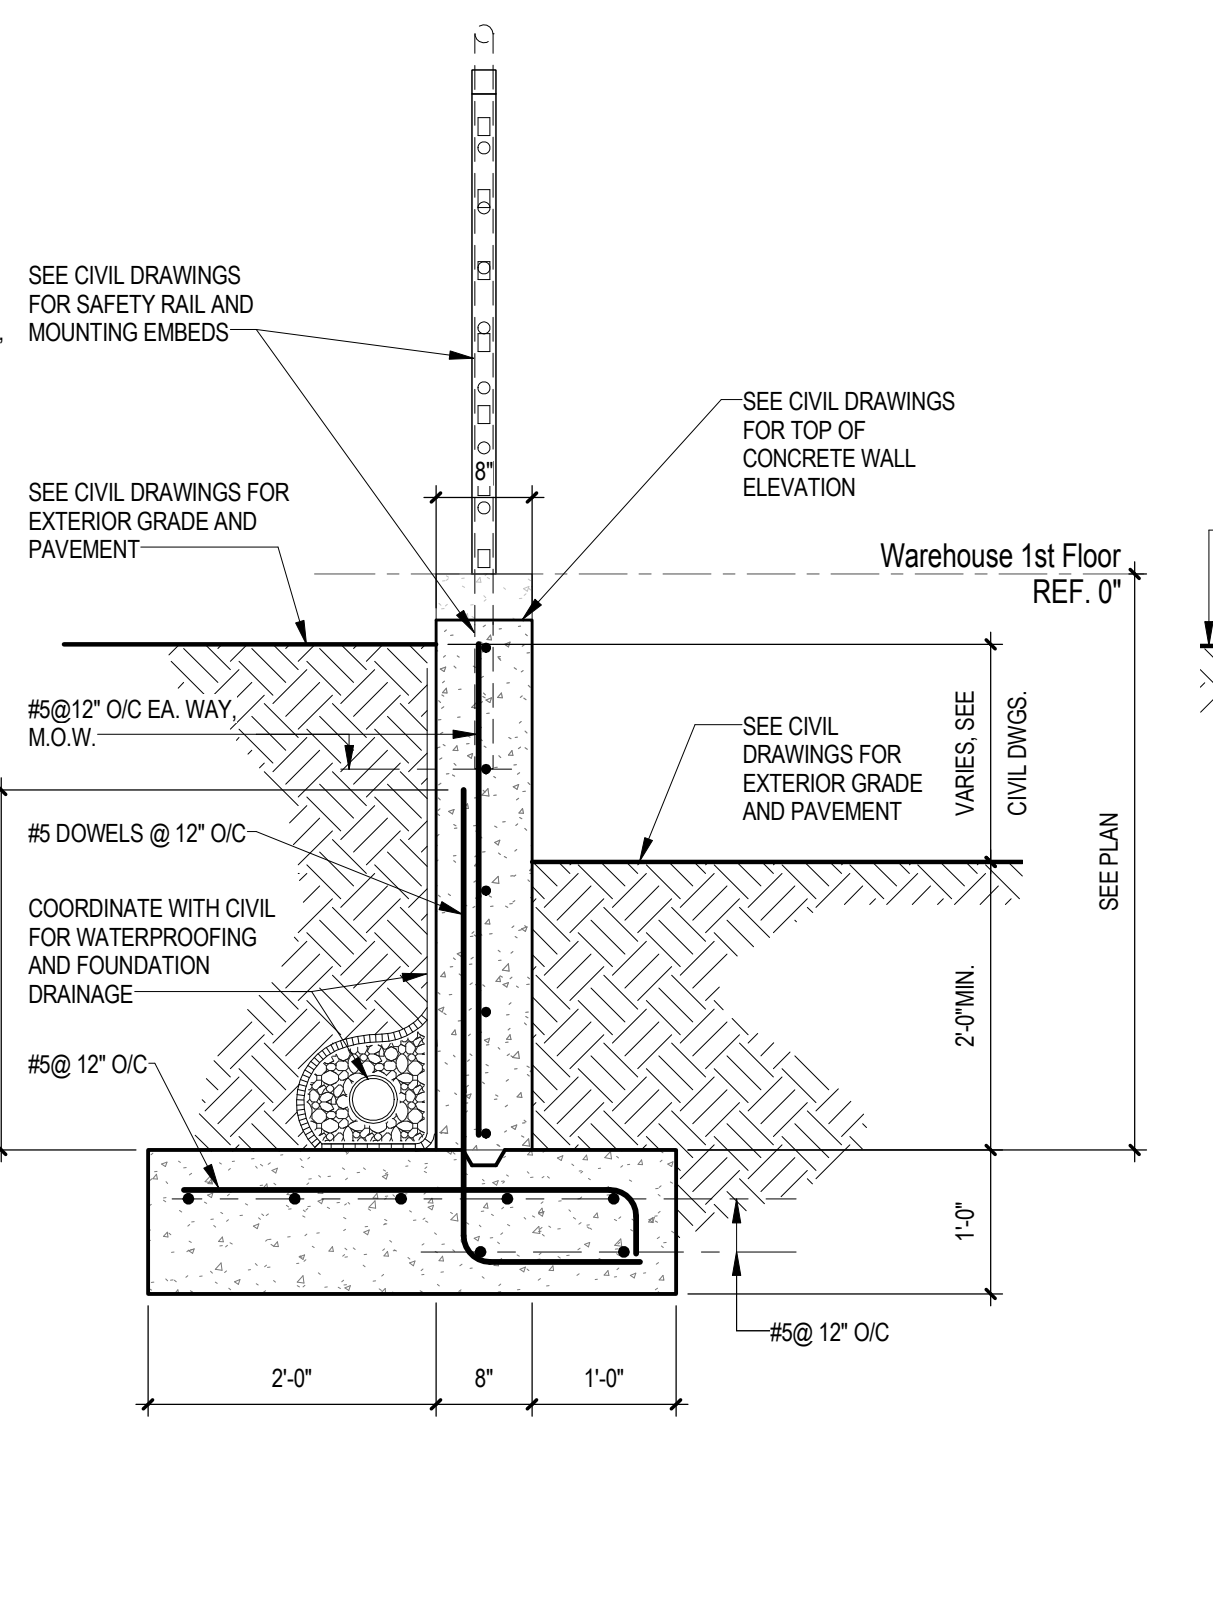

8 SECTION AT LOADING DOCK WALL
3/4" = 1'-0"

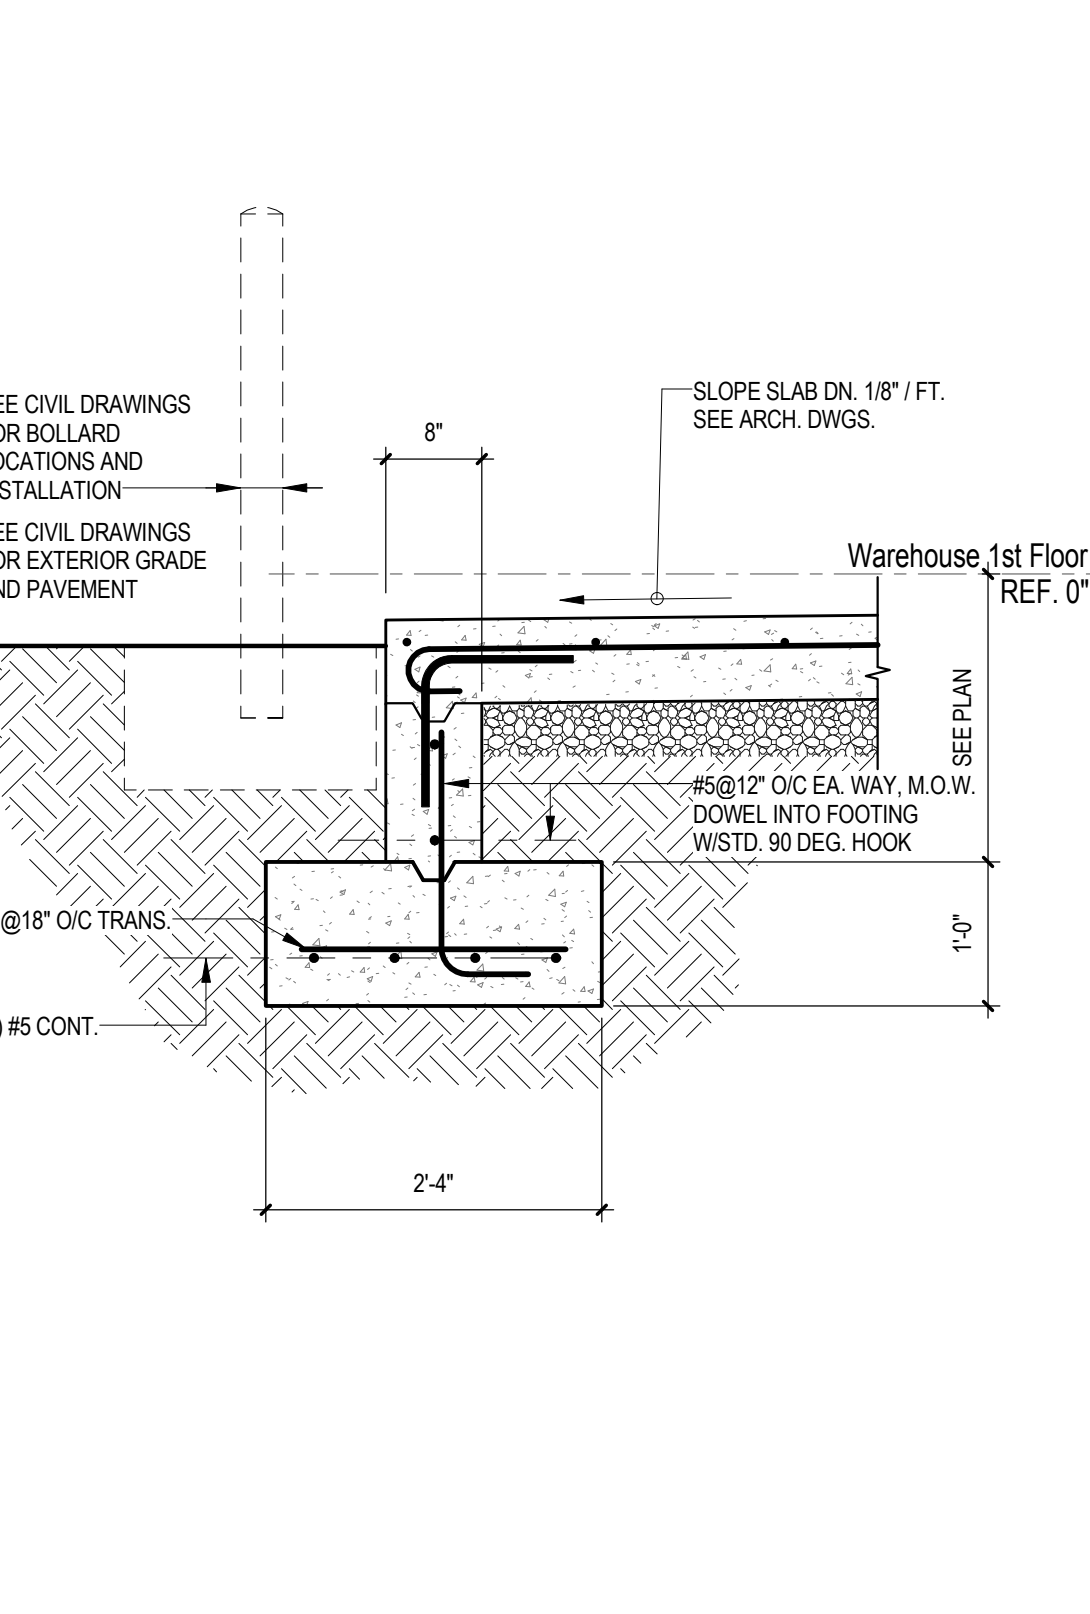

9 SECTION AT LOADING DOCK WALL
3/4" = 1'-0"

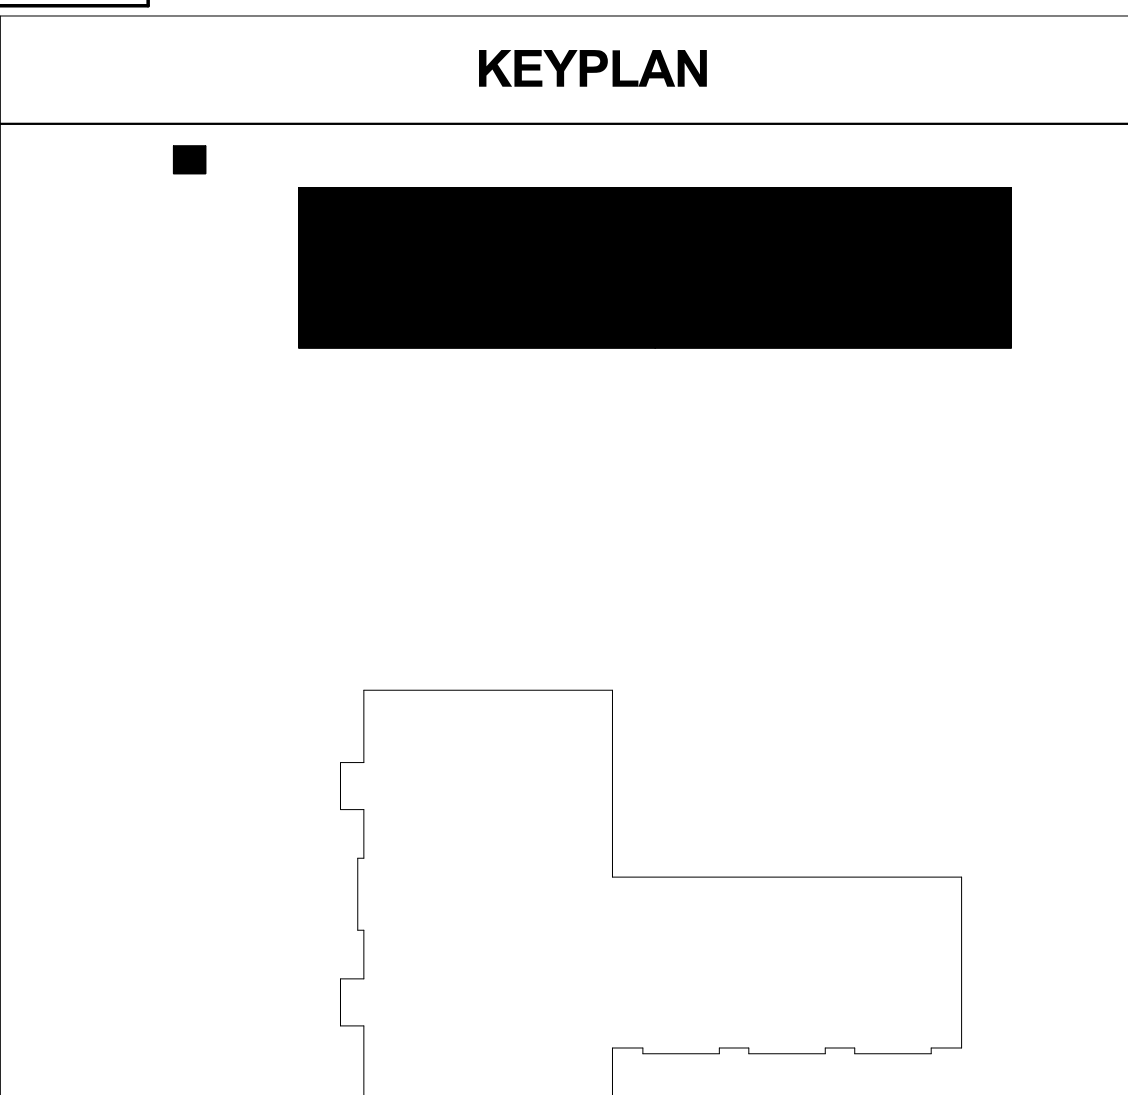




REVISIONS:

No.	Description	Date
1	ADDENDUM NO. 4	08/28/2017

PROJECT: 9202-164730
SCO ID: 16-15656-02B
ITEM: 315 CODE: 41526
DATE: August 21, 2017
DRAWN BY: WPI/AFJ
CHECKED BY: CEC

SECTIONS AND DETAILS

S-601

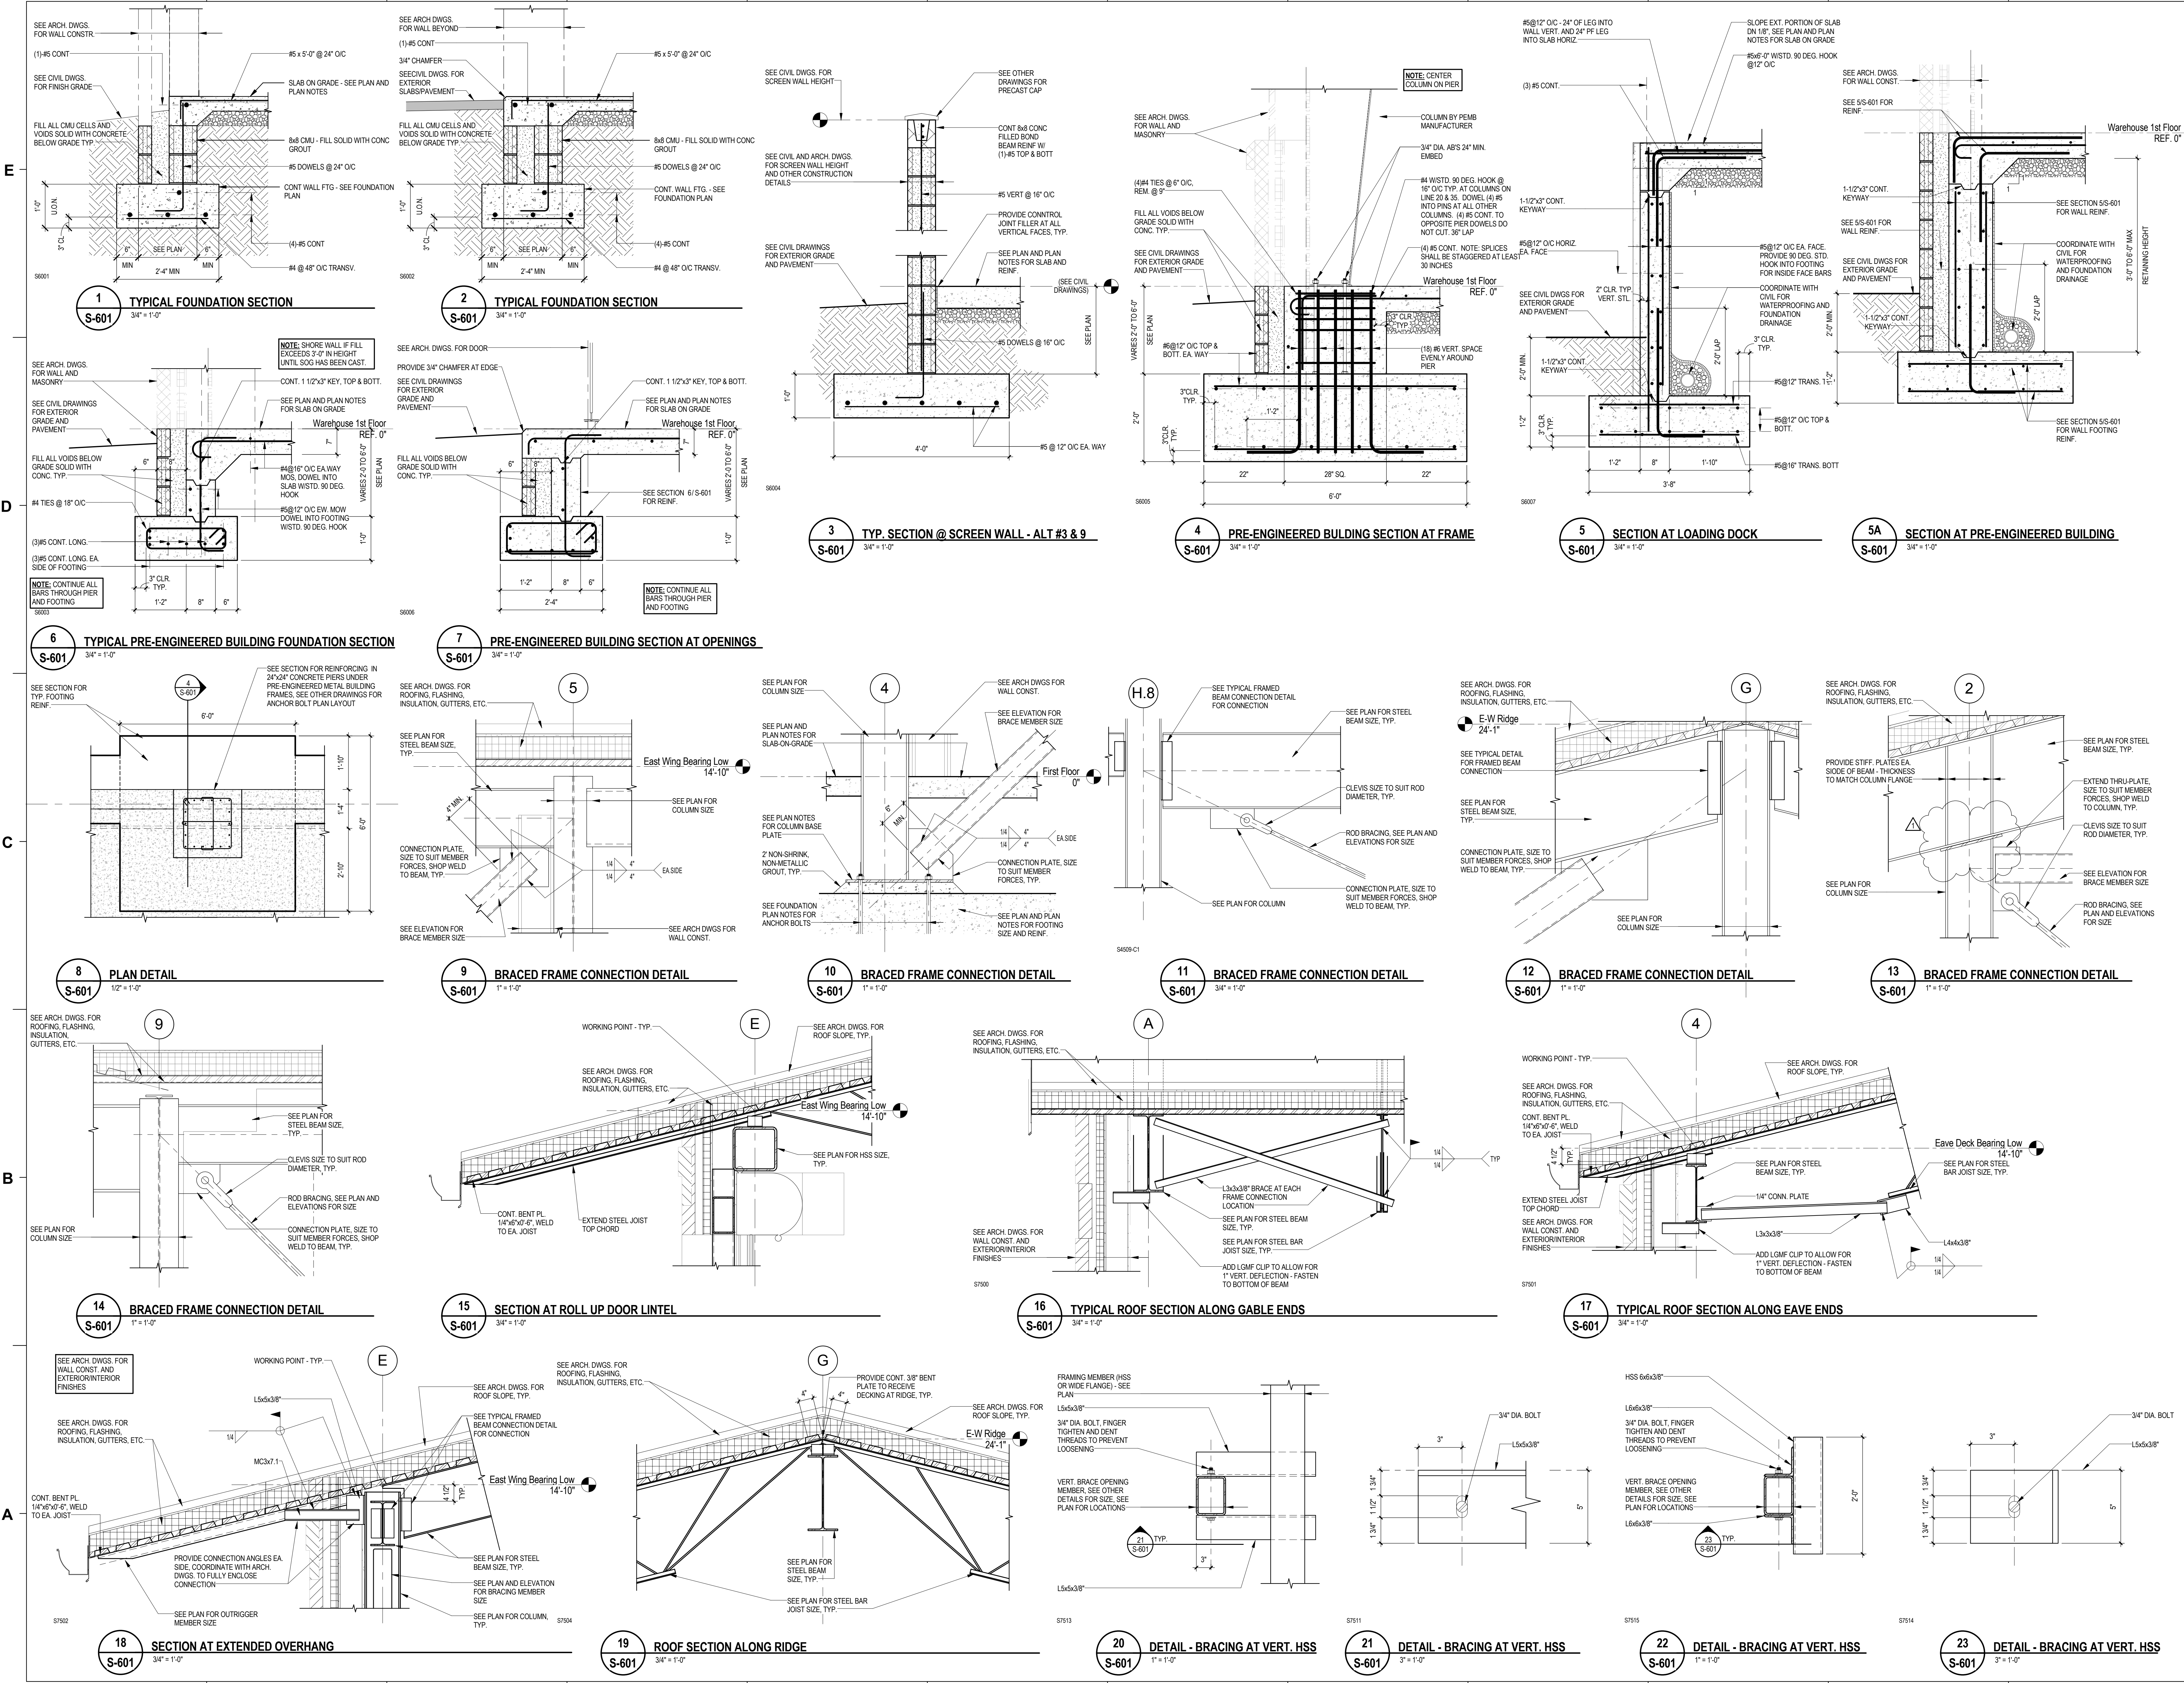

C:\2016 Projects\160378\SKA Drawings\160378-RT1&S.rvt
 8/28/2017 4:12:29 PM


E

D


C

B


A

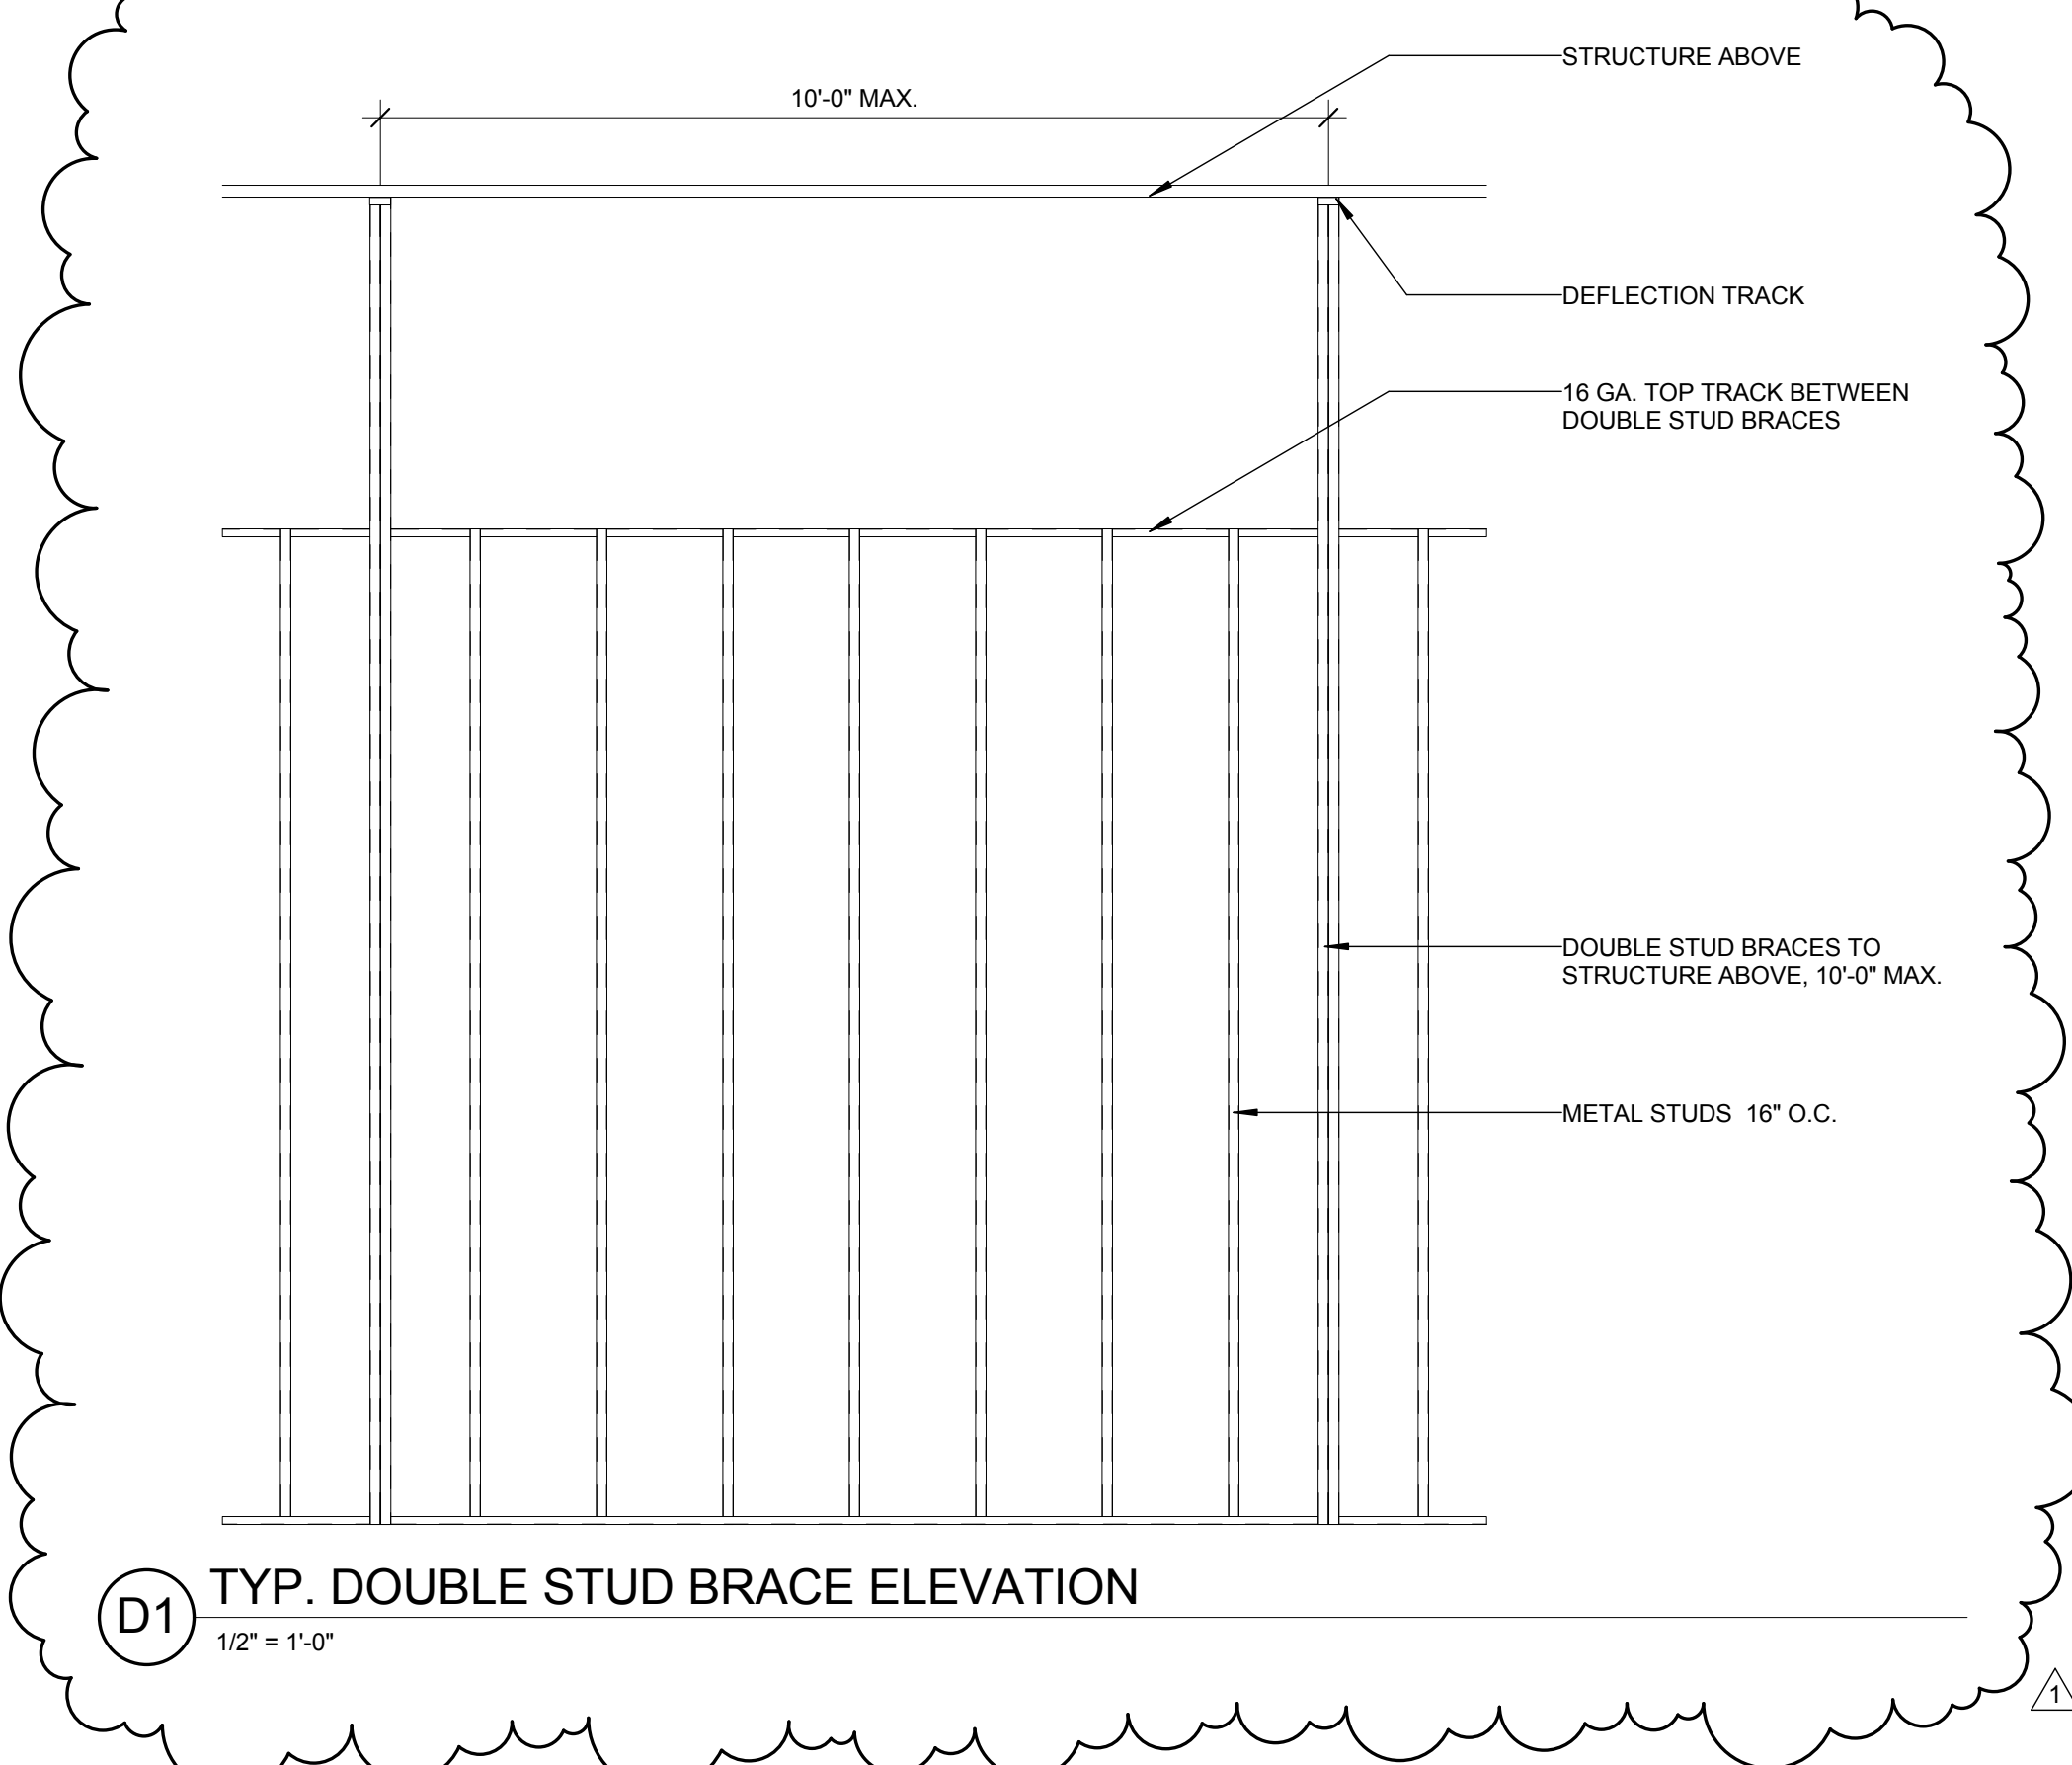


D1 TYP. DOUBLE STUD BRACE ELEVATION
1/2" x 1'-0"

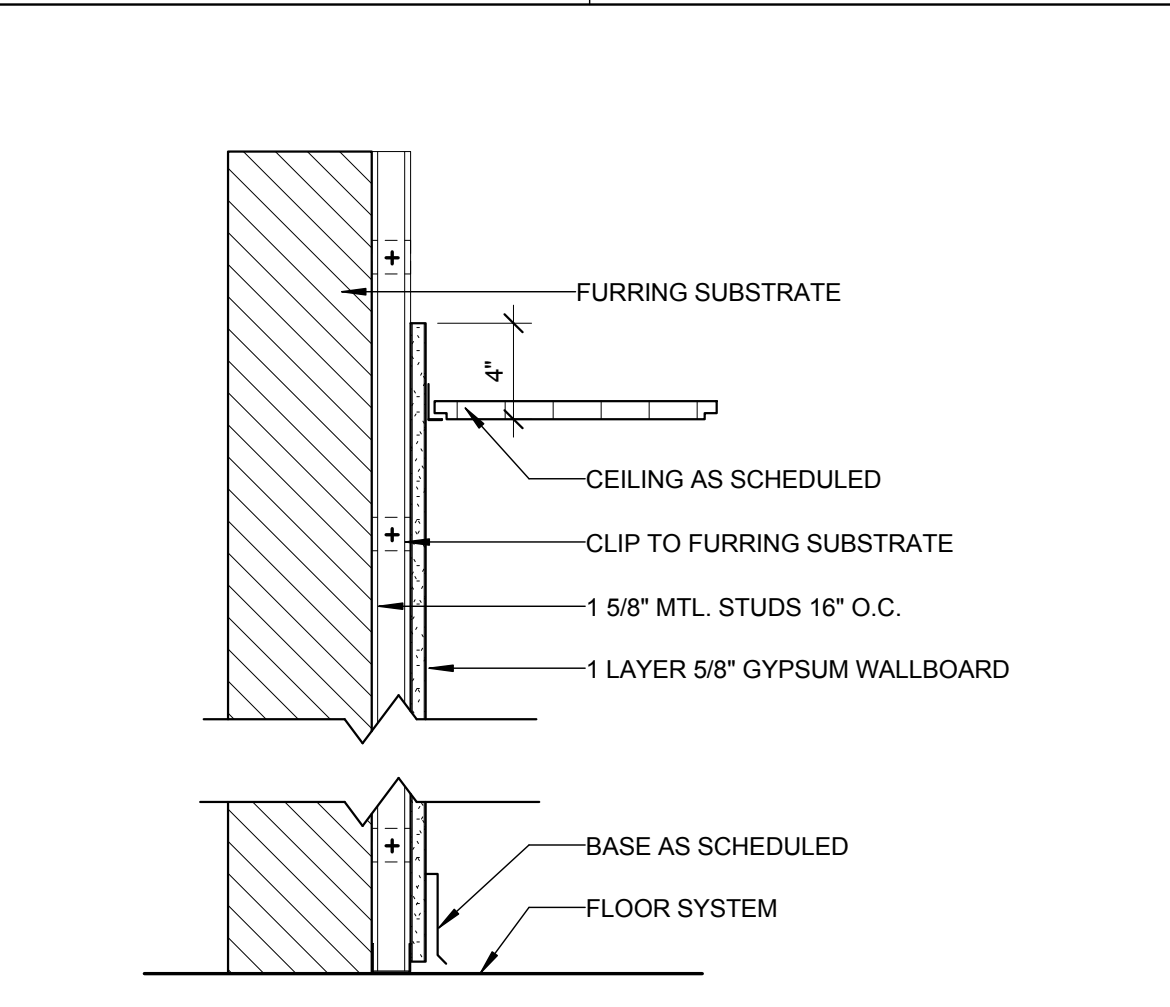


G21	FIRE RATING	UL TEST NO.	STC RATING - N/A
	N/A	N/A	N/A

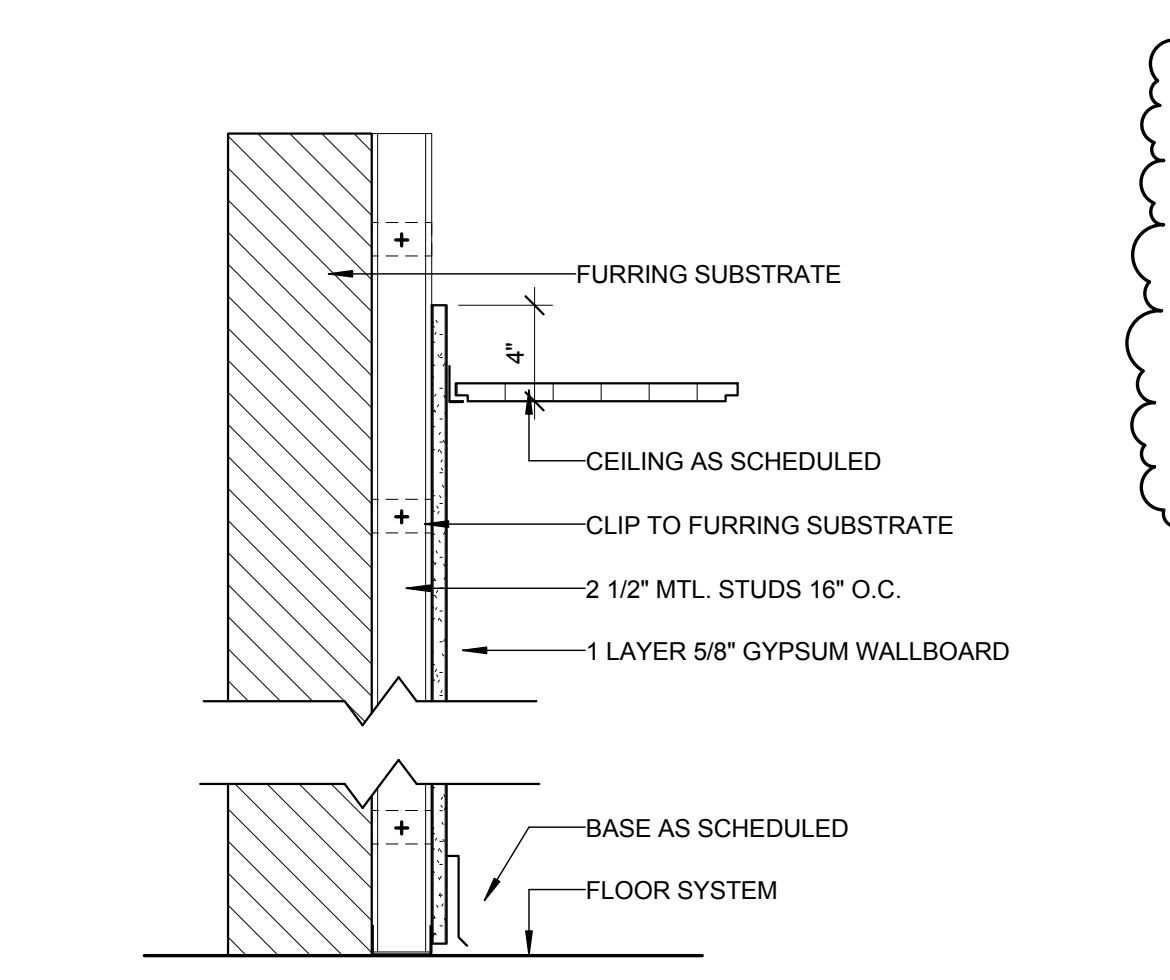


G22	FIRE RATING	UL TEST NO.	STC RATING - N/A
	N/A	N/A	N/A

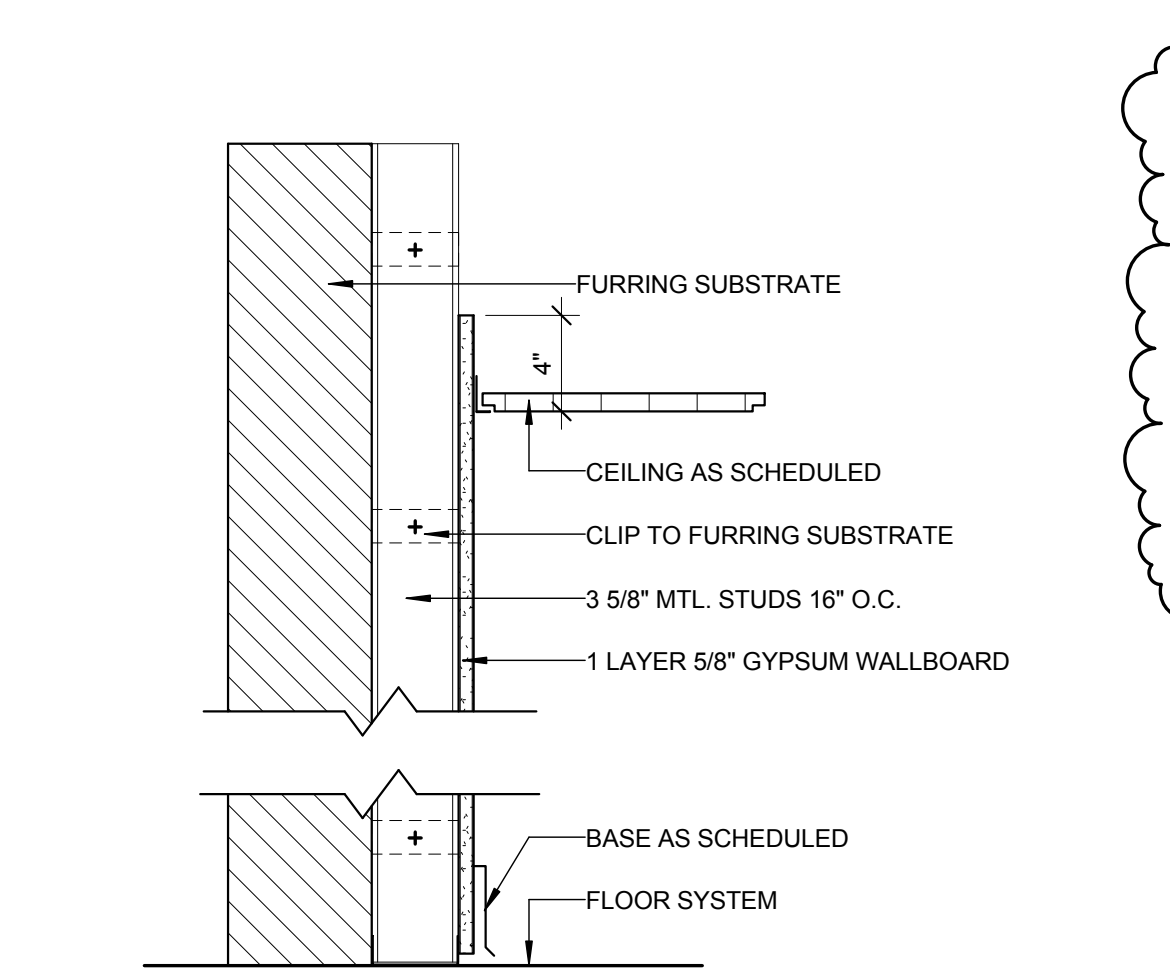


G23	FIRE RATING	UL TEST NO.	STC RATING - N/A
	N/A	N/A	N/A

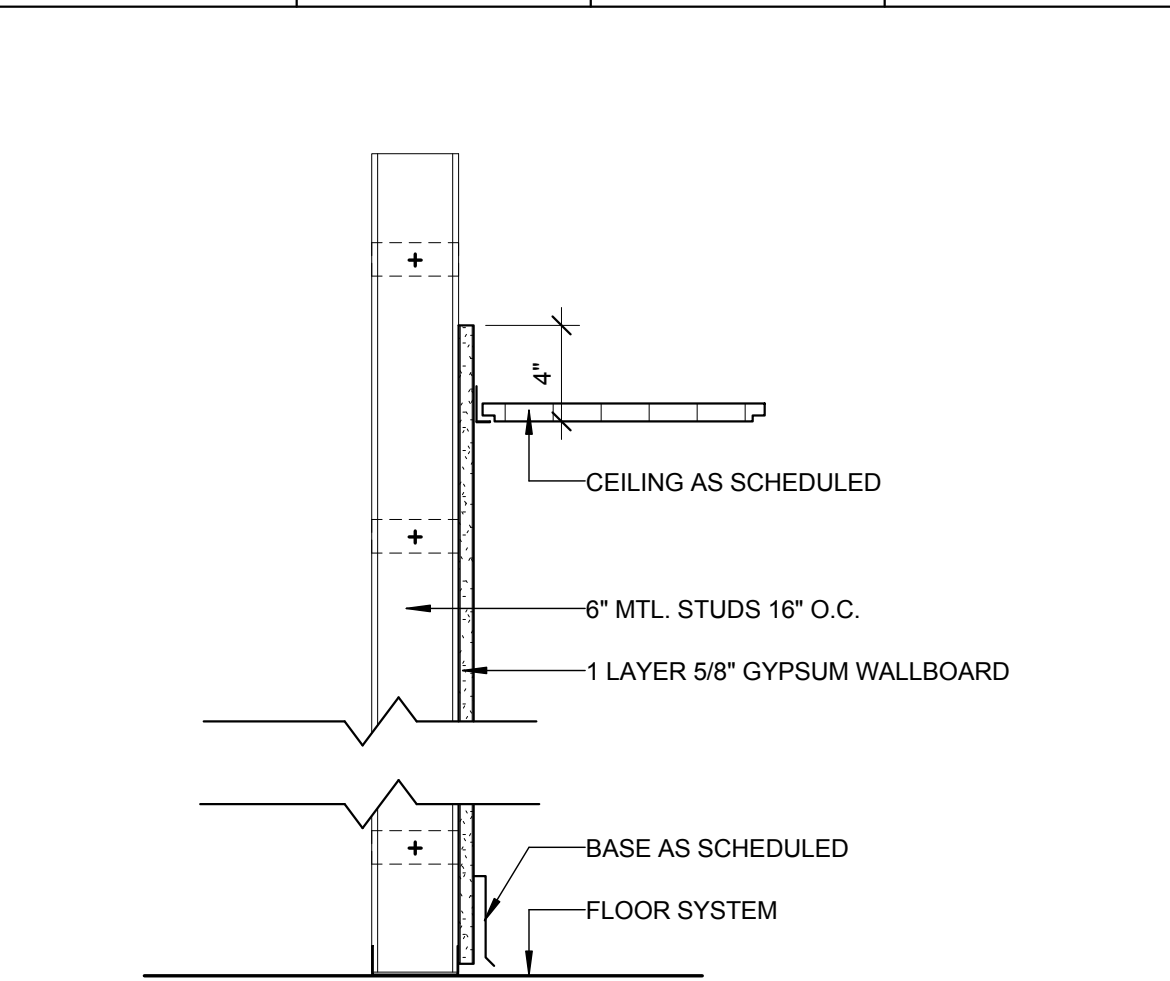


G24	FIRE RATING	UL TEST NO.	STC RATING - N/A
	N/A	N/A	N/A

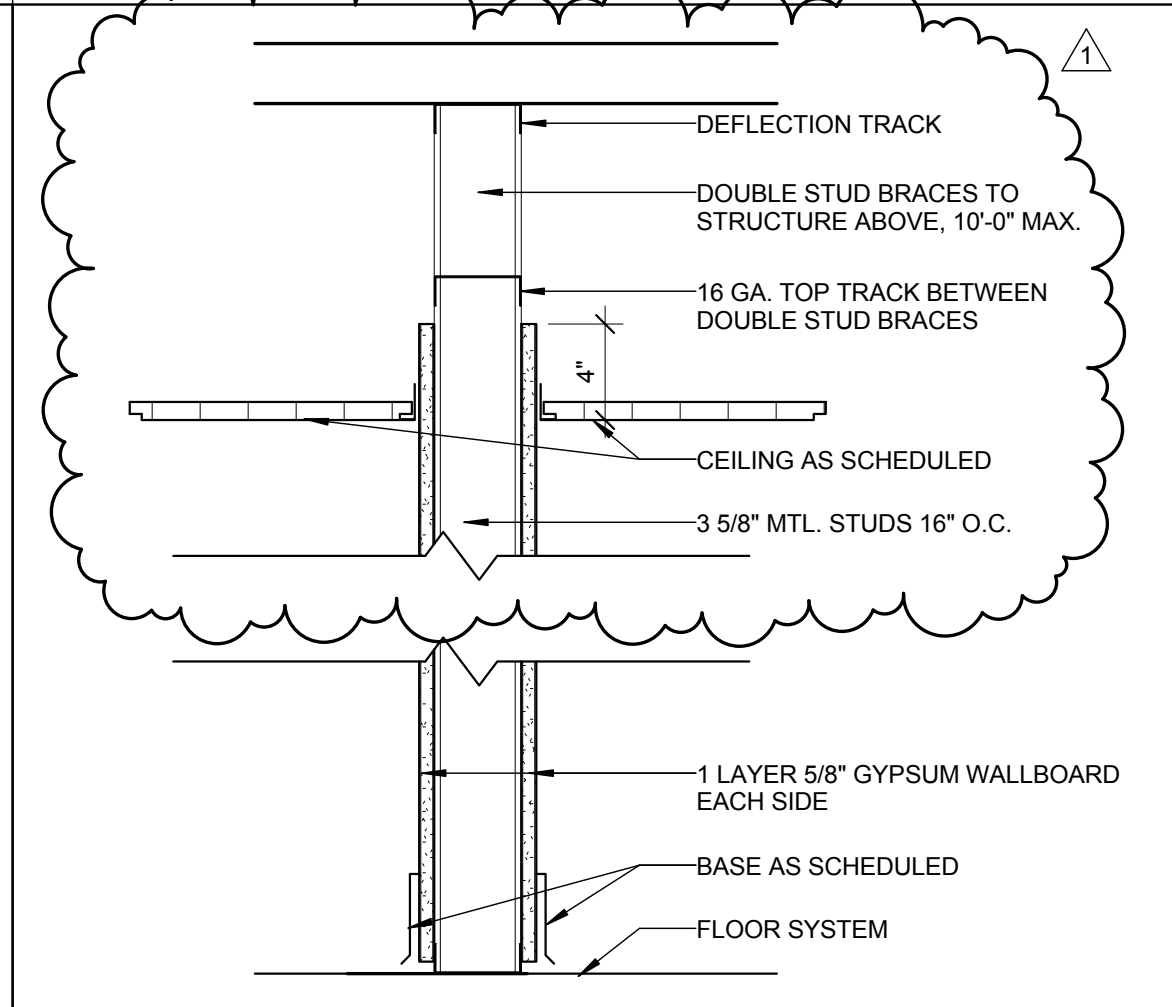


G31	FIRE RATING	UL TEST NO.	STC RATING - N/A
	N/A	N/A	N/A

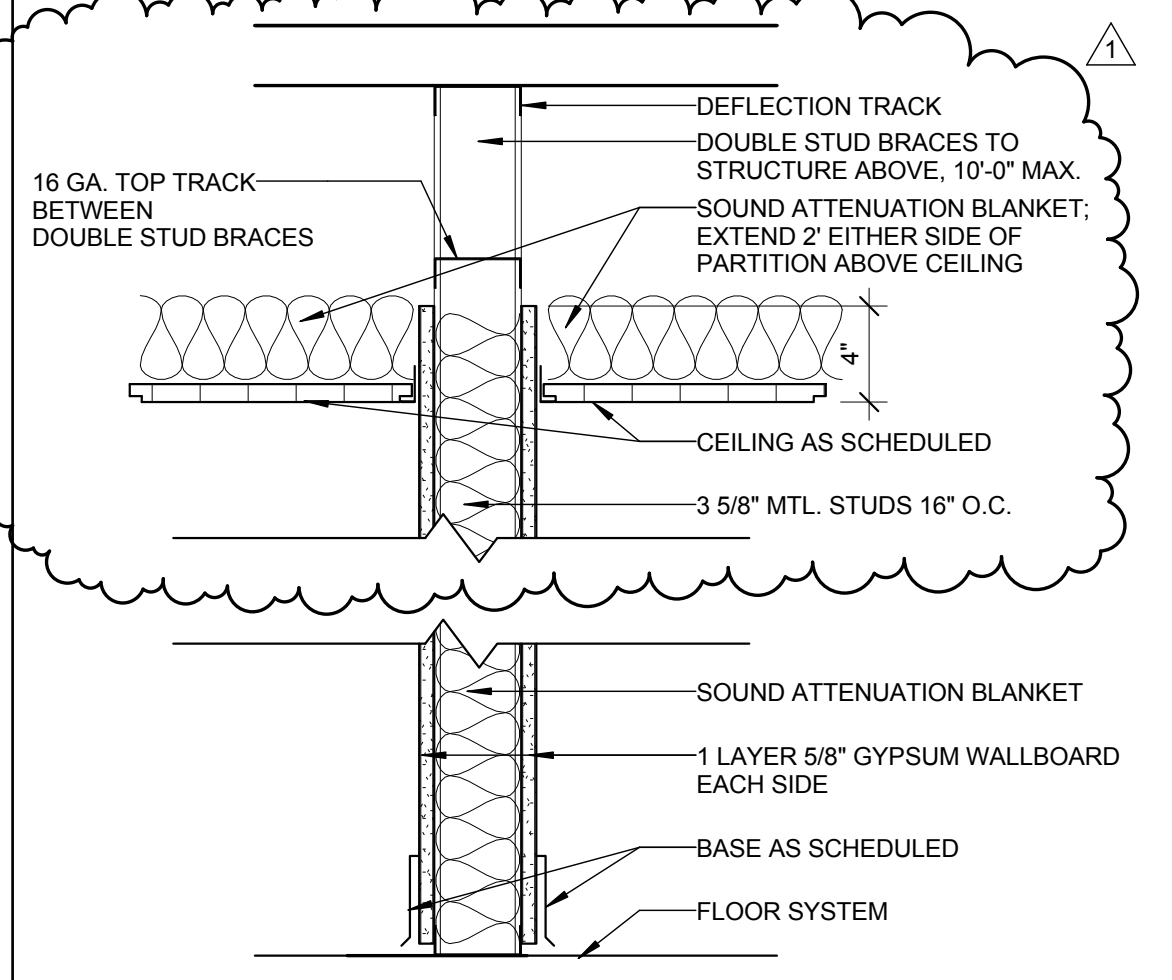


G32	FIRE RATING	UL TEST NO.	STC RATING - 49
	N/A	N/A	SA-870717

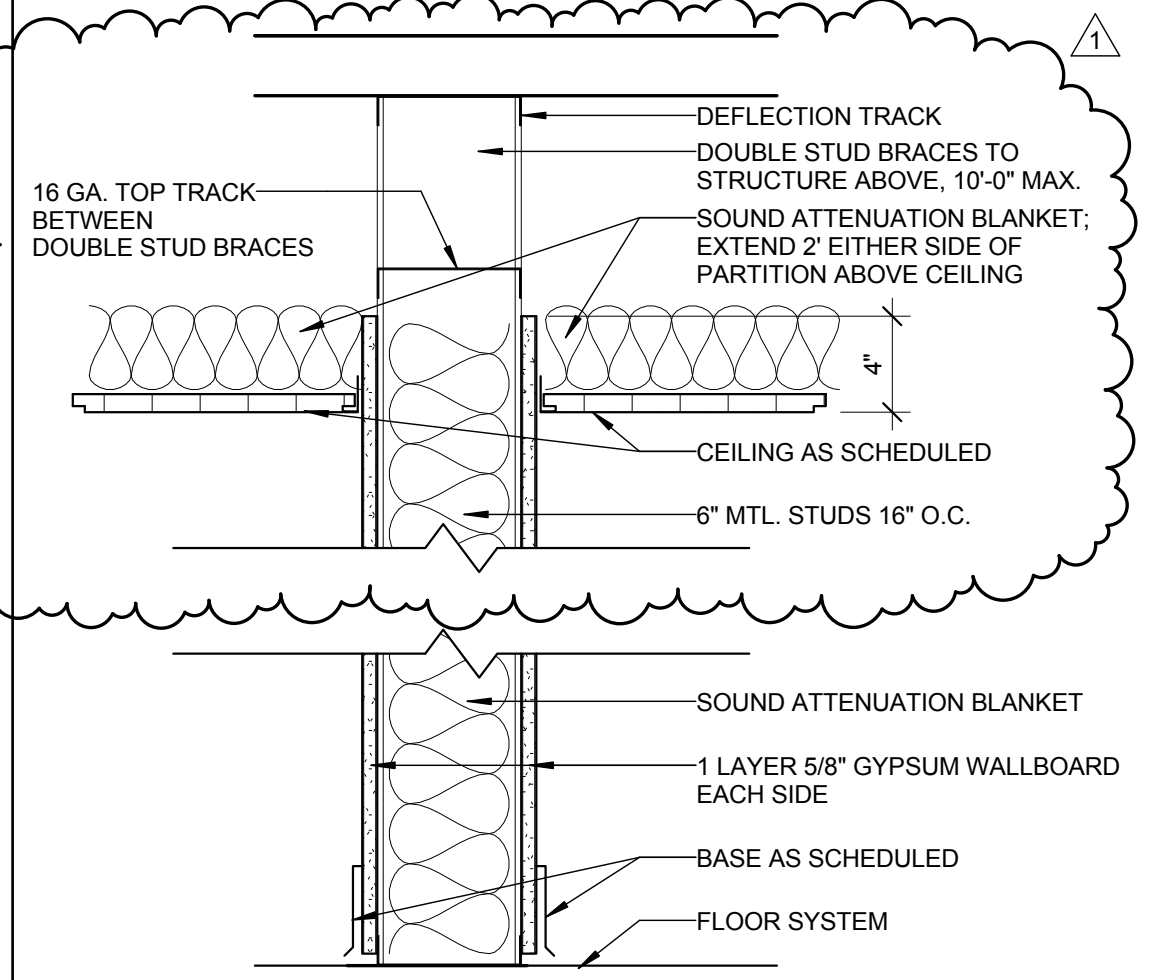


G33	FIRE RATING	UL TEST NO.	STC RATING - 49
	N/A	N/A	SA-870717

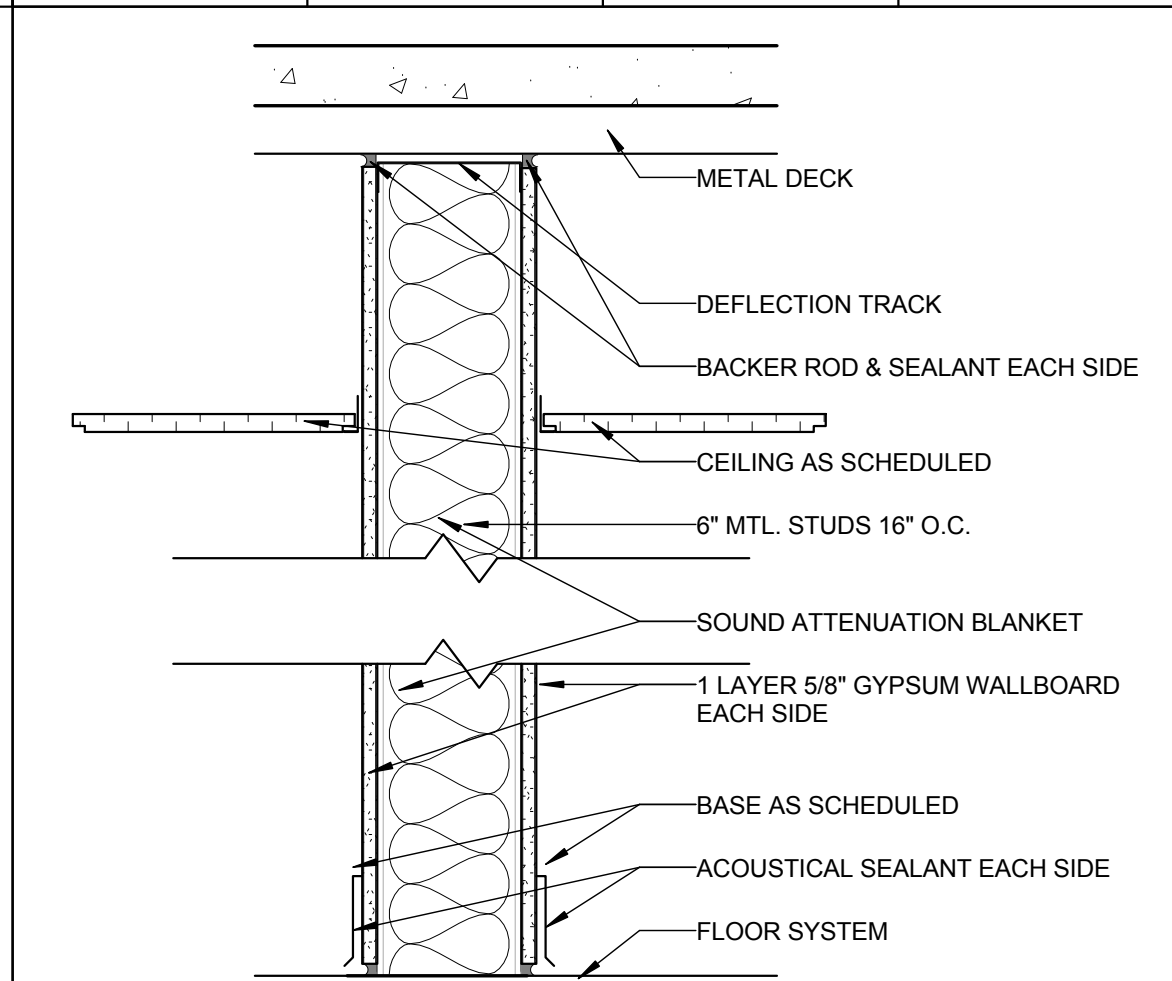


G34	FIRE RATING	UL TEST NO.	STC RATING - 49
	N/A	N/A	SA-870717

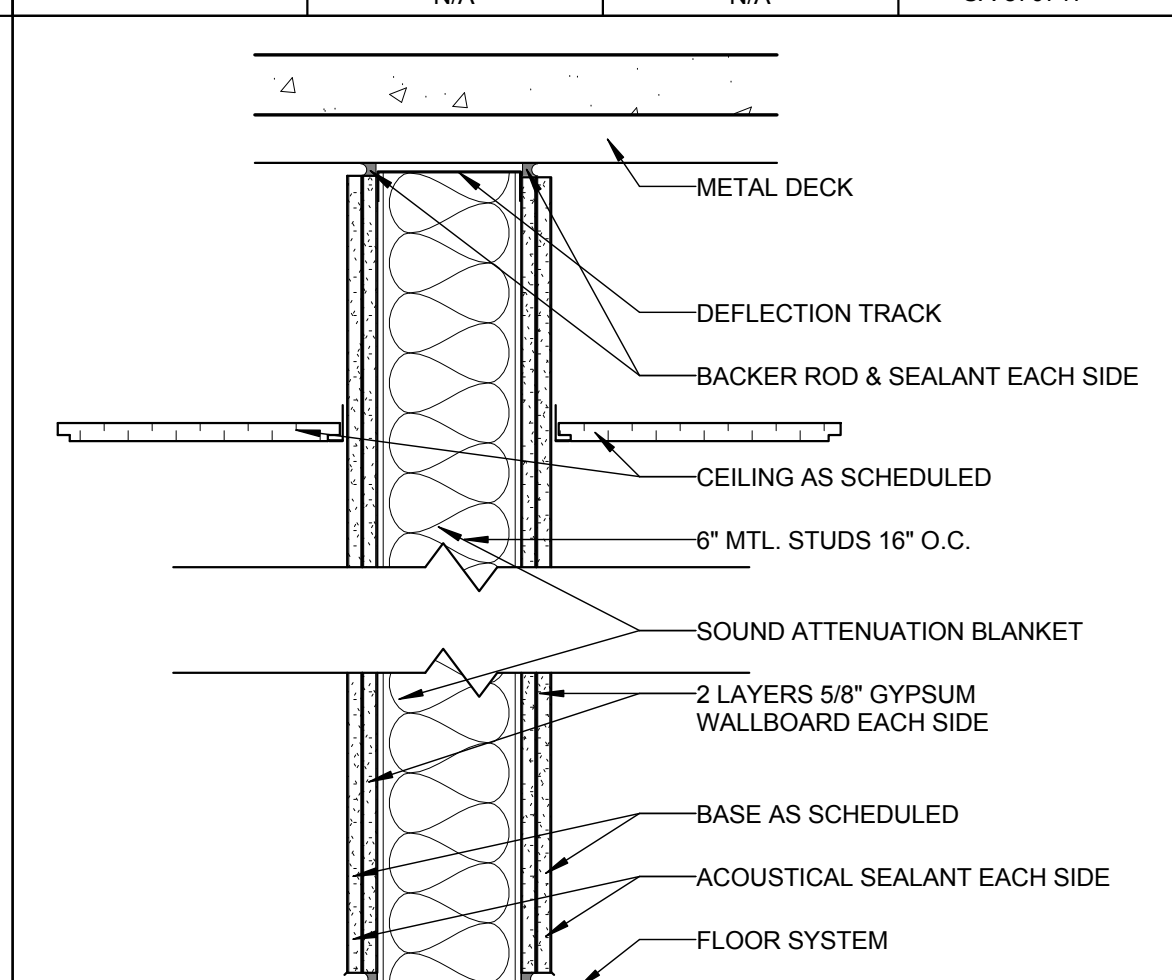


G35	FIRE RATING	UL TEST NO.	STC RATING - 52
	N/A	N/A	RAL-TL11-080

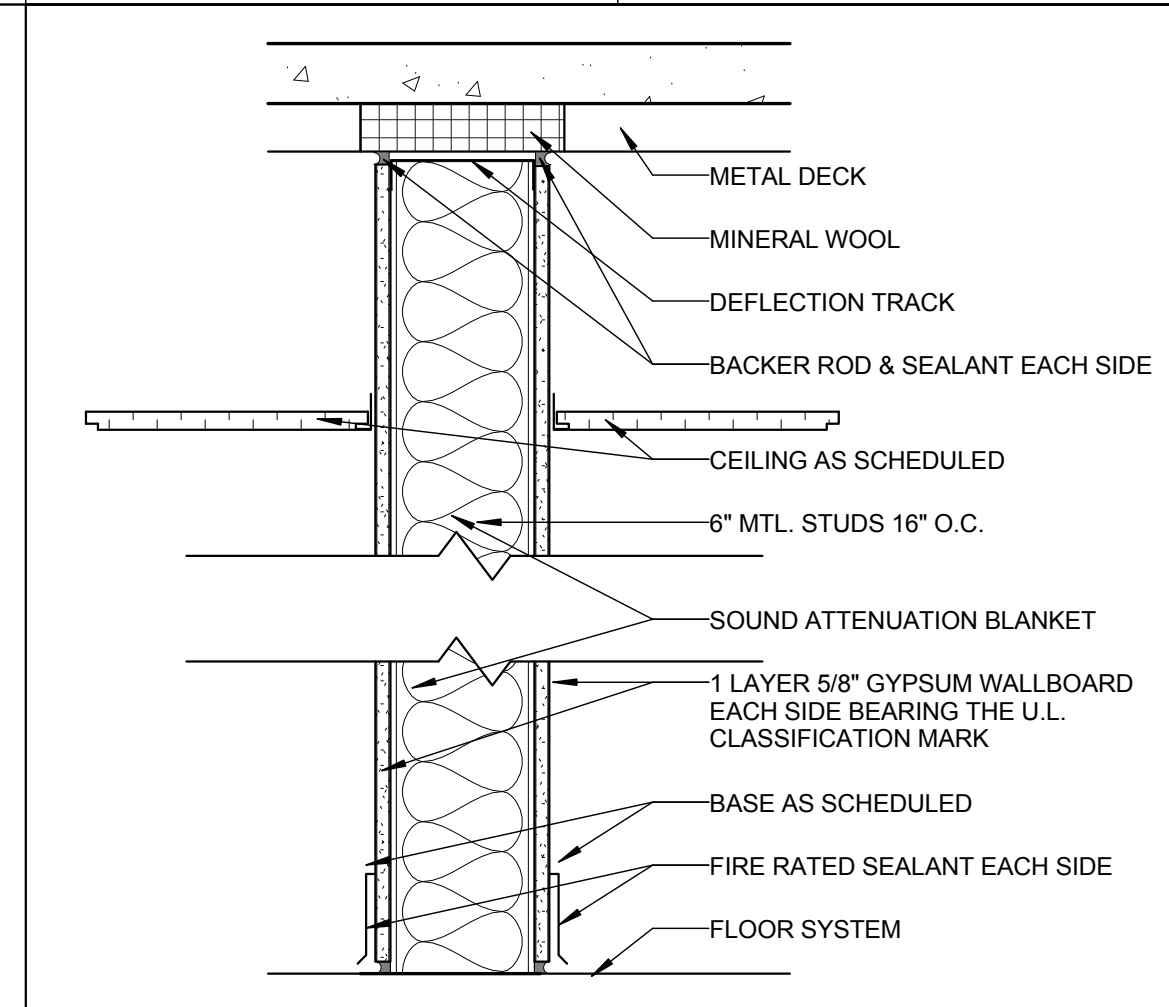

G36b	FIRE RATING	UL TEST NO.	STC RATING - 49
	1 HOUR	U419	SA-870717

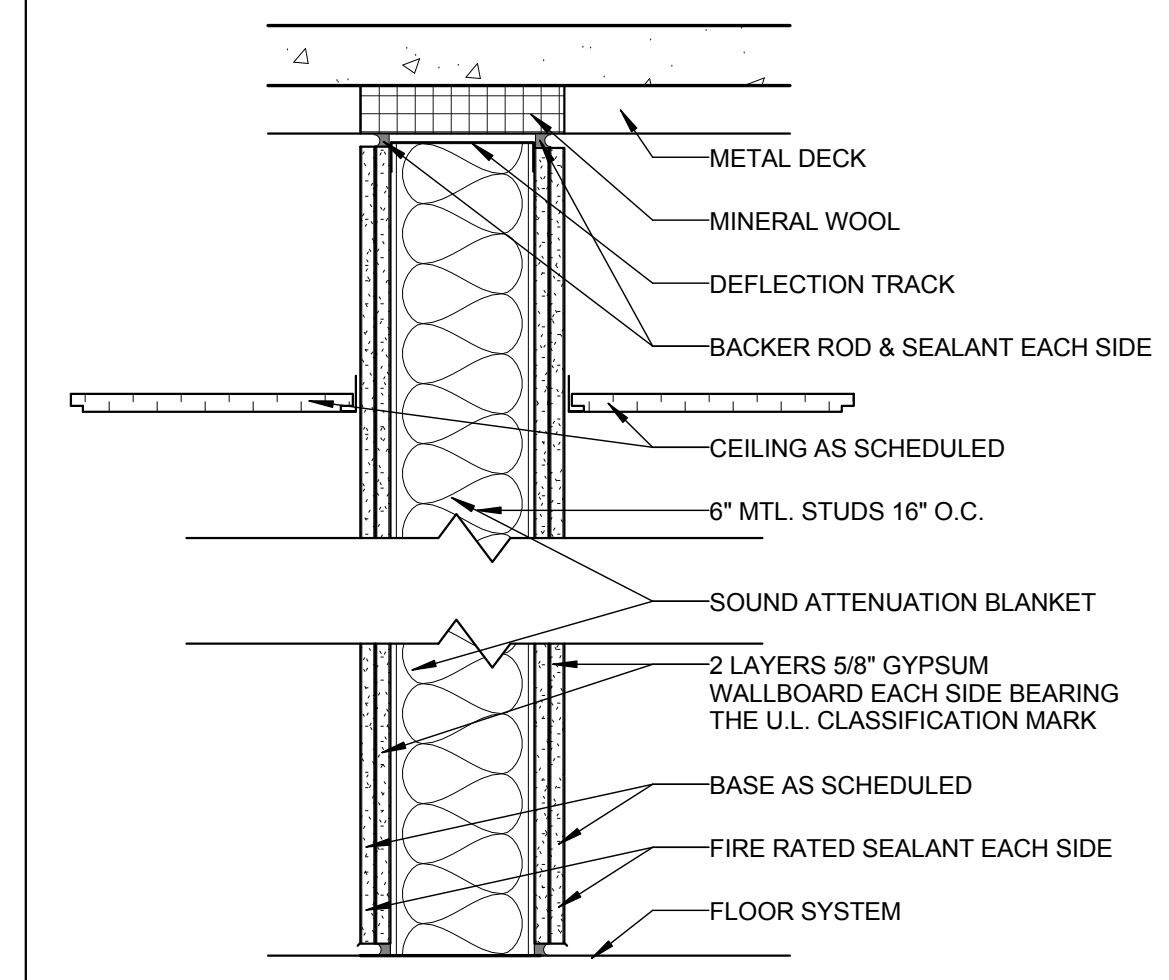


G37b	FIRE RATING	UL TEST NO.	STC RATING - 52
	1 HOUR	U419	RAL-TL11-080

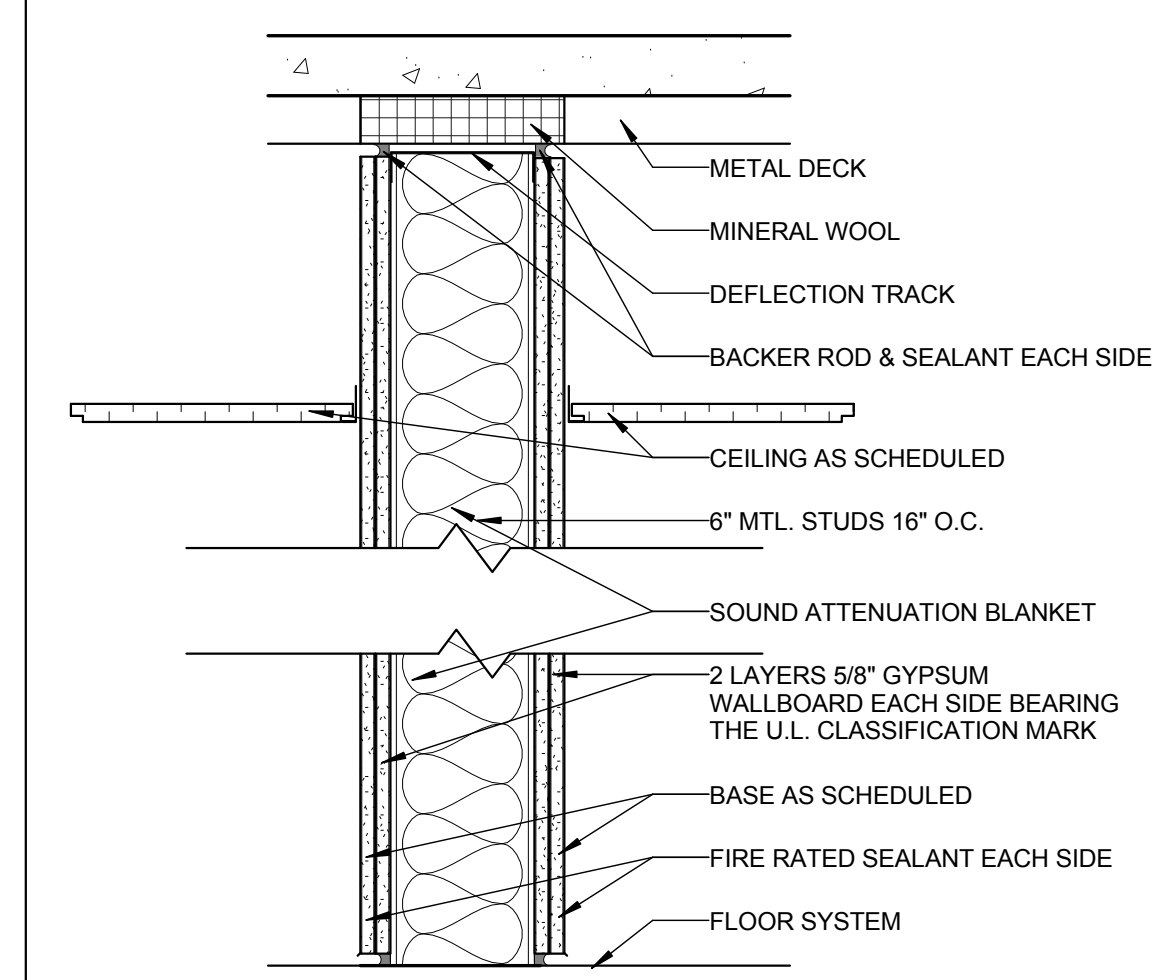

G38d	FIRE RATING	UL TEST NO.	STC RATING - 52
	2 HOUR	U419	RAL-TL11-080

PARTITION DESIGNATION KEY

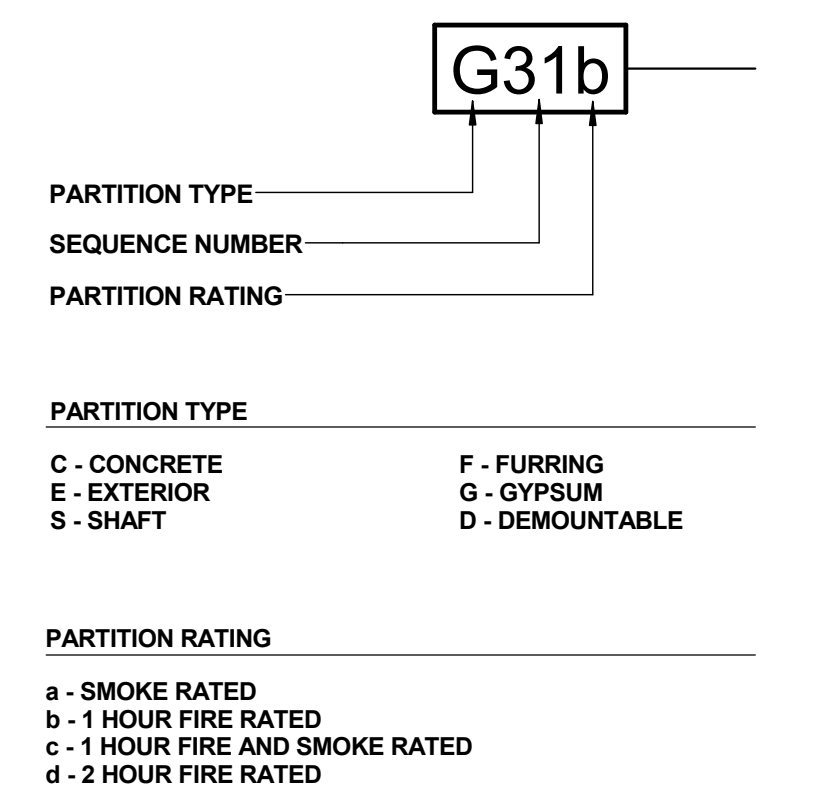

GENERAL NOTES

- A. THE CONSTRUCTION SUBSYSTEMS AND PARTITION TYPES SHOWN, INDICATE THE GENERAL CONSTRUCTION FEATURES OF THE MAJORITY OF THE CONSTRUCTION SYSTEMS TO BE PROVIDED. THEY ARE NOT INTENDED TO REPRESENT A COMPLETE LISTING OF SYSTEMS REQUIRED AND DO NOT NECESSARILY INDICATE ALL OF THE CONSTRUCTION REQUIREMENTS TO BE PROVIDED BY THE CONTRACT DOCUMENTS.
- B. SEE REFLECTED CEILING PLANS FOR ADDITIONAL REQUIREMENTS FOR PARTITION TYPES.
- C. REFERENCE FOR FIRE RESISTANCE & SOUND RATINGS:
 COMA: CAROLINAS CONCRETE MASONRY ASSOCIATION, CONCRETE MASONRY HANDBOOK, SOUND CONTROL
 GA: GYPSUM ASSOCIATION, FIRE RESISTANCE DESIGN MANUAL, ELEVENTH EDITION
 NCMA: NATIONAL CONCRETE MASONRY ASSOCIATION, TEK NOTES
 SA: SHINER AND ASSOCIATES
 SBCC: STANDARD BUILDING CODE CONGRESS, LATEST EDITION
 UL: UNDERWRITERS LABORATORY, INC., FIRE RESISTANCE DIRECTORY
- D. WHERE FURRED/SINGLE FACED SYSTEMS OCCUR ON CONCRETE MASONRY UNIT WALL OR PARTITION SURFACE, PROVIDE GYPSUM BOARD TO 4" ABOVE CEILING, OR IF NO CEILING OCCURS, PROVIDE GYPSUM BOARD TO UNDERSIDE OF DECK.

NOTES

1. CONCRETE MASONRY UNIT WALLS AND PARTITIONS: PROVIDE HORIZONTAL JOINT REINFORCEMENT, VERTICAL REINFORCEMENT, BOND BEAMS, GROUING, AND ADDITIONAL REQUIREMENTS AS INDICATED BY STRUCTURAL DRAWINGS AND SPECIFICATIONS.
2. COLOR, TEXTURE AND FACE PATTERN MAY VARY. SEE MISCELLANEOUS AND EXTERIOR COLOR SCHEDULE, SPECIFICATIONS AND DRAWINGS FOR CLARIFICATION.
3. KEEP CAVITY CLEAR OF ALL MORTAR.
4. SEE FINISH SCHEDULE FOR LOCATION OF APPLIED FINISHES (SUCH AS CERAMIC TILE, WALL COVERING, ETC) THAT MAY AFFECT THE PARTITION SURFACE AND CONSTRUCTION REQUIREMENTS.
5. WHERE CERAMIC TILE AND CEMENTITIOUS BACKER UNIT ARE NOT SCHEDULED TO BE FULL HEIGHT OF PARTITION, PROVIDE GYPSUM BOARD (TYPE X @ RATED PARTITIONS) @ THOSE PORTIONS OF THE PARTITION NOT SCHEDULED TO RECEIVE CERAMIC TILE. CEMENTITIOUS BACKER UNIT TO BE SAME THICKNESS AS GYPSUM BOARD.
6. PROVIDE FIRE RATED CMU (OR EQUIVALENT) WHERE PARTITION INDICATED TO BE FIRE RATED ON REFLECTED CEILING PLANS. RATED PARTITION TO MEET CONSTRUCTION REQUIREMENTS OF FIRE RATING REFERENCE LISTED.
7. PROVIDE MANUFACTURER'S PROPRIETARY TYPE 'X' GYPSUM BOARD (MEETING THE DESIGNATED FIRE REFERENCE LISTED) WHERE PARTITION IS INDICATED TO BE FIRE RATED ON REFLECTED CEILING PLANS. RATED PARTITION TO MEET CONSTRUCTION REQUIREMENTS OF FIRE RATING REFERENCE LISTED.
8. PROVIDE ACOUSTICAL SEALANT AT PERIMETER OF ALL SOUND RATED PARTITIONS AND AT ALL PARTITION PENETRATIONS. IF PARTITION IS FIRE RATED, PROVIDE UL LABELED FIRESTOPPING IN PLACE OF ACOUSTICAL SEALANT. AT PARTITIONS THAT ARE SOUND AND FIRE RATED, PROVIDE ACOUSTICAL SEALANT AT PARTITION PENETRATIONS THAT DO NOT REQUIRE FIRESTOPPING (EXAMPLE: DUCT PENETRATIONS WITH FIRE DAMPERS).
9. PROVIDE MOISTURE RESISTANT GYPSUM BOARD IN ALL TOILET ROOMS, ALL SHOWER ROOMS AND ALL CASEWORK WALLS IN BREAKROOM AREAS.

227 WEST TRADE STREET SUITE 700
 CHARLOTTE, NORTH CAROLINA 28202
 TEL. 704.333.6666 FAX 704.333.2926
 WWW.LS3P.COM



MEMBERS OF THE AMERICAN INSTITUTE OF ARCHITECTS

COPYRIGHT 2017 ALL RIGHTS RESERVED
 PRINTED OR ELECTRONIC DRAWINGS AND DOCUMENTATION MAY NOT BE REPRODUCED IN ANY FORM WITHOUT WRITTEN PERMISSION FROM LS3P ASSOCIATES LTD.

REVISIONS:

No.	Description	Date
1	Addendum No. 4	08/28/2017

PROJECT: 9202-164730
 SCO ID: 16-15656-025
 ITEM: 315 CODE: 41526
 DATE: AUGUST 21, 2017
 DRAWN BY: KF
 CHECKED BY: SH

PARTITION TYPES

A-004

C:\Users\sharonh\Documents\Aron_UNCC Facilities Operations Complex_2016_sharonh\ar01.rvt 8/30/2017 7:58:30 AM



No.	Description	Date
1	Addendum No. 4	08/28/2017

FLOOR PLAN SHEET NOTES

- EXTERIOR DIMENSIONS AT MASONRY VENEER ARE TO FACE OF MASONRY.
- INTERIOR DIMENSIONS INDICATED ARE TO FACE OF FINISH WALLS AND CENTERLINES OF COLUMNS, UNO.
- LOCATE DOOR OPENINGS 4' FROM NEAREST PERPENDICULAR WALL, UNO.
- FIRE AND SOUND RATED WALL PARTITIONS TO BE CONSTRUCTED TIGHT TO STRUCTURE, PIPING, DUCTWORK AND OTHER PENETRATIONS. ALL WORK IS TO BE BRACED TO STRUCTURE ABOVE.
- WHERE PARTITIONS OF DIFFERENT FIRE RATINGS INTERSECT, THE HIGHEST RATED PARTITION SHALL CONTINUE THROUGH. MAINTAIN PARTITION FIRE RATING BEHIND RECESSED FIRE EXTINGUISHER CABINETS.
- INSTALL BLOCKING IN PARTITIONS FOR CASEWORK, WALL MOUNTED EQUIPMENT, TRIM AND RELATED CONSTRUCTION AS INDICATED IN THE SPECIFICATIONS.
- SEE LIFE SAFETY PLANS FOR REQUIRED FIRE SEPARATION WALLS.
- SEE SHEET A-601 & A-603 FOR DOOR WINDOW & GLAZING TYPES.
- SEE SHEET A-603 FOR LOUVER TYPES.
- SEE SHEET A-003 FOR CONSTRUCTION SUBSYSTEMS.
- SEE SHEET A-251, A-252, A-410, A-411 AND A-781 FOR CASEWORK ELEVATIONS & DETAILS.
- SEE SHEETS A-251 AND A-252 FOR INTERIOR ELEVATIONS, ACCESSORY DESCRIPTIONS & MOUNTING HEIGHTS.
- SEE SHEETS A-721 THROUGH A-722 FOR FINISH FLOORING, TRANSITIONS, PATTERNS AND WALL PROTECTION.
- SEE SHEET A-720 FOR FINISH SCHEDULE.
- SEE SHEETS A-401 FOR ENLARGED PLANS INDICATING ADDITIONAL DIMENSIONS AND PARTITION TYPES.
- SEE SHEET A-765 FOR SIGN SCHEDULE & ELEVATIONS AND DETAILS.
- SEE STRUCTURAL DRAWINGS FOR SLAB DEPRESSIONS AND CUTOUTS.
- SEE BUILDING ELEVATION DRAWINGS FOR LOCATION OF EXTERIOR MASONRY CONTROL JOINTS.
- EXTERIOR DIMENSIONS TAKEN FROM MASONRY FACE, NOT METAL PANEL.
- ACCESSIBLE AND COMMON FEATURES, E.G., AUTOMATIC DOOR ACTIVATOR, CARD SWIPE, SHALL BE PLACED 34"-36" AFF. DO NOT PLACE ACCESSIBLE OR COMMON USE BUILDING FEATURES WITHIN 24" OF AN INTERIOR CORNER.



PARTITION NOTES

- ALL NON-DESIGNATED PARTITIONS SHALL BE TYPE G32.
- ALL PIPE AND CONDUIT PENETRATIONS THRU 1 HR RATED OR MORE PARTITIONS, FLOORS, ROOF, ETC. SHALL BE SEALED WITH A RESPECTIVELY RATED FIRE BARRIER PENETRATION SEALING SYSTEM BY 3M OR U.L. APPROVED EQUAL.
- TILE BACKER BOARD SHALL BE USED IN ALL LOCATIONS TO RECEIVE TILE FINISHES. REFER TO FINISH SCHEDULE AND INTERIOR ELEVATIONS FOR LOCATIONS.
- CONTRACTOR SHALL COORDINATE WITH MECHANICAL DUCTWORK PRIOR TO FABRICATION OF PARTITION WALLS.
- SHOULD CONDITIONS OCCUR WHERE A WALL IS UNABLE TO GO STRAIGHT UP TO STRUCTURE DUE TO PIPING, DUCTWORK, ETC., THE PARTITION (GYPSUM BOARD AND FRAMING) MAY JOG HORIZONTALLY ABOVE THE CEILING TO AVOID THE PROBLEM. RATED WALL INTEGRITY SHALL BE MAINTAINED.
- WHERE STUDS EXTEND TO STRUCTURE AND GYPSUM WALLBOARD AND SOUND ATTENUATION BLANKETS EXTEND JUST ABOVE THE FINISH CEILING, CAP OFF PARTITION FINISHES WITH A RUNNER CHANNEL WHEN CEILING PLENUM IS USED AS A RETURN AIR PLENUM.
- DIMENSIONAL CONFLICTS BETWEEN PARTITION TYPES AND THE ARCHITECTURAL FLOOR PLANS SHALL BE BROUGHT TO THE ATTENTION OF THE ARCHITECT.
- SEE LIFE SAFETY PLANS FOR THE LOCATIONS OF SMOKE BARRIERS, SMOKE PARTITIONS AND FIRE-RATED PARTITIONS.
- REFER TO UNDERWRITERS LABORATORIES, INC. FIRE RESISTANCE VOLUMES - CURRENT EDITION FOR SPECIFIC CONSTRUCTION REQUIREMENTS OF U.L. LISTED ASSEMBLIES.
- REFER TO MECHANICAL, ELECTRICAL AND PLUMBING DRAWINGS FOR TYPICAL U.L. LISTED PENETRATIONS THROUGH FIRE-RATED ASSEMBLIES. CONTRACTOR SHALL BE RESPONSIBLE FOR PROVIDING APPROPRIATE PROJECT-SPECIFIC U.L. LISTED ASSEMBLIES FOR PENETRATIONS.
- AT ALL EXISTING AND CONSTRUCTED PARTITIONS THE CONTRACTOR IS TO MAINTAIN THE FIRE-RESISTIVE INTEGRITY.
- PROVIDE ACOUSTICAL SEALANT AT PERIMETER OF ALL SOUND RATED PARTITIONS AND AT ALL PARTITION PENETRATIONS. IF PARTITION IS FIRE RATED, PROVIDE U.L. LABELED FIRESTOPPING IN PLACE ACOUSTICAL SEALANT AT PARTITIONS THAT ARE SOUND AND FIRE RATED. PROVIDE ACOUSTICAL SEALANT AT PARTITION PENETRATIONS THAT DO NOT REQUIRE FIRESTOPPING (EXAMPLE: DUCT PENETRATIONS WITH FIRE DAMPERS).


PARTITION LEGEND

- ALL EXTERIOR WALLS TO BE TYPE W1 U.N.O. SEE A-003 FOR CONSTRUCTION OF SUBSYSTEMS.
 - SEE SHEET A-004 FOR CONSTRUCTION OF PARTITION TYPES.
 - ALL INTERIOR METAL STUD PARTITIONS TO BE TYPE G32 U.N.O.
- NON-RATED WALL, EXTEND GYP. BD. AND FRAMING TO STRUCTURE ABOVE.
 - NON-RATED WALL, EXTEND GYP. BD. TO MIN. 4" ABOVE FINISHED CEILING AND FRAMING TO STRUCTURE ABOVE.
 - 1 HR.-RATED BARRIER, EXTEND TO THE UNDERSIDE OF THE DECK ABOVE.
 - 2 HR.-RATED BARRIER, EXTEND TO THE UNDERSIDE OF THE DECK ABOVE.
 - FIRE EXTINGUISHER CABINET
 - FIRE EXTINGUISHER BRACKET
 - CORNER GUARD


KEYPLAN

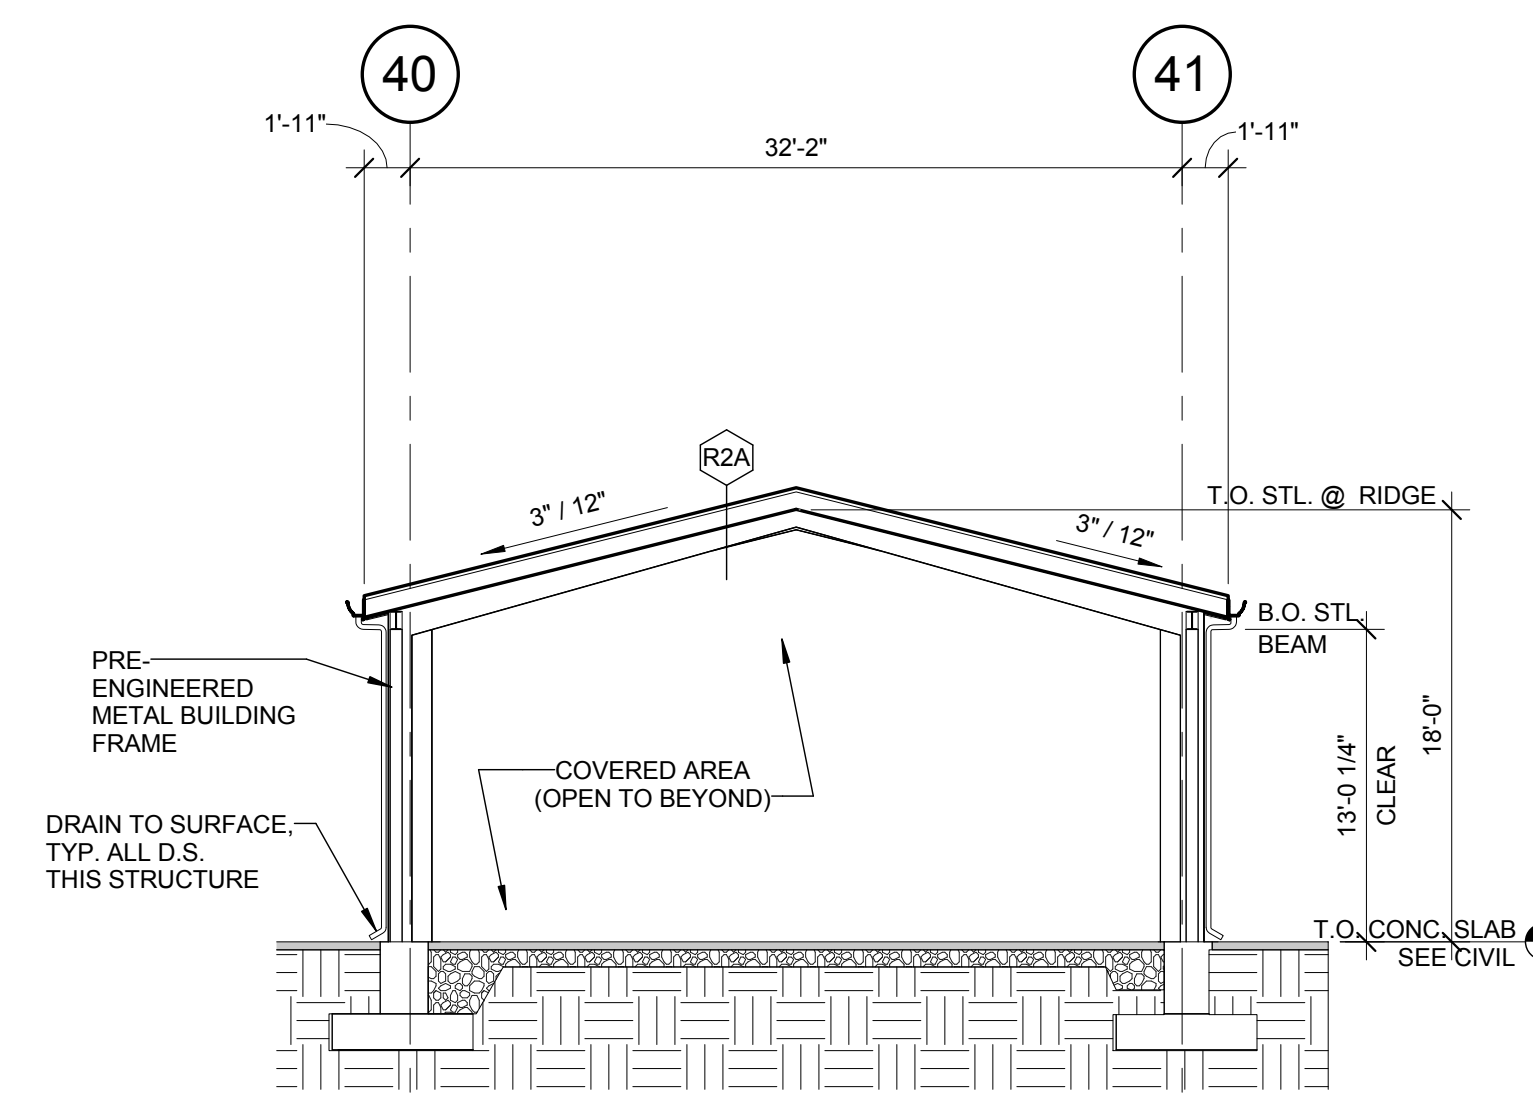 


D4 STORAGE CANOPY SECTION - ALTERNATE NO. 12
1/8" = 1'-0"

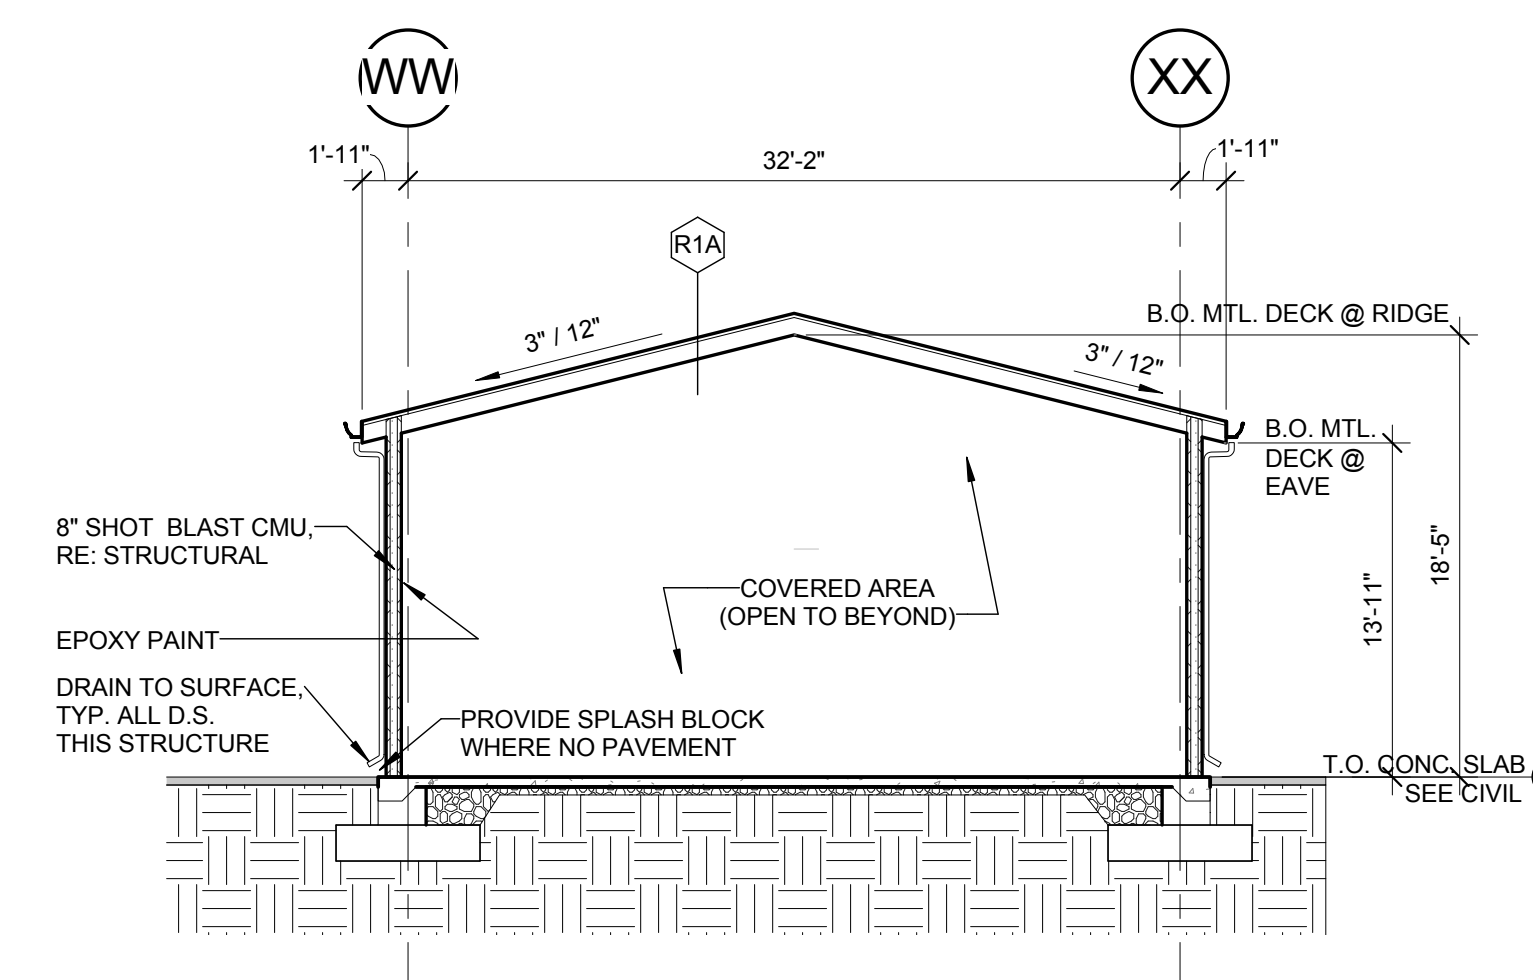


C4 WASH RACK SECTION - ALTERNATE NO. 2B
1/8" = 1'-0"

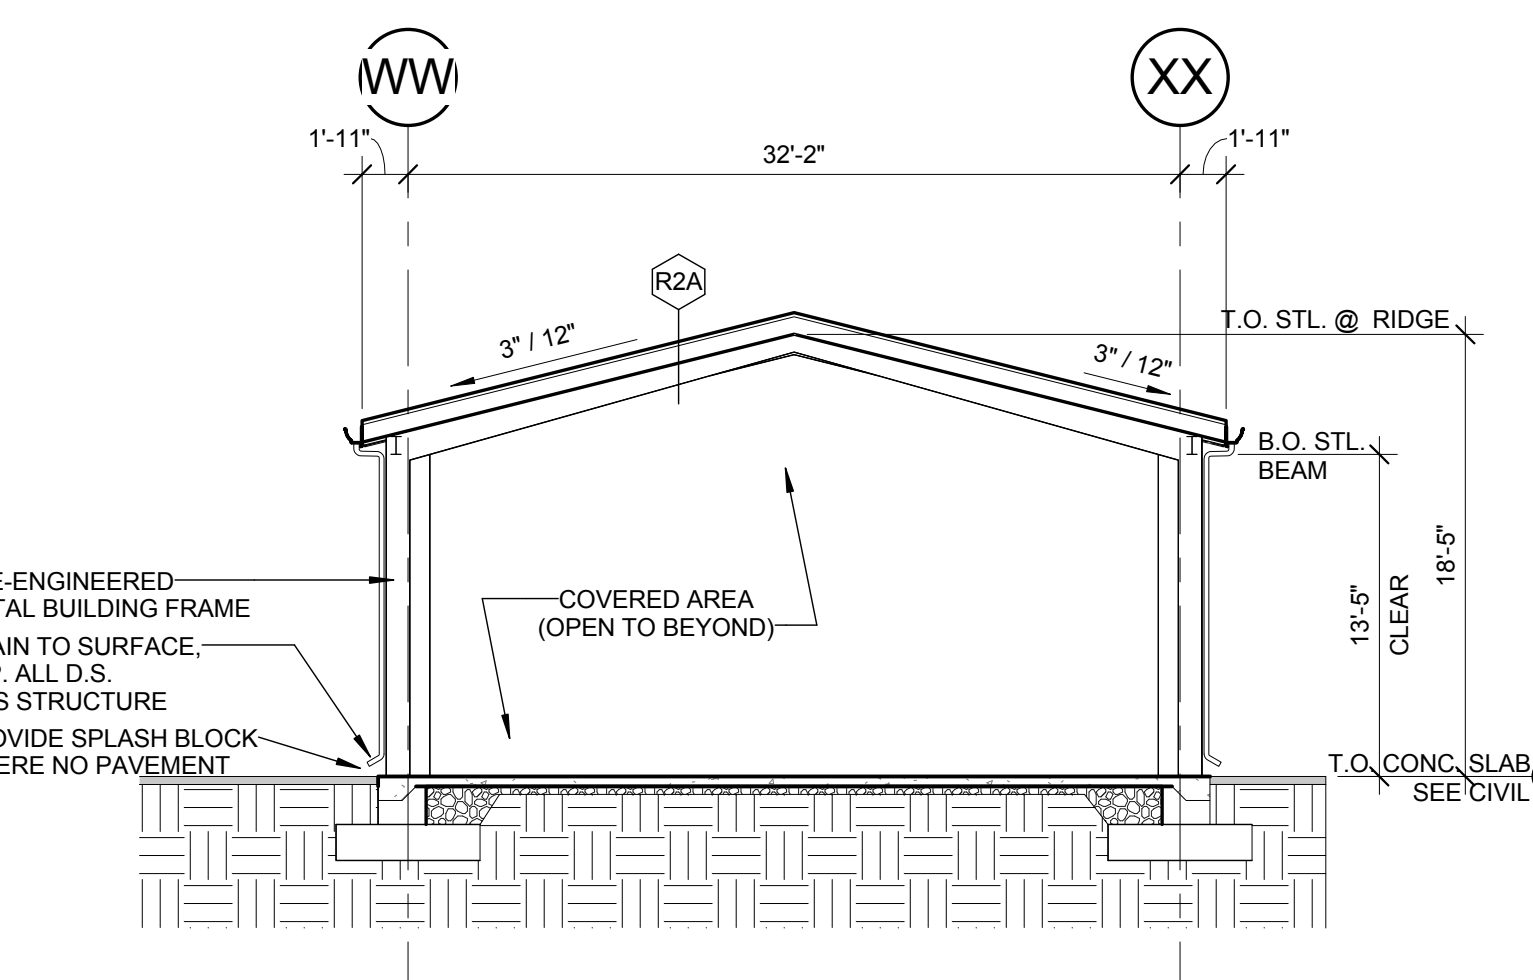





B4 WASH RACK CANOPY SECTION - ALTERNATE NO. 2A
1/8" = 1'-0"

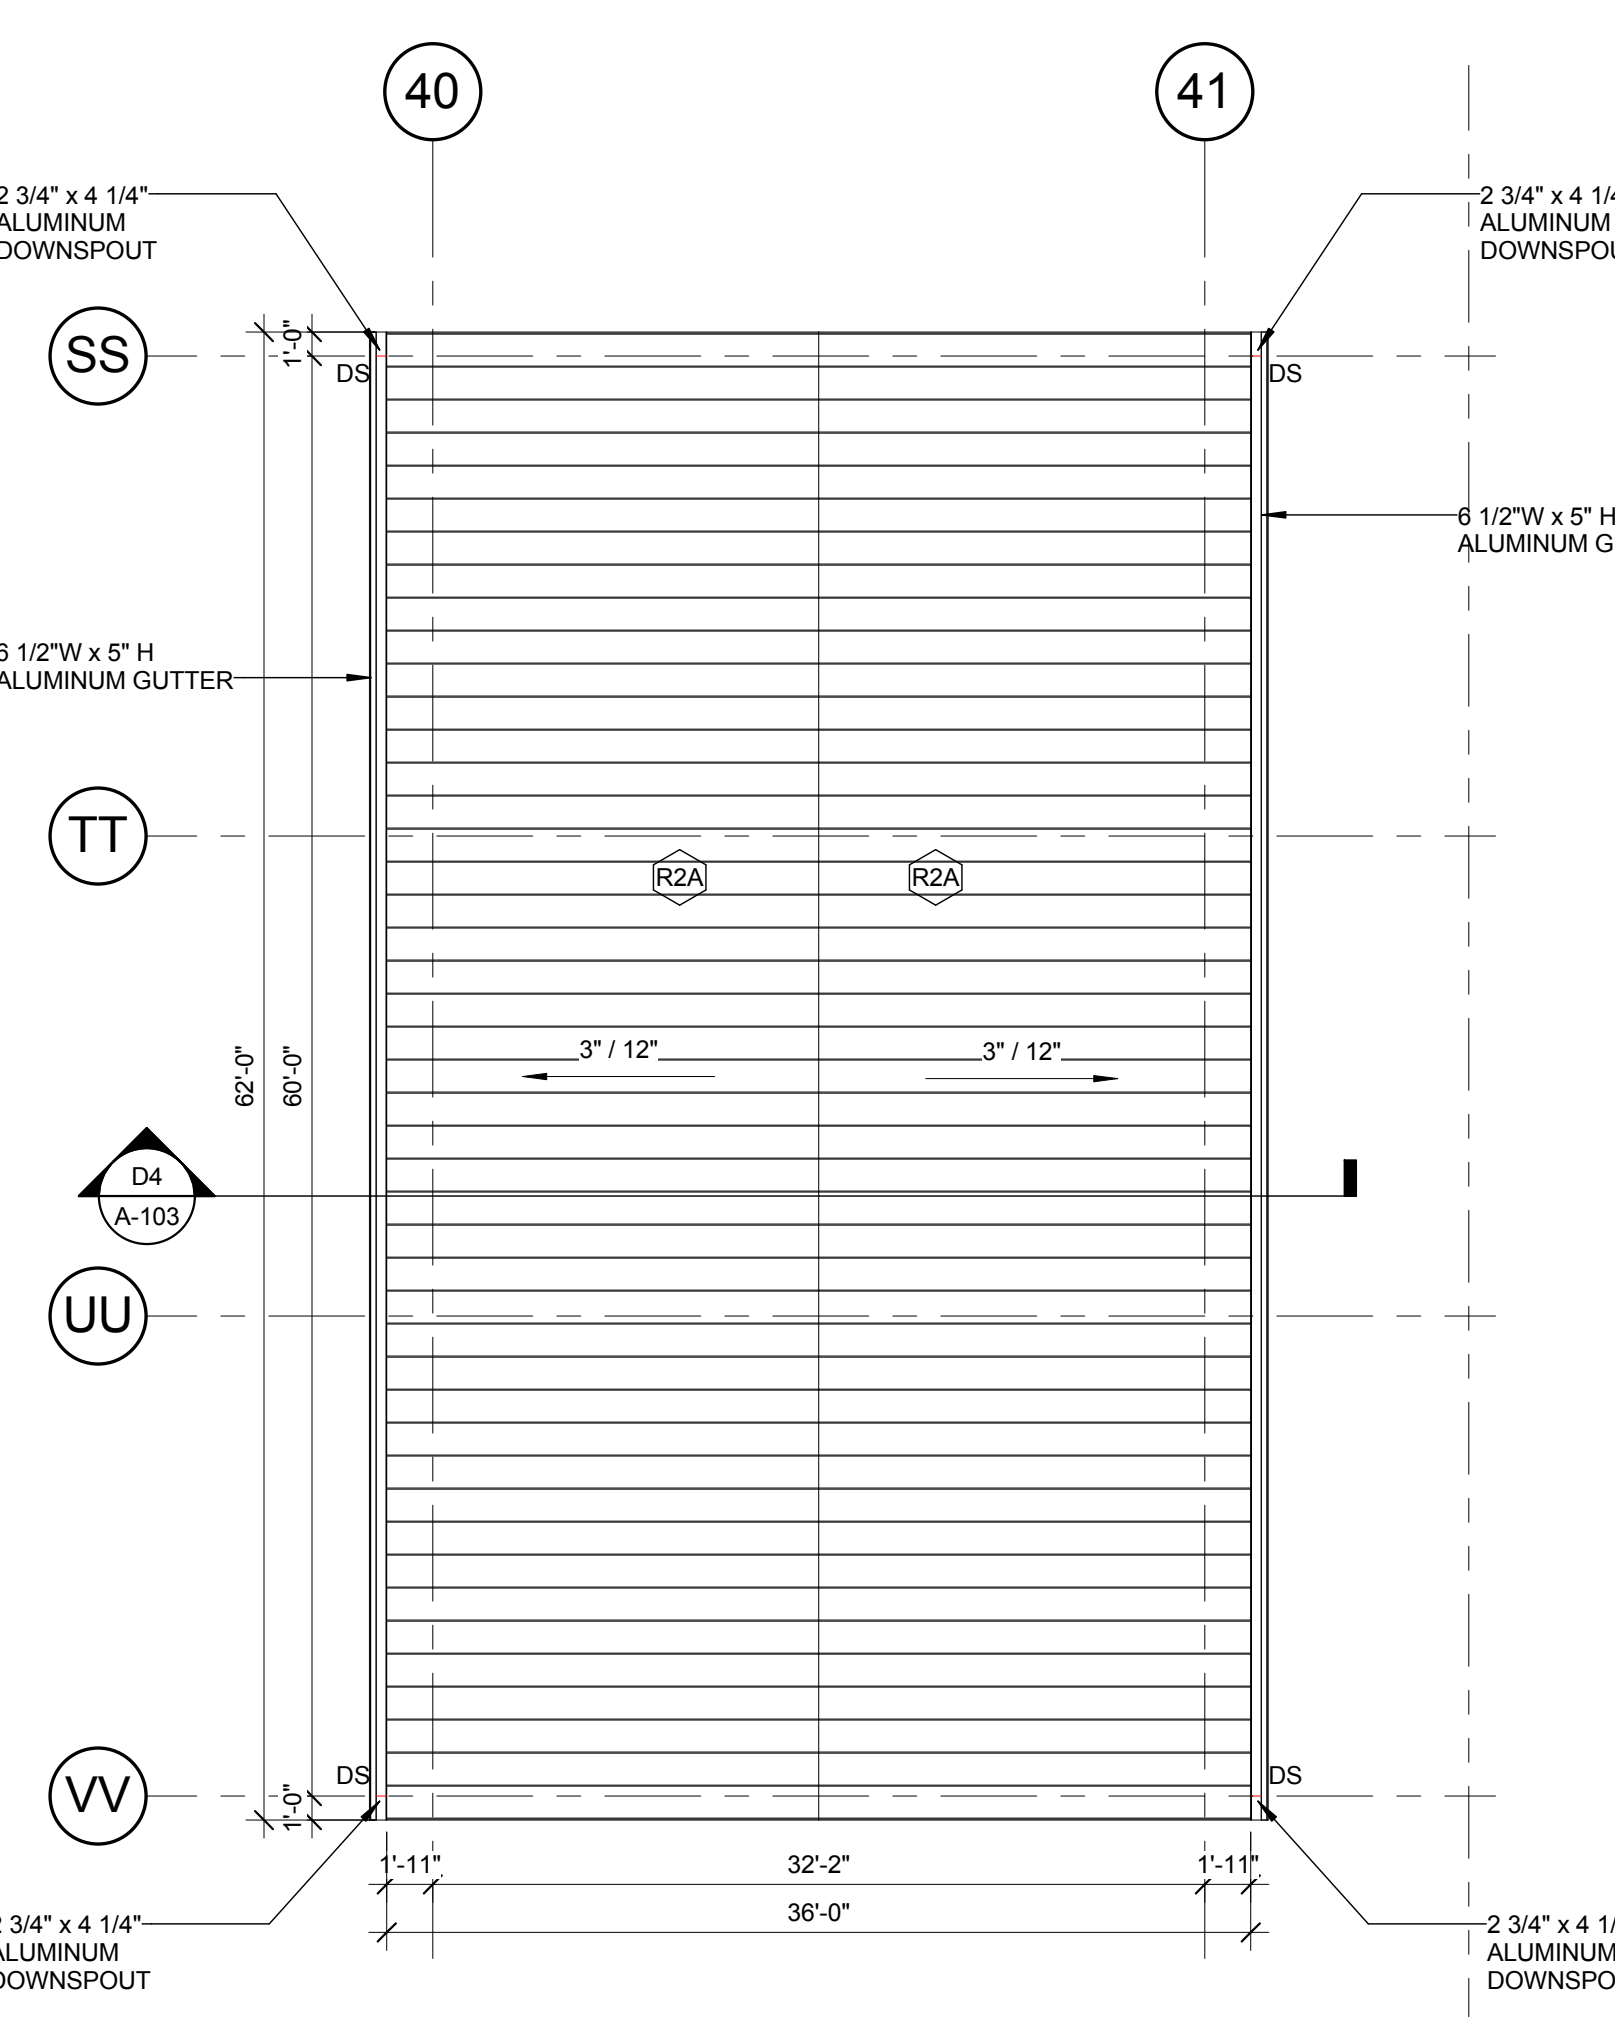

C3 STORAGE CANOPY ROOF PLAN - ALTERNATE NO. 12
1/8" = 1'-0"

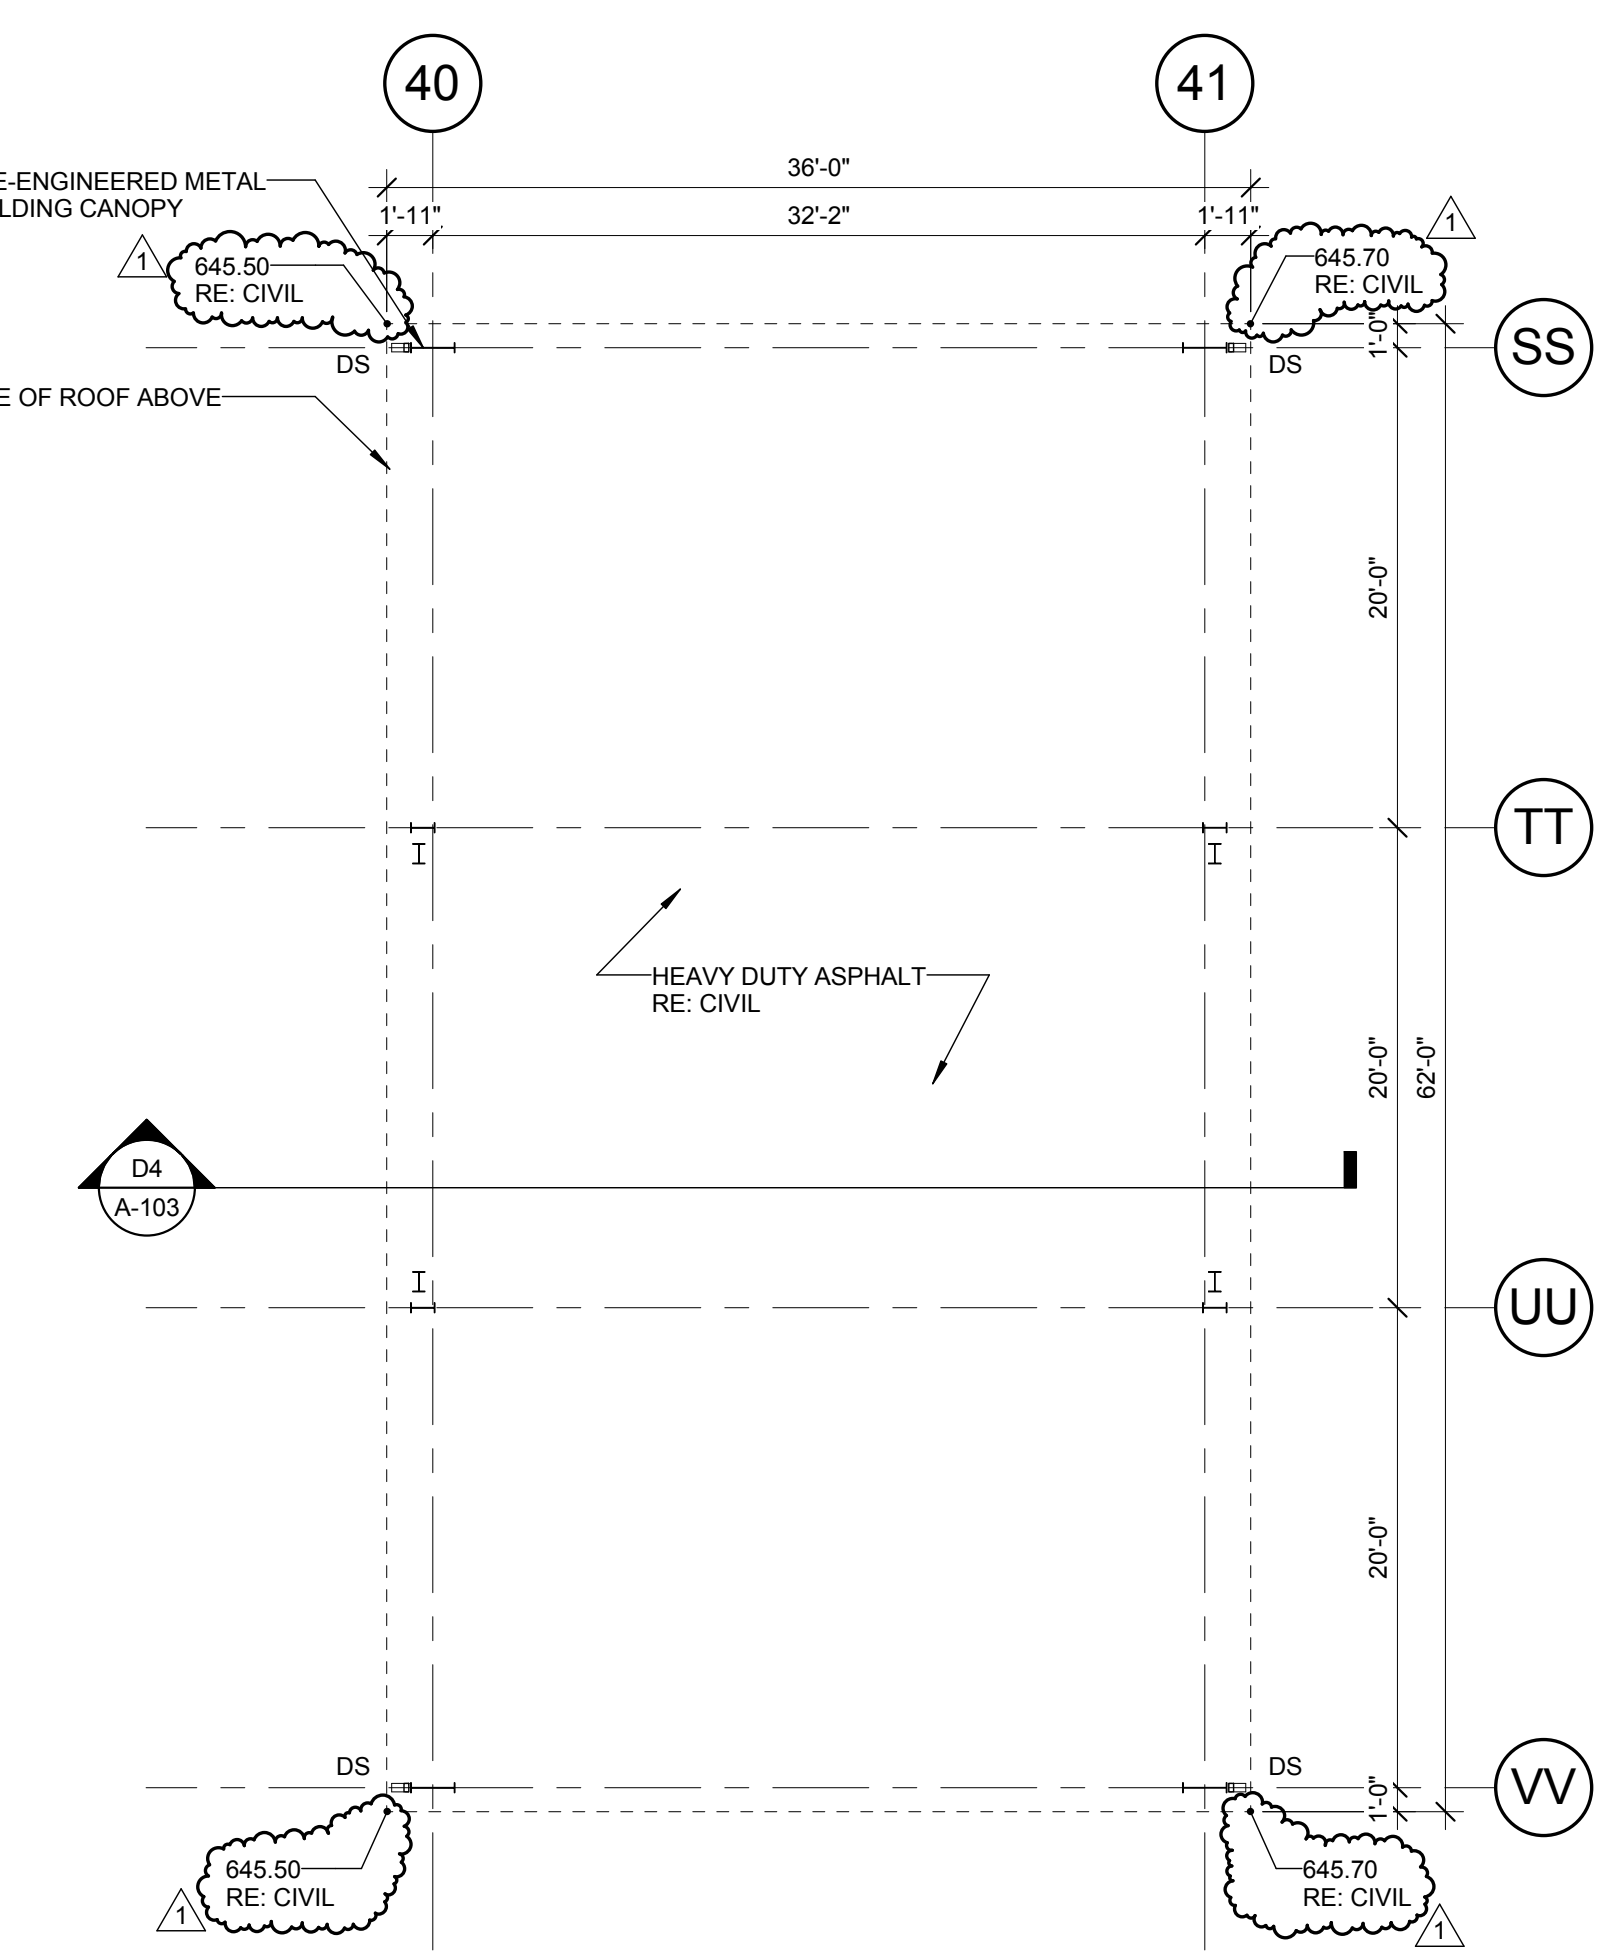

A3 STORAGE CANOPY PLAN - ALTERNATE NO. 12
1/8" = 1'-0"

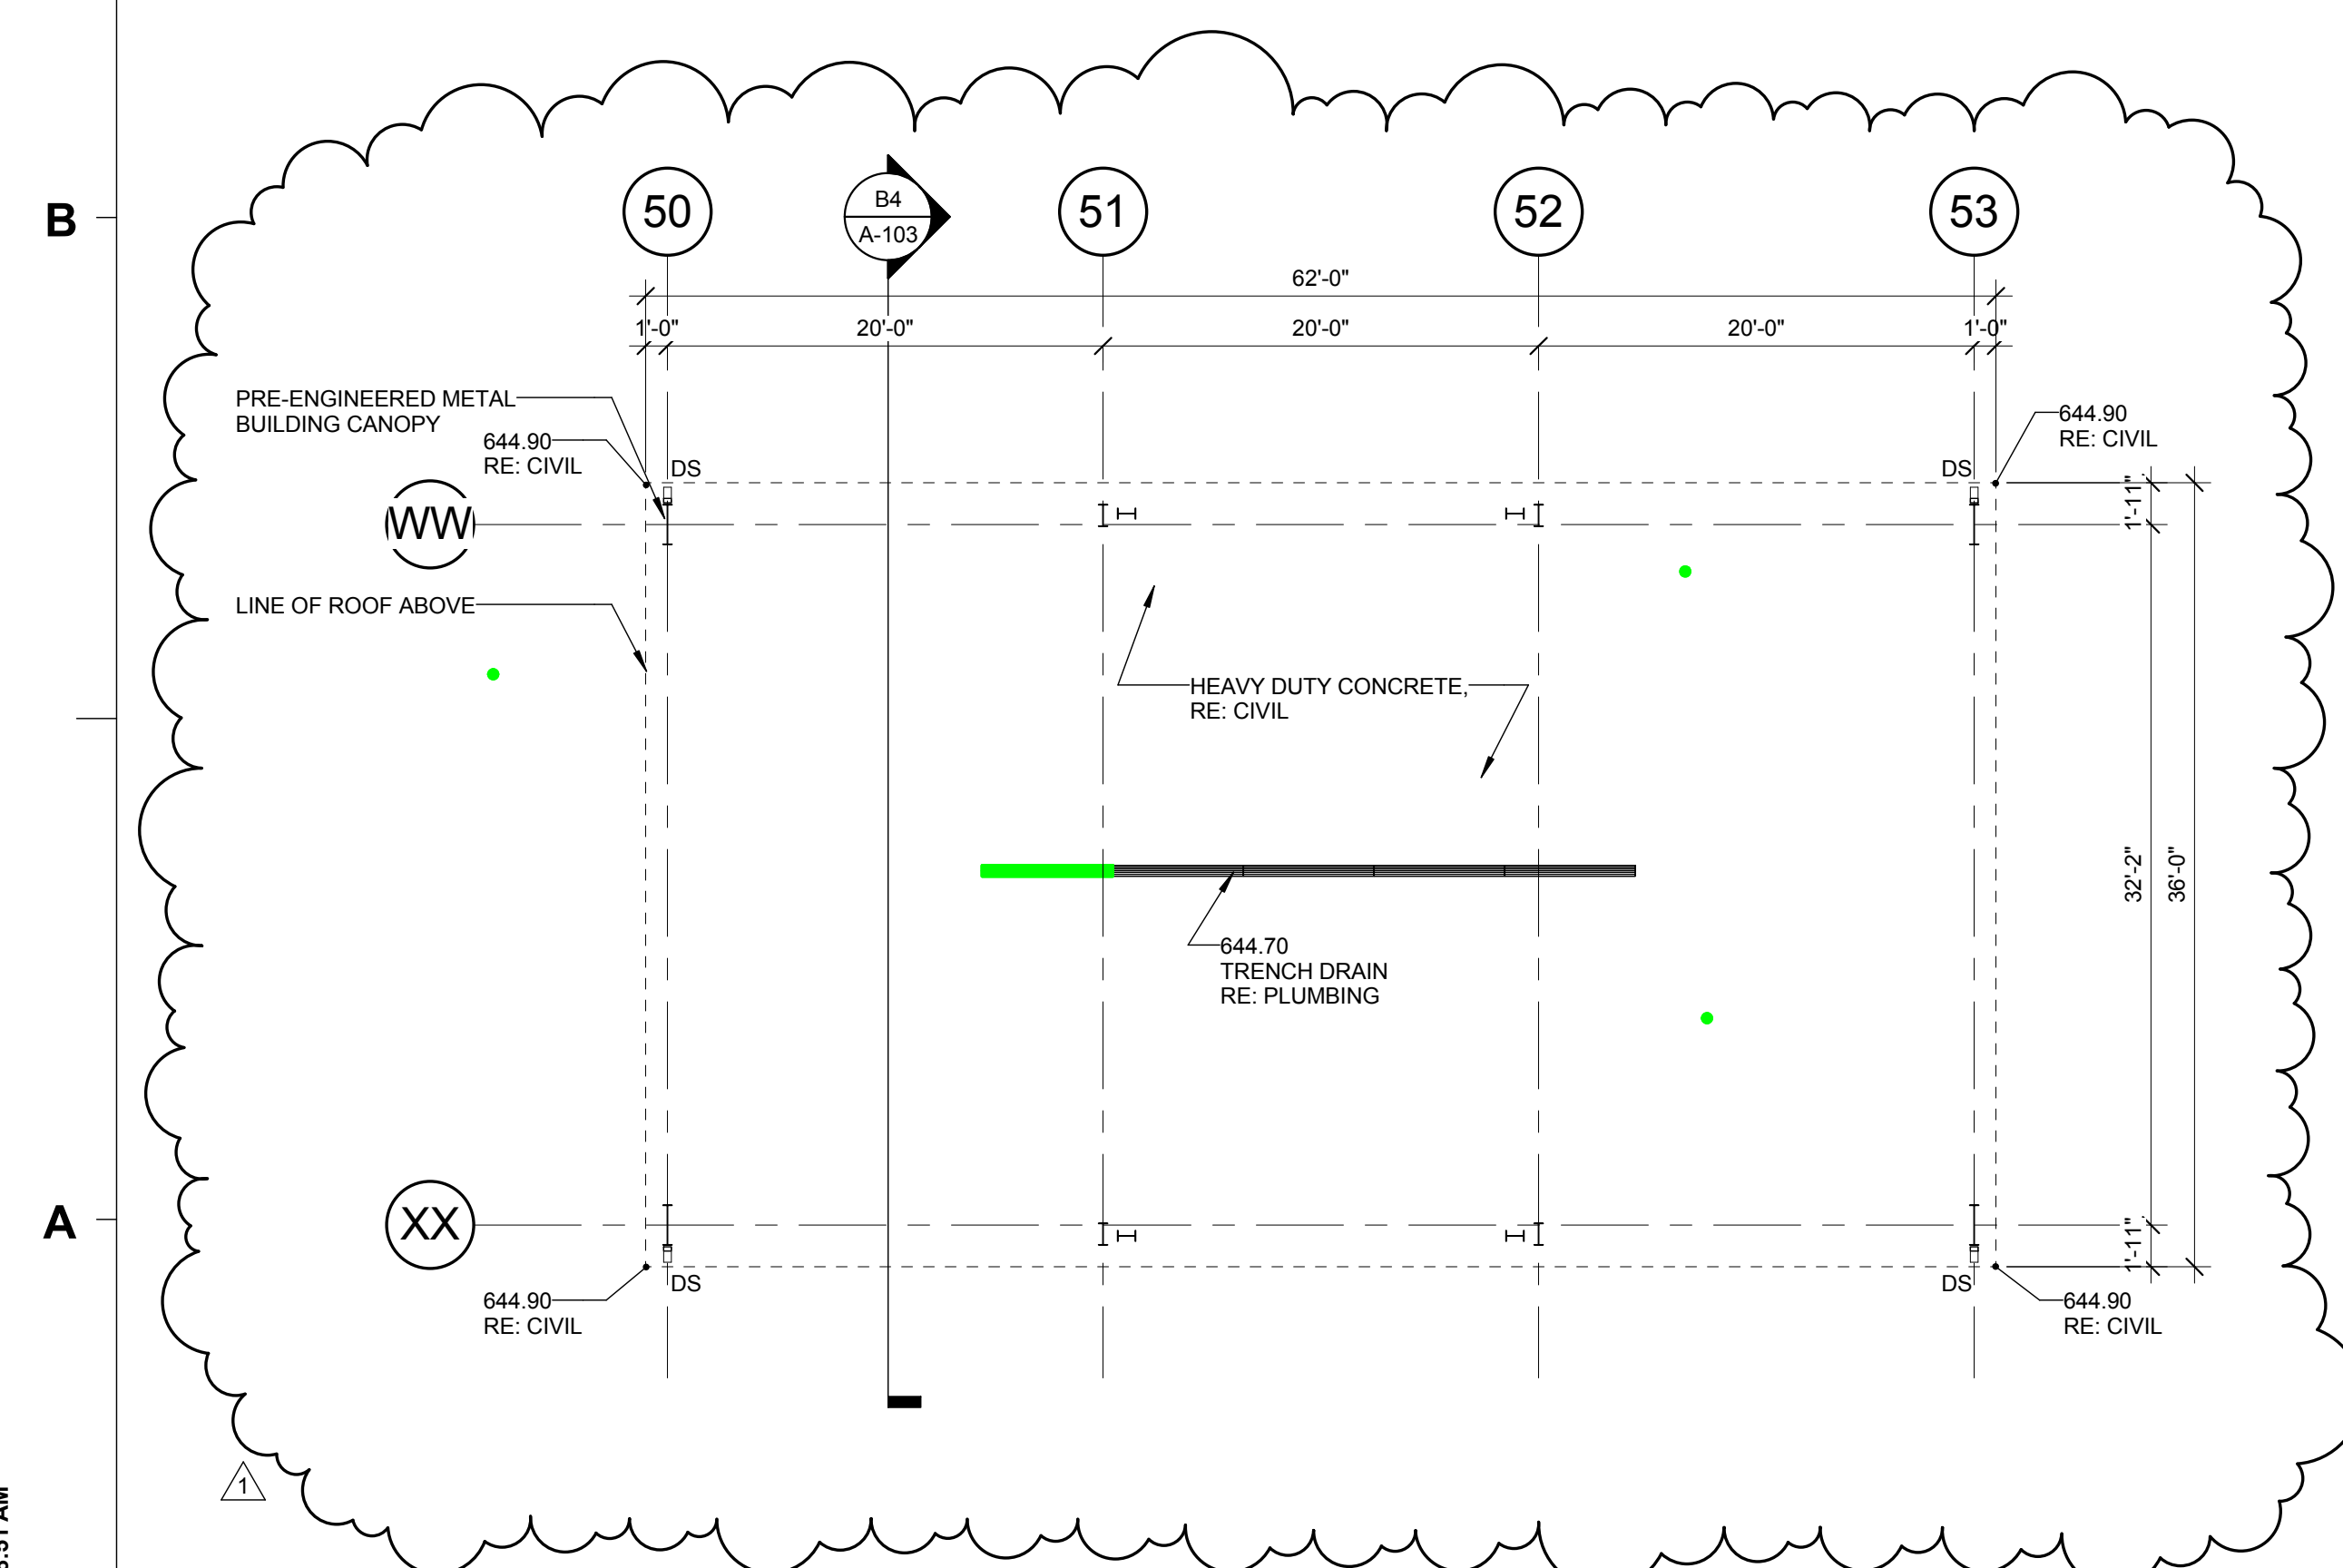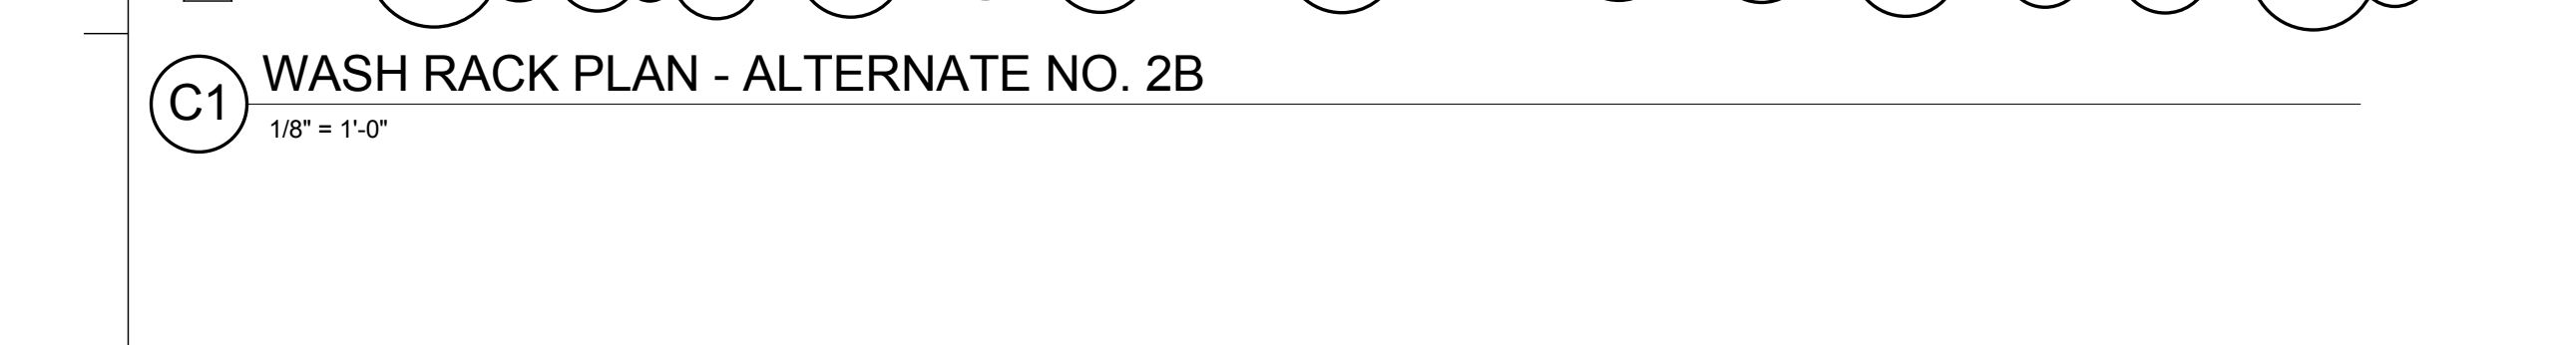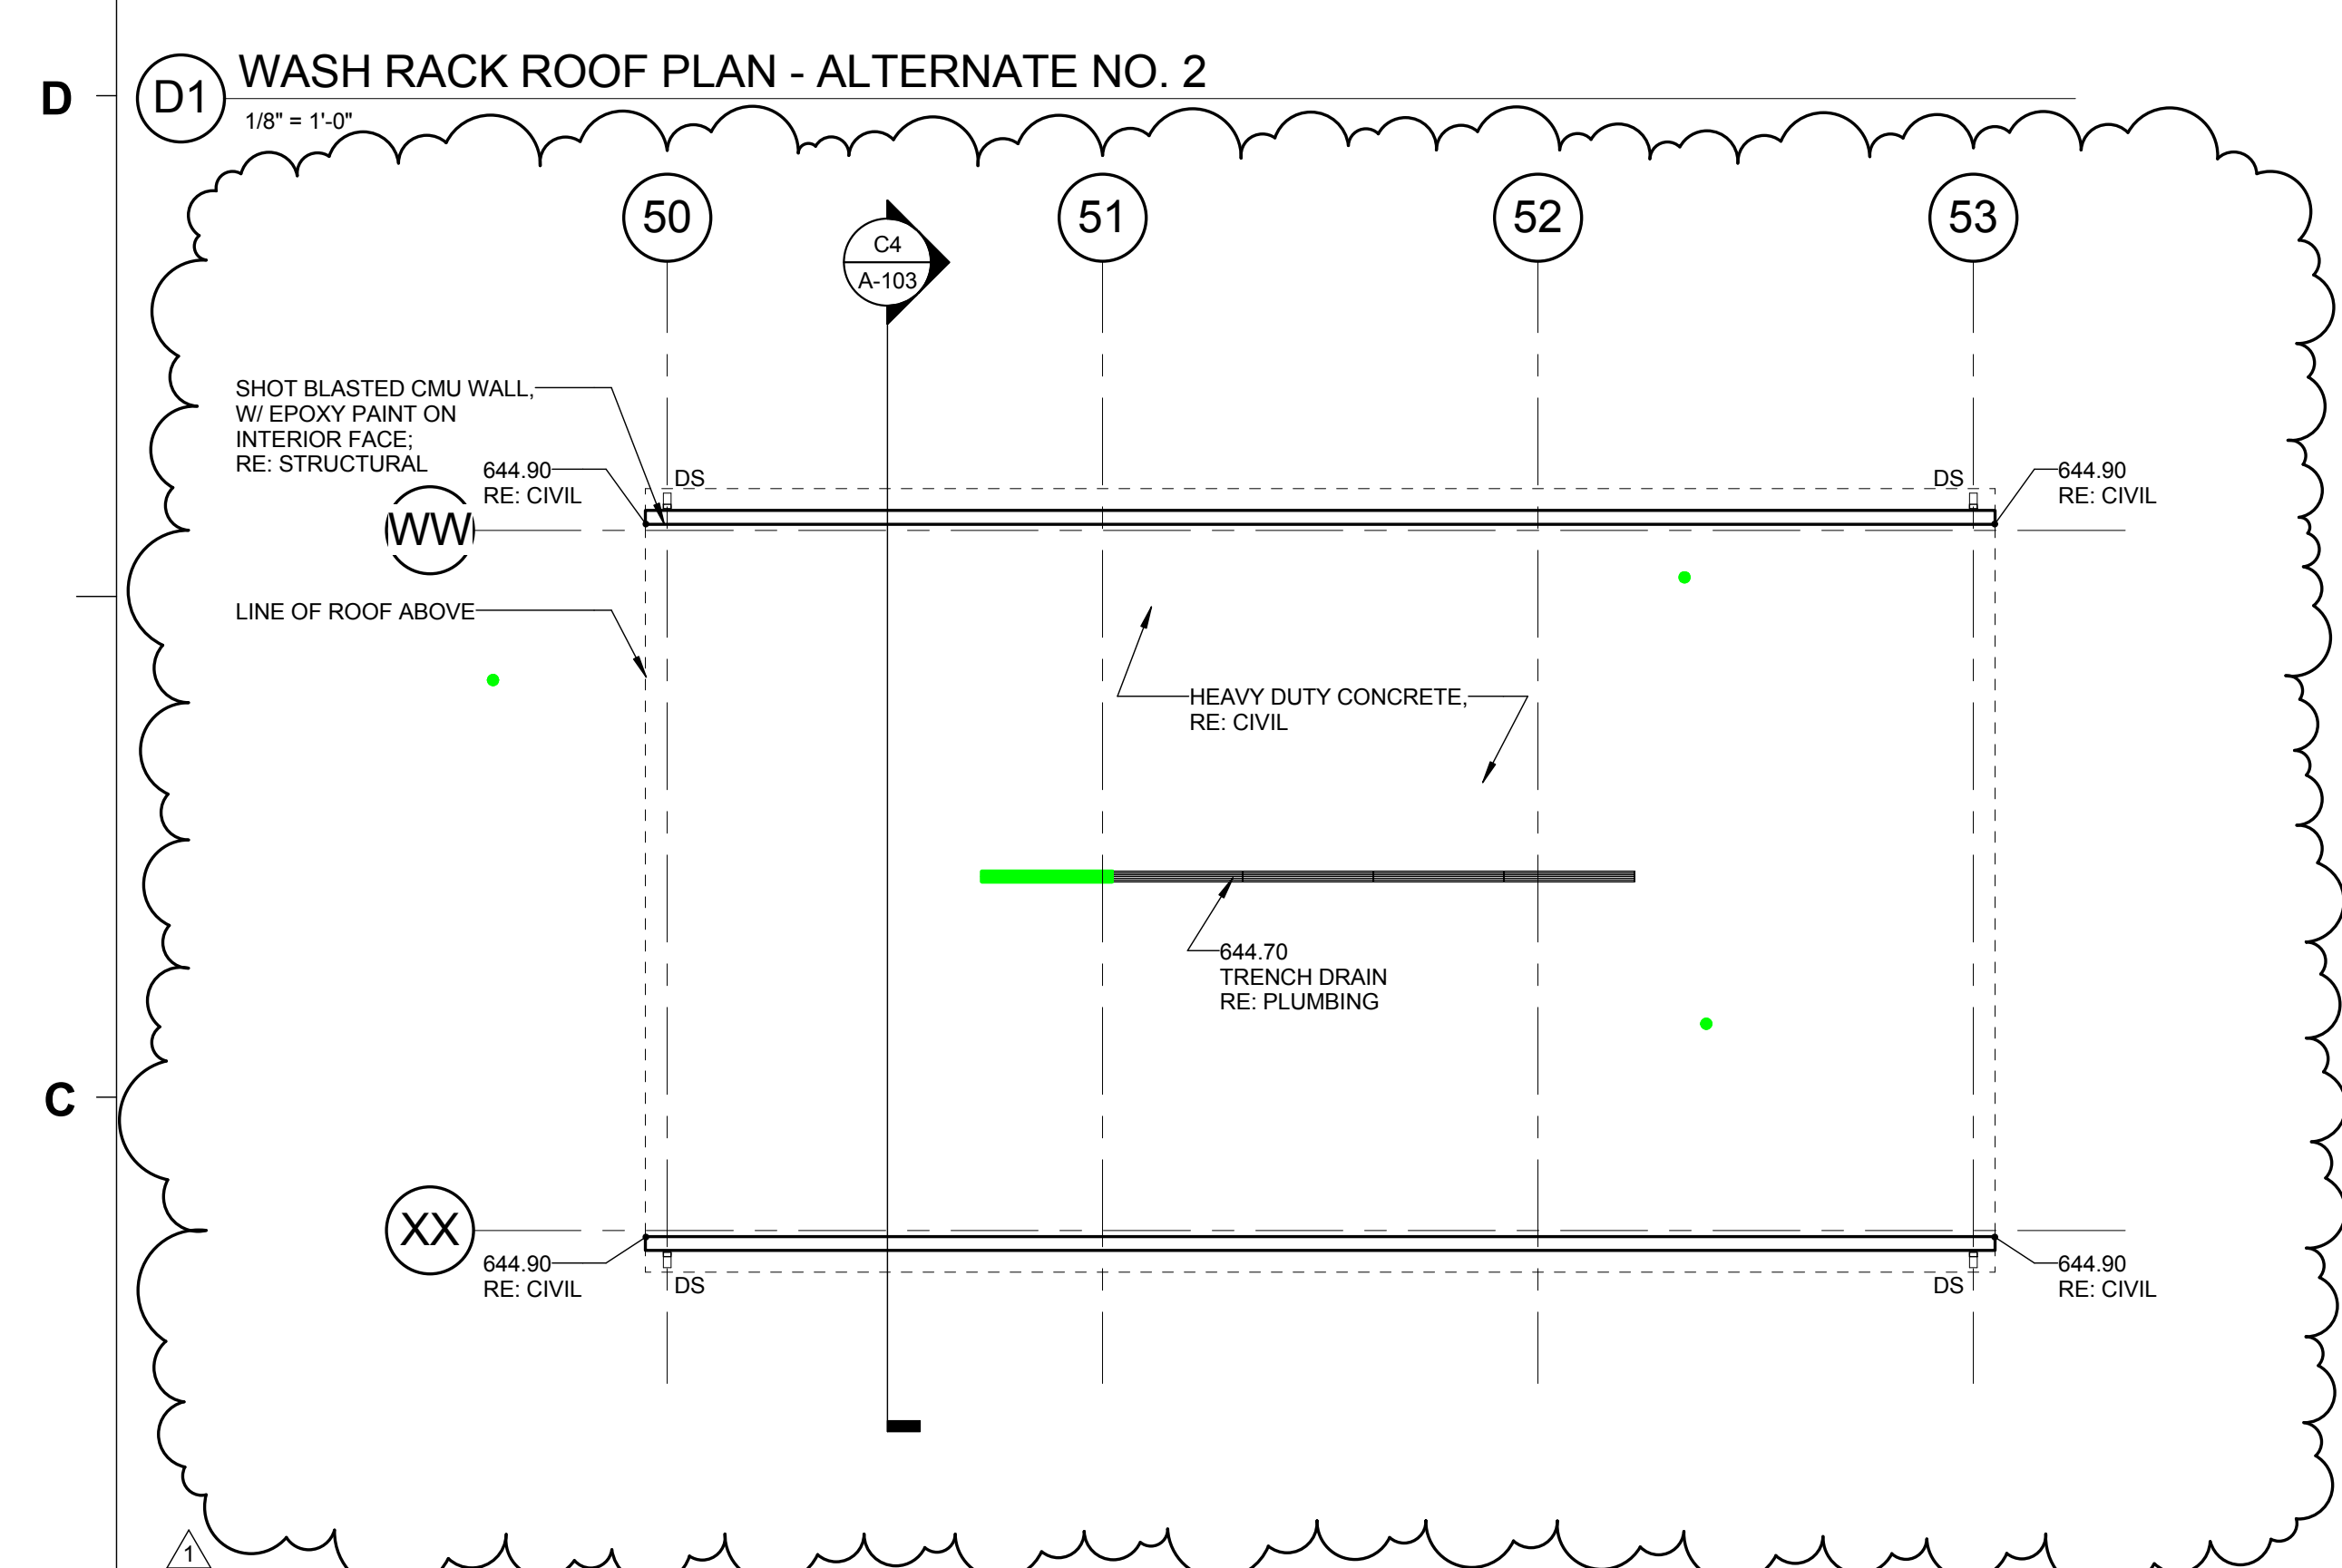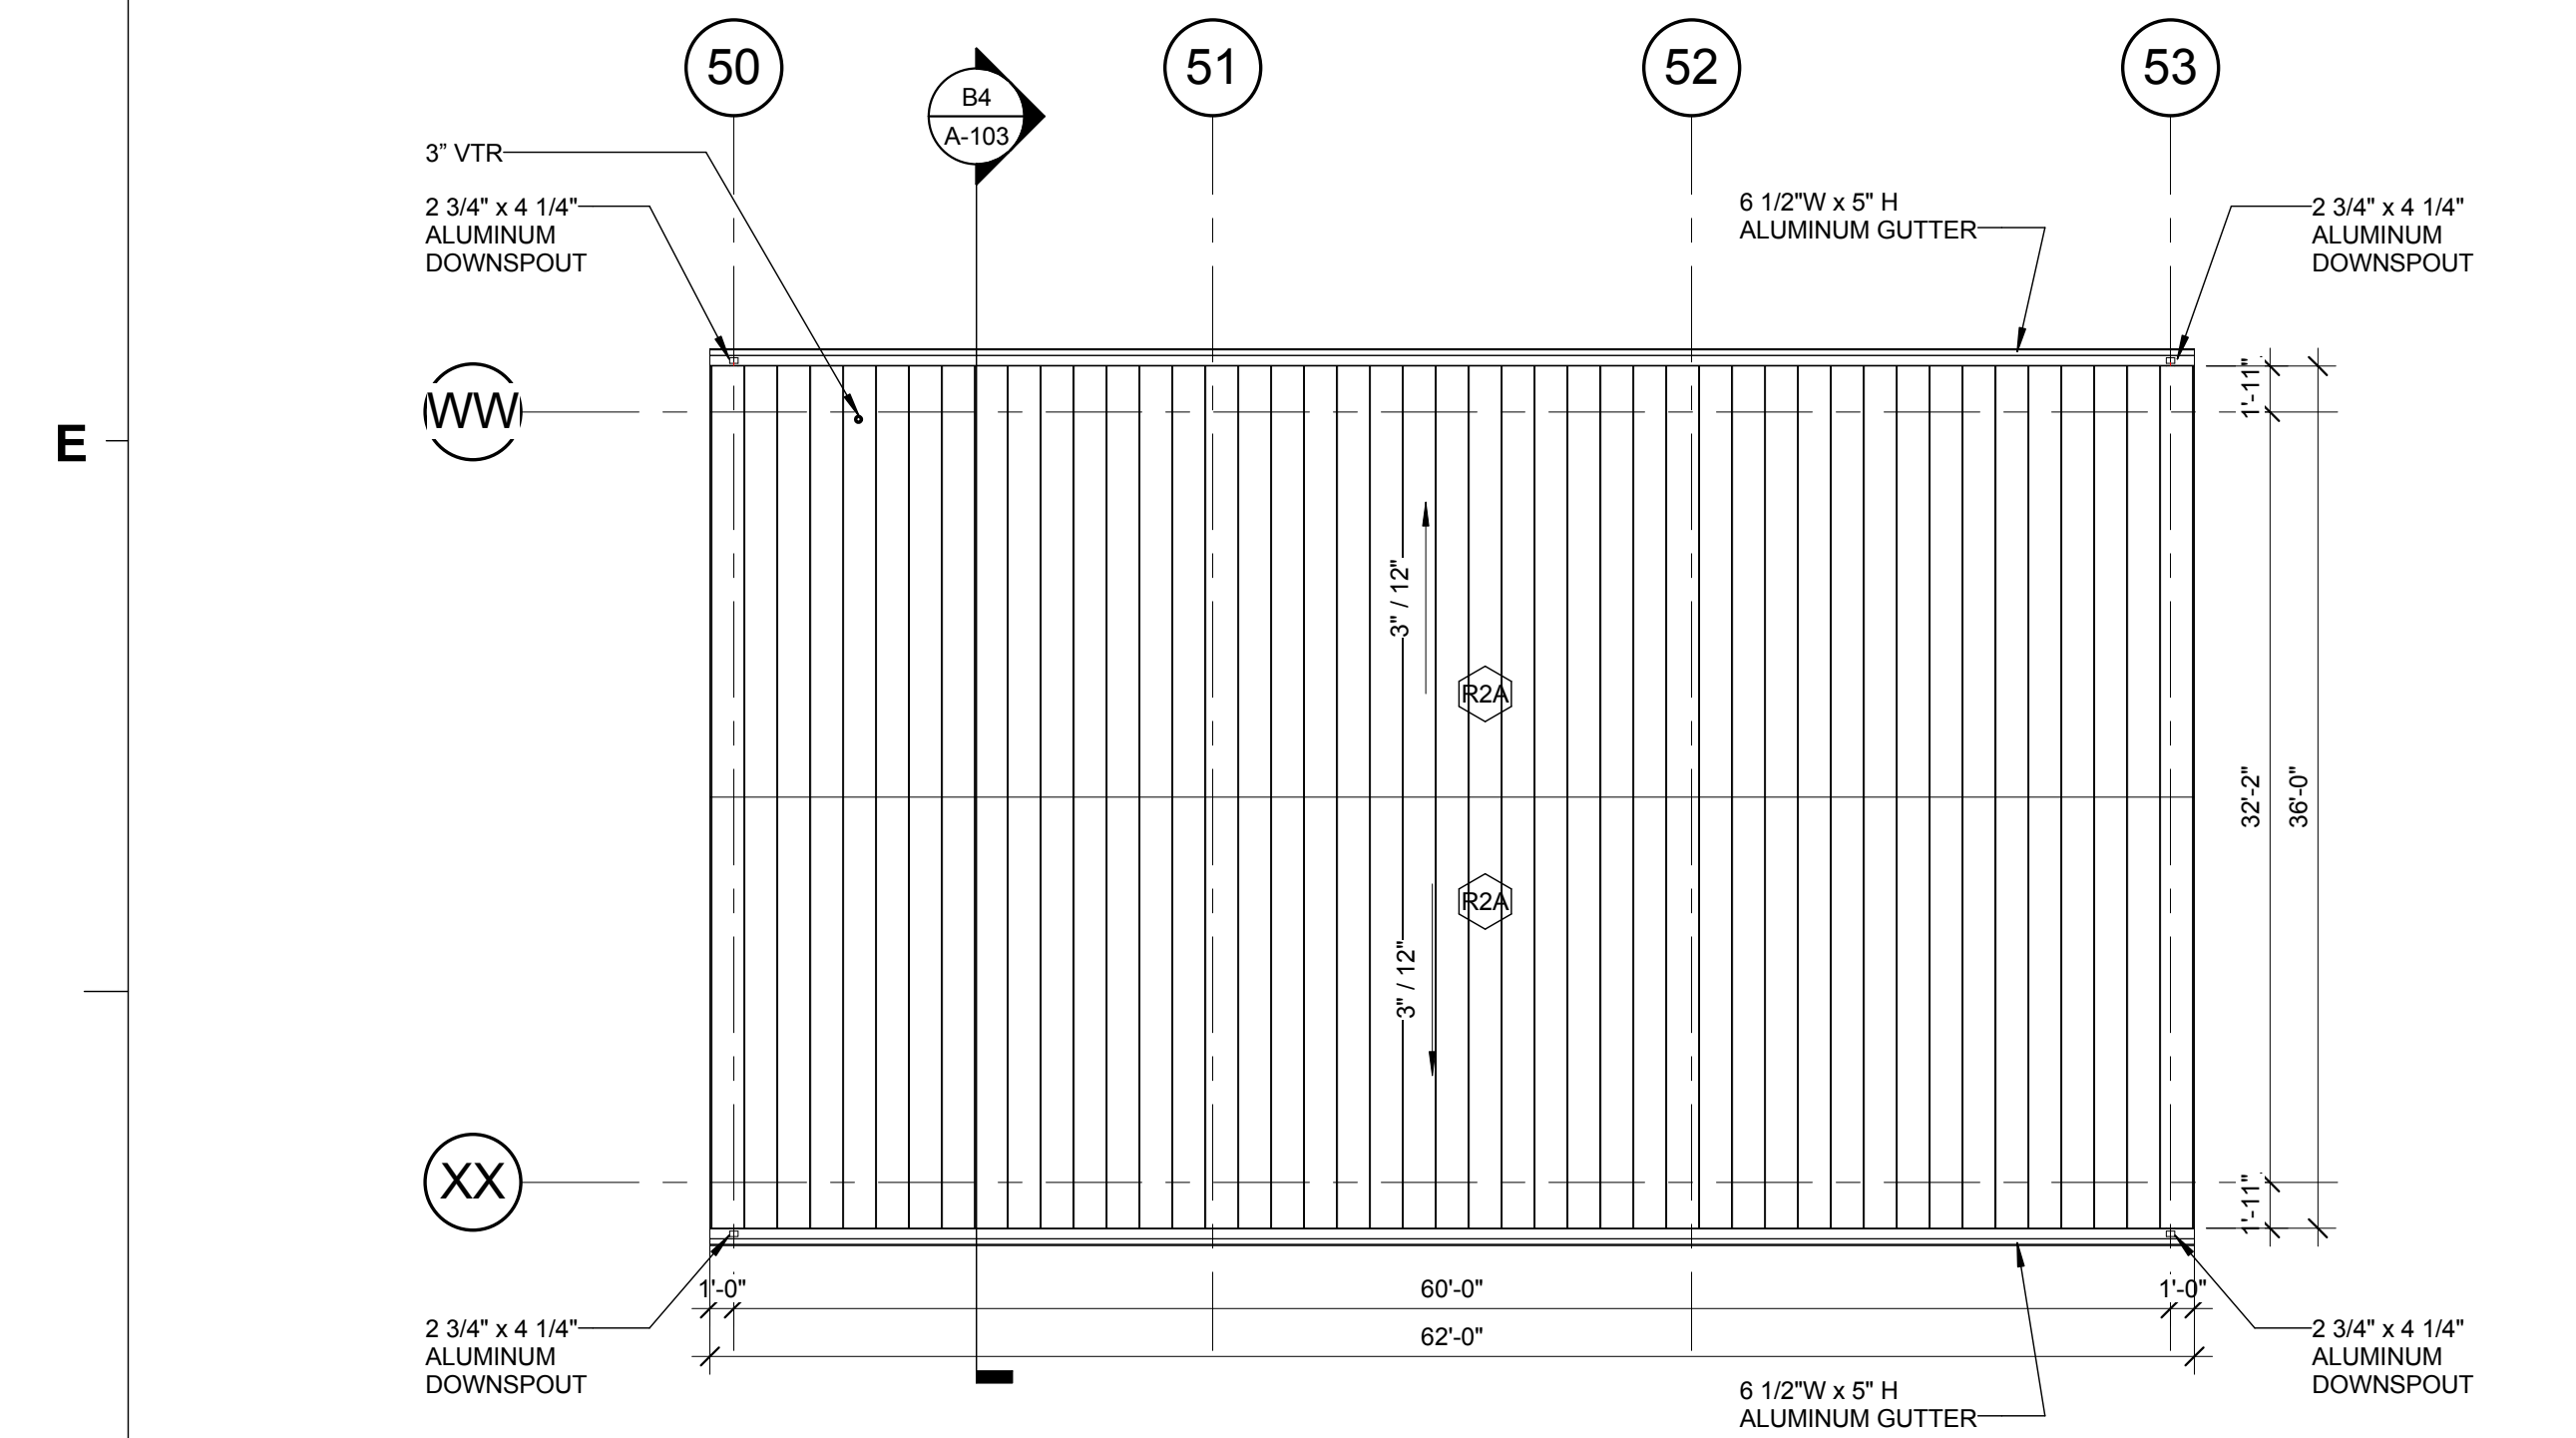

A1 WASH RACK PLAN - ALTERNATE NO. 2A
1/8" = 1'-0"

C:\Users\sharonh\Documents\Acrp_UNCC Facilities Operations Complex_2016_sharonh\Acrp_2017_08_30_2017_7:58:51 AM





MEMBERS OF THE AMERICAN INSTITUTE OF ARCHITECTS

COPYRIGHT 2017 ALL RIGHTS RESERVED
PRINTED OR ELECTRONIC DRAWINGS AND DOCUMENTATION MAY NOT BE REPRODUCED IN ANY FORM WITHOUT WRITTEN PERMISSION FROM LS3P ASSOCIATES LTD.


REVISIONS:

No.	Description	Date
1	Addendum No. 4	08/28/2017


PROJECT: 9202-164730
SCO ID: 16-15656-02B
ITEM: 315 CODE: 41526
DATE: AUGUST 21, 2017
DRAWN BY: AR
CHECKED BY: SH

INTERIOR ELEVATIONS


A-252

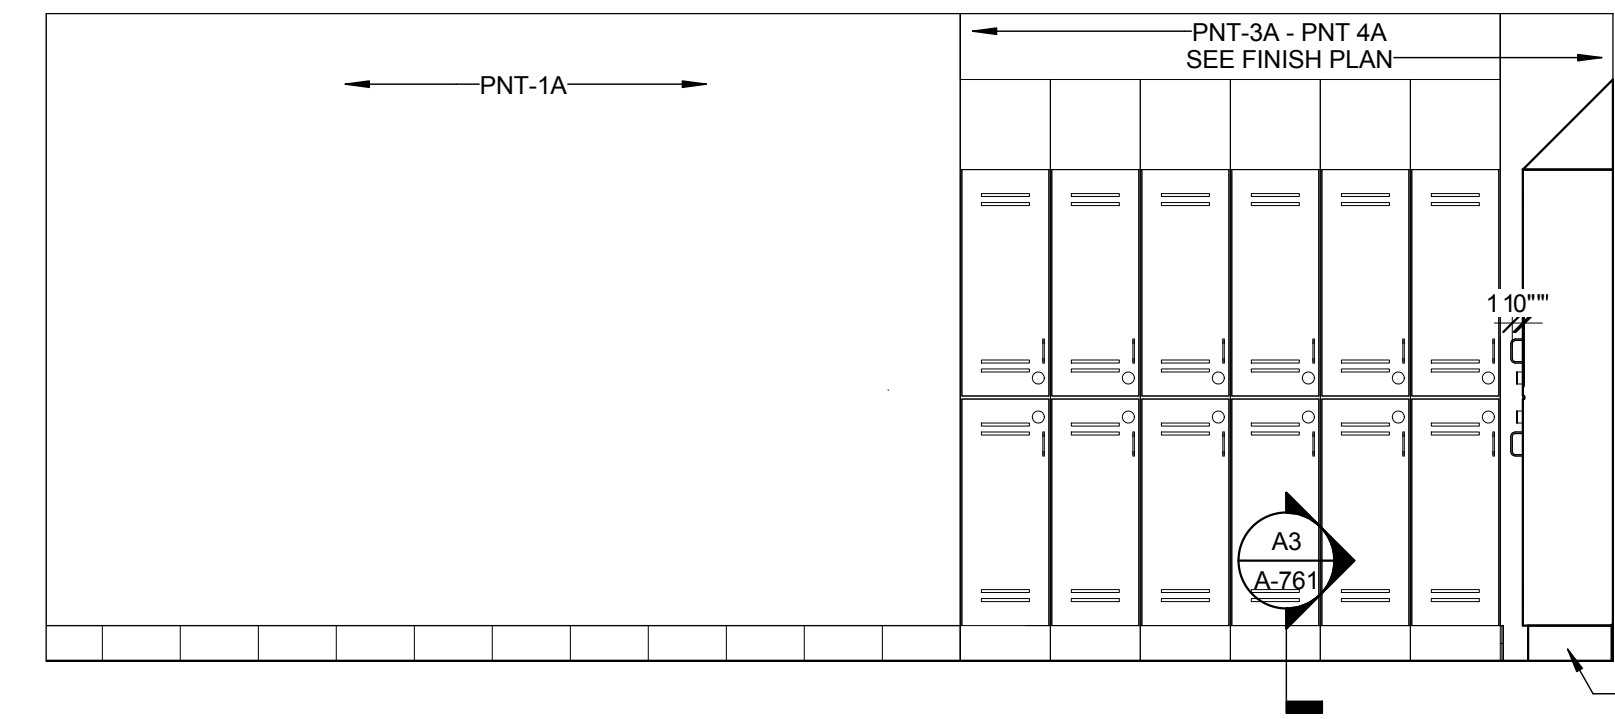


E2 CHANGING LOCKERS 136/140 TYP. WALL
3/8" = 1'-0"

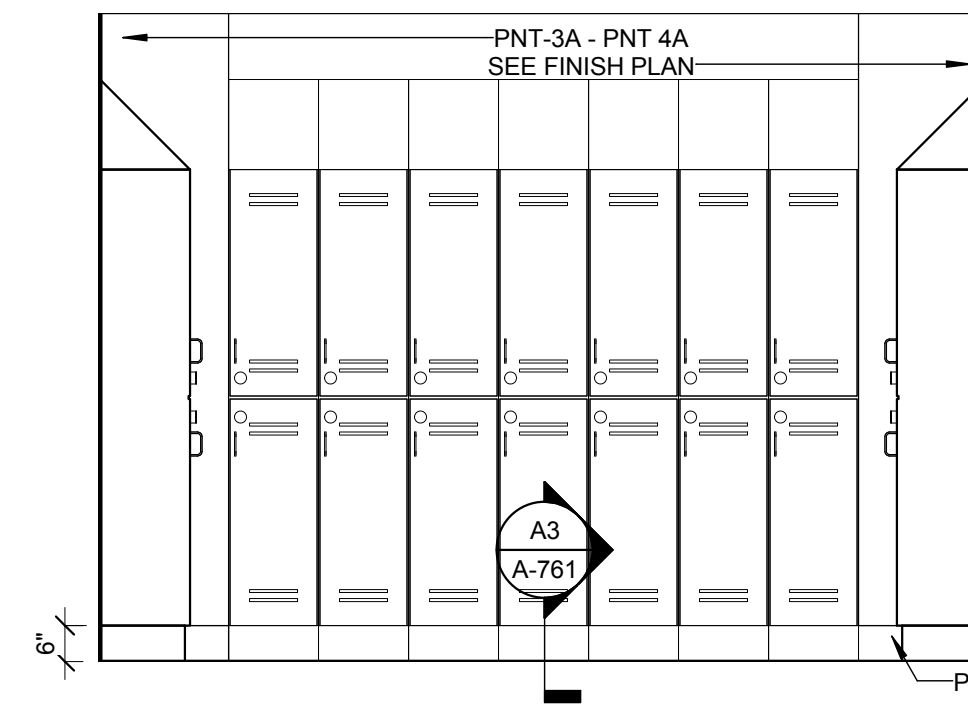


E4 CHANGING LOCKERS 136/140 TYP. WEST WALL
3/8" = 1'-0"

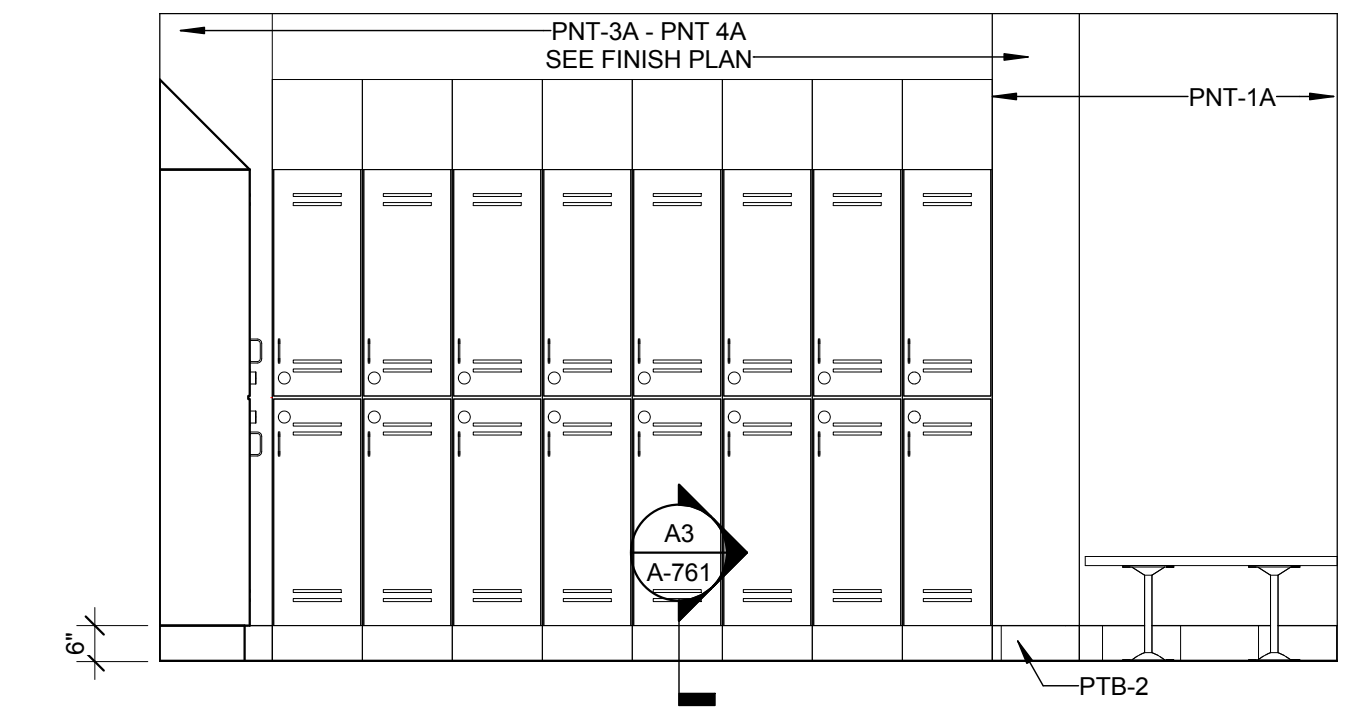


E5 CHANGING LOCKERS 136/140 TYP. BENCH WALL
3/8" = 1'-0"

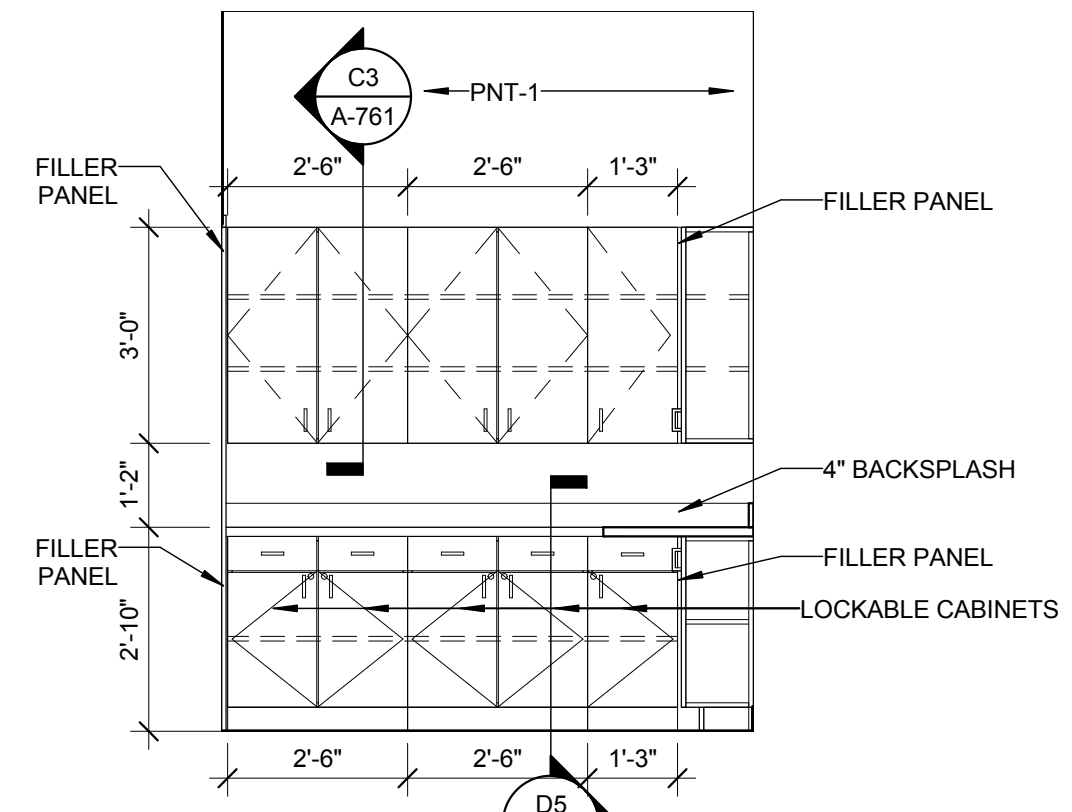


D1 WORKROOM 125D SOUTH ELEVATION
3/8" = 1'-0"

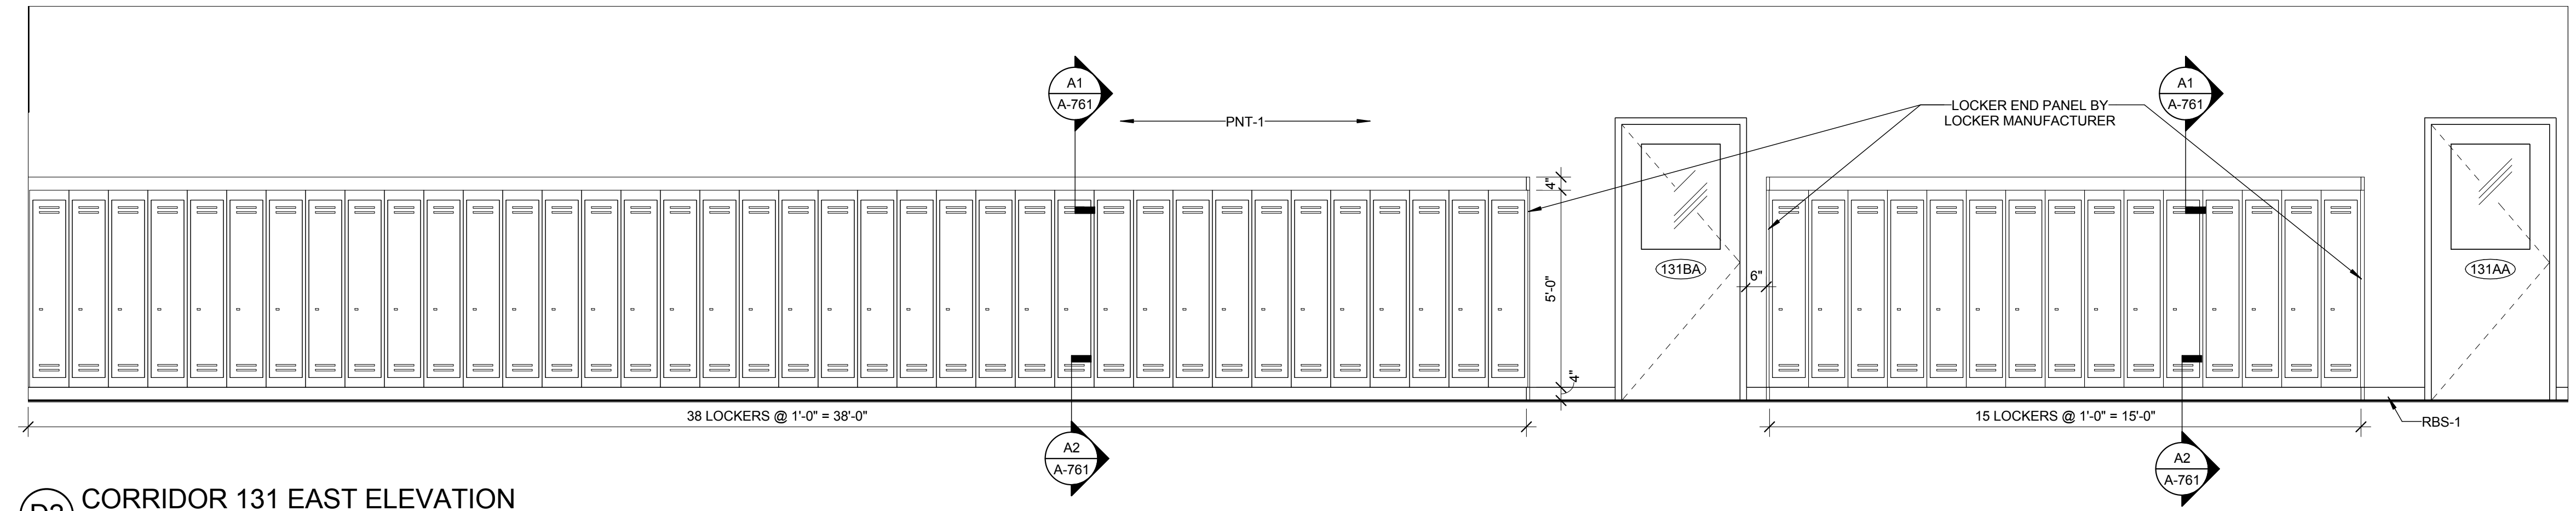


D2 CORRIDOR 131 EAST ELEVATION
3/8" = 1'-0"

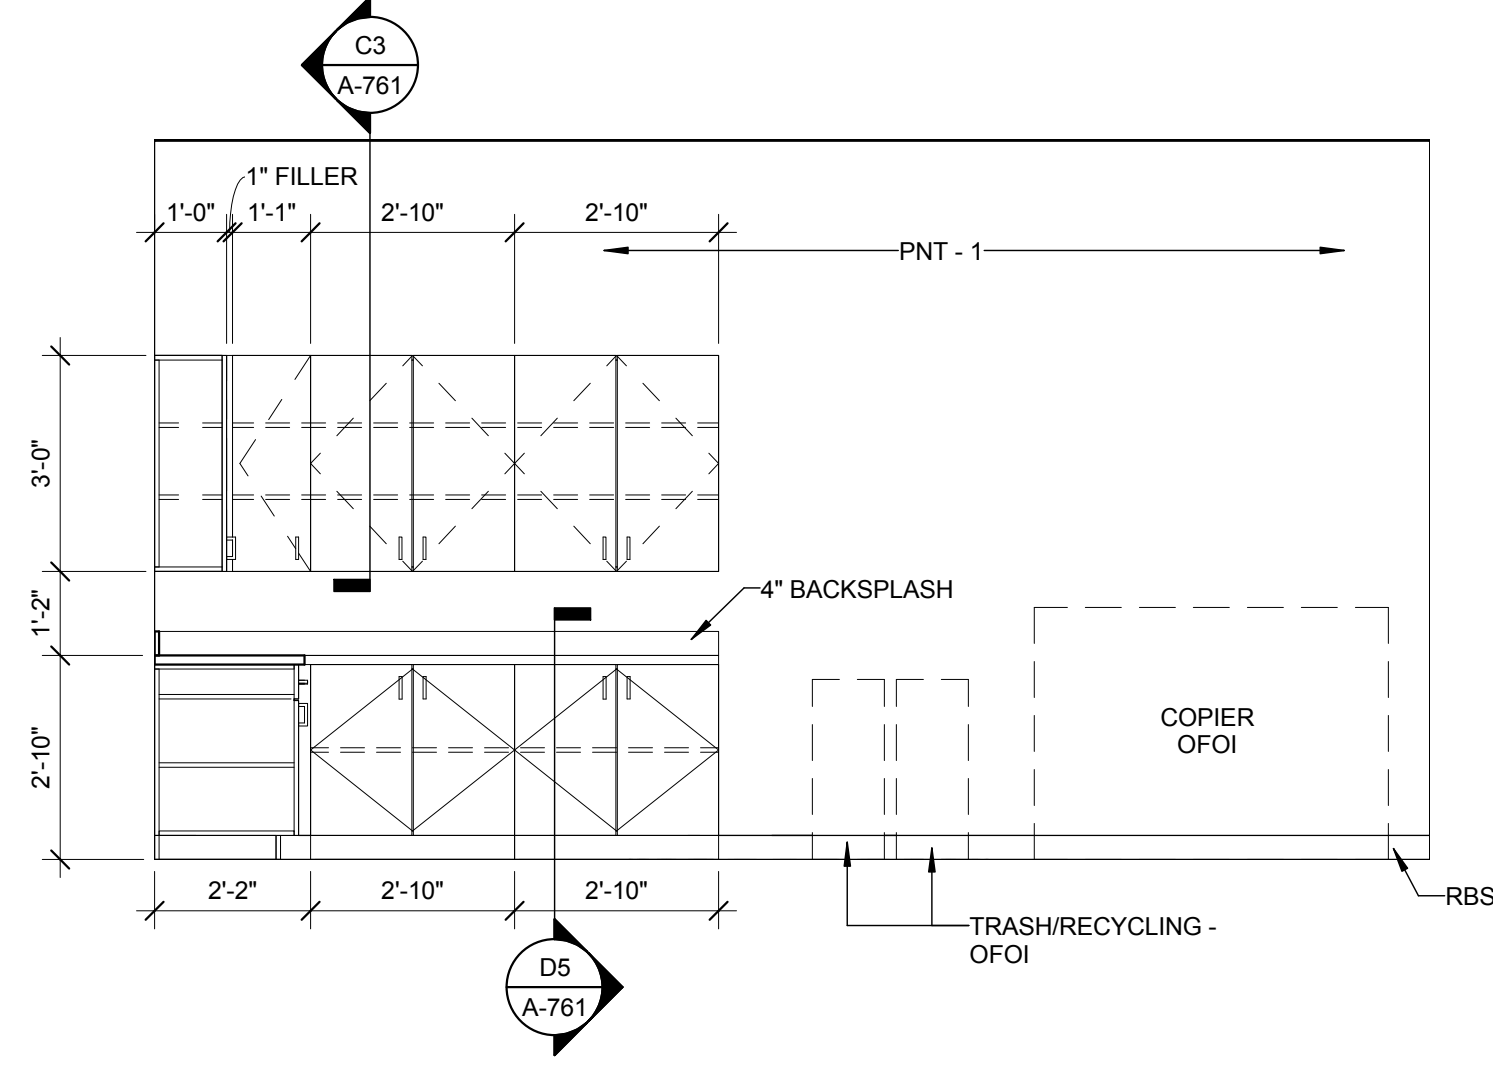


C1 WORKROOM 125D WEST ELEVATION
3/8" = 1'-0"

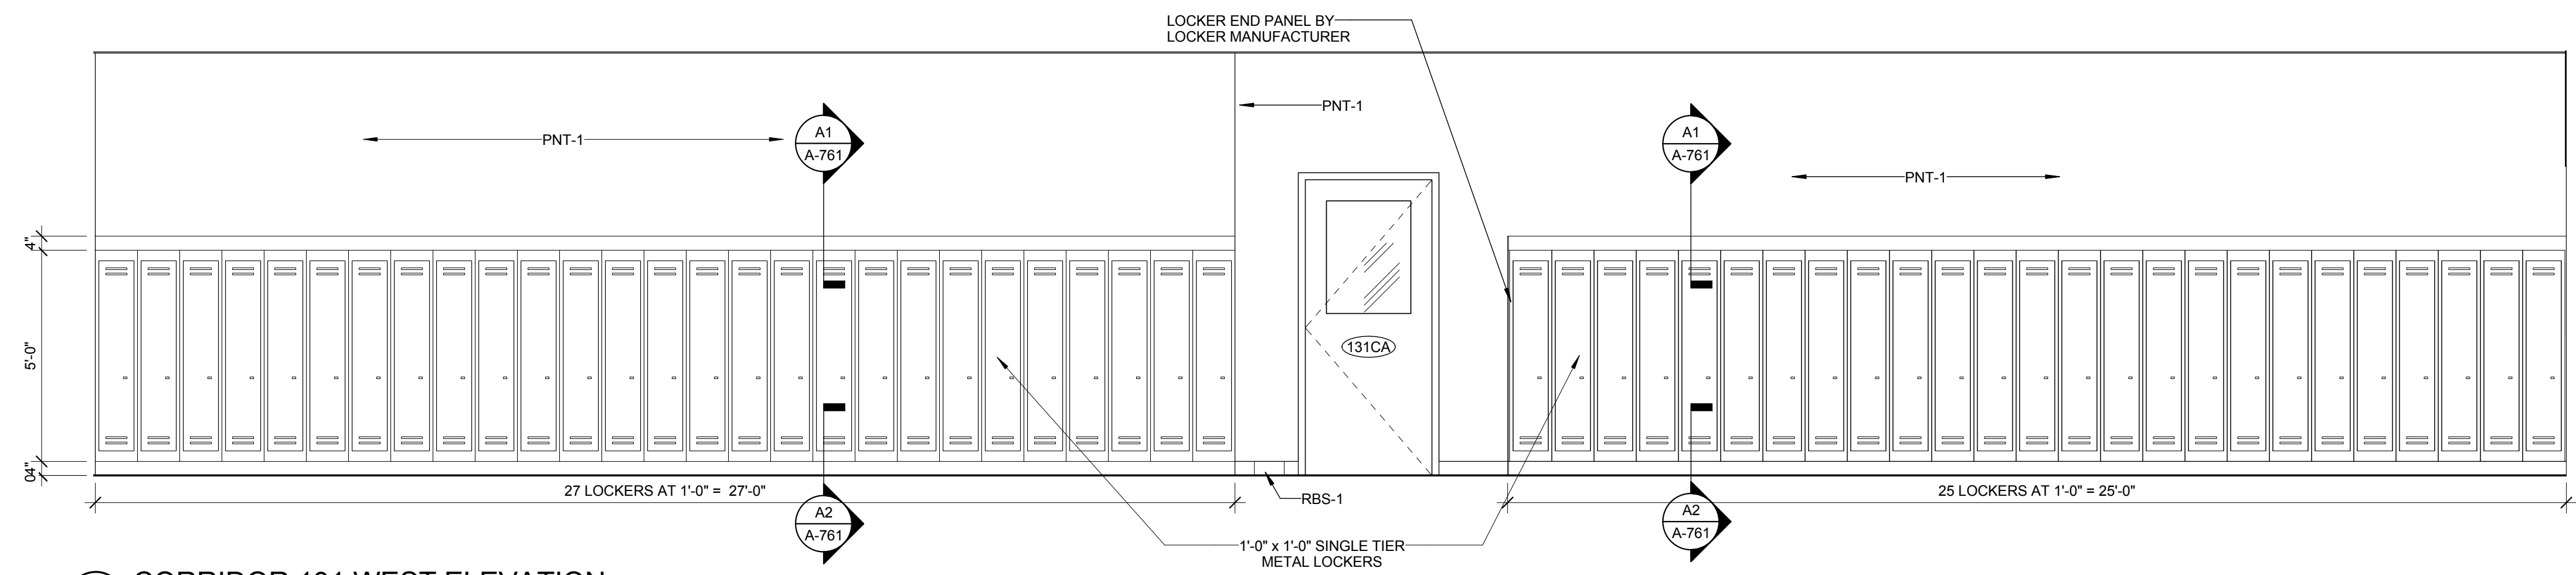


C2 CORRIDOR 131 WEST ELEVATION
3/8" = 1'-0"

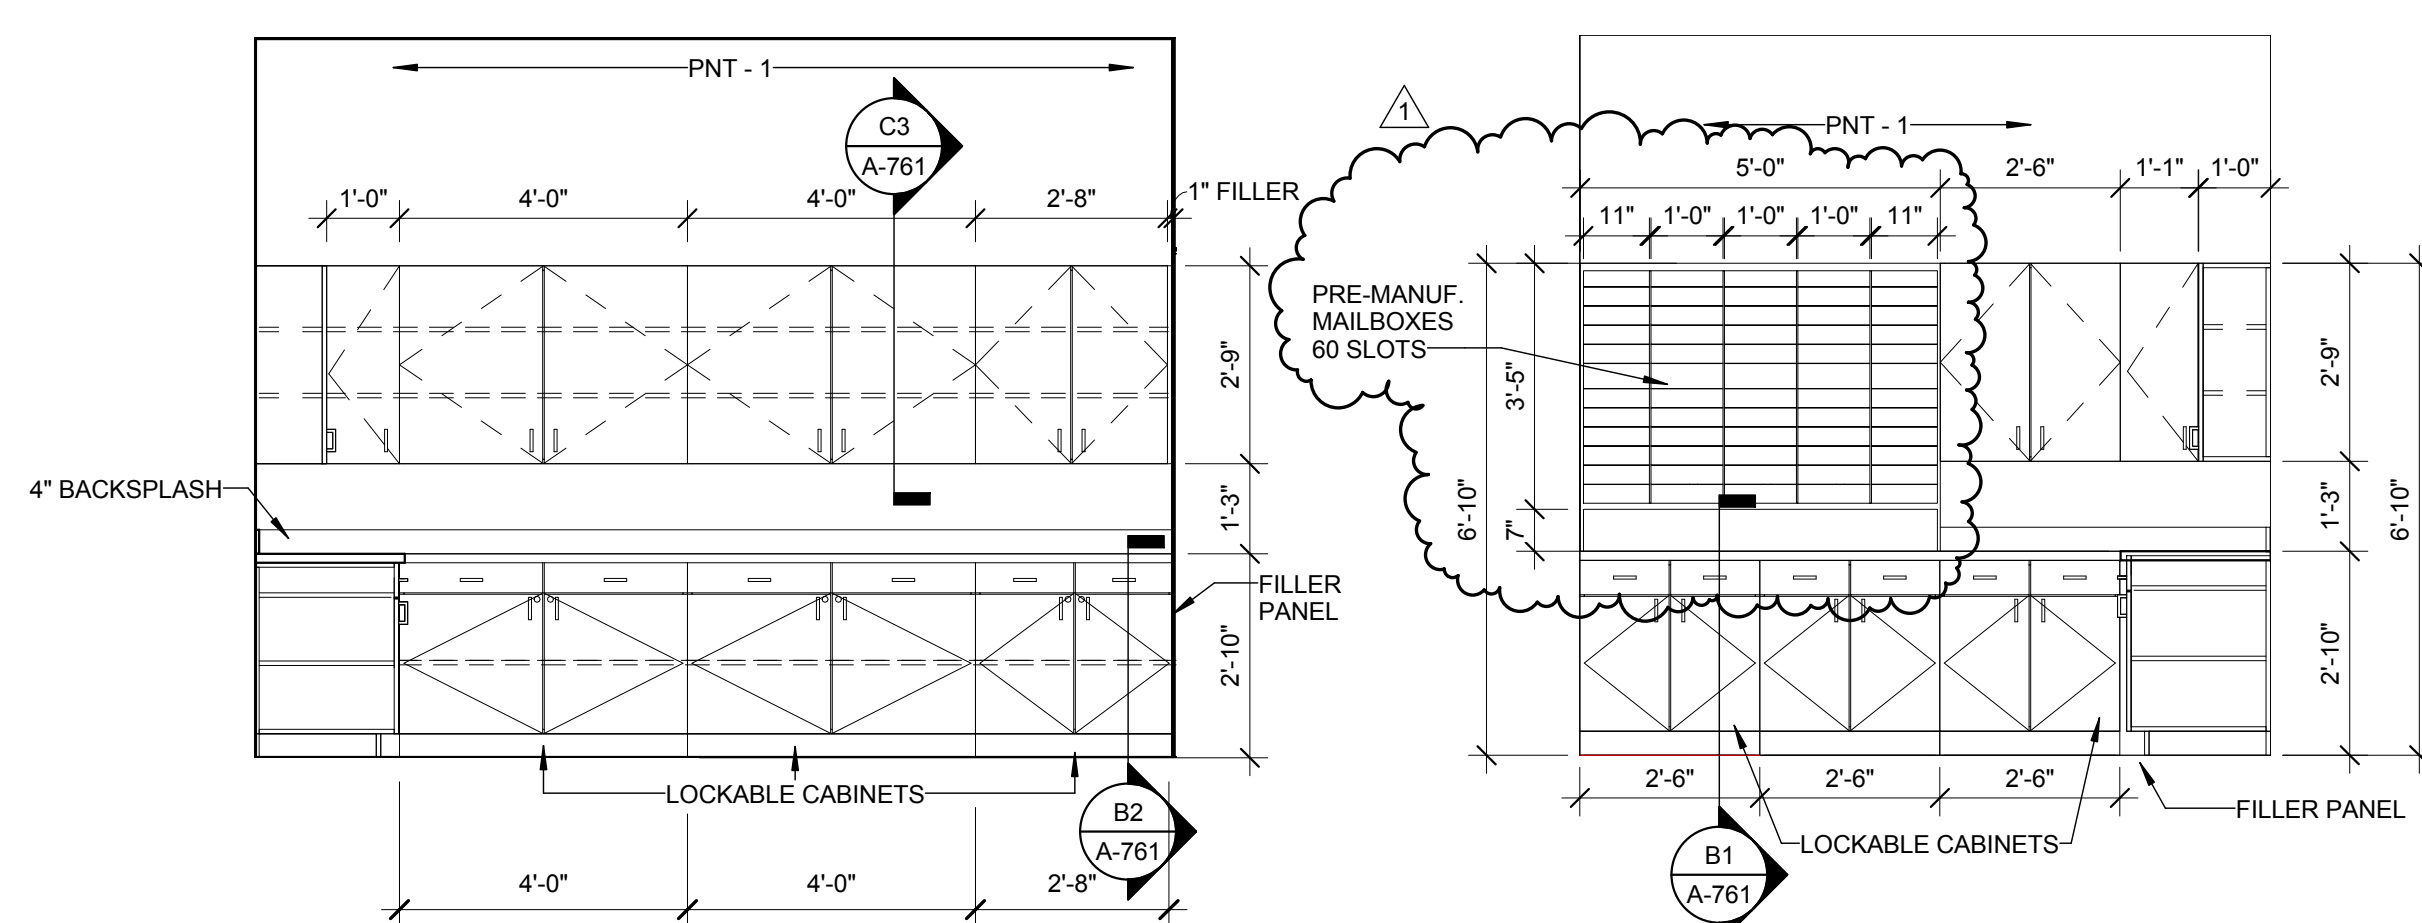


B1 WORKROOM 102A NORTH ELEVATION
3/8" = 1'-0"

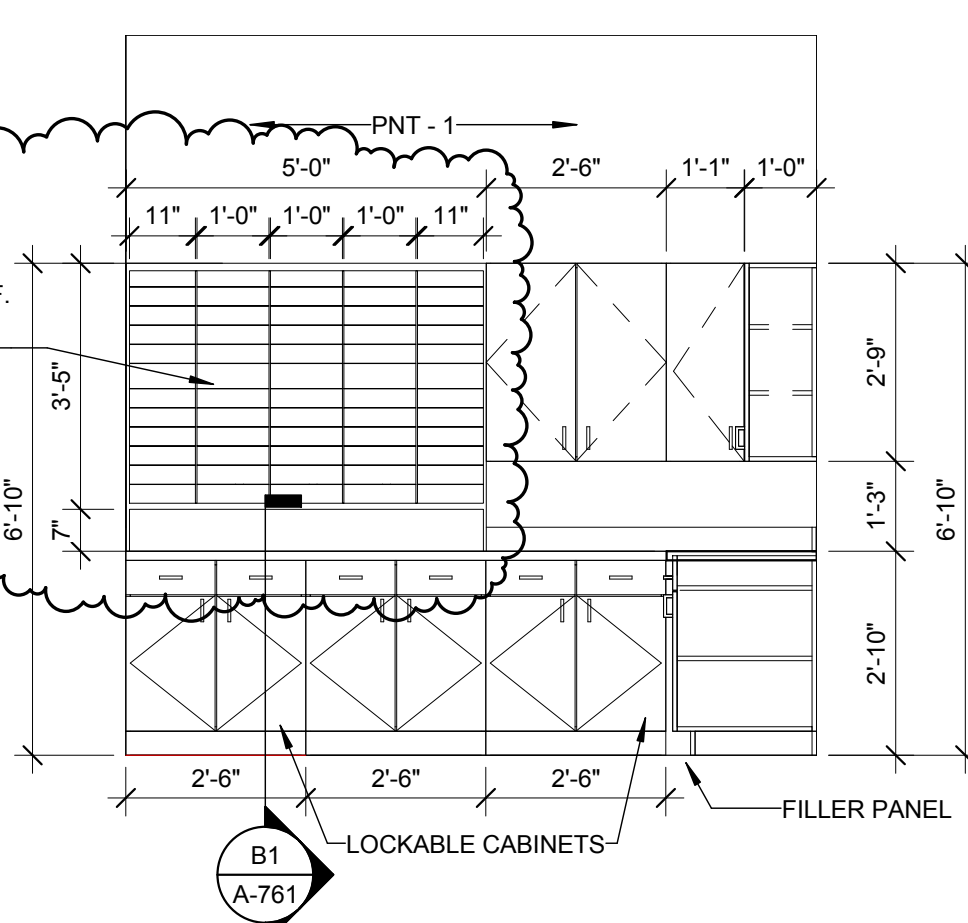


B2 WORKROOM 102A WEST ELEVATION
3/8" = 1'-0"

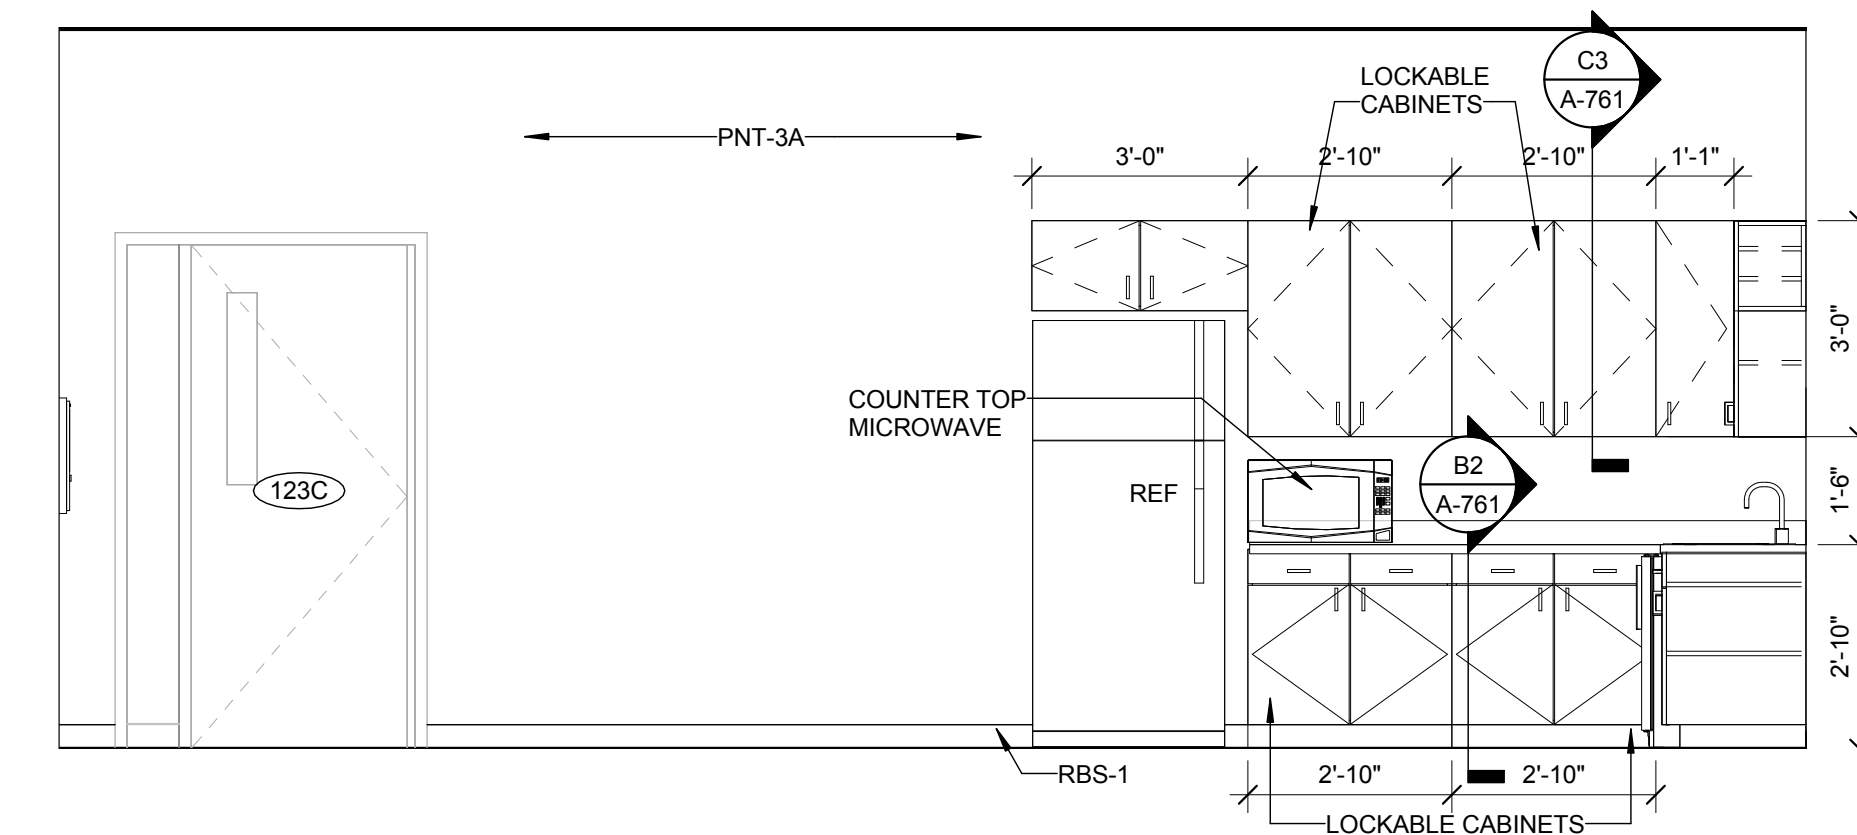


B3 KITCHEN/BREAKROOM 123I WEST ELEVATION
3/8" = 1'-0"

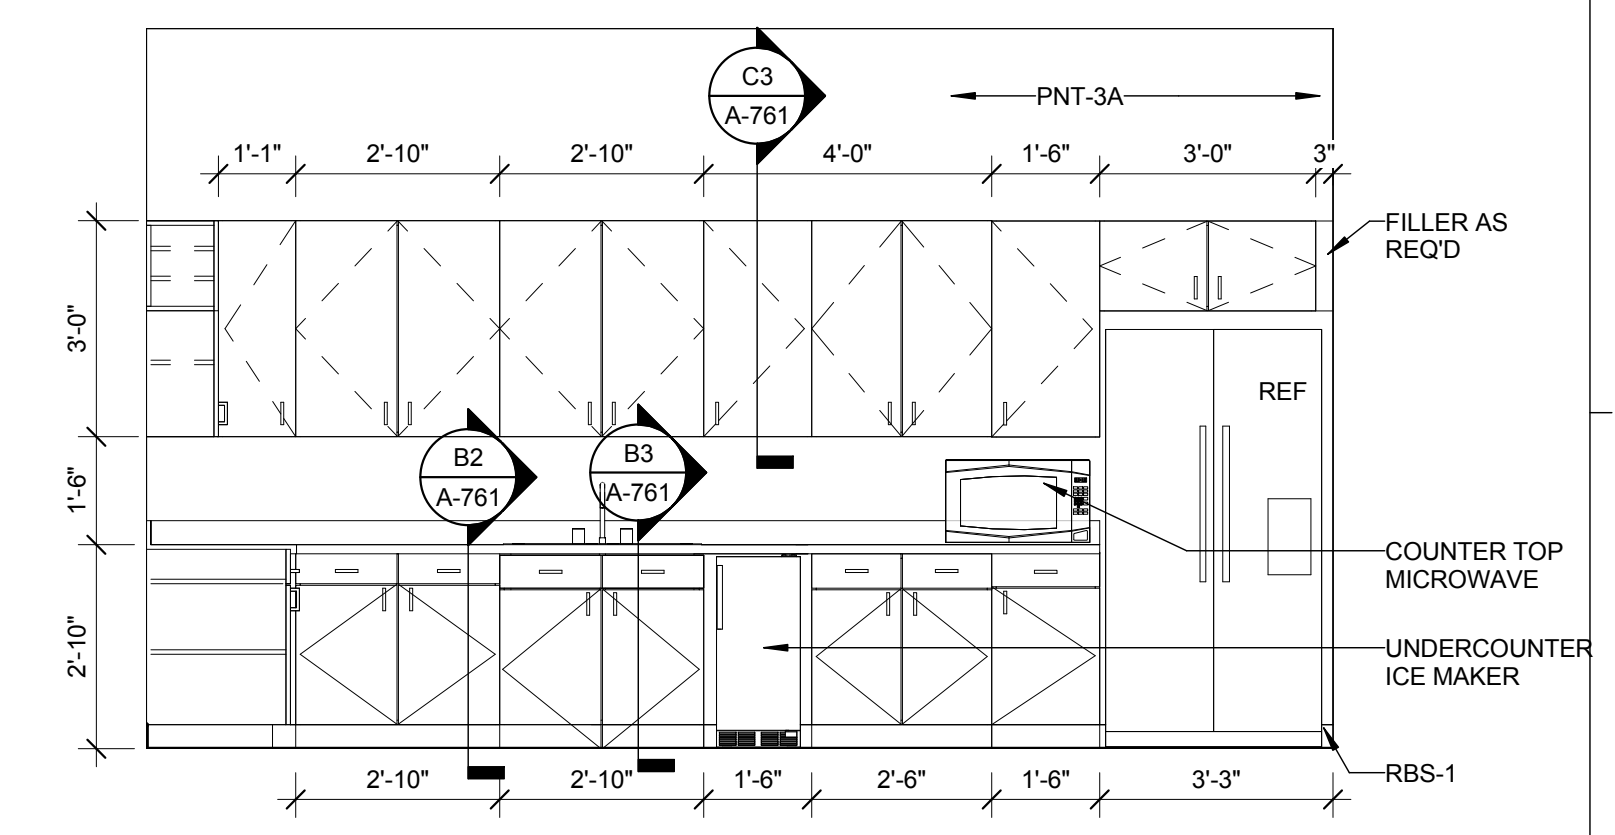


B5 KITCHEN/BREAKROOM 123I NORTH ELEVATION
3/8" = 1'-0"

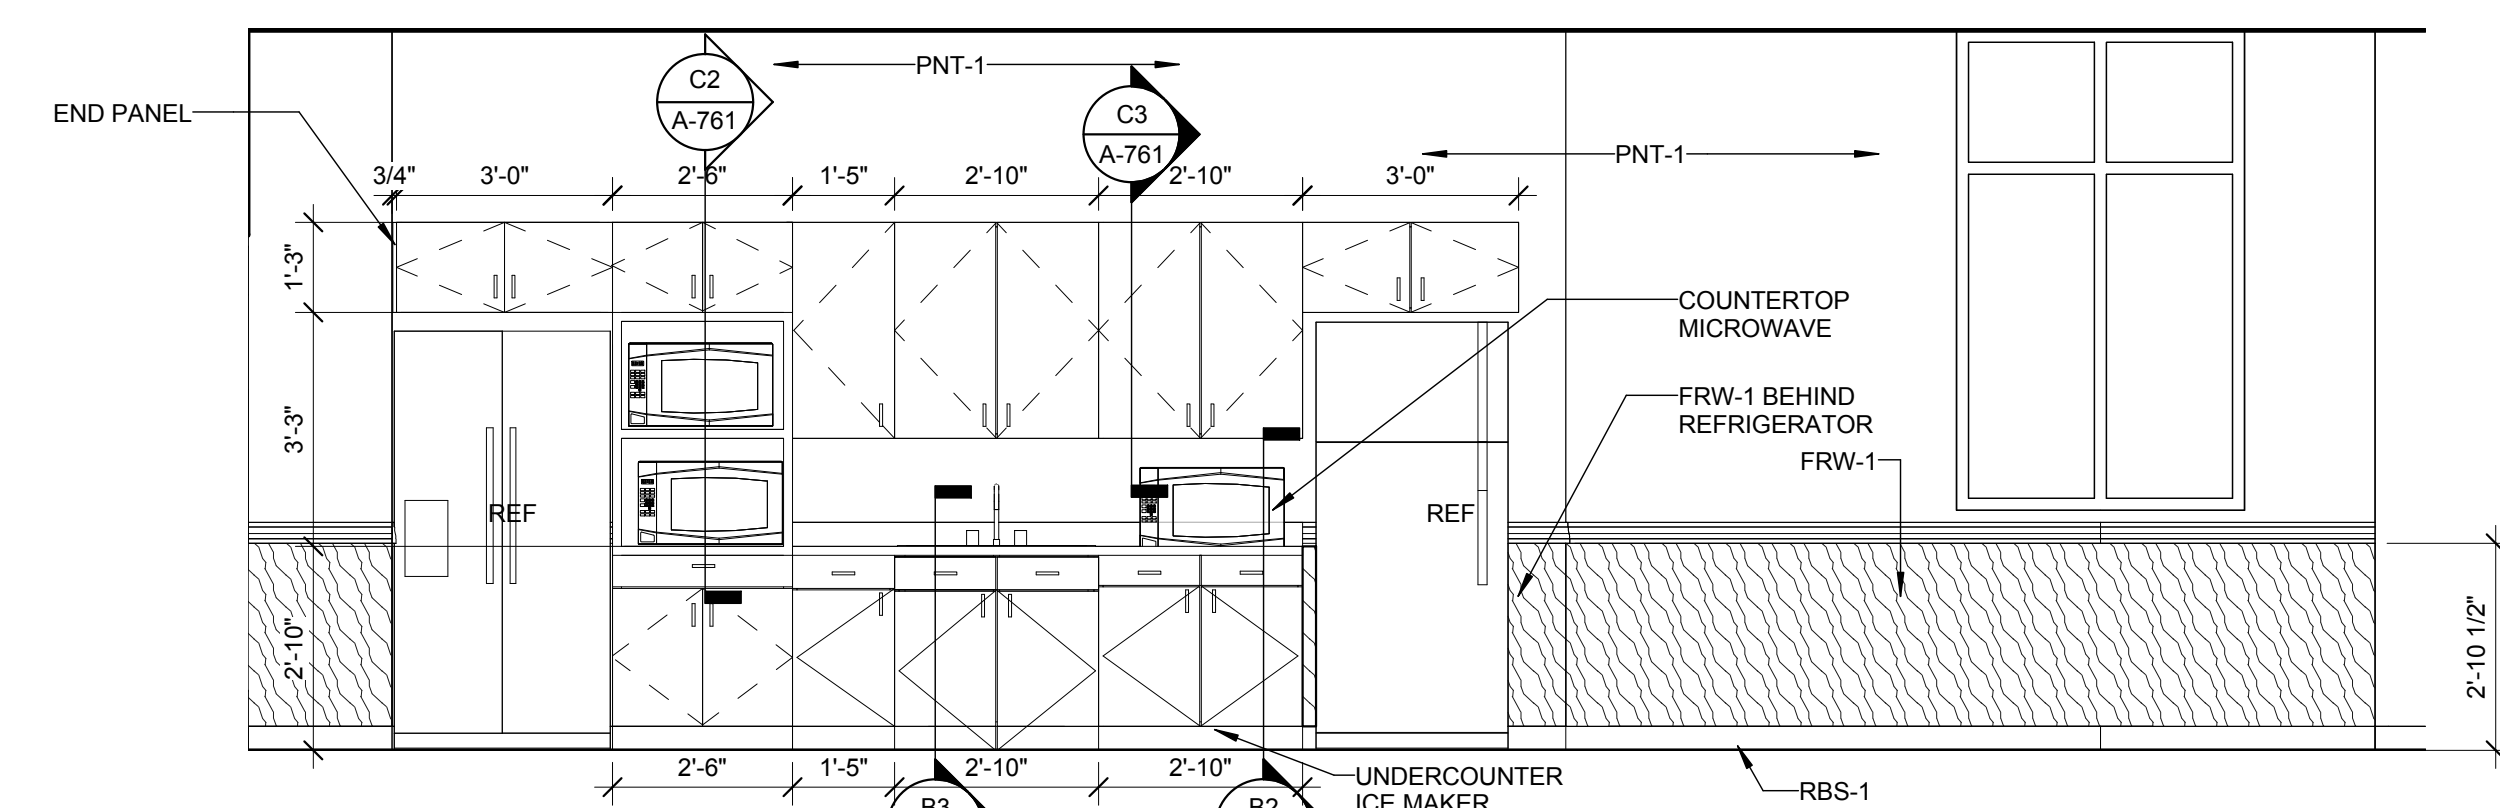

A1 BREAKROOM 130A EAST ELEVATION
3/8" = 1'-0"

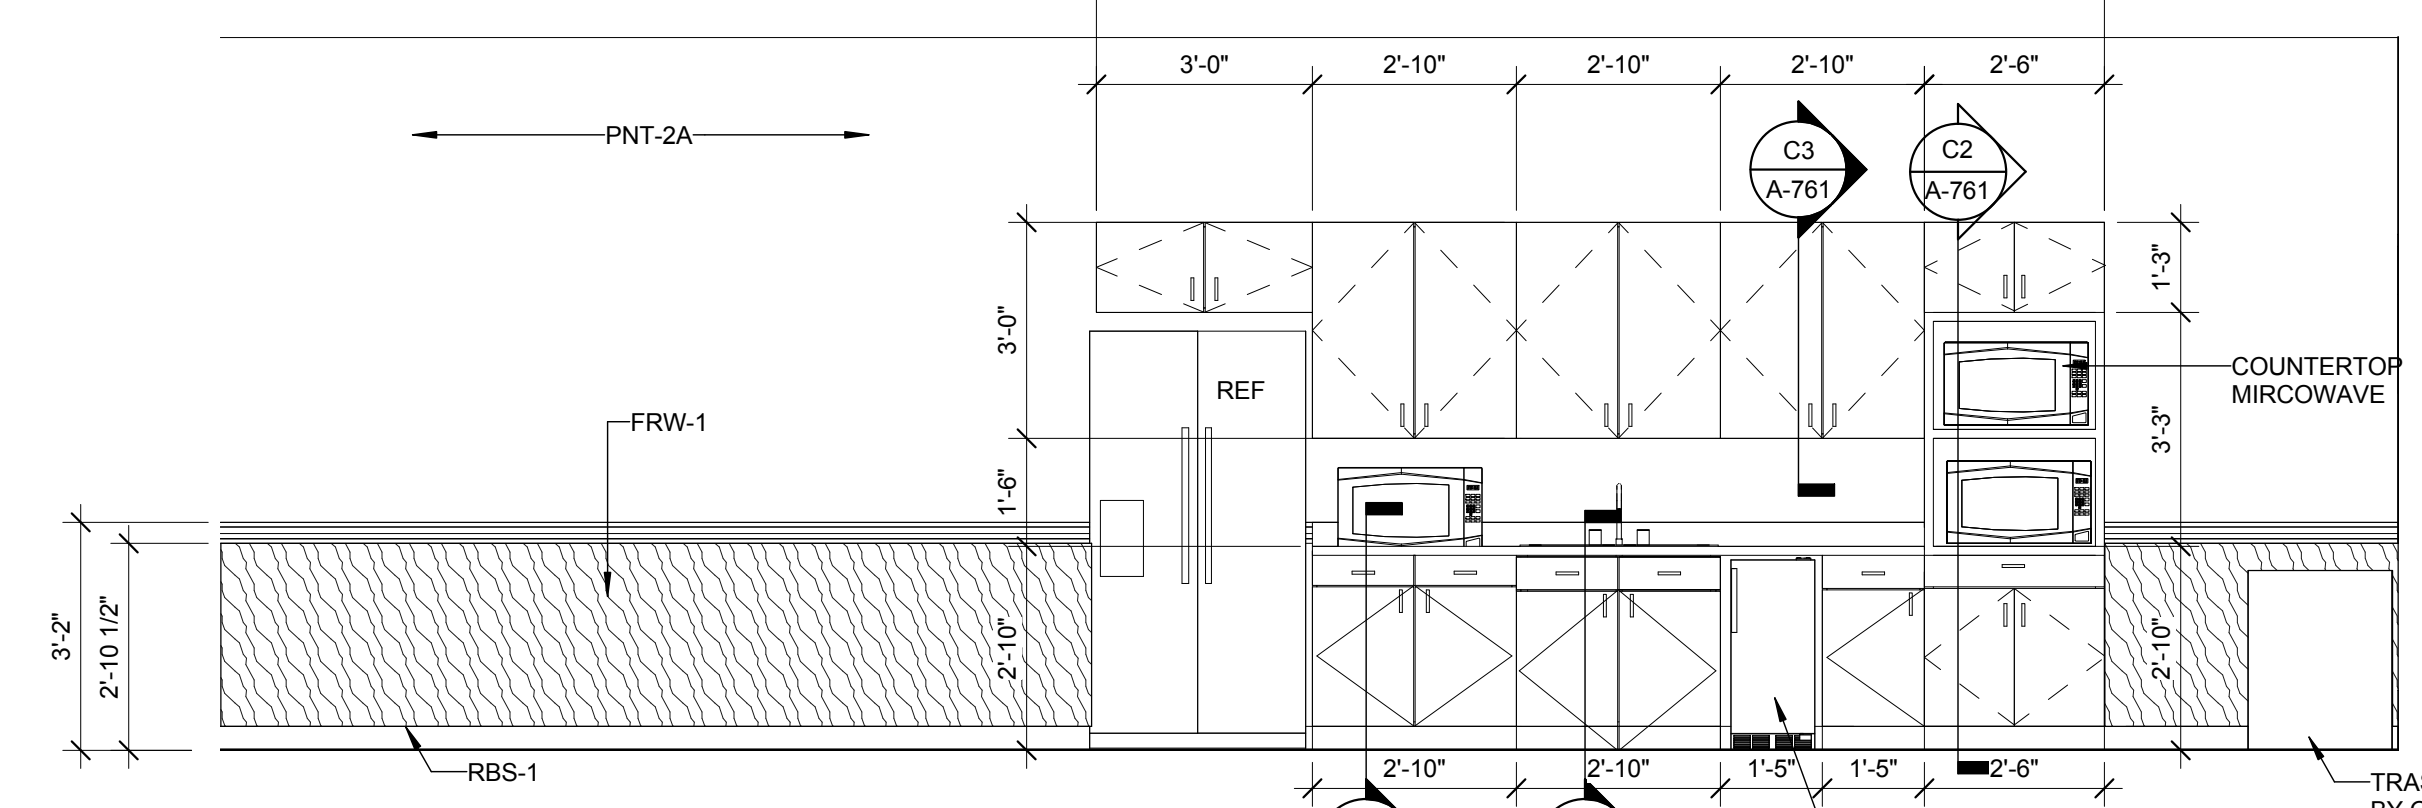

A3 BREAKROOM 130A WEST ELEVATION
3/8" = 1'-0"

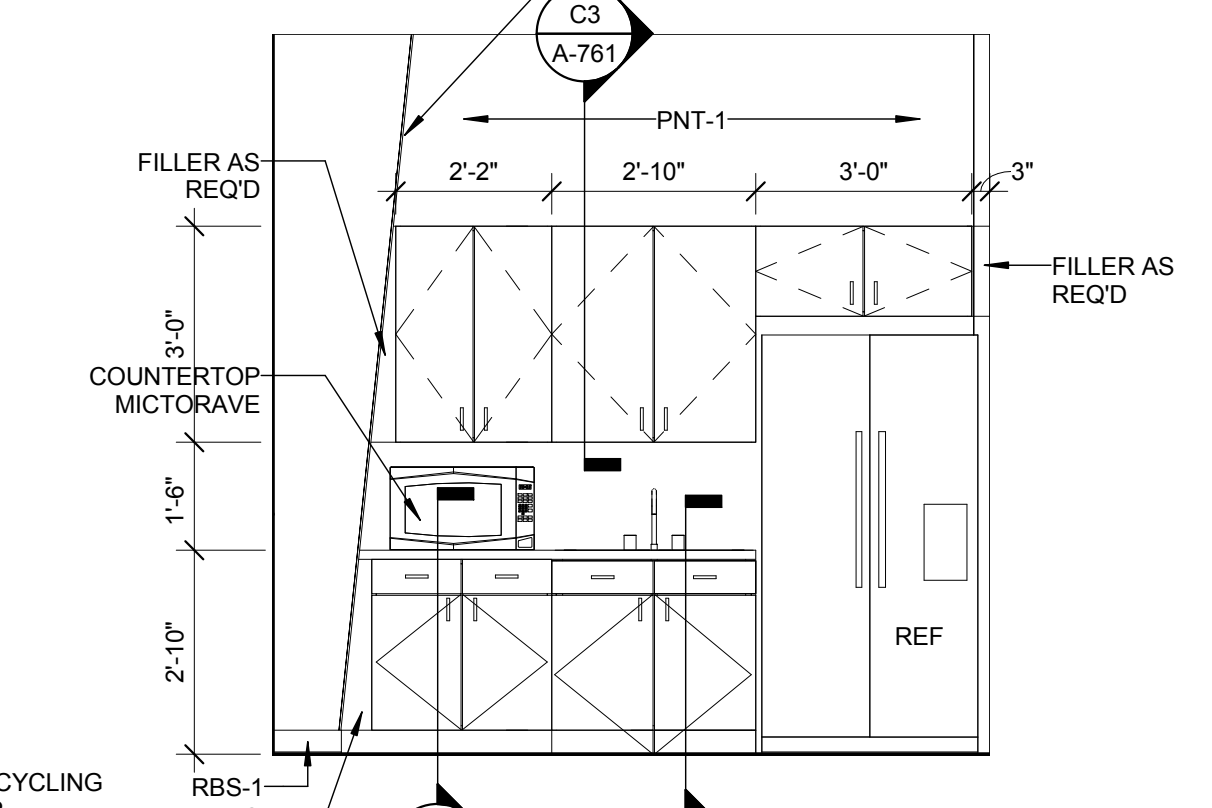

A5 CONFERENCE/BREAKROOM 153B
3/8" = 1'-0"

C:\Users\sharouh\Documents\A01_UNCC Facilities Operations Complex_2016_sharouh.rvt 8/30/2017 7:59:05 AM



MEMBERS OF THE AMERICAN INSTITUTE OF ARCHITECTS

COPYRIGHT 2017 ALL RIGHTS RESERVED
PRINTED OR ELECTRONIC DRAWINGS AND DOCUMENTATION MAY NOT BE REPRODUCED IN ANY FORM WITHOUT WRITTEN PERMISSION FROM LS3P ASSOCIATES LTD.


REVISIONS:

No.	Description	Date
1	Addendum No. 4	08/28/2017


PROJECT: 9202-164730
SCO ID: 16-15656-025
ITEM: 315 CODE: 41526
DATE: AUGUST 21, 2017
DRAWN BY: RD
CHECKED BY: SH

WALL SECTIONS - OFFICE / SHOPS, WAREHOUSE AND MISC. BUILDINGS


A-353

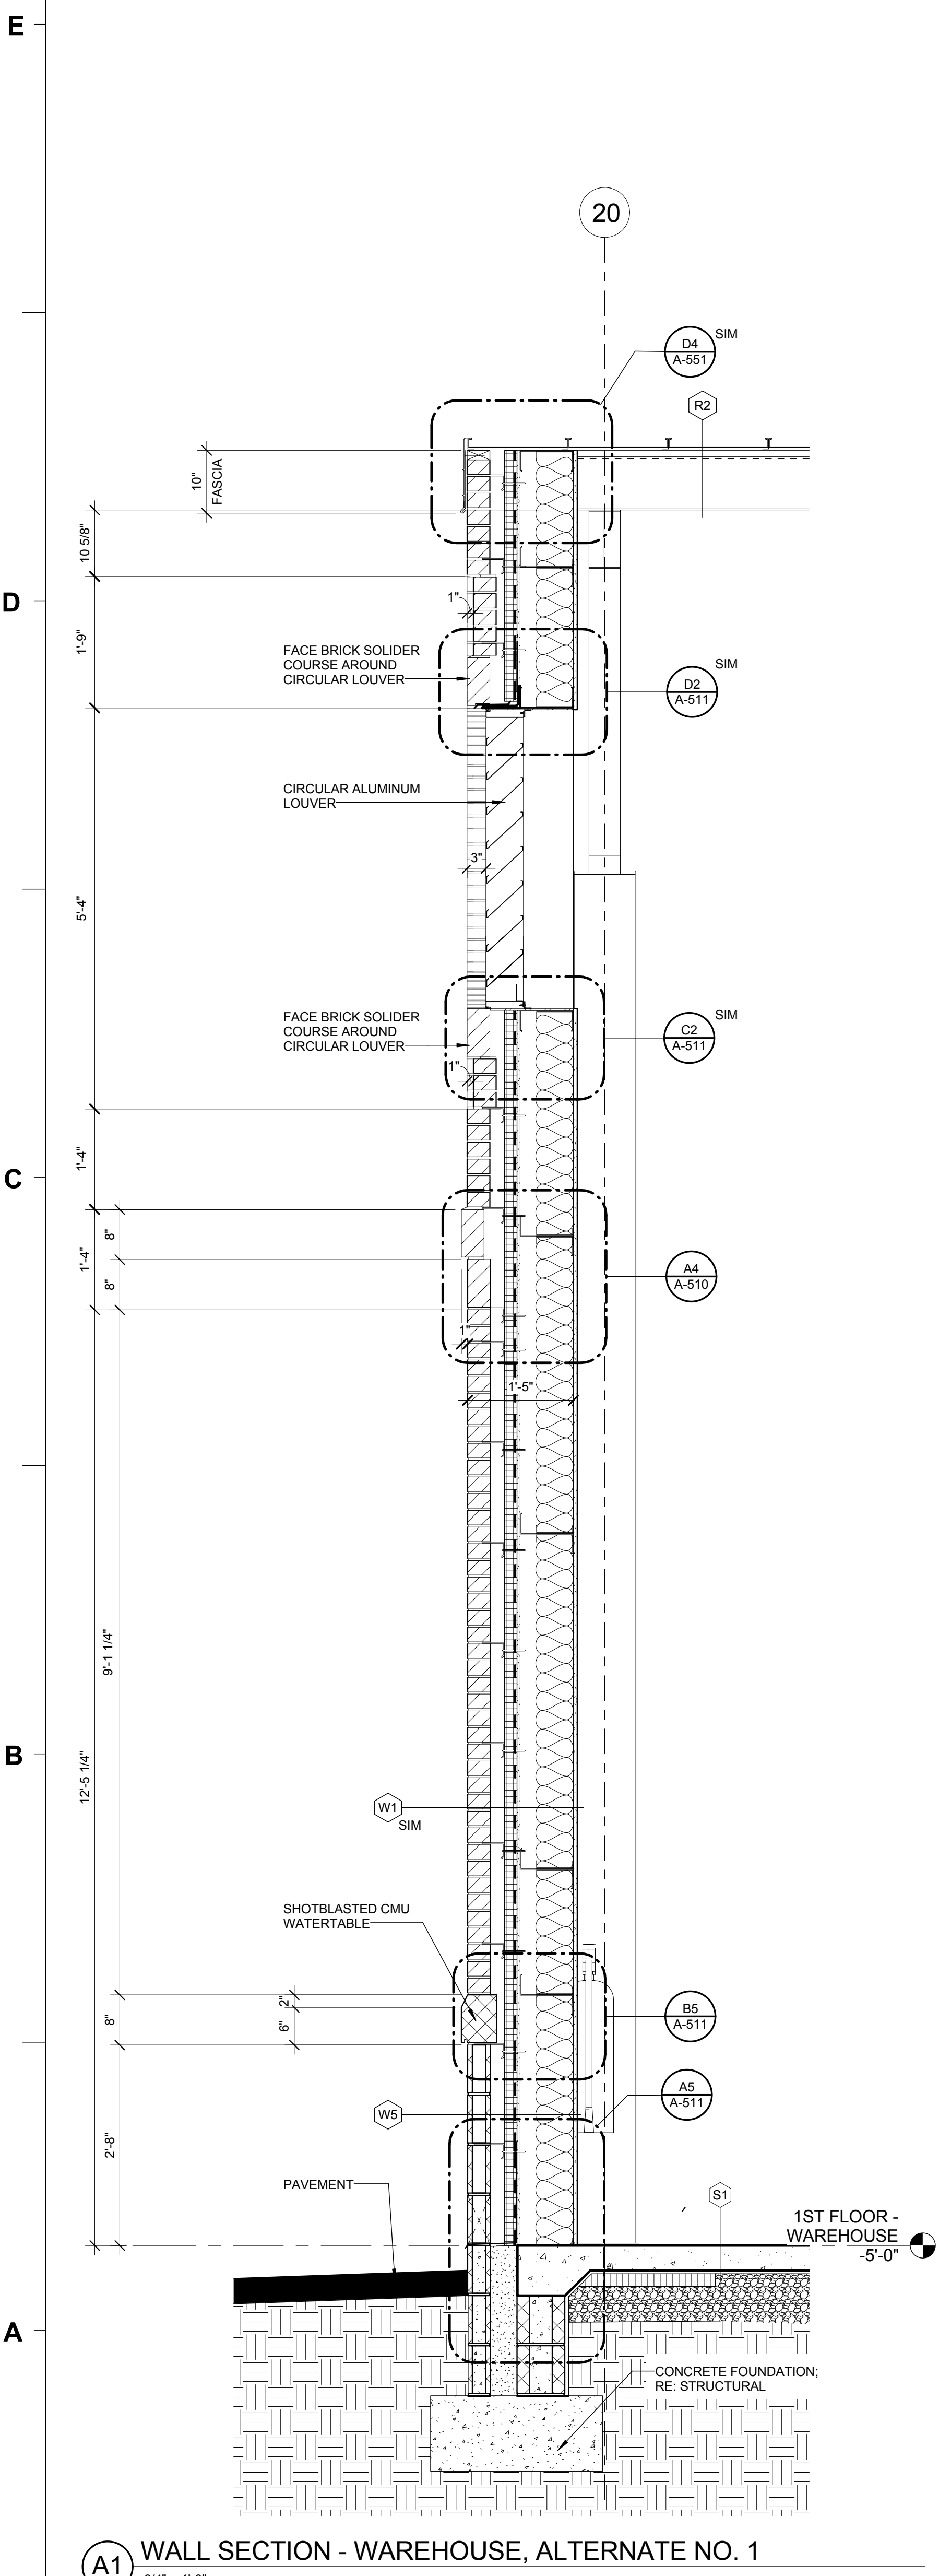


A1 WALL SECTION - WAREHOUSE, ALTERNATE NO. 1
3/4" = 1'-0"

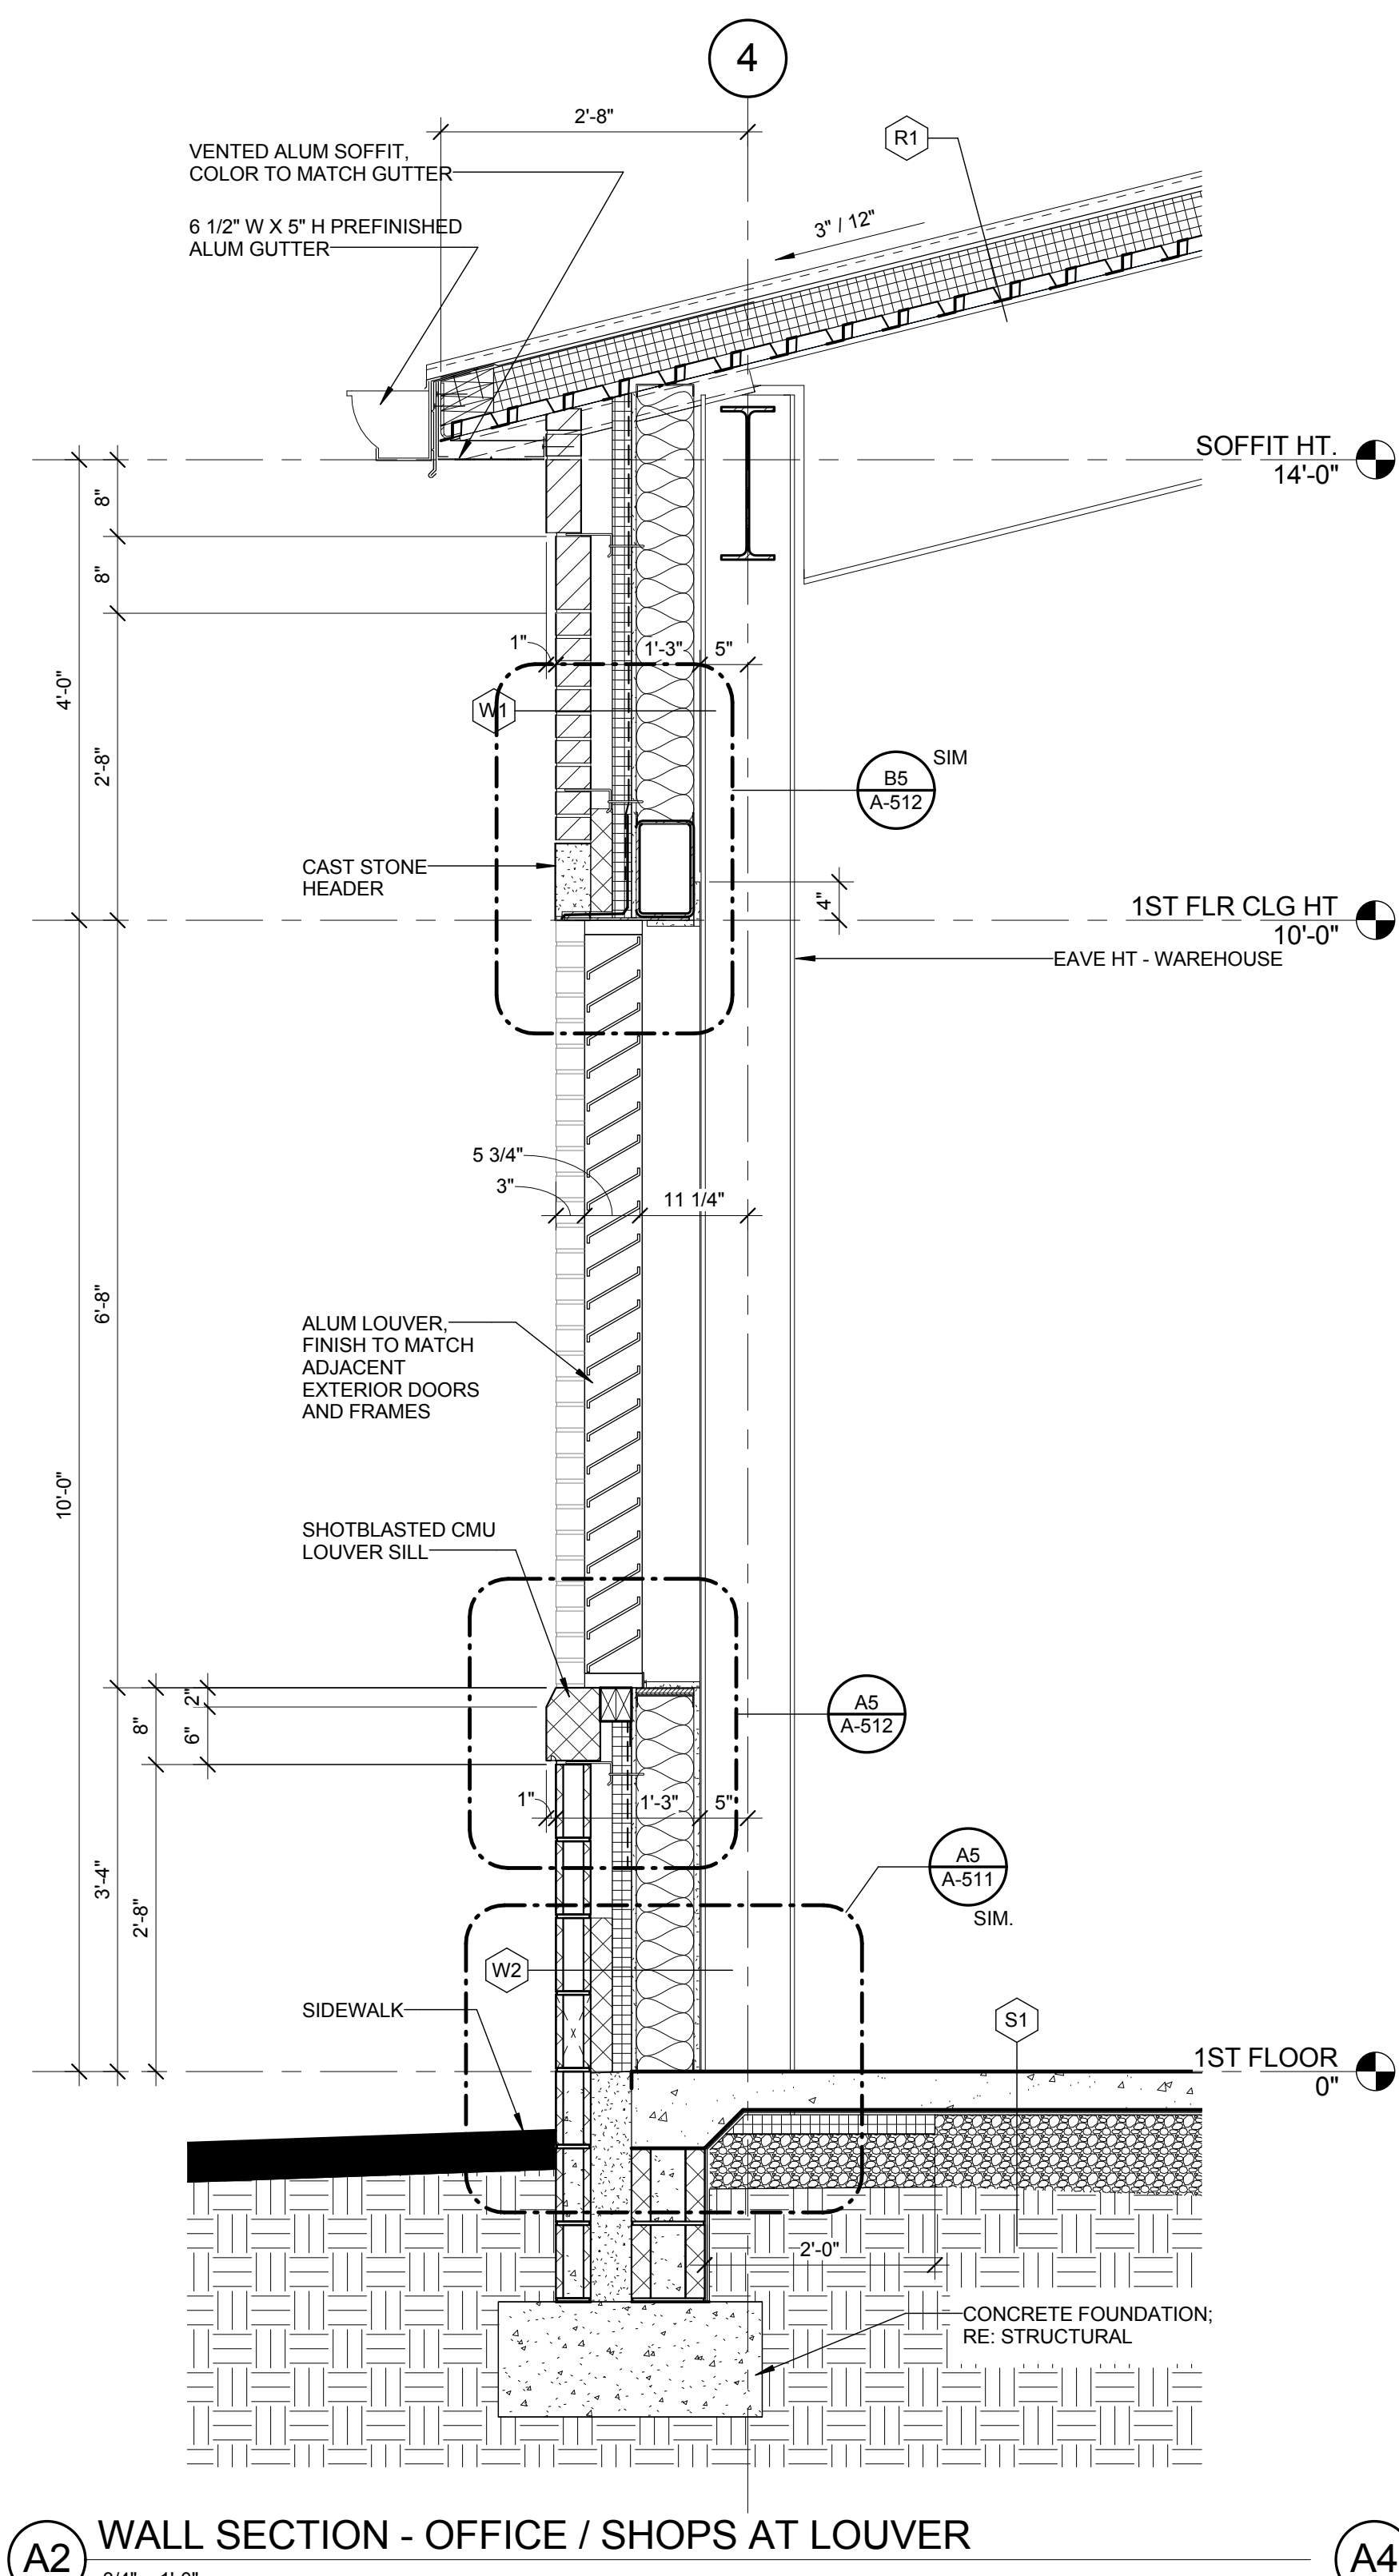


A2 WALL SECTION - OFFICE / SHOPS AT LOUVER
3/4" = 1'-0"

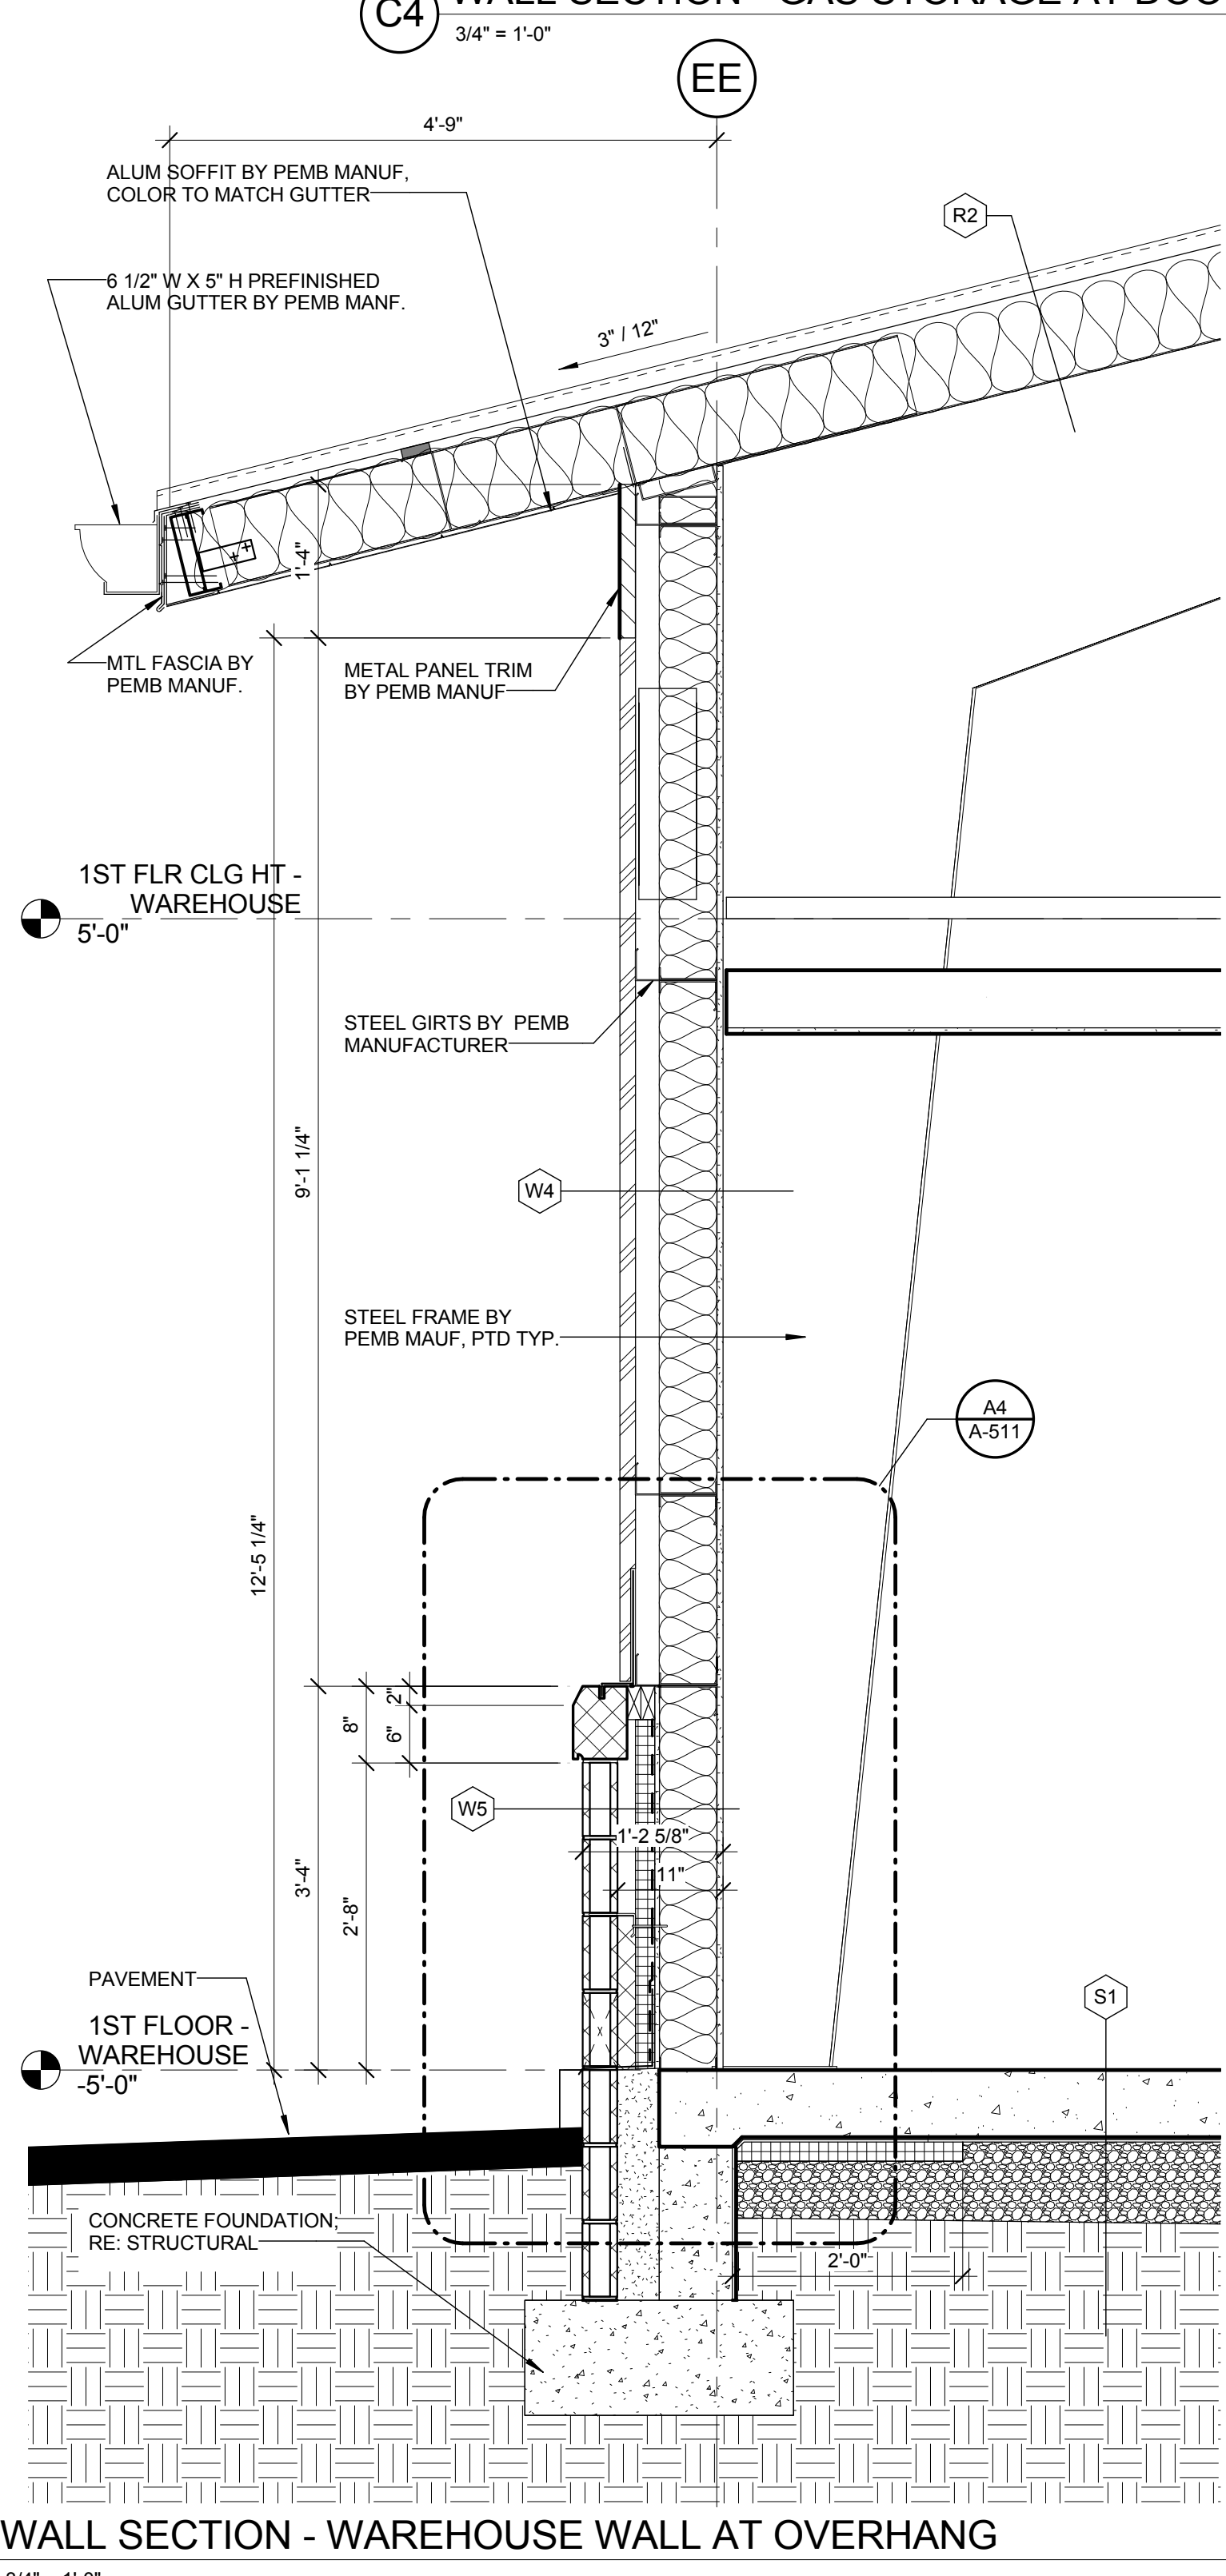


A4 WALL SECTION - WAREHOUSE WALL AT OVERHANG
3/4" = 1'-0"

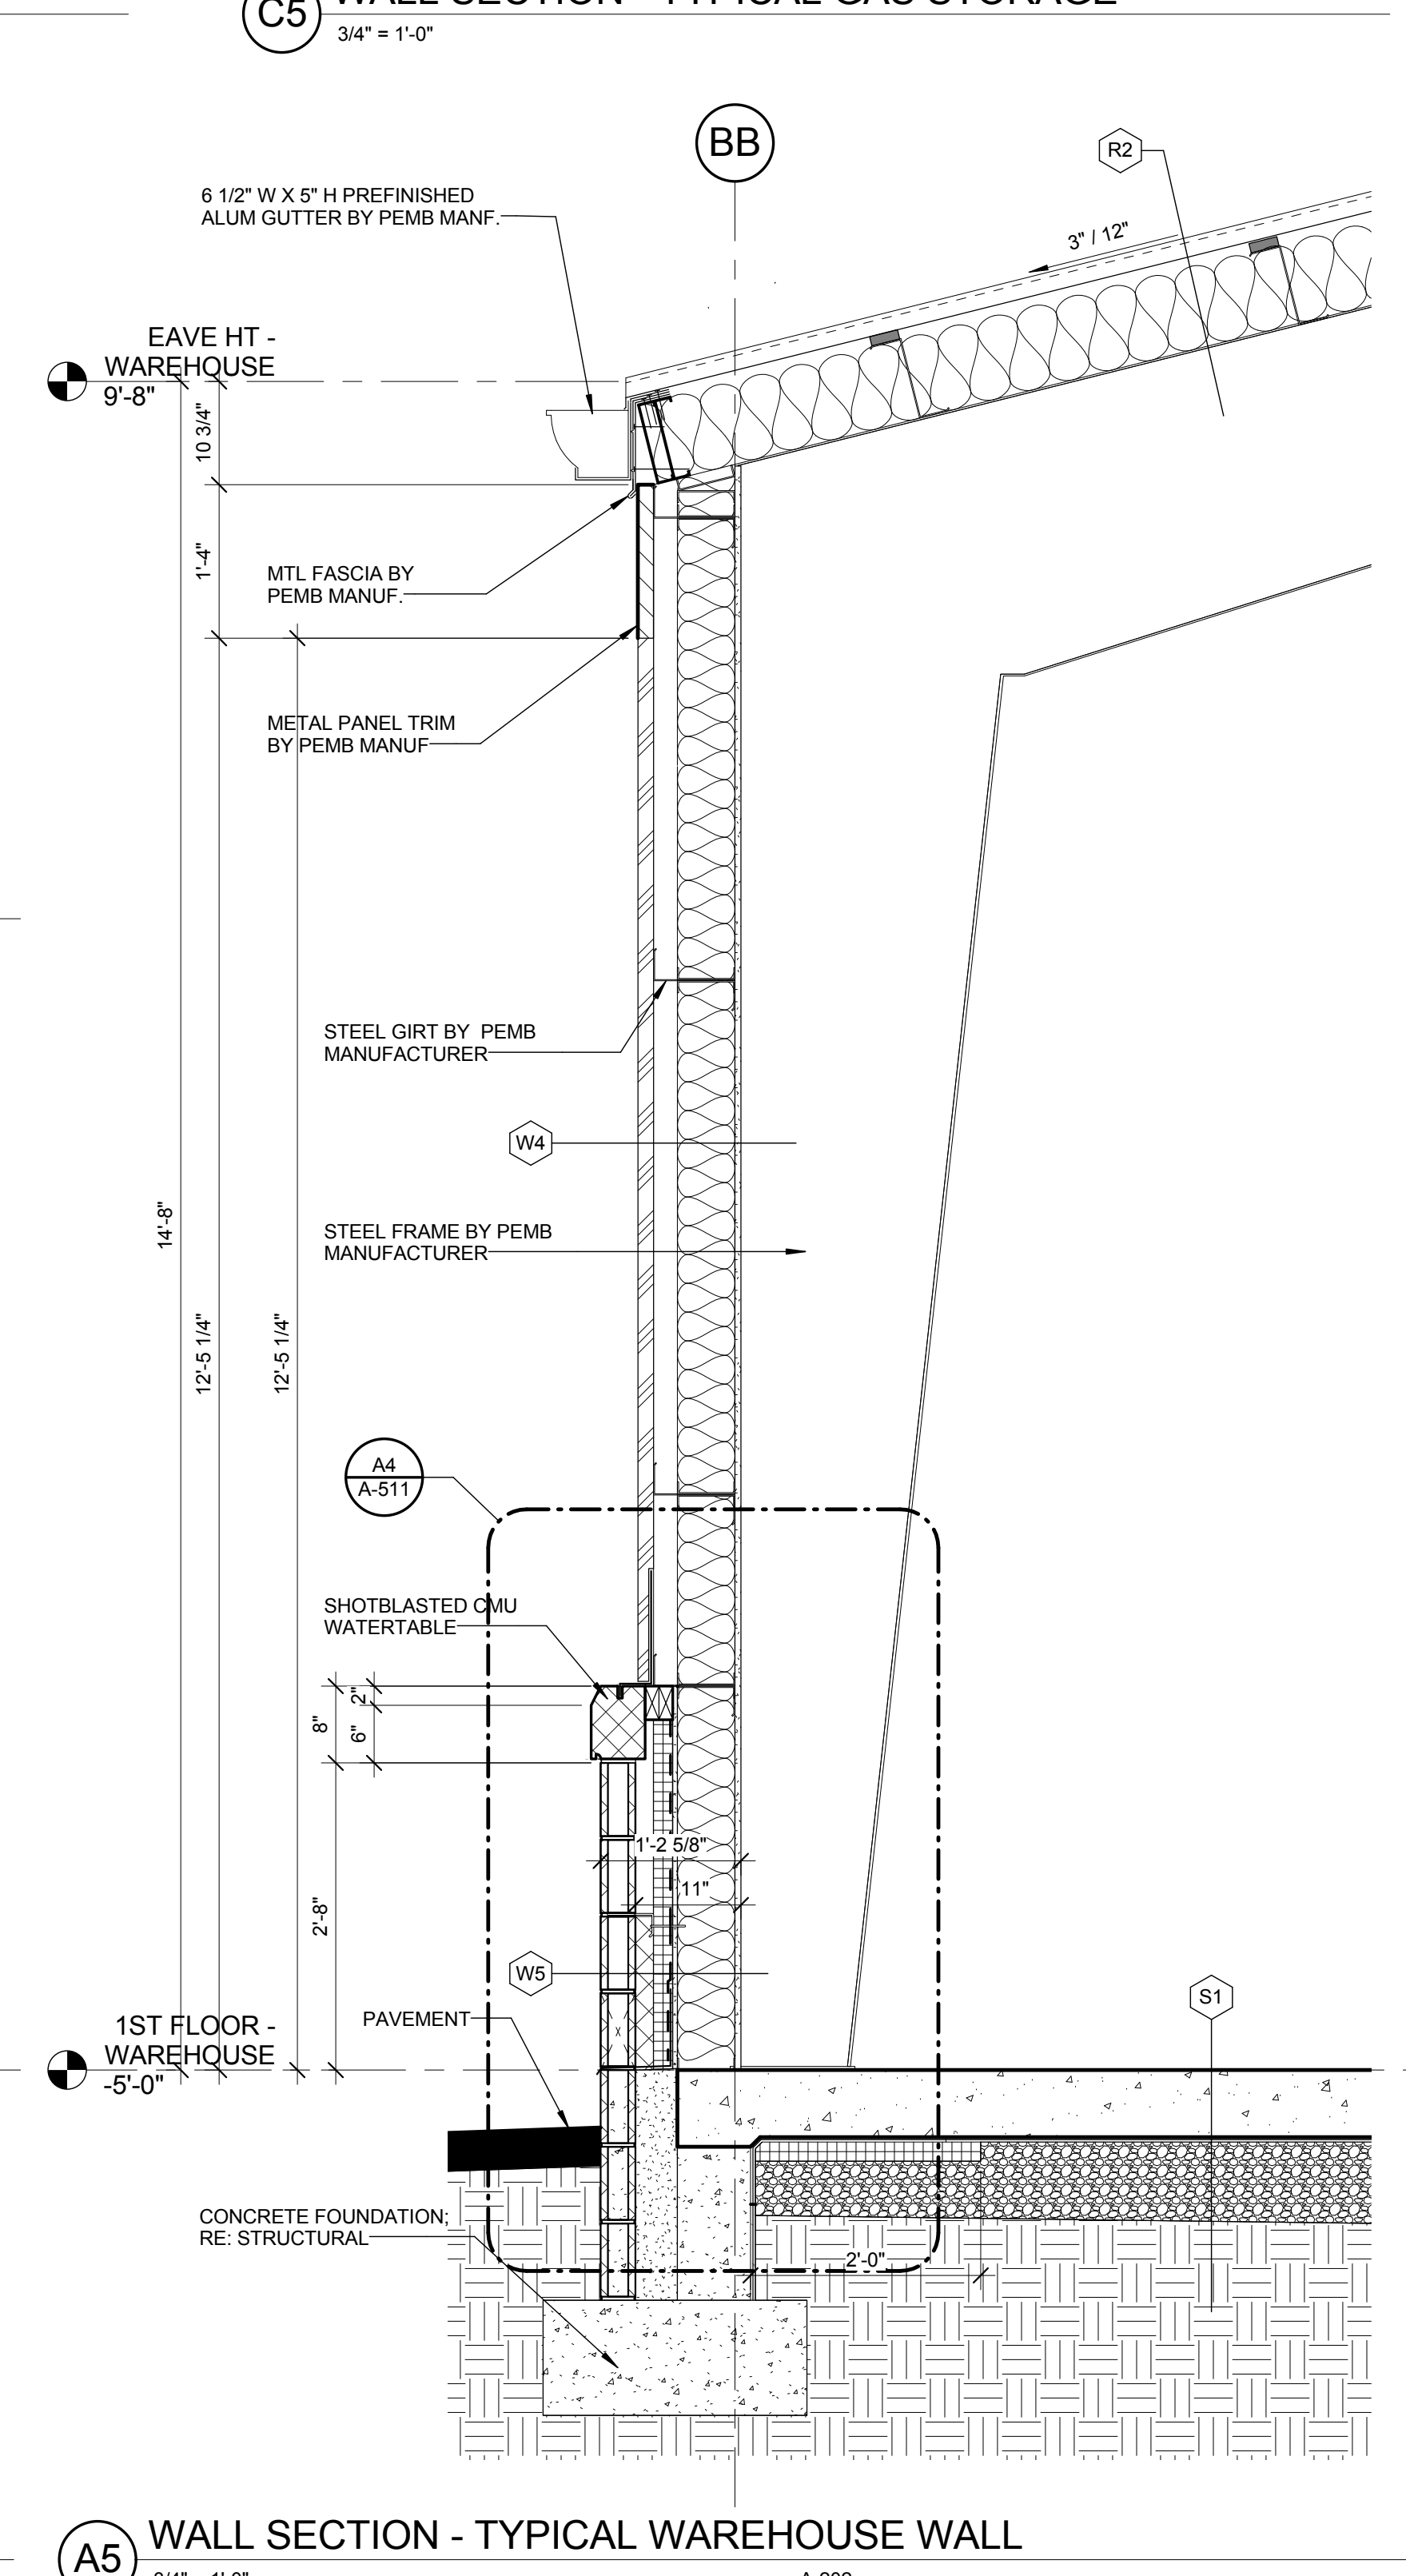

A5 WALL SECTION - TYPICAL WAREHOUSE WALL
3/4" = 1'-0"

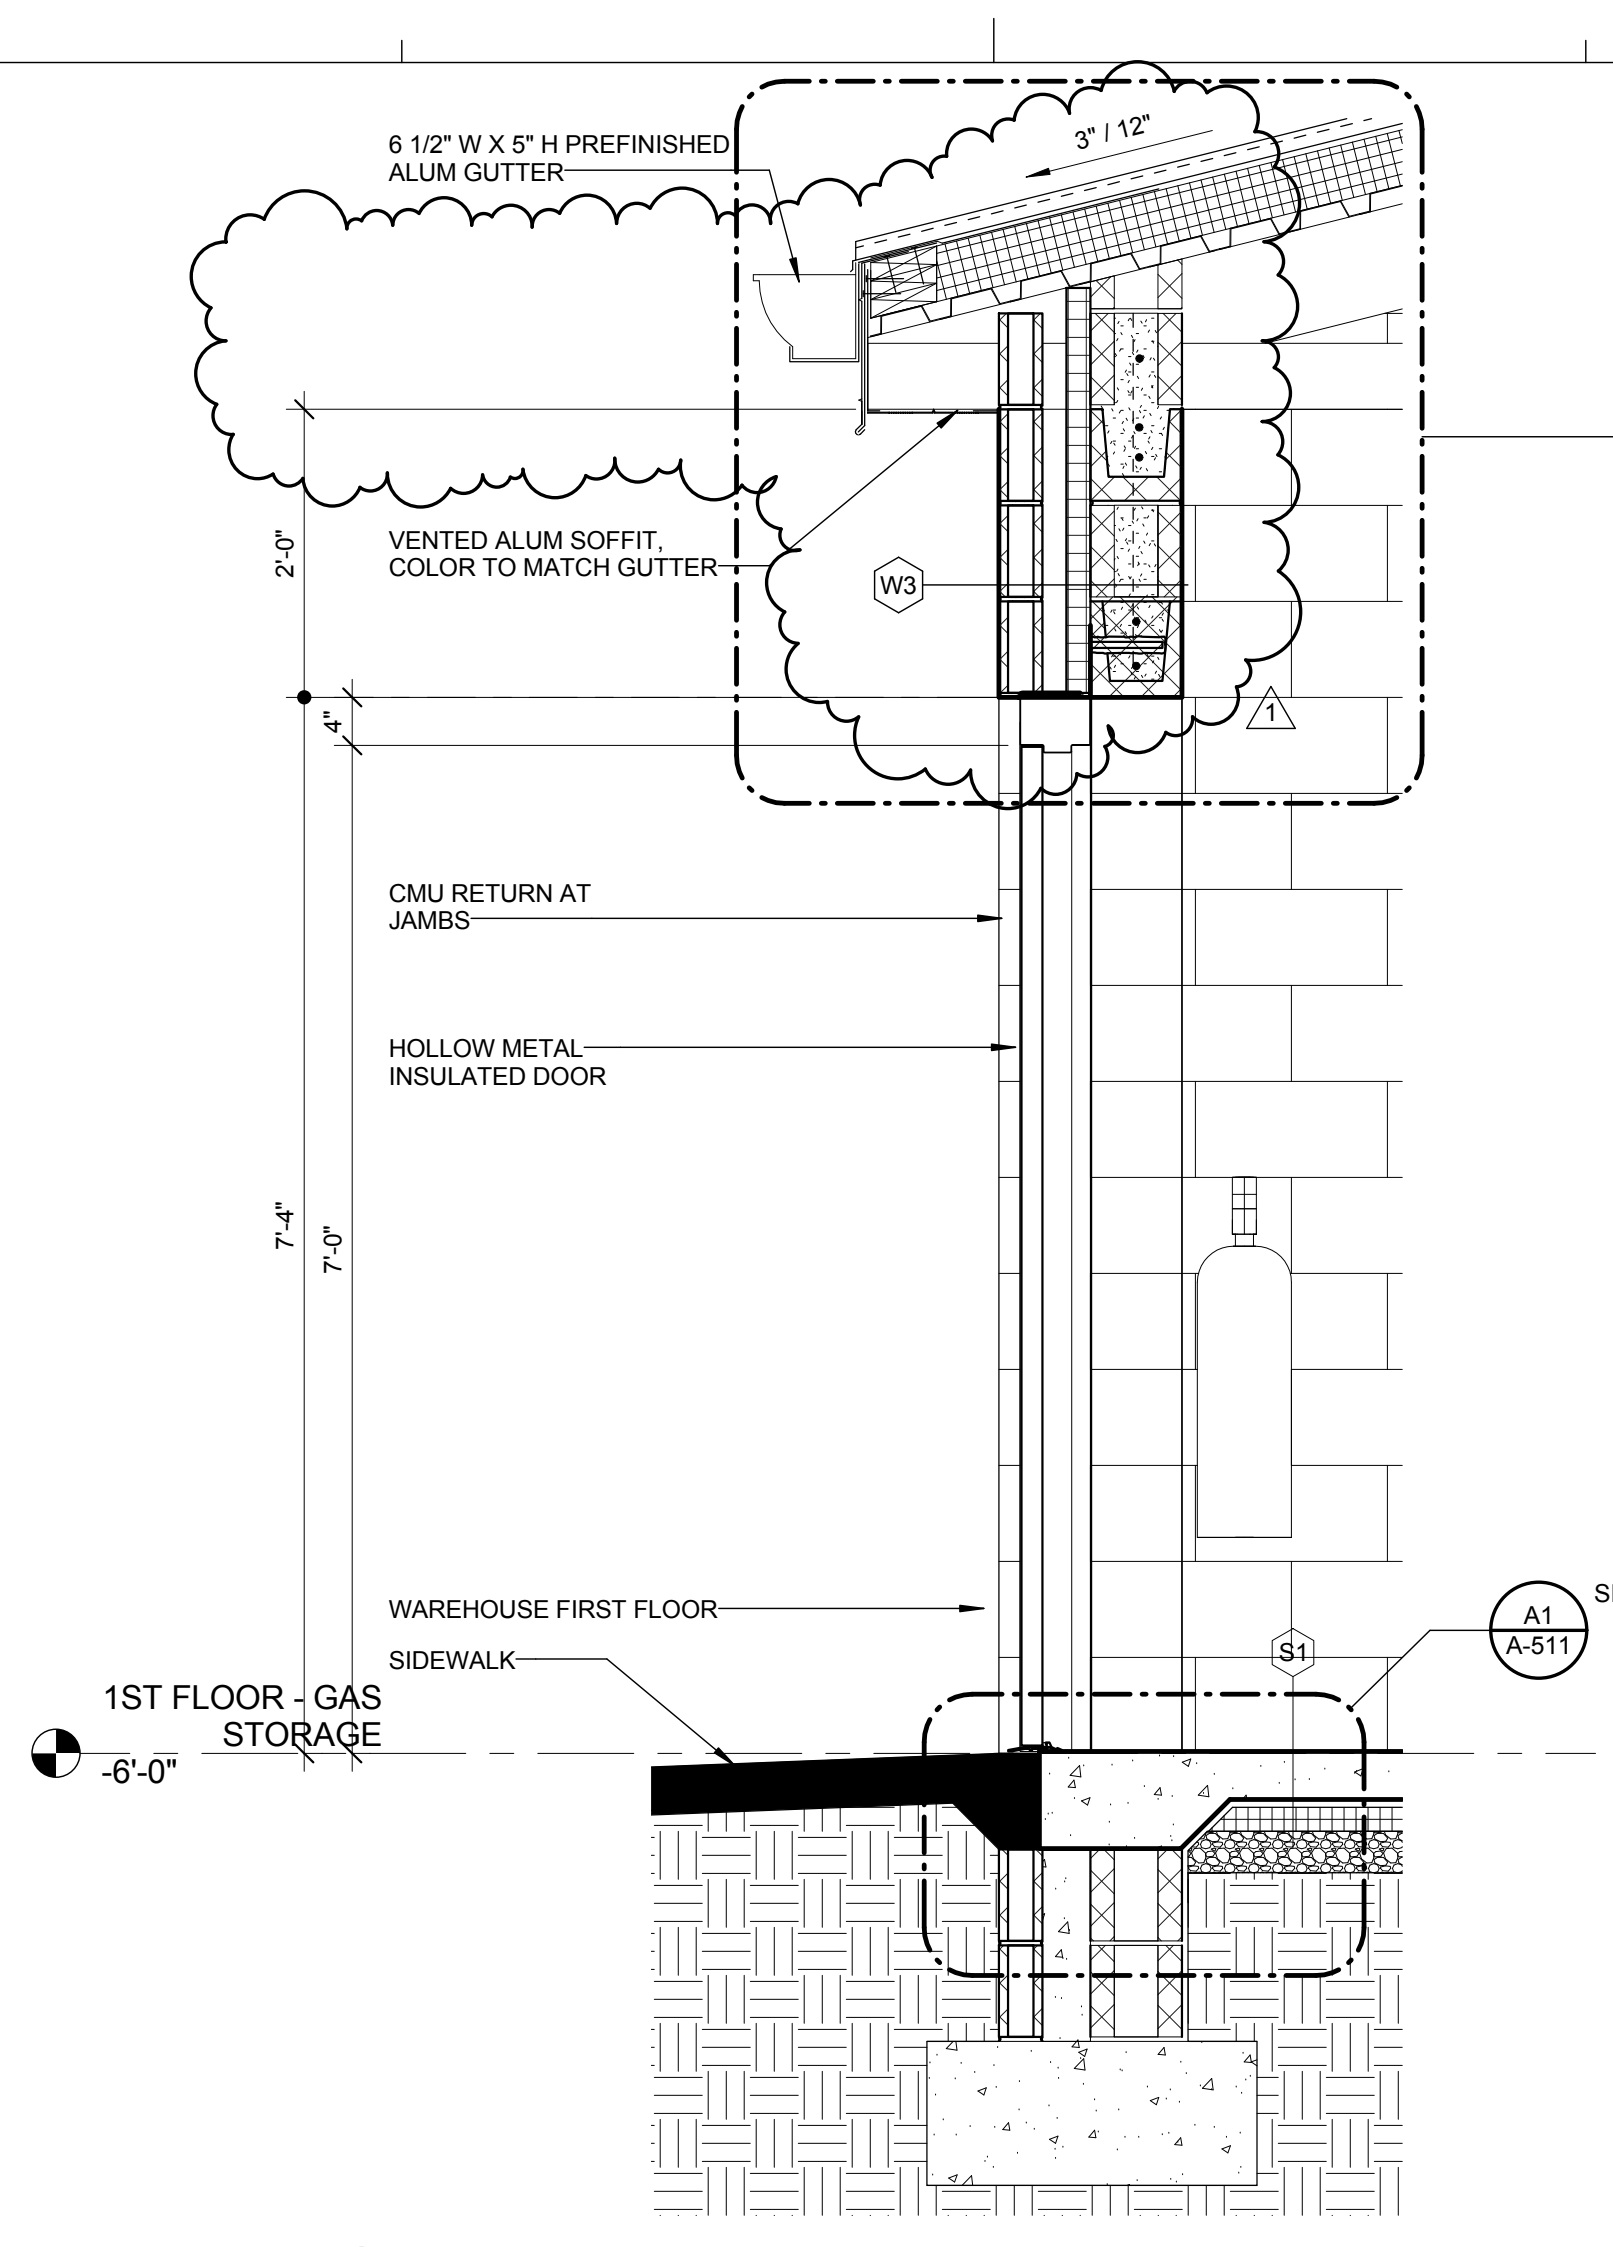

C4 WALL SECTION - GAS STORAGE AT DOOR
3/4" = 1'-0"

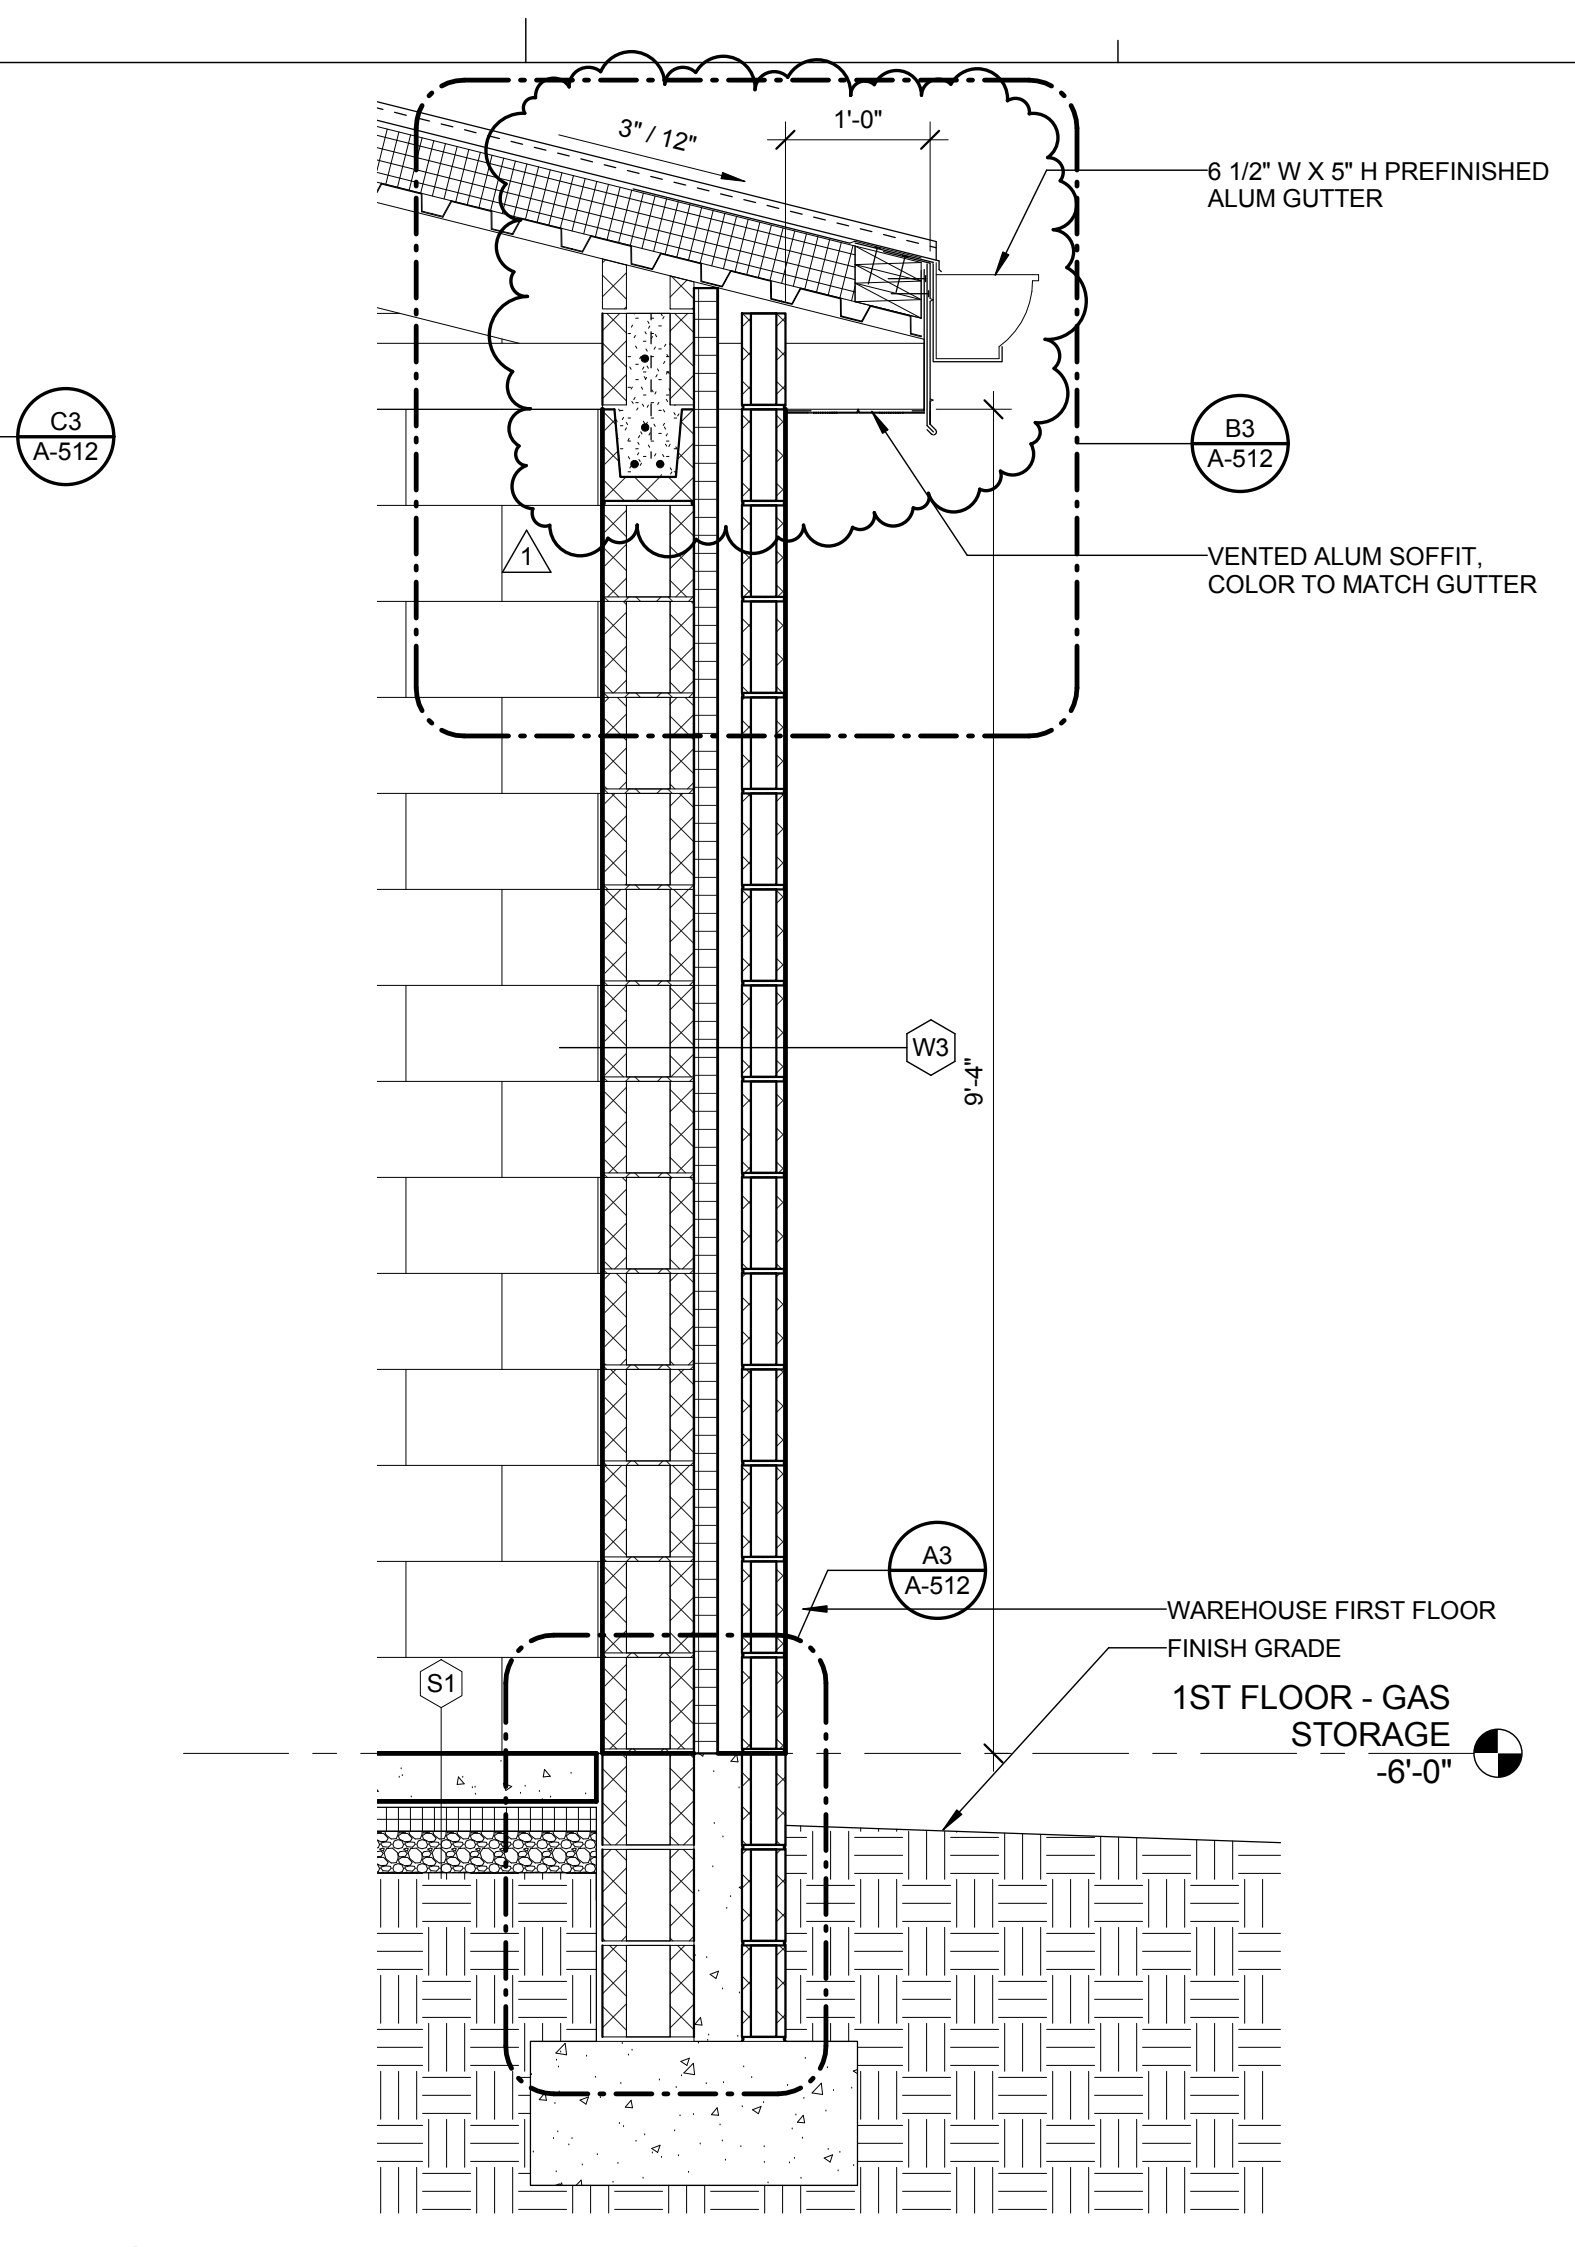

C5 WALL SECTION - TYPICAL GAS STORAGE
3/4" = 1'-0"

C:\Users\sharohud\Documents\A01_UNCC Facilities Operations Complex_2016_sharohud.rvt 8/30/2017 7:59:18 AM



REVISIONS:

No.	Description	Date
1	Addendum No. 4	08/28/2017

PROJECT: 9202-164730
SCO ID: 16-15656-02B
ITEM: 315 CODE: 41526
DATE: AUGUST 21, 2017
DRAWN BY: ZS
CHECKED BY: SH

TOILET ROOM PLANS AND SCHEDULE

A-410

FLOOR PLAN SHEET NOTES

- EXTERIOR DIMENSIONS AT MASONRY VENEER ARE TO FACE OF MASONRY.
- INTERIOR DIMENSIONS INDICATED ARE TO FACE OF FINISH WALLS AND CENTERLINES OF COLUMNS, UNO.
- LOCATE DOOR OPENINGS 4" FROM NEAREST PERPENDICULAR WALL, UNO.
- FIRE AND SOUND RATED WALLS/PARTITIONS TO BE CONSTRUCTED TIGHT TO STRUCTURE, PIPING, DUCTWORK AND OTHER PENETRATIONS. ALL WORK IS TO BE BRACED TO STRUCTURE ABOVE.
- WHERE PARTITIONS OF DIFFERENT FIRE RATINGS INTERSECT, THE HIGHEST RATED PARTITION SHALL CONTINUE THROUGH. MAINTAIN PARTITION FIRE RATING BEHIND RECESSED FIRE EXTINGUISHER CABINETS.
- INSTALL BLOCKING IN PARTITIONS FOR CASEWORK, WALL MOUNTED EQUIPMENT, TRIM AND RELATED CONSTRUCTION AS INDICATED IN THE SPECIFICATIONS.
- SEE LIFE SAFETY PLANS FOR REQUIRED FIRE SEPARATION WALLS.
- SEE SHEET A-401 & A-403 FOR DOOR WINDOW & GLAZING TYPES.
- SEE SHEET A-403 FOR LOUVER TYPES.
- SEE SHEET A-403 FOR CONSTRUCTION SUBSYSTEMS.
- SEE SHEETS A-251, A-252, A-410, A-411 AND A-761 FOR CASEWORK ELEVATIONS & DETAILS.
- SEE SHEETS A-251 AND A-252 FOR INTERIOR ELEVATIONS, ACCESSORY DESCRIPTIONS & MOUNTING HEIGHTS.
- SEE SHEETS A-721 THROUGH A-722 FOR FINISH FLOORING, TRANSITIONS, PATTERNS AND WALL PROTECTION.
- SEE SHEET A-723 FOR FINISH SCHEDULE.
- SEE SHEETS A-401 FOR ENLARGED PLANS INDICATING ADDITIONAL DIMENSIONS AND PARTITION TYPES.
- SEE SHEET A-765 FOR SIGN SCHEDULE & ELEVATIONS AND DETAILS.
- SEE STRUCTURAL DRAWINGS FOR SLAB DEPRESSIONS AND CUTOUTS.
- SEE BUILDING ELEVATION DRAWINGS FOR LOCATION OF EXTERIOR MASONRY CONTROL JOINTS.
- EXTERIOR DIMENSIONS TAKEN FROM MASONRY FACE, NOT METAL PANEL.
- ACCESSIBLE AND COMMON FEATURES, E.G. AUTOMATIC DOOR ACTIVATOR, CARD SWIPE SHALL BE PLACED 34"-36" AFF. DO NOT PLACE ACCESSIBLE OR COMMON USE BUILDING FEATURES WITHIN 24" OF AN INTERIOR CORNER.

PARTITION NOTES

- ALL NON-DESIGNATED PARTITIONS SHALL BE TYPE G32.
- ALL PIPE AND CONDUIT PENETRATIONS THRU 1 HR RATED OR MORE PARTITIONS, FLOORS, ROOF, ETC. SHALL BE SEALED WITH A RESPECTIVELY RATED FIRE BARRIER PENETRATION SEALING SYSTEM BY 3M OR U.L. APPROVED EQUAL.
- TILE BACKER BOARD SHALL BE USED IN ALL LOCATIONS TO RECEIVE TILE FINISHES. REFER TO FINISH SCHEDULE AND INTERIOR ELEVATIONS FOR LOCATIONS.
- CONTRACTOR SHALL COORDINATE WITH MECHANICAL DUCTWORK PRIOR TO FABRICATION OF PARTITION WALLS.
- SHOULD CONDITIONS OCCUR WHERE A WALL IS UNABLE TO GO STRAIGHT UP TO STRUCTURE DUE TO PIPING, DUCTWORK, ETC., THE PARTITION (GYPSUM BOARD AND FRAMING) MAY JOG HORIZONTALLY ABOVE THE CEILING TO AVOID THE PROBLEM. RATED WALL INTEGRITY SHALL BE MAINTAINED.
- WHERE STUDS EXTEND TO STRUCTURE AND GYPSUM WALLBOARD AND SOUND ATTENUATION BLENDETS EXTEND JUST ABOVE THE FINISH CEILING, CAP OFF PARTITION FINISHES WITH A RUNNER CHANNEL WHEN CEILING PLENUM IS USED AS A RETURN AIR PLENUM.
- DIMENSIONAL CONFLICTS BETWEEN PARTITION TYPES AND THE ARCHITECTURAL FLOOR PLANS SHALL BE BROUGHT TO THE ATTENTION OF THE ARCHITECT.
- SEE LIFE SAFETY PLANS FOR THE LOCATIONS OF SMOKE BARRIERS, SMOKE PARTITIONS AND FIRE RATED PARTITIONS.
- REFER TO UNDERWRITERS LABORATORIES, INC. FIRE RESISTANCE VOLUMES - CURRENT EDITION FOR SPECIFIC CONSTRUCTION REQUIREMENTS OF U.L. LISTED ASSEMBLIES.
- REFER TO MECHANICAL, ELECTRICAL AND PLUMBING DRAWINGS FOR TYPICAL U.L. LISTED PENETRATIONS THROUGH FIRE-RATED ASSEMBLIES. CONTRACTOR SHALL BE RESPONSIBLE FOR PROVIDING APPROPRIATE PROJECT-SPECIFIC U.L. LISTED ASSEMBLIES FOR PENETRATIONS.
- AT ALL EXISTING AND CONSTRUCTED PARTITIONS THE CONTRACTOR IS TO MAINTAIN THE FIRE-RESISTIVE INTEGRITY.
- PROVIDE ACOUSTICAL SEALANT AT PERIMETER OF ALL SOUND RATED PARTITIONS AND AT ALL PARTITION PENETRATIONS. IF PARTITION IS FIRE RATED, PROVIDE U.L. LABELED FIRESTOPPING IN PLACE ACOUSTICAL SEALANT AT PARTITIONS THAT ARE SOUND AND FIRE RATED. PROVIDE ACOUSTICAL SEALANT AT PARTITION PENETRATIONS THAT DO NOT REQUIRE FIRESTOPPING (EXAMPLE: DUCT PENETRATIONS WITH FIRE DAMPERS).


TOILET ACCESSORIES LEGEND

DESCRIPTION	SUPPLIED BY	INSTALLED BY
TT TOILET TISSUE DISPENSER	OWNER	G.C.
PTR PAPER TOWEL DISPENSER, ROLL	OWNER	G.C.
WR WASTE RECEPTACLE	OWNER	OWNER
SD LIQUID SOAP DISPENSER	OWNER	G.C.
GB18 18" GRAB BAR	G.C.	G.C.
GB28 28" GRAB BAR	G.C.	G.C.
GB36 36" GRAB BAR	G.C.	G.C.
GB42 42" GRAB BAR	G.C.	G.C.
SDU SANITARY PRODUCT DISPOSAL UNIT	G.C.	G.C.
MG GLASS MIRROR UNIT	G.C.	G.C.
SCR SHOWER CURTAIN ROD	G.C.	G.C.
SC SHOWER CURTAIN	G.C.	G.C.
FSS FOLDING SHOWER SEAT	G.C.	G.C.
SH SOAP HOLDER	G.C.	G.C.
RH ROBE HOOK	G.C.	G.C.
TB TOWEL BAR	G.C.	G.C.
MH MOP HOOKS	G.C.	G.C.

PARTITION LEGEND


- ALL EXTERIOR WALLS TO BE TYPE W1 U.N.O. SEE A-003 FOR CONSTRUCTION OF SUBSYSTEMS.
- SEE SHEET A-004 FOR CONSTRUCTION OF PARTITION TYPES.
- ALL INTERIOR METAL STUD PARTITIONS TO BE TYPE G32 U.N.O.

- NON-RATED WALL, EXTEND GYP. BD. AND FRAMING TO STRUCTURE ABOVE.
- NON-RATED WALL, EXTEND GYP. BD. TO MIN. 4" ABOVE FINISHED CEILING AND FRAMING TO STRUCTURE ABOVE.
- 1 HR.-RATED BARRIER, EXTEND TO THE UNDERSIDE OF THE DECK ABOVE.
- 2 HR.-RATED BARRIER, EXTEND TO THE UNDERSIDE OF THE DECK ABOVE.
- FIRE EXTINGUISHER CABINET
- FIRE EXTINGUISHER BRACKET
- CORNER GUARD

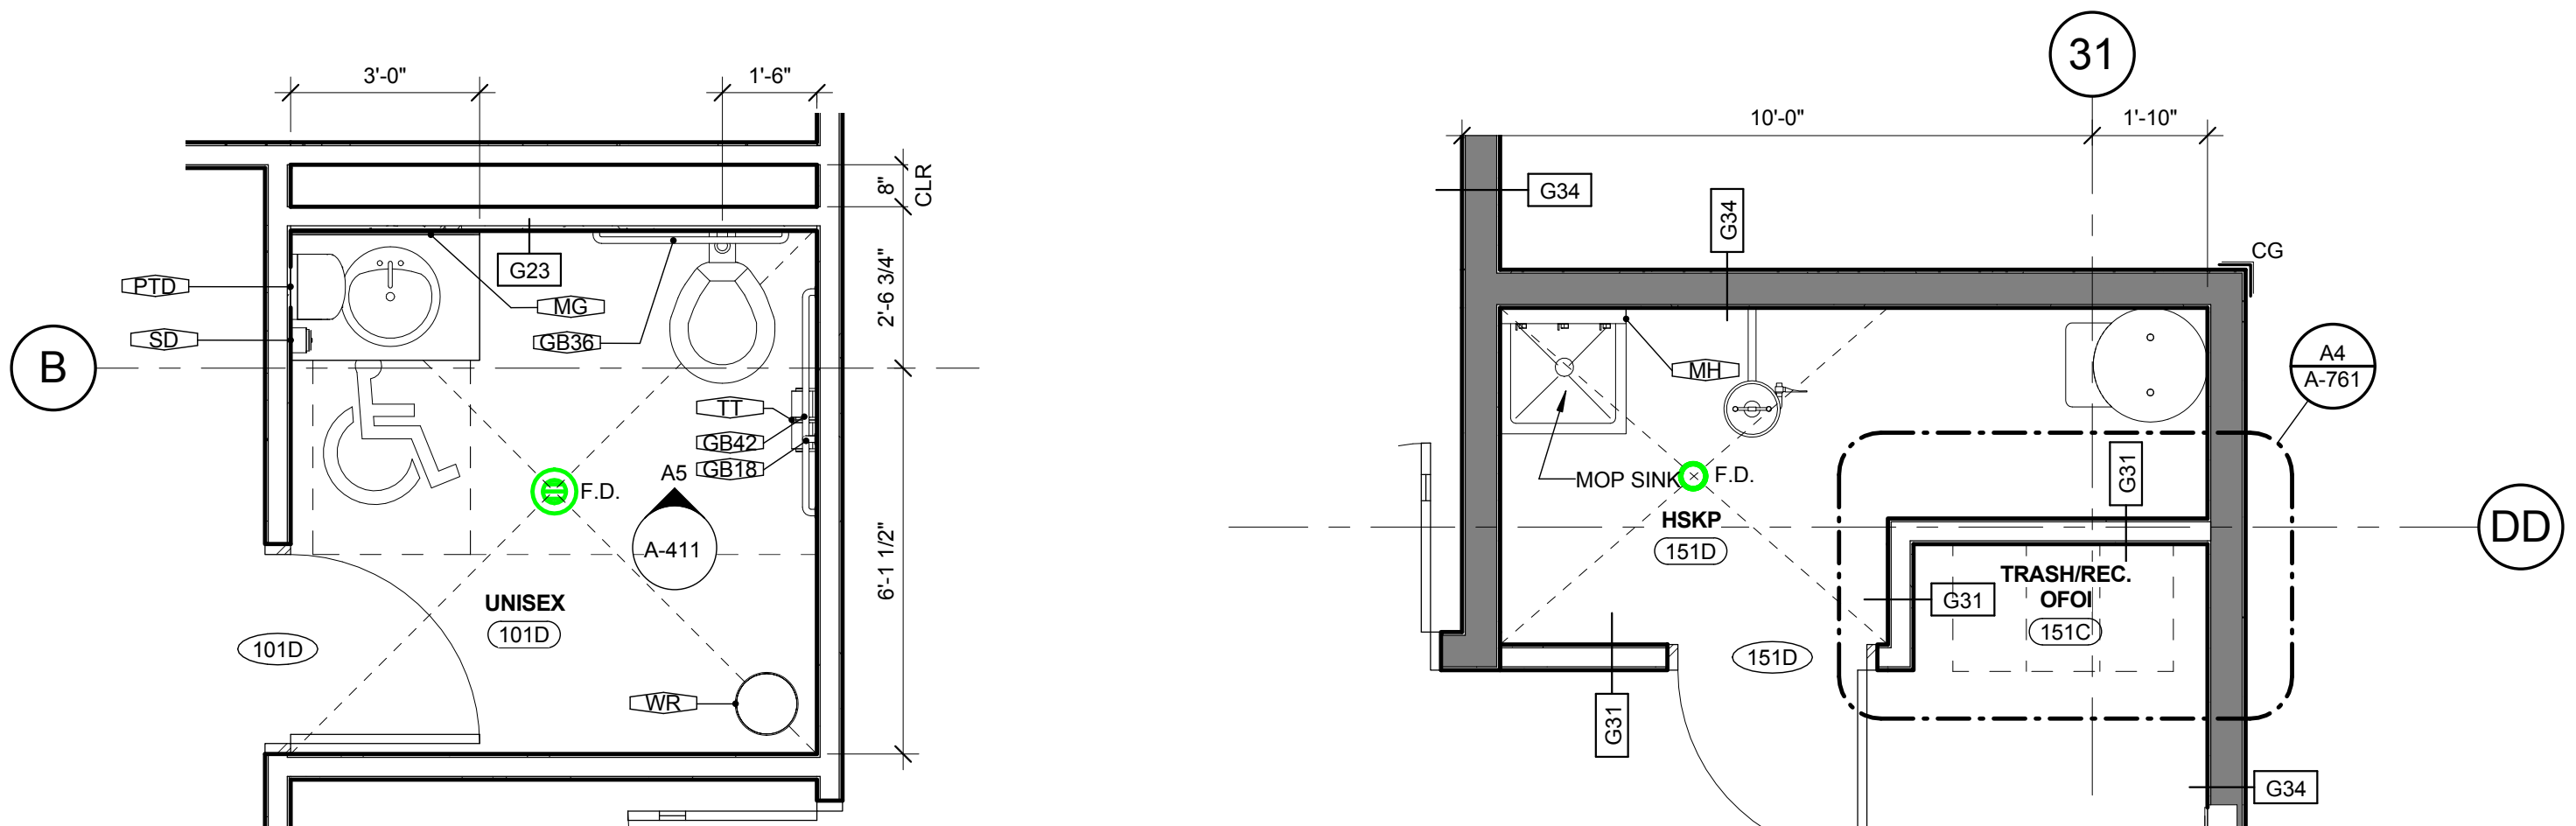


E1 ENLARGED PLAN - UNISEX RESTROOM
3/8" = 1'-0"


E2 ENLARGED PLAN - WAREHOUSE HSKP AND RECY
3/8" = 1'-0"

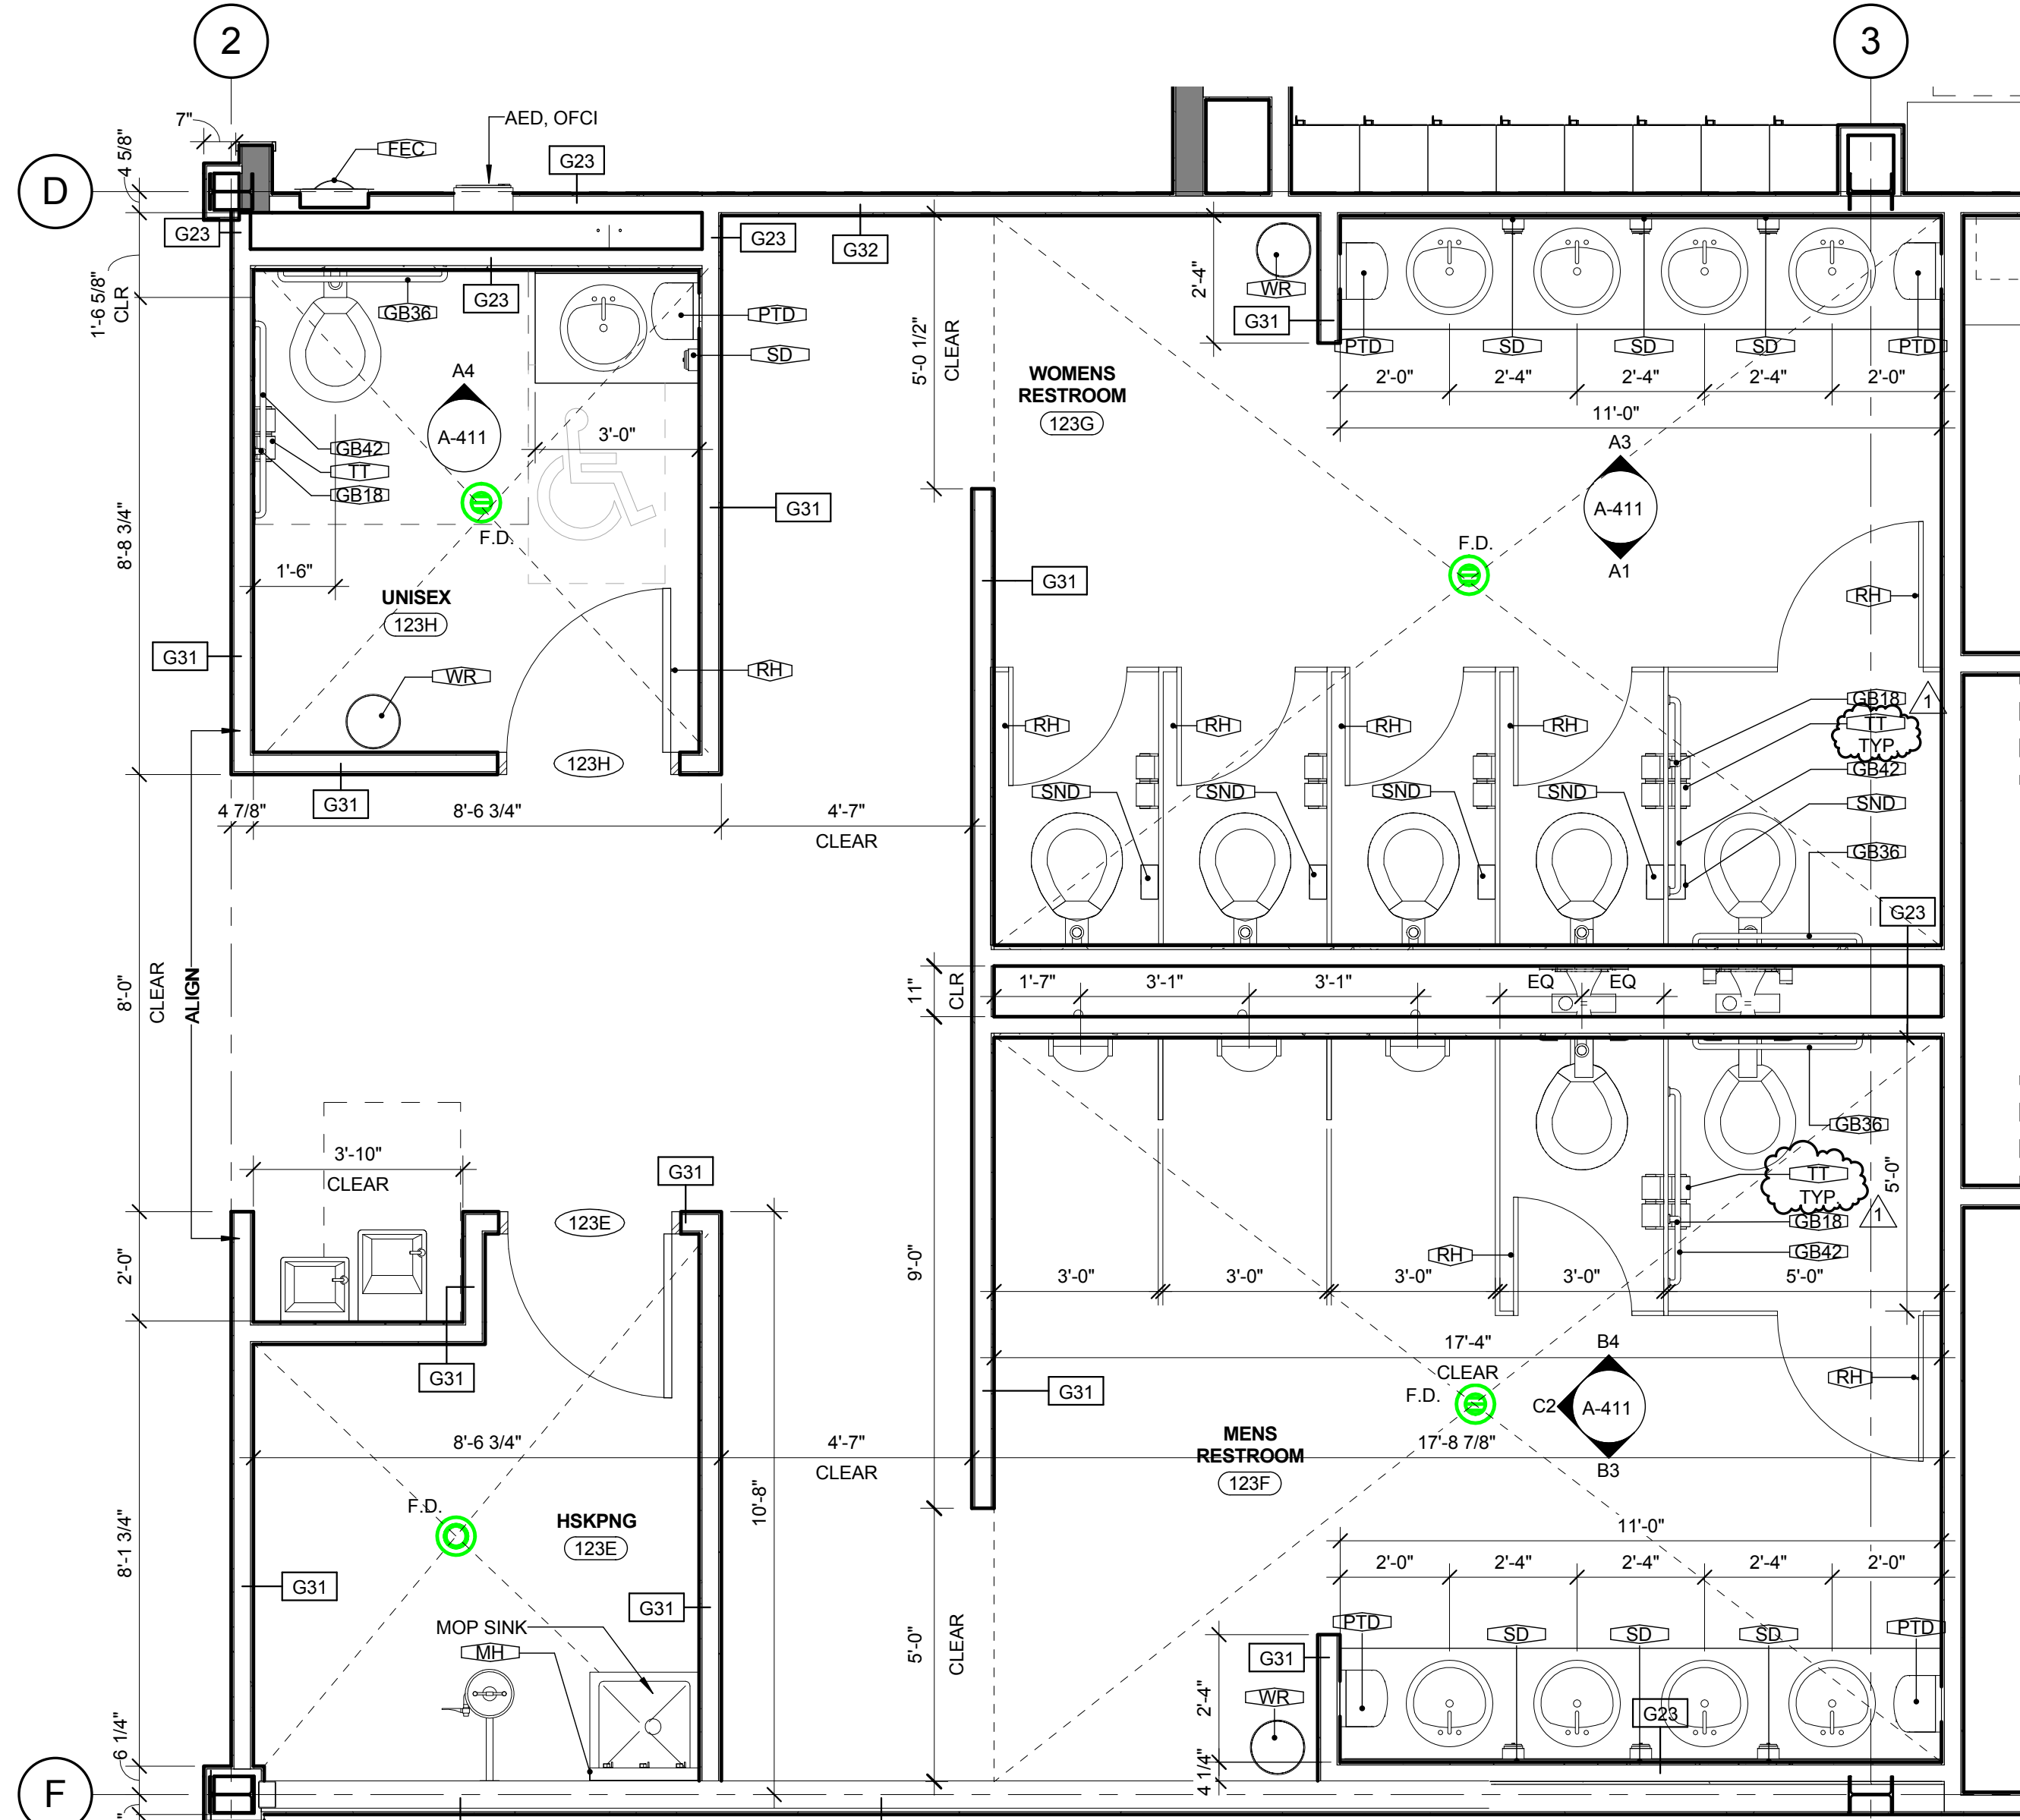


D1 ENLARGED PLAN - OFFICE RESTROOMS
3/8" = 1'-0"

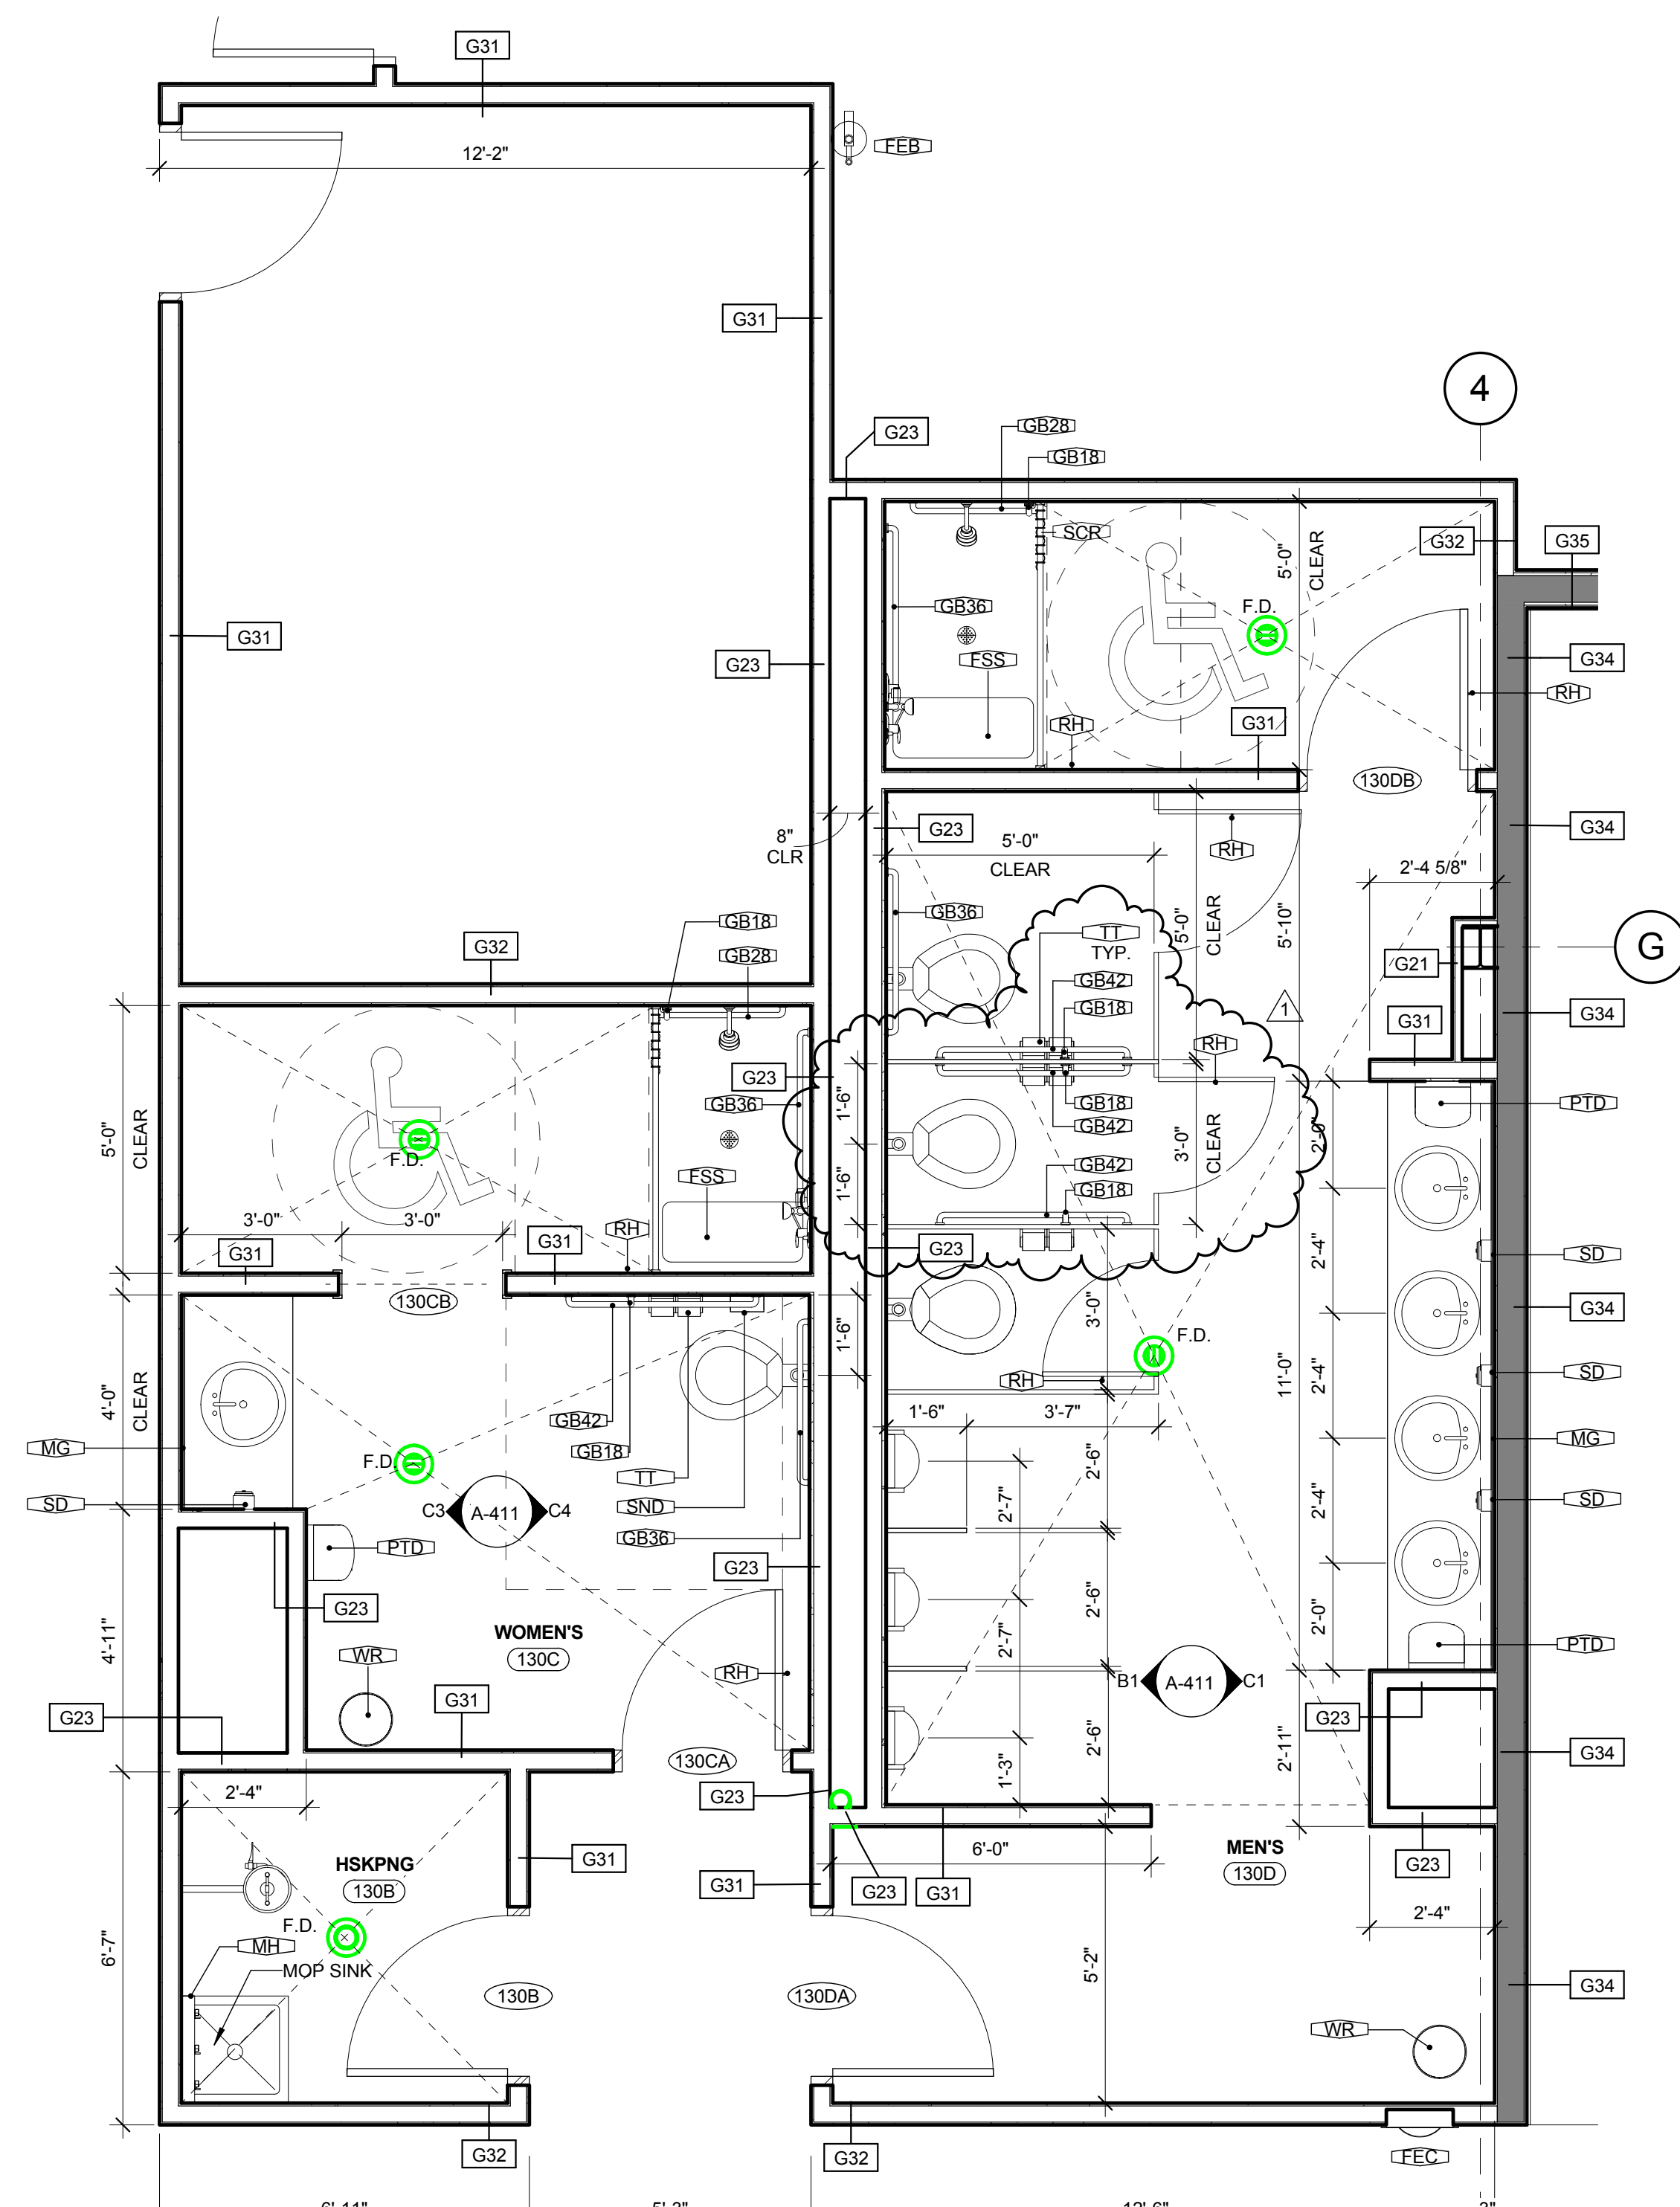

D3 ENLARGED PLAN - FO SHOP RESTROOMS
3/8" = 1'-0"

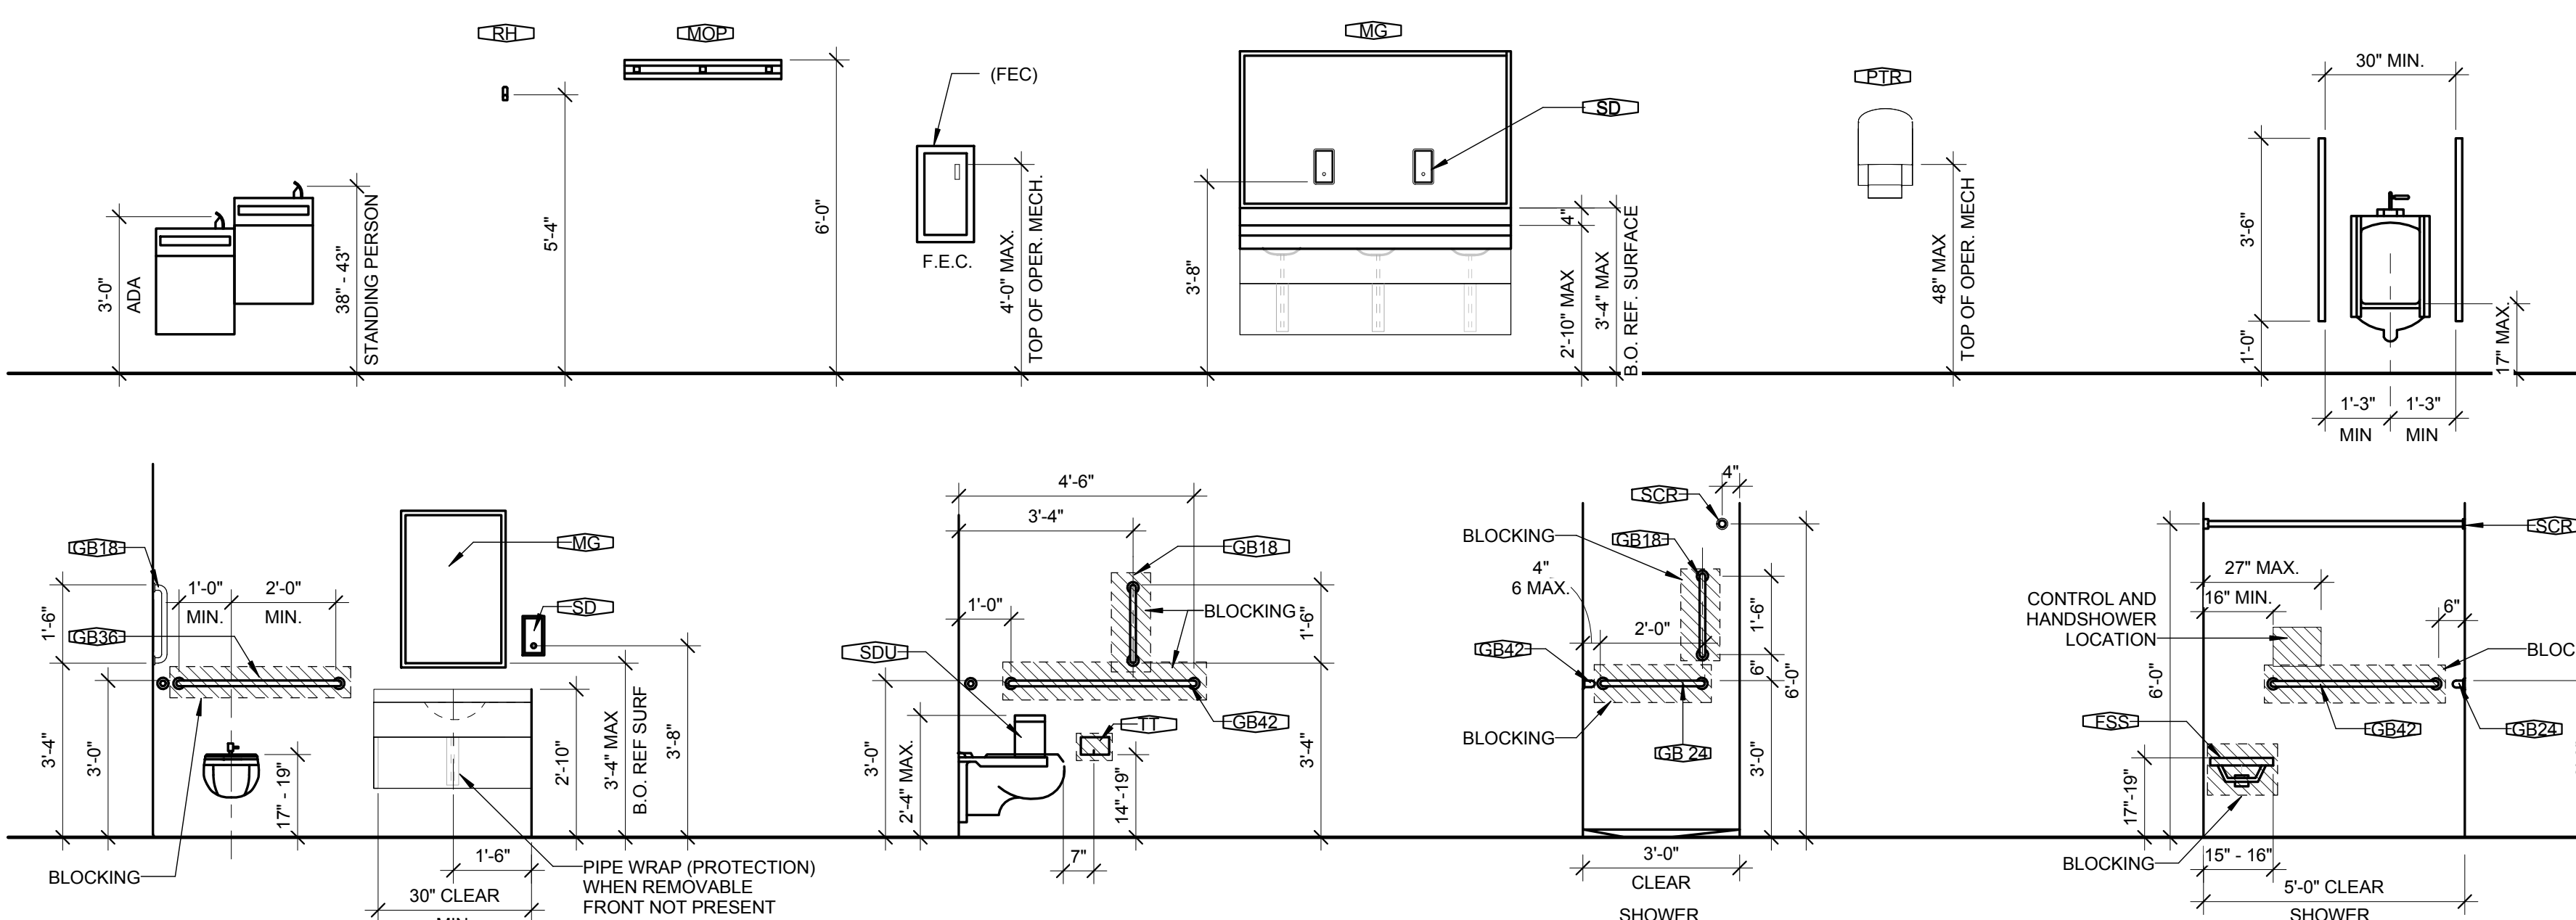

A1 TYPICAL MOUNTING HEIGHTS
3/8" = 1'-0"

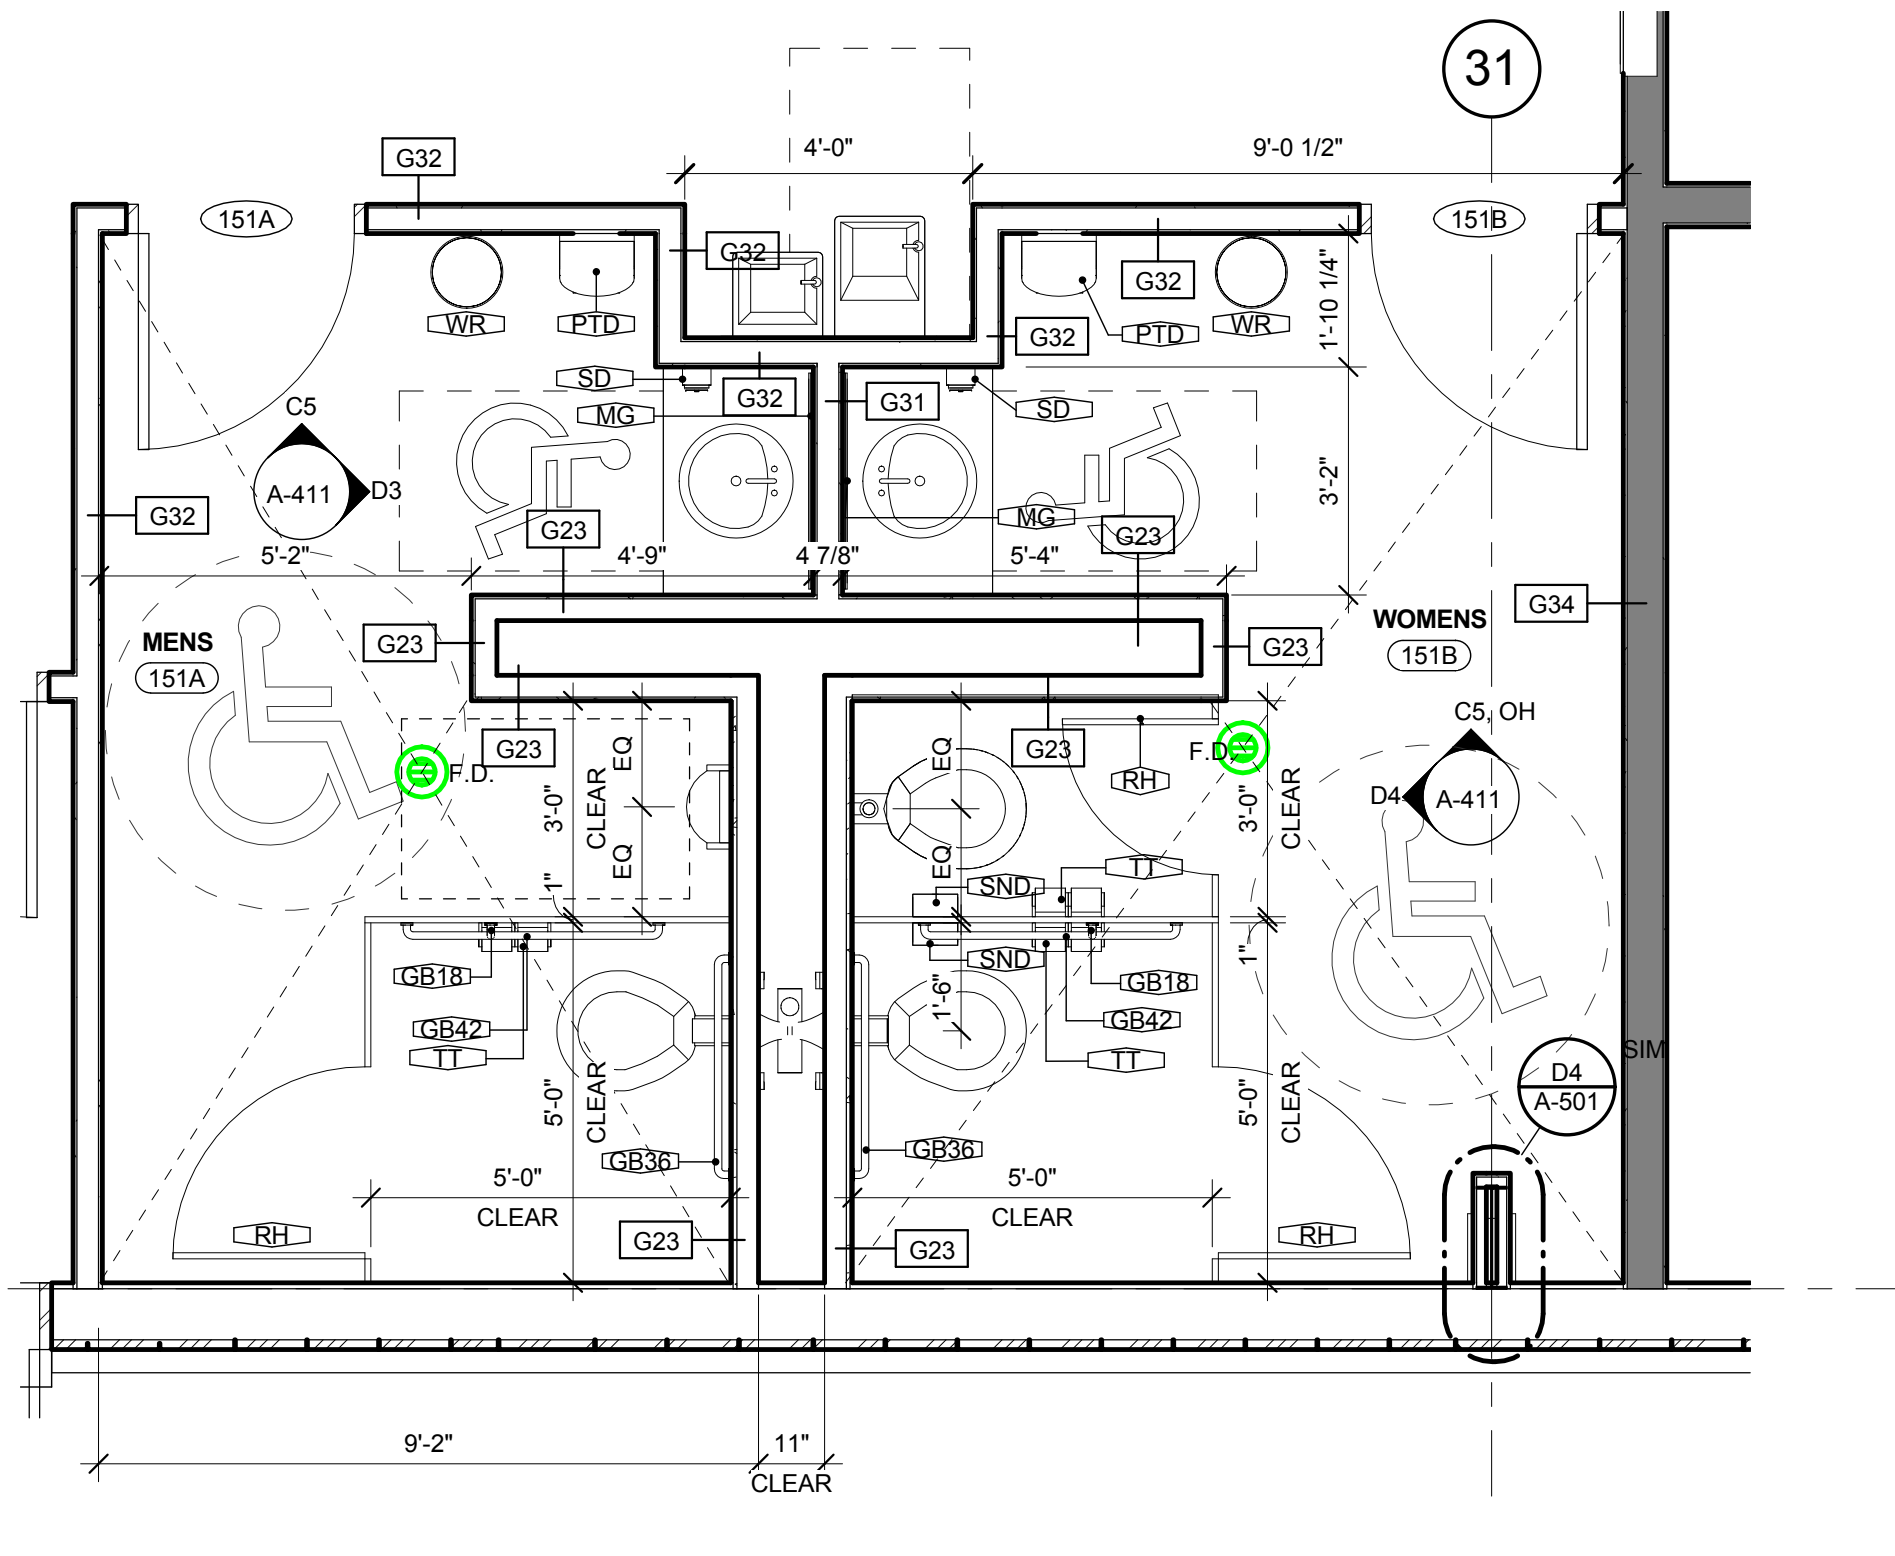

D5 ENLARGED PLAN - WAREHOUSE RESTROOMS
3/8" = 1'-0"





MEMBERS OF THE AMERICAN INSTITUTE OF ARCHITECTS

COPYRIGHT 2017 ALL RIGHTS RESERVED
PRINTED OR ELECTRONIC DRAWINGS AND DOCUMENTATION MAY NOT BE REPRODUCED IN ANY FORM WITHOUT WRITTEN PERMISSION FROM LS3P ASSOCIATES LTD.


REVISIONS:

No.	Description	Date
1	Addendum No. 4	08/28/2017


PROJECT: 9202-164730
SCO ID: 16-15656-02B
ITEM: 315 CODE: 41526
DATE: AUGUST 21, 2017
DRAWN BY: RD
CHECKED BY: SH

SECTION DETAILS (EXTERIOR)


A-512

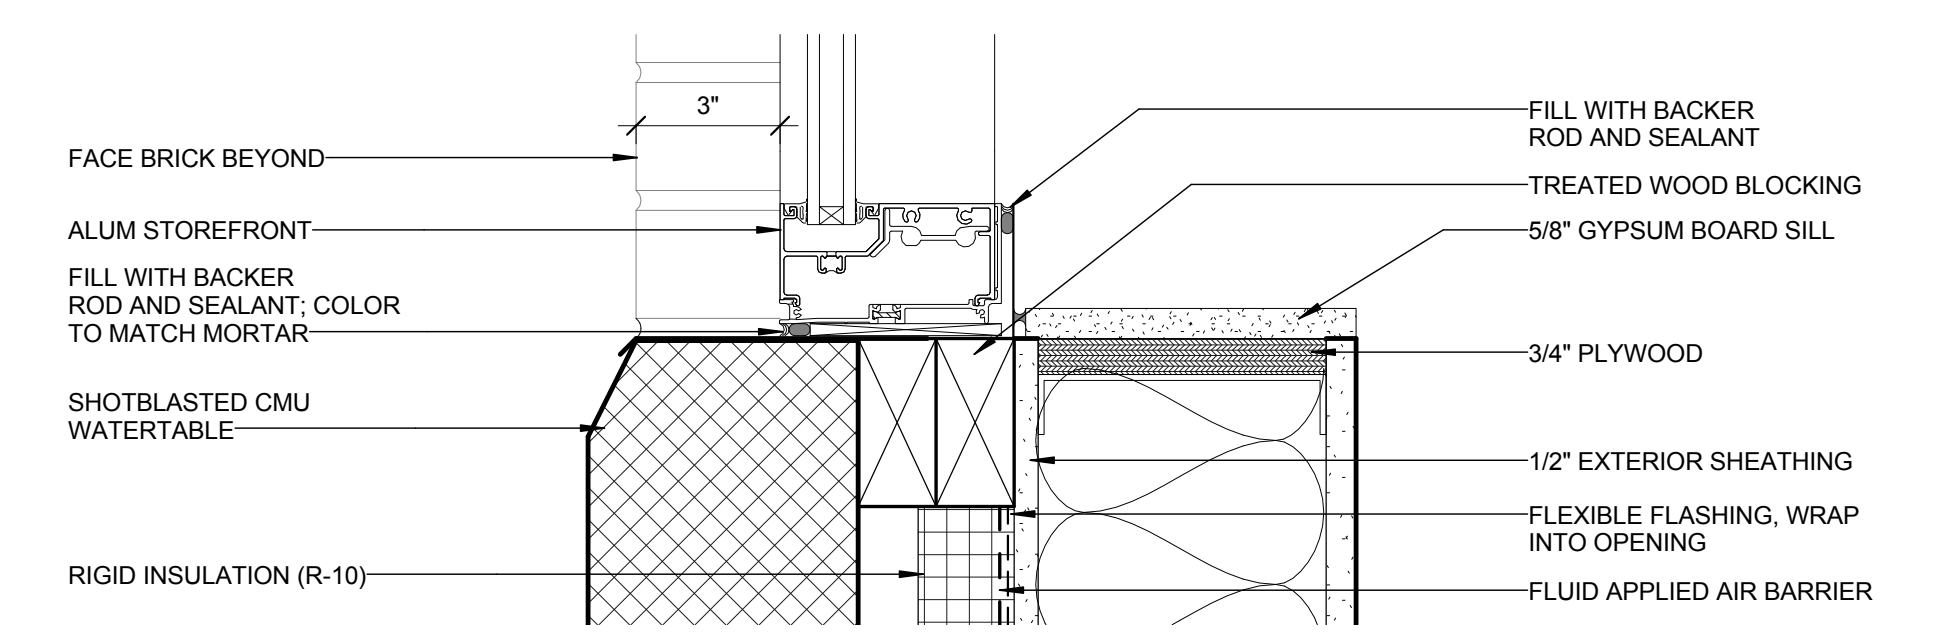


E6 TYPICAL WINDOW SILL
3" = 1'-0"

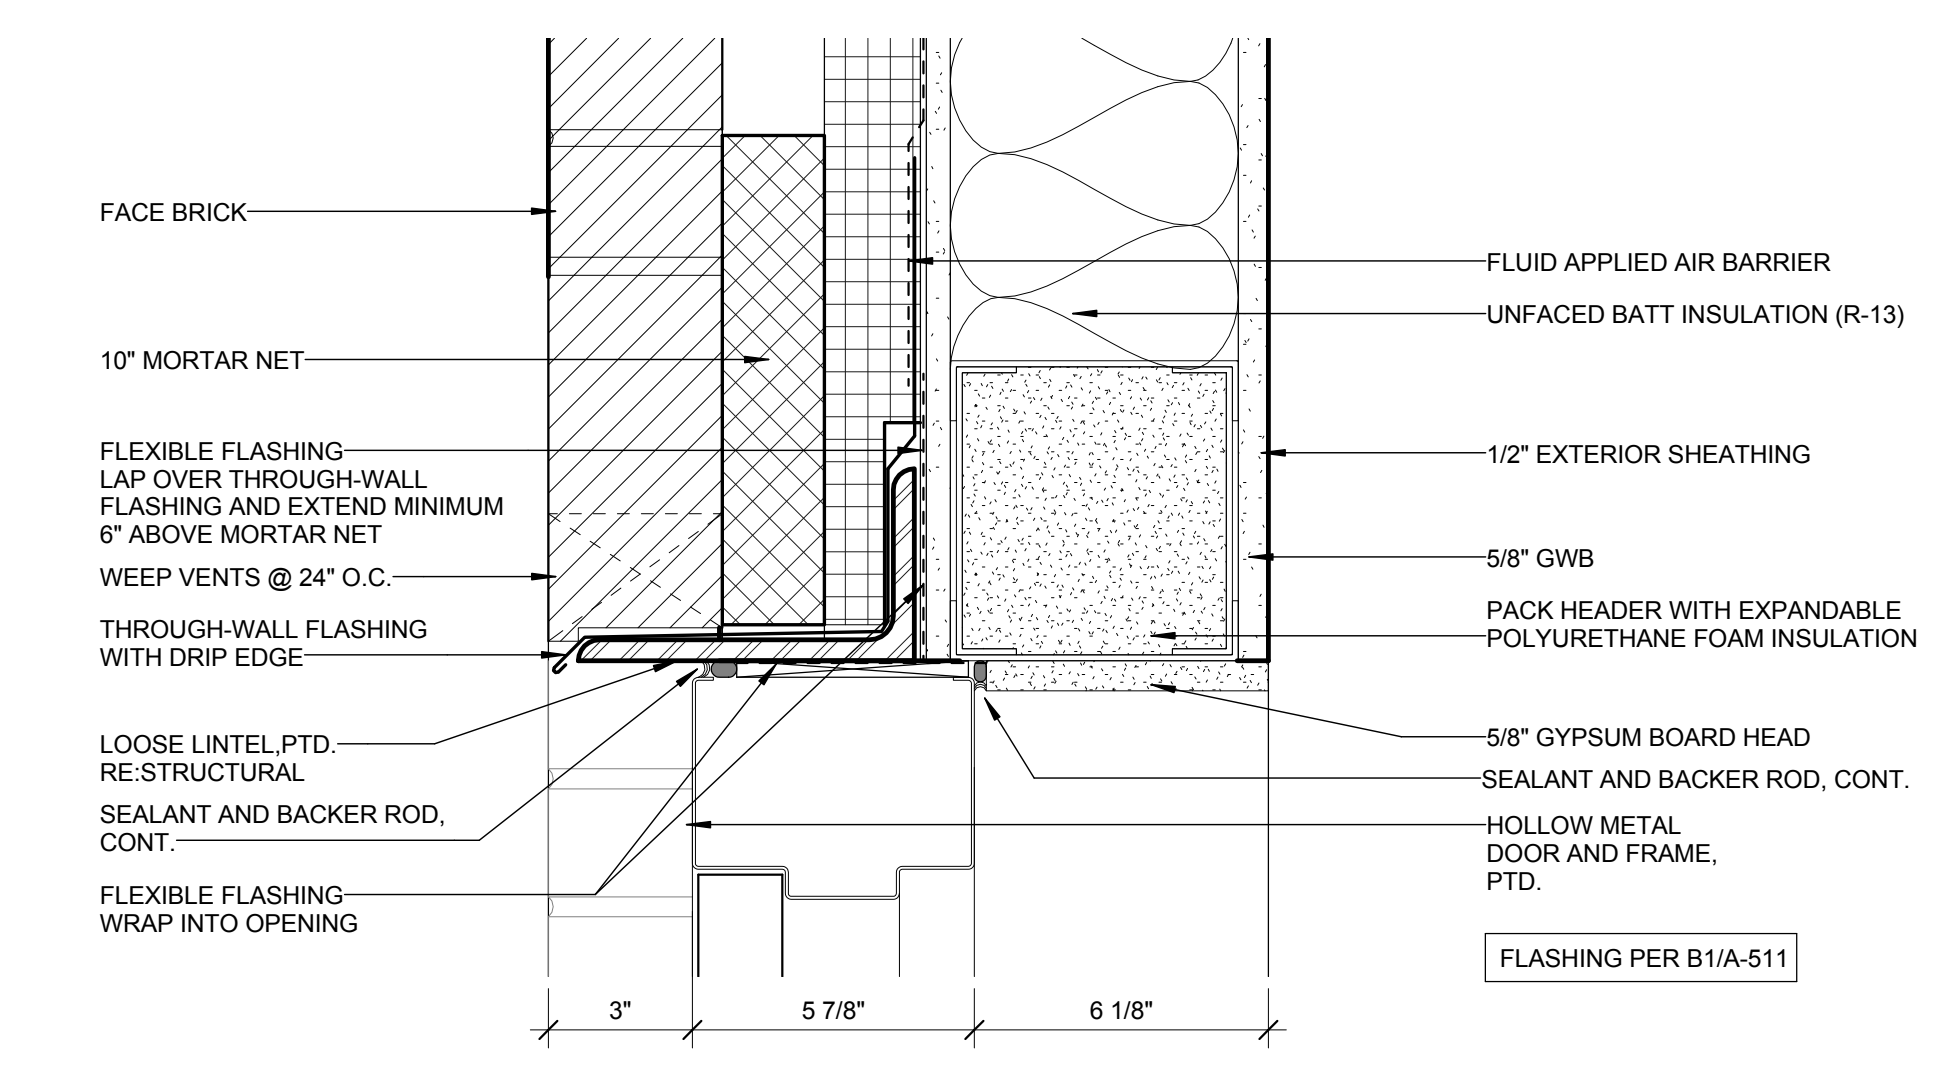


D6 TYPICAL DOOR HEAD
3" = 1'-0"

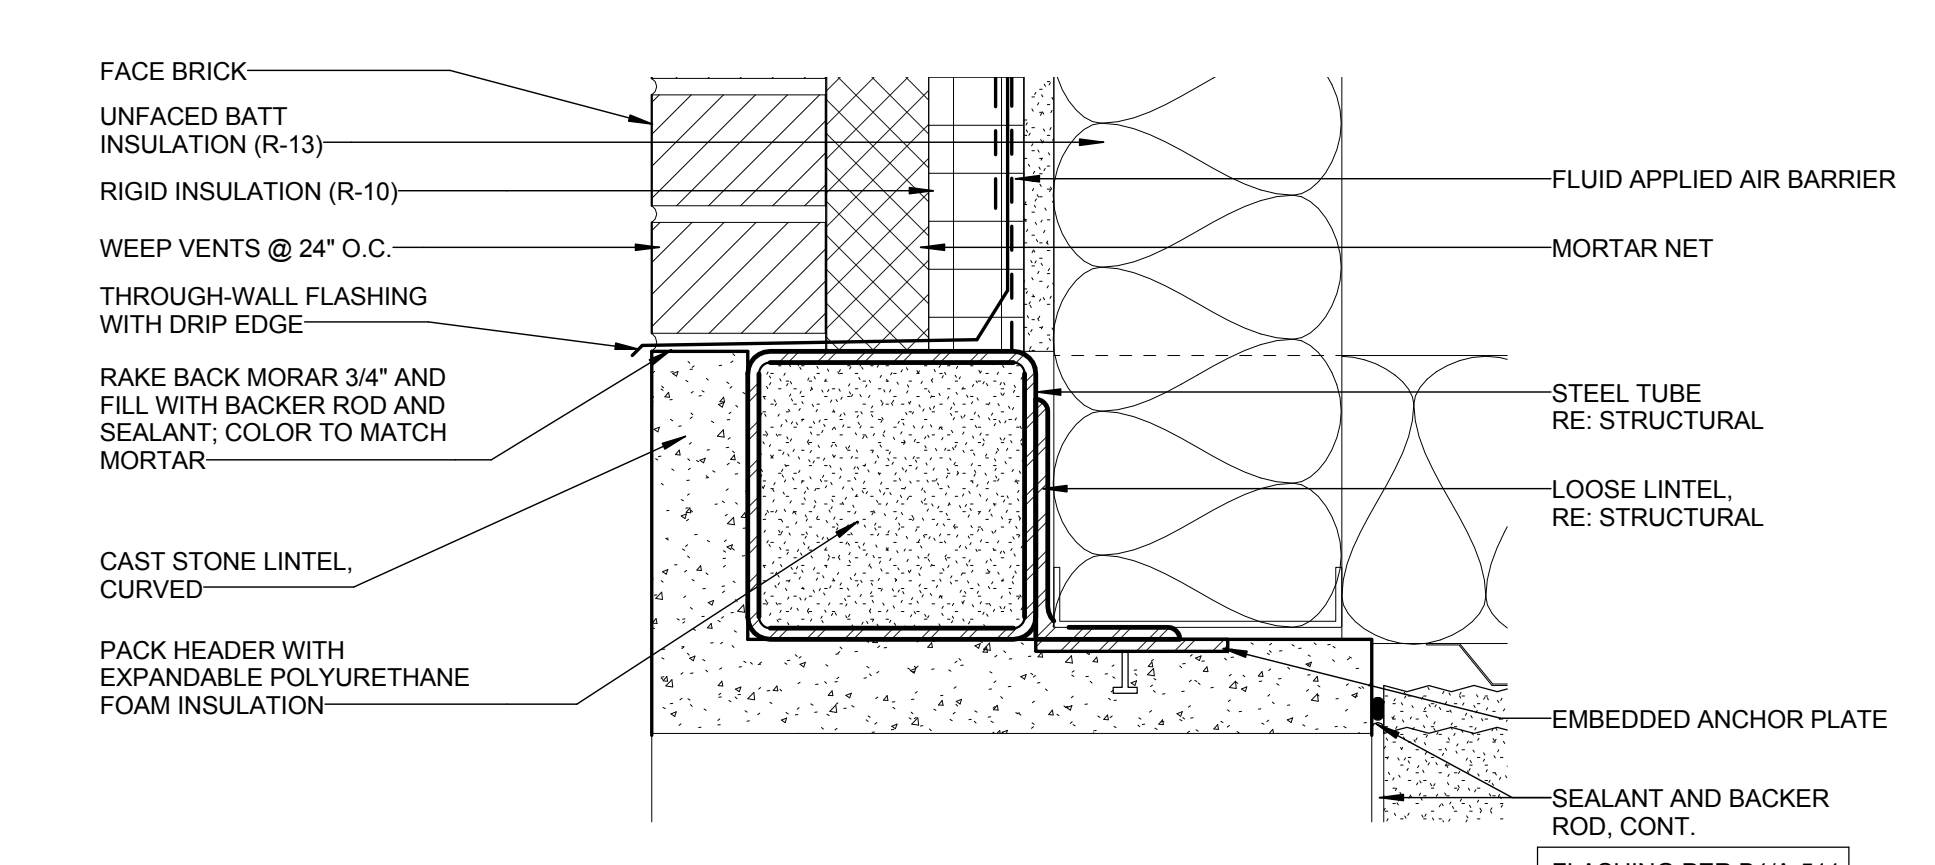


C6 CAST STONE HEAD DETAIL
3" = 1'-0"

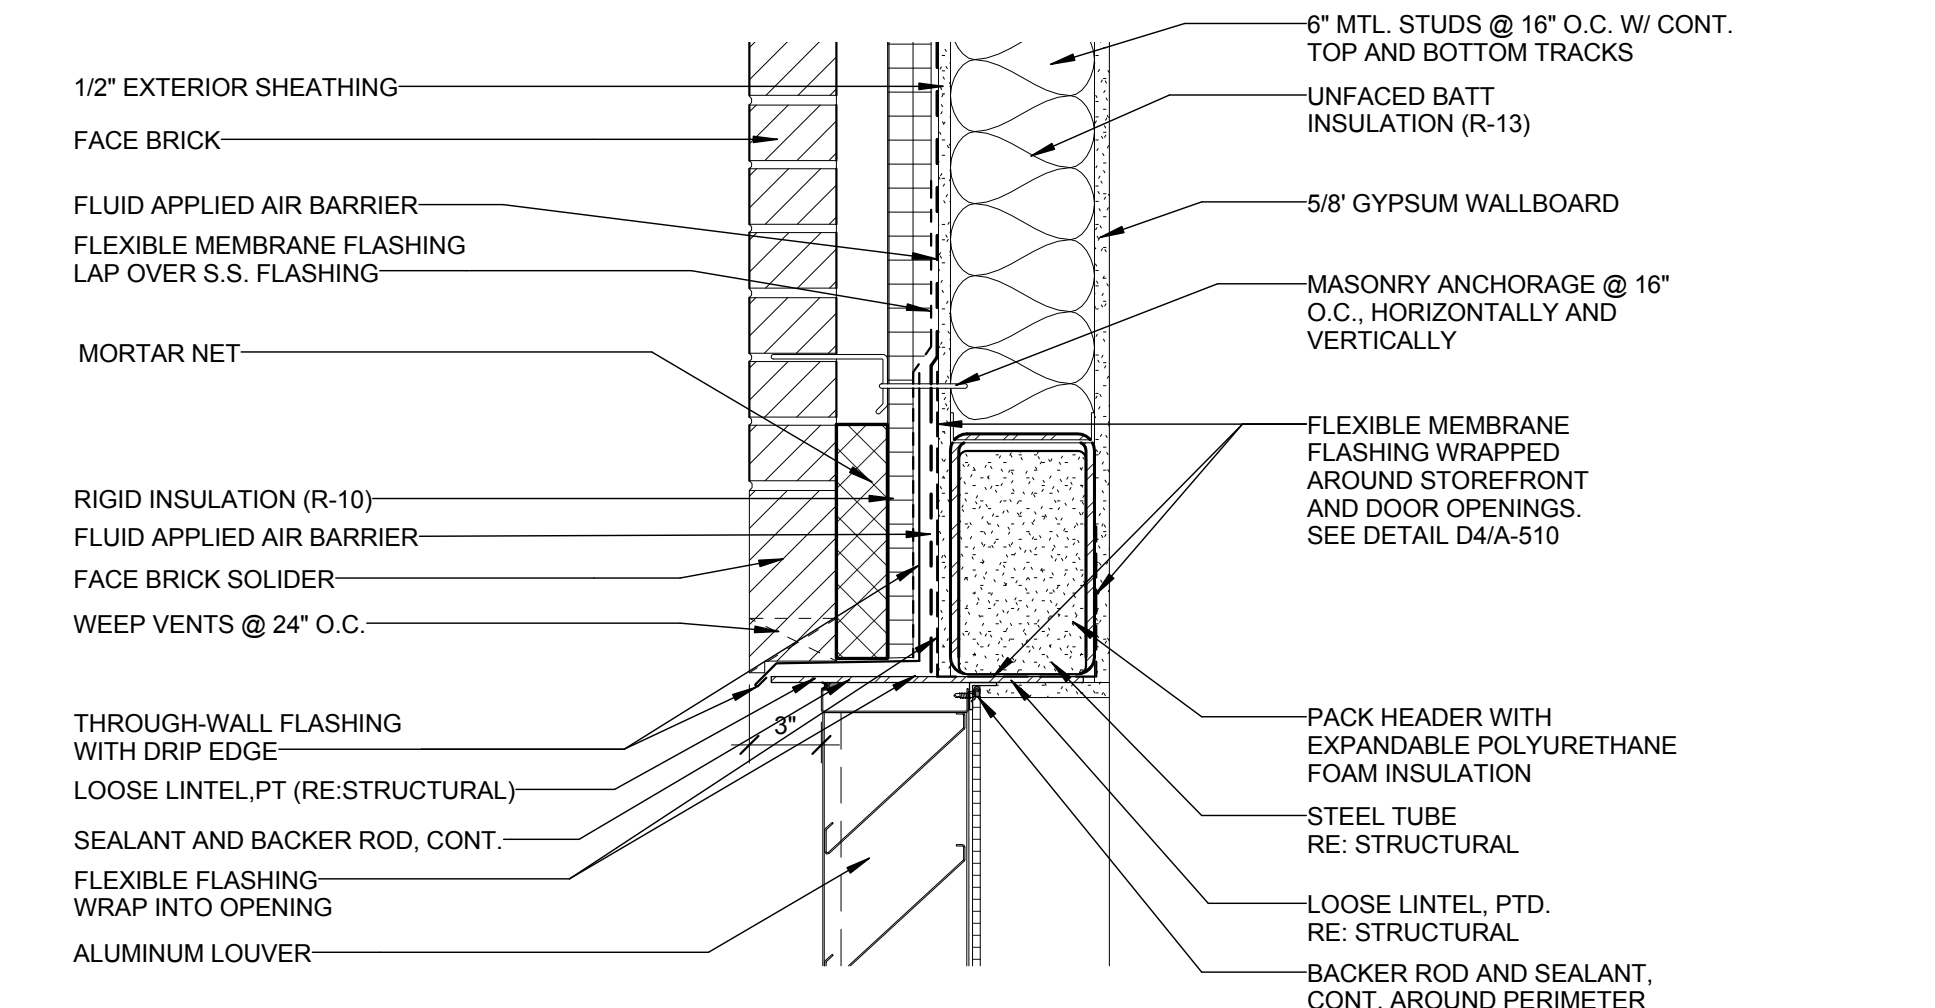


B5 SECTION - LOUVER HEAD
1 1/2" = 1'-0"

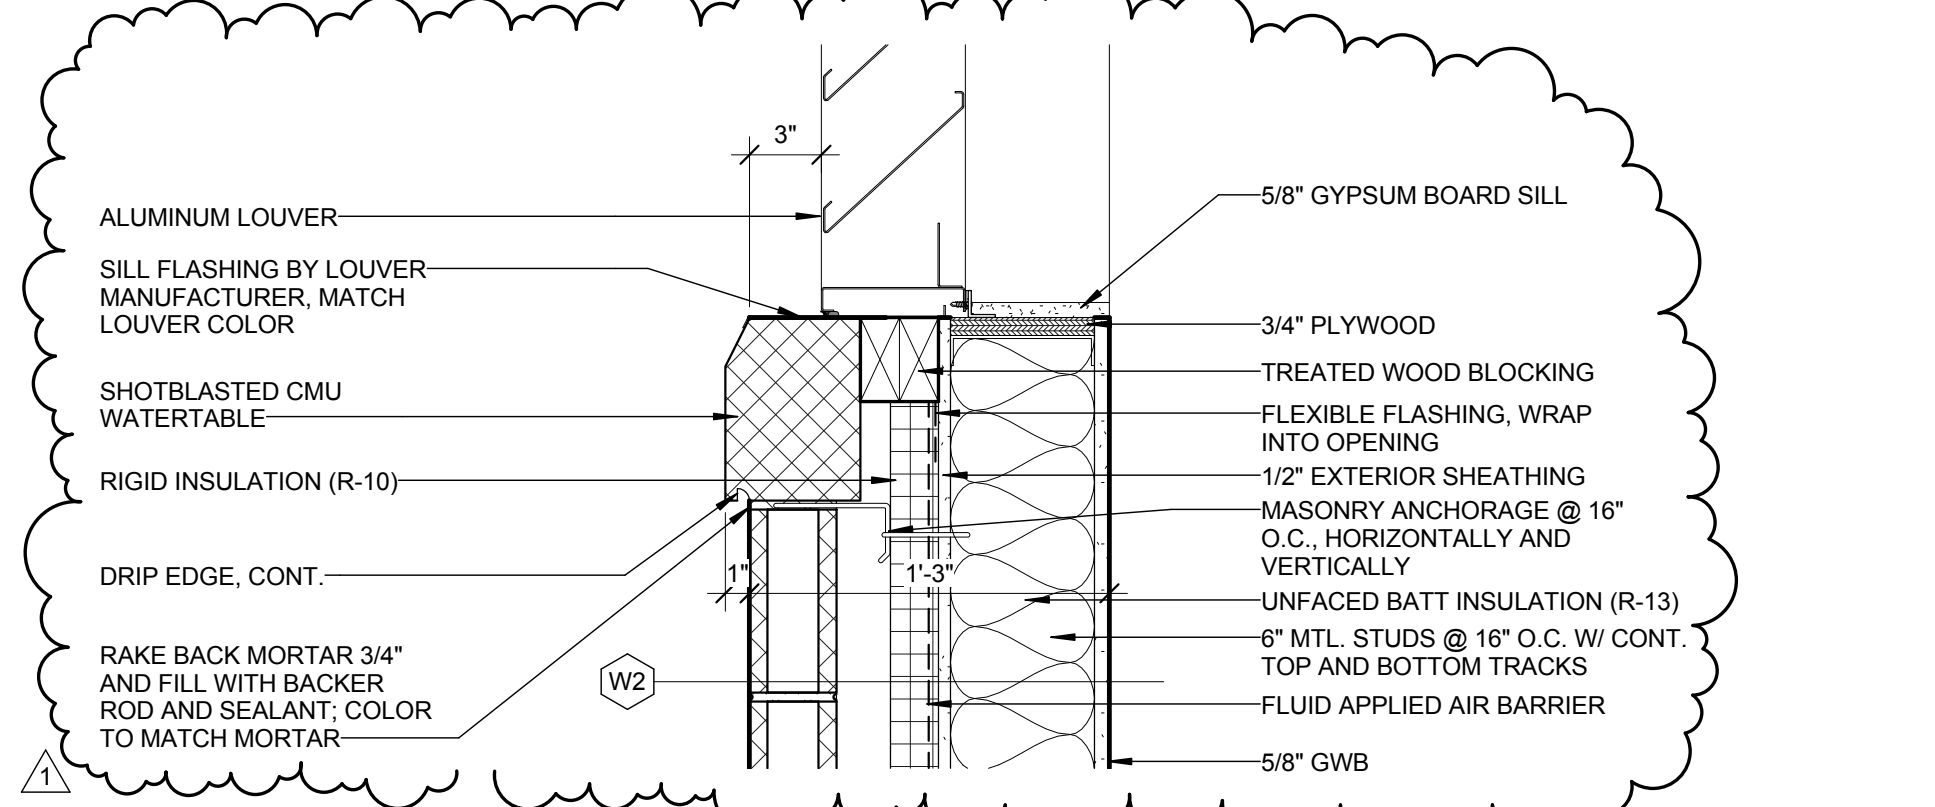


A5 SECTION - LOUVER SILL
1 1/2" = 1'-0"

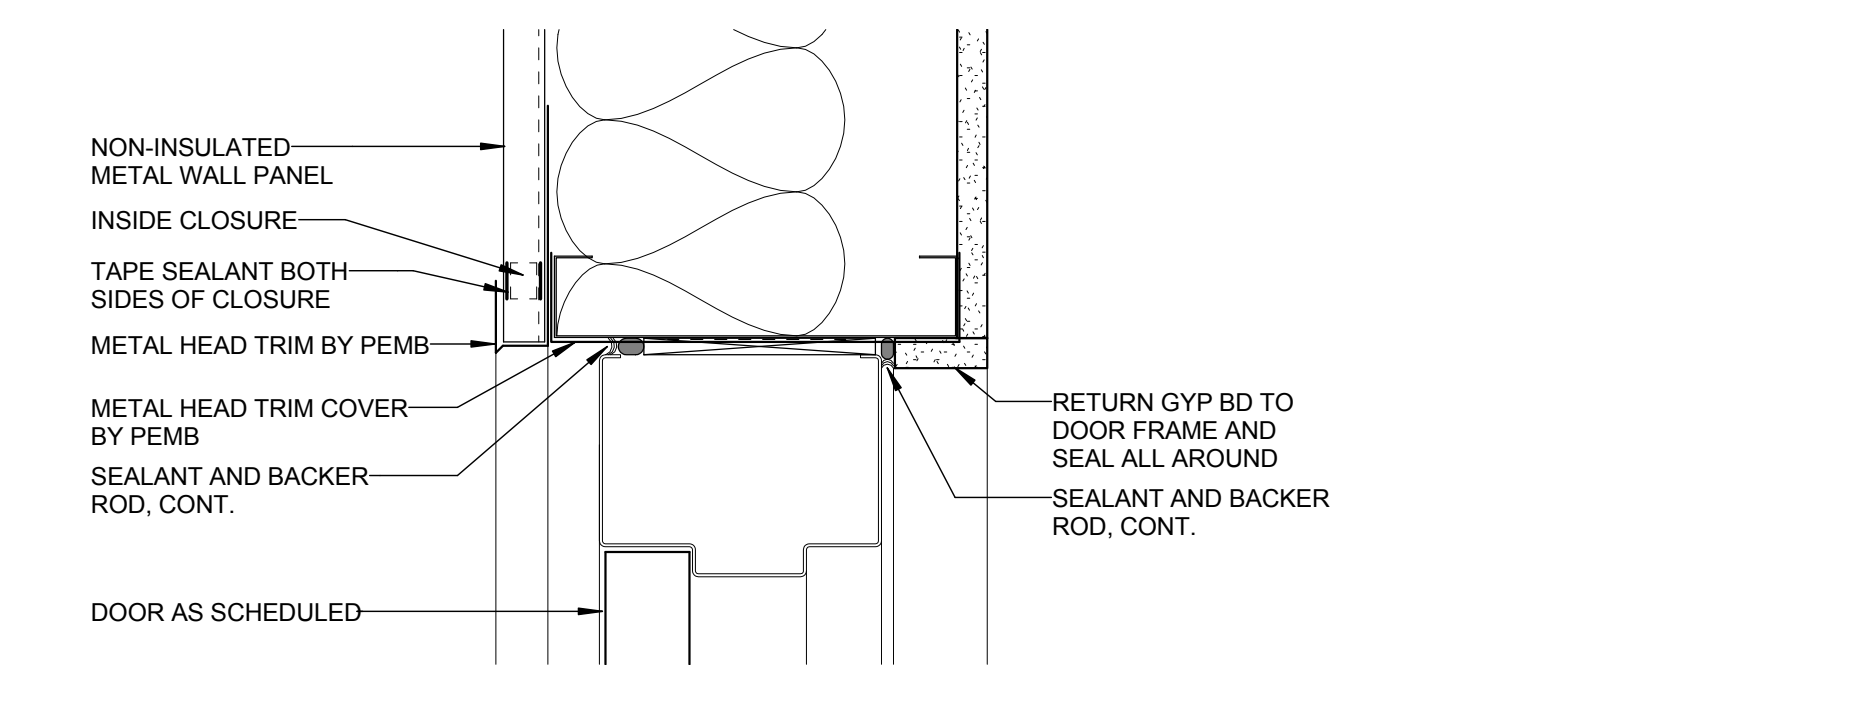


E3 TYPICAL DOOR HEAD @ PEMB
3" = 1'-0"

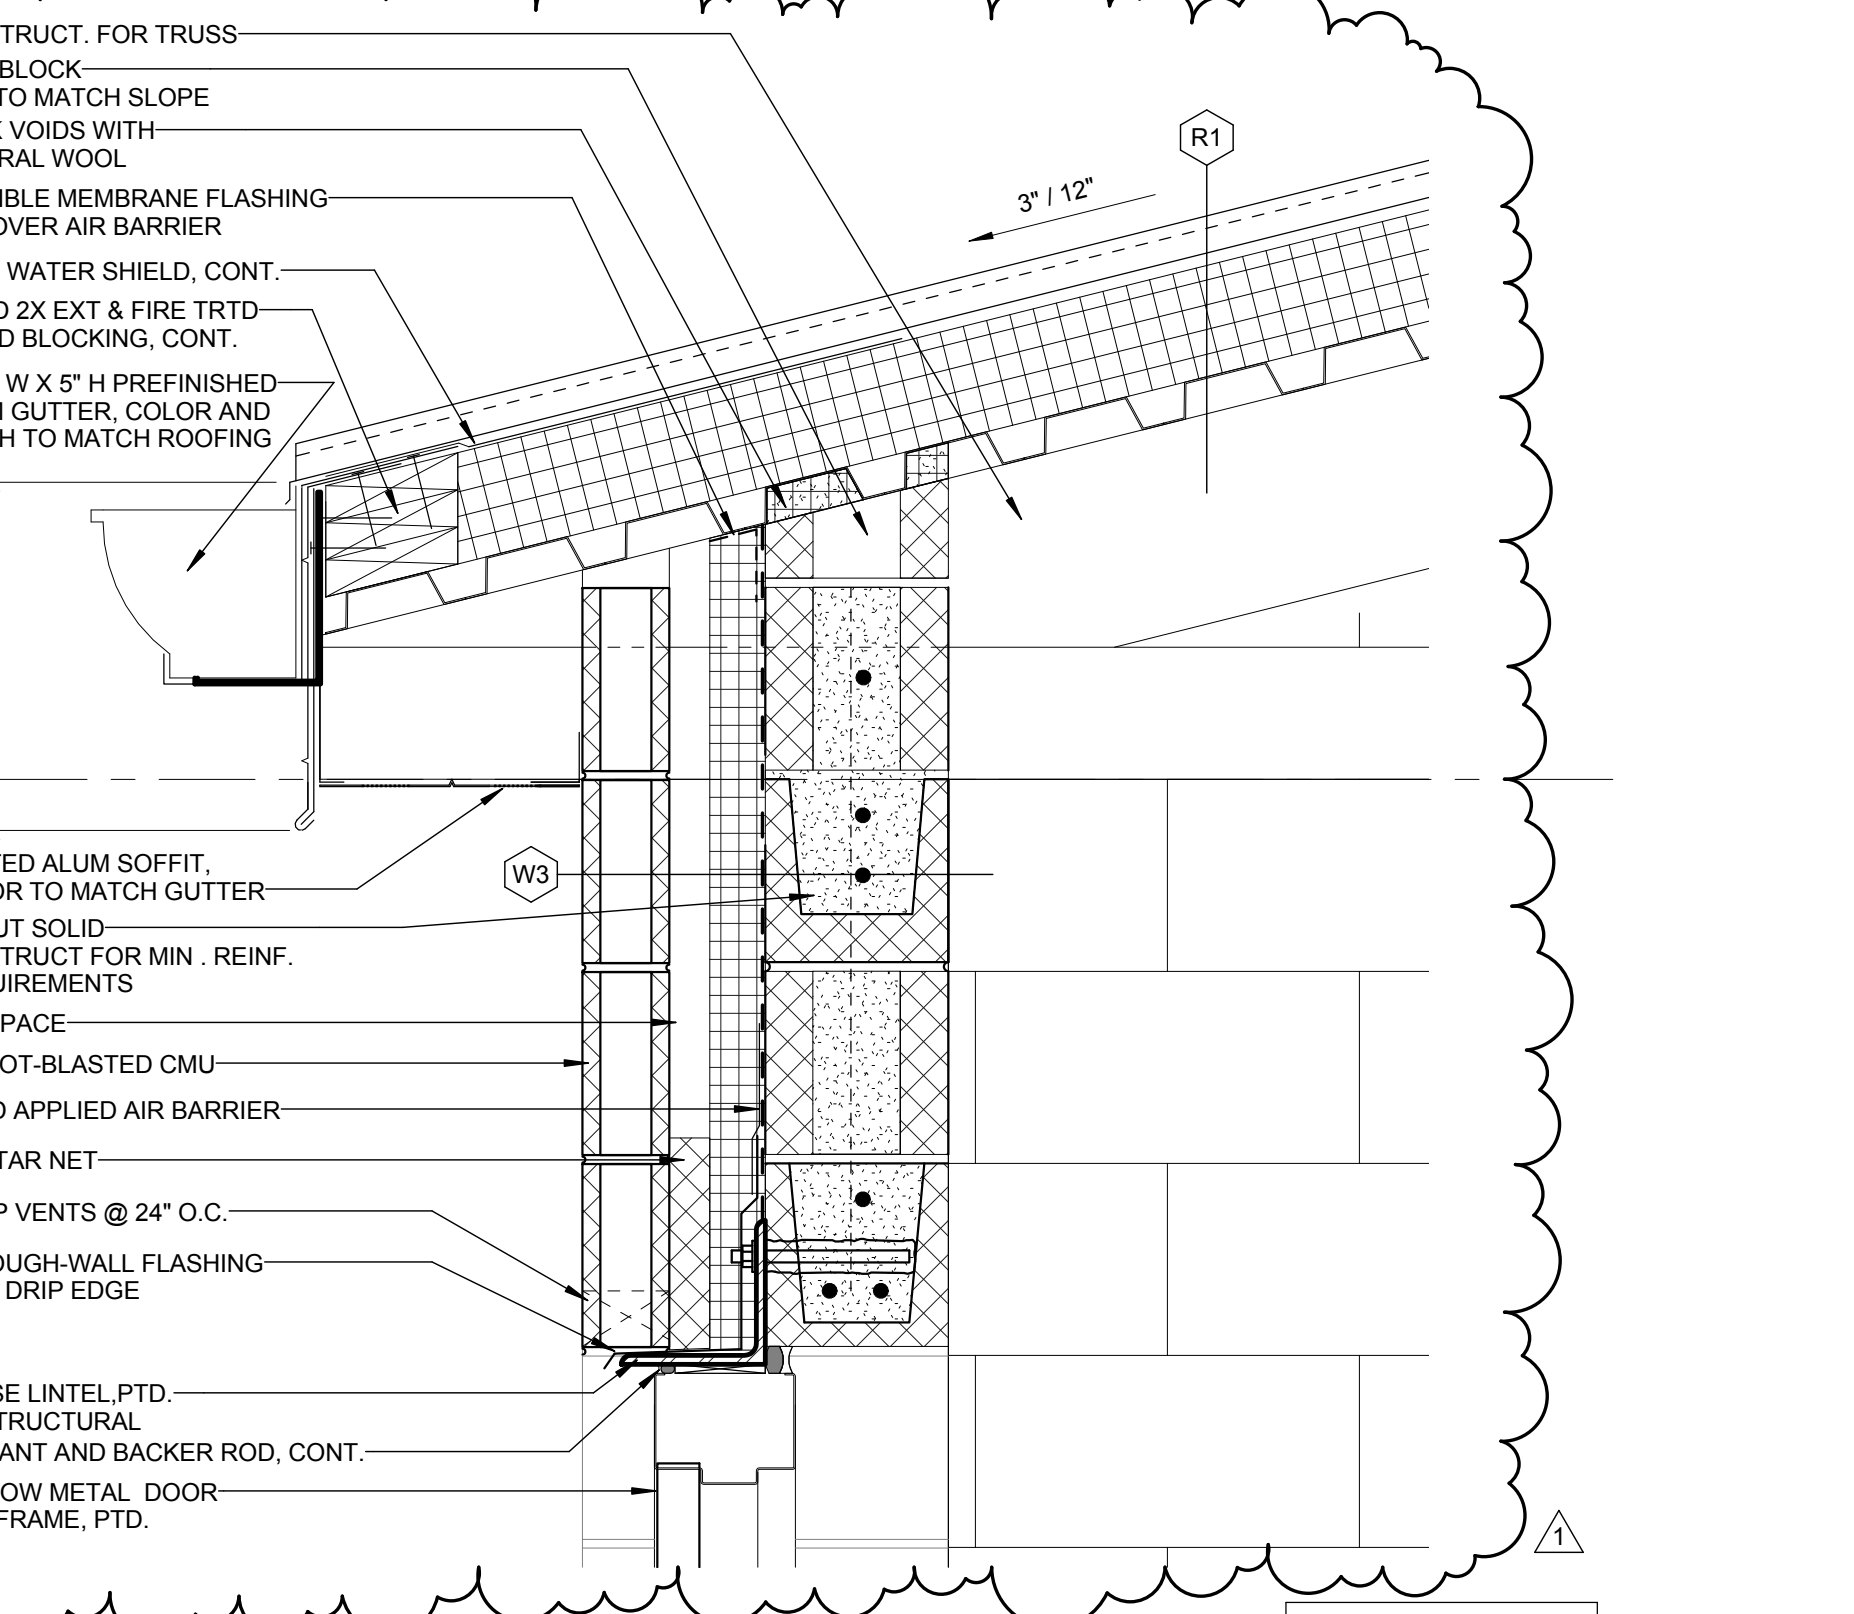


C3 SECTION-GAS STORAGE DOOR HEAD
1 1/2" = 1'-0"

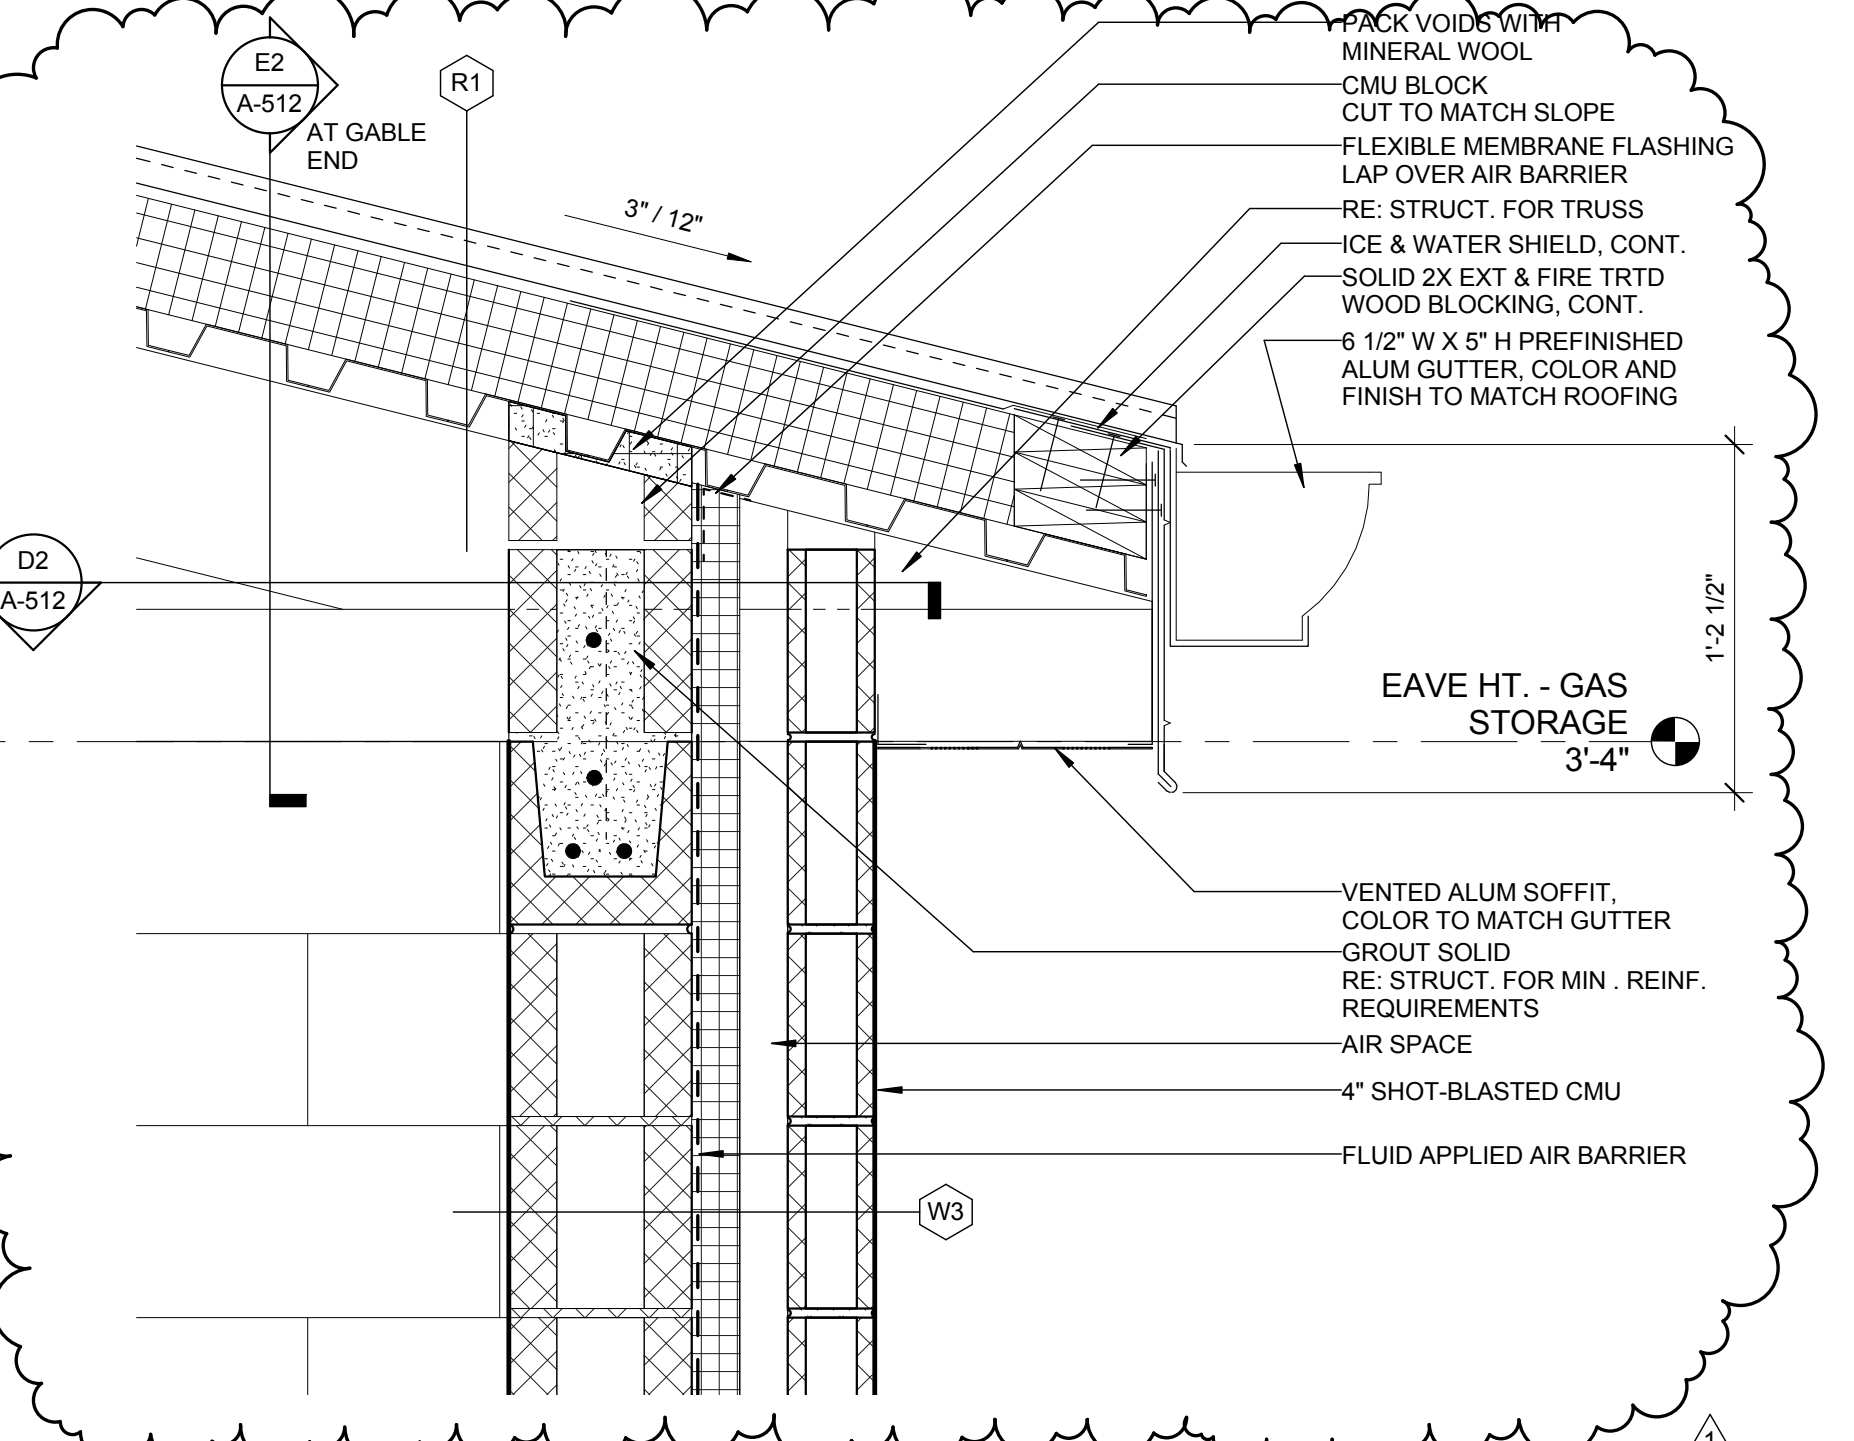


B3 SECTION - GAS STORAGE
1 1/2" = 1'-0"

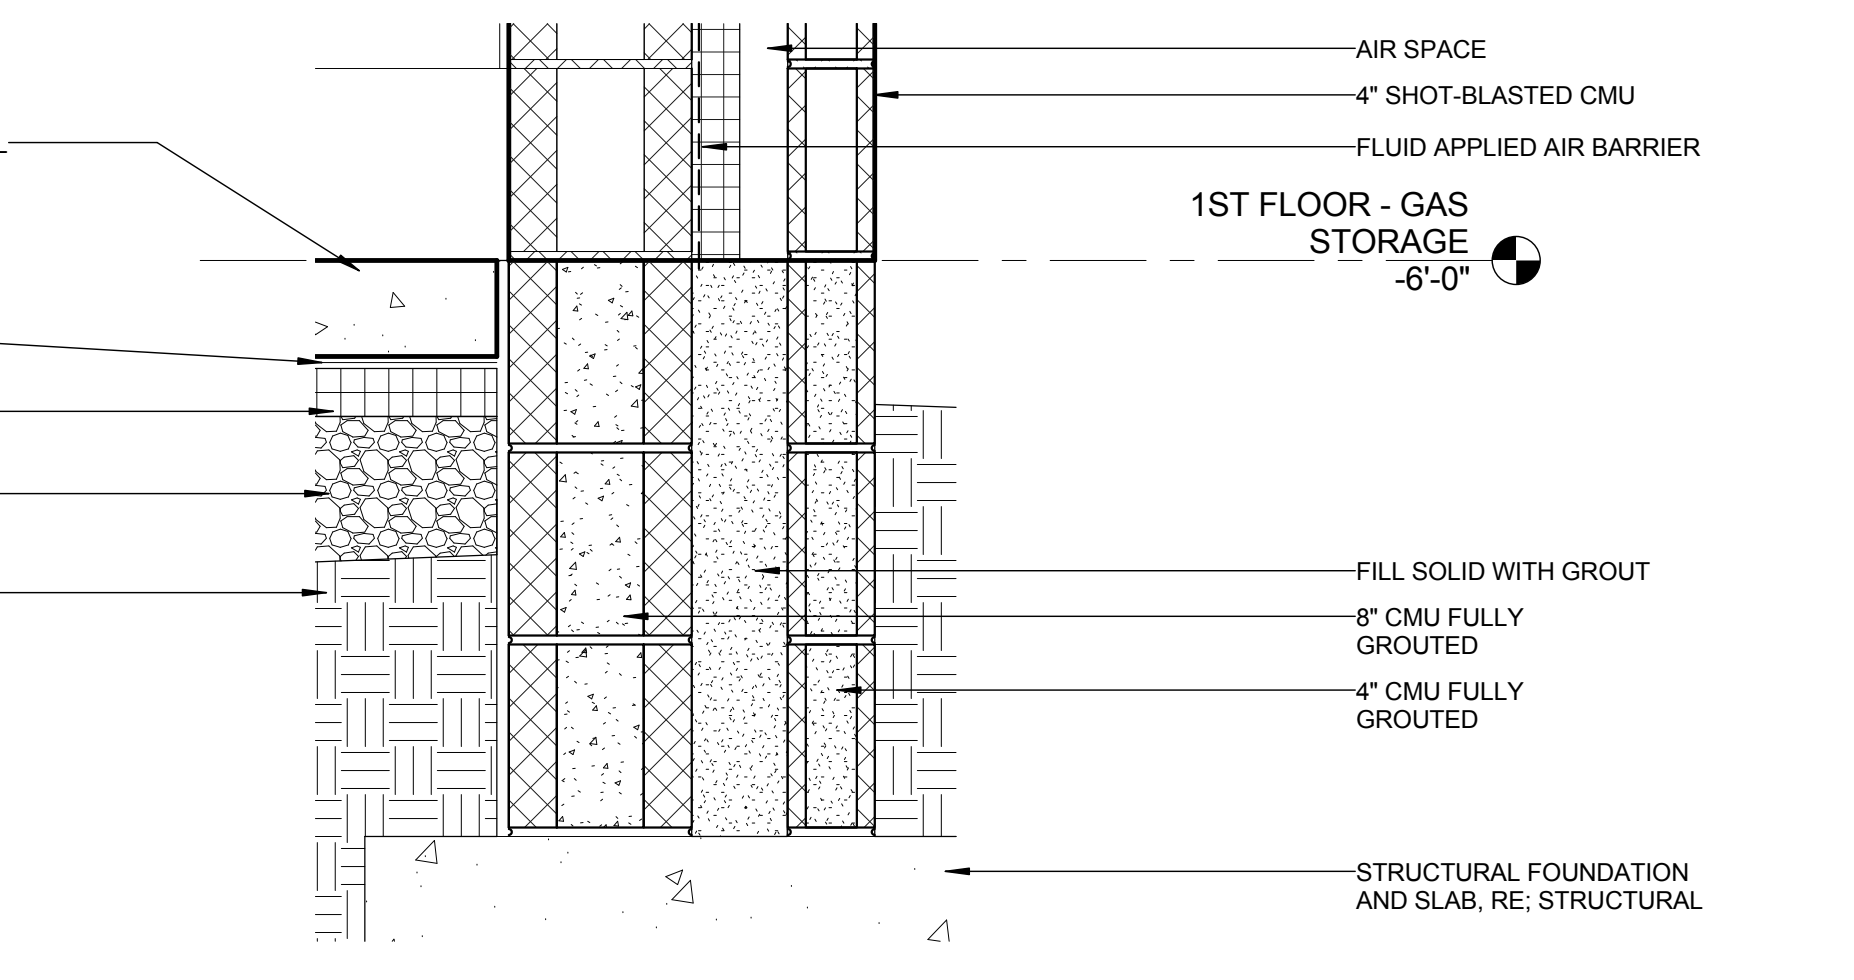


A3 SECTION-GAS STORAGE WALL
1 1/2" = 1'-0"

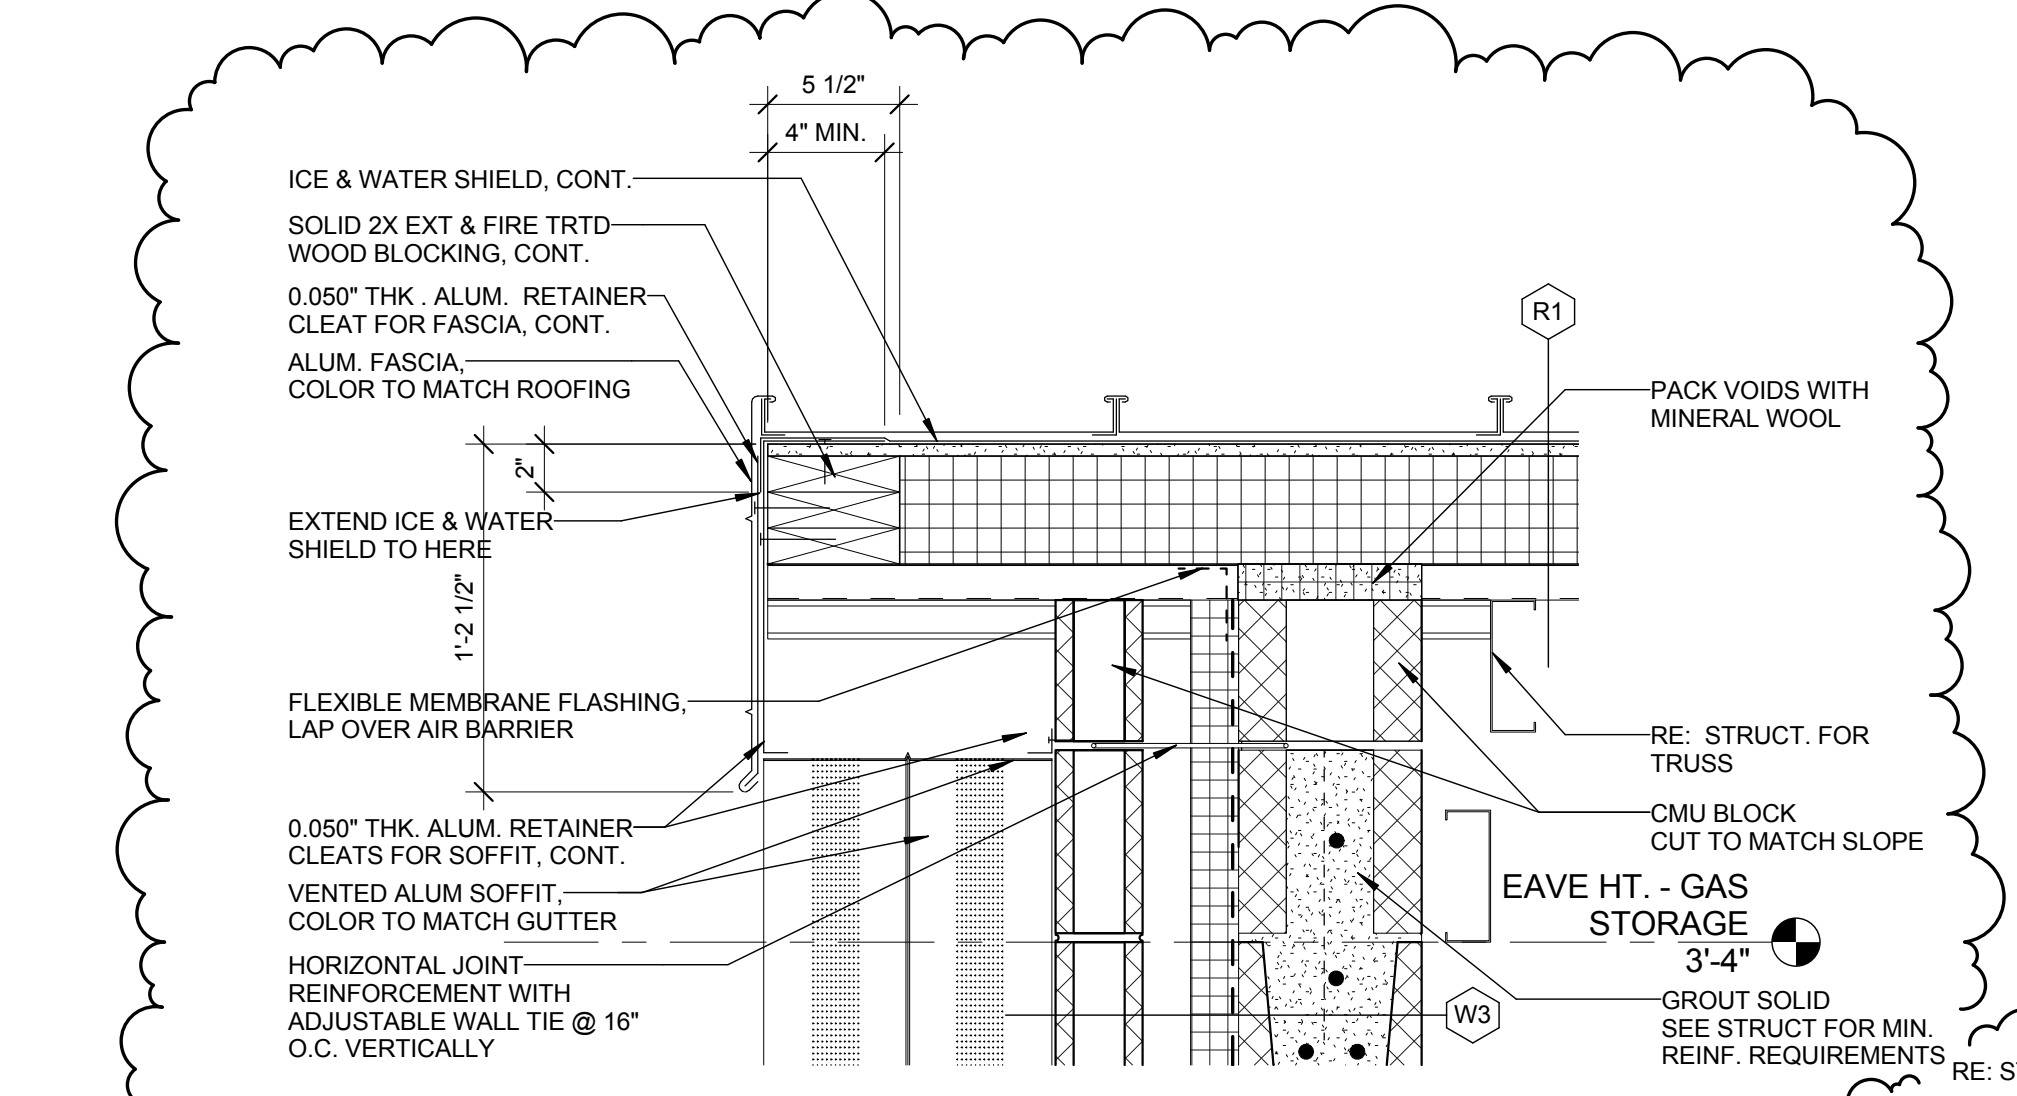

E2 SECTION DETAIL - GAS STORAGE AT GABLE END
1 1/2" = 1'-0"

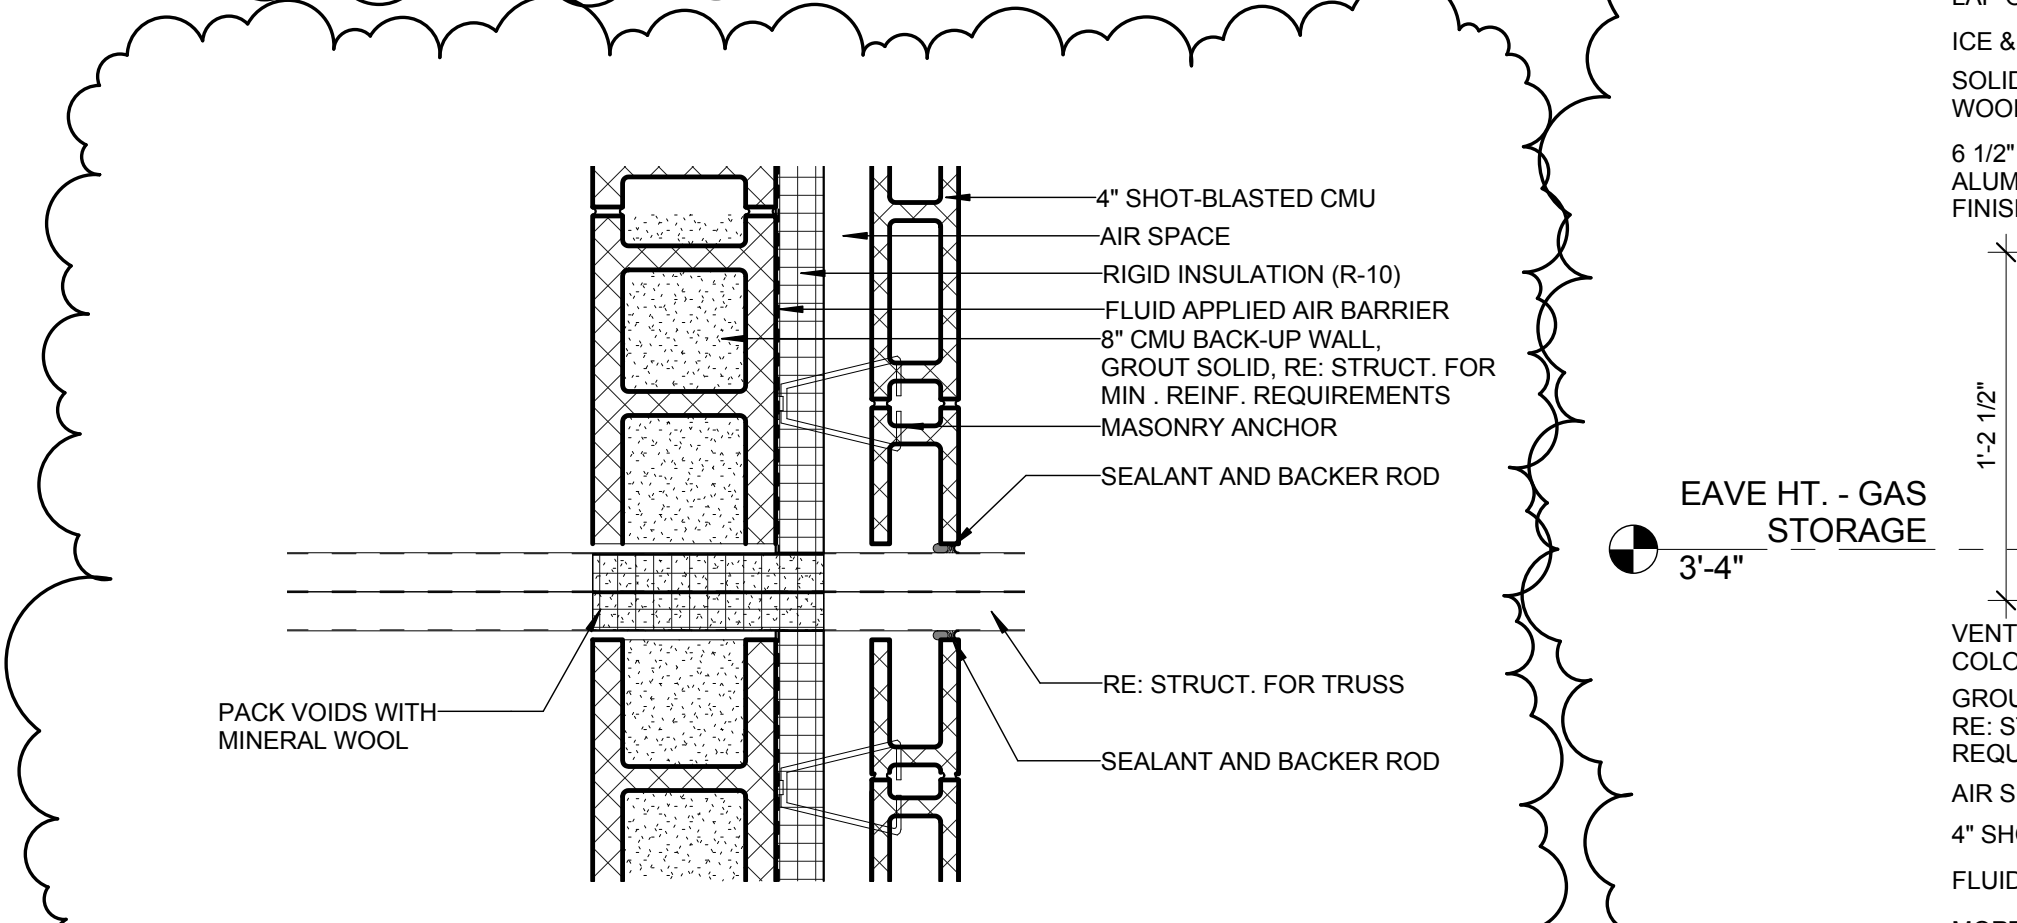

D2 PLAN DETAIL - GAS STORAGE
1 1/2" = 1'-0"

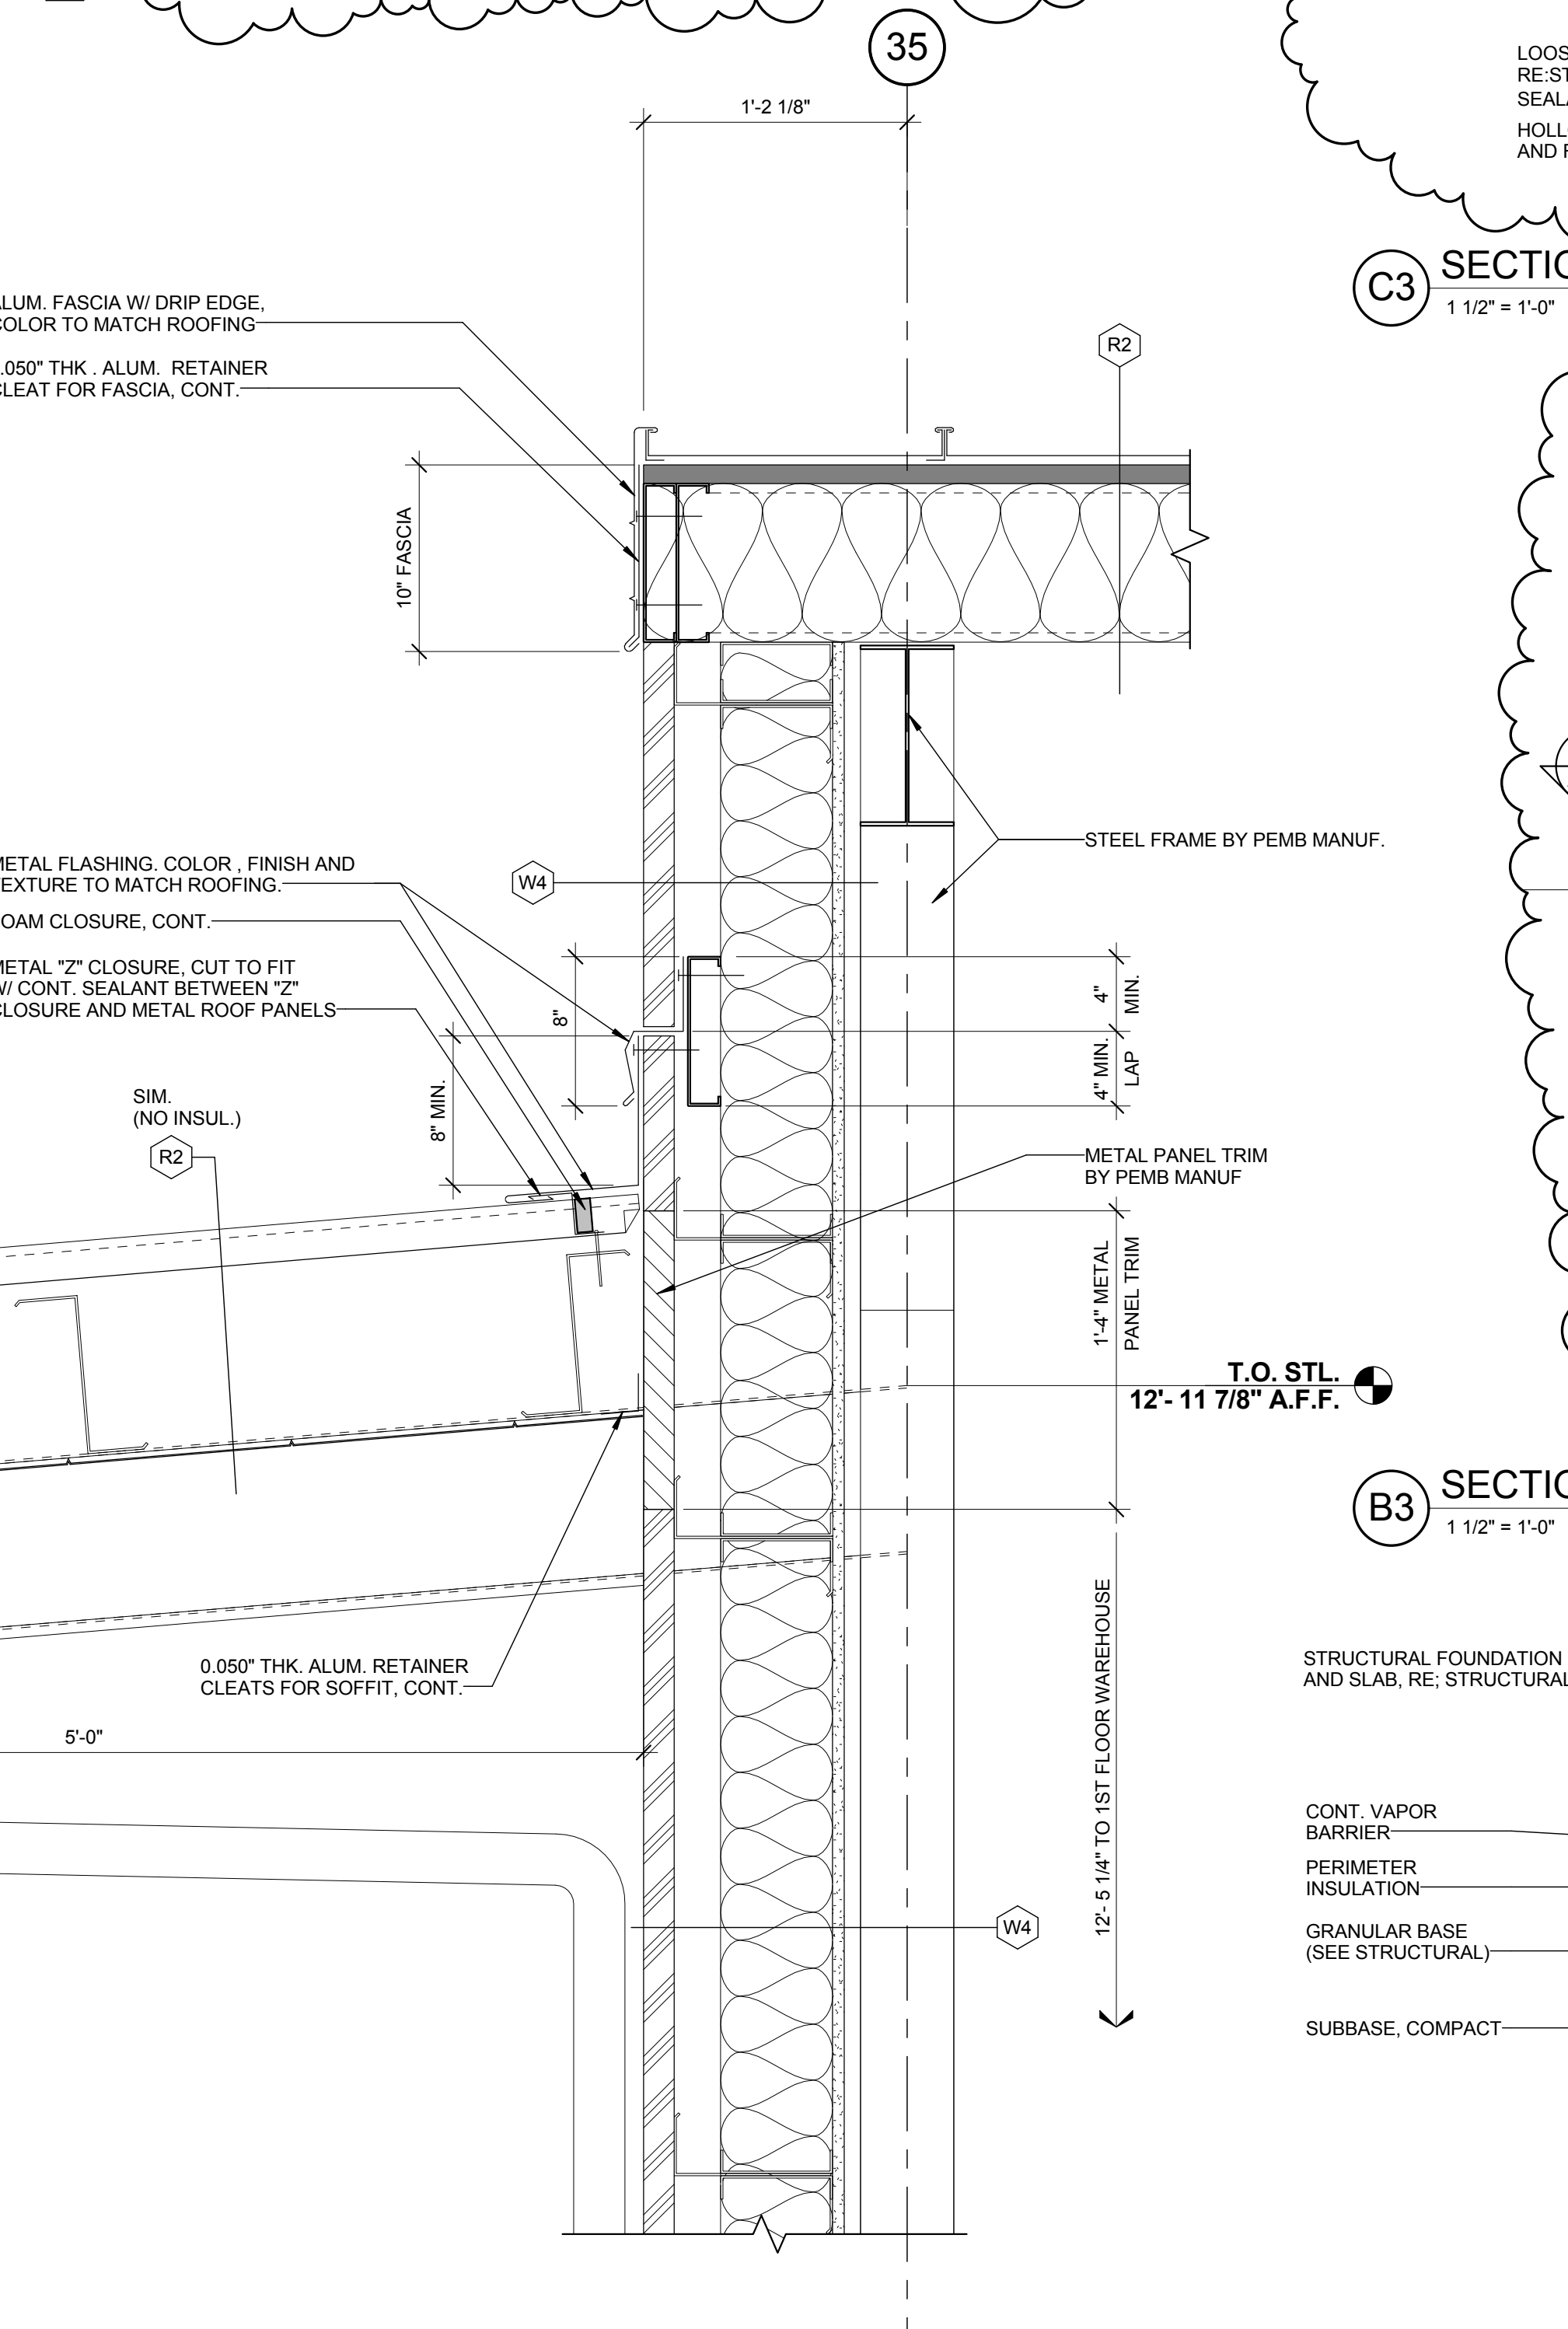

A1 SECTION - WAREHOUSE CANOPY
1 1/2" = 1'-0"

E
D
C
B
A

C:\Users\sharone\Documents\Acad\UNCC Facilities Operations Complex_2016_sharone\dwg\8/30/2017 7:59:46 AM

1 2 3 4 5



MEMBERS OF THE AMERICAN INSTITUTE OF ARCHITECTS

COPYRIGHT 2017 ALL RIGHTS RESERVED
PRINTED OR ELECTRONIC DRAWINGS AND DOCUMENTATION MAY NOT BE REPRODUCED IN ANY FORM WITHOUT WRITTEN PERMISSION FROM LS3P ASSOCIATES LTD.


REVISIONS:

No.	Description	Date
1	Addendum No. 4	08/28/2017


PROJECT: 9202-164730
SCO ID: 16-15656-02B
ITEM: 315 CODE: 41526
DATE: AUGUST 21, 2017
DRAWN BY: KF
CHECKED BY: SH

ROOF DETAILS


A-551

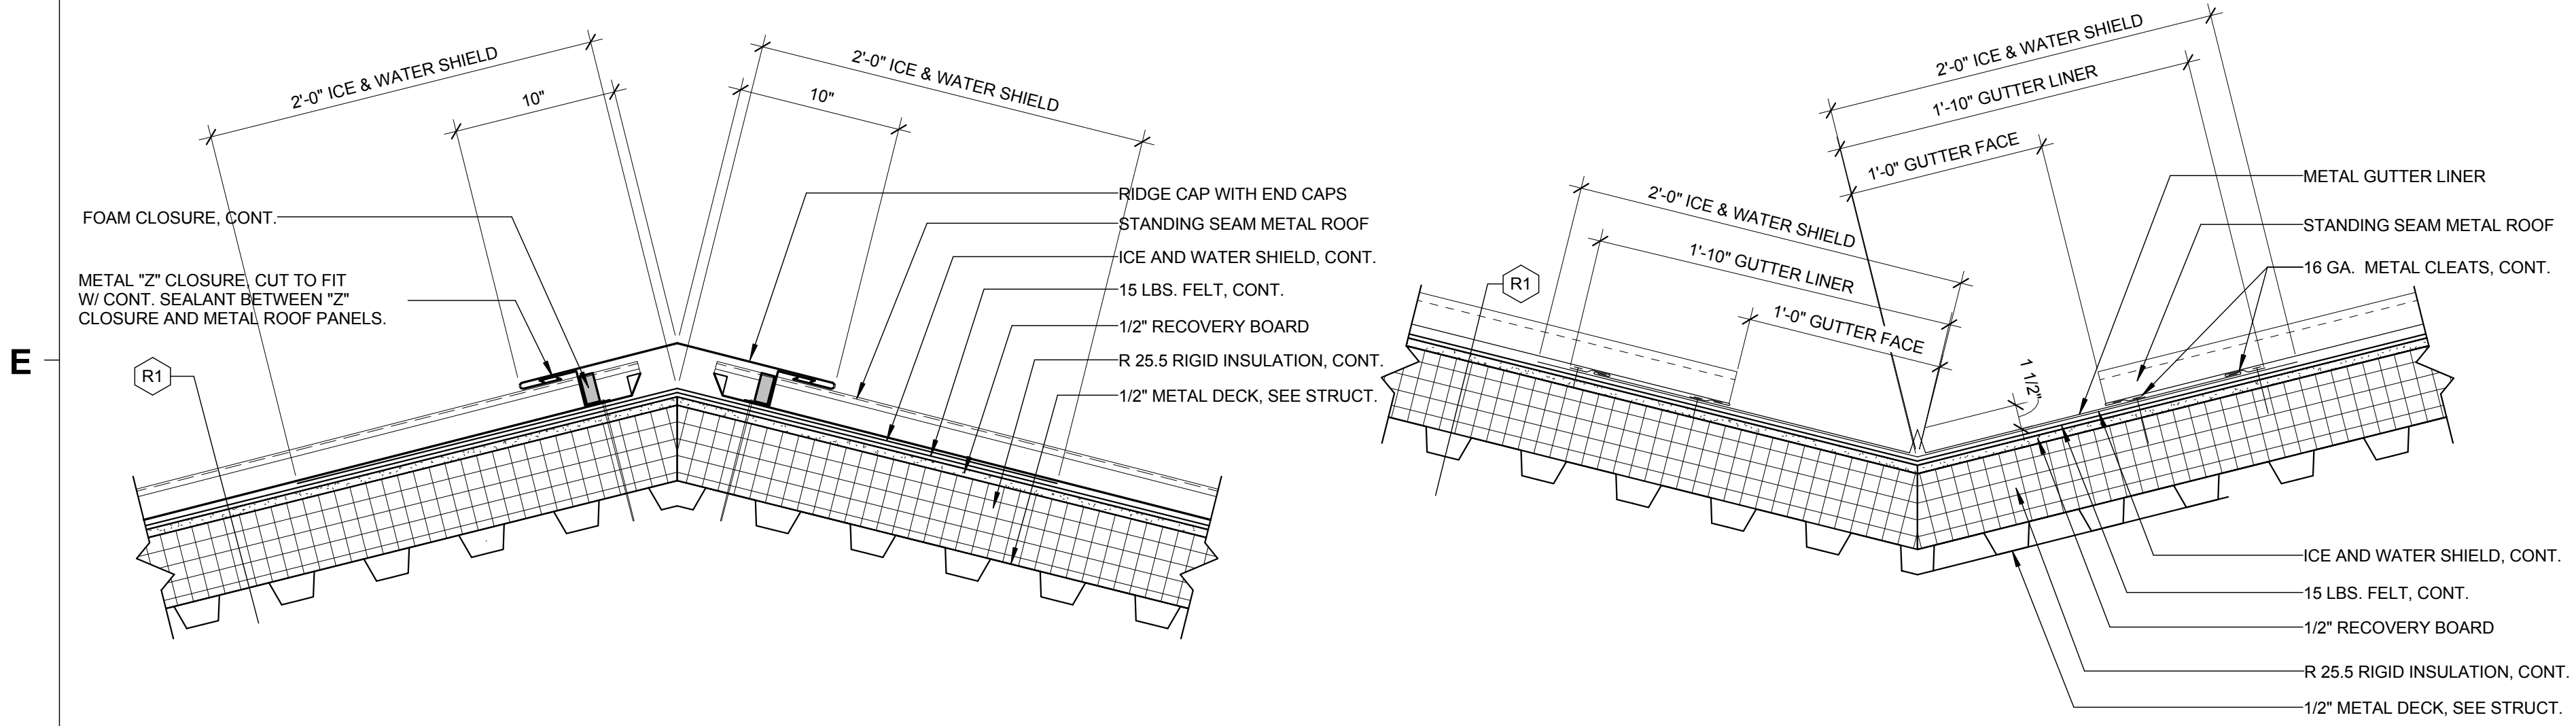

E1 SECTION - TYPICAL RIDGE DETAIL
1 1/2" = 1'-0"

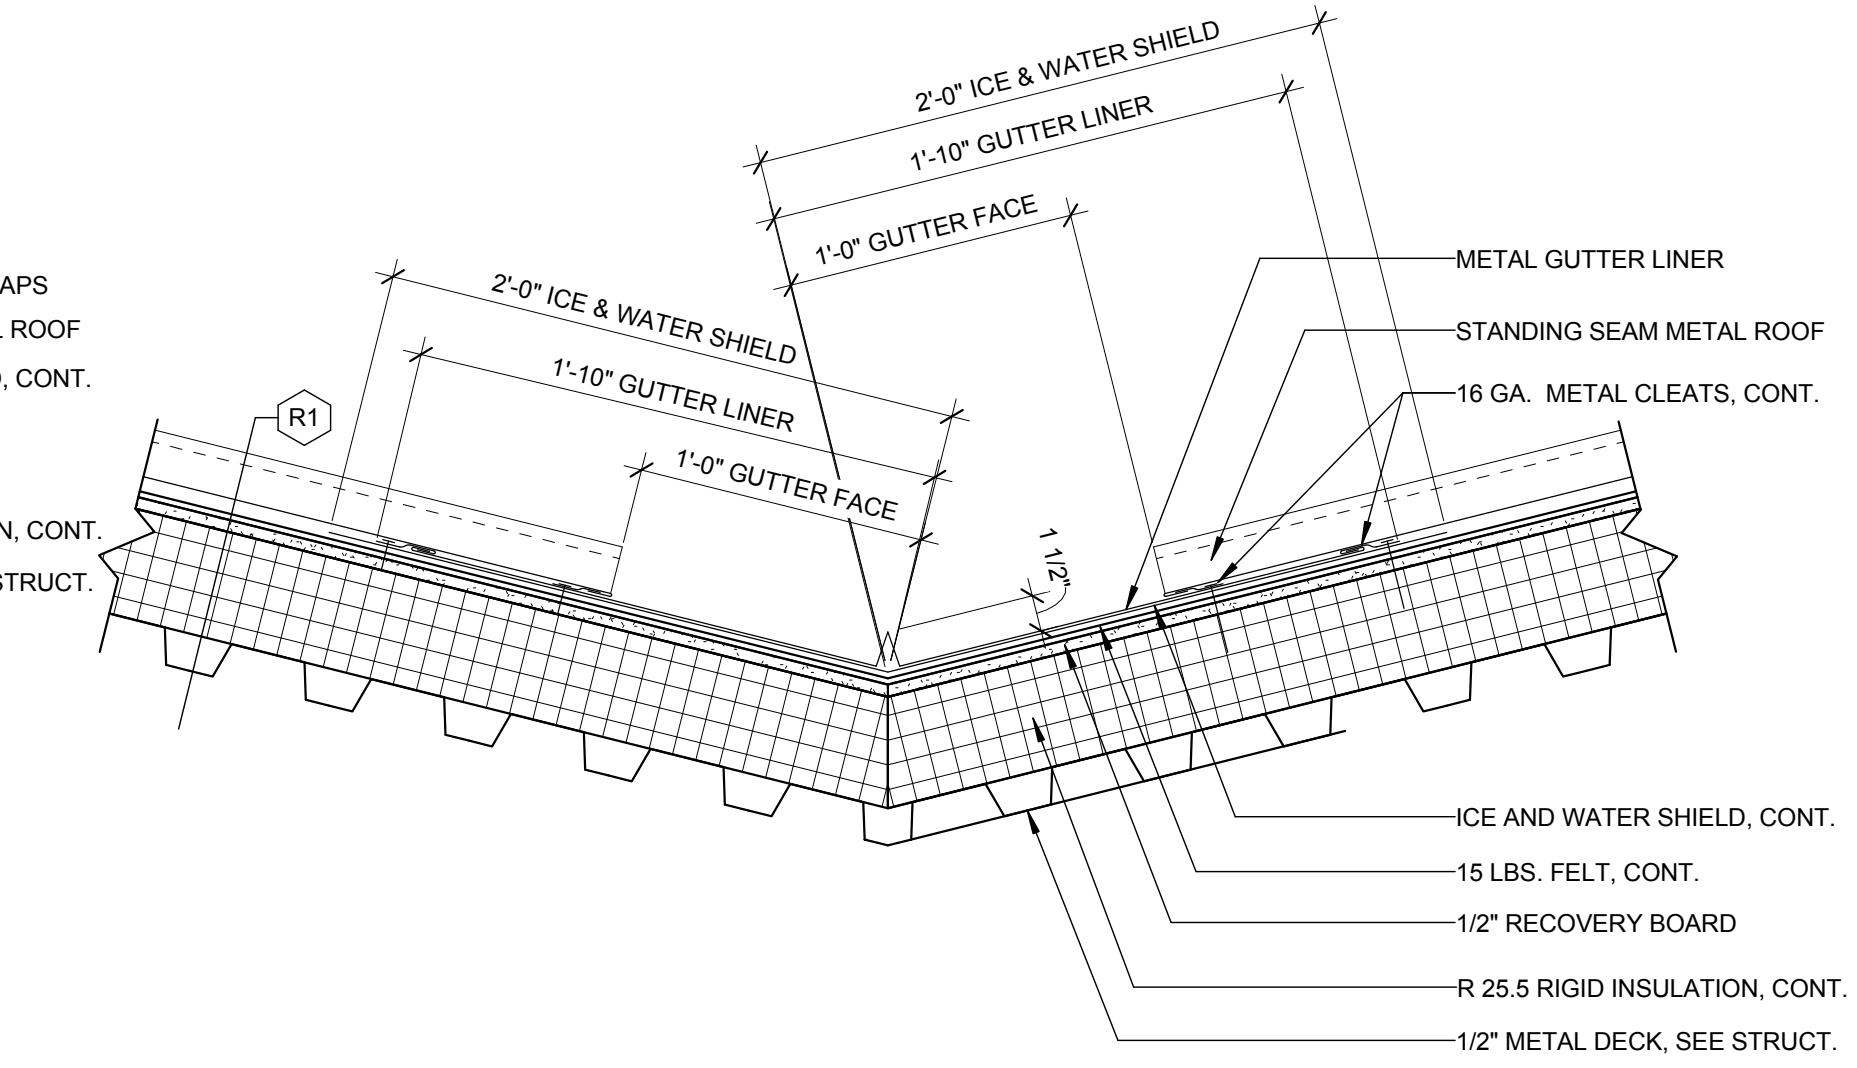


E2 SECTION - TYPICAL VALLEY DETAIL
1 1/2" = 1'-0"

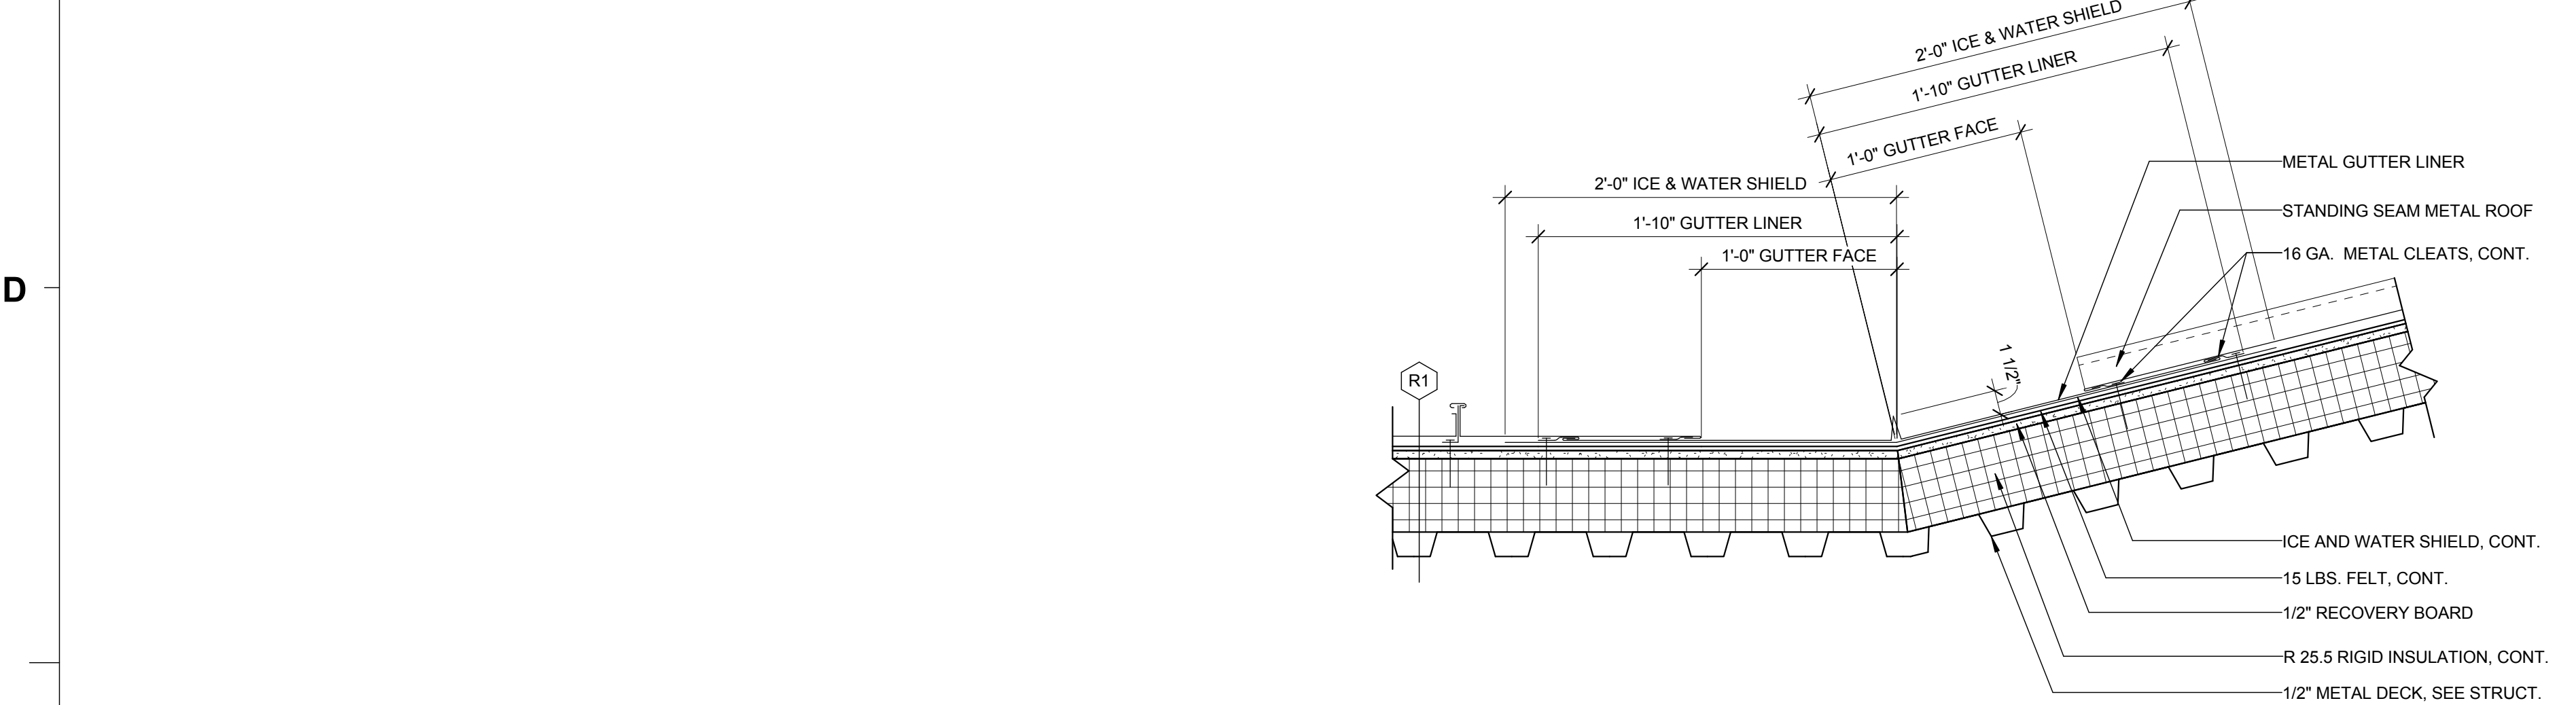


D2 SECTION - VALLEY DETAIL AT RIDGE
1 1/2" = 1'-0"




D4 SECTION - ROOF, EAVE ALONG GABLE END
1 1/2" = 1'-0"

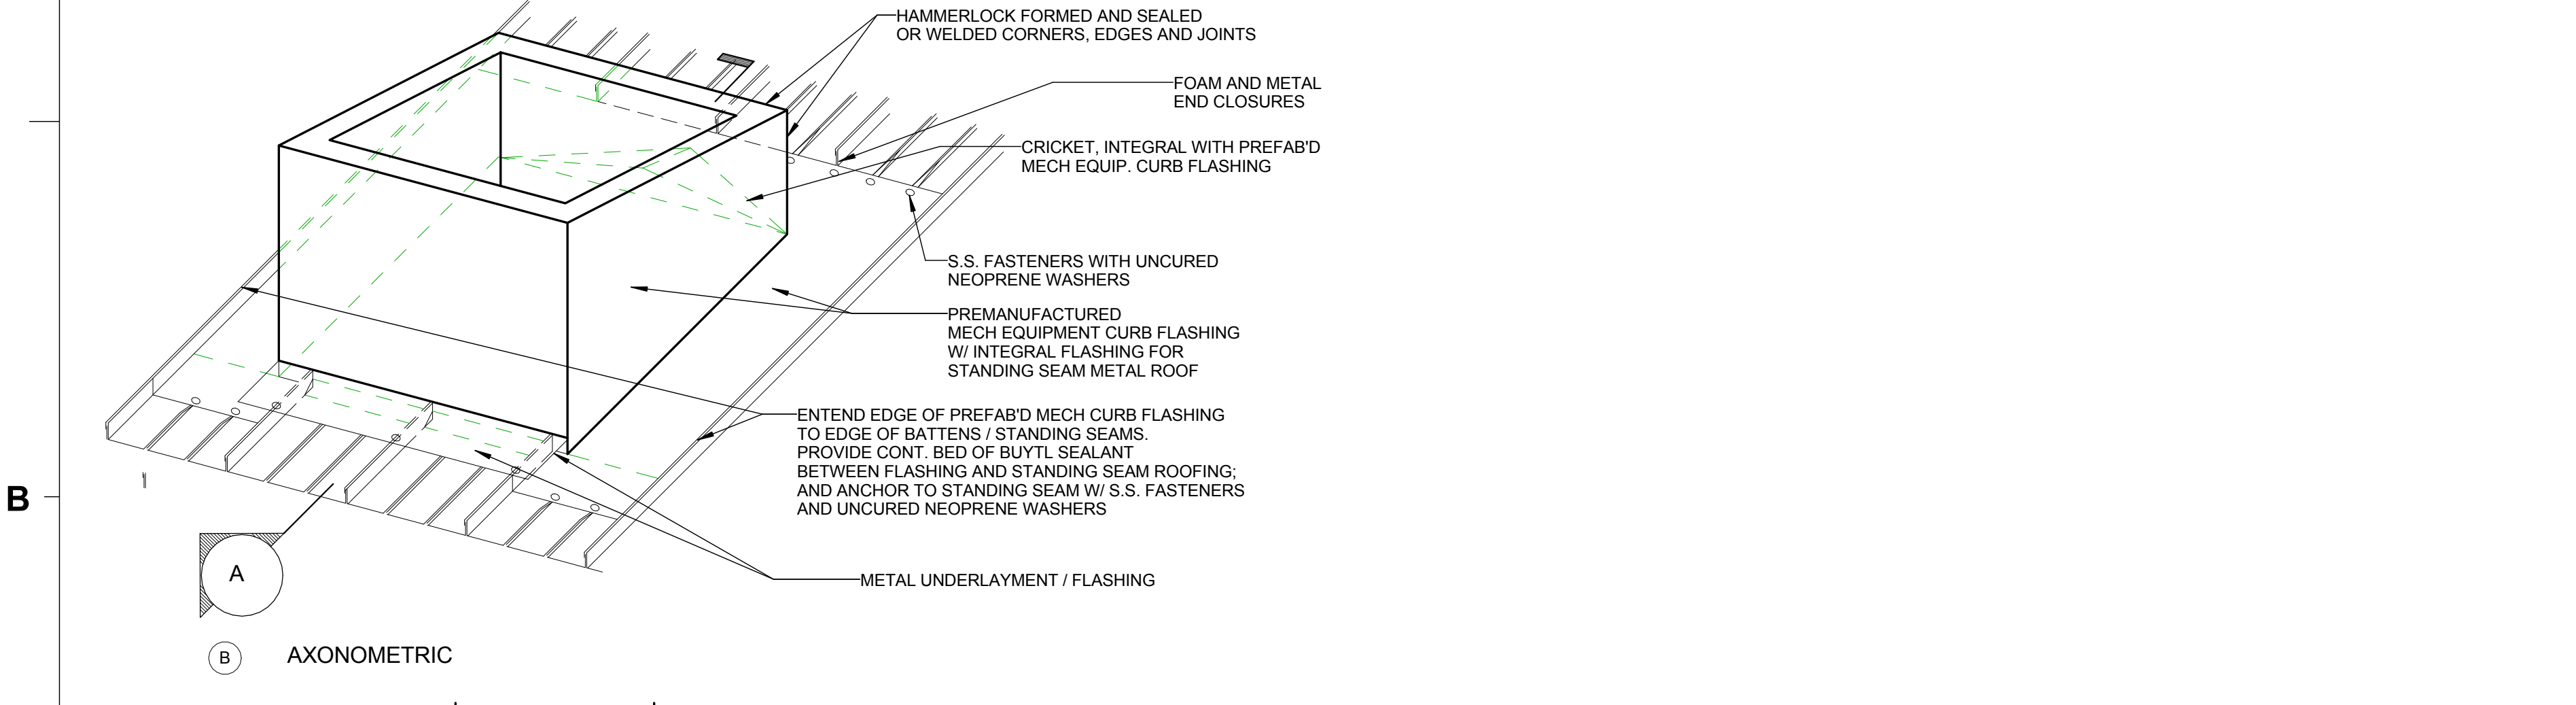


A1 EQUIPMENT CURB DETAIL
NTS

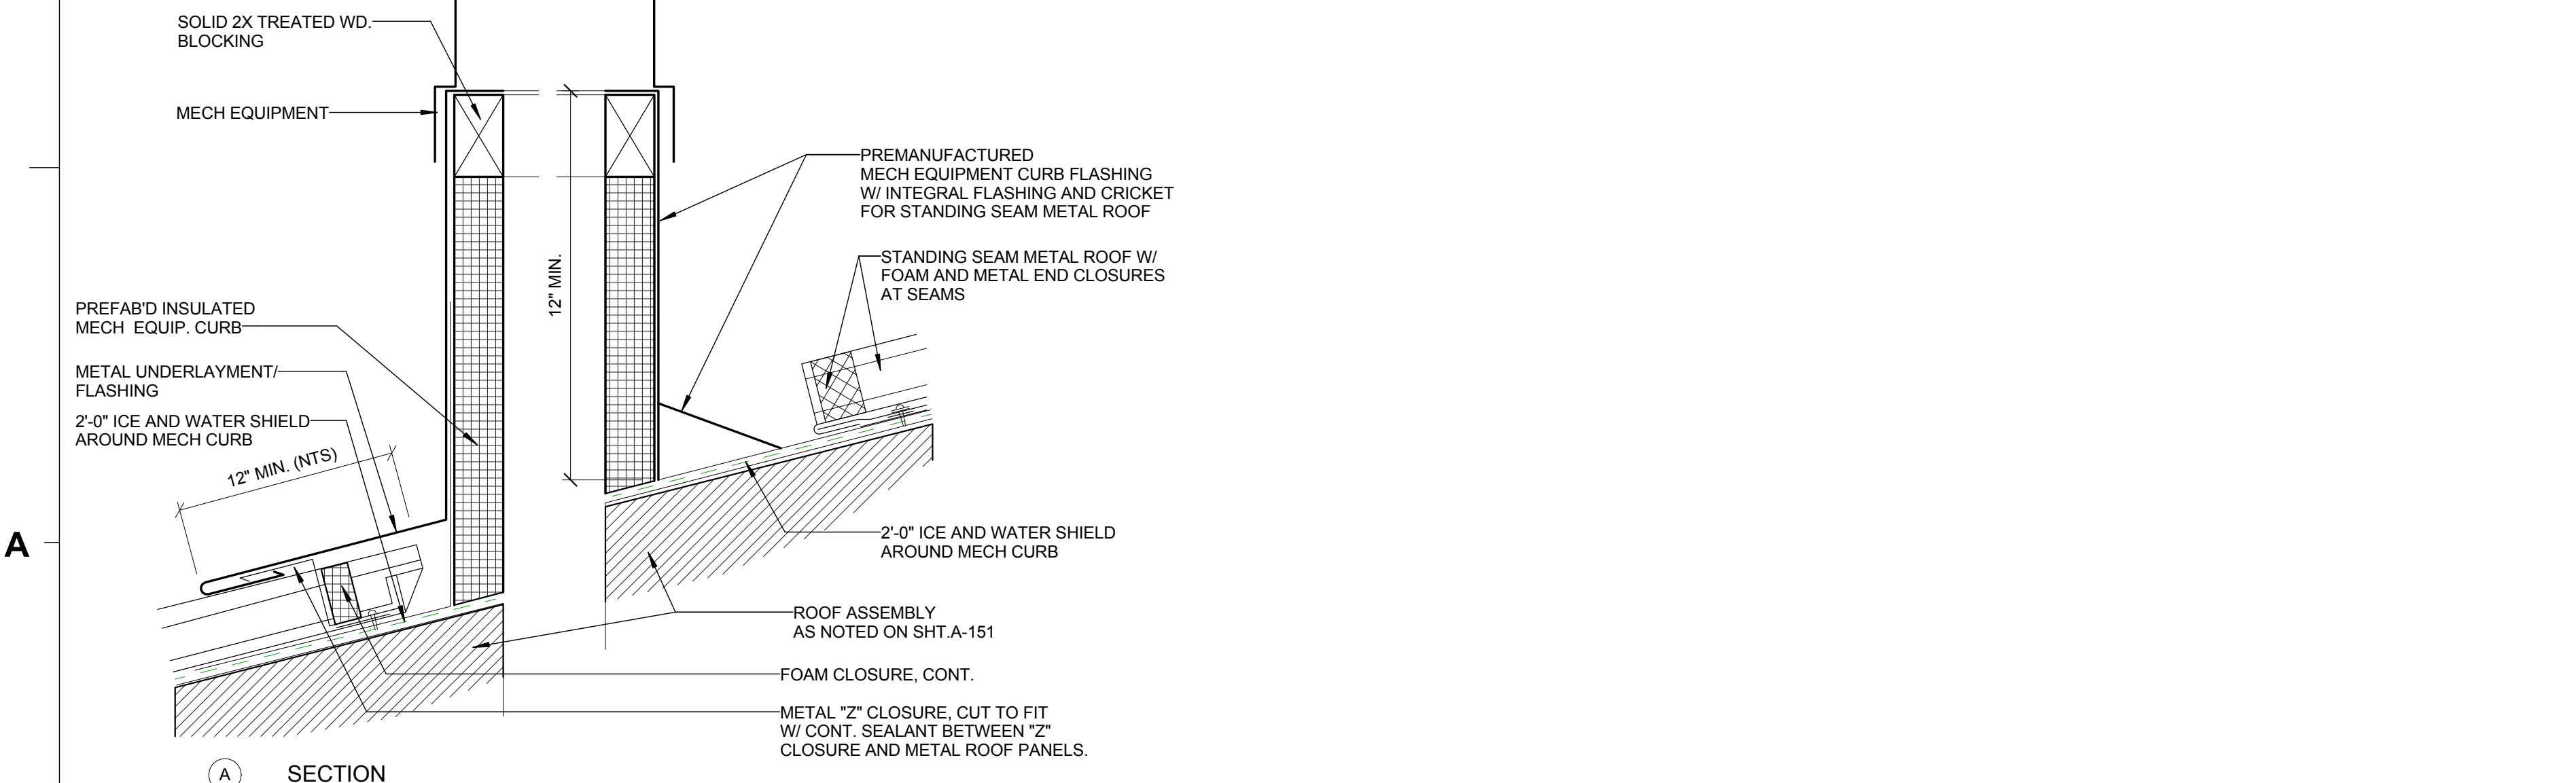


A4 DETAIL - ROOF VENT FLASHING
3" = 1'-0"

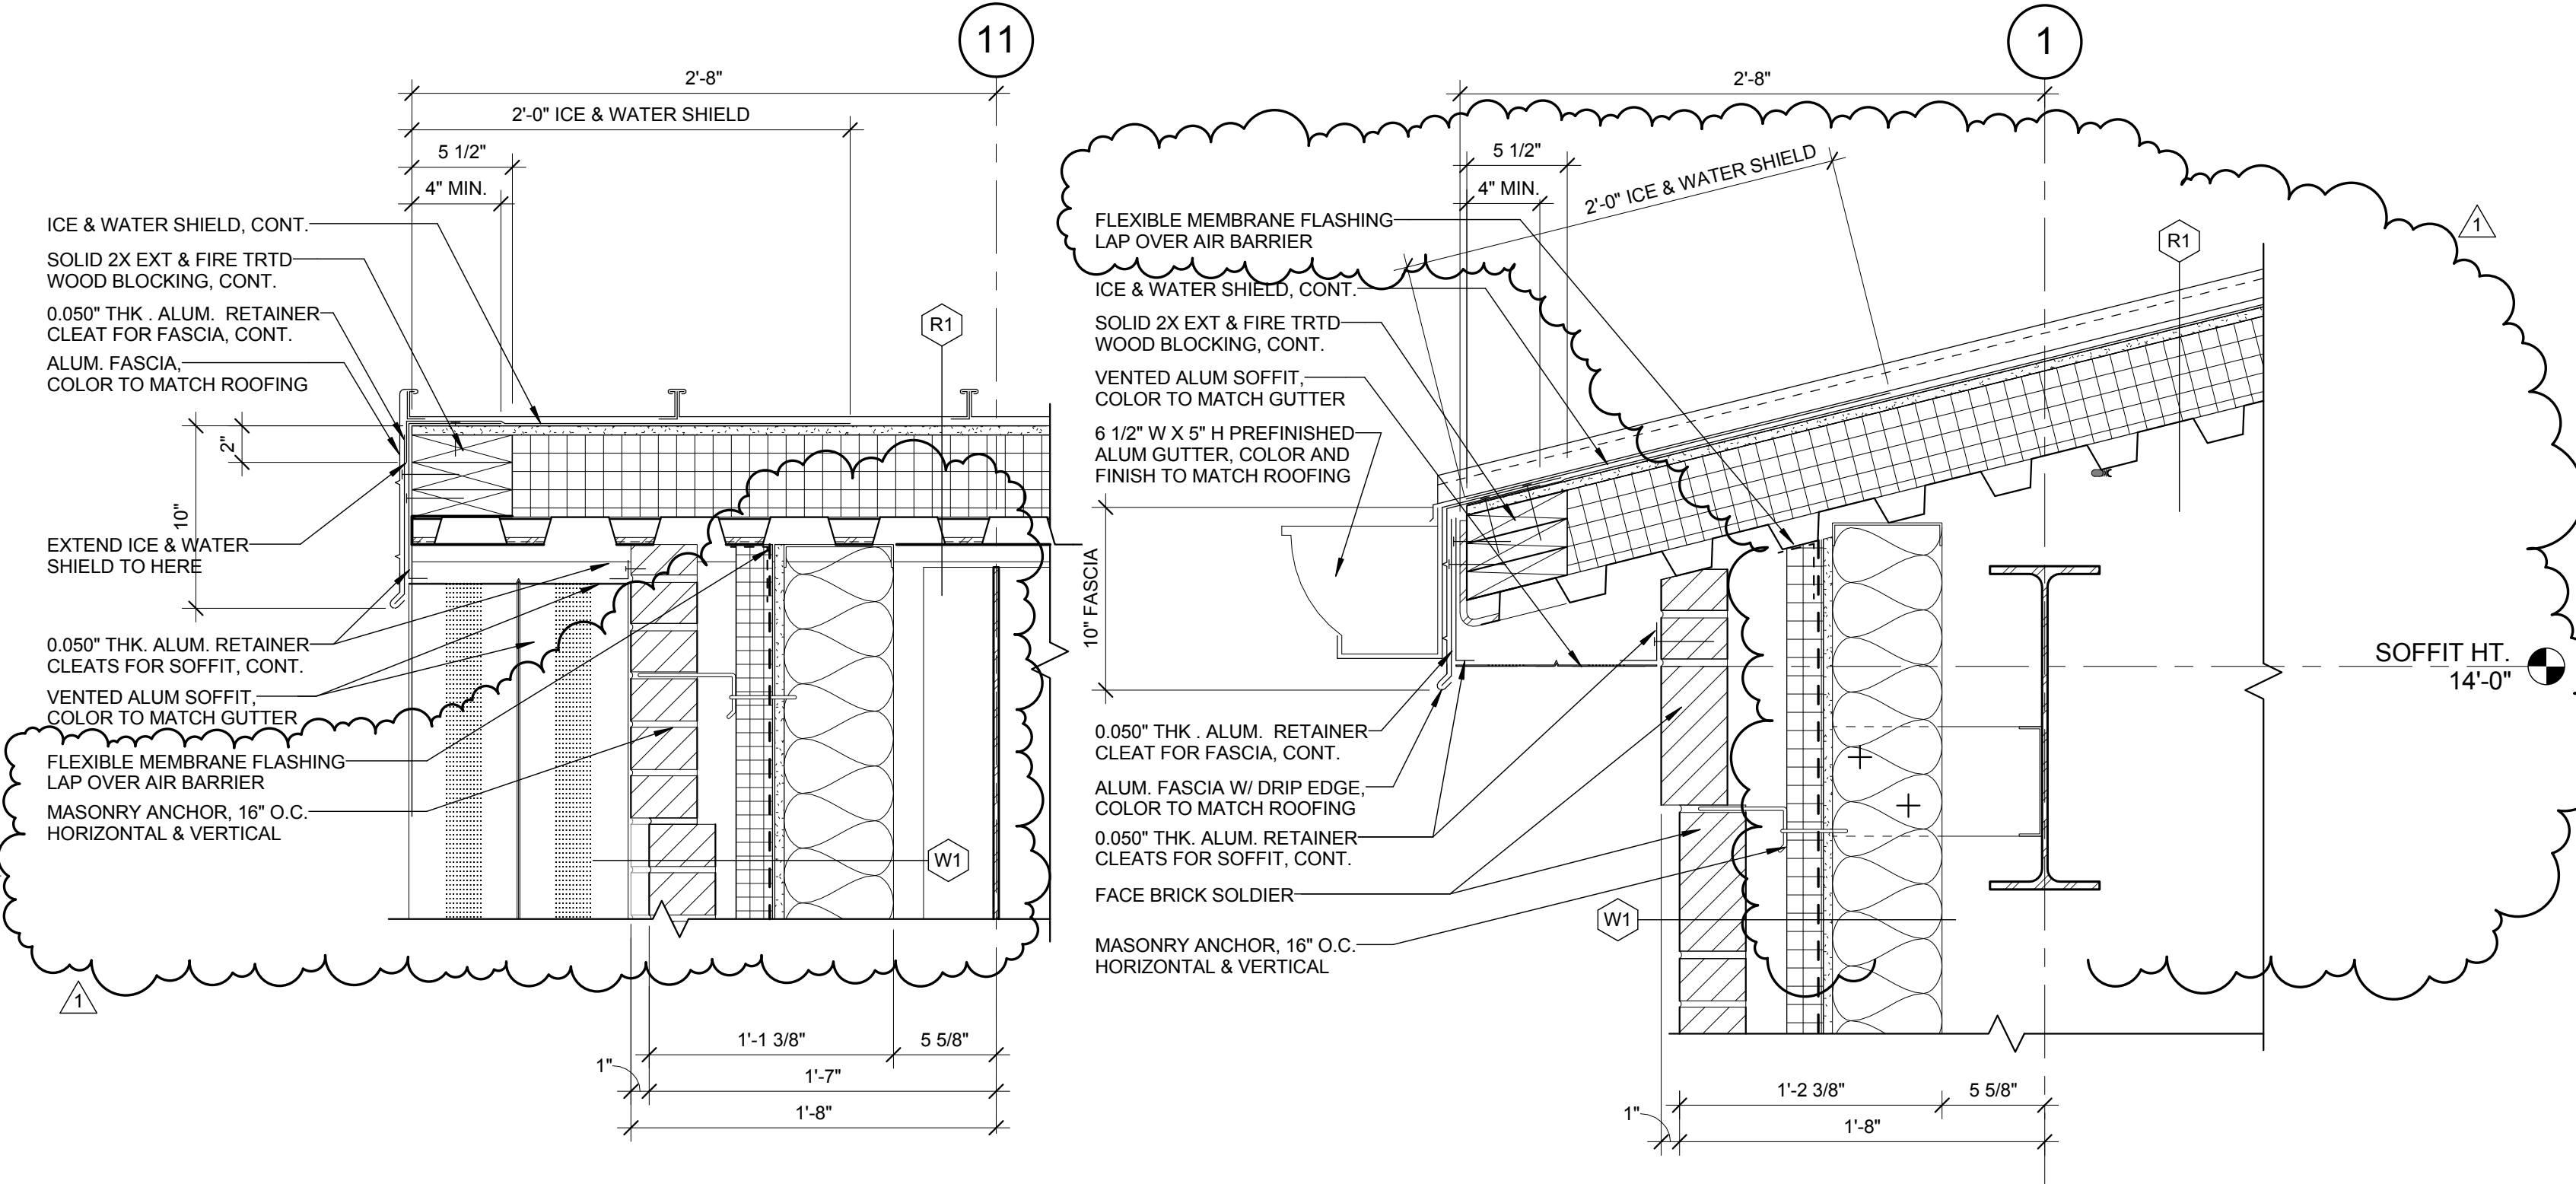


D5 SECTION - TYPICAL ROOF EAVE AT GUTTER
1 1/2" = 1'-0"

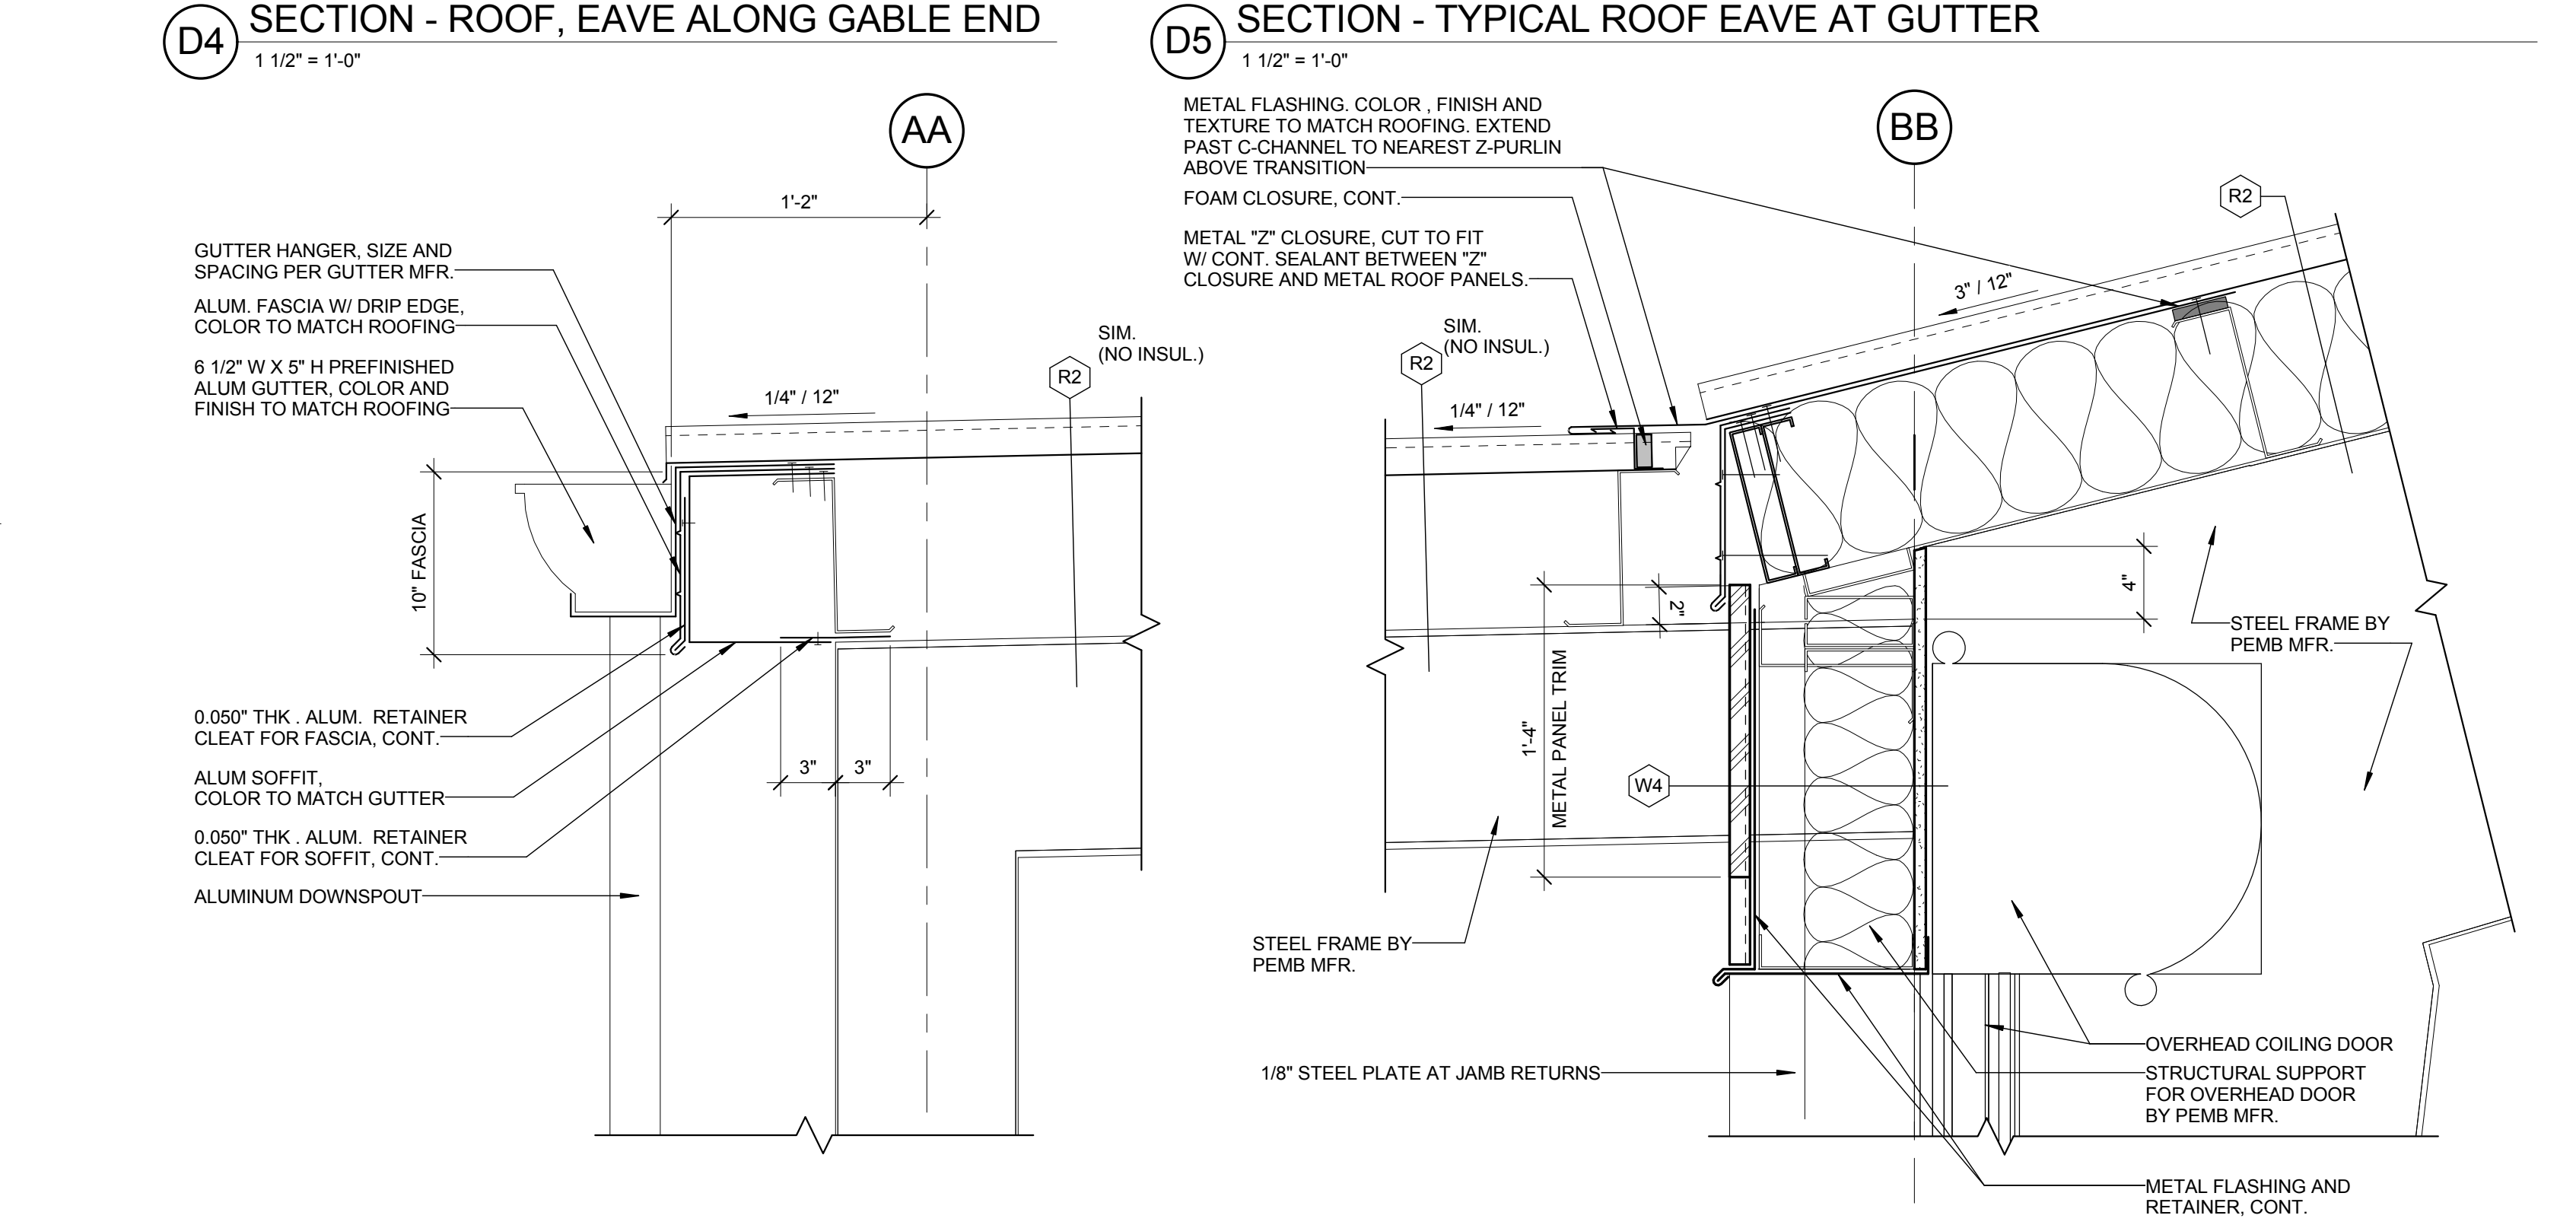

C4 SECTION - EAVE AT LOADING DOCK
1 1/2" = 1'-0"

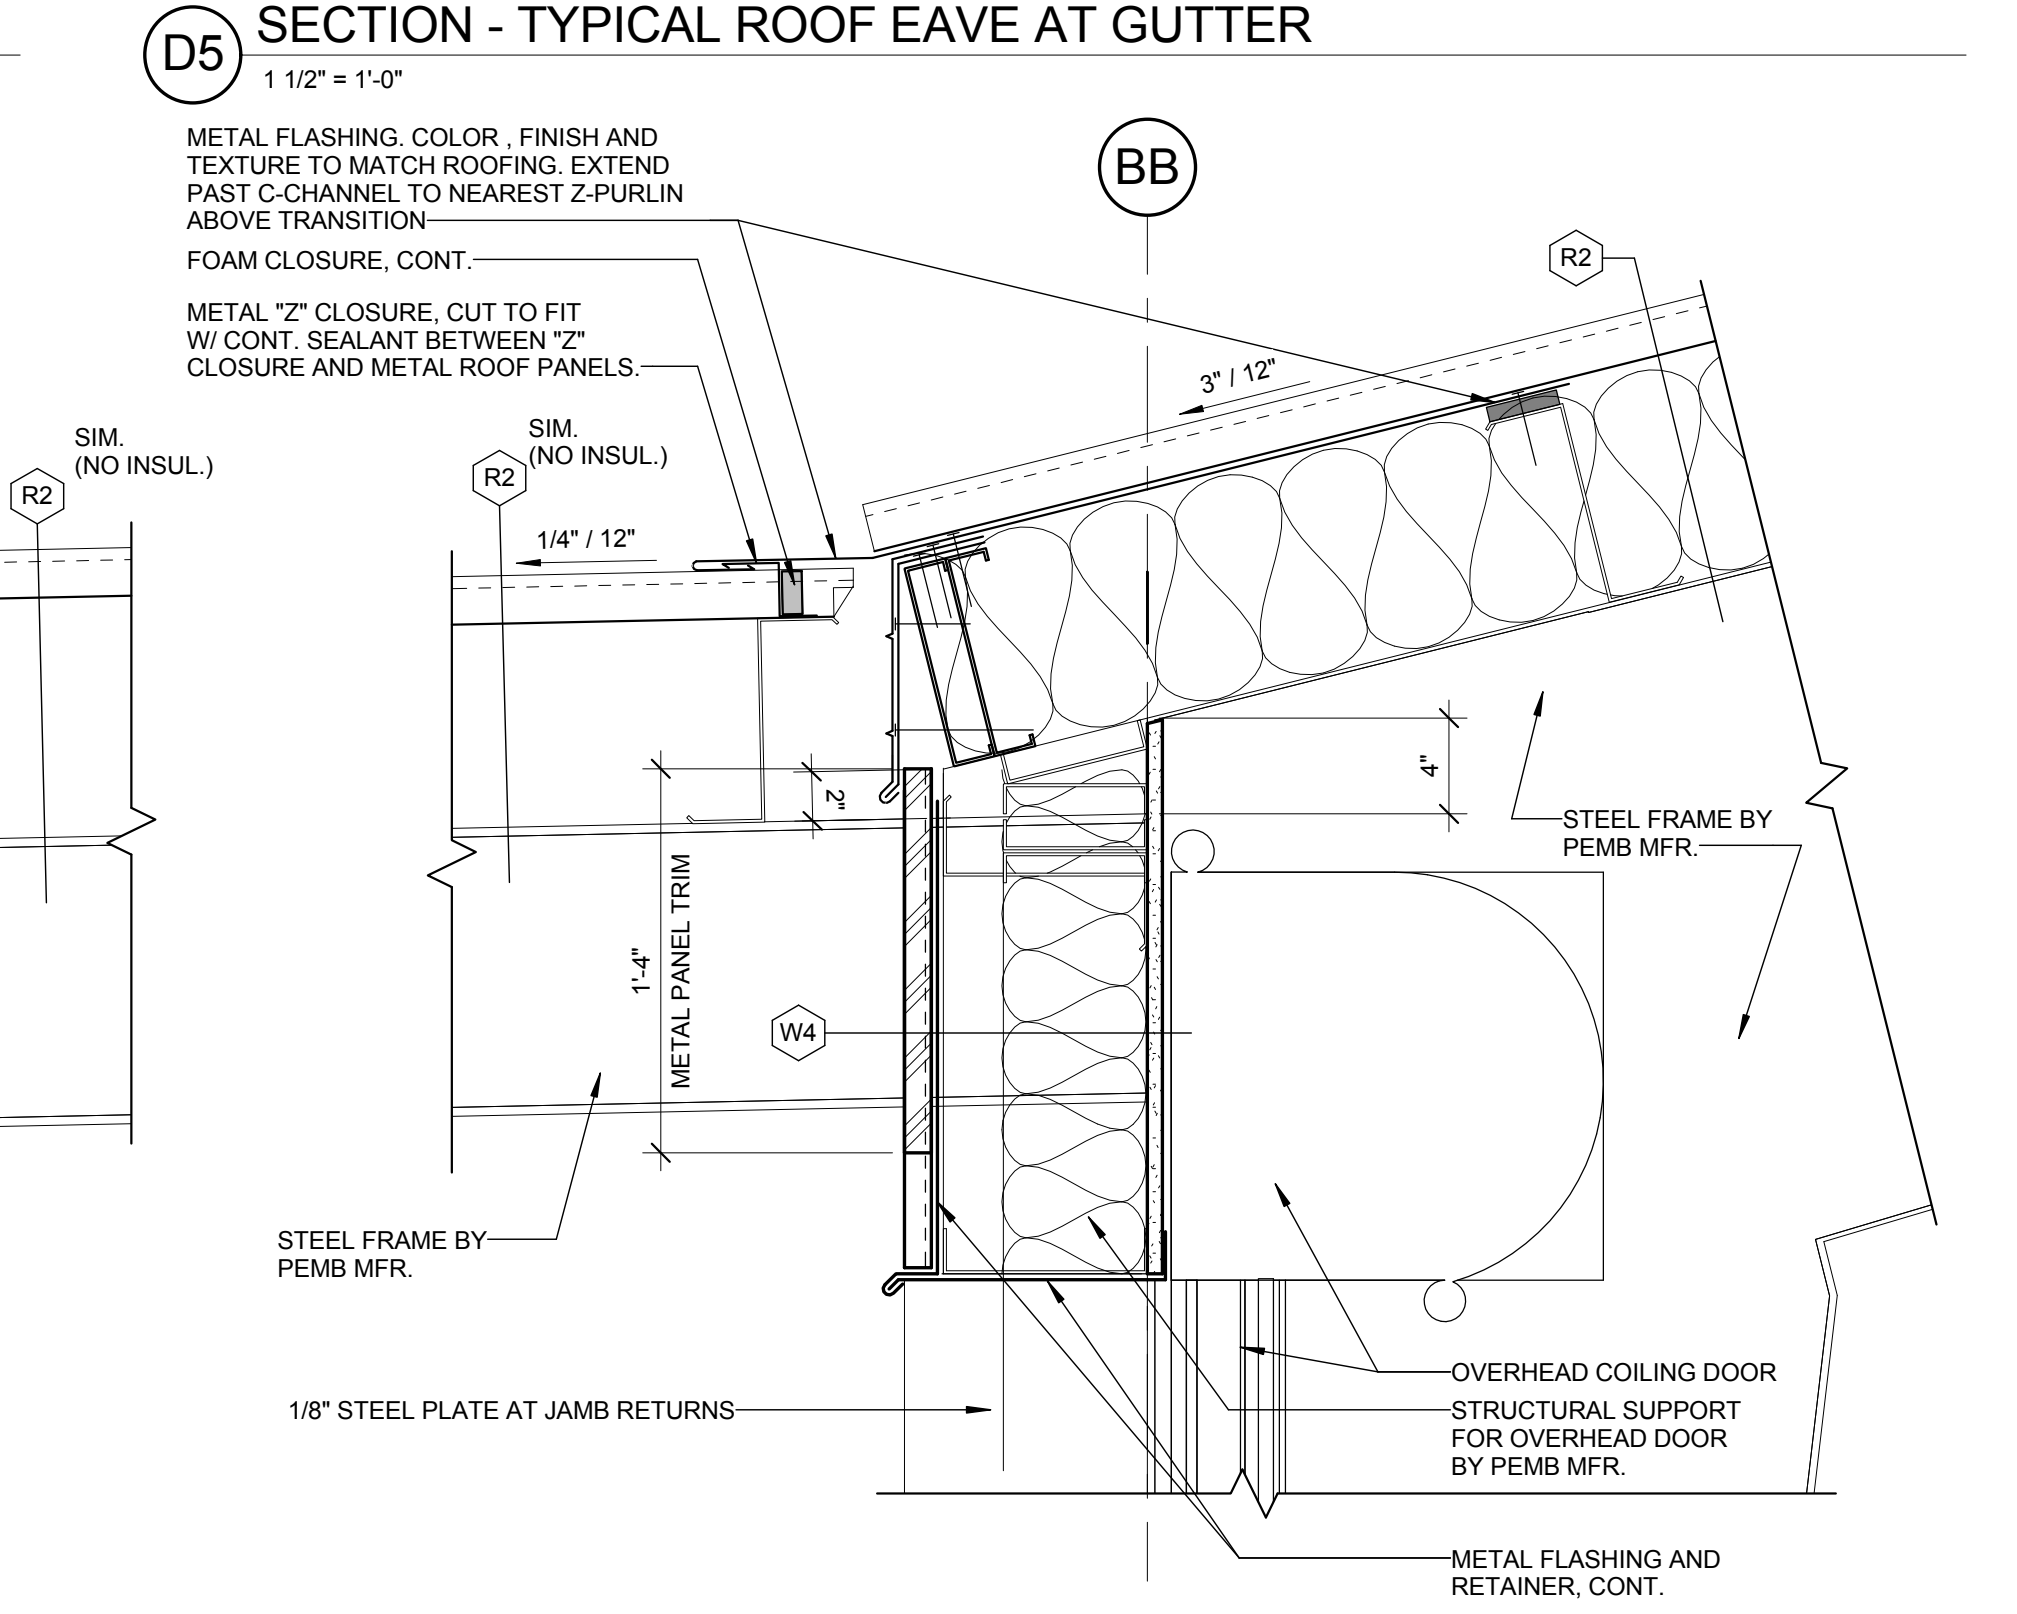


C5 SECTION - ROOF TRANSITION AT LOADING DOCK
1 1/2" = 1'-0"

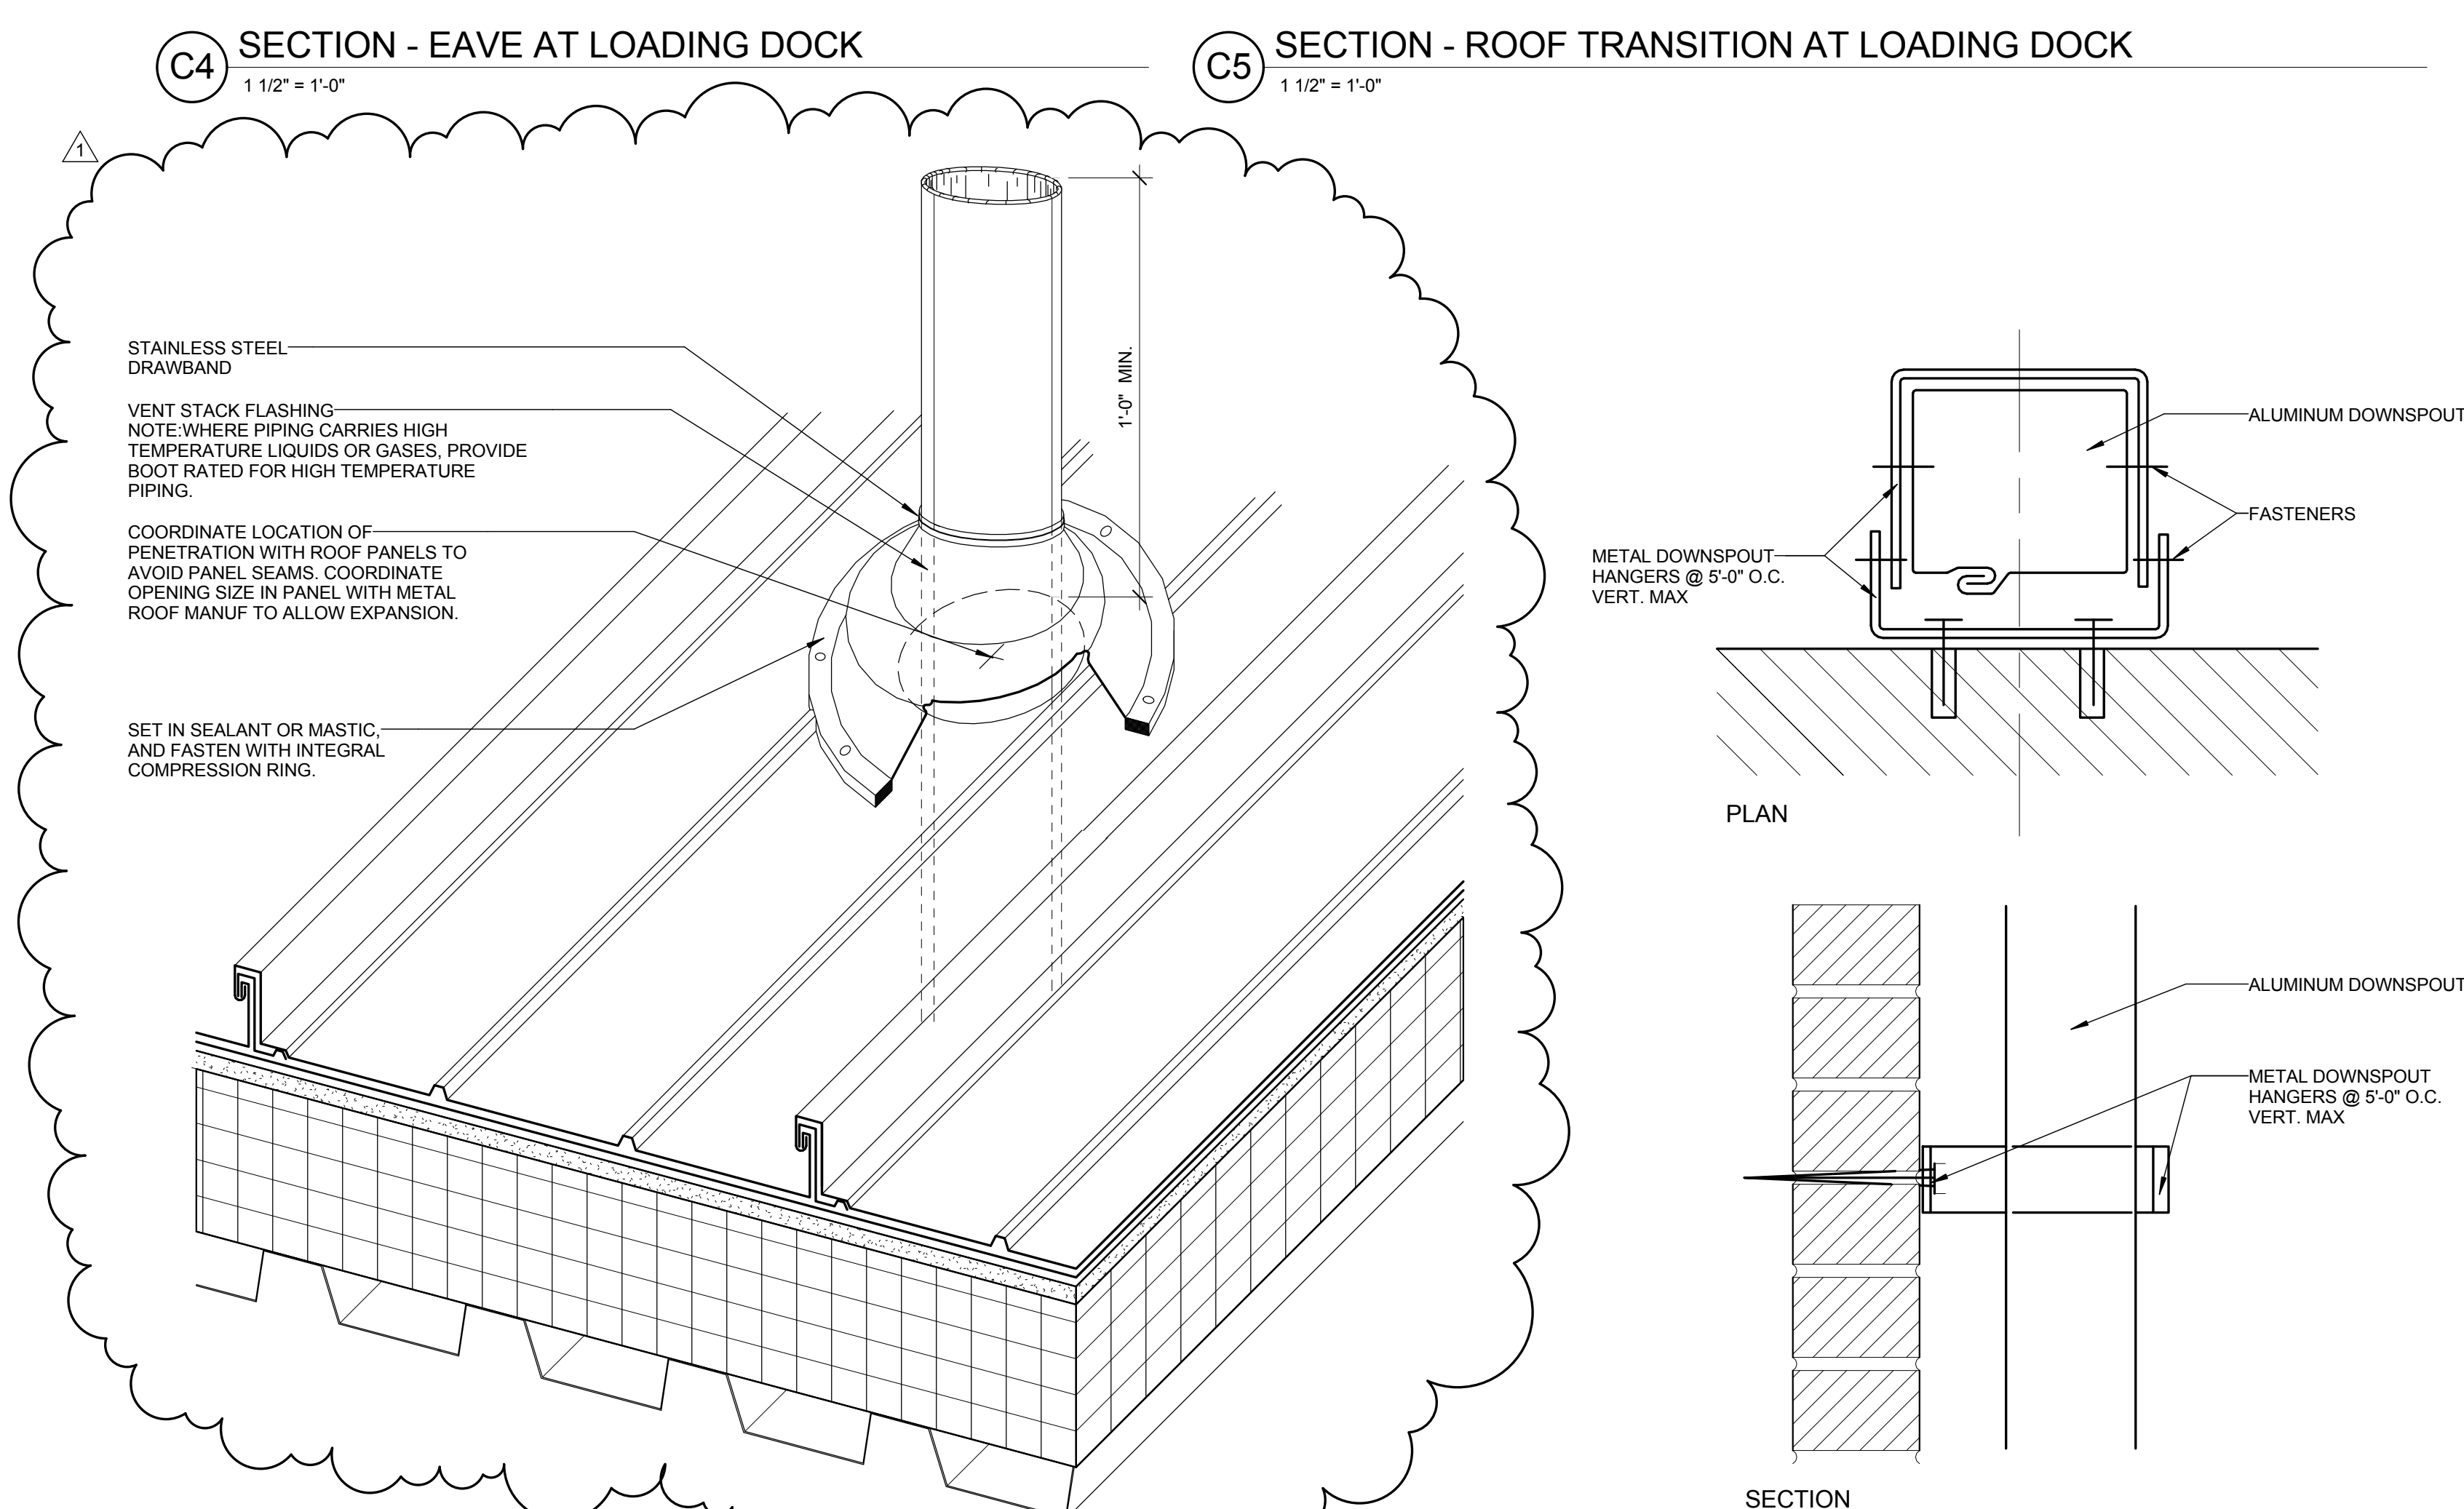

A6 PLAN & SECTION - DOWNSPOUT DETAIL
3" = 1'-0"

C:\Users\sharohud\Documents\A001_UNCC Facilities Operations Complex_2016_sharohud.rvt 8/30/2017 7:59:57 AM

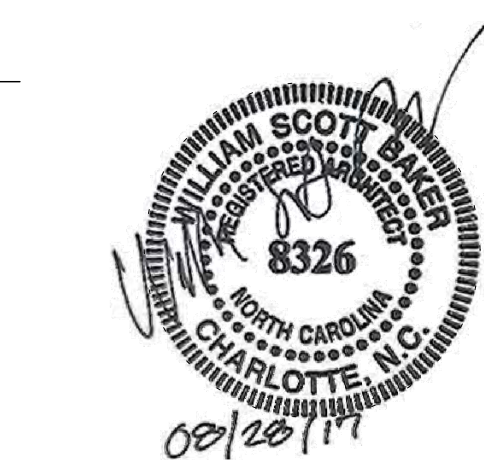

MEMBERS OF THE AMERICAN INSTITUTE OF ARCHITECTS

COPYRIGHT 2017 ALL RIGHTS RESERVED PRINTED OR ELECTRONIC DRAWINGS AND DOCUMENTATION MAY NOT BE REPRODUCED IN ANY FORM WITHOUT WRITTEN PERMISSION FROM LS3P ASSOCIATES LTD.

REVISIONS:

No.	Description	Date
1	Addendum No. 4	08/28/2017

PROJECT: 9202-164730
SCO ID: 16-15656-025
ITEM: 315 CODE: 41526
DATE: AUGUST 21, 2017
DRAWN BY: SH
CHECKED BY: SH

DOOR SCHEDULE & DOOR TYPES

A-601

DOOR AND FRAME SCHEDULE - OFFICE/SHOPS BUILDING																
DOOR NUMBER	TYPE	MATL	DOOR					FRAME					REMARKS			
			FINISH	WIDTH	HEIGHT	THICKNESS	LABEL	STC	HDWR	TYPE	MATL	FINISH		HEAD	JAMB	SILL
100A	FG (PAIR)	AL	-	6'-0"	8'-0"	1 3/4"	-	3.0	H	AL	-	H2/A-511	J2	A1/A-511	CARD READER, AUTOMATIC OPERATOR	
100B	FG (PAIR)	AL	-	6'-0"	8'-0"	1 3/4"	-	9.0	H	AL	-	H2	J2	S5	CARD READER, AUTOMATIC OPERATOR	
101	FG	WD	ST	3'-0"	7'-0"	1 3/4"	-	10.0	F1	HM	PT	H1	J1	S5	CARD READER	
101A	N	WD	ST	3'-0"	7'-0"	1 3/4"	-	23.3	F1	HM	PT	H1	J1	NONE	CARD READER	
101B	N	WD	ST	3'-0"	7'-0"	1 3/4"	-	15.0	F1	HM	PT	H1	J1	NONE		
101C	N	WD	ST	3'-0"	7'-0"	1 3/4"	-	15.0	F1	HM	PT	H1	J1	S5		
101D	F	WD	ST	3'-0"	7'-0"	1 3/4"	-	13.0	F1	HM	PT	H1	J1	NONE		
102A	-	-	-	4'-0"	7'-0"	0"	-	-	-	F1	HM	PT	H1	J1	S3	CASED OPENING
102B	F	WD	ST	3'-0"	7'-0"	1 3/4"	-	23.3	F1	HM	PT	H1	J1	NONE	CARD READER	
102C	N	WD	ST	3'-0"	7'-0"	1 3/4"	-	16.0	F1	HM	PT	H1	J1	NONE		
102D	F	WD	ST	3'-0"	7'-0"	1 3/4"	-	23.3	F1	HM	PT	H1	J1	NONE	CARD READER	
102E	N	WD	ST	3'-0"	7'-0"	1 3/4"	-	15.0	F1	HM	PT	H1	J1	NONE		
102F	F	WD	ST	3'-0"	7'-0"	1 3/4"	-	17.0	F1	HM	PT	H1	J1	NONE		
103A	N	WD	ST	3'-0"	7'-0"	1 3/4"	-	15.0	F1	HM	PT	H1	J1	NONE		
103B	N	WD	ST	3'-0"	7'-0"	1 3/4"	-	15.0	F1	HM	PT	H1	J1	NONE		
103C	N	WD	ST	3'-0"	7'-0"	1 3/4"	-	15.0	F1	HM	PT	H1	J1	NONE		
103D	N	WD	ST	3'-0"	7'-0"	1 3/4"	-	15.0	F1	HM	PT	H1	J1	NONE		
103E	N	WD	ST	3'-0"	7'-0"	1 3/4"	-	15.0	F1	HM	PT	H1	J1	NONE		
103F	N	WD	ST	3'-0"	7'-0"	1 3/4"	-	15.0	F1	HM	PT	H1	J1	NONE		
103G	F	WD	ST	3'-0"	7'-0"	1 3/4"	-	23.3	F1	HM	PT	H1	J1	NONE	CARD READER	
103KA	N	WD	ST	3'-0"	7'-0"	1 3/4"	-	23.3	F1	HM	PT	H1	J1	NONE	CARD READER	
103KB	F	WD	ST	3'-0"	7'-0"	1 3/4"	-	16.1	F1	HM	PT	H1	J1	NONE		
103P	N	WD	ST	3'-0"	7'-0"	1 3/4"	-	15.0	F1	HM	PT	H1	J1	NONE		
104A	N	WD	ST	3'-0"	7'-0"	1 3/4"	-	15.0	F1	HM	PT	H1	J1	NONE		
104D	N	WD	ST	3'-0"	7'-0"	1 3/4"	-	15.0	F1	HM	PT	H1	J1	S3		
104E	N	WD	ST	3'-0"	7'-0"	1 3/4"	-	23.3	F1	HM	PT	H1	J1	S3	CARD READER	
104F	F	WD	ST	3'-0"	7'-0"	1 3/4"	-	24.0	F1	HM	PT	H1	J1	S3		
104G	F (PAIR)	WD	ST	6'-0"	7'-0"	1 3/4"	-	21.1	F1	HM	PT	H1	J1	S2		
104H	F	WD	ST	3'-0"	7'-0"	1 3/4"	-	24.0	F1	HM	PT	H1	J1	S3		
105A	N	WD	ST	3'-0"	7'-0"	1 3/4"	-	23.3	F1	HM	PT	H1	J1	S4	CARD READER	
106A	FG	AL	-	3'-0"	8'-0"	1 3/4"	-	2.0	G	AL	-	C4/A-511	B6/A-501	A1/A-511	CARD READER	
106B	FG	AL	-	3'-0"	8'-0"	1 3/4"	-	9.2	G	AL	-	H1	J1	S3		
120A	FG (PAIR)	AL	-	6'-0"	8'-0"	1 3/4"	-	3.1	J	AL	-	D4/A-511	J2	A1/A-511	CARD READER, AUTOMATIC OPERATOR	
120B	FG (PAIR)	AL	-	6'-0"	8'-0"	1 3/4"	-	9.1	H	AL	-	H2	J2	S4	AUTOMATIC OPERATOR	
121B	F	WD	ST	3'-0"	7'-0"	1 3/4"	-	21.2	F1	HM	PT	H1	J1	S1		
122	N	WD	ST	3'-0"	7'-0"	1 3/4"	-	17.1	F1	HM	PT	H1	J1	S4		
122A	N	WD	ST	3'-0"	7'-0"	1 3/4"	-	15.0	F1	HM	PT	H1	J1	NONE		
122B	N	WD	ST	3'-0"	7'-0"	1 3/4"	-	15.0	F1	HM	PT	H1	J1	NONE		
122C	N	WD	ST	3'-0"	7'-0"	1 3/4"	-	16.0	F1	HM	PT	H1	J1	NONE		
123A	N	WD	ST	3'-0"	7'-0"	1 3/4"	-	16.0	F1	HM	PT	H1	J1	NONE		
123B	F	WD	ST	3'-0"	7'-0"	1 3/4"	-	17.1	F1	HM	PT	H1	J1	S4		
123B1	F	WD	ST	3'-0"	7'-0"	1 3/4"	-	23.0	F1	HM	PT	H1	J1	NONE		
123C	N	WD	ST	3'-0"	7'-0"	1 3/4"	-	23.3	F1	HM	PT	H1	J1	S4	CARD READER	
123D	N	WD	ST	3'-0"	7'-0"	1 3/4"	-	23.3	F1	HM	PT	H1	J1	S4	CARD READER	
123E	F	WD	ST	3'-0"	7'-0"	1 3/4"	-	21.0	F1	HM	PT	H1	J1	S2		
123H	F	WD	ST	3'-0"	7'-0"	1 3/4"	-	13.0	F1	HM	PT	H1	J1	S3		
123J	-	-	-	4'-0"	7'-0"	0"	-	-	-	F1	HM	PT	H1	J1	NONE	CASED OPENING
124	N (PAIR)	WD	ST	4'-0"	7'-0"	1 3/4"	-	20.0	F1	HM	PT	H1	J1	NONE	1'-0" LEAF & 3'-0" LEAF, CARD READER	
124A	F	WD	ST	3'-0"	7'-0"	1 3/4"	-	21.0	F1	HM	PT	H1	J1	S2		
124C	F	WD	ST	3'-0"	7'-0"	1 3/4"	-	23.1	F1	HM	PT	H1	J1	NONE	CARD READER	
124D	F (PAIR)	WD	ST	6'-0"	7'-0"	1 3/4"	-	11.0	F1	HM	PT	H1	J1	S2		
124D1	F	WD	ST	3'-0"	7'-0"	1 3/4"	-	120min	10.1	F1	HM	PT	H1	J1	NONE	
124E	F	WD	ST	3'-0"	7'-0"	1 3/4"	-	23.3	F1	HM	PT	H1	J1	S2	CARD READER	
124G	N	WD	ST	3'-0"	7'-0"	1 3/4"	-	18.0	F1	HM	PT	H1	J1	S4		
125A	N	WD	ST	3'-0"	7'-0"	1 3/4"	-	15.0	F1	HM	PT	H1	J1	NONE		
125B	N	WD	ST	3'-0"	7'-0"	1 3/4"	-	15.0	F1	HM	PT	H1	J1	NONE		
125C	N	WD	ST	3'-0"	7'-0"	1 3/4"	-	15.0	F1	HM	PT	H1	J1	NONE		
125D	-	-	-	4'-0"	7'-0"	0"	-	-	-	F1	HM	PT	H1	J1	S4	CASED OPENING
125D1	F	WD	ST	3'-0"	7'-0"	1 3/4"	-	16.0	F1	HM	PT	H1	J1	S2		
125E	N	WD	ST	3'-0"	7'-0"	1 3/4"	-	49	17.0	F1	HM	PT	H1	J1	NONE	
125G	-	-	-	3'-0"	7'-0"	0"	-	-	-	F1	HM	PT	H1	J1	NONE	CASED OPENING
125H	N	WD	ST	3'-0"	7'-0"	1 3/4"	-	16.0	F1	HM	PT	H1	J1	NONE		
125J	N	WD	ST	3'-0"	7'-0"	1 3/4"	-	15.0	F1	HM	PT	H1	J1	NONE		
125K	N	WD	ST	3'-0"	7'-0"	1 3/4"	-	15.0	F1	HM	PT	H1	J1	NONE		
126	N	WD	ST	3'-0"	7'-0"	1 3/4"	-	17.1	F1	HM	PT	H1	J1	S4		
126A	N	WD	ST	3'-0"	7'-0"	1 3/4"	-	15.0	F1	HM	PT	H1	J1	NONE		
126B	N	WD	ST	3'-0"	7'-0"	1 3/4"	-	16.0	F1	HM	PT	H1	J1	NONE		
126C	N	WD	ST	3'-0"	7'-0"	1 3/4"	-	15.0	F1	HM	PT	H1	J1	NONE		
130A	FG	WD	ST	3'-0"	7'-0"	1 3/4"	-	17.1	F1	HM	PT	H1	J1	S2		
130B	F	HM	PT	3'-0"	7'-0"	1 3/4"	-	21.0	F1	HM	PT	H1	J1	S2		
130CA	F	HM	PT	3'-0"	7'-0"	1 3/4"	-	14.0	F1	HM	PT	H1	J1	S3		
130CB	-	-	-	3'-0"	7'-0"	0"	-	-	-	F1	HM	PT	H1	J1	NONE	CASED OPENING
130DA	F	HM	PT	3'-0"	7'-0"	1 3/4"	-	24.0	F1	HM	PT	H1	J1	S3		
130DB	F	HM	PT	3'-0"	7'-0"	1 3/4"	-	12.0	F1	HM	PT	H1	J1	NONE		
130EA	FG	AL	-	3'-0"	8'-0"	1 3/4"	-	2.0	F	AL	-	E3/A-420	D3/A-501	A1/A-511	CARD READER	
130EB	FG	AL	-	3'-0"	7'-0"	1 3/4"	-	9.2	K	AL	-	H2	J2	-		
130G	G	WD	ST	3'-0"	7'-0"	1 3/4"	-	15.0	F4	HM	PT	H1	J1	S4		
130I	G	WD	ST	3'-0"	7'-0"	1 3/4"	-	15.0	F4	HM	PT	H1	J1	S4		
130K	G	WD	ST	3'-0"	7'-0"	1 3/4"	-	15.0	F4	HM	PT	H1	J1	S4		
130M	G	WD	ST	3'-0"	7'-0"	1 3/4"	-	15.0	F4	HM	PT	H1	J1	S4		
130P	G	WD	ST	3'-0"	7'-0"	1 3/4"	-	15.0	F4	HM	PT	H1	J1	S4		
130R	G	WD	ST	3'-0"	7'-0"	1 3/4"	-	15.0	F4	HM	PT	H1	J1	S4		
131	G	HM	PT	3'-8"	7'-0"	1 3/4"	-	4.0	F2	HM	PT	D6/A-512	B6/A-501	A1/A-511	INSULATED, CARD READER	
131A1	G	HM	PT	3'-0"	7'-0"	1 3/4"	-	52	15.0	F4	HM	PT	H1	J1	S6	
131AA	G	HM	PT	3'-0"	7'-0"	1 3/4"	-	52	23.3	F1	HM	PT	H1	J1	S2	CARD READER
131AB	FG	AL	-	3'-8"	8'-0"	1 3/4"	-	1.0	F	AL	-	C4/A-511	C6/A-501	A1/A-51		



MEMBERS OF THE AMERICAN INSTITUTE OF ARCHITECTS

COPYRIGHT 2017 ALL RIGHTS RESERVED
PRINTED OR ELECTRONIC DRAWINGS AND DOCUMENTATION MAY NOT BE REPRODUCED IN ANY FORM WITHOUT WRITTEN PERMISSION FROM LS3P ASSOCIATES LTD.

REVISIONS:


No.	Description	Date
1	Addendum No. 4	08/28/2017

PROJECT: 9202-164730
SCO ID: 16-15656-02B
ITEM: 315 CODE: 41526
DATE: AUGUST 21, 2017
DRAWN BY: ZS
CHECKED BY: SH


FRAME, LOUVER, AND STOREFRONT ELEVATIONS

A-603


E
D
C
B
A

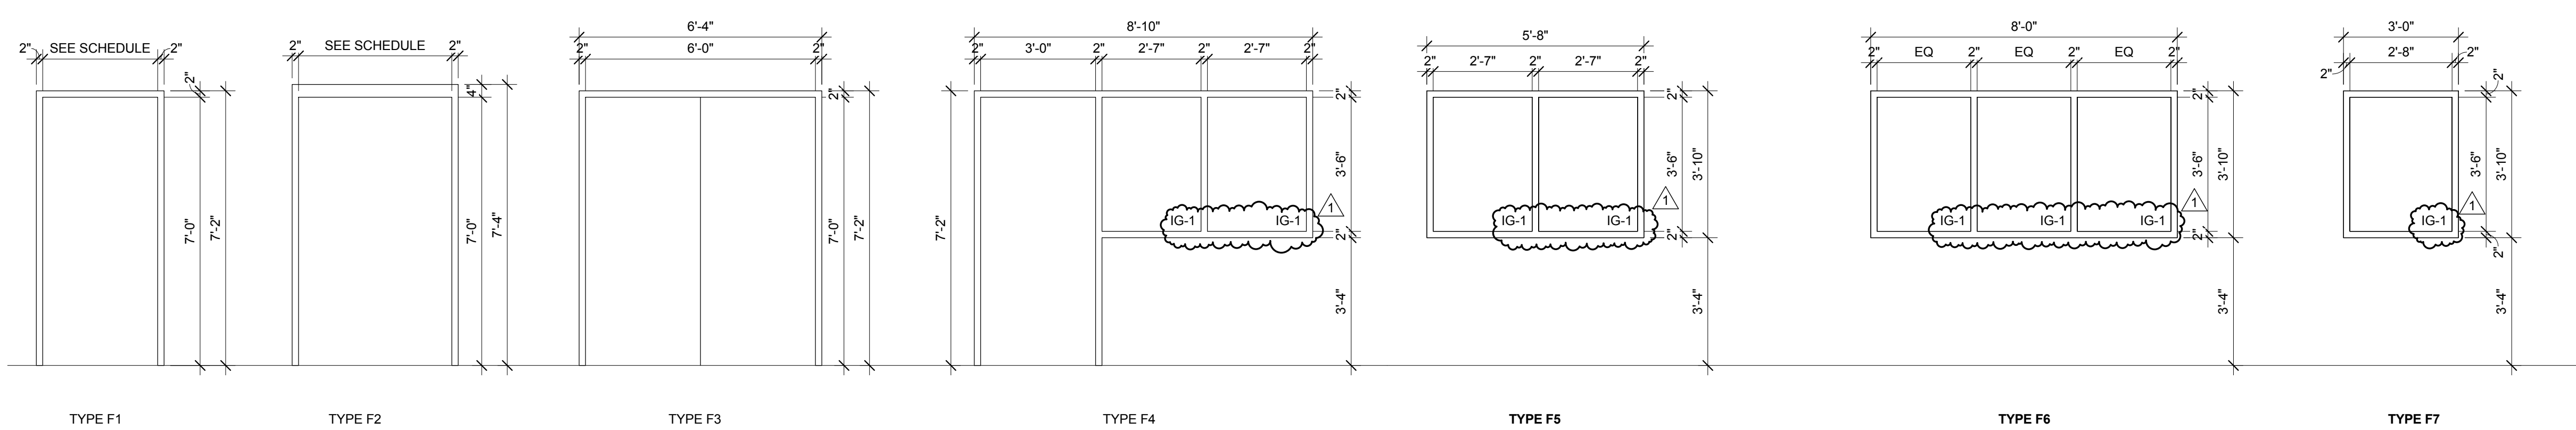

HOLLOW METAL FRAME ELEVATIONS
3/8" = 1'-0"

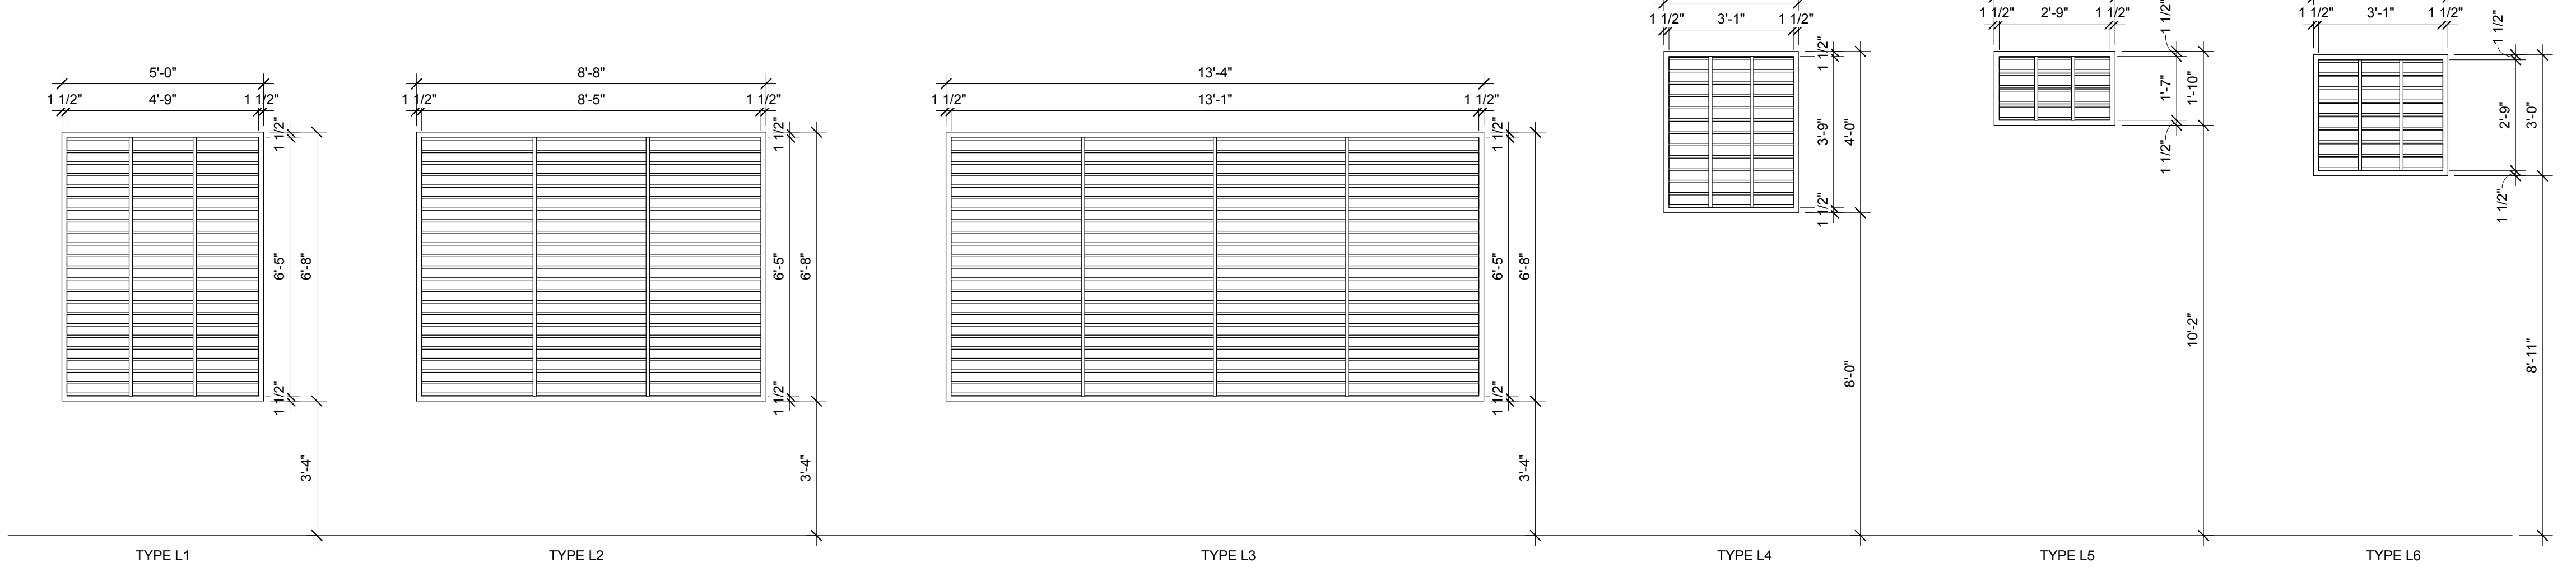

LOUVER ELEVATIONS
3/8" = 1'-0"

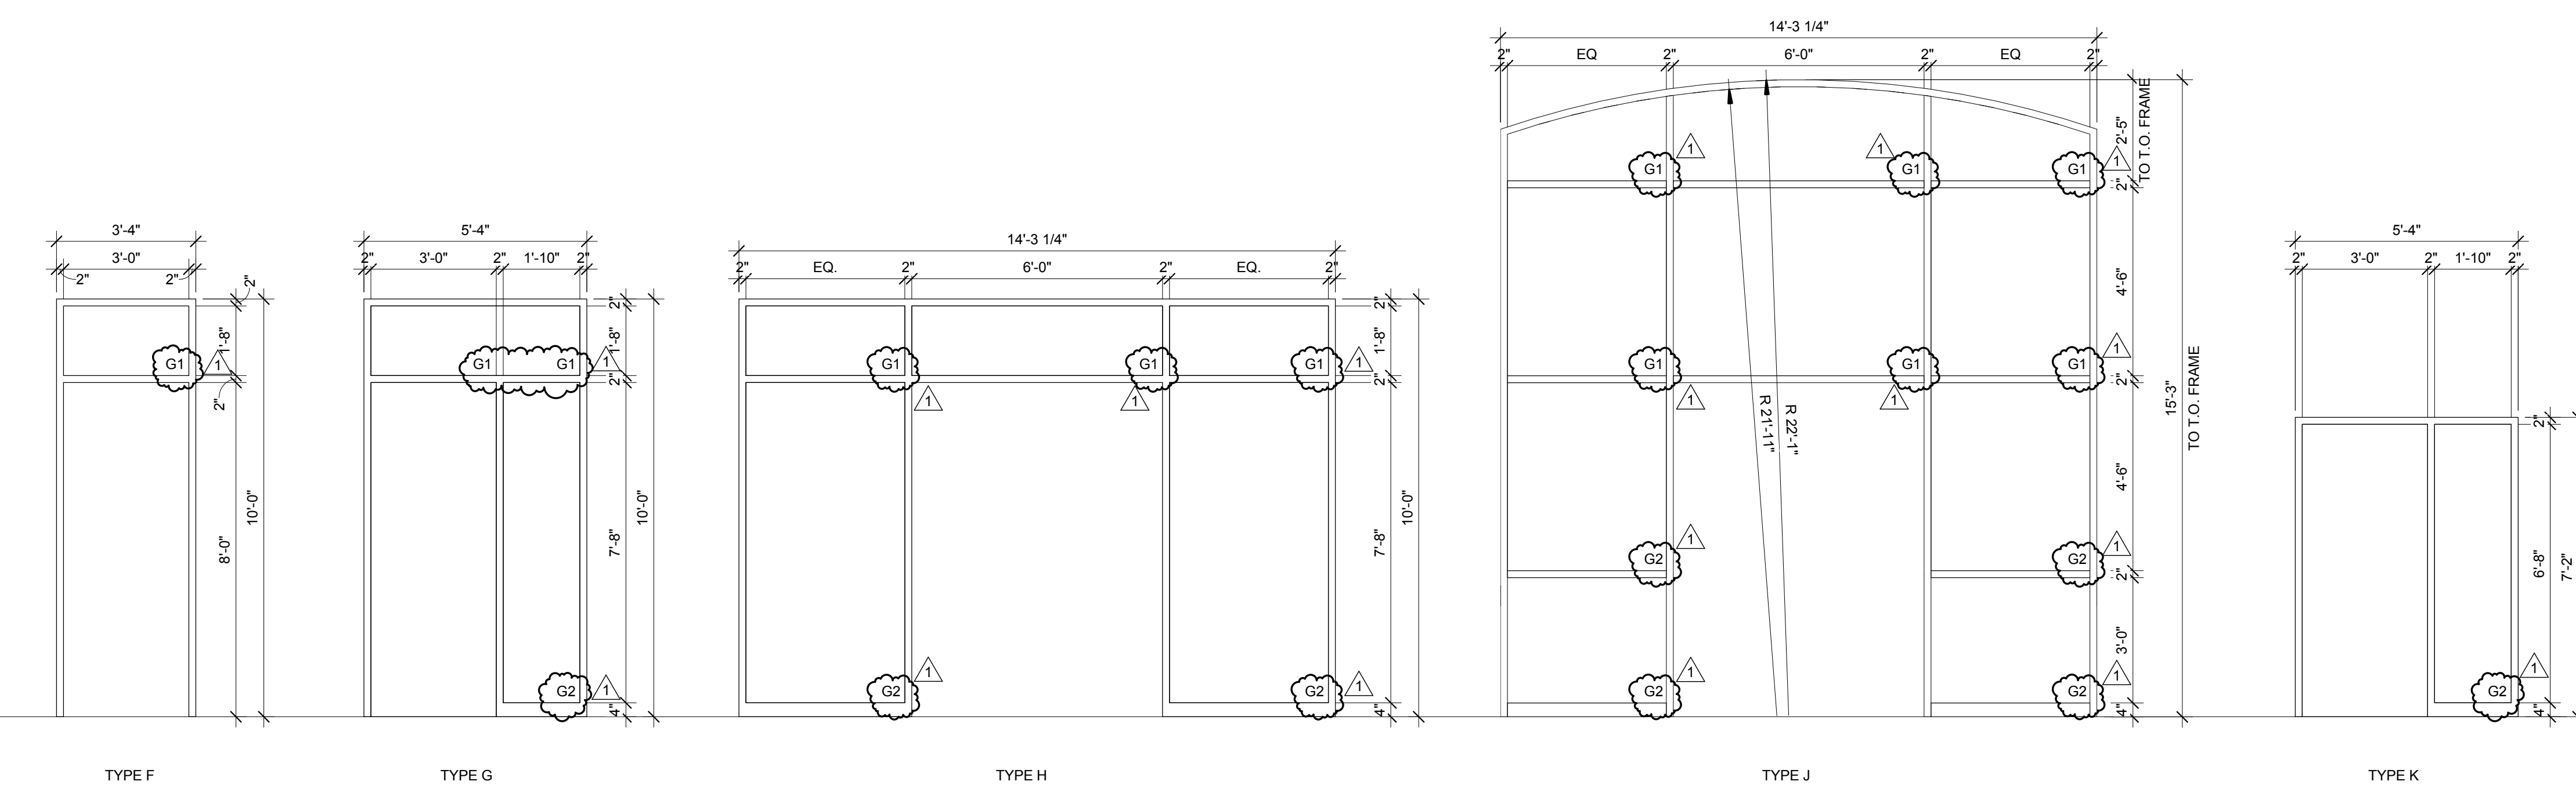

ALUMINUM STOREFRONT ELEVATIONS
3/8" = 1'-0"

GLAZING LEGEND

G1	1" INSULATED LOW-E GLASS, TYPICAL UNO
G2	SAME AS G1 EXCEPT BOTH LITES TEMPERED
IG-1	1/4" MONOLITHIC GLASS, TEMPERED

C:\Users\sharohu\Documents\Acoi_UNCC Facilities Operations Complex_2016_sharohu.rvt
8/30/2017 8:00:20 AM

1 2 3 4 5

REVISIONS:

No.	Description	Date
1	Addendum #4	8.28.2017

PROJECT: 9202-164730
SCO ID: 16-16656-02B
ITEM: 315 CODE: 41626
DATE: AUGUST 21, 2017
DRAWN BY: RPD
CHECKED BY: DAR

FIRE PROTECTION - SPECIFICATIONS, NOTES AND SCHEDULES

FP-001

FIRE PROTECTION LEGEND		
SYMBOL	ABBREV.	DESCRIPTION
	F	FIRE MAIN (ABOVE CEILING)
	OSBY	OSBY VALVE WITH TAMPER SWITCH
	BFY	BUTTERFLY VALVE WITH TAMPER SWITCH
	FDC	FREE STANDING FIRE DEPT. CONNECTION
	EB	ELECTRIC BELL
	FCV	FLOOR CONTROL VALVE WITH TAMPER SWITCH
	FS	FLOW SWITCH
	TDV	TEST AND DRAIN VALVE WITH SIGHT GLASS
	FHV	FIRE HOSE VALVE WITH CAP

FIRE PROTECTION NOTES	
<p>GENERAL REQUIREMENTS:</p> <ol style="list-style-type: none"> PROVIDE DESIGN, FABRICATION AND INSTALLATION OF A HYDRAULICALLY CALCULATED AUTOMATIC SPRINKLER SYSTEM. INCLUDE ALL SERVICES, MATERIALS, LABOR AND EQUIPMENT REQUIRED FOR A COMPLETE WORKING SYSTEM. DESIGN, AND INSTALL SPRINKLER SYSTEM IN FULL COMPLIANCE WITH THE REQUIREMENTS OF 2012 NFPA 13, 2013 NFPA-13, THE OWNER'S INSURANCE UNDERWRITER AND THE LOCAL AUTHORITIES. THE FIRE PROTECTION CONTRACTOR SHALL BE RESPONSIBLE FOR THE COMPLETE DESIGN OF THE FIRE PROTECTION SYSTEM AND SHALL PROVIDE SEALED SHOP DRAWINGS FOR THE SYSTEM. SPRINKLER SYSTEM PLANS AND CALCULATIONS SHALL BE PREPARED BY A NICET LEVEL IV TECHNICIAN. INCLUDE THE DESIGNER'S NAME, SIGNATURE AND CERTIFICATE NUMBER ON THE PLANS AND HYDRAULIC CALCULATIONS. DESIGN AND HYDRAULICALLY CALCULATE THE SPRINKLER SYSTEM UTILIZING THE INFORMATION INCLUDED HEREON. MEET ALL NFPA 13 STANDARDS WHETHER OR NOT SPECIFICALLY INDICATED WITHIN THESE DOCUMENTS. OBTAIN CURRENT UP-TO-DATE WATER FLOW TEST INFORMATION BEFORE STARTING THE WORKING PLAN DESIGN. WATER FLOW TEST DATA OLDER THAN 1 YEAR WILL NOT BE ACCEPTED. FLOW TEST DATA NOTED ON THESE PLANS DOES NOT WAIVE THE CONTRACTOR'S RESPONSIBILITY TO MEET THIS REQUIREMENT. THE INTENT OF THESE PLANS IS TO PROVIDE INFORMATION TO THE REVIEWING AUTHORITIES THAT THE BUILDING WILL BE PROTECTED BY A SPRINKLER SYSTEM. SPRINKLER HEAD LAYOUT INCLUDED WITH THIS SET OF PLANS IS PROVIDED FOR COORDINATION AND AS A REFERENCE ONLY, AND SHALL NOT BE CONSIDERED AN ACTUAL DESIGN OR CONSTRUCTION DOCUMENT. PRIOR TO THE START OF CONSTRUCTION, SUBMIT EIGHT (8) SETS OF SPRINKLER PLANS, MATERIALS DATA AND HYDRAULIC CALCULATIONS TO THE A/E FOR REVIEW. EACH SET OF PRINTS AND CALCULATIONS SUBMITTED SHALL BEAR APPROVAL STAMPS FROM THE LOCAL FIRE MARSHAL OR FIRE BUREAU CHIEF, THE OWNER'S INSURANCE CARRIER REVIEW BOARD AND IF REQUIRED, THE STATE FIRE MARSHAL. EXAMINE THE CONSTRUCTION DOCUMENTS, INCLUDING ANY SPECIFICATIONS OR PROJECT MANUALS. REVIEW THE JOB CONDITIONS AND VERIFY ALL MEASUREMENTS, DISTANCES, ELEVATIONS, CLEARANCES, PIPE SIZES, ETC. PRIOR TO THE START OF CONSTRUCTION. COORDINATE THE LOCATION OF SPRINKLERS WITH THE ARCHITECTURAL PLANS. ANY CHANGES OR ALTERATIONS REQUIRED DUE TO LACK OF COORDINATION WILL BE THE RESPONSIBILITY OF THE CONTRACTOR. AT THE COMPLETION OF THE PROJECT, PROVIDE TO THE OWNER TWO SETS OF RECORD DRAWINGS WHICH CLEARLY SHOW ANY CHANGES AND/OR MODIFICATIONS, ADDITIONS OR DELETIONS TO AND FROM THE CONSTRUCTION DOCUMENTS, AND ALL WORK ADDED TO THE CONTRACT DOCUMENTS. THE SETS SHALL BE REVIEWED BY THE A/E BEFORE TURNING THEM OVER TO THE OWNER. PROVIDE ALL NECESSARY OFFSETS, RISES OR DROPS IN THE PIPING AND AUXILIARY DRAINS AS REQUIRED BY BUILDING CODES WHETHER OR NOT SHOWN ON THE PLANS. PROVIDE RECORD DRAWINGS WHICH CLEARLY SHOW ALL UNDERGROUND PIPING DIMENSIONED FROM ANY PERMANENT STRUCTURE, AND ALL WORK ADDED TO THE CONTRACT DOCUMENTS. WARRANT THE SYSTEM LABOR, MATERIALS AND EQUIPMENT FOR THE AMOUNT OF TIME SPECIFIED IN THE PROJECT MANUAL. IF NO WARRANTY SECTION IS PROVIDED, THEN WARRANT THE SYSTEM LABOR, MATERIAL AND EQUIPMENT FOR A MINIMUM OF ONE YEAR AFTER COMPLETION AND ACCEPTANCE. PRIOR TO TURNING THE COMPLETED SYSTEM OVER TO THE OWNER, REVIEW THE INSTALLATION WITH THE A/E AND REPLACE OR REPAIR ANY DEFECTIVE WORKMANSHIP, EQUIPMENT AND MATERIALS AT NO ADDITIONAL COST TO THE OWNER. <p>MATERIALS:</p> <ol style="list-style-type: none"> ABOVE GRADE PIPE AND FITTINGS: BLACK STEEL. PIPING SHALL BE LISTED FOR FIRE SPRINKLER PIPING USE AND INCLUDE FM APPROVED MIC INHIBITING COATING. PIPING 2" AND SMALLER SHALL BE SCHEDULE 40 BLACK STEEL PIPE THREADED, WELDED OR ROLL GROOVED FOR MECHANICAL FITTINGS. PIPING 2-1/2" AND LARGER SHALL BE SCHEDULE 10 BLACK STEEL PIPE ROLL GROOVED FOR MECHANICAL FITTINGS. PIPE HANGERS: CONFORM TO NFPA 13 AND U.L. STANDARDS FOR SPACING, NUMBER, SIZE, AND TYPE. PIPE SHALL BE GENERALLY SUPPORTED BY CLAMPS AND RODS SECURED TO OVERHEAD CONSTRUCTION. VALVES: OSBY TYPE, IRON BODY BRONZE MOUNTED, DOUBLE DISC WITH PARALLEL SEATS, OR BUTTERFLY, LUG TYPE, DUCTILE IRON BODY, STAINLESS STEEL STEM, ALUMINUM BRONZE DISC, PHENOLIC RING AND BUNA N SEAT. VALVES SHALL BE FM/UL LISTED AND APPROVED FOR FIRE PROTECTION SERVICE. ESCUTCHEON PLATES: PROVIDE CHROME PLATED ESCUTCHEON PLATES WHERE PIPES PASS THROUGH FINISHED WALLS, FLOORS, OR CEILING. PROVIDE PRIME COAT PAINTED ESCUTCHEON PLATES WHEREVER PIPES PASS THROUGH THE WALLS, FLOORS, OR CEILING IN UNFINISHED EXPOSED AREAS. TESTING AND FLUSHING: OVERHEAD SPRINKLER PIPING: TESTED FOR A PERIOD OF TWO HOURS AT A HYDROSTATIC PRESSURE OF 200 LBS. AND ALL PIPING, VALVES, HEADS, ETC. SHALL BE WATERTIGHT. 	

DRAWING LIST - FIRE PROTECTION	
SHEET #	SHEET NAME
FP-001	FIRE PROTECTION - SPECIFICATIONS, NOTES AND SCHEDULES
FP-002	FIRE PROTECTION - DETAILS
FP-011	FLOOR PLAN - OFFICE/SHOPS - FIRE PROTECTION
FP-012	FLOOR PLAN - WAREHOUSE - FIRE PROTECTION

FIRE PROTECTION DESIGN CRITERIA								
SYMBOL	OCCUPANCY	TYPE	DESIGN DENSITY (GPM/SF)	HYDRAULIC REMOTE AREA (SF)	MAX. COVERAGE PER SPRINKLER HEAD (SF)	HOSE STREAM		AREAS OF COVERAGE
						INSIDE (GPM)	OUTSIDE (GPM)	
LH	LIGHT HAZARD	WET	0.10	1500	225	100	-	OFFICES AREAS, EXCEPT AS NOTED OTHERWISE
OH-1	ORDINARY HAZARD GROUP 1	WET	0.15	1500	130	100	150	MECH. ROOMS, STORAGE ROOMS, ELEC. ROOMS, JANITORS CLOSETS, ETC.
OH-2	ORDINARY HAZARD GROUP 2	WET	0.20	1500	130	100	150	WAREHOUSE, TRASH ROOMS & STORAGE ROOMS WITH SHELVES OVER 8 FT TALL AND LESS THAN 12 FT TALL
OH-2D	ORDINARY HAZARD GROUP 2	DRY	0.20	1950	130	100	150	LOADING DOCK

APPLICABLE PUBLICATIONS:	
THE FOLLOWING PUBLICATIONS SHALL BE USED AS A REFERENCE FOR THE DESIGN OF THE FIRE PROTECTION SYSTEM ON THIS PROJECT:	
<ol style="list-style-type: none"> NORTH CAROLINA STATE BUILDING CODE - FIRE CODE, 2012 EDITION NFPA 13 - STANDARD FOR THE INSTALLATION OF SPRINKLER SYSTEMS - 2013 EDITION NFPA 20 - STANDARD FOR THE INSTALLATION OF CENTRIFUGAL FIRE PUMPS - 2013 EDITION NFPA 24 - STANDARD FOR THE INSTALLATION OF PRIVATE FIRE SERVICE MAINS AND THEIR APPURTENANCES - 2013 EDITION NORTH CAROLINA STATE CONSTRUCTION OFFICE - WATER BASED FIRE PROTECTION SYSTEMS GUIDELINES AND POLICIES - 2014 	
NOTES:	
<ol style="list-style-type: none"> FIRE PROTECTION WORK SHALL BE INSTALLED IN ACCORDANCE WITH THE ABOVE PUBLICATIONS AS WELL AS WITH THE REQUIREMENTS OF THE LOCAL AUTHORITY HAVING JURISDICTION. SPRINKLER HEADS SHALL BE SPACED IN ACCORDANCE WITH NFPA 13 AND THE MANUFACTURERS APPROVAL LISTING. COORDINATE PIPE ROUTING WITH DUCT ROUTING, EQUIPMENT LOCATIONS, ELECTRICAL INSTALLATIONS, AND BUILDING STRUCTURAL MEMBERS. AVOID PENETRATING ANY MAIN STRUCTURAL BEAM, NOTIFY ARCHITECT OF ANY CONFLICTS. CONTRACTOR SHALL BE RESPONSIBLE FOR PROVIDING HIS OWN FIRE PROTECTION SYSTEM DESIGN AND SHOP DRAWINGS. CONTRACTOR SHALL MEET ALL REQUIREMENTS OF THE DATA LISTED ON THIS SHEET AND THE REQUIREMENTS OF THE CONTRACT SPECIFICATIONS. SPRINKLERS SHALL BE CENTERED IN CEILING TILES IN AREAS WITH LAY-IN TILES AND VISUALLY ALIGNED IN AREAS WITH SMOOTH CEILINGS. SEE REFLECTED CEILING PLAN FOR PREFERRED LOCATION OF HEADS. PROVIDE CONCEALED TYPE SPRINKLER HEADS FOR AREAS WITH LAY-IN CEILINGS AND GYPOBOARD CEILINGS. PROVIDE UPRIGHT SPRINKLER HEADS FOR EXPOSED AREAS. COORDINATE COLOR OF CONCEALED SPRINKLER HEAD COVER-PLATE WITH ARCHITECT. DURING DESIGN CALCULATIONS, AN ALLOWANCE SHALL BE MADE FOR A 250 GPM HOSE STREAM. FIRE PROTECTION CONTRACTOR SHALL TERMINATE THE HYDRAULIC CALCULATIONS AT THE HYDRANT TEST CONNECTION. INDICATE ON DRAWINGS ALL UNDERGROUND PIPE AND FITTINGS BOTH NEW AND EXISTING. PROVIDE SPRINKLER HEADS IN ALL CLOSET AND BATHROOMS. PROVIDE FIRE SPRINKLERS IN ALL ELEVATORS SHAFTS, HOIST WAYS AND PITS AS REQUIRED PER NFPA 13. 	

FLOW TEST DATA						
DATE	LOCATION	FLOW TEST PERFORMED BY	PRESSURE		FLOW AT 20 PSI (GPM)	FLOW AT 100 PSI (GPM)
			STATIC (PSI)	RESIDUAL (PSI)		
7/21/2017	HYDRANT #158662 @ NE CORNER OF LOT 26 NEAR MAINTENANCE YARD	CHARLOTTE FIRE DEPARTMENT	74	67	1061	3198
	NC-SCO ADJUSTED FLOW TEST		64	57	955	2878

FLOW TEST NOTES:

- SEE SITE UTILITY PLANS FOR EXACT LOCATION OF FIRE HYDRANTS.
- THE CONTRACTOR IS RESPONSIBLE FOR OBTAINING A NEW FIRE FLOW TEST ON WHICH TO BASE HIS CALCULATIONS.
- THE FLOW TEST USED FOR THE WORKING PLAN DESIGN SHOULD BE PERFORMED AS INDICATED IN NFPA 13 WHICH USES TWO HYDRANTS, A PRESSURE HYDRANT AND A FLOW HYDRANT. THE TWO HYDRANTS SHALL BE AS CLOSE TO THE POINT OF CONNECTION AS POSSIBLE. A COPY OF THE FLOW TEST AND TEST HYDRANT LOCATIONS SHALL BE SUBMITTED WITH THE SHOP DRAWING PACKAGE.

PUMP SCHEDULE											
SYM	DESCRIPTION	TYPE	CAPACITY				ELECTRICAL DATA			SELECTION BASED ON	REMARKS
			GPM	HEAD (FT)	HP	VOLTS	PH	HZ	MANUFACTURER		
FP1	ELECTRIC FIRE PUMP	VERTICAL IN-LINE	500	100 ft	25	480	3	60	A-C FIRE PUMP	SERIES 1580 4447F	1
JPI	JOCKEY PUMP	IN-LINE	-	--	5 MAX	480	3	60	GOULDS	--	2

REMARKS:

- PROVIDE SERVICE ENTRANCE RATED WYE DELTA CLOSED FIRE PUMP CONTROLLER EQUAL TO FIRETROL FTA-1350, WITH SERVICE ENTRANCE RATED AUTOMATIC TRANSFER SWITCH EQUAL TO FIRETROL FTA-950.
- PROVIDE JOCKEY PUMP CONTROLLER.

BACKFLOW PREVENTER SCHEDULE						
SYM.	DESCRIPTION	SYSTEM	DESCRIPTION	MANUF.	MODEL	COMMENTS
BEPL-F	REDUCED PRESSURE PRINCIPLE ASSEMBLY	FIRE SERVICE	REDUCED PRESSURE PRINCIPLE ASSEMBLY 6"	ZURN WILKINS	375V-OSY	1 & 2

NOTES:


- PROVIDE WITH AIR GAP FITTING.
- ROUTE 6" MIN. DISCHARGE FROM AIR GAP FITTING DRAIN TO THE NEAREST BUILDING EXTERIOR WALL AND TERMINATE DRAIN PIPING WITH ELBOW TURNED DOWN AT 12" A.F.G.

COORDINATION DRAWINGS	
PER WRITTEN SPECIFICATION SECTIONS 01 09 00 AND 01 31 00, THE MECHANICAL CONTRACTOR SHALL ORGANIZE COORDINATION MEETINGS TO DEVELOP A SET OF COORDINATION DRAWINGS WITH ALL CONTRACTORS (ELECTRICAL, MECHANICAL, PLUMBING, FIRE PROTECTION, IT/DATA, AND GENERAL CONTRACTOR). THE MECHANICAL CONTRACTOR WILL HAVE THE LEAD RESPONSIBILITY FOR THE COORDINATION DRAWINGS. THE MECHANICAL CONTRACTOR SHALL PRODUCE THE ORIGINAL DRAWINGS AND FORWARD THE DRAWINGS TO EACH OF THE OTHER CONTRACTORS FOR THEM TO ADD THEIR SYSTEMS TO THIS SET OF COORDINATION DRAWINGS. THE CONTRACTORS WILL DEVELOP THE DRAWINGS IN THIS ORDER: MECHANICAL, FIRE PROTECTION, PLUMBING, ELECTRICAL, IT/DATA, AND GENERAL. THIS SHALL ALSO BE THE ORDER OF PRECEDENCE FOR INSTALLATION OF SYSTEMS. ANY RELOCATION OF SYSTEM ROUTINGS WILL BE FOUND IN THE COORDINATION PHASE AND NOTICED BY EACH OF THE CONTRACTORS. THESE DRAWINGS, WHEN COMPLETED, SHALL BE SIGNED OFF BY ALL OF THE ABOVE LISTED PARTIES. DRAWINGS SHALL BE COMPLETED PRIOR TO FABRICATION AND INSTALLATION OF DUCTWORK AND PIPING SYSTEMS, OR PURCHASE OF EQUIPMENT. THE FOLLOWING ITEMS REPRESENT THE MINIMUM REQUIREMENTS AND COORDINATION DRAWINGS:	
<ol style="list-style-type: none"> ALL COORDINATION DRAWINGS WILL BE PRODUCED AT 1/4" = 1'-0" SCALE. COORDINATION DRAWINGS WILL BE DISTRIBUTED ON REPRODUCIBLE MATERIAL 48"x36" COORDINATION DRAWINGS ARE NOT SHOP DRAWINGS AND ARE REQUIRED IN ADDITION TO SHOP DRAWINGS. ONCE THE COMPLETE COORDINATION DRAWINGS HAVE BEEN COMPLETED, THE MECHANICAL CONTRACTOR WILL DISTRIBUTE ONE SET TO EACH OF THE FOLLOWING CONTRACTORS: ELECTRICAL, PLUMBING, FIRE PROTECTION, AND GENERAL. ADDITIONAL SETS WILL BE SENT TO THE OWNER, ARCHITECT, AND ENGINEER. 	
THE USE OF BUILDING INFORMATION MODELING (BIM) THROUGHOUT THE CONSTRUCTION PROCESS IS A REQUIREMENT FOR THIS PROJECT TO HELP REDUCE OR ELIMINATE FIELD DETECTED CONFLICTS, IMPROVE CONSTRUCTION QUALITY AND MAINTAIN AN AGGRESSIVE SCHEDULE. THE CONTRACTOR WILL BE RESPONSIBLE FOR CREATING THE MODEL AND MANAGING THE COORDINATION AND COLLISION DETECTION PROCESS. THE MODEL MUST CONTAIN COMPLETE ARCHITECTURAL, STRUCTURAL, MECHANICAL, ELECTRICAL, PLUMBING AND FIRE PROTECTION SYSTEMS CONSISTENT WITH THE DESIGN AND FABRICATION DRAWINGS.	

E
D
C
B
A

1
2
3
4
5

C:\Users\rdessa\Documents\16-0265_R16_MEP_updates.rvt
8/29/2017 11:30:12 AM

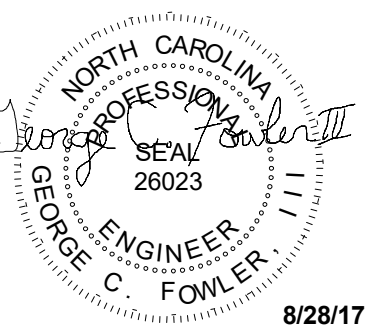


MEMBERS OF THE AMERICAN INSTITUTE OF ARCHITECTS

COPYRIGHT 2016 ALL RIGHTS RESERVED
PRINTED OR ELECTRONIC DRAWINGS AND DOCUMENTATION MAY NOT BE REPRODUCED IN ANY FORM WITHOUT WRITTEN PERMISSION FROM LS3P ASSOCIATES LTD.


REVISIONS:

No.	Description	Date
1	Addendum #4	8.28.2017

E
D
C
B
A

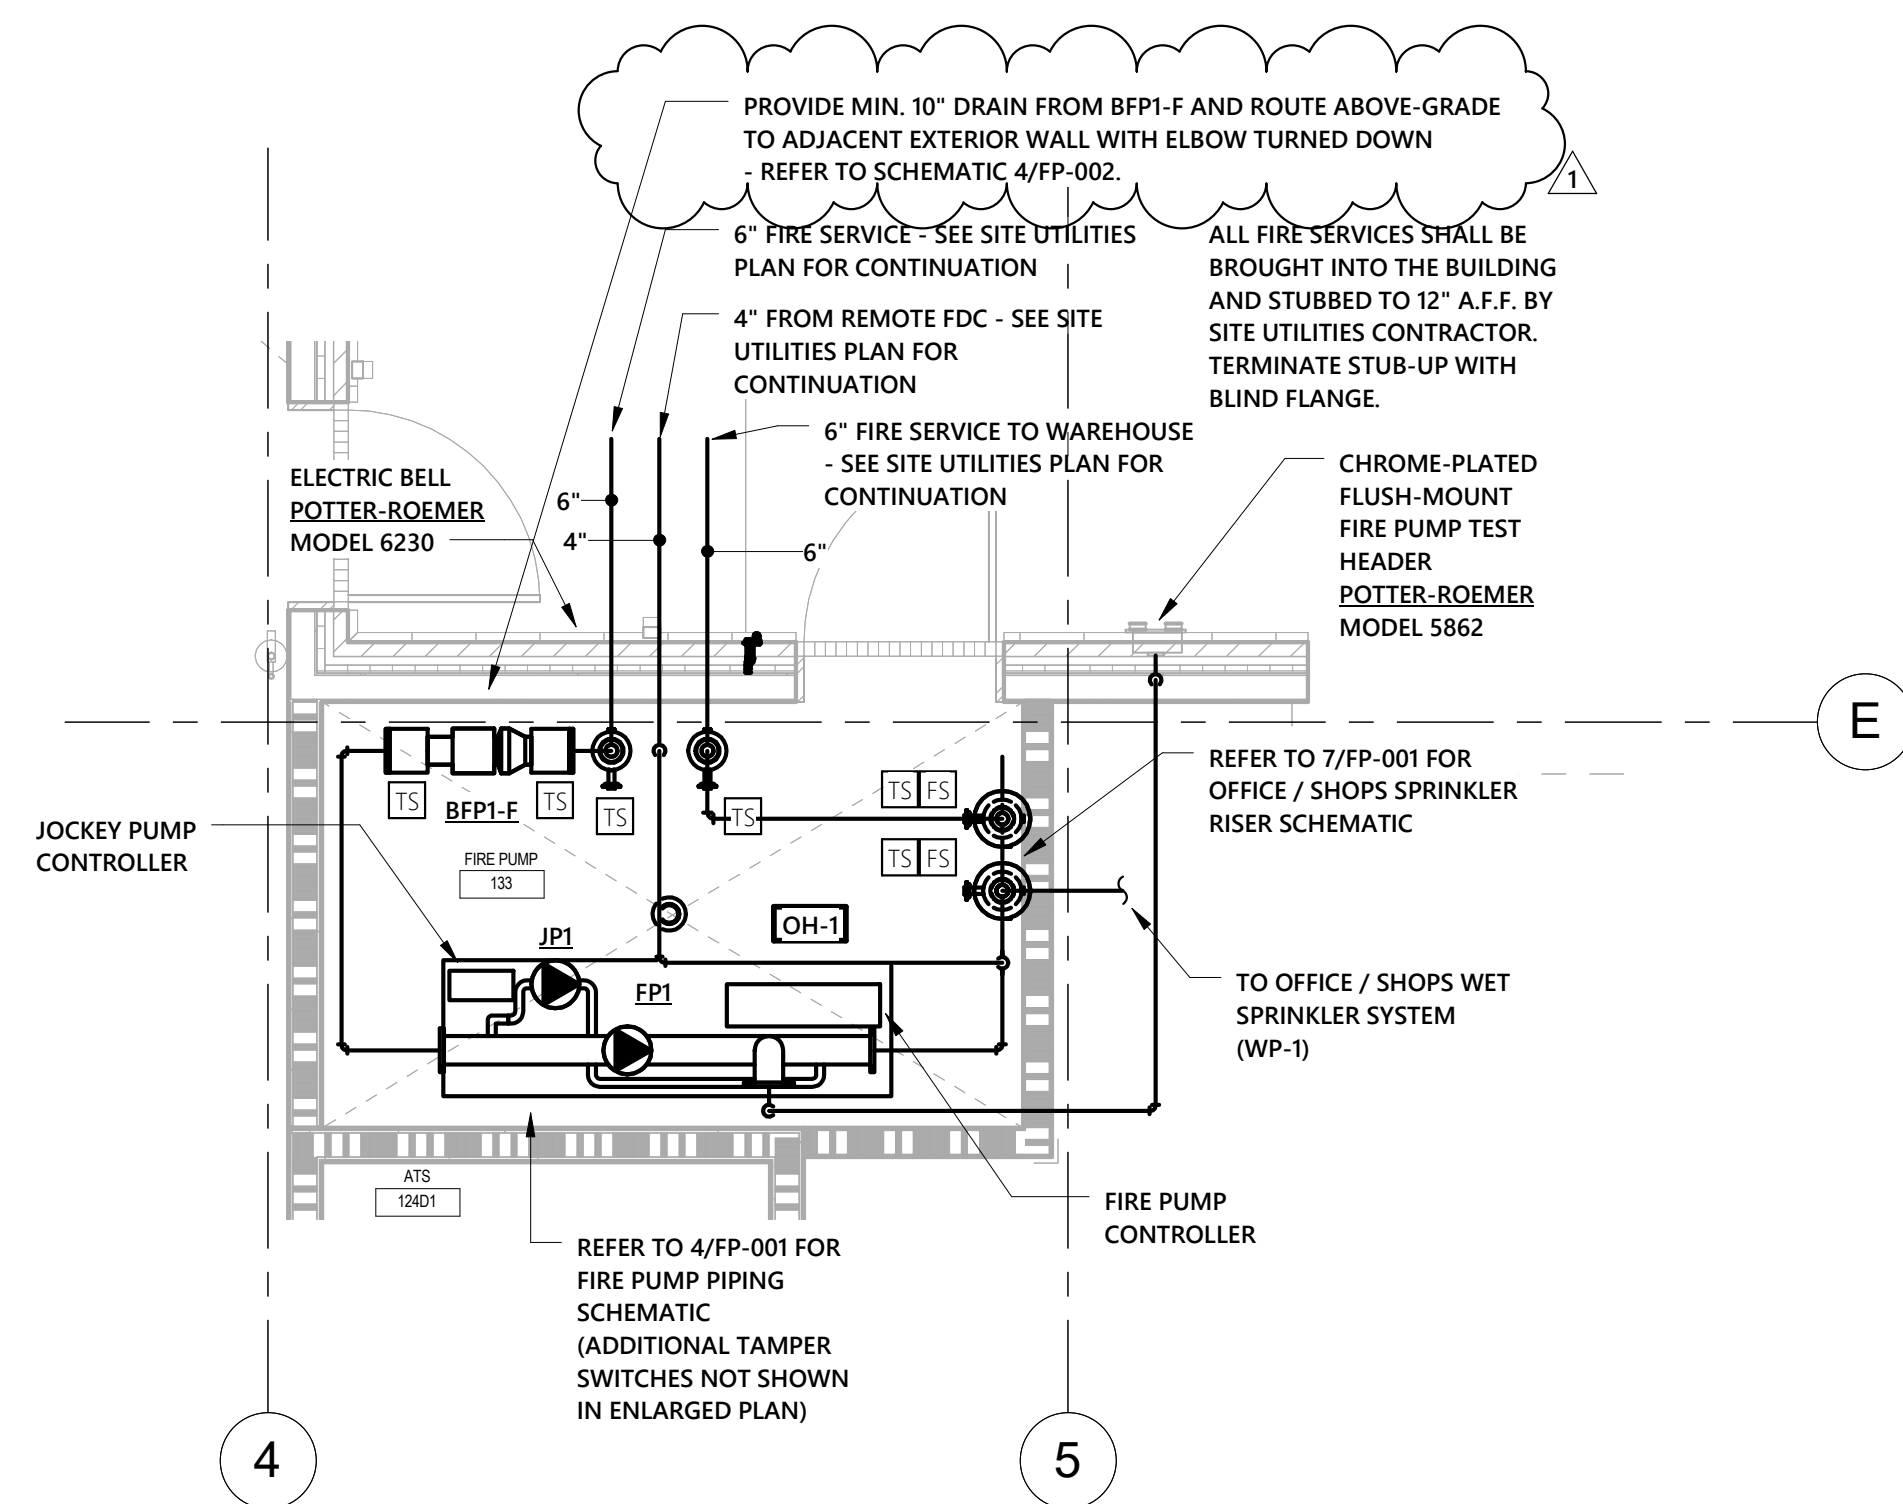

2 ENLARGED PLAN - FIRE PUMP ROOM
4 1/4" = 2'-0"
SCALE: 1/4" = 1'-0"

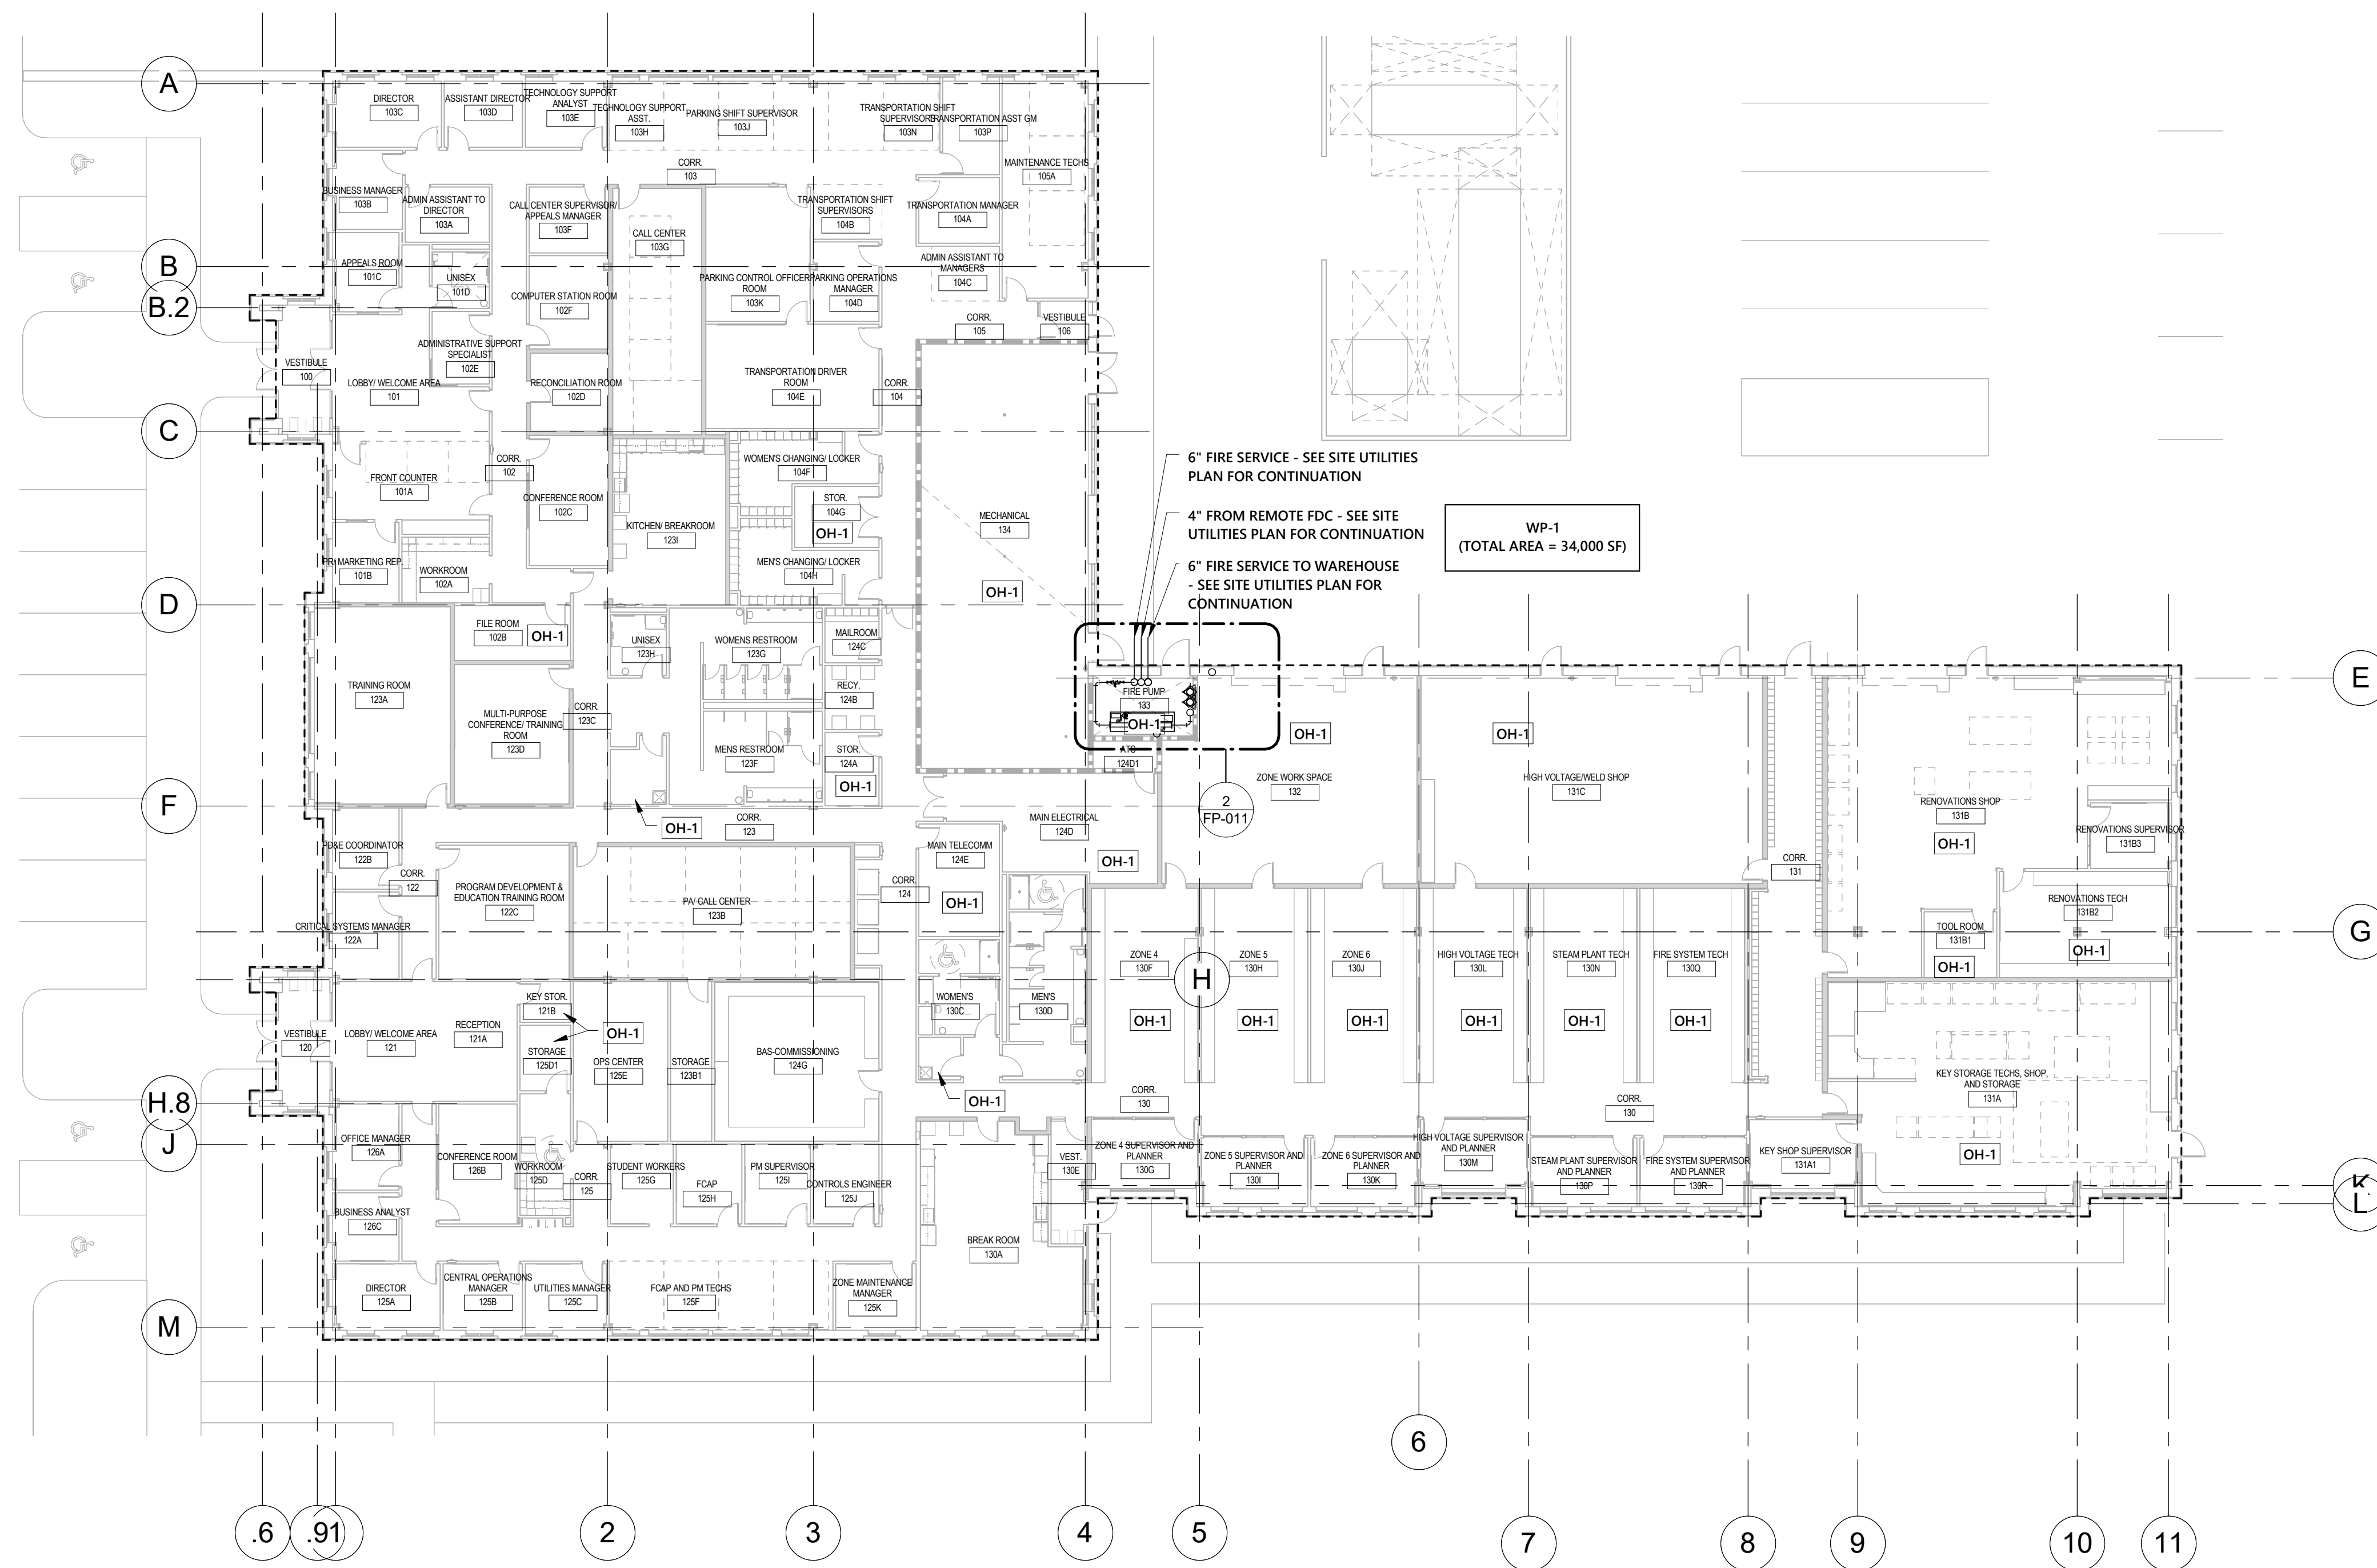

1 OFFICE/SHOPS FLOOR PLAN - FIRE PROTECTION
1/16" = 1'-0"
SCALE: 1/16" = 1'-0"

PARTITION LEGEND

- ALL EXTERIOR WALLS TO BE W1 U.N.O.
- ALL INTERIOR METAL STUD PARTITIONS TO BE TYPE G32 U.N.O.

- NON-RATED PARTITION TO CEILING
- NON-RATED PARTITION TO DECK
- 1 HR. RATED PARTITION TO DECK
- 2 HR. RATED PARTITION TO DECK

NOTE: SEE SHEET A-004 FOR CONSTRUCTION OF PARTITION TYPES.


KEYPLAN

PROJECT: 9202-164730
SCO ID: 16-15656-02B
ITEM: 315 CODE: 41526
DATE: AUGUST 21, 2017
DRAWN BY: RPD
CHECKED BY: DAR

FLOOR PLAN - OFFICE/SHOPS - FIRE PROTECTION

FP-011



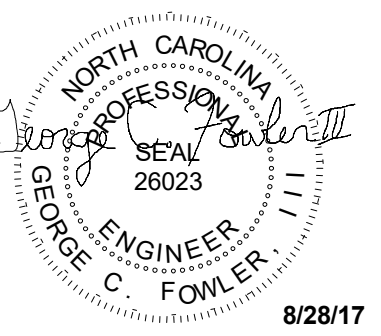


8/28/17

MEMBERS OF THE AMERICAN INSTITUTE OF ARCHITECTS

COPYRIGHT 2016 ALL RIGHTS RESERVED
PRINTED OR ELECTRONIC DRAWINGS AND DOCUMENTATION MAY NOT BE REPRODUCED IN ANY FORM WITHOUT WRITTEN PERMISSION FROM LS3P ASSOCIATES LTD.

REVISIONS:

No.	Description	Date
1	Addendum #4	8.28.2017

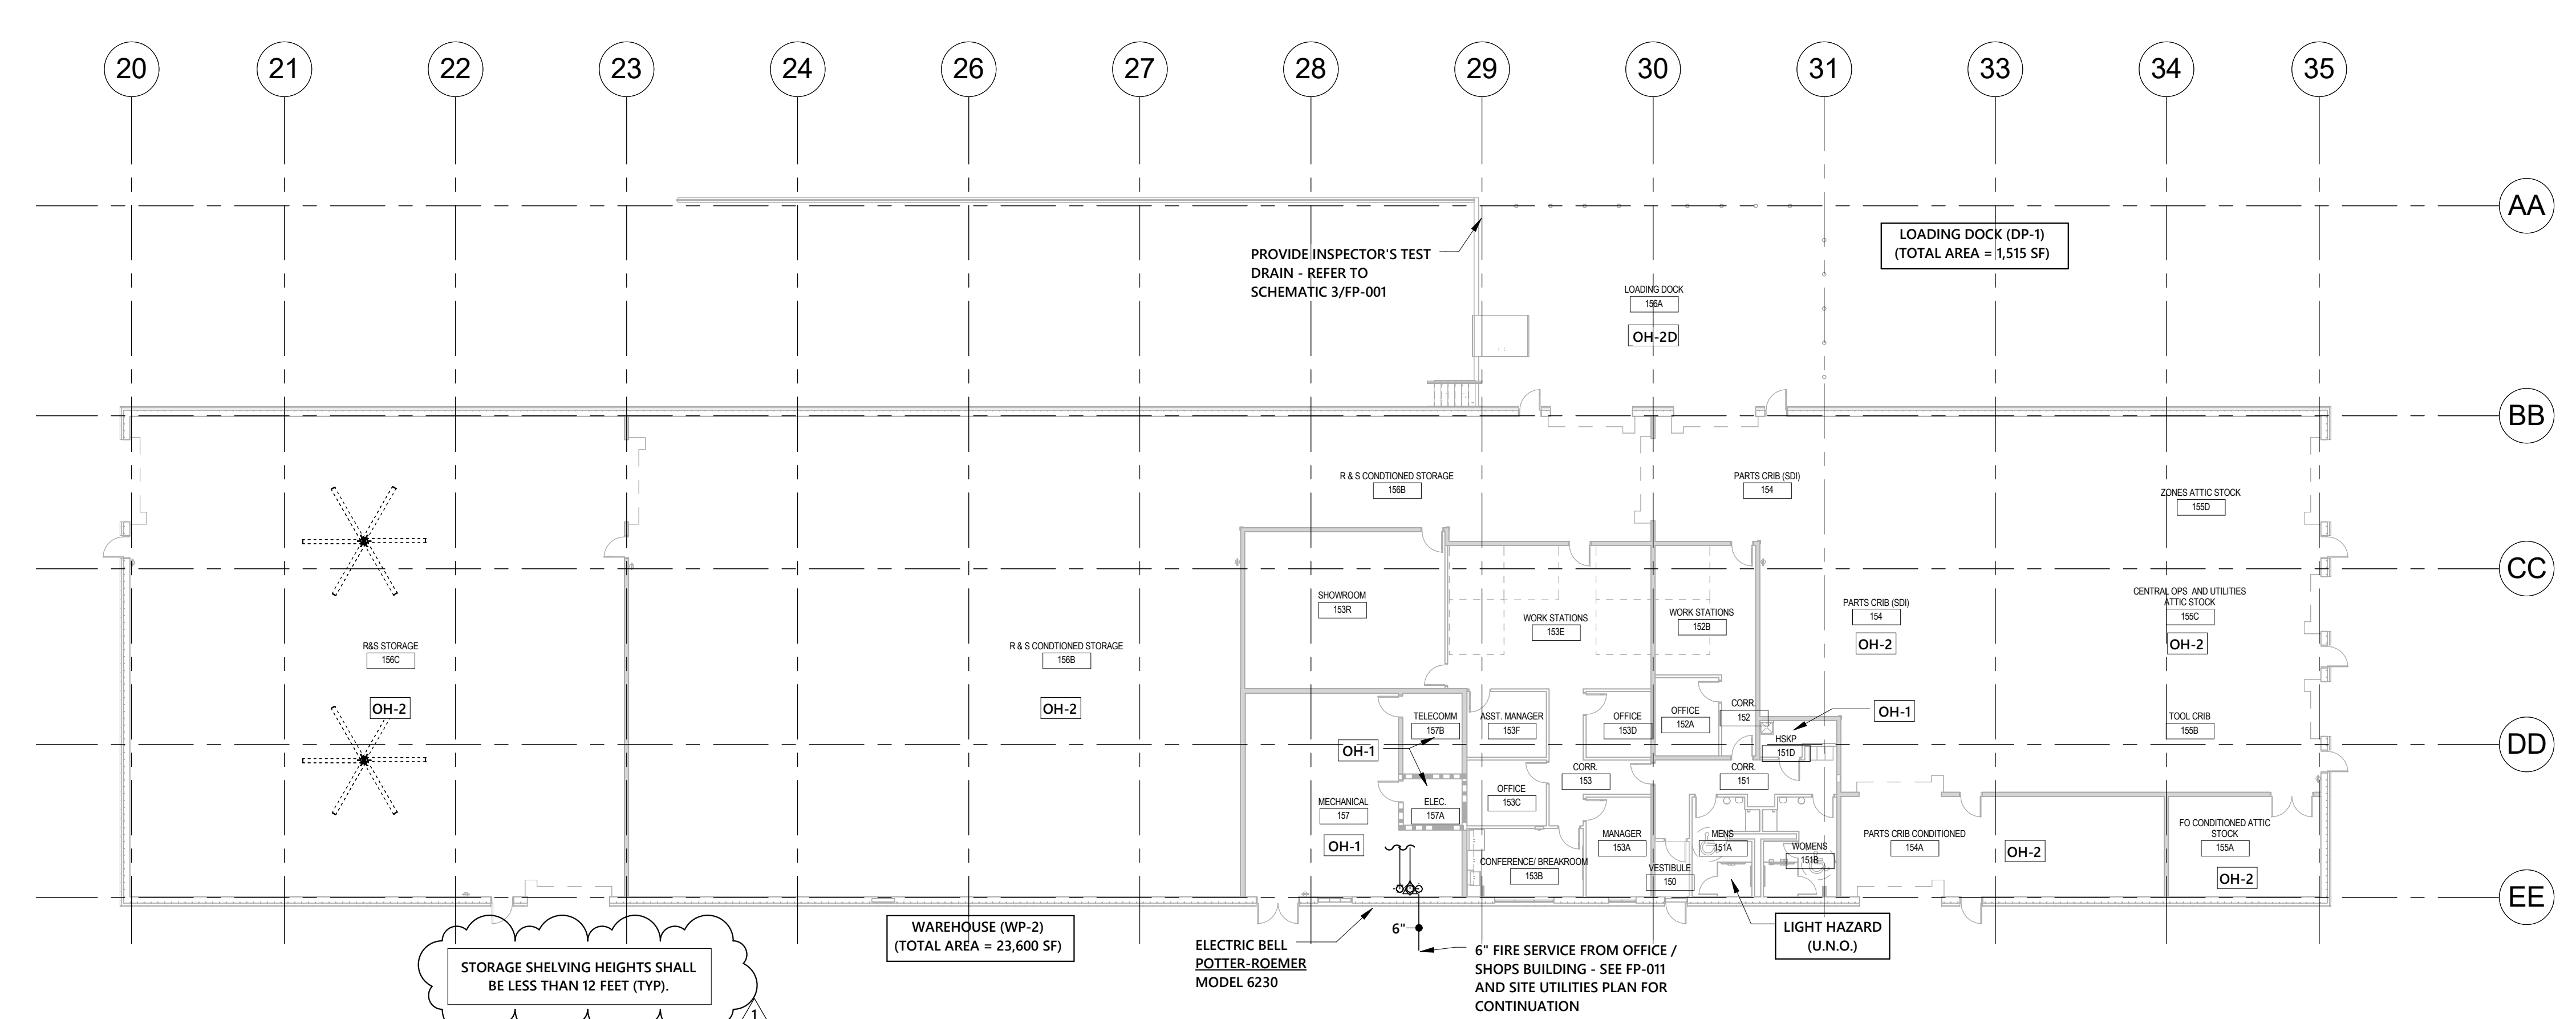


1 FLOOR PLAN - WAREHOUSE - FIRE PROTECTION
1/16" = 1'-0"
SCALE: 1/16"=1'-0"

PARTITION LEGEND

- ALL EXTERIOR WALLS TO BE W1 U.N.O.
- ALL INTERIOR METAL STUD PARTITIONS TO BE TYPE G32 U.N.O.

- NON-RATED PARTITION TO CEILING
- NON-RATED PARTITION TO DECK
- 1 HR. RATED PARTITION TO DECK
- 2 HR. RATED PARTITION TO DECK

NOTE: SEE SHEET A-004 FOR CONSTRUCTION OF PARTITION TYPES.

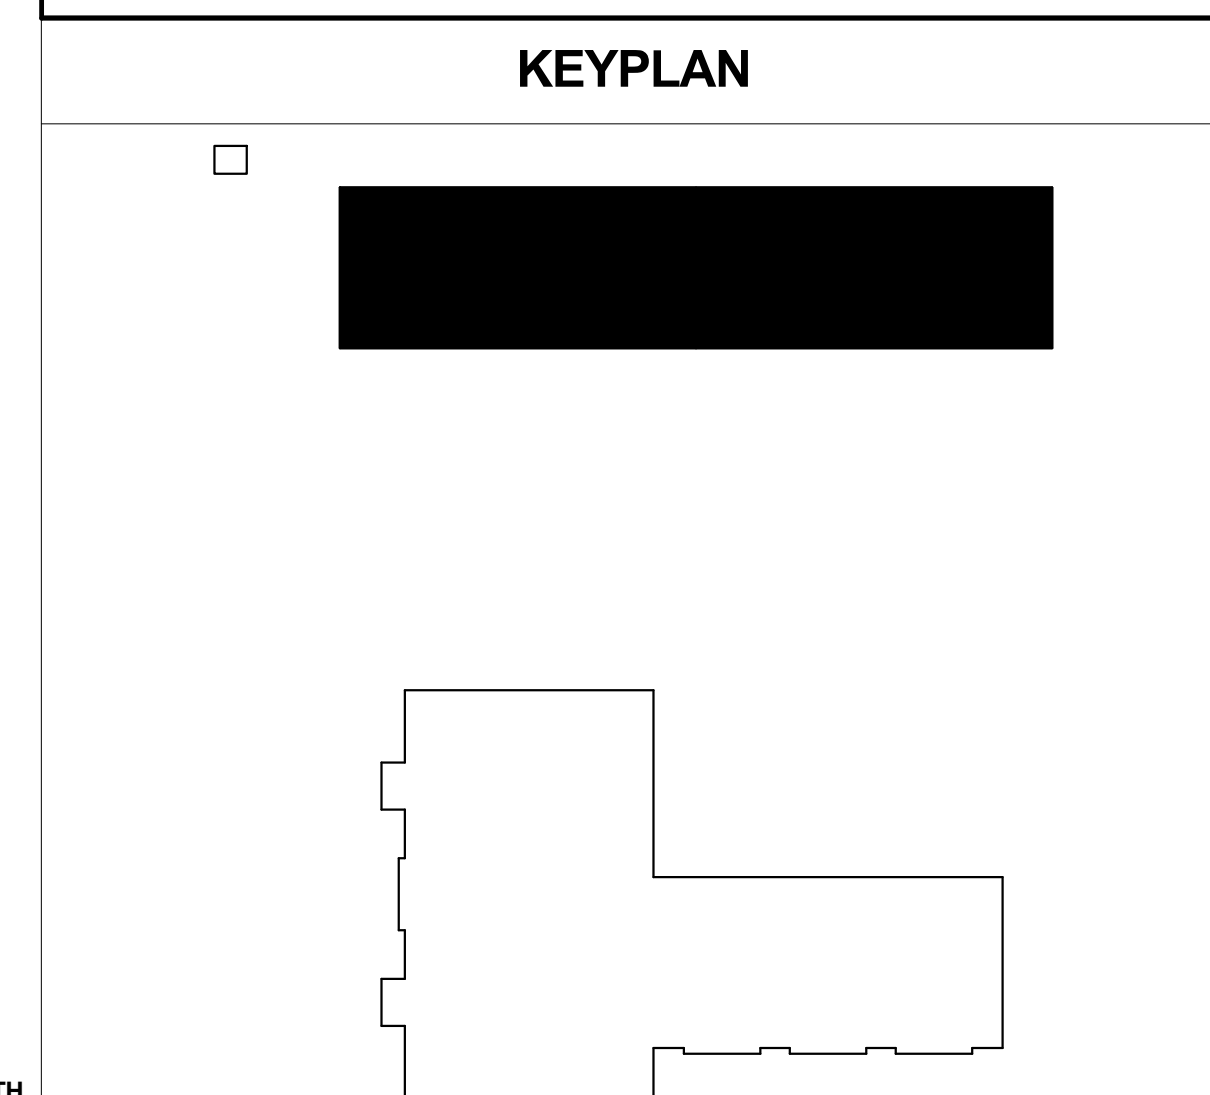


PROJECT: 9202-164730
SCO ID: 16-15656-02B
ITEM: 315 CODE: 41526
DATE: AUGUST 21, 2017
DRAWN BY: RPD
CHECKED BY: DAR

FLOOR PLAN - WAREHOUSE - FIRE PROTECTION

FP-012

OPTIMA #: 16-0265 4 OF 4

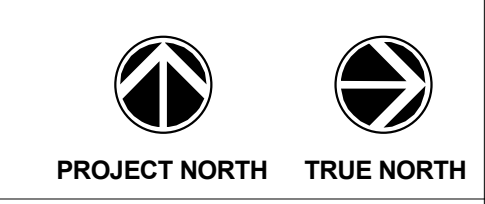

C:\Users\jdesse\Documents\16-0265_R16_MEP_Updates.rvt 8/29/2017 6:44:17 AM

SHOCK ARRESTOR SIZING TABLE

DRAWING SYMBOL	FIXTURE UNITS	PDI WH201 STANDARD DESIGNATION	ARRESTOR SIZE	APPROVED MANUFACTURERS
SA-A	1-11	A	1/2"	SILOUX CHIEF -WATTS -PPP INC.
SA-B	12-32	B	3/4"	
SA-C	33-60	C	1"	
SA-D	61-113	D	1-1/4"	REMARKS
SA-E	114-154	E	1-1/2"	INSTALL SHOCK ARRESTORS PER PDI WH201 GUIDELINES
SA-E	155-330	F	2"	

PLUMBING LOAD SUMMARY

LOAD	FIXTURE UNITS	FLOW
OFFICE: SANITARY WASTE	125 DFU	-
OFFICE: DOMESTIC WATER	263 FU	103 GPM
WAREHOUSE: SANITARY WASTE	30 DFU	-
WAREHOUSE: DOMESTIC WATER	66 FU	56 GPM

GAS LOAD SUMMARY (BASE BID)

LOAD	CONSUMPTION (CFH)
DOMESTIC WATER HEATER: WH1	150
MECHANICAL BOILER: HWB-1	1,250
MECHANICAL BOILER: HWB-2	1,250
RADIANT HEATER: GRH-1	40
RADIANT HEATER: GRH-2	40
RADIANT HEATER: GRH-3	40
RADIANT HEATER: GRH-4	50
TOTAL	2,820

NOTES:
 FARTHEST POINT OF DELIVERY FROM GAS METER (TO 2 PSI GAS PRESSURE REGULATOR AT WATER HEATERS IN MECHANICAL ROOM) = 350 FT.
 FUEL GAS CODE TABLE FOR ABOVE GRADE 2 PSI PIPING: 2012 NCGC - TABLE 402.4(3)
 SCHEDULE 40 METALLIC PIPE, 2 PSI INLET PRESSURE, 0.5 PSI PRESSURE DROP.
 FUEL GAS CODE TABLE FOR ABOVE GRADE LOW PRESSURE PIPING: 2012 NCGC - TABLE 402.4(2)
 SCHEDULE 40 METALLIC PIPE, 0.5 PSI INLET PRESSURE, 0.5" W.C. PRESSURE DROP.
 *AVAILABLE AT PRESSURE REGULATOR

GAS LOAD SUMMARY (ALTERNATE #10)

LOAD	CONSUMPTION (CFH)
DOMESTIC WATER HEATER: WH1	150
MECHANICAL BOILER: HWB-1	1,250
MECHANICAL BOILER: HWB-2	1,250
TOTAL	2,650

NOTES:
 FARTHEST POINT OF DELIVERY FROM GAS METER (TO 2 PSI GAS PRESSURE REGULATOR AT WATER HEATERS IN MECHANICAL ROOM) = 350 FT.
 FUEL GAS CODE TABLE FOR ABOVE GRADE 2 PSI PIPING: 2012 NCGC - TABLE 402.4(3)
 SCHEDULE 40 METALLIC PIPE, 2 PSI INLET PRESSURE, 1 PSI PRESSURE DROP.
 FUEL GAS CODE TABLE FOR ABOVE GRADE LOW PRESSURE PIPING: NCGC 2012 - TABLE 402.4(2)
 SCHEDULE 40 METALLIC PIPE, 0.5 PSI INLET PRESSURE, 0.5" W.C. PRESSURE DROP.
 *AVAILABLE AT PRESSURE REGULATOR

ALTERNATE NOTE AS IT RELATES TO GAS PIPING:
 THIS ALTERNATE REFLECTS THE UPDATED GAS LOAD SUMMARY RESULTING FROM THE REMOVED GAS-FIRED RADIANT HEATERS GRH-1 (3 EACH) AND GRH-2 (2 EACH).

PLUMBING FIXTURE AND EQUIPMENT SCHEDULE

SYM.	DESCRIPTION	CONNECTIONS (IN.)				SPECIFICATION	REMARKS
		W	V	CV	HW		
E1	WATER CLOSET, HET, ELONGATED BOWL, WALL HUNG, FLUSH VALVE, SENSOR, HARD-WIRED, 1.28 GPF	4"	2"	1-1/2"	-	FIXTURE: ZURN Z5615-BWL SEAT: CHURCH 950CT FLUSH VALVE: ZURN ZEM56000PL-HET MATERIAL: VITREOUS CHINA COLOR: WHITE CARRIER: ZURN Z-1203 SERIES	SEAT HEIGHT 15" AFF SEE NOTE 4 BELOW
E1A	WATER CLOSET, HET, ADA COMPLIANT, ELONGATED BOWL, WALL HUNG, FLUSH VALVE, SENSOR, HARD-WIRED, 1.28 GPF	4"	2"	1-1/2"	-	FIXTURE: ZURN Z5615-BWL SEAT: CHURCH 950CT FLUSH VALVE: ZURN ZEM56000PL-HET MATERIAL: VITREOUS CHINA COLOR: WHITE CARRIER: ZURN Z-1203 SERIES	SEAT HEIGHT 17"-19" AFF SEE NOTE 4 BELOW
E2	URINAL, HEU, ADA COMPLIANT, WALL MOUNTED, FLUSH VALVE, SENSOR, HARD-WIRED, 0.125 GPF	2"	1-1/2"	3/4"	-	FIXTURE: ZURN Z5758 FLUSH VALVE: ZURN ZEM56003PL-ULF COLOR: WHITE MATERIAL: VITREOUS CHINA CARRIER: ZURN FLOOR MOUNTED URINAL CARRIER	FIXTURE UP HEIGHT 24" AFF SEE NOTE 4 BELOW
E2A	URINAL, HEU, ADA COMPLIANT, WALL MOUNTED, FLUSH VALVE, SENSOR, HARD-WIRED, 0.125 GPF	2"	1-1/2"	3/4"	-	FIXTURE: ZURN Z5758 FLUSH VALVE: ZURN ZEM56003PL-ULF COLOR: WHITE MATERIAL: VITREOUS CHINA CARRIER: ZURN FLOOR MOUNTED URINAL CARRIER	FIXTURE UP HEIGHT 17" AFF SEE NOTE 4 BELOW
E3A	LAVATORY, ADA COMPLIANT, SINK UNDER-MOUNTED OVAL BOWL, GRID DRAIN, SENSOR FAUCET, HARD-WIRED, 0.25 GPC	2"	1-1/2"	1/2"	1/2"	FIXTURE: ZURN Z5230 DRAIN: ZURN Z9743 GRID STRAINER FAUCET: ZURN Z9950-XL-IM-S-CWB, 0.25 GPC P-TRAP: ZURN Z-8701 (1-1/2" X 1-1/2", 17 GA.) SUPPLIES/STOPS: ZURN 8806-LR-LK MATERIAL: VITREOUS CHINA	SEE NOTES 1 & 4 BELOW
E4A	ELECTRIC WATER COOLER, ADA WALL MOUNTED, SINGLE COOLER, STAINLESS STEEL FINISH, BOTTLE FILLER, FLEXIBLE BUBBLER	2"	1-1/2"	1/2"	-	FIXTURE: ELKAY LW45-1RPM20K P-TRAP: ZURN Z-8701 (1-1/2" X 1-1/2", 17 GA.) SUPPLIES/STOPS: ZURN 8806-LR-LK CARRIER: FLOOR MOUNTED CHAIR CARRIER	BUBBLER HEIGHT 34" AFF
E5A	2-COMP. STAINLESS STEEL SINK, ADA COMPLIANT, 42" X 18" X 5.5" (19" X 16" BOWLS), FOUR HOLE PUNCH, KITCHEN FAUCET, 1.5 GPM OUTLET, BASKET STRAINERS	2"	1-1/2"	1/2"	1/2"	FIXTURE: ELKAY ELUHAD4218 DRAIN: ELKAY LK35L BASKET STRAINER FAUCET: ZURN Z8230-XL-CPB-HS (1.5 GPM) P-TRAP: ZURN 8703 (1-1/2" X 2", 17 GA.) SUPPLIES/STOPS: ZURN 8806-LR-LK	PROVIDE MINIMUM CLEARANCES BELOW SINK TO MEET ADA REQUIREMENTS. SEE NOTE 1 & 5 BELOW
E5B	2-COMP. STAINLESS STEEL SINK, ADA COMPLIANT, 42" X 18" X 5.5" (19" X 16" BOWLS), FOUR HOLE PUNCH, KITCHEN FAUCET, 1.5 GPM OUTLET, BASKET STRAINERS	2"	1-1/2"	1/2"	1/2"	FIXTURE: ELKAY ELUHAD4218 DRAIN: ELKAY LK35L BASKET STRAINER FAUCET: ZURN Z8230-XL-CPB-HS (1.5 GPM) P-TRAP: ZURN 8703 (1-1/2" X 2", 17 GA.) SUPPLIES/STOPS: ZURN 8806-LR-LK	PROVIDE MINIMUM CLEARANCES BELOW SINK TO MEET ADA REQUIREMENTS. SEE NOTES 1 & 5 BELOW
E5C	LAUNDRY TUB, MOLDED COMPOSITE 21-1/2" X 23" X 19" (7-7/16" FLOOR MOUNTED) PROVIDE (1.5 GPM) AERATOR	2"	1-1/2"	1/2"	1/2"	FIXTURE: FIAT FL-1 FAUCET: ZURN Z8136G-XL (1.5 GPM) DRAIN: 1-1/2" PLUG DRAIN P-TRAP: ZURN 8703 (1-1/2" X 2", 17 GA.) SUPPLIES/STOPS: ZURN 8806-LR	PROVIDE ACCESSORY KIT WITH (4) LEGS
E5A	SHOWER, ROLL-IN ADA COMPLIANT, TRENCH DRAIN, PRESSURE BALANCED SHOWER VALVE, 1.5 GPM WALL SHOWERHEAD AND HAND HELD SHOWER WITH HOSE AND SLIDE BAR.	2"	1-1/2"	1/2"	1/2"	FIXTURE: COMFORT DESIGN XST 4232 TR.75 SHOWER TRIM: LEONARD 45055-02L-HY4-515P(G)30 DRAIN: ZURN Z5880, STAINLESS STEEL, GRATE TO BE SELECTED BY ARCH. P-TRAP: 2" TRAP	REFER TO ARCHITECTURAL DETAIL FOR ADDITIONAL SURROUND INFORMATION AND SHOWER TRIM HEIGHTS AND LOCATIONS. GROUT BASE SOLID
E7	MOP SINK TERRAZZO 28" X 28" X 12" BUMPER GUARDS	3"	1-1/2"	1/2"	1/2"	BASEIN: FIAT TSBCR-1100 DRAIN: FIAT 1453-BB FAUCET: FIAT 650-AA ACCESSORIES: MSG2828 SS WALL GUARDS ACCESSORIES: B32-AA HOSE & BRACKET ACCESSORIES: BR-CC MOP HANGER ACCESSORIES: E-49-AA BUMPERGUARDS	
E8	EMERGENCY EYE WASH / SHOWER POLISHED CHROME FINISH STAINLESS STEEL SHOWERHEAD AND RECEPTOR, WITH MIXING VALVE ADA COMPLIANT	4"	2"	1-1/4"	1"	FIXTURE: GUARDIAN GBF9055H-BC-TMV MOUNT PULL ROD AT ADA COMPLIANT HEIGHT TMV: GUARDIAN G300F	PROVIDE TEST KIT WITH TRAP FOR EYE WASH DRAIN AT BASE OF UNIT.
E9	EMERGENCY EYE WASH WALL MOUNTED, STAINLESS STEEL, STAY-OPEN BALL VALVE, TWO SPRAY HEADS, WITH MIXING VALVE	2"	1-1/2"	1/2"	1/2"	FIXTURE: GUARDIAN G1818AC-TMV MIXING VALVE: GUARDIAN G300LF P-TRAP: ZURN 8703 (1-1/2" X 2", 17 GA.)	INSTALL PER ANSI Z358.1
E10	EMERGENCY EYE WASH WALL MOUNTED, STAINLESS STEEL, STAY-OPEN BALL VALVE, TWO SPRAY HEADS	2"	1-1/2"	1/2"	1/2"	FIXTURE: GUARDIAN G1818AC P-TRAP: ZURN 8703 (1-1/2" X 2", 17 GA.)	INSTALL PER ANSI Z358.1
SA	SHOCK ARRESTOR	-	-	-	-	EQUIPMENT: SILOUX CHIEF 650 SERIES SIZE PER P.D.I. REQUIREMENTS	SEE SIZING TABLE THIS SHEET.
H81	WALL HYDRANT AUTOMATIC DRAINING, FREEZELESS, ANTI-SIPHON VACUUM BREAKER	-	-	3/4"	-	EQUIPMENT: WOODFORD 65EP	MOUNT 18" AFF.
H82	HOSE BIBB AUTOMATIC DRAINING, ANTI-SIPHON VACUUM BREAKER	-	-	3/4"	-	EQUIPMENT: WOODFORD 24	MOUNT 24" AFF.
H83	YARD HYDRANT NON-FREEZE, AUTOMATIC DRAINING, VACUUM BREAKER	-	-	3/4"	-	EQUIPMENT: WOODFORD Y95 FINISH: BRASS BOX	
ECO	FLOOR CLEANOUT ADJUSTABLE, CAST IRON BODY, COATED CAST IRON TOP	SEE DWG	-	-	-	CLEANOUT: ZURN ZN-1400	GAS / WATER TIGHT ABS PLUG
WCO	WALL CLEANOUT CAST IRON BODY, STAINLESS STEEL WALL PLATE	SEE DWG	-	-	-	CLEANOUT: ZURN ZS-1468	GAS / WATER TIGHT ABS PLUG
YCO	YARD CLEANOUT ADJUSTABLE, CAST IRON BODY, COATED CAST IRON TOP	SEE DWG	-	-	-	CLEANOUT: ZURN ZN-1474 IN AN 18" X 18" X 6" C.D. CONCRETE PAD.	GAS / WATER TIGHT ABS PLUG
CO	END OF LINE PLUG CLEANOUT CAST BRONZE	-	-	-	-	CLEANOUT: ZURN Z-1470	
ED1	FLOOR DRAIN CAST IRON BODY	SEE DWG	-	-	-	DRAIN: ZURN ZN-415-VP STRAINER: ZURN 6" O TYPE B FINISH: POLISHED NICKEL BRONZE	PROVIDE TRAP PRIMER WITH 1/2" COPPER SUPPLY TO TRAP.
ED2	FLOOR DRAIN, MECHANICAL ROOM CAST IRON BODY SEDIMENT BUCKET	SEE DWG	-	-	-	DRAIN: ZURN Z-556-Y STRAINER: ZURN 8" O FINISH: COATED CAST IRON	SEE NOTE 2 BELOW. PROVIDE TRAP PRIMER CONNECTION AS REQUIRED
ID1	TRENCH DRAIN, 6"-8" LONG, INTEGRAL FRAMES, DUCTILE IRON	4"	2"	-	-	DRAIN: ZURN Z886-HD-DGC, 1 SECTION WITH 2 CLOSED END CAPS AND A 4" BOTTOM OUTLET P-TRAP: ZURN Z-1203	
NOT USED							
E11	TRAP PRIMER PROVIDE DISTRIBUTION UNIT WHEN SERVING MORE THAN ONE DRAIN	-	-	1/2"	-	PRIMER: PPP OREGON #1	PROVIDE TRAP PRIMER WITH 1/2" COPPER SUPPLY TO TRAP.
IMB1	ICE MAKER BOX	-	-	1/2"	-	EQUIPMENT: GLY GRAY BBI-875 MATERIAL: 16 GAUGE STEEL WITH EPOXY FINISH	
IMB	INDIRECT WASTE BOX RECESSED WHITE ABS BOX & FRAME, WITH INTEGRAL SHOCK ARRESTOR	2"	1-1/2"	-	-	FIXTURE: SILOUX CHIEF 696-3 "OX BOX" FUNNEL: SILOUX CHIEF 696-CF, 1-1/2" AIR GAP	
CS1	BALANCING VALVE	-	-	3/4"	-	EQUIPMENT: CIRCUIT SOLVER CS-3/4"-120	PROVIDE 3/4"-120 UNLESS OTHERWISE NOTED ON PLAN.
NOTES:							
1. PROVIDE PRE-MANUFACTURED INSULATION KIT FOR EXPOSED TRIM UNDER SINK. COORDINATE WITH ARCHITECT PRIOR TO ORDERING.			2. PROVIDE SURESEAL INLINE FLOOR DRAIN TRAP SEALER IN FLOOR DRAIN FOR WATERLESS TRAP PRIMER.			3. CONTRACTOR SHALL VERIFY IF GF1 TYPE ELECTRICAL OUTLET IS REQUIRED WITH ELECTRICAL CONTRACTOR. PROVIDE GF1 TYPE OUTLET IF REQUIRED.	
4. PROVIDE "HWG" HARD-WIRED CONVERTER AND "MU" MINI JUNCTION BOX IN EACH ROOM AT FIXTURE LOCATION TO POWER UP TO 8 SEASON FIXTURES. COORDINATE WITH E.C. AND ARCHITECT PRIOR TO PERFORMING ANY WORK.			5. PROVIDE VALVED CW SUPPLY TO ADJACENT ICEMAKER. PROVIDE BACKFLOW PREVENTER EQUAL TO WATTS S23 PRIOR TO CONNECTION TO ICEMAKER. DRAIN BACKFLOW PREVENTER AND ICEMAKER TO FLOOR DRAIN WITH AIR GAP. PROVIDE TRAP PRIMER WITH 1/2" CW SUPPLY FOR ICEMAKER FLOOR DRAIN.				
APPROVED EQUALS:		SPECIFIED PRODUCT:		ACCEPTED EQUAL:			
THE CONTRACTOR IS RESPONSIBLE FOR PROVIDING THE MODEL WHICH MOST CLOSELY MATCHES THE SPECIFIED PRODUCT. PROVIDE PRODUCTS MADE BY THE MANUFACTURER'S LISTED.		ZURN (VITREOUS CHINA FIXTURES) ZURN (SENSOR FLUSH VALVES) ZURN (SENSOR FAUCETS) ZURN (MANUAL FAUCETS) ELKAY (S.S. SINKS) ELKAY (WATER COOLERS) ZURN (SUPPLY STOPS) ZURN (DRAINS, CARRIERS) FIAT (UTILITY) LEONARD (SHOWER VALVES)		AMERICAN STANDARD, KOHLER, TOTO KOHLER, SLOAN, TOTO CHICAGO, KOHLER, SLOAN, TOTO CHICAGO, KOHLER ACCORN, JUST HAWES, OASIS BRASSCRAFT, E.B.C., MCGUIRE J.R. SMITH, WADE FLORESTONE, STERN WILLIAMS DELTA, MOEN COMMERCIAL, LAWLER, SYMMONS			

GAS-FIRED WATER HEATER SCHEDULE

SYM.	DESCRIPTION	STORAGE (GALLONS)	GAS BURNER DATA				SELECTION BASED ON		REMARKS
			INLET PRESS. (IN. W.C.)	BTU/HR INPUT	GPH RECOVERY @ 80°F RISE	FLUE SIZE	MANUFACTURER	MODEL	
WH1	GAS FIRED WATER HEATER	100	8	150,000	223	4"	A.O. SMITH	BTH-150	1-6

REMARKS:
 1. EQUIVALENT MANUFACTURERS: BRADFORD WHITE, LOCHINVAR.
 2. ELECTRICAL REQUIREMENTS: 120V, 15 AMP BREAKER.
 3. WATER HEATER SHALL MEET OR EXCEED THE REQUIREMENTS OF ASHRAE 90.1.
 4. PROVIDE HEATER WITH ACID NEUTRALIZATION KIT FOR CONDENSATE.
 5. INSTALL DIRECT VENT PIPING PER MANUFACTURER'S DIRECTIONS. CPVC PIPING OR STAINLESS STEEL SHALL BE USED FOR VENT PIPING MATERIAL. PVC PIPING IS NOT ACCEPTABLE.
 6. PROVIDE CARBON MONOXIDE DETECTOR ADJACENT TO WATER HEATERS. INTERLOCK CARBON MONOXIDE DETECTOR WITH BAS.

ELECTRIC WATER HEATER SCHEDULE

SYM.	DESCRIPTION	STORAGE (GALLONS)	GPH RECOVERY	ELECTRICAL DATA				SELECTION BASED ON		REMARKS
				KW	VOLTS	PHASE	HERTZ	MANUFACTURER	MODEL	
WH2	TANKLESS WATER HEATER	-	61°F RISE @ 1.0 GPM	9.0	277	1	60	EEMAX	EX90T	4
WH3	TANKLESS WATER HEATER	-	56°F RISE @ 0.5 GPM	4.1	277	1	60	EEMAX	EX4277T EE	4
WH4	ELECTRIC WATER HEATER	120	221 GPH @ 100°F RISE	54.0	480	3	60	A.O. SMITH	DRE-120-54.0	1,2,3

REMARKS:
 1. EQUIVALENT MANUFACTURERS: BRADFORD WHITE, LOCHINVAR.
 2. WATER HEATER SHALL MEET OR EXCEED THE REQUIREMENTS OF ASHRAE 90.1
 3. BASIS-OF-DESIGN WATER HEATER CONTAINS (9) 6.0 KW ELEMENTS, WITH SIMULTANEOUS OPERATION.
 4. EQUIVALENT MANUFACTURERS: BOSCH, BRADFORD WHITE, CHRONOMITE.

EXPANSION TANK SCHEDULE

SYM.	DESCRIPTION	VOLUME (GALLONS)	DIAMETER (INCHES)	HEIGHT (INCHES)	SELECTION BASED ON		REMARKS
					MANUFACTURER	MODEL	
ET1	BLADDER TYPE EXPANSION TANK	6.4	12	15.375	AMTROL	ST-12	1, 2
ET4	BLADDER TYPE EXPANSION TANK	6.4	12	15.375	AMTROL	ST-12	1, 2

REMARKS:
 1. EQUIVALENT MANUFACTURERS: BELL & GOSSETT, WESSELS COMPANY.
 2. EXPANSION TANK SHALL BE CHARGE TO MEET FINAL OPERATING PRESSURE FOR DOMESTIC WATER SYSTEM.

PUMP SCHEDULE

SYM.	DESCRIPTION	TYPE	CAPACITY		ELECTRICAL DATA				SELECTION BASED ON		REMARKS
			GPM	HEAD (FT)	HP	VOLTS	PH	HZ	MANUFACTURER	MODEL	
BCP1	HW RECIRC PUMP	IN-LINE	4	6	1/12	120	1	60	BELL & GOSSETT	NBF-9F/LW	1,2,3
BCP4	HW RECIRC PUMP	IN-LINE	4	6	1/12	120	1	60	BELL & GOSSETT	NBF-9F/LW	1,2,3
BP1	DUPLEX VARIABLE SPEED WATER BOOSTER PACKAGE	END SUCTION	60 EACH	104	5 EACH	480	3	60	HY-FAB	MVP-850-460	1,4,5

REMARKS:
 1. EQUIVALENT MANUFACTURERS: GRUNDFOS, TACO, PACE
 2. PUMP SHALL BE ALL BRONZE CONSTRUCTION.
 3. PROVIDE AUTOMATIC TIMER KIT AND AQUASTAT EQUAL TO BELL & GOSSETT MODEL TC-1 AND AGS-3/4
 4. PROVIDE BOOSTER PUMP PACKAGE WITH FX-60 HYDRO-PNEUMATIC TANK
 5. PROVIDE WITH BACNET MS/TP COMMUNICATION MODULE FOR OUTPUT TO BAS. COORDINATE CONNECTION TO BAS SYSTEM WITH CONTROLS CONTRACTOR.

MIXING VALVE SCHEDULE

SYM.	DESCRIPTION	MAXIMUM GPM	MINIMUM GPM	PRESSURE LOSS (PSI)	LEAVING WATER TEMP. (°F)	SELECTION BASED ON		REMARKS
						MANUFACTURER	MODEL	
MV1	THERMOSTATIC MIXING VALVE CONTROL STATION	115	1	5	115	LEONARD	4NB-LF	1,2
MV2	THERMOSTATIC MIXING VALVE	4.5	0.5	5	110	SYMMONS	7-225-CK SERIES	1

REMARKS:
 1. EQUIVALENT MANUFACTURERS: LAWLER, POWERS
 2. HIGH-LOW MANIFOLD.
















INTERCEPTOR SCHEDULE

SYM.	DESCRIPTION	INLET/OUTLET SIZE	FLOW RATE (GPM)	CAPACITY		SELECTION BASED ON		REMARKS
				WATER (GALLONS)	OIL (GALLONS)	MANUFACTURER	MODEL	
Q11	OIL INTERCEPTOR	4	100	300	156	PROCEPTOR	OMC 300	1,2,3

REMARKS:
 1. EQUIVALENT MANUFACTURERS: SCHEIR, XERXES, HIGHLAND TANK, ZURN
 2. INSTALL BELOW GRADE FOR HEAVY VEHICULAR TRAFFIC
 3. PROVIDE MULTI-LEVEL OIL MONITOR

BACKFLOW PREVENTER SCHEDULE

SYM.	DESCRIPTION	SYSTEM	DESCRIPTION	MANUF.	MODEL	COMMENTS
BP1	REDUCED PRESSURE PRINCIPLE ASSEMBLY	DOMESTIC WATER	REDUCED PRESSURE PRINCIPLE ASSEMBLY 2"	ZURN WILKINS	375V-OSY	
BP2	REDUCED PRESSURE PRINCIPLE ASSEMBLY	MAKE-UP WATER	REDUCED PRESSURE PRINCIPLE ASSEMBLY 1"	ZURN WILKINS	975XL	

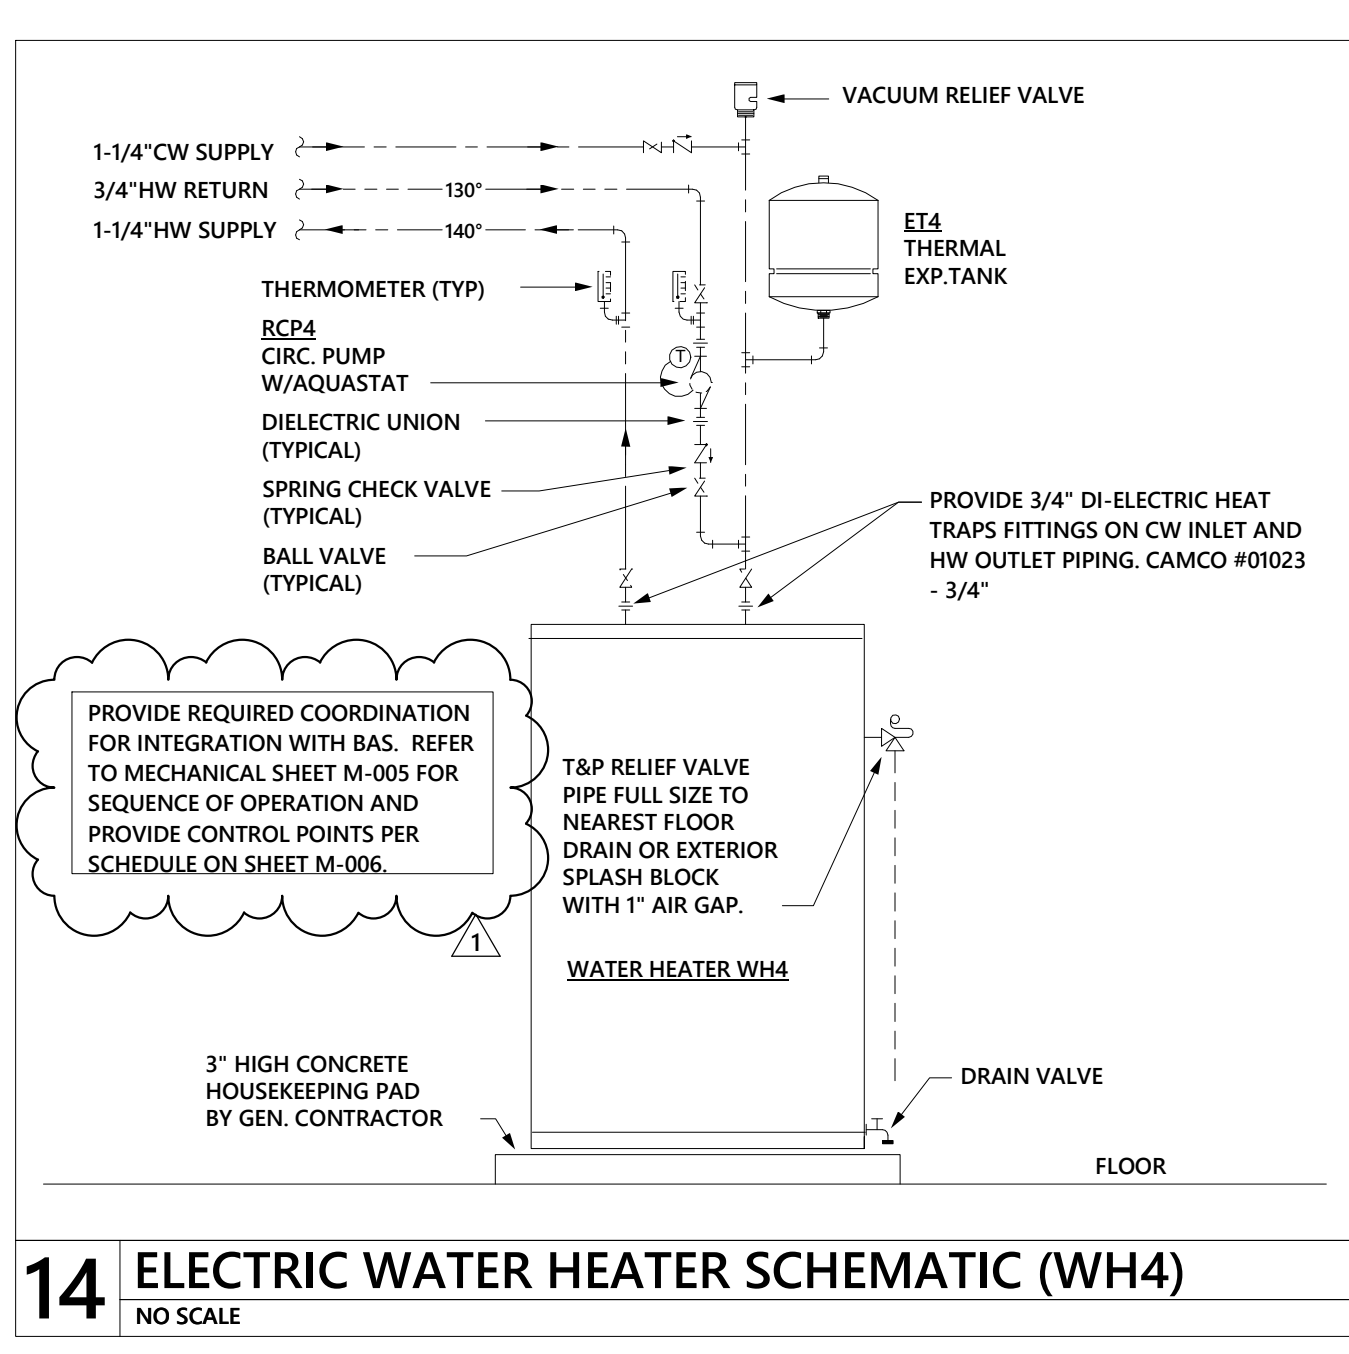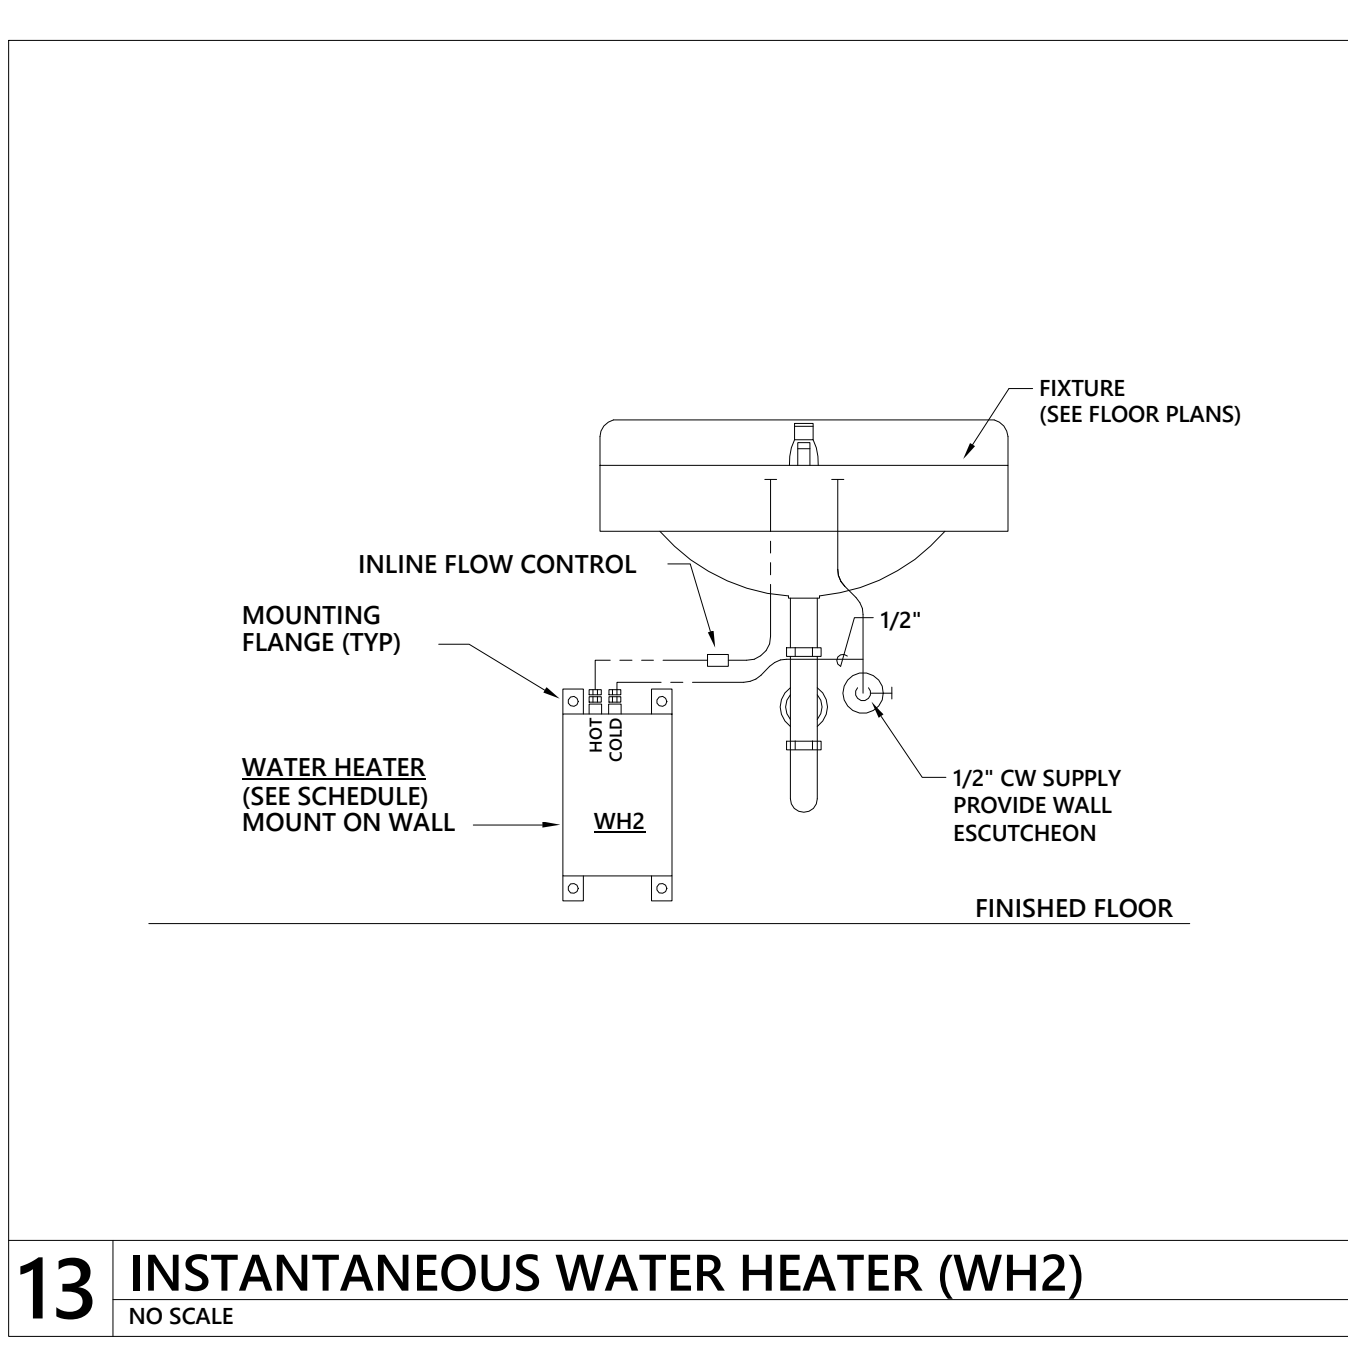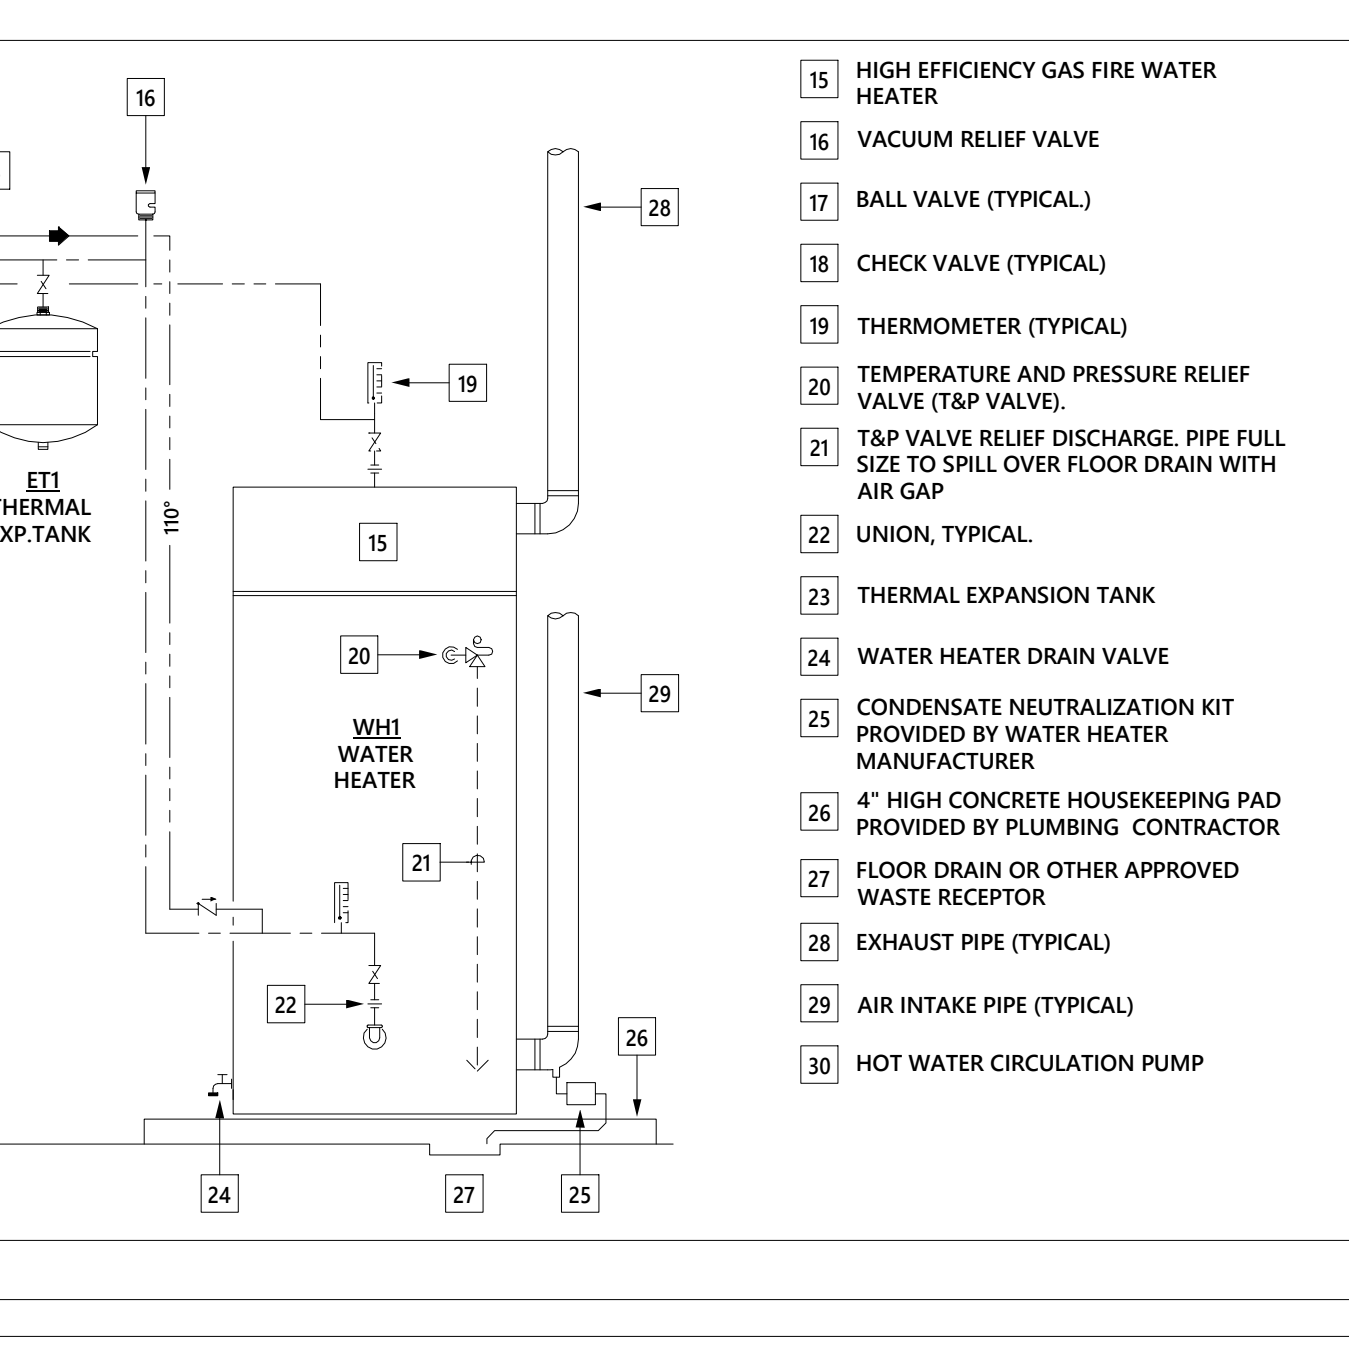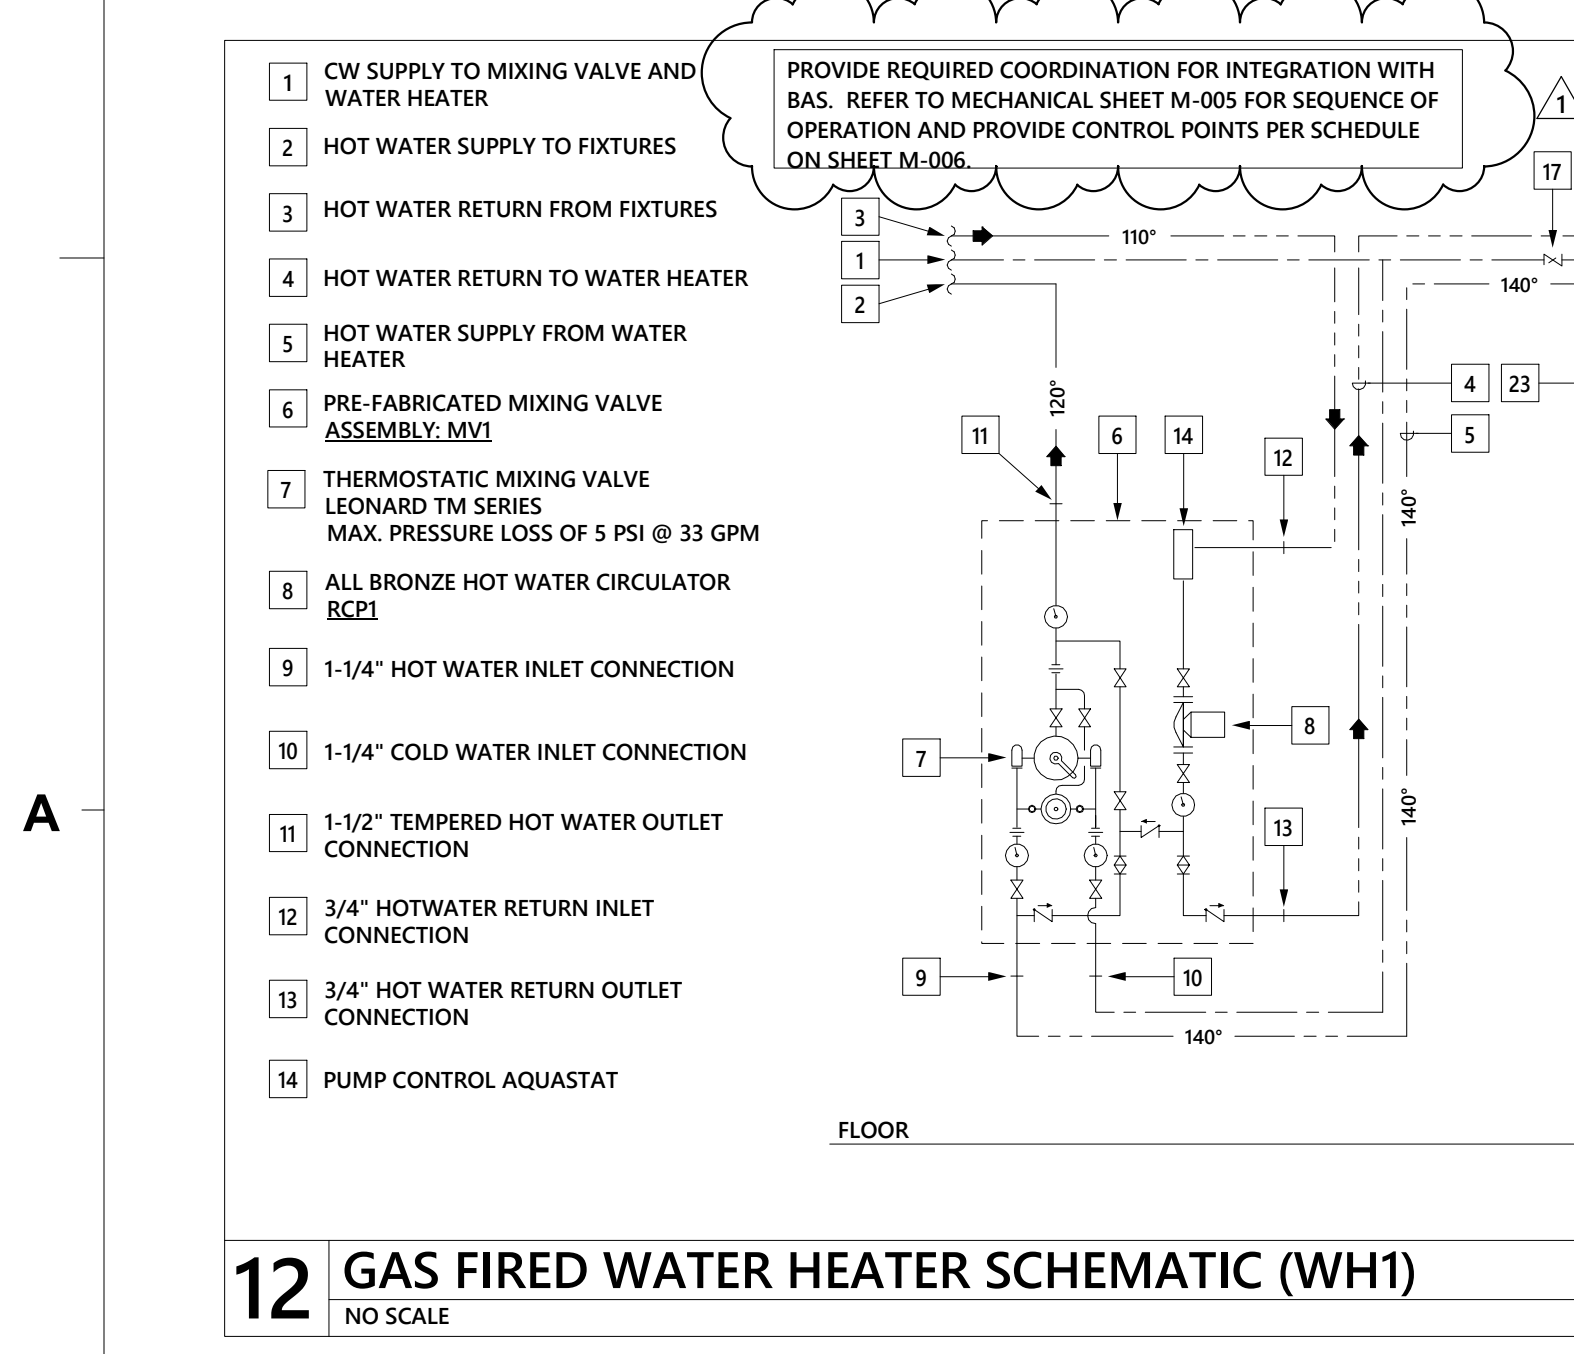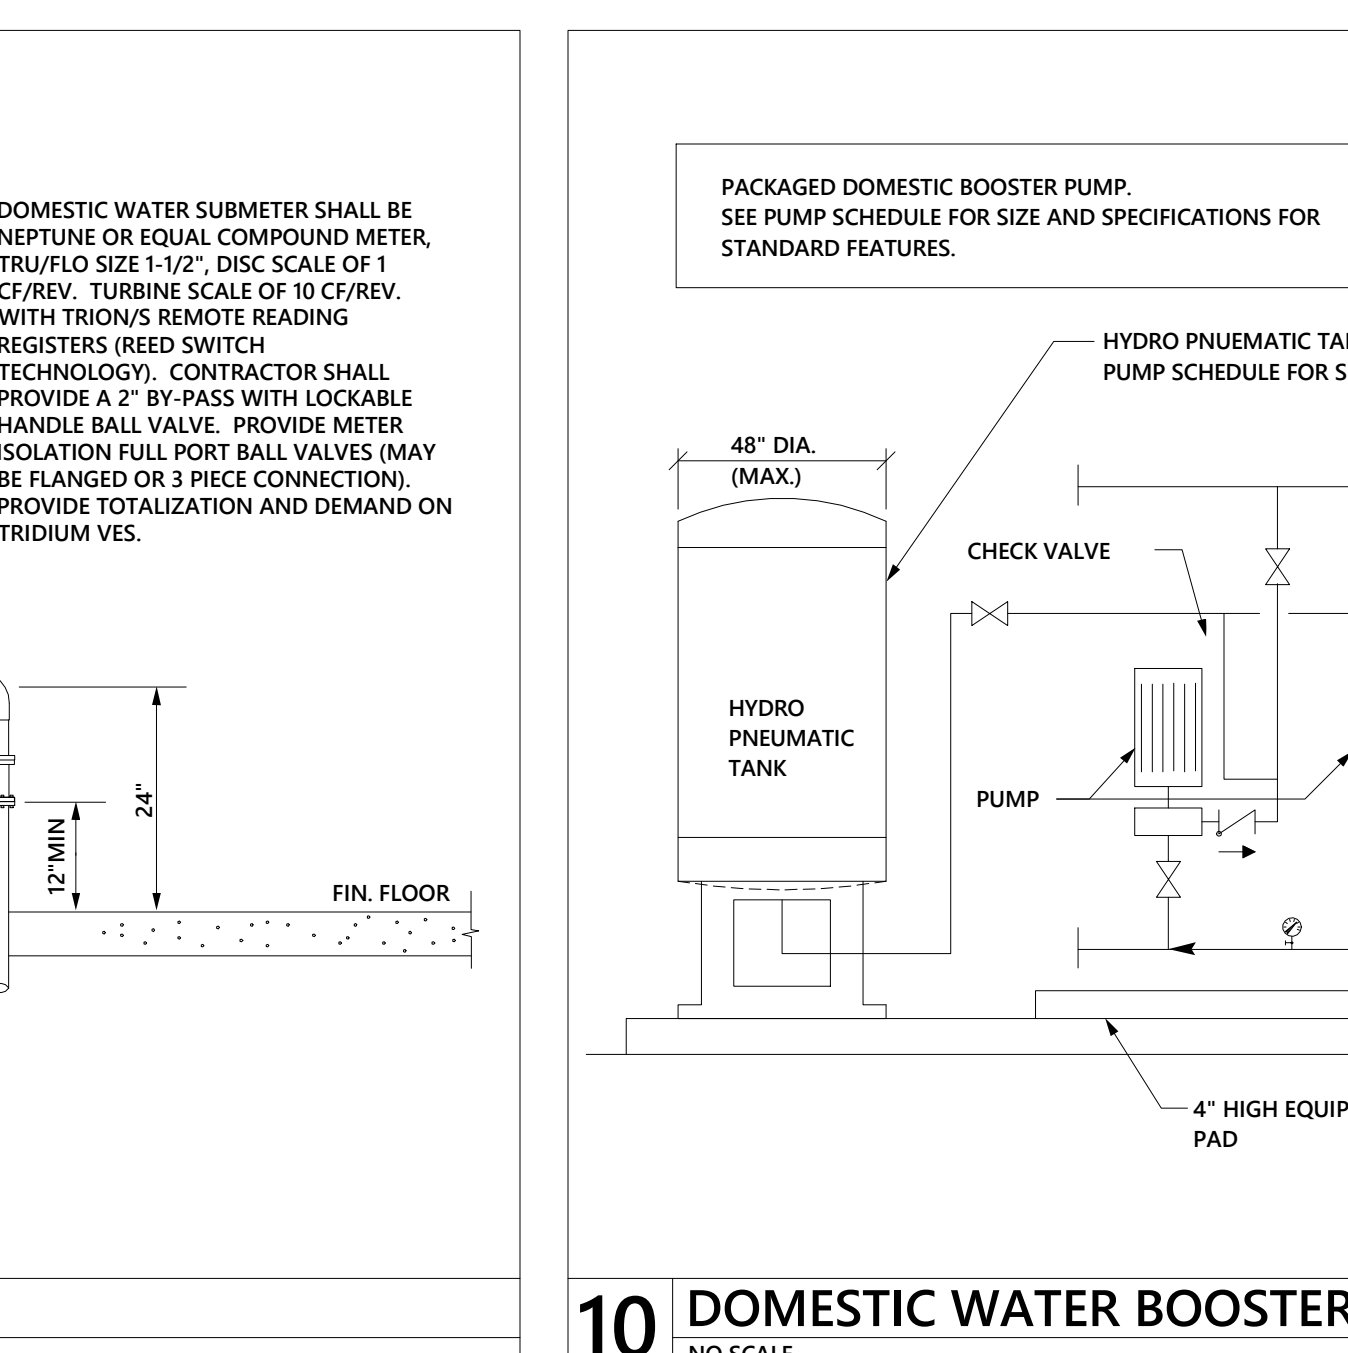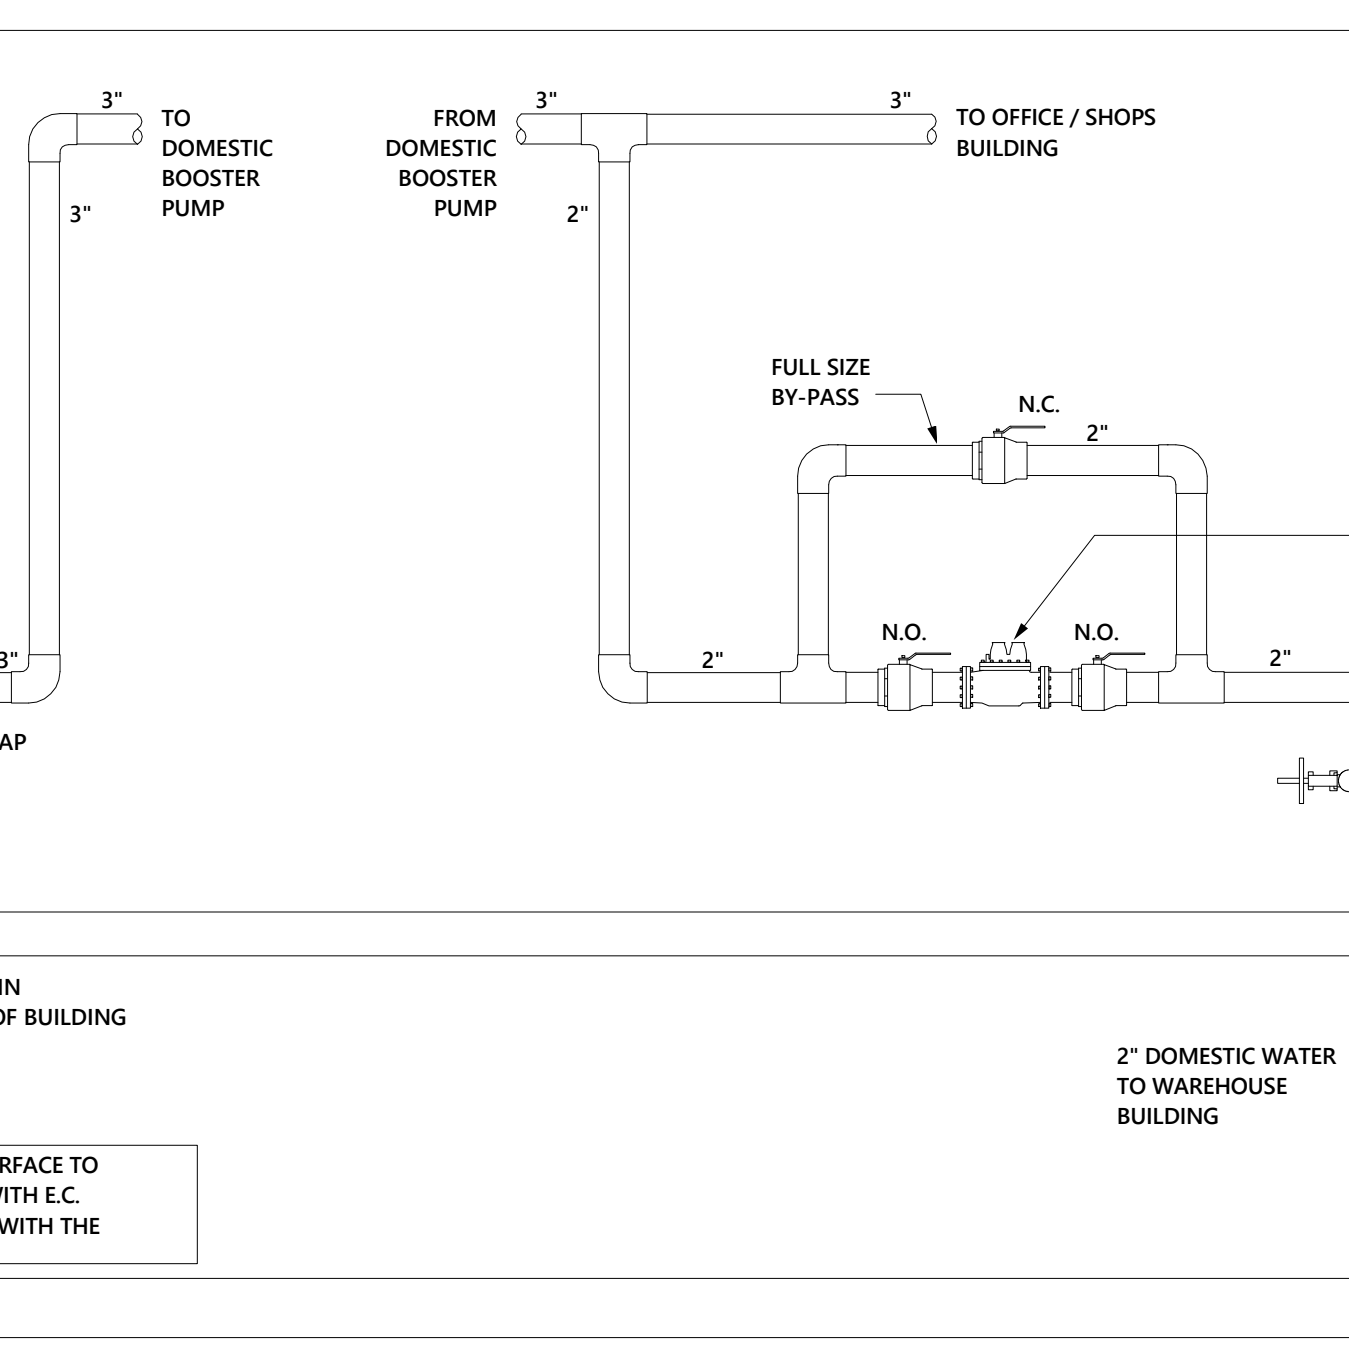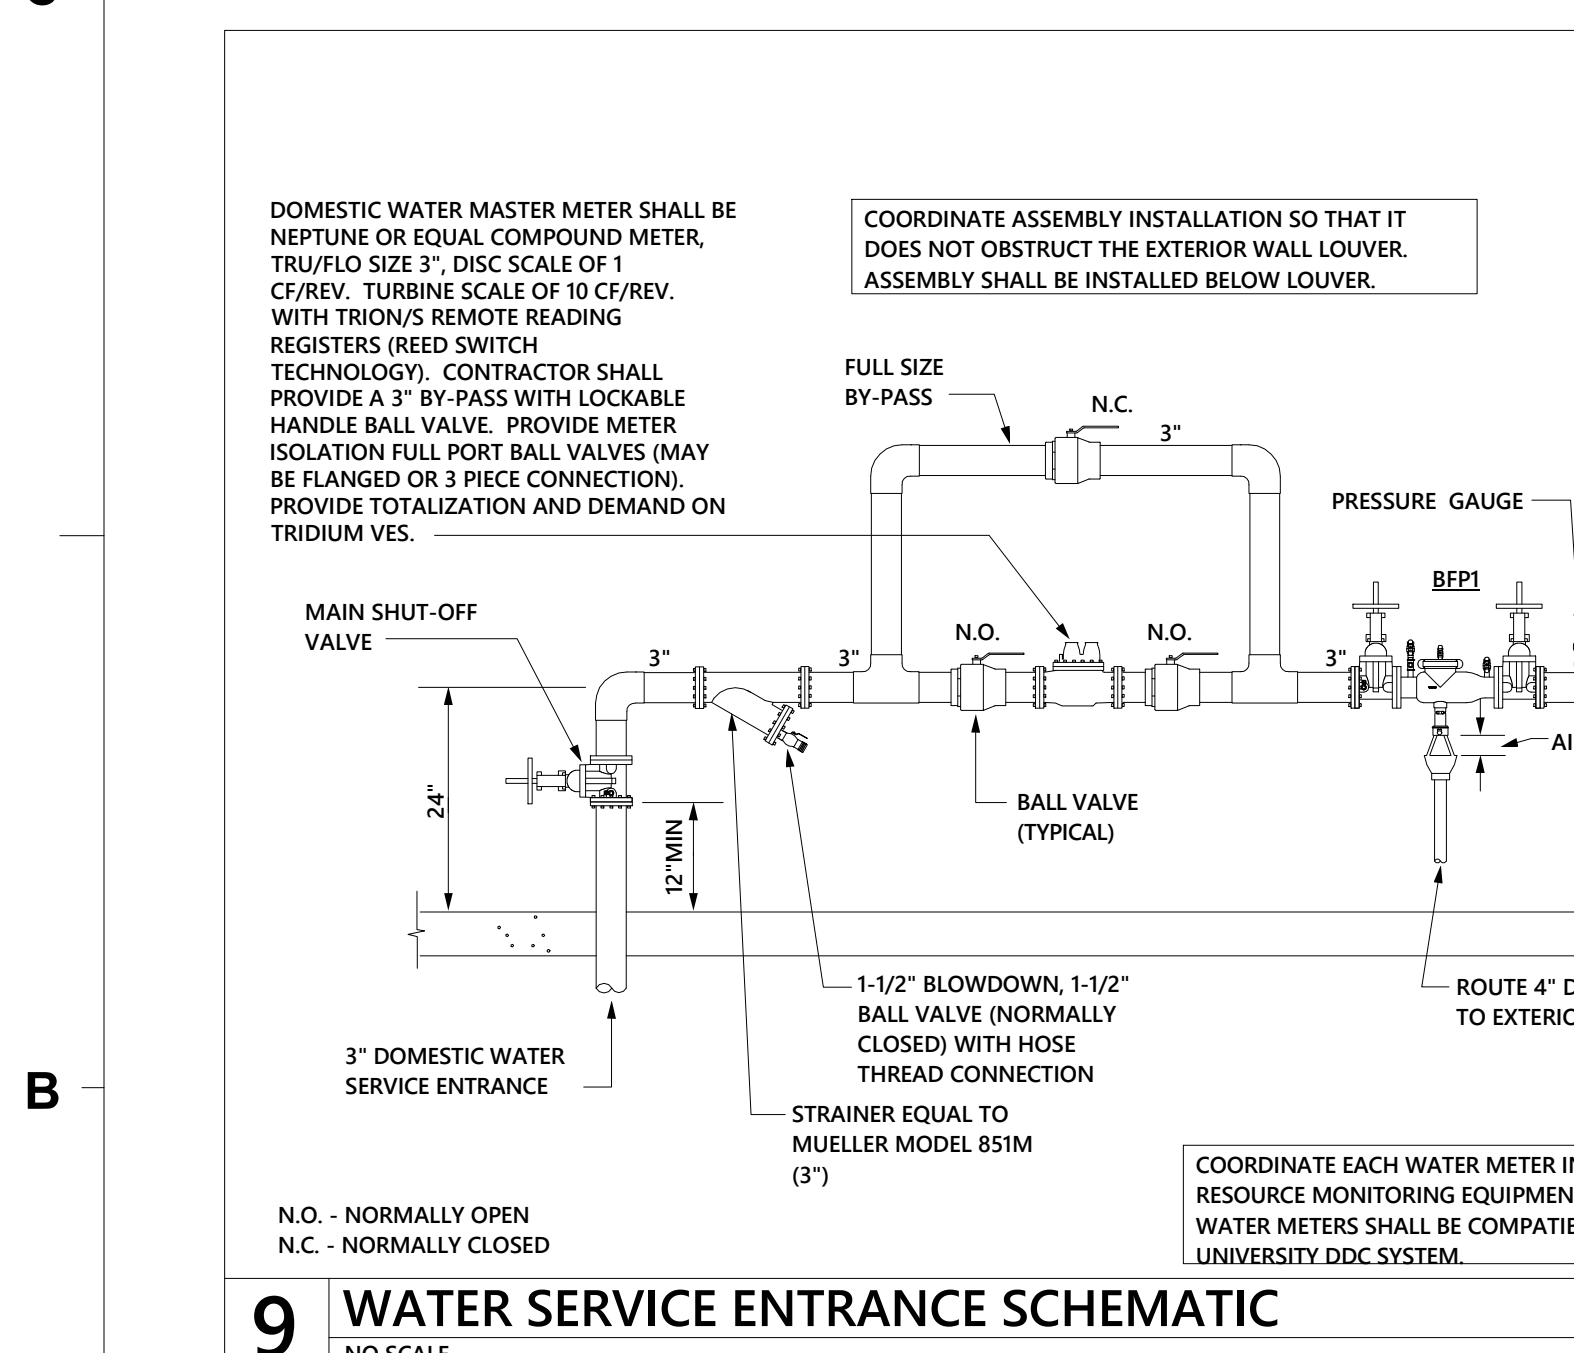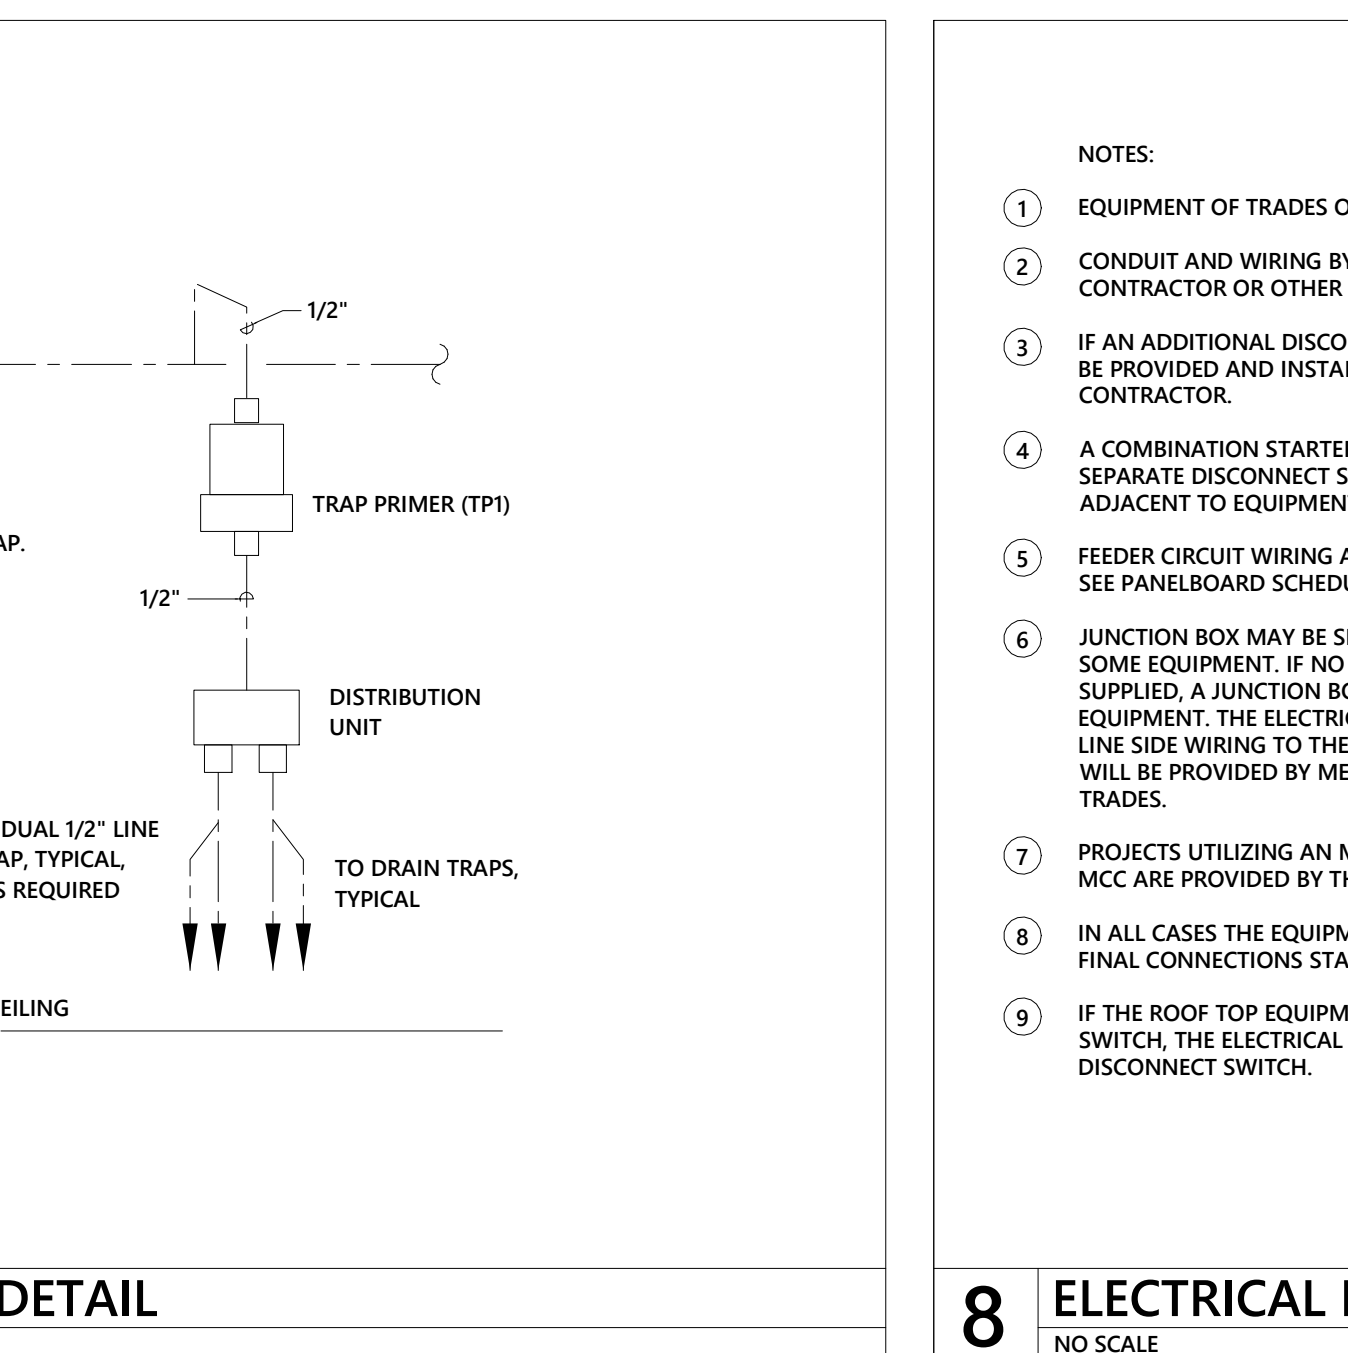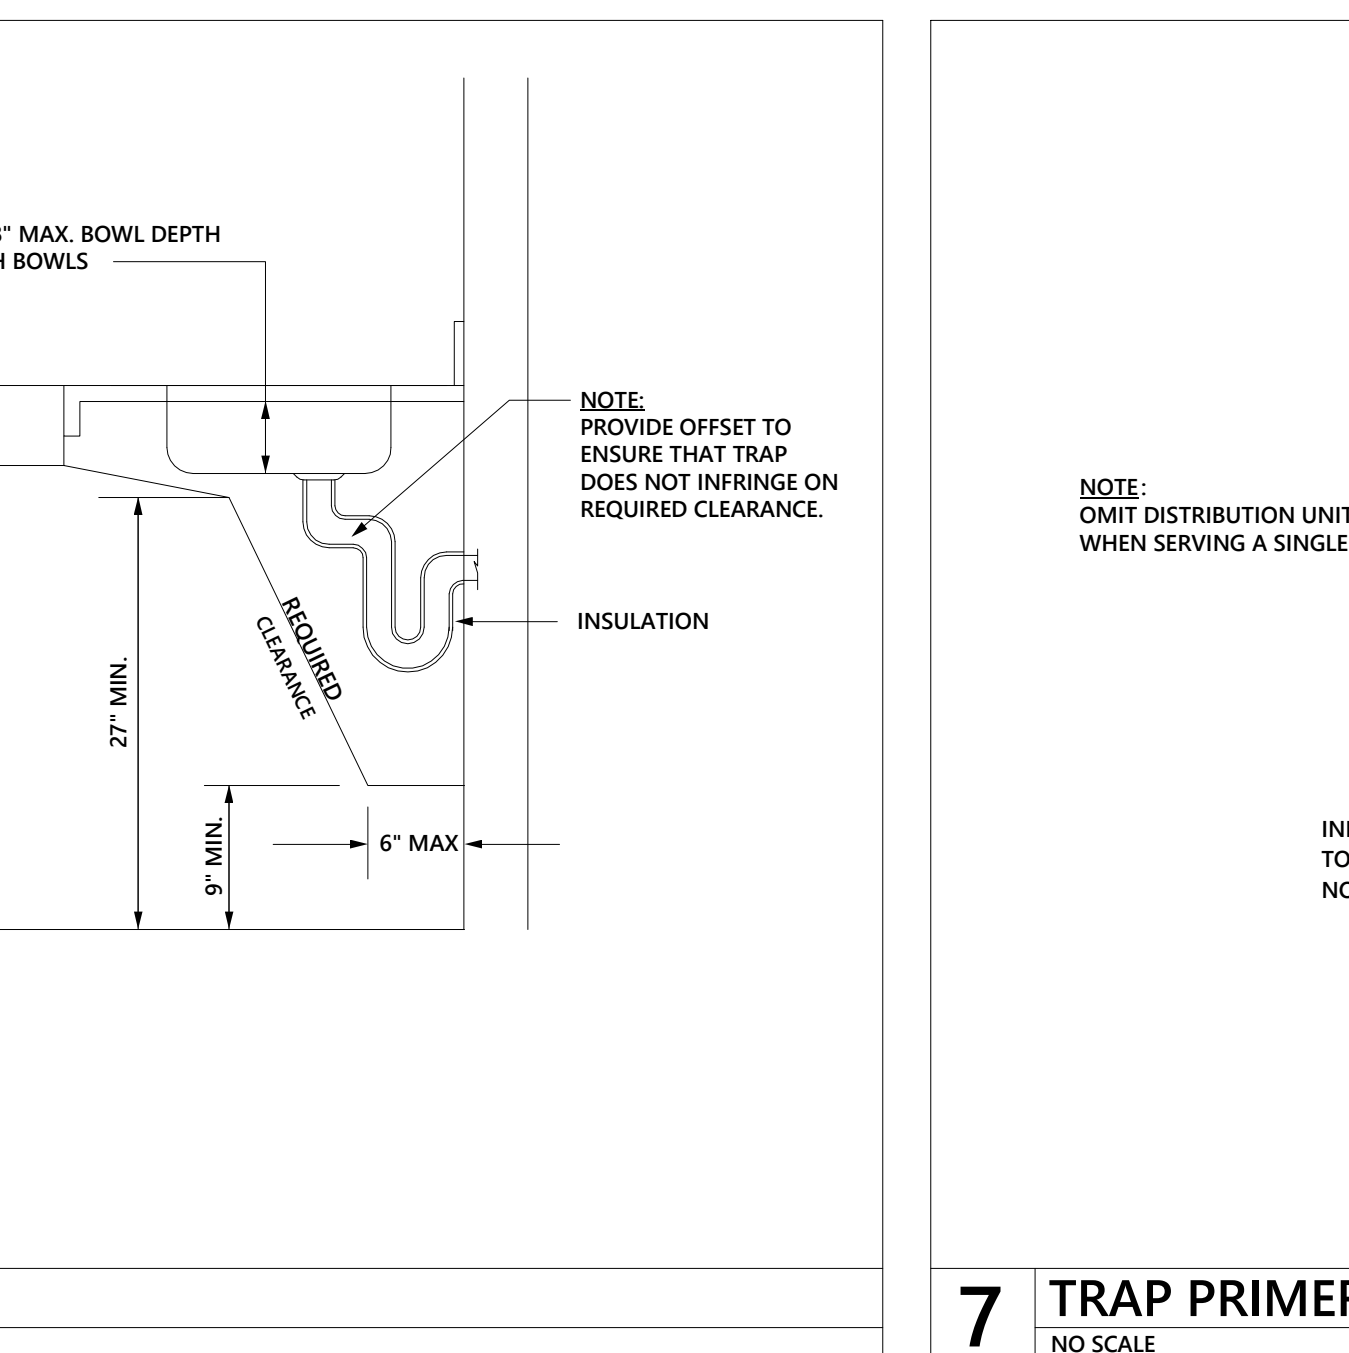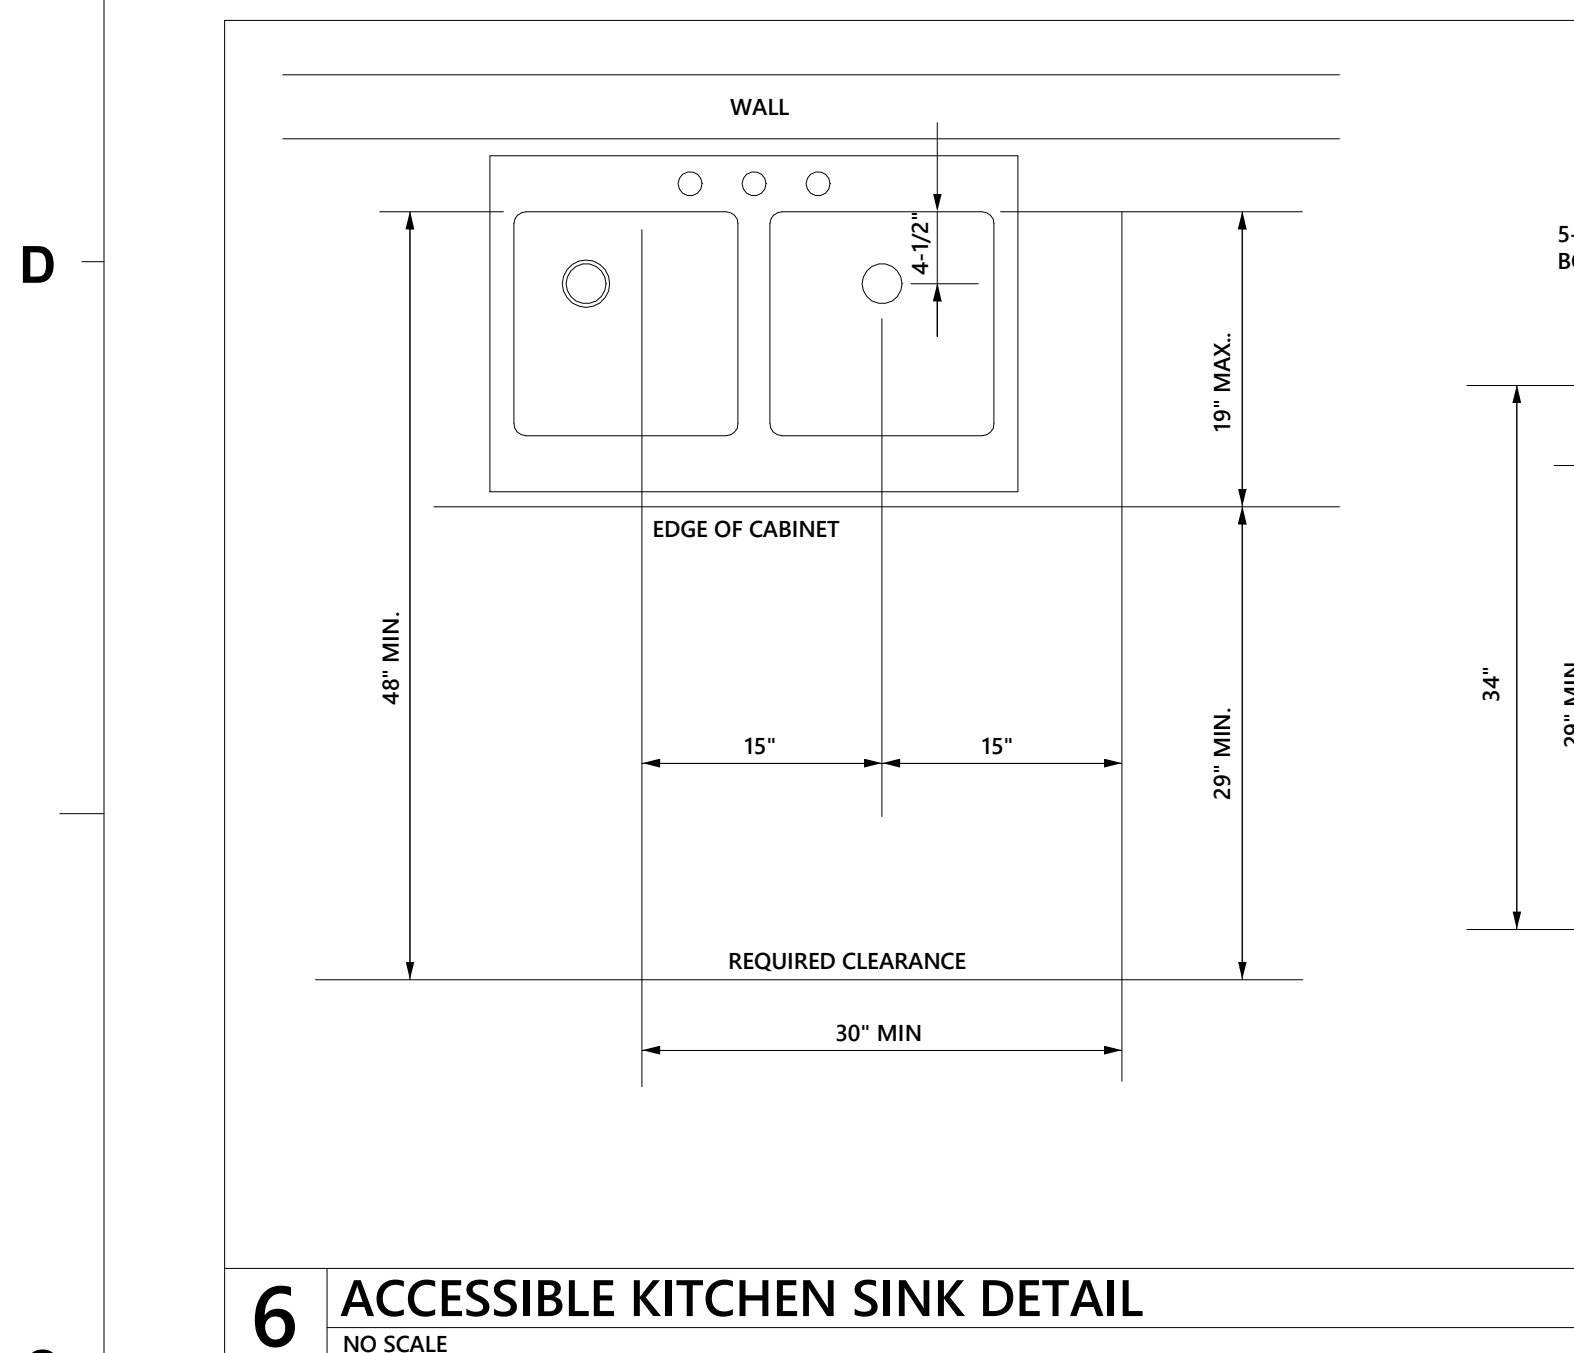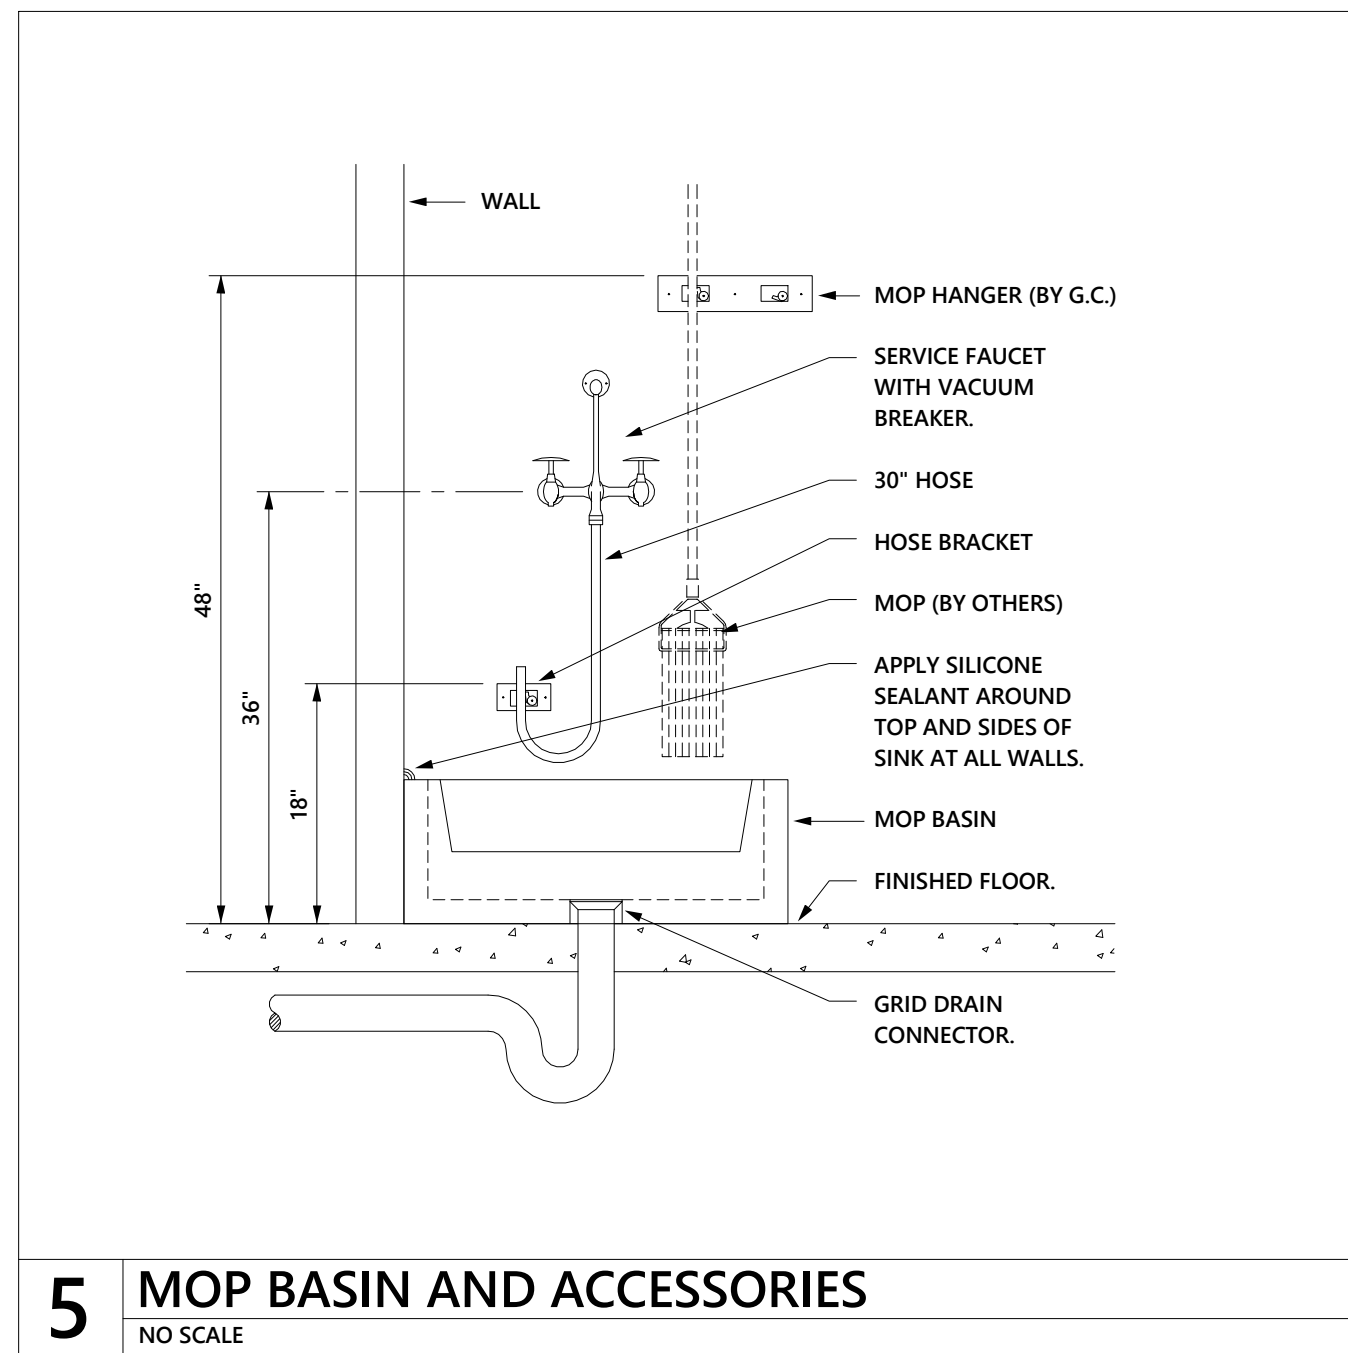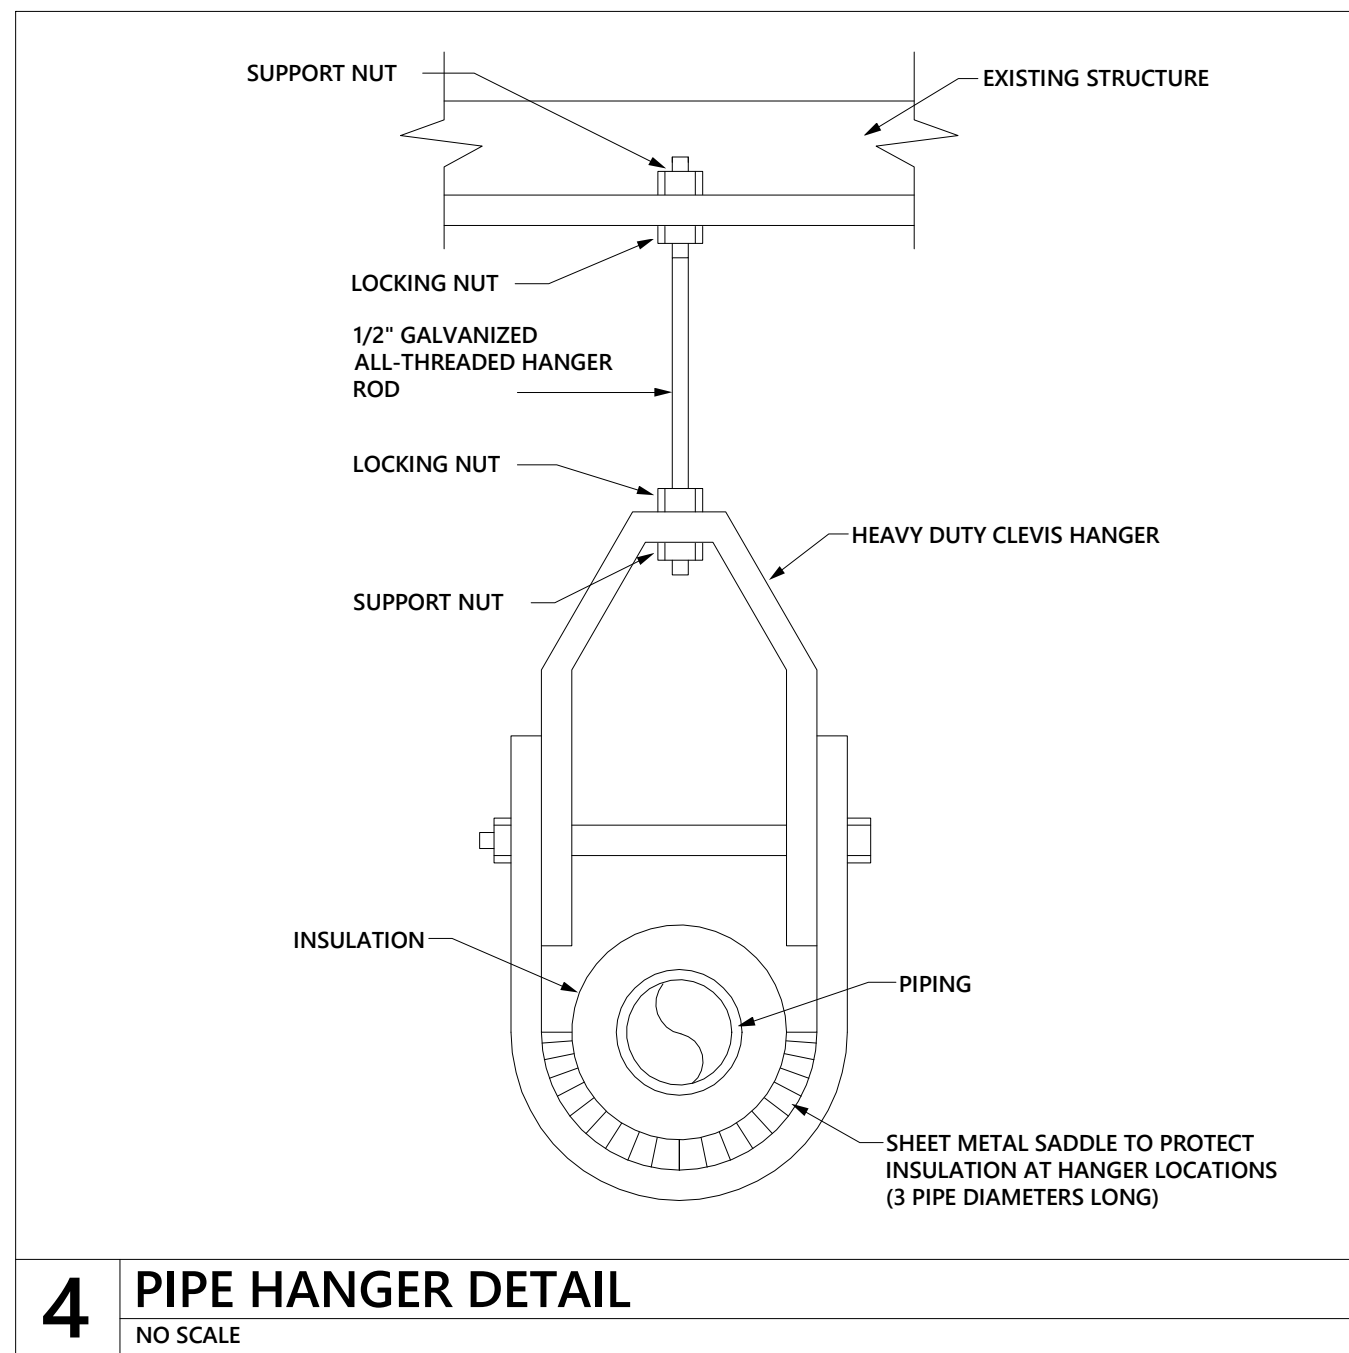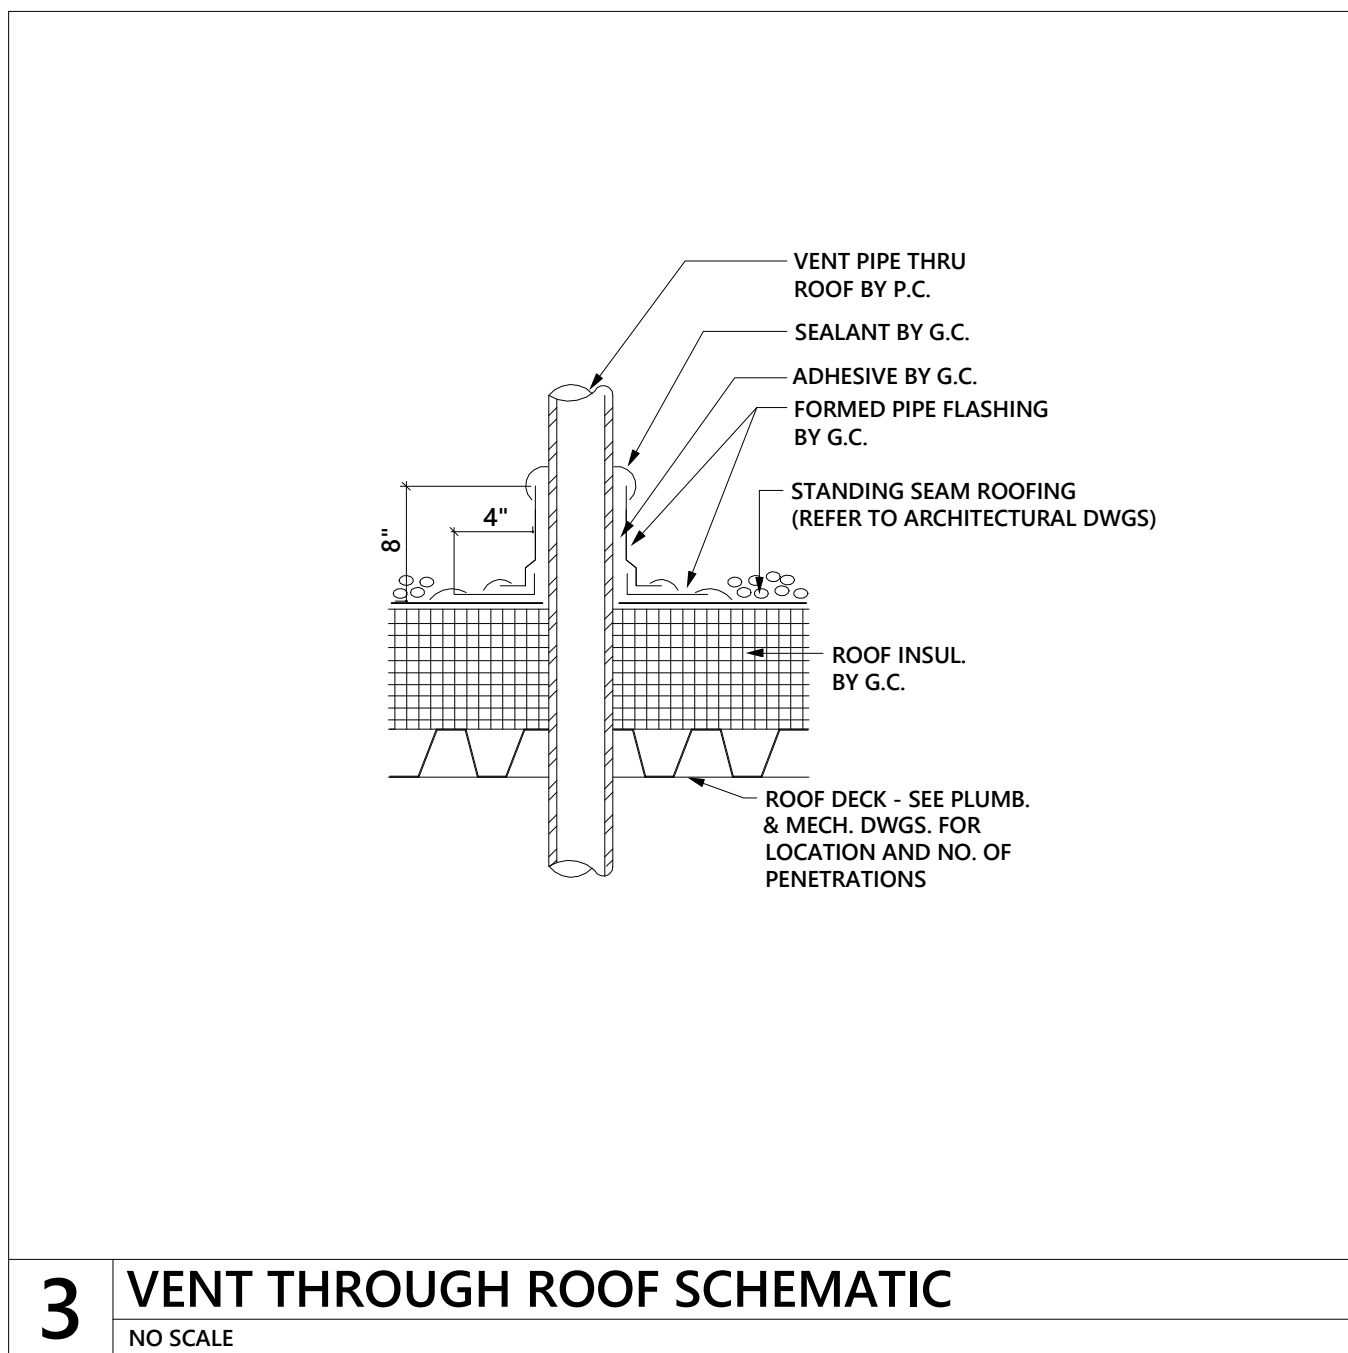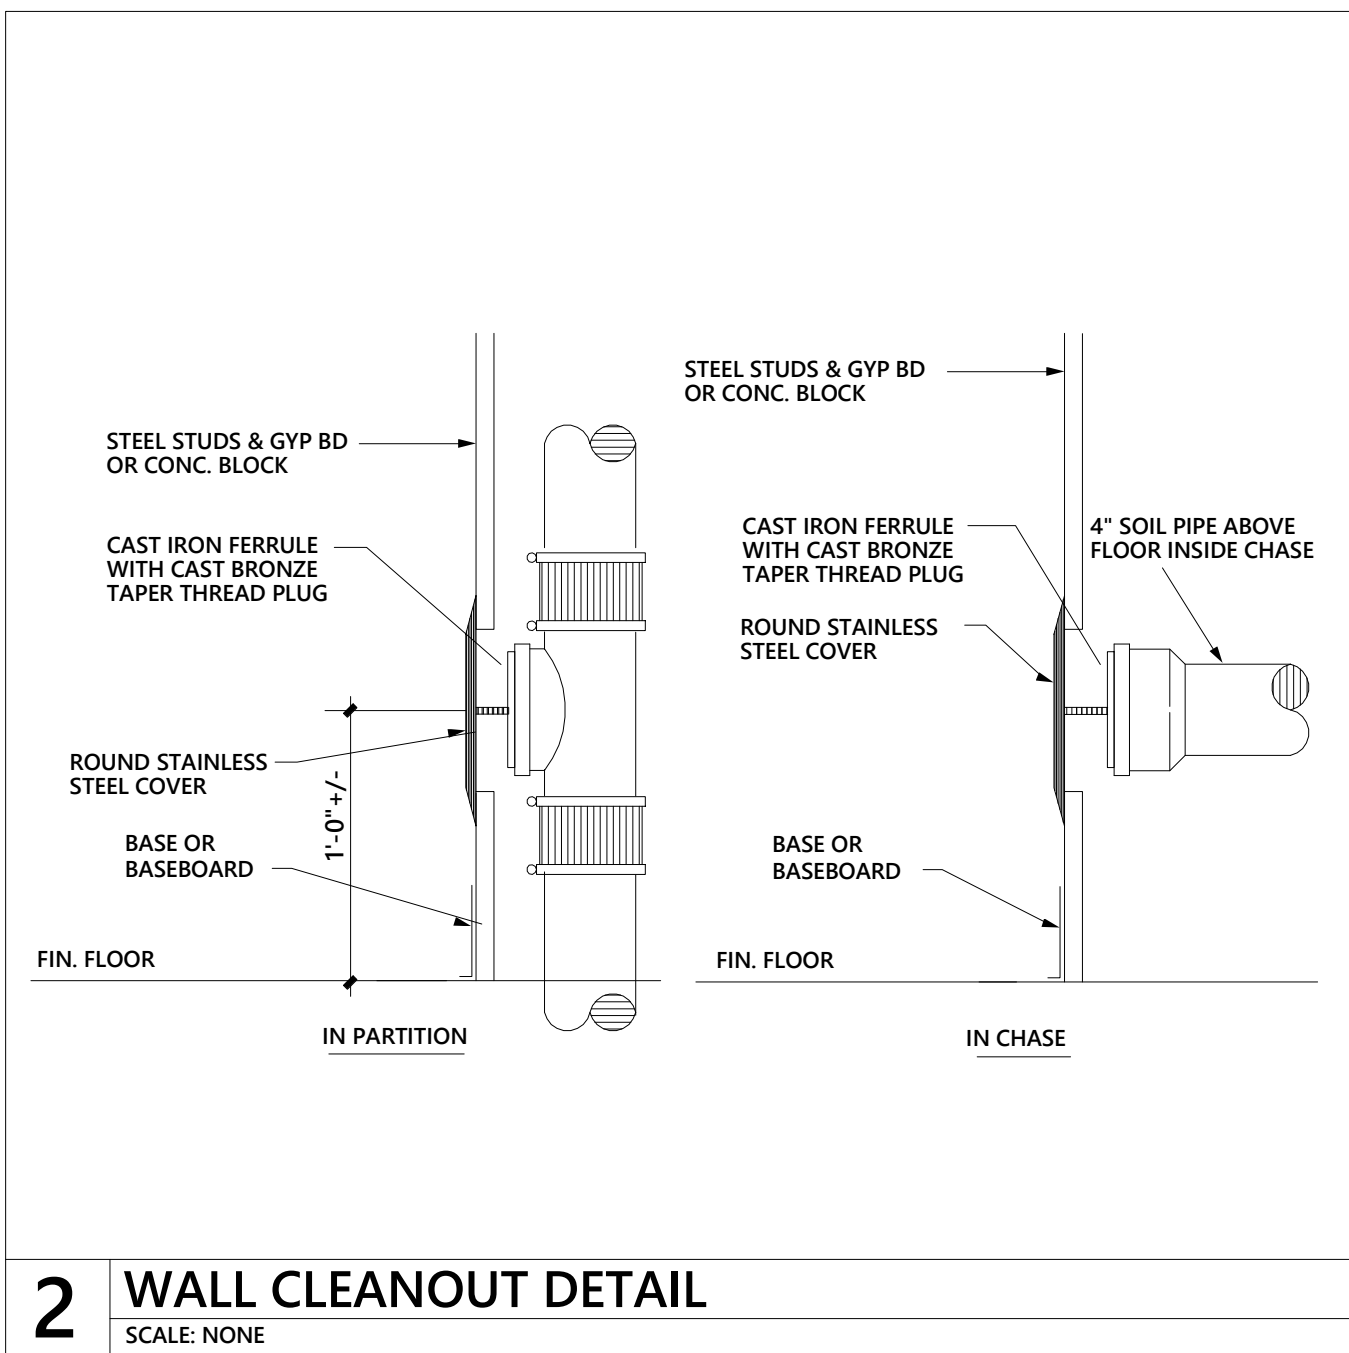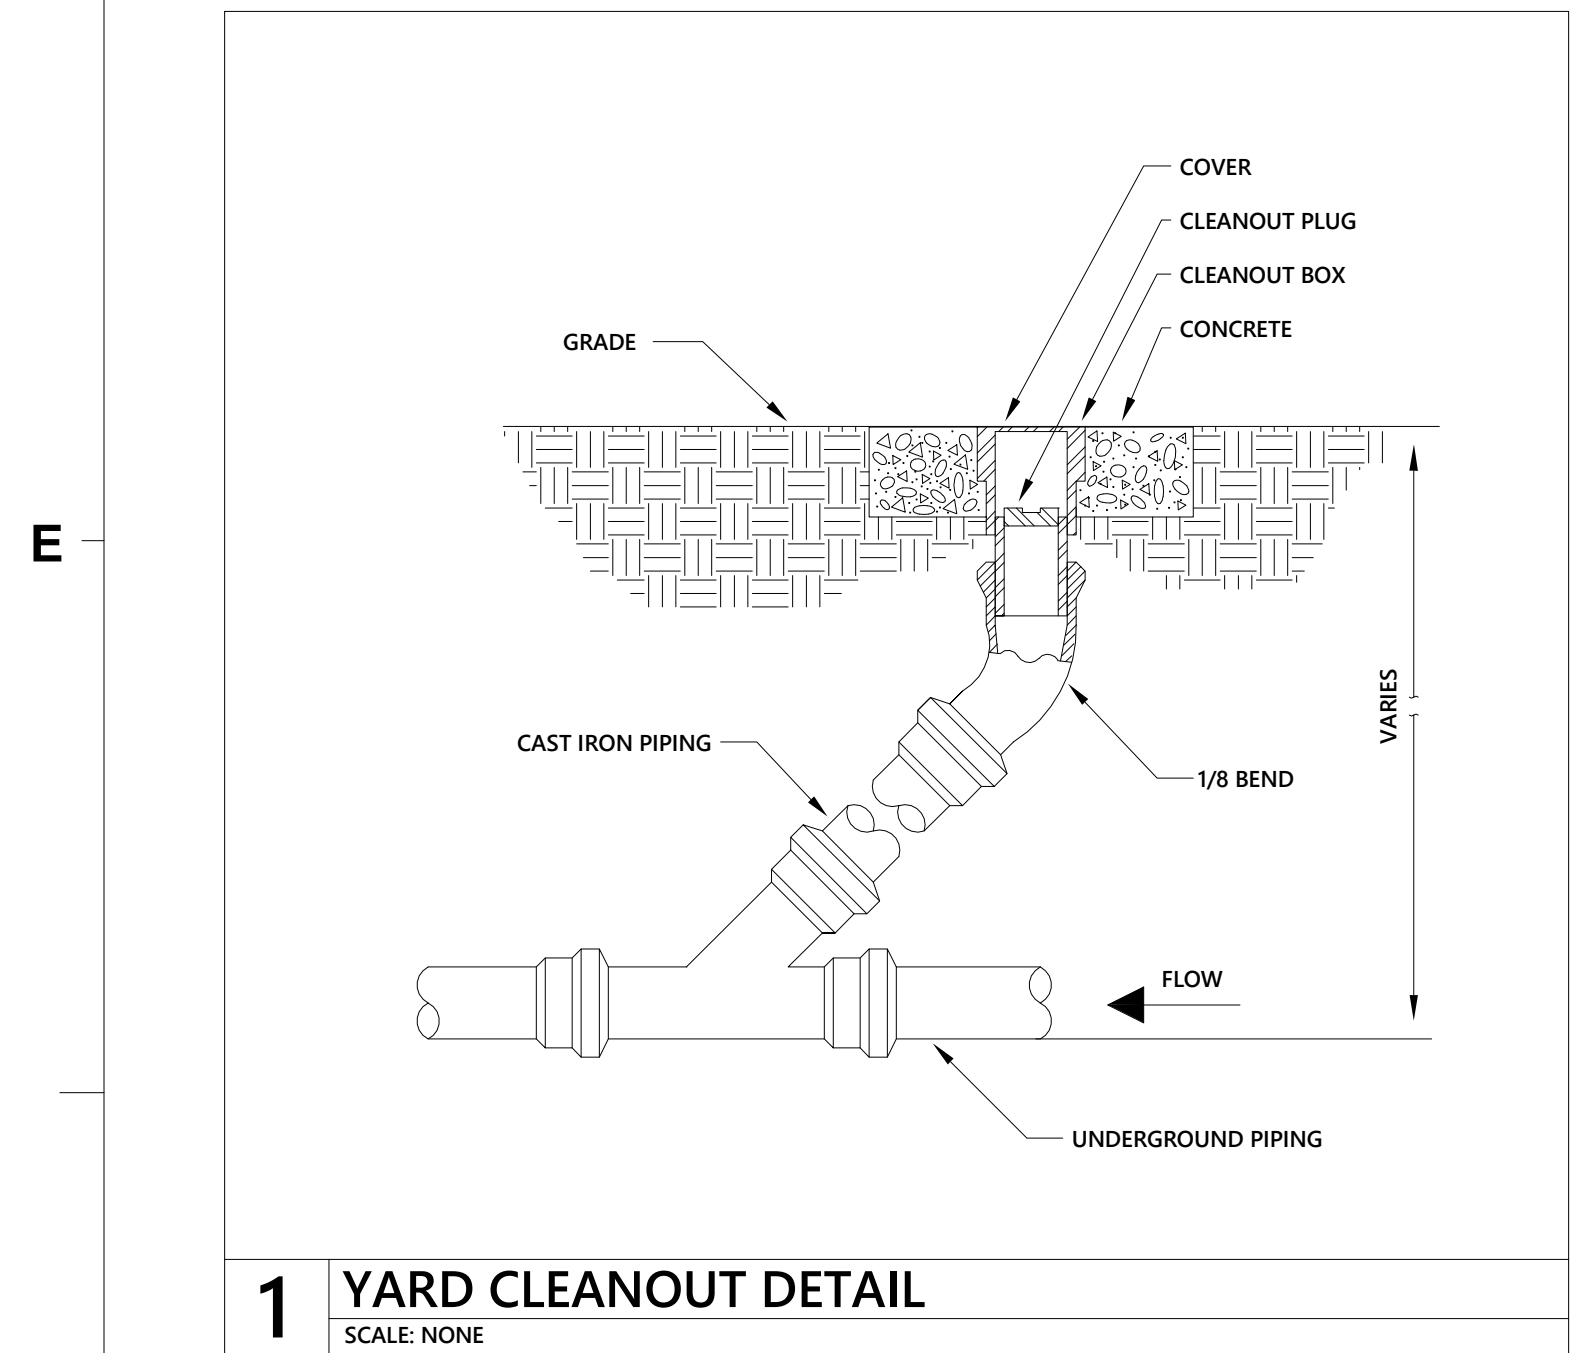

REVISIONS:

No.	Description	Date
1	Addendum #4	8.28.2017


REVISIONS:

No.	Description	Date
1	Addendum #4	8.28.2017


PROJECT: 9202-164730
SCO ID: 16-15656-02B
ITEM: 315 CODE: 41526
DATE: AUGUST 21, 2017
DRAWN BY: RPD
CHECKED BY: DAR

PLUMBING DETAILS


P-004

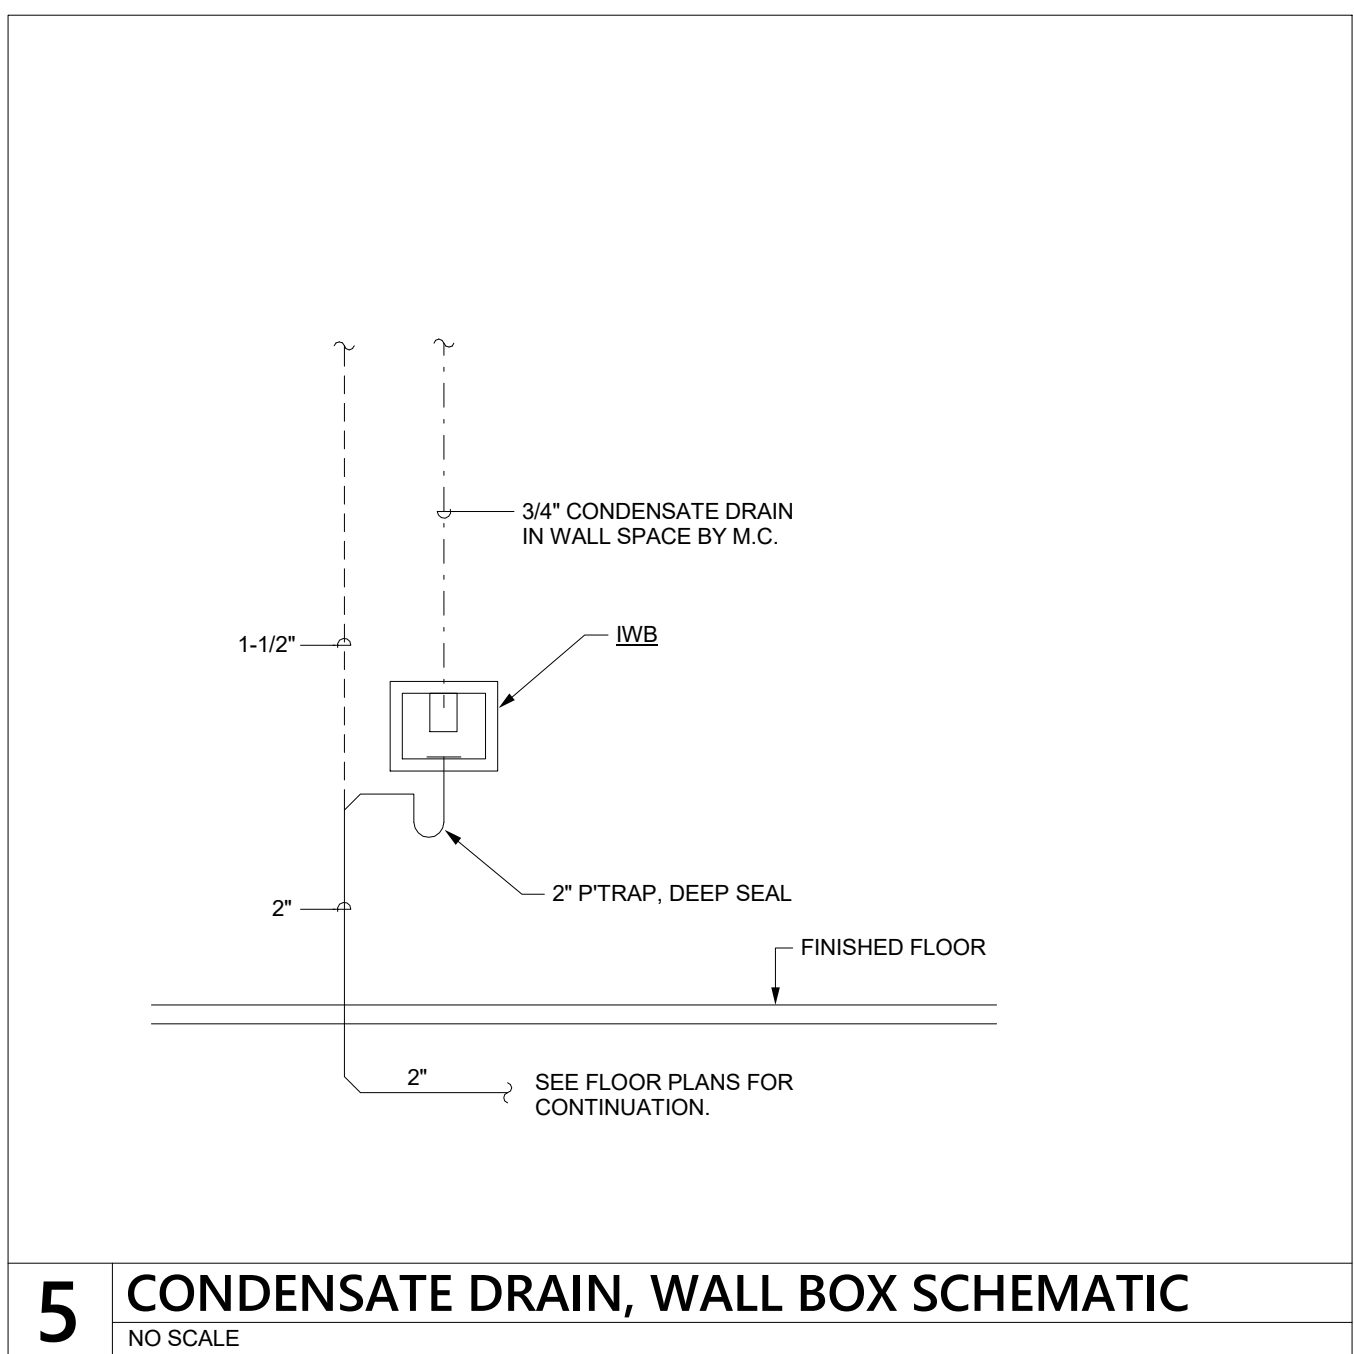


5 CONDENSATE DRAIN, WALL BOX SCHEMATIC
NO SCALE

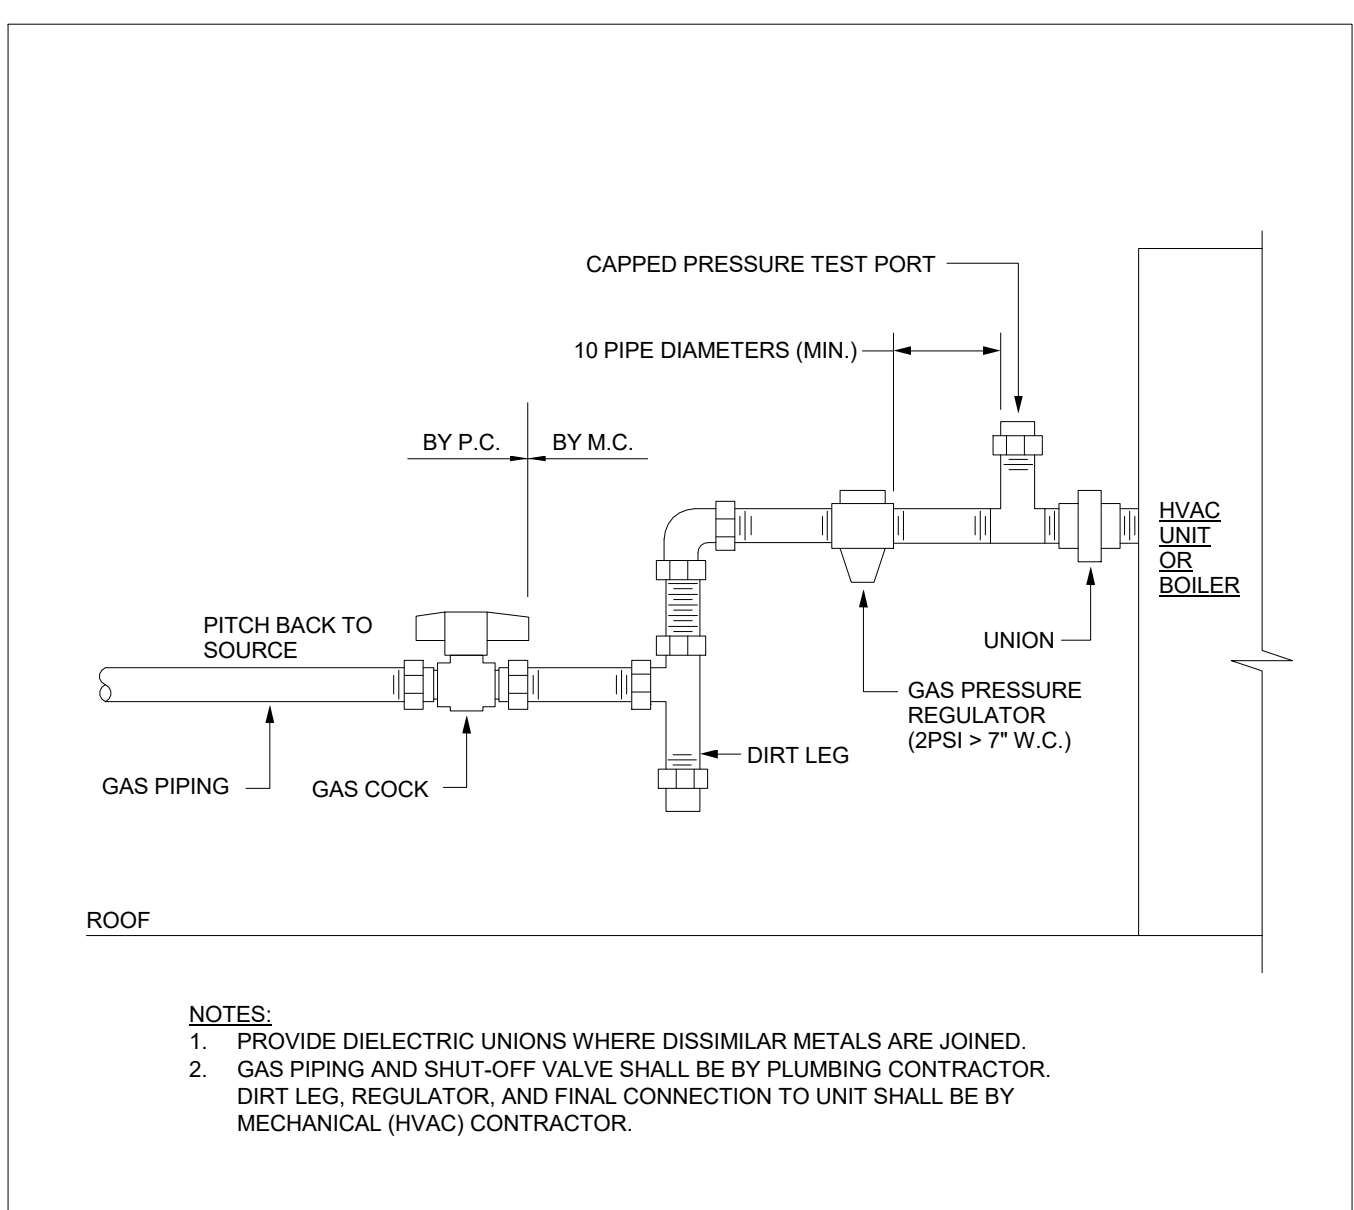


6 GAS CONNECTION DETAIL (TO HVAC EQUIPMENT)
NO SCALE

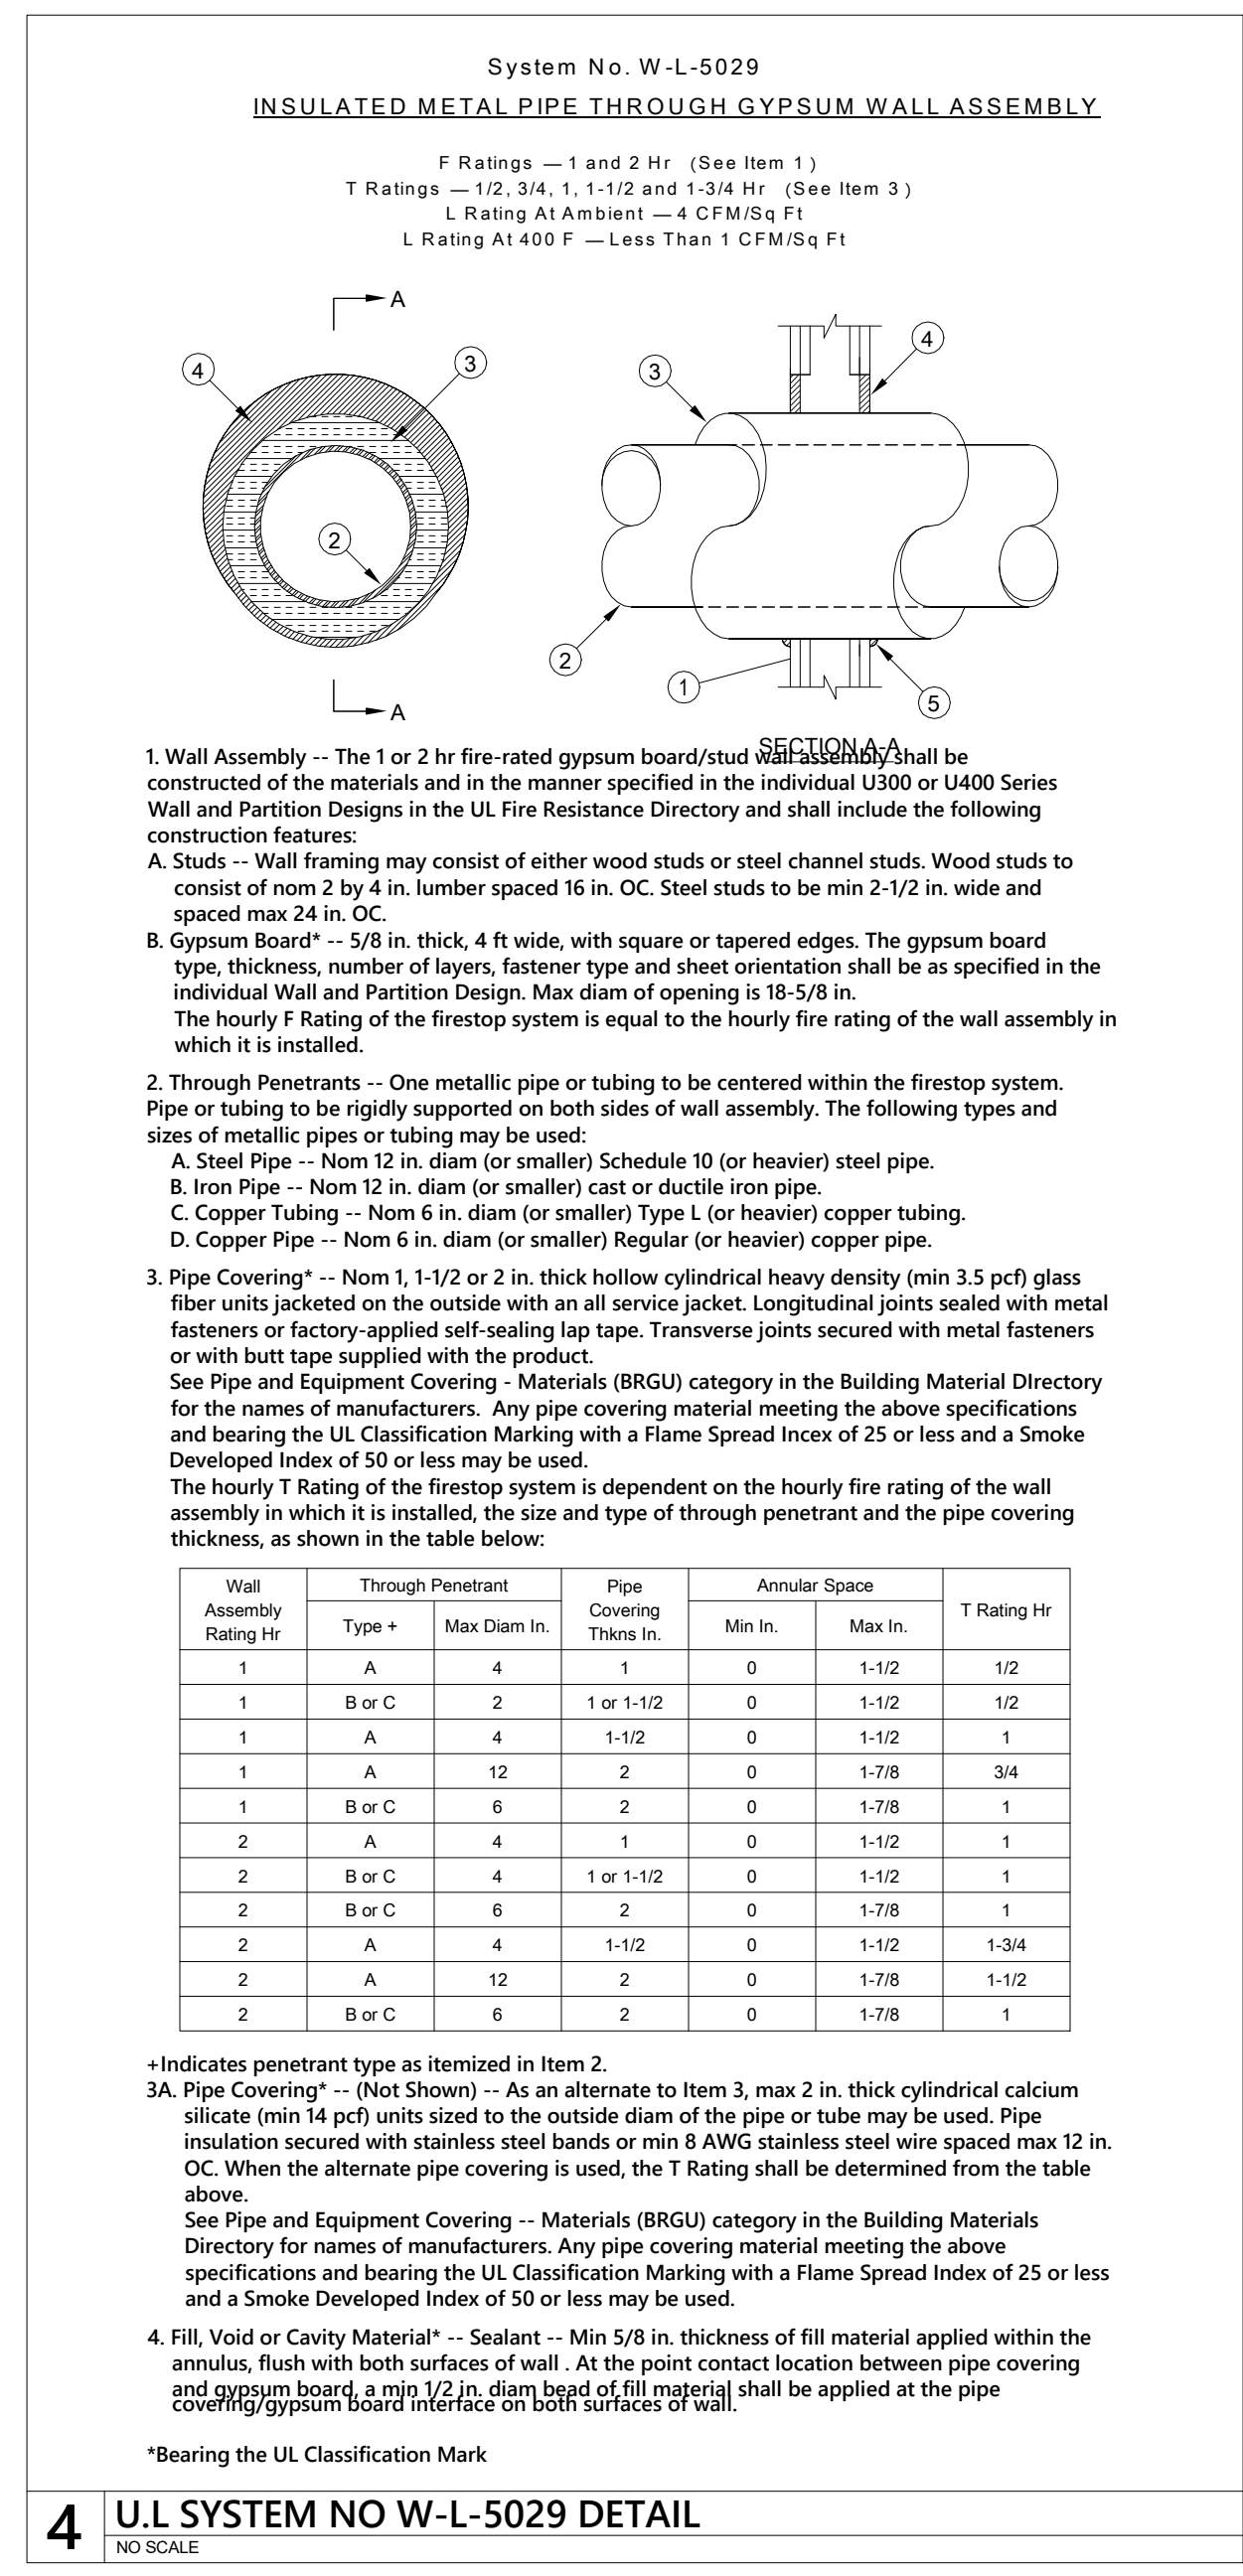


4 U.L. SYSTEM NO W-L-5029 DETAIL
NO SCALE

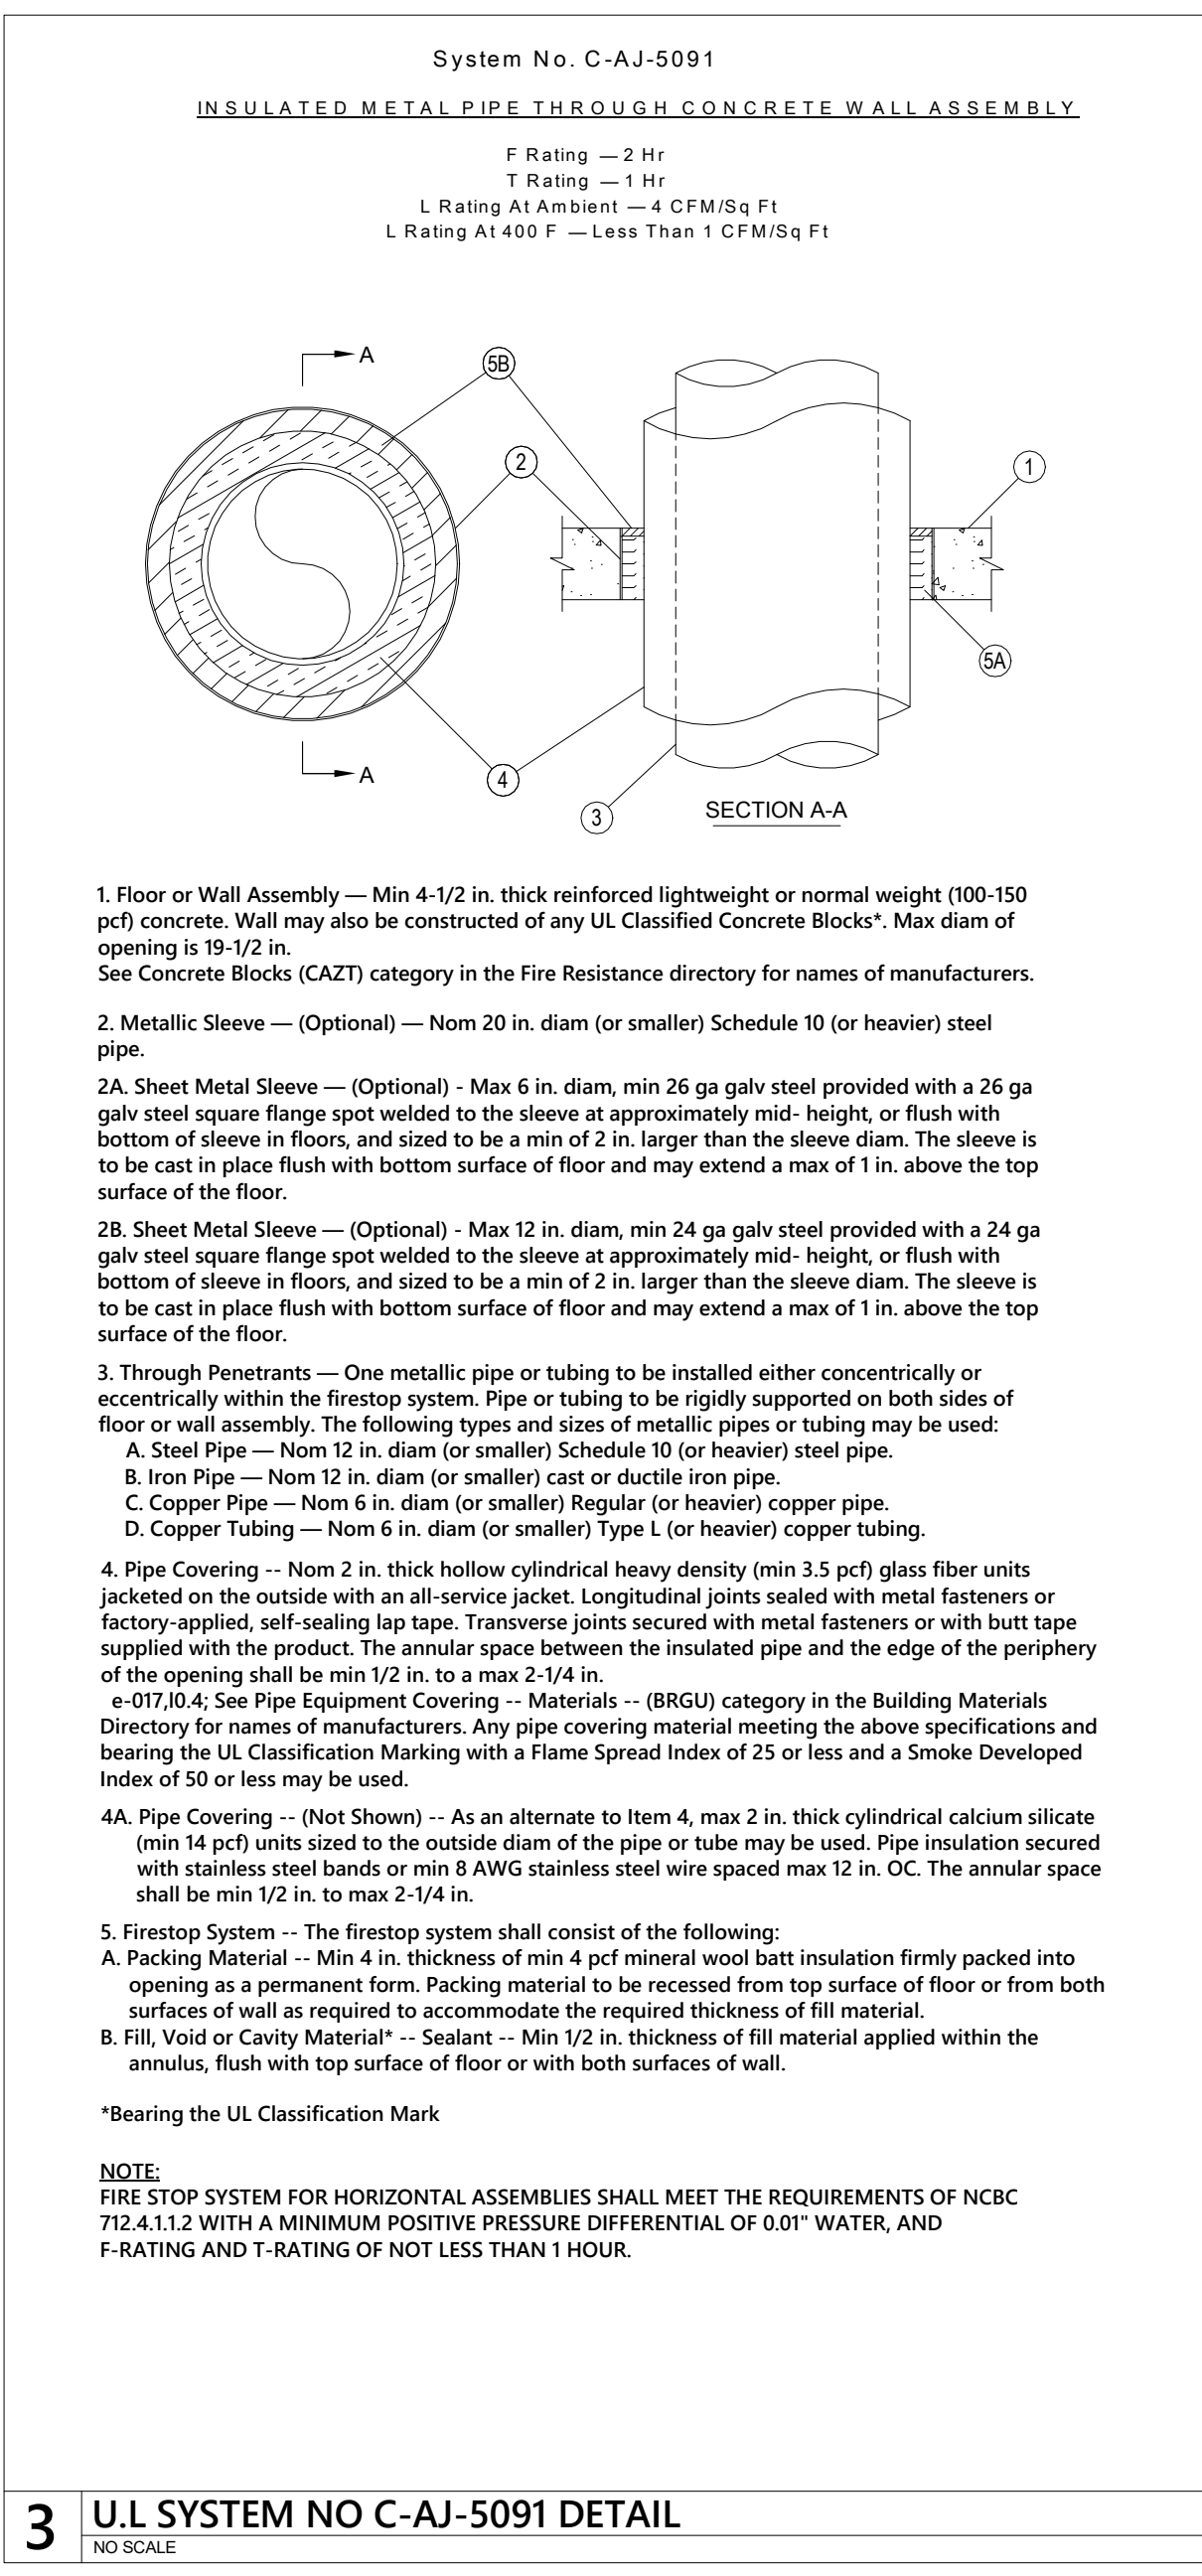


3 U.L. SYSTEM NO C-AJ-5091 DETAIL
NO SCALE

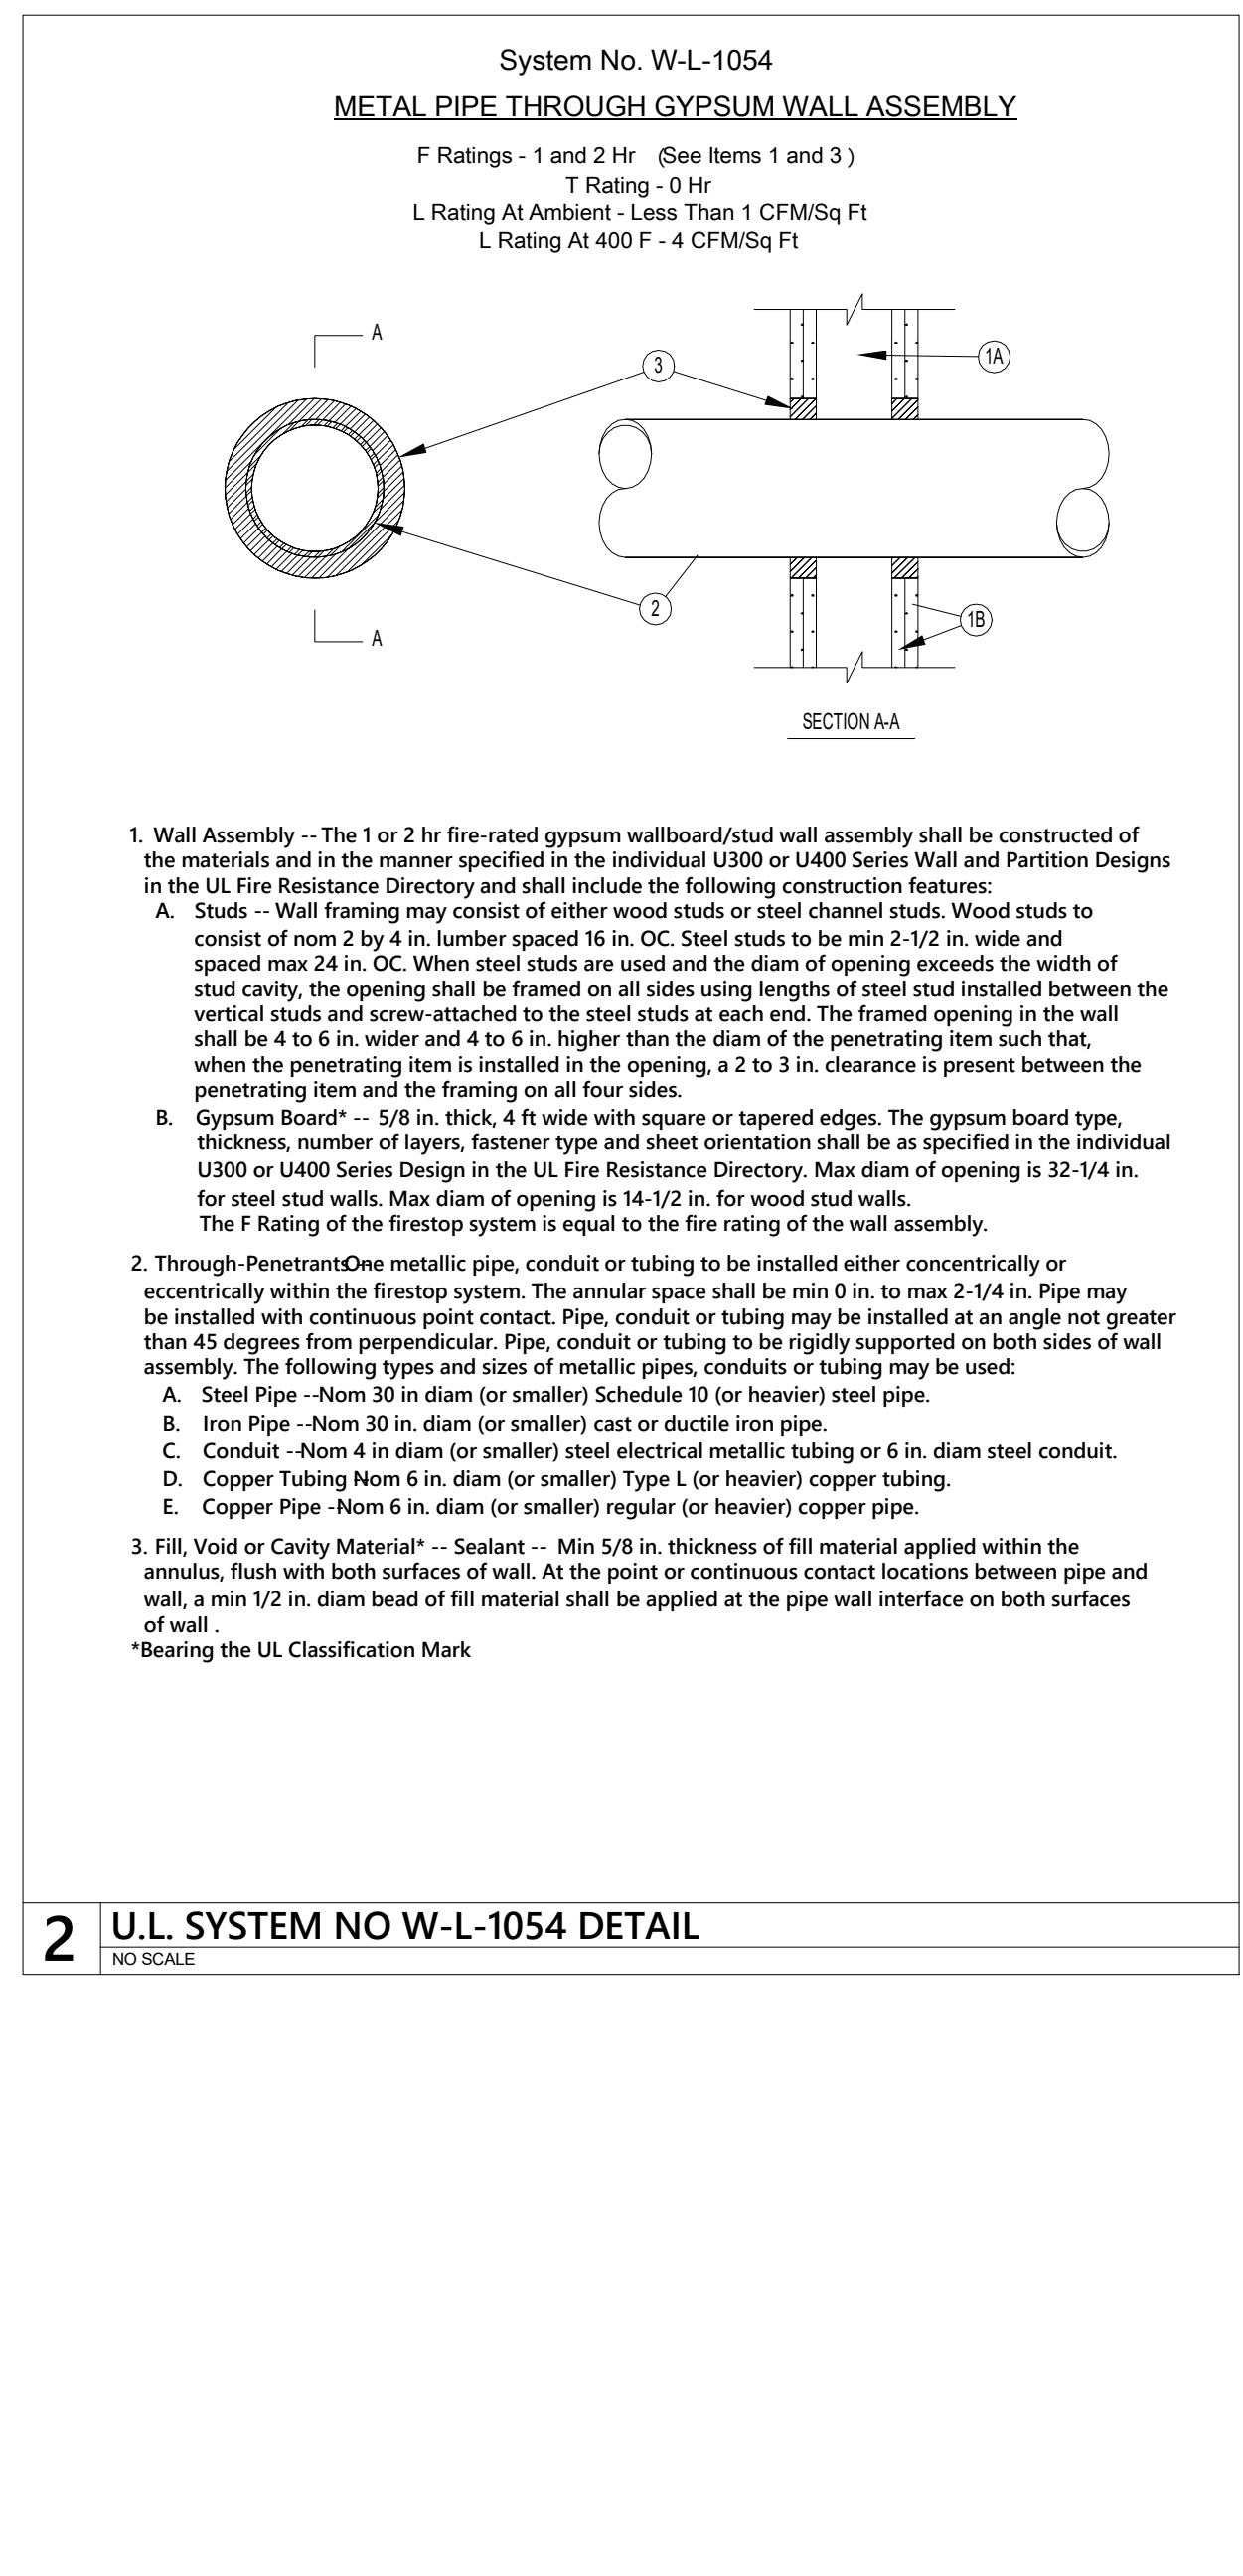


2 U.L. SYSTEM NO W-L-1054 DETAIL
NO SCALE

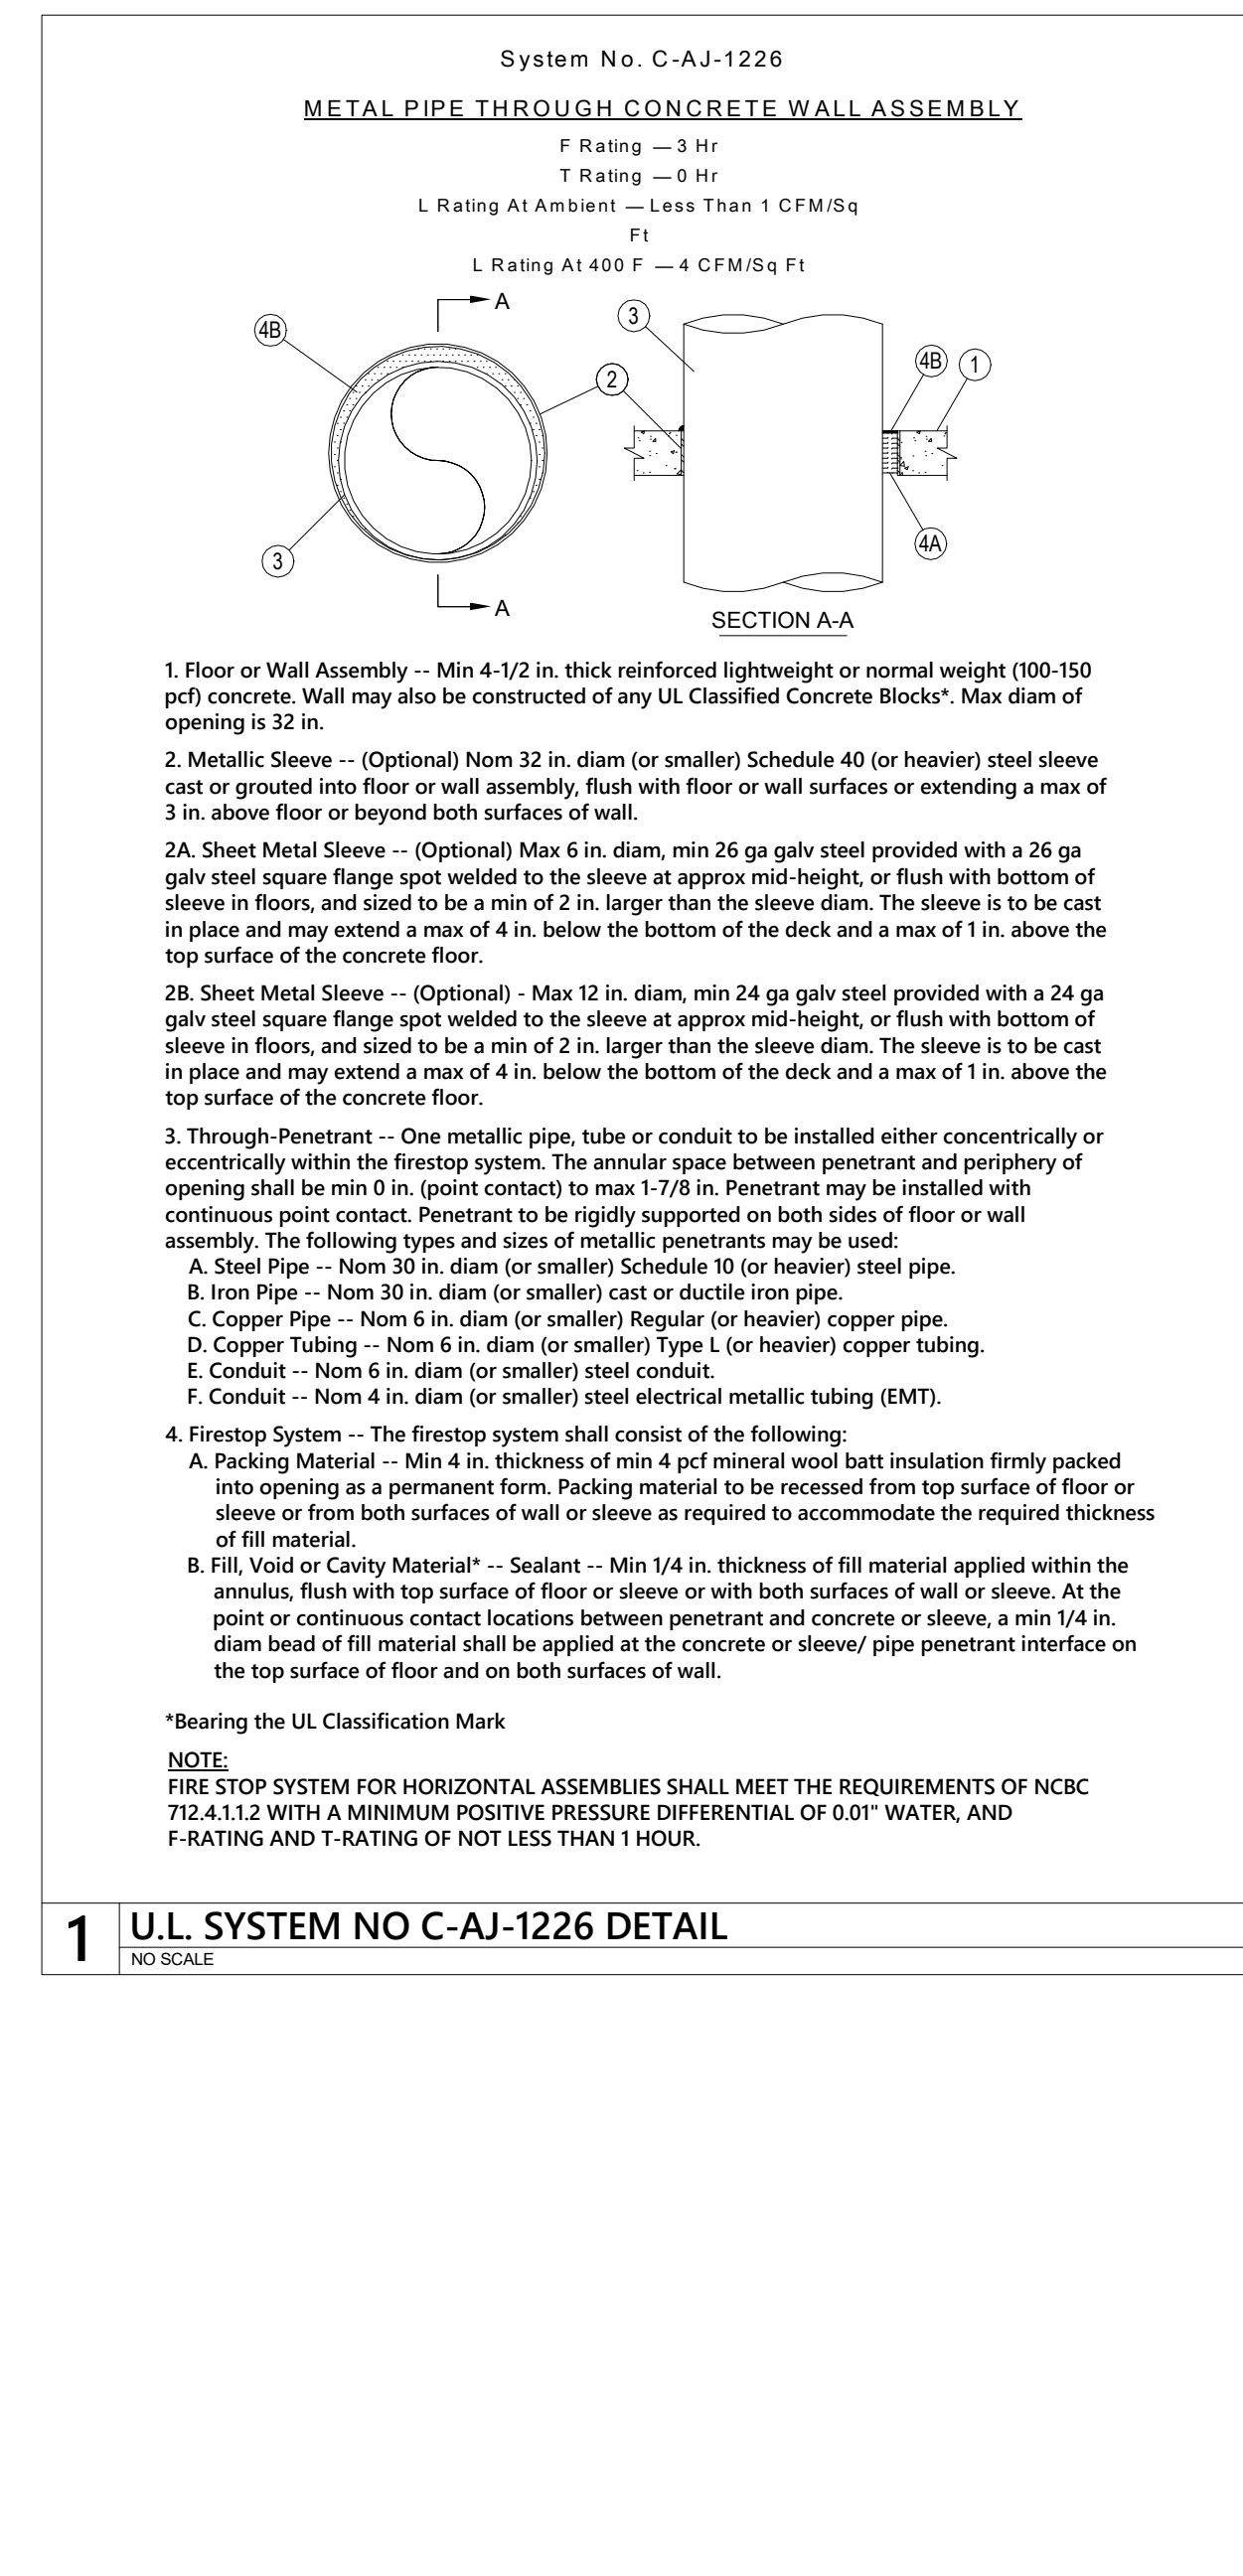


1 U.L. SYSTEM NO C-AJ-1226 DETAIL
NO SCALE

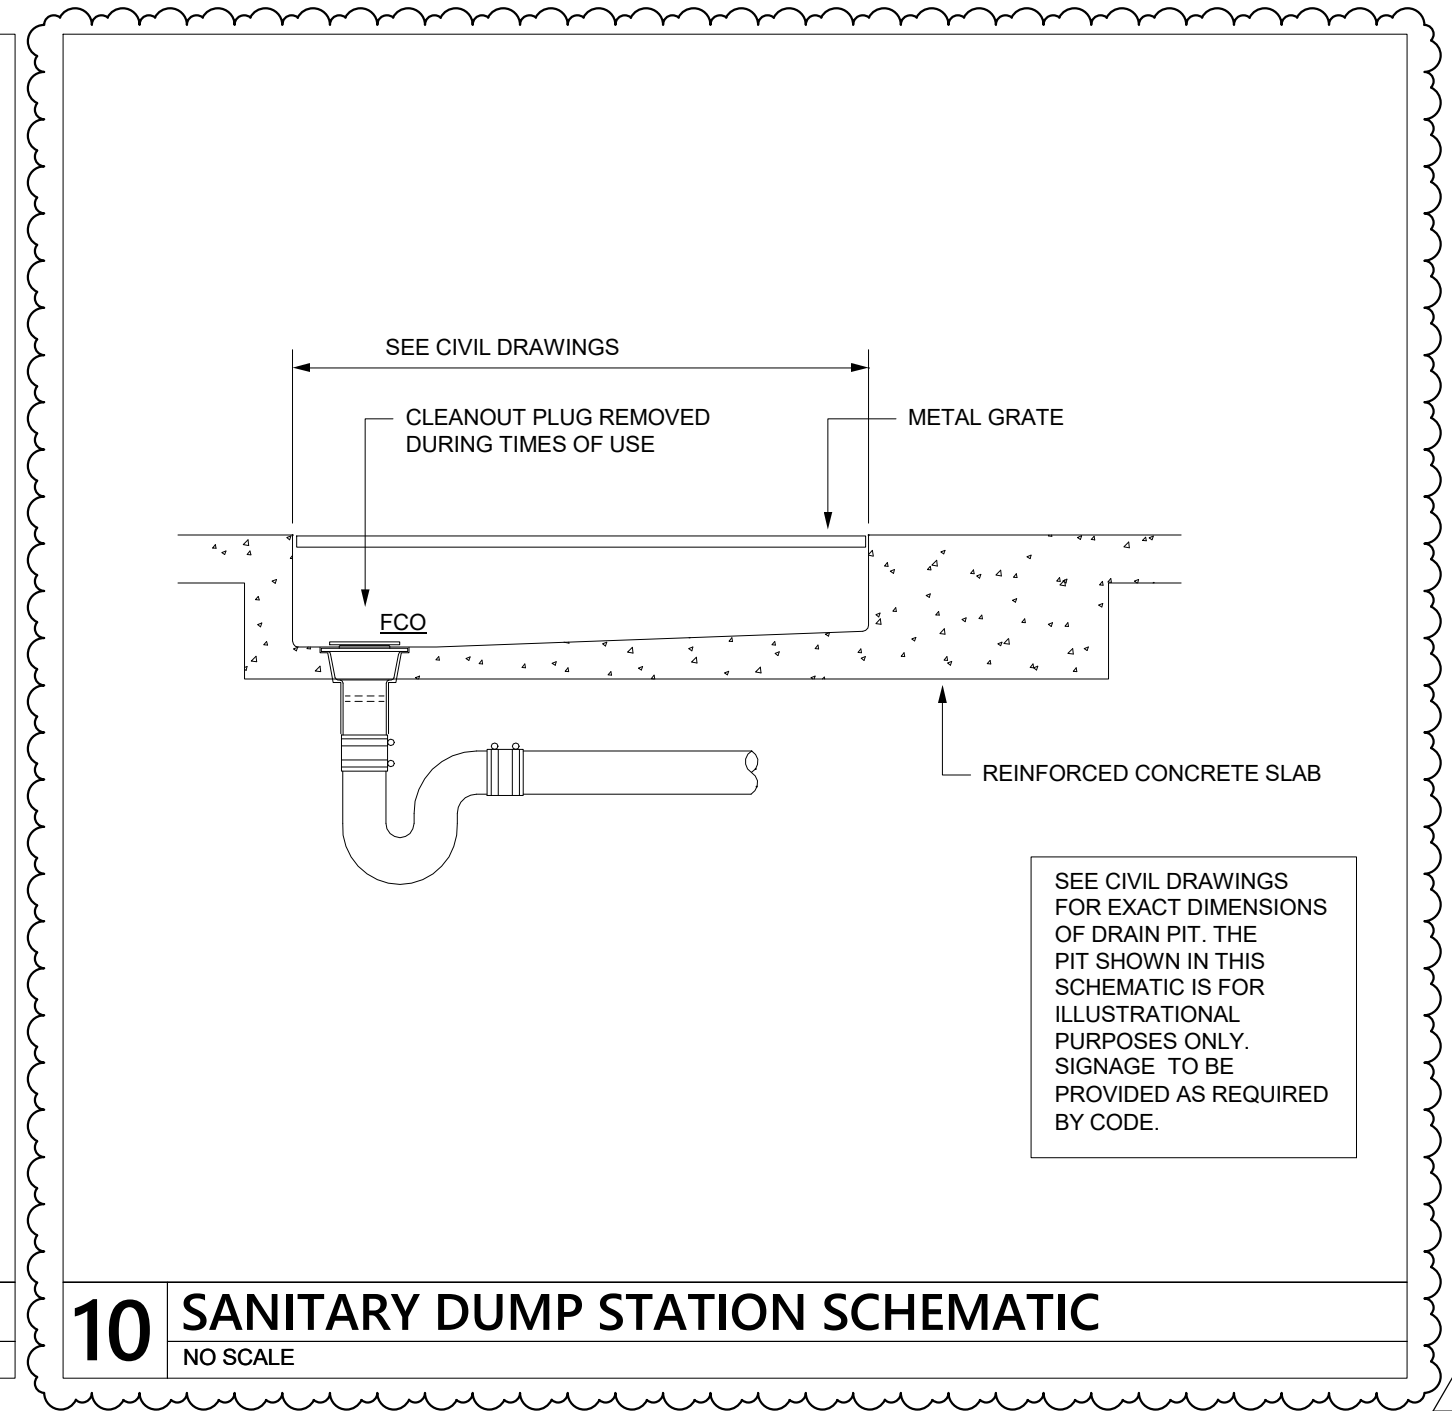


10 SANITARY DUMP STATION SCHEMATIC
NO SCALE

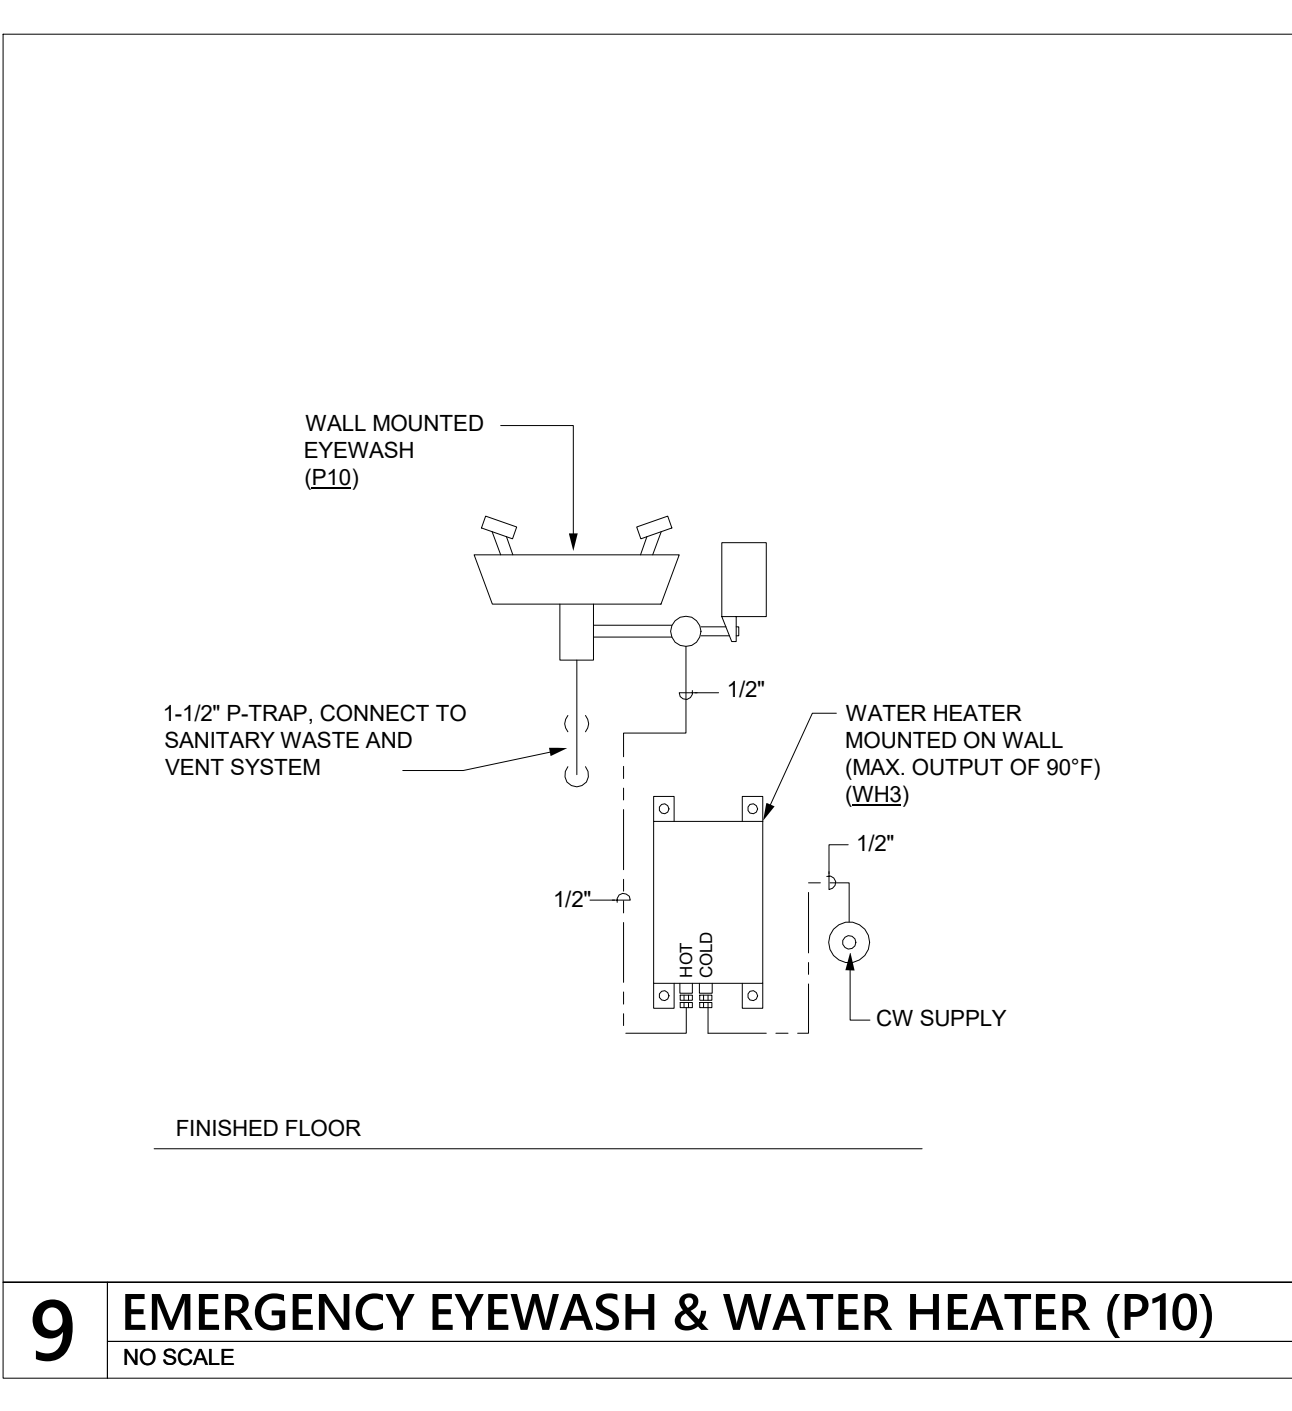


9 EMERGENCY EYEWASH & WATER HEATER (P10)
NO SCALE

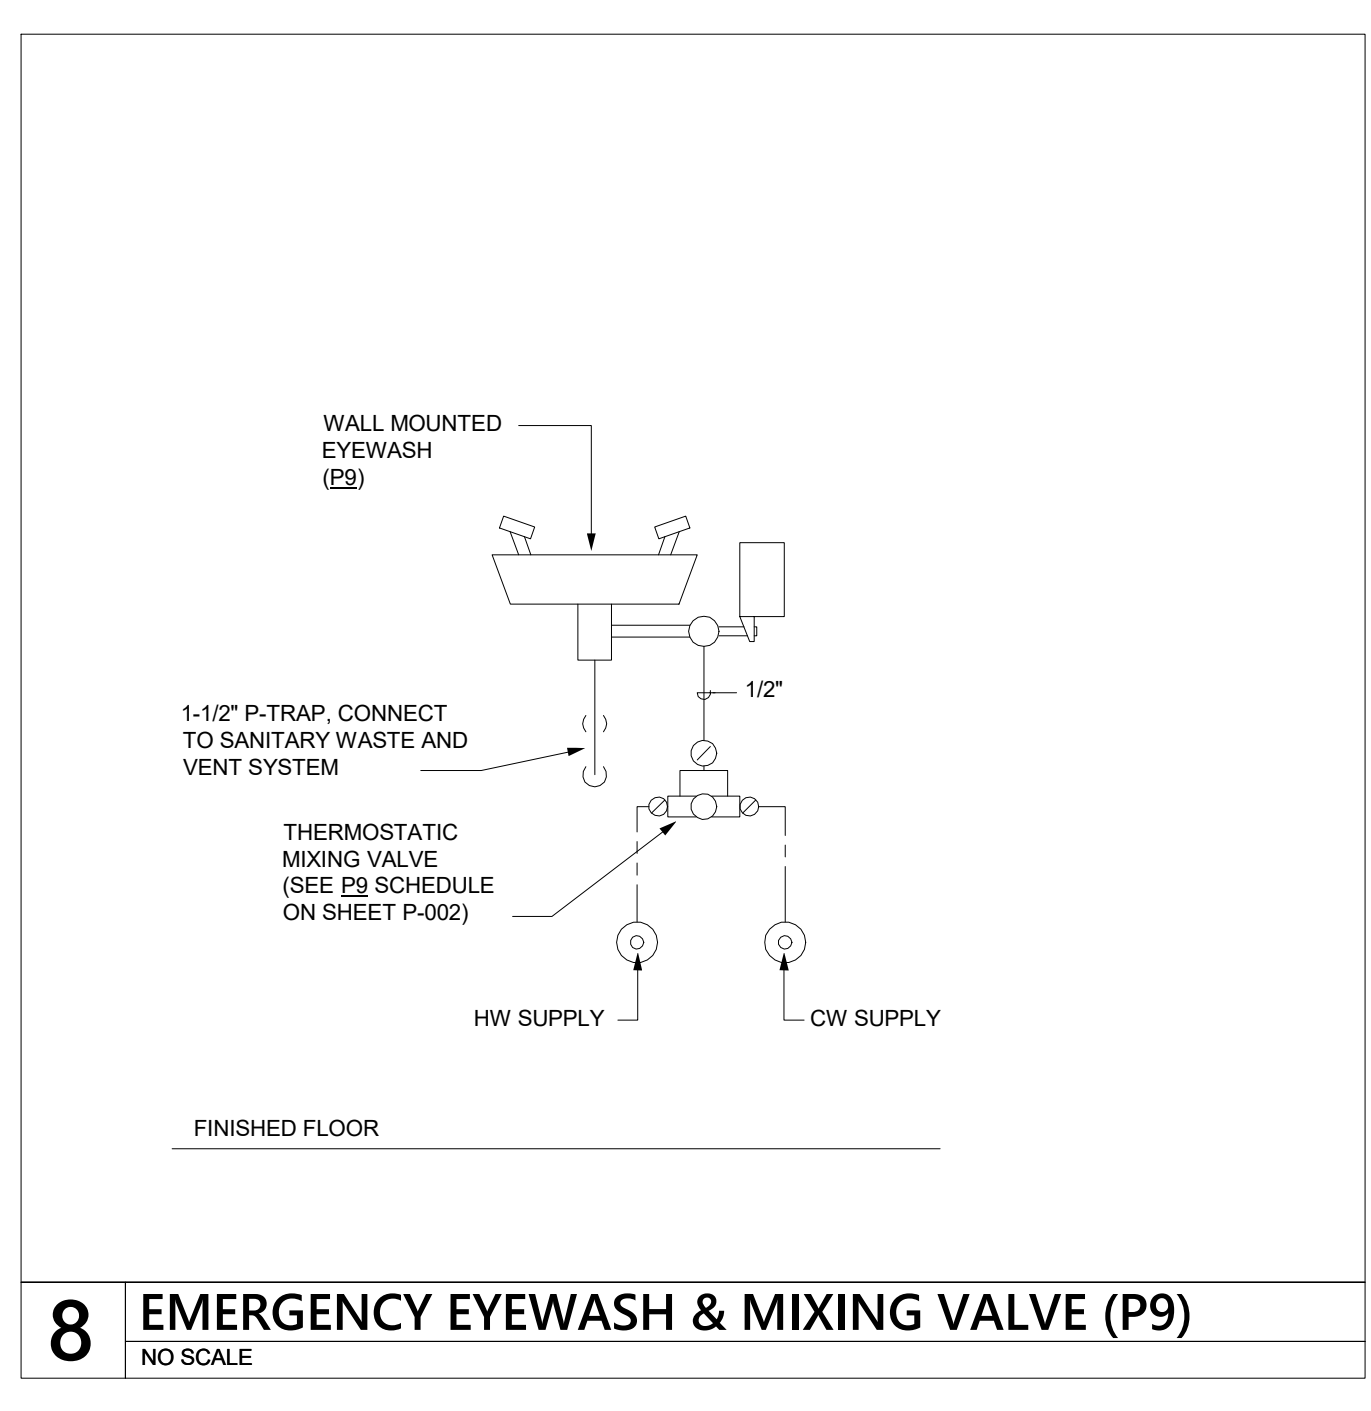

8 EMERGENCY EYEWASH & MIXING VALVE (P9)
NO SCALE

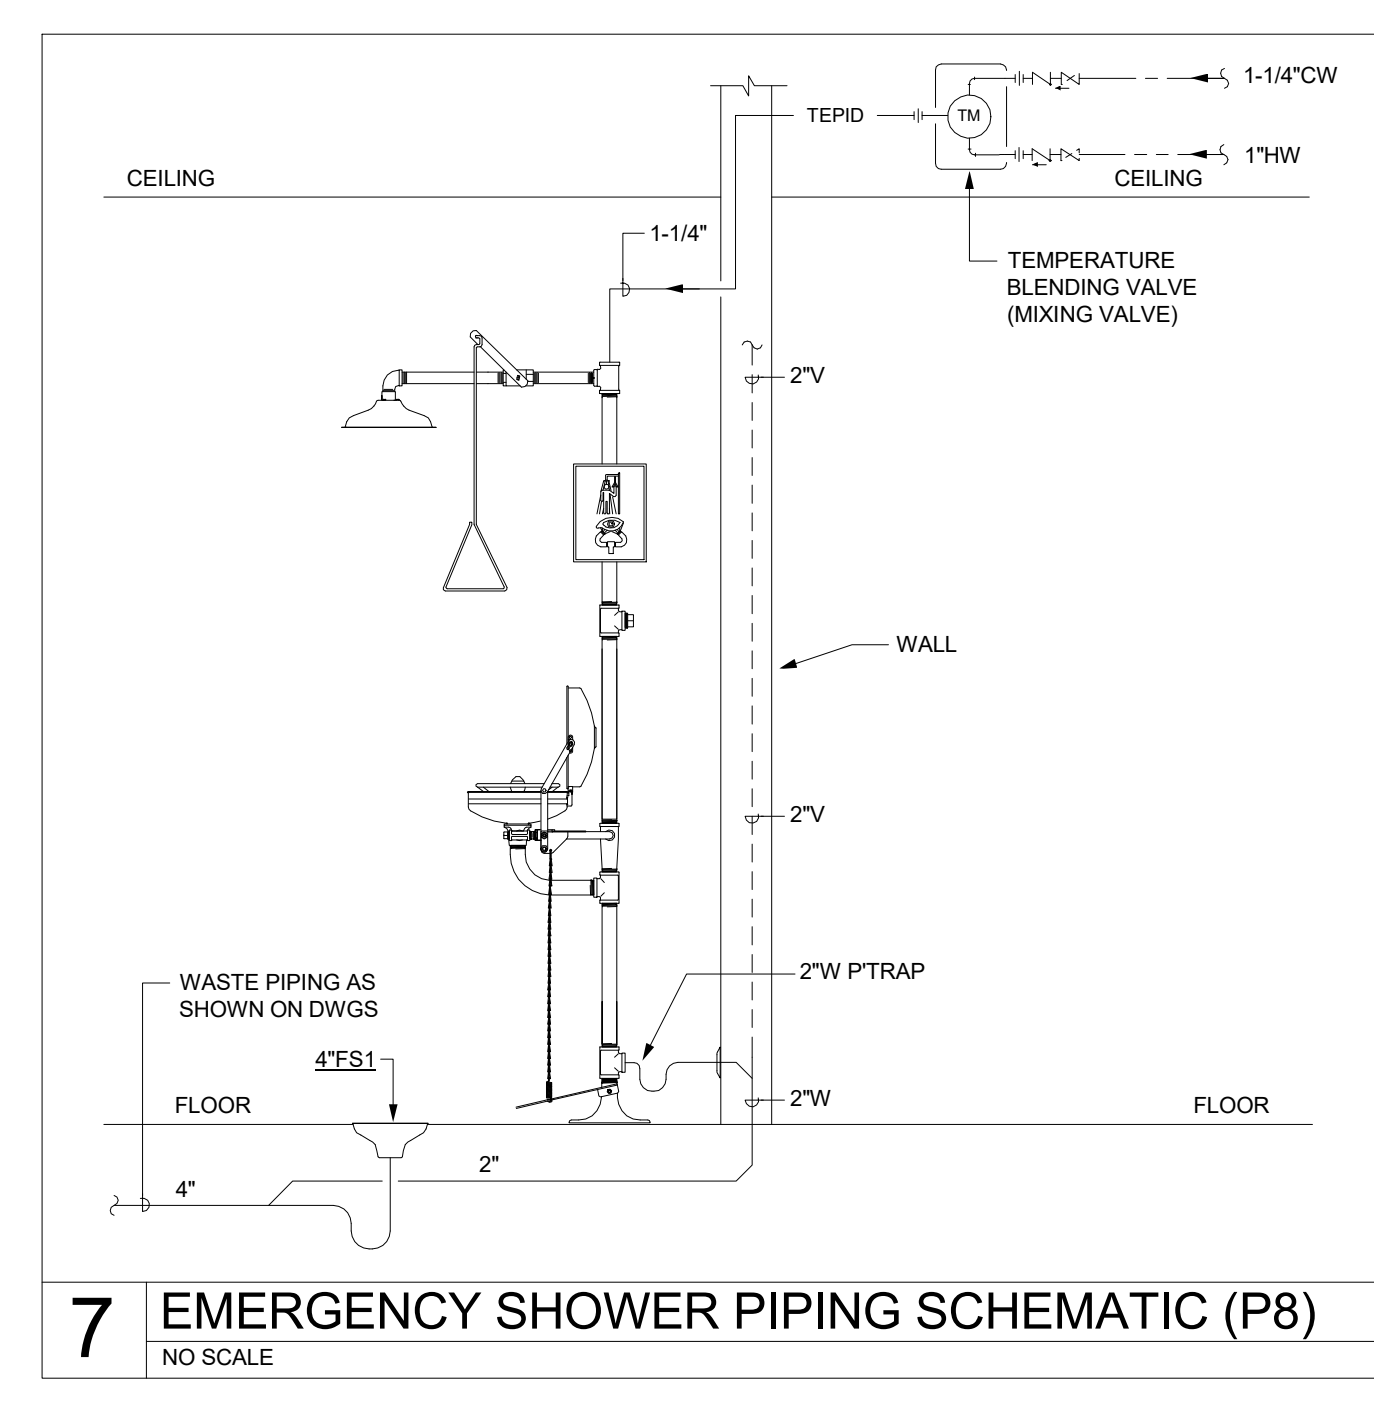

7 EMERGENCY SHOWER PIPING SCHEMATIC (P8)
NO SCALE

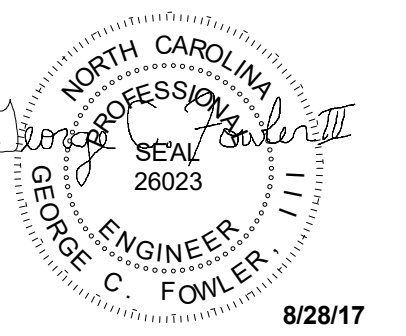

8/28/17

MEMBERS OF THE AMERICAN INSTITUTE OF ARCHITECTS

COPYRIGHT 2016 ALL RIGHTS RESERVED
PRINTED OR ELECTRONIC DRAWINGS AND DOCUMENTATION MAY NOT BE REPRODUCED IN ANY FORM WITHOUT WRITTEN PERMISSION FROM LS3P ASSOCIATES LTD.

REVISIONS:

No.	Description	Date
1	Addendum #4	8.28.2017


E

D


C

B

A

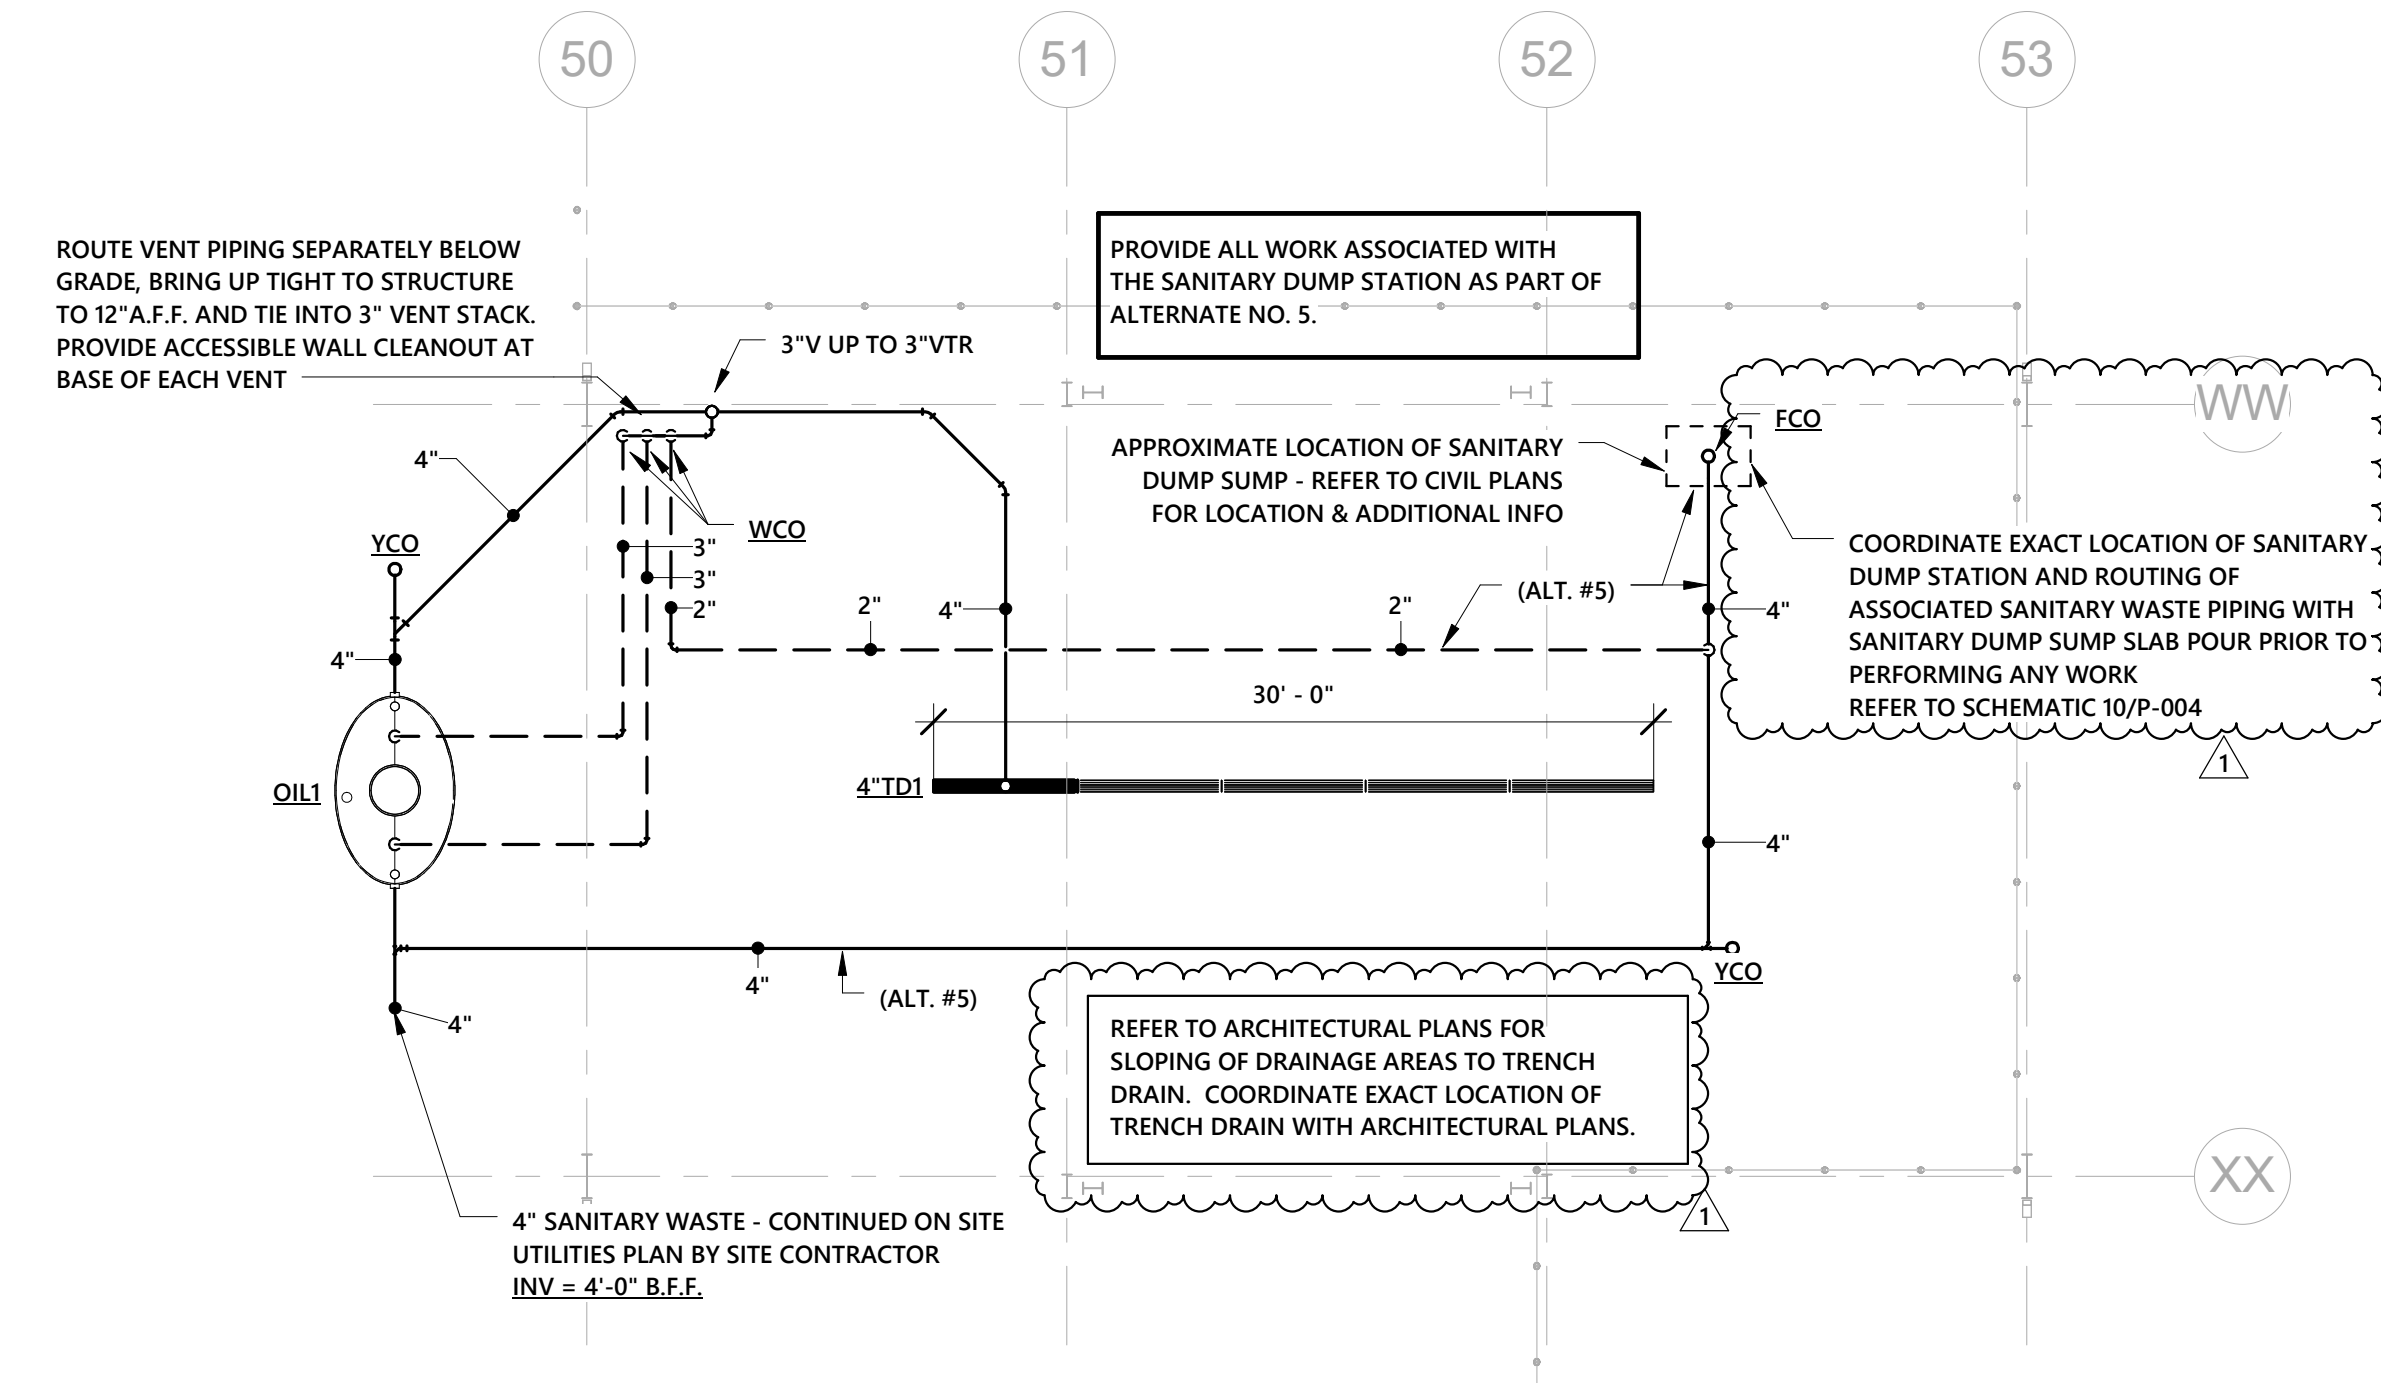

2 FLOOR PLAN - WASH RACK - WASTE & VENT
1/8" = 1'-0"
SCALE: 1/8"=1'-0"

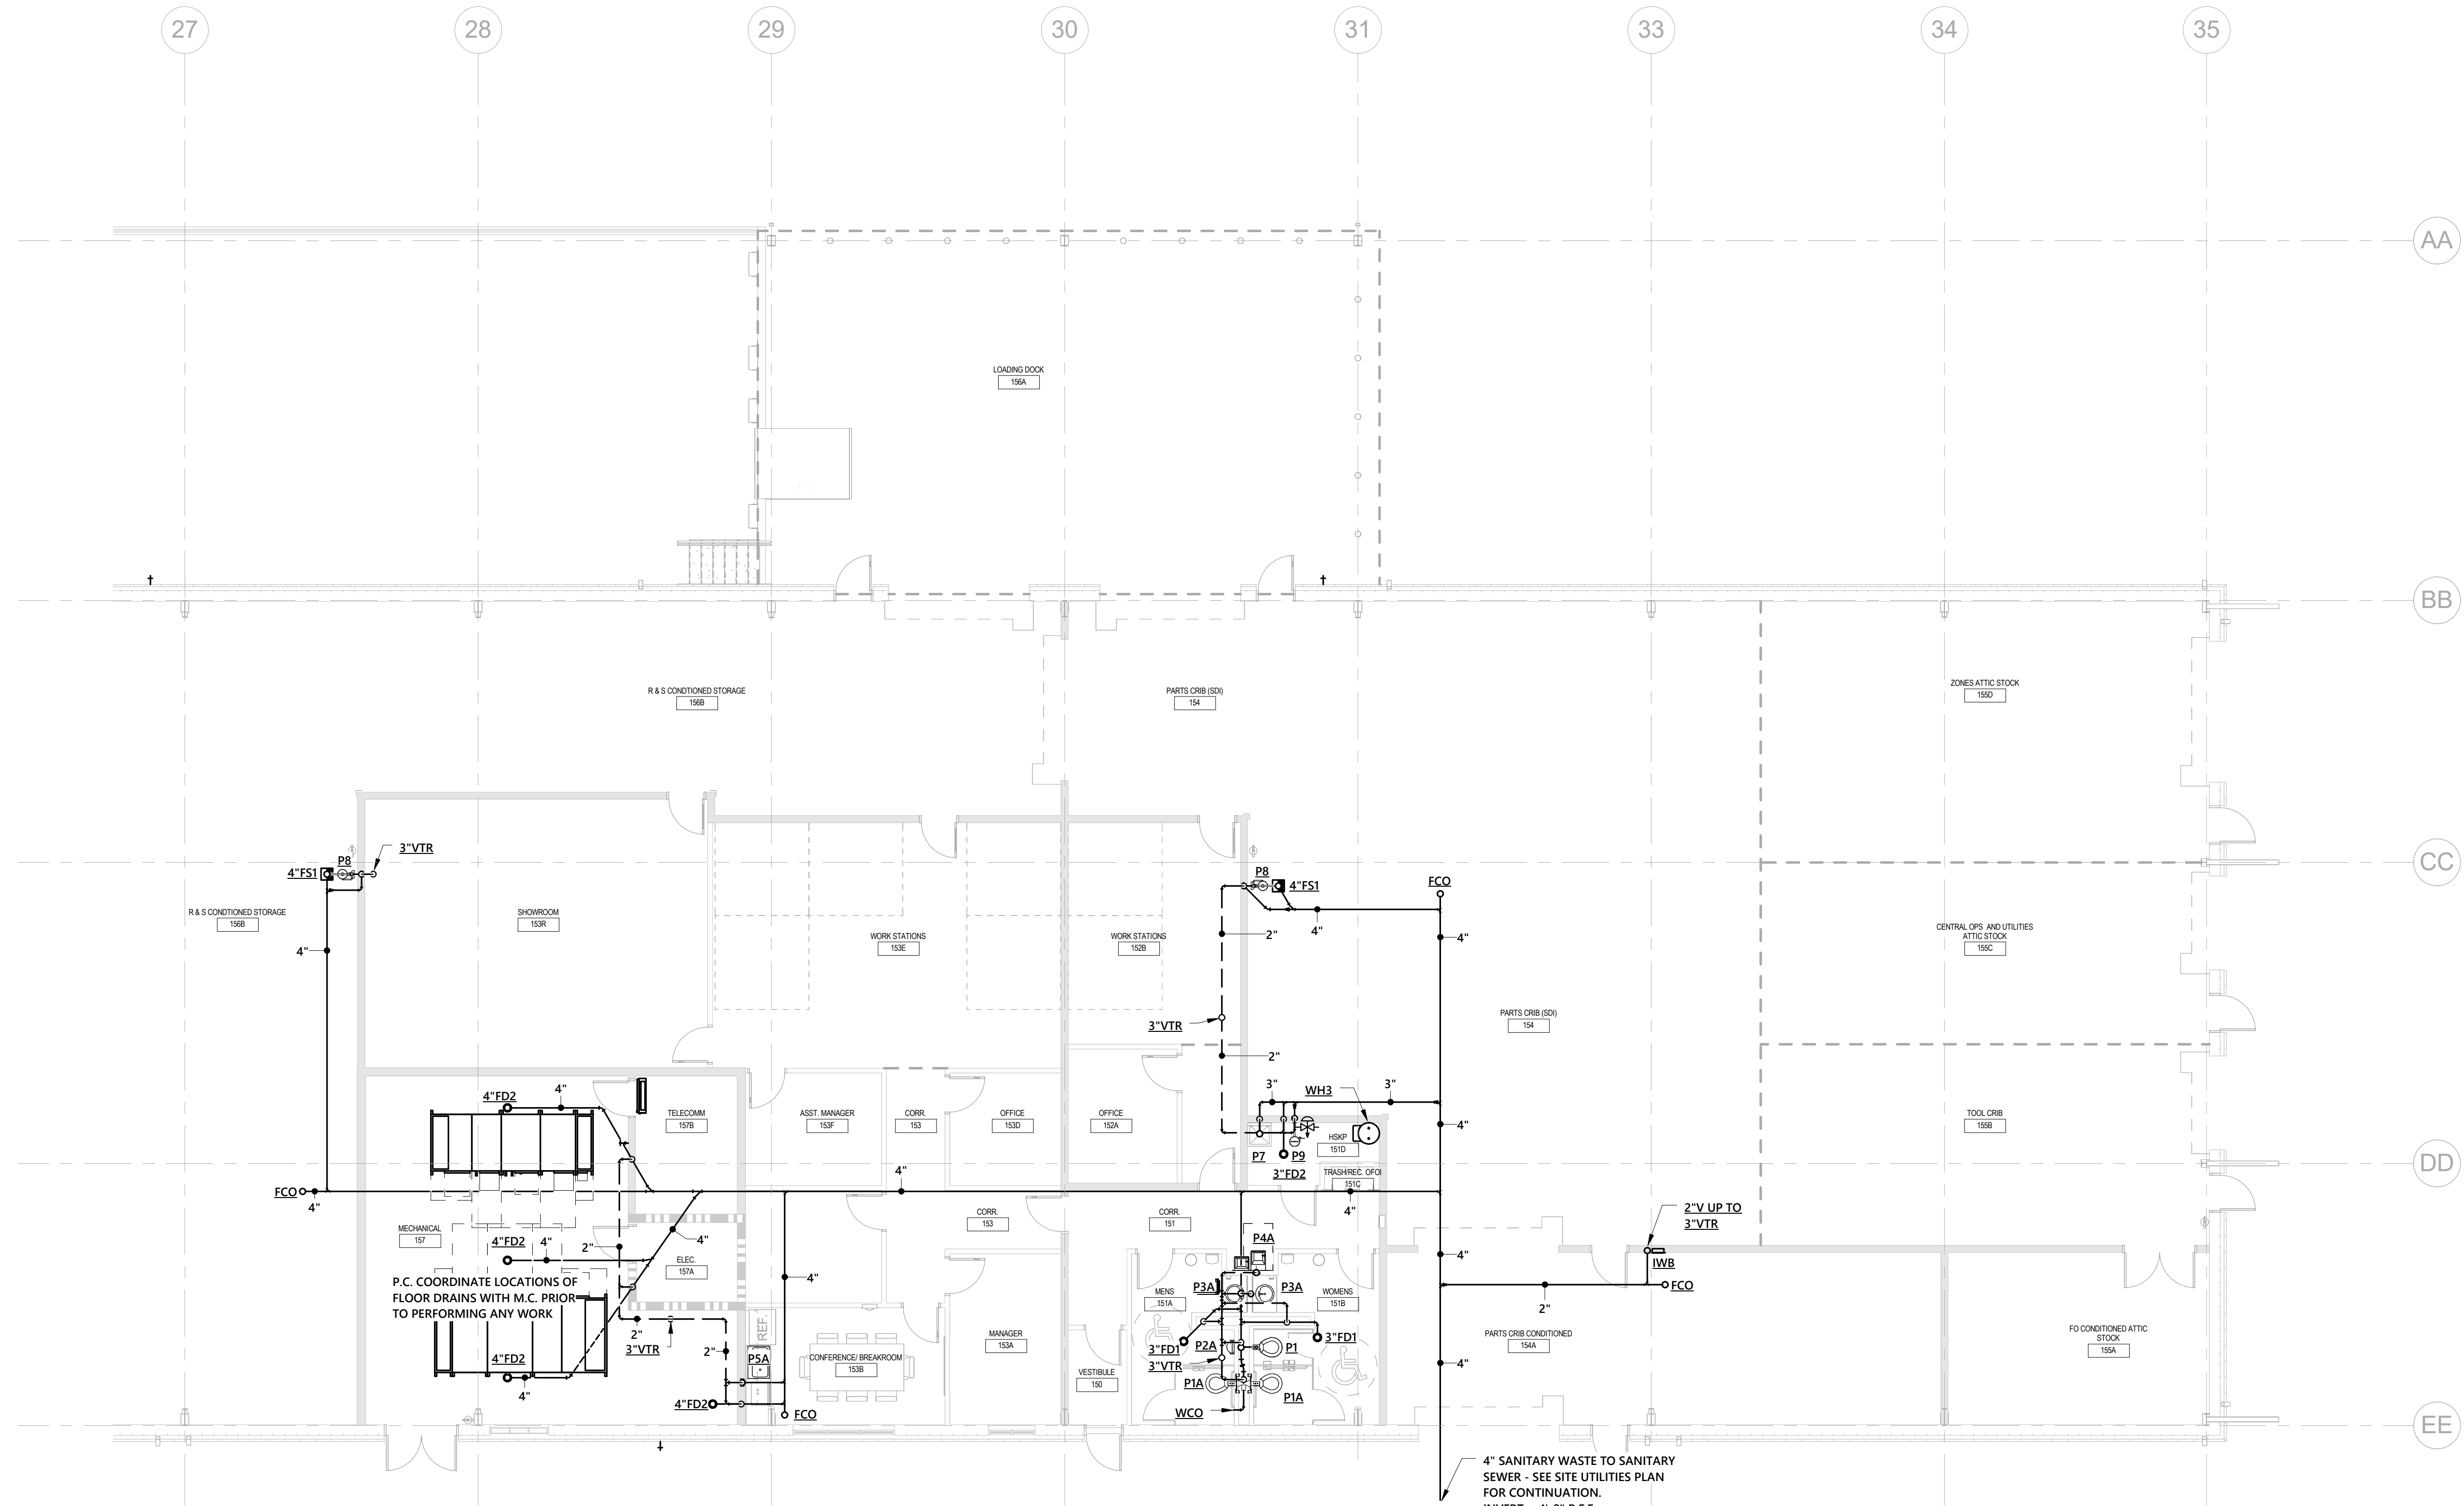


1 WAREHOUSE FLOOR PLAN - WASTE & VENT - WAREHOUSE - EAST
1/8" = 1'-0"
SCALE: 1/8"=1'-0"

PARTITION LEGEND

- ALL EXTERIOR WALLS TO BE W1 U.N.O.
- ALL INTERIOR METAL STUD PARTITIONS TO BE TYPE G32 U.N.O.

- NON-RATED PARTITION TO CEILING
- NON-RATED PARTITION TO DECK
- 1 HR. RATED PARTITION TO DECK
- 2 HR. RATED PARTITION TO DECK

NOTE: SEE SHEET A-004 FOR CONSTRUCTION OF PARTITION TYPES.

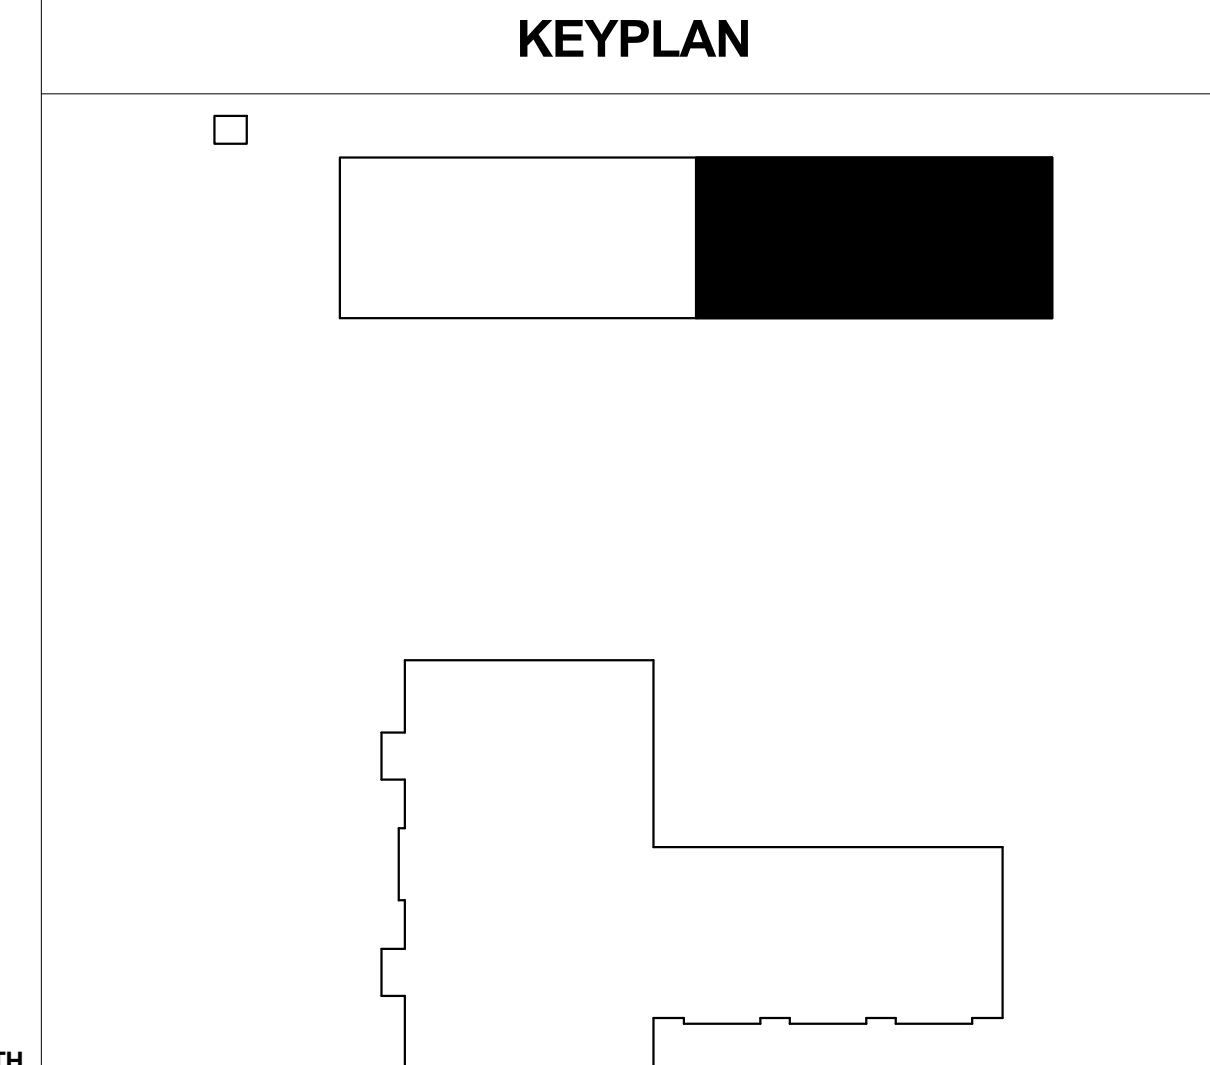


PROJECT: 9202-164730
SCO ID: 16-15656-02B
ITEM: 315 CODE: 41526
DATE: AUGUST 21, 2017
DRAWN BY: RPD
CHECKED BY: DAR


FLOOR PLAN - WAREHOUSE - WASTE AND VENT - EAST

P-102B

OPTIMA #: 16-0265 8 OF 12

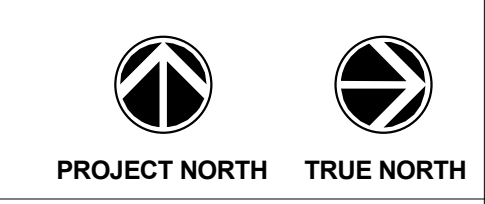

C:\Users\jdoose\Documents\16-0265_R16_MEP_Uploads.rvt 8/29/2017 3:03:28 PM

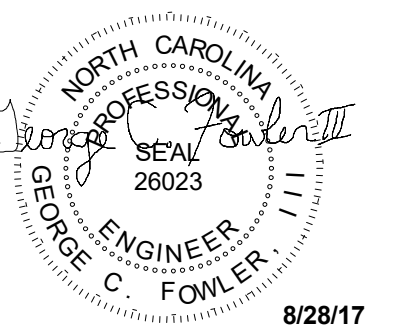

8/28/17

MEMBERS OF THE AMERICAN INSTITUTE OF ARCHITECTS


COPYRIGHT 2016 ALL RIGHTS RESERVED
PRINTED OR ELECTRONIC DRAWINGS AND DOCUMENTATION MAY NOT BE REPRODUCED IN ANY FORM WITHOUT WRITTEN PERMISSION FROM LS3P ASSOCIATES LTD.

REVISIONS:

No.	Description	Date
1	Addendum #4	8.28.2017

1 FLOOR PLAN - PATS/FO - WATER & GAS
1/8" = 1'-0"
SCALE: 1/8" = 1'-0"

PARTITION LEGEND	
1. ALL EXTERIOR WALLS TO BE W1 U.N.O.	
2. ALL INTERIOR METAL STUD PARTITIONS TO BE TYPE G32 U.N.O.	
	NON-RATED PARTITION TO CEILING
	NON-RATED PARTITION TO DECK
	1 HR. RATED PARTITION TO DECK
	2 HR. RATED PARTITION TO DECK
NOTE: SEE SHEET A-004 FOR CONSTRUCTION OF PARTITION TYPES.	

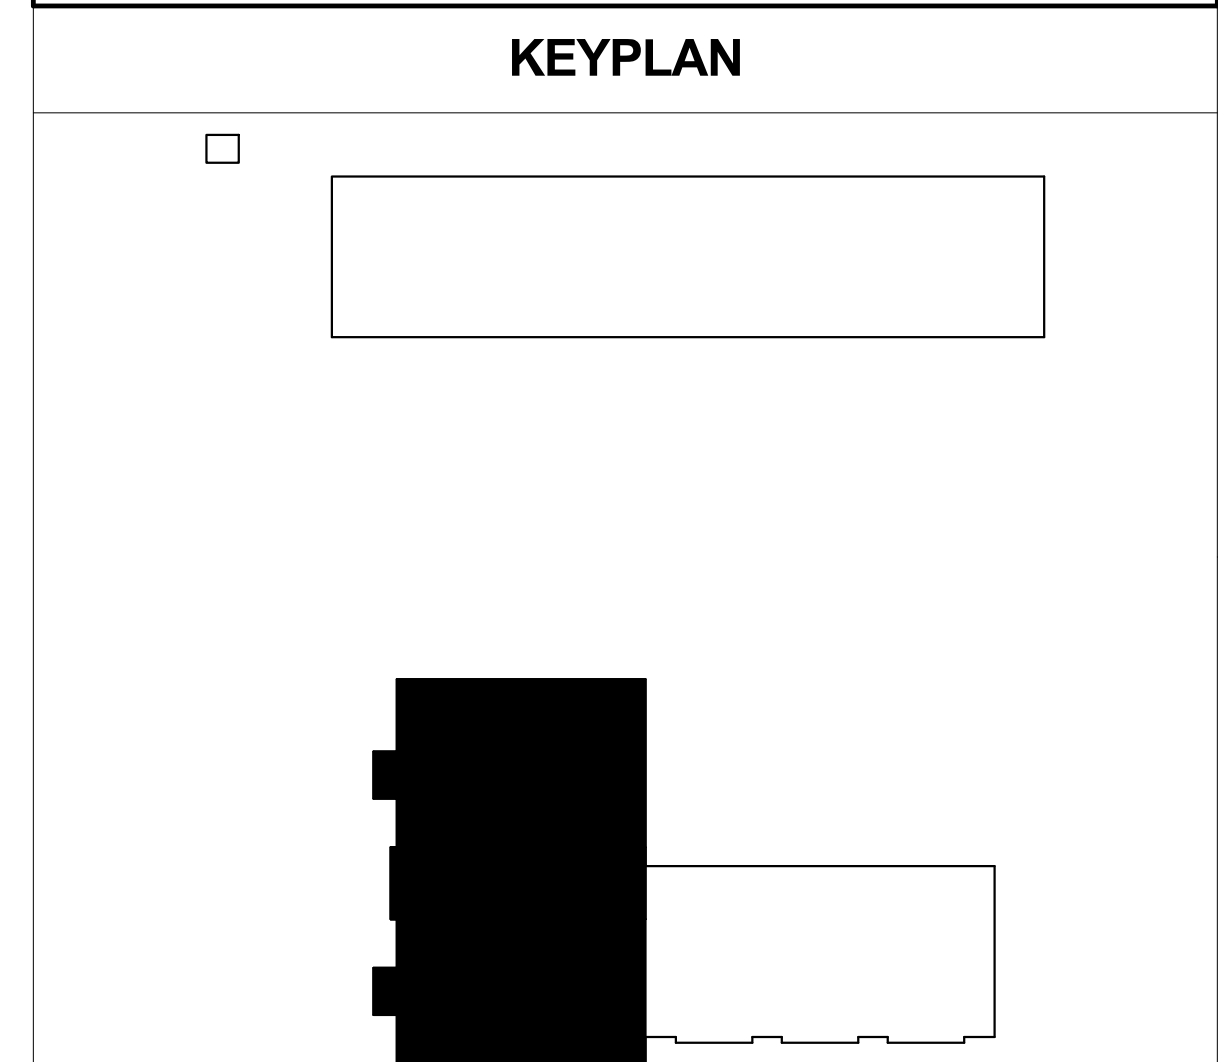

PROJECT: 9202-164730
SCO ID: 16-15656-02B
ITEM: 315 CODE: 41526
DATE: AUGUST 21, 2017
DRAWN BY: RPD
CHECKED BY: DAR

FLOOR PLAN - PATS/FO - WATER AND GAS

P-201A

OPTIMA #: 16-0265 9 OF 12



C:\Users\jdoose\Documents\16-0265_R16 MEP - Update.rvt
8/29/2017 6:46:46 AM

SEQUENCE OF OPERATION

A COMPLETE AND OPERATIONAL DDC CONTROL SYSTEM (BAS) SHALL BE INSTALLED IN ACCORDANCE WITH THE SPECIFICATIONS (SECTION 230900) AND AS INTENDED ON THESE PLANS. ALL CONTROL POINTS AND EQUIPMENT SEQUENCES OF OPERATION LISTED IN SPECIFICATION SECTION 230900 SHALL BE CONSIDERED IN ADDITION TO THOSE LISTED HERE. IN THE EVENT THAT THE VERBIAGE IS IN CONFLICT OR CONTRADICTS THE REQUIREMENTS LISTED HERE, THE QUESTION SHALL BE ASKED BEFORE BIDDING OR THE MORE STRINGENT SHALL APPLY AT THE ENGINEER'S DISCRETION.

NOTE: NEW BAS SHALL BE INTEGRATED WITH THE OWNER'S EXISTING CAMPUS BAS SYSTEM. BAS CONTRACTOR SHALL INCLUDE ALL NECESSARY HARDWARE AND SOFTWARE TO FULLY INTEGRATE NEW SYSTEM WITH THE EXISTING SYSTEM. MECHANICAL CONTRACTOR SHALL COORDINATE ALL EQUIPMENT COMMUNICATION REQUIREMENTS WITH CONTROLS VENDOR PRIOR TO ORDERING EQUIPMENT.

CHILLER PLANT

CHILLER AND CHILLED WATER PUMPS SHALL BE STOPPED/STARTED BY THE BAS ON A PROGRAMMED BASIS. CHILLERS P1, P2, AND SECONDARY CHILLED WATER PUMPS P3, P4 SHALL BE CONTROLLED TO PROVIDE CHILLED WATER TO THE SYSTEM. THE OPERATING PRIMARY PUMP AND OPERATING SECONDARY PUMP SHALL BE STARTED WHEN ANY ZONE IS IN THE OCCUPIED MODE AND THE OUTSIDE AIR TEMPERATURE IS ABOVE 50° F. (ADJ.) AND ANY CHILLED WATER CONTROL VALVE HAS A CALL/DEMAND FOR CHILLED WATER. PRIMARY PUMPS P1, P2, AND SECONDARY PUMPS, P3, P4, SHALL BE CONTROLLED IN AN OPERATING/STAND-BY CONFIGURATION. BAS SHALL ALTERNATE OPERATING/STAND-BY EQUIPMENT TO EQUALIZE RUN TIME.

SECONDARY PUMP SPEED SHALL BE CONTROLLED BY DIFFERENTIAL PRESSURE SENSOR IN THE PIPING SYSTEM TO MAINTAIN SYSTEM PRESSURE. AS AIR HANDLING EQUIPMENT 2-WAY CONTROL VALVES OPEN, OPERATING PUMP SPEED SHALL BE INCREASED VIA VARIABLE FREQUENCY DRIVE TO MAINTAIN SYSTEM PRESSURE SETPOINT.

UPON A CALL FOR CHILLED WATER, THE OPERATING PRIMARY PUMP SHALL BE STARTED. THE CHILLER SHALL BE ENABLED. CHILLER FLOW SWITCH SHALL ENERGIZE CHILLER CONTROL CIRCUIT AND START CHILLER. CHILLER FACTORY CONTROLS SHALL OPERATE CHILLER TO MAINTAIN A SECONDARY CHILLED WATER SUPPLY TEMPERATURE OF 45° F. (ADJ.) BAS SHALL SEND AN ALARM TO THE CENTRAL STATION IF THE SECONDARY CHILLED WATER SUPPLY TEMPERATURE RISES MORE THAN 3° F. (ADJ.) ABOVE THE SETPOINT CONTINUOUSLY FOR A PERIOD OF 15 MINUTES (ADJ.)

BAS SHALL INTERFACE WITH CHILLER CONTROL PANEL TO ALLOW ALL CHILLER MONITOR, CONTROL, AND ALARM FUNCTIONS SPECIFIED WITH THE UNIT TO BE EXECUTED/REPORTED THROUGH THE BAS, INCLUDING SUPPLY AND RETURN TEMPERATURES AND FLOW RATES. CHILLER STATUS AND PUMP STATUS.

CHILLED WATER SUPPLY TEMPERATURE RESET SCHEDULE (ADJ.)
45° F. CHS AT 85° F. O.A. TEMP. (OR ABOVE)
50° F. CHS AT 60° F. O.A. TEMP. (OR BELOW)
CHS SHALL VARY LINEARLY BETWEEN THE HIGH AND LOW SETPOINTS (AS MEASURED IN CHS LOOP)

OPERATING/STANDBY ROTATION

CHILLERS
ROTATE 168 HOURS (SIMILAR TO BOILERS)

PRIMARY PUMPS

PRIMARY PUMP ROTATION IS PERFORMED ON AN OPERATOR SELECTABLE TIME INTERVAL, WHICH SHOULD BE CHOSEN TO BE DIFFERENT THAN THE CHILLER ROTATION SCHEDULE. WHEN THE ROTATION OCCURS, IF THE PRIMARY OPERATING PUMP IS ENABLED, IT WILL REMAIN ENABLED UNTIL PROOF OF FLOW HAS BEEN PROVEN FROM THE NEW "OPERATING" PUMP. OPERATING PRIMARY PUMP SHALL BE ROTATED AUTOMATICALLY TO INCLUDE ALL TWO PUMPS ON A ROTATING BASIS AT TIME INTERVALS OF 168 HOURS RUNTIME (ADJ.). SHOULD AN OPERATING PUMP FAIL, THE STAND-BY PUMP SHOULD BE STARTED AUTOMATICALLY AND ALARM SHALL BE SENT TO THE CENTRAL STATION.

SECONDARY PUMPS

SECONDARY PUMP ROTATION IS PERFORMED ON AN OPERATOR SELECTABLE TIME INTERVAL, WHICH SHOULD BE CHOSEN TO BE DIFFERENT THAN THE CHILLER ROTATION SCHEDULE. WHEN THE ROTATION OCCURS, IF THE SECONDARY OPERATING PUMP IS ENABLED, IT WILL REMAIN ENABLED UNTIL PROOF OF FLOW HAS BEEN PROVEN FROM THE NEW "OPERATING" PUMP. DURING PUMP OPERATION, THE SPEED SIGNAL WILL BE SLOWLY DECREASED TO ZERO ON THE OLD "OPERATING" PUMP TO ALLOW THE NEW "OPERATING" PUMP TO SMOOTHLY ACCEPT THE LOAD AND THEN THE OLD "OPERATING" PUMP WILL BE DISABLED. OPERATING SECONDARY CHILLED WATER PUMP SHALL BE ROTATED AUTOMATICALLY TO INCLUDE ALL TWO PUMPS ON A ROTATING BASIS AT TIME INTERVALS OF 168 HOURS RUNTIME (ADJ.). SHOULD AN OPERATING PUMP FAIL, THE STAND-BY PUMP SHOULD BE STARTED AUTOMATICALLY AND ALARM SHALL BE SENT TO THE CENTRAL STATION.

EMERGENCY OPERATION

UPON RECEIPT OF A STATUS SIGNAL FROM THE GENERATOR/BUILDING ATPS. (GENERATOR RUNNING/OPERATIONAL), ONLY (1) CHILLER/ASSOCIATED PUMPS SHALL OPERATE AND THE OTHER CHILLER/ASSOCIATED PUMPS SHALL SHUT DOWN/REMAIN OFF. AFTER RELEASE OF GENERATOR STATUS (OFF) BOTH CHILLERS/ASSOCIATED PUMPS SHALL BE CAPABLE OF OPERATION

HOT WATER PLANT

SYSTEM SHALL BE STOPPED/STARTED BY THE BAS ON A PROGRAMMED BASIS UPON LOSS OF THE HOT WATER SET POINT. BOILERS SHALL BE CYCLED ON AUTOMATICALLY AT TIME INTERVALS OF 168 HOURS RUNTIME TO ALLOW FOR BOILER USE AND OPERATION.

PRIMARY HOT WATER PUMPS (P3 & P4) AND SECONDARY HOT WATER PUMPS (P7 & P8) SHALL BE ENABLED WITH LEAD BOILER AND ASSOCIATED PRIMARY HOT WATER PUMP AND LEAD SECONDARY HOT WATER PUMP STARTED BY THE BAS WHEN ANY ZONE IS IN THE OCCUPIED MODE AND THE OUTSIDE AIR TEMPERATURE IS BELOW 60° F. (ADJ.) AND MIN 3 VAV HOT WATER CONTROL VALVE HAS A CALL/DEMAND FOR HOT WATER ZONE HAS A DEMAND FOR HEATING OR THE SYSTEM HAS A CALL FOR DEHUMIDIFICATION. BOILERS AND PRIMARY PUMPS SHALL BE STAGED BY THE BOILERS FACTORY CONTROLS AND CASCADING SEQUENCER AS REQUIRED TO MAINTAIN THE SECONDARY HOT WATER SUPPLY TEMPERATURE PER THE RESET SCHEDULE BELOW. SECONDARY PUMPS SHALL BE CONTROLLED IN A LEAD/LAG STAND-BY CONFIGURATION.

SECONDARY HOT WATER SUPPLY TEMPERATURE RESET SCHEDULE (ADJ.)
160° F. HWS AT 30° F. O.A. TEMP. (OR BELOW)
120° F. HWS AT 60° F. O.A. TEMP. (OR ABOVE)
NOTE: HWS SETPOINT SHALL VARY LINEARLY BETWEEN THE HIGH AND LOW SETPOINTS.

LEAD/LAG ROTATION

BOILERS
BOILER LEAD/LAG ROTATION IS PERFORMED ON AN OPERATOR SELECTABLE TIME INTERVAL OR BY AN OPERATOR INITIATED MANUAL SWITCH. UPON A CALL FOR A LEAD/LAG ROTATION SWITCH, THE OLD LEAD BOILER WILL REMAIN ENABLED UNTIL THE NEW LEAD BOILER HAS PICKED UP THE LOAD. THE OLD LEAD CHILLER WILL BE DEMAND LIMITED SLOWLY TO ZERO AND THEN DISABLED NORMALLY. LEAD BOILER SHALL BE ROTATED AUTOMATICALLY AT TIME INTERVALS OF 168 HOURS RUNTIME (ADJ.). SHOULD THE LEAD BOILER (OR ASSOCIATED PRIMARY PUMP) FAIL, THE LAG BOILER SHALL BE STARTED AUTOMATICALLY AND AN ALARM SHALL BE SENT TO THE CENTRAL STATION.

PRIMARY PUMPS

PRIMARY PUMPS SHALL BE CONTROLLED BY THEIR ASSOCIATED BOILER TO OPERATE WITH BOILER.

SECONDARY PUMPS

SECONDARY PUMP ROTATION IS PERFORMED ON AN OPERATOR SELECTABLE TIME INTERVAL, WHICH SHOULD BE CHOSEN TO BE DIFFERENT THAN THE BOILER ROTATION SCHEDULE. WHEN THE ROTATION OCCURS, IF THE SECONDARY OPERATING PUMP IS ENABLED, IT WILL REMAIN ENABLED UNTIL PROOF OF FLOW HAS BEEN PROVEN FROM THE NEW "OPERATING" PUMP. DURING PUMP OPERATION, THE SPEED SIGNAL WILL BE SLOWLY DECREASED TO ZERO ON THE OLD "OPERATING" PUMP TO ALLOW THE NEW "OPERATING" PUMP TO SMOOTHLY ACCEPT THE LOAD AND THEN THE OLD "OPERATING" PUMP WILL BE DISABLED. OPERATING SECONDARY HOT WATER PUMP SHALL BE ROTATED AUTOMATICALLY TO INCLUDE ALL TWO PUMPS ON A ROTATING BASIS AT TIME INTERVALS OF 168 HOURS RUNTIME (ADJ.). SHOULD AN OPERATING PUMP FAIL, THE STAND-BY PUMP SHOULD BE STARTED AUTOMATICALLY AND ALARM SHALL BE SENT TO THE CENTRAL STATION.

A CARBON MONOXIDE/OXYGEN DEPLETION SENSOR SHALL BE PROVIDED IN THE BOILER ROOM AND SHALL SEND AN ALARM TO THE CENTRAL BAS IF ACTIVATED.

EMERGENCY GAS SHUTOFF SWITCH SHALL BE INTERLOCKED WITH ALL THE BOILERS IN THE ASSOCIATED BOILER ROOM AND SHALL SHUT DOWN ALL BOILERS UPON ACTIVATION.

VARIABLE VOLUME AIR HANDLING UNITS (AHU-1)

ALL UNITS SHALL BE STOPPED/STARTED ON A PROGRAMMED BASIS THROUGH THE BAS.

WHILE IN THE OCCUPIED MODE, THE UNIT SUPPLY FAN(S) (WHERE MULTIPLE FANS ARE PROVIDED) SHALL OPERATE TOGETHER, AND UPON LOSS OF A SINGLE FAN, REMAINING FAN OR FANS SHALL CONTINUE TO OPERATE PER THE BELOW SEQUENCE) SHALL OPERATE CONTINUOUSLY. SUPPLY FAN SPEED SHALL BE CONTROLLED BY VARIABLE FREQUENCY DRIVE AND 100% MOUNTED STATIC PRESSURE SENSOR. THE STATIC PRESSURE SENSOR SETPOINT SHALL BE RESET USING A TRIM AND RESPOND ALGORITHM BASED ON ZONE AIR FLOW REQUIREMENTS FROM A LOW SETTING OF 0.75" (ADJ.) TO A HIGH SETTING OF 1.50" (ADJ.) ON A CALL FOR MORE AIRFLOW AT THE ZONE LEVEL AND THE SPACE TEMPERATURE ABOVE SETPOINT. THE SETPOINT SHALL RESET TO THE HIGHER VALUE, AS ZONE TEMPERATURE SETPOINT IS SATISFIED AND THE AIRFLOW DEMAND DECREASES. THE SETPOINT SHALL RESET TO THE LOWER VALUE. RETURN FAN SHALL BE STARTED AND RELIEF DAMPERS SHALL BE MODULATED AS REQUIRED TO MAINTAIN BUILDING PRESSURIZATION AS OUTSIDE AIR DAMPERS MODULATE OPEN. EACH UNIT SHALL BE PROVIDED WITH A PRESSURIZATION SENSOR LOCATED AS INDICATED ON THE PLANS.

RETURN FAN (IF EQUIPPED) SHALL BE STARTED AND STOPPED WITH SUPPLY FAN AND SHALL BE MODULATED BASED ON TRACKING THE SUPPLY AIR FLOW WITH A CONSTANT DIFFERENTIAL OFFSET. UTILIZING THE RETURN AIRFLOW STATION AND SHALL BE EQUAL TO THE BUILDING EXHAUST ASSOCIATED WITH THAT UNIT. DIFFERENTIAL SHALL BE ADJUSTED TO ALLOW FOR THE BUILDING PRESSURE TO REMAIN POSITIVE. BUILDING PRESSURE SHALL BE MONITORED AND AT ANY TIME THE RETURN AIR FAN SPEED SHALL BE ADJUSTED TO MAINTAIN A POSITIVE PRESSURE SETPOINT IN THE UNIT (O.A.R. MIXING SECTION 0.1" WC (ADJ.)). THE UNIT RETURN DAMPER AND RELIEF DAMPERS SHALL BE MODULATED TO PROVIDE THE O.A. AIRFLOW SEQUENCE NOTED BELOW.

A DISCHARGE AIR SENSOR SHALL CONTROL UNIT COOLING AND HEATING CONTROL VALVES TO MAINTAIN THE ROOM/OP UNIT SUPPLY AIR TEMPERATURE PER THE FOLLOWING SUPPLY AIR TEMPERATURE (SAT) RESET SCHEDULE:

SUPPLY AIR TEMPERATURE RESET:
WHEN COOLING IS REQUIRED, CONTROL MODULE SHALL MONITOR ALL VAV TERMINALS AND RECALCULATE SUPPLY AIR TEMPERATURE BASED ON THE MOST DEMANDING ZONE WITHIN THE SETPOINT RANGE (55 °F AND 65 °F, 60 °F INITIAL). FOR EVERY COOLING REQUEST AT THE ZONE LEVEL, SETPOINT WILL BE TRIMMED BY 0.5 ° (ADJUSTABLE) AND WHEN NO REQUESTS ARE PRESENT, 1°F (ADJUSTABLE) WILL BE ADDED TO THE SETPOINT. SUPPLY AIR TEMPERATURE SETPOINT IS OVERRIDDEN AND SUPPLY AIR TEMPERATURE DEFAULTS TO 55 °F. IF THE RETURN AIR RELATIVE HUMIDITY RISES ABOVE 60% RH (ADJUSTABLE), SETPOINT REMAINS 55 °F UNTIL RETURN AIR RELATIVE HUMIDITY FALLS BELOW 55% RH (ADJUSTABLE).

BAS SHALL PROVIDE ECONOMIZER OPERATION TO PROVIDE "FREE COOLING" WHEN OUTDOOR AIR CONDITIONS ALLOW. UPON BAS DETERMINATION THAT OUTSIDE AIR ENTHALPY IS BELOW RETURN AIR ENTHALPY IN COOLING MODE, THE OUTSIDE AIR, RETURN AIR AND RELIEF AIR DAMPERS SHALL MODULATE TO MAINTAIN UNIT DISCHARGE AIR TEMPERATURE. IF ECONOMIZER CONTROL IS INSUFFICIENT TO MAINTAIN DISCHARGE AIR TEMPERATURE, THE UNIT COOLING CYCLE SHALL FUNCTION AS OUTLINED ABOVE. UPON A DROP IN DISCHARGE AIR TEMPERATURE BELOW 55° F. (ADJ.) OR FALLS BELOW 78° F. (ADJ.), THE DAMPERS SHALL MODULATE CLOSED UNTIL THE MINIMUM OUTSIDE AIR POSITION IS REACHED. BUILDING PRESSURE SHALL BE MONITORED AND DAMPERS SHALL BE ADJUSTED TO PREVENT AN OVERPRESSURIZATION OF THE SPACE WHERE THE BUILDING PRESSURE SENSORS ARE LOCATED.

CONTROLS SHALL PROVIDE FOR MORNING WARM-UP AND NIGHT SETBACK DURING UNOCCUPIED TIMES. UPON UNIT START-UP, IF RETURN AIR TEMPERATURE IS BELOW 65° F. (ADJ.) OR ABOVE 75° F. (ADJ.), THE OUTSIDE AIR DAMPERS SHALL REMAIN CLOSED AND THE HEATING OR COOLING CONTROL VALVES SHALL OPEN TO THE HEATING OR COOLING COILS AS REQUIRED TO RAISE OR LOWER THE RETURN AIR TEMPERATURE. WHEN RETURN AIR TEMPERATURE RISES ABOVE 62° F. (ADJ.) OR FALLS BELOW 78° F. (ADJ.), THE UNIT SHALL BE CONTROLLED AS OUTLINED ABOVE.

WHILE IN THE UNOCCUPIED MODE, THE UNIT SUPPLY FAN SHALL BE OFF, THE CHILLED WATER AND HOT WATER CONTROL VALVES SHALL BE CLOSED TO THE UNIT AND THE TERMINAL UNIT SPACE TEMPERATURE SETPOINTS SHALL BE SET TO UNOCCUPIED SETTINGS OF 60° FOR HEATING (ADJ) AND 85° FOR COOLING (ADJ.) UPON A CALL FOR HEATING OR COOLING TO MEET UNOCCUPIED SETPOINTS, THE UNIT FAN SHALL BE STARTED AND THE HEATING OR CHILLED WATER CONTROL VALVES SHALL BE OPENED TO THE HEATING OR COOLING COIL AS REQUIRED BY THE SPACE TEMPERATURE. THE BOILER PLANT OR CHILLER PLANT SHALL ALSO BE STARTED AS REQUIRED TO SATISFY SETPOINTS. THE UNIT AND ASSOCIATED CENTRAL PLANT SHALL OPERATE FOR A MINIMUM OF 30 MINUTES (OR AS REQUIRED TO SATISFY UNOCCUPIED SETPOINT) AND SHALL NOT BE ALLOWED TO RESTART FOR A MINIMUM OF 15 MINUTES FOLLOWING SATISFACTION OF UNOCCUPIED SETPOINT AND SYSTEM SHUT-DOWN.

OUTSIDE AIR INTAKE SHALL BE PROVIDED WITH (2) MOTORIZED DAMPERS (1) SIZED FOR MINIMUM OUTSIDE (2-POSITION) AND (1) SIZED FOR THE REMAINING CO2 CONTROL AND ECONOMIZER OUTSIDE AIRFLOW (MODULATING), ON UNIT START UP, THE O.A. DAMPERS SHALL REMAIN CLOSED UNTIL THE RETURN AIR TEMPERATURE RISES ABOVE 65° (ADJ.) OR FALLS BELOW 78° (ADJ.). ONCE RETURN AIR TEMPERATURE IS SATISFIED, THE MINIMUM O.A. INTAKE DAMPER SHALL BE OPEN WHILE THE AIR HANDLING UNIT IS IN THE OCCUPIED MODE. DAMPER SHALL OPEN TO MAINTAIN THE MINIMUM OUTSIDE AIRFLOW. DAMPER SHALL REMAIN CLOSED WHILE THE UNIT IS IN THE UNOCCUPIED MODE. DAMPER SHALL BE CAPABLE OF OPENING AND CLOSING OUTSIDE AIR DAMPERS.

CO2 SENSORS MOUNTED IN THE SPACE (RETURN DUCT FOR VERIFICATION ONLY) SHALL MODULATE THE CO2/ECONOMIZER OUTSIDE AIR DAMPER BASED ON CO2 LEVELS IN THE SPACE. DAMPER SHALL MODULATE OPEN AS REQUIRED TO MAINTAIN A SPACE CO2 LEVEL OF 700 PPM ABOVE THE OUTSIDE AIR CO2 LEVEL. AN ALARM SHALL BE ACTIVATED IF THE SPACE CO2 LEVEL RISES ABOVE 1200 PPM.

CO2 CONTROL SHALL APPLY TO AIR HANDLING UNITS - AHU 1,2

SMOKE DETECTOR SHALL BE PROVIDED IN THE RETURN DUCT (UPSTREAM OF THE OUTSIDE AIR DUCT CONNECTION). DETECTOR SHALL SHUT DOWN SUPPLY AND RELIEF FAN UPON ACTIVATION.

A FREEZE-STAT SHALL BE LOCATED IN THE MIXED AIR STREAM TO SHUT-DOWN SUPPLY FAN IF THE MIXED AIR TEMPERATURE FALLS BELOW 40° F. FREEZE-STAT SHALL HAVE MANUAL RESET ONLY. (FREEZE-STAT SHALL BE LOCATED DOWNSTREAM OF PREHEAT COIL.)

STATIC PRESSURE RESET SHALL BE PROVIDED TO POLL ALL BOXES AND ADJUST STATIC PRESSURE SETPOINT DOWN UNTIL (1) BOX IS IN FULL COOLING MODE. THE ASSOCIATED HOT WATER PUMP (P-9) SERVING THE HOT WATER PREHEAT COIL SHALL BE ACTIVATED WHEN THE OAT DROPS TO 45° (ADJ.) AND THE PREHEAT CONTROL VALVE SHALL MODULATE TO MAINTAIN A MINIMUM COIL DISCHARGE AIR TEMPERATURE PER THE RESET SCHEDULE.

UNIT HEATERS

A SPACE TEMPERATURE SENSOR SHALL CONTROL UNIT HEATER FAN AND HOT WATER CONTROL VALVE TO MAINTAIN SPACE TEMPERATURE ABOVE SETPOINT WITH SPACE TEMPERATURE ABOVE SETPOINT. FAN SHALL REMAIN OFF AND CONTROL VALVE SHALL REMAIN CLOSED. AS SPACE TEMPERATURE FALLS BELOW SETPOINT, THE FAN SHALL BE STARTED AND THE HOT WATER VALVE SHALL OPEN TO THE UNIT TO SATISFY SETPOINT.

MISC. EXHAUST FANS

PROVIDE WALL SWITCHES, WALL THERMOSTATS, INTERLOCKS, ETC. AS INDICATED ON THE FAN SCHEDULE TO CONTROL FANS AS INDICATED ON PLANS.

TOILET EXHAUST FANS

BAS SHALL OPERATE EXHAUST FANS ON A PROGRAMMED SCHEDULE.

WELDING AREA GENERAL EXHAUST FAN

FAN SHALL BE PROVIDED WITH HAND-OFF-AUTO SWITCH. FAN SHALL BE CAPABLE OF BEING OPERATED IN MANUAL MODE (ON OR OFF) AND IN AUTOMATIC MODE. UPON SENSING OF CURRENT (BY CURRENT SENSORS) ON ASSOCIATED DEDICATED WELDER CIRCUIT FAN AND ASSOCIATED MOTOR OPERATED DAMPER ON OUTSIDE AIR HOOD SHALL OPEN/TURN ON. AFTER NO CURRENT IS SENSED ON ASSOCIATED WELDER CIRCUITS, FAN AND DAMPER SHALL OPERATE FOR 10 MINS (ADJ.), THEN CLOSE/TURN OFF. ALL DIGITAL/ANALOG RELAYS TO PULL SIGNAL FROM OT PROVIDED IN ELECTRICAL PANEL (BY EC) SHALL BE BY CONTROLS CONTRACTOR

VARIABLE VOLUME AIR HANDLING UNITS (AHU-2&3)

ALL UNITS SHALL BE STOPPED/STARTED ON A PROGRAMMED BASIS THROUGH THE BAS.

WHILE IN THE OCCUPIED MODE, THE UNIT SUPPLY FAN(S) (WHERE MULTIPLE FANS ARE PROVIDED) SHALL OPERATE TOGETHER, AND UPON LOSS OF A SINGLE FAN, REMAINING FAN OR FANS SHALL CONTINUE TO OPERATE PER THE BELOW SEQUENCE) SHALL OPERATE CONTINUOUSLY. SUPPLY FAN SPEED SHALL BE CONTROLLED BY A VARIABLE FREQUENCY DRIVE AND DUCT MOUNTED STATIC PRESSURE SENSOR. THE STATIC PRESSURE SENSOR SETPOINT SHALL BE RESET USING A TRIM AND RESPOND ALGORITHM BASED ON ZONE AIR FLOW REQUIREMENTS FROM A LOW SETTING OF 0.75" (ADJ.) TO A HIGH SETTING OF 1.50" (ADJ.) ON A CALL FOR MORE AIRFLOW AT THE ZONE LEVEL AND THE SPACE TEMPERATURE ABOVE SETPOINT. THE SETPOINT SHALL BE RESET TO THE HIGHER VALUE, AS ZONE TEMPERATURE SETPOINT IS SATISFIED AND THE AIRFLOW DEMAND DECREASES. THE SETPOINT SHALL RESET TO THE LOWER VALUE. EACH UNIT SHALL BE PROVIDED WITH A PRESSURIZATION SENSOR LOCATED AS INDICATED ON THE PLANS.

A DISCHARGE AIR SENSOR SHALL CONTROL UNIT COOLING AND HEATING CONTROL VALVES TO MAINTAIN THE ROOM/OP UNIT SUPPLY AIR TEMPERATURE PER THE FOLLOWING SUPPLY AIR TEMPERATURE (SAT) RESET SCHEDULE:

SUPPLY AIR TEMPERATURE RESET:
WHEN COOLING IS REQUIRED, CONTROL MODULE SHALL MONITOR ALL VAV TERMINALS AND RECALCULATE SUPPLY AIR TEMPERATURE BASED ON THE MOST DEMANDING ZONE WITHIN THE SETPOINT RANGE (55 °F AND 65 °F, 60 °F INITIAL). FOR EVERY COOLING REQUEST AT THE ZONE LEVEL, SETPOINT WILL BE TRIMMED BY 0.5 ° (ADJUSTABLE) AND WHEN NO REQUESTS ARE PRESENT, 1°F (ADJUSTABLE) WILL BE ADDED TO THE SETPOINT. SUPPLY AIR TEMPERATURE SETPOINT IS OVERRIDDEN AND SUPPLY AIR TEMPERATURE DEFAULTS TO 55 °F. IF THE RETURN AIR RELATIVE HUMIDITY RISES ABOVE 60% RH (ADJUSTABLE), SETPOINT REMAINS 55 °F UNTIL RETURN AIR RELATIVE HUMIDITY FALLS BELOW 55% RH (ADJUSTABLE).

BAS SHALL PROVIDE ECONOMIZER OPERATION TO PROVIDE "FREE COOLING" WHEN OUTDOOR AIR CONDITIONS ALLOW. UPON BAS DETERMINATION THAT OUTSIDE AIR ENTHALPY IS BELOW RETURN AIR ENTHALPY IN COOLING MODE, THE OUTSIDE AIR, RETURN AIR AND RELIEF AIR DAMPERS SHALL MODULATE TO MAINTAIN UNIT DISCHARGE AIR TEMPERATURE. IF ECONOMIZER CONTROL IS INSUFFICIENT TO MAINTAIN DISCHARGE AIR TEMPERATURE, THE UNIT COOLING CYCLE SHALL FUNCTION AS OUTLINED ABOVE. UPON A DROP IN DISCHARGE AIR TEMPERATURE BELOW 55° F. (ADJ.) OR FALLS BELOW 78° F. (ADJ.), THE DAMPERS SHALL MODULATE CLOSED UNTIL THE MINIMUM OUTSIDE AIR POSITION IS REACHED. BUILDING PRESSURE SHALL BE MONITORED AND DAMPERS SHALL BE ADJUSTED TO PREVENT AN OVERPRESSURIZATION OF THE SPACE WHERE THE BUILDING PRESSURE SENSORS ARE LOCATED.

CONTROLS SHALL PROVIDE FOR MORNING WARM-UP AND NIGHT SETBACK DURING UNOCCUPIED TIMES. UPON UNIT START-UP, IF RETURN AIR TEMPERATURE IS BELOW 65° F. (ADJ.) OR ABOVE 75° F. (ADJ.), THE OUTSIDE AIR DAMPERS SHALL REMAIN CLOSED AND THE HEATING OR COOLING CONTROL VALVES SHALL OPEN TO THE HEATING OR COOLING COILS AS REQUIRED TO RAISE OR LOWER THE RETURN AIR TEMPERATURE. WHEN RETURN AIR TEMPERATURE RISES ABOVE 62° F. (ADJ.) OR FALLS BELOW 78° F. (ADJ.), THE UNIT SHALL BE CONTROLLED AS OUTLINED ABOVE.

WHILE IN THE UNOCCUPIED MODE, THE UNIT SUPPLY FAN SHALL BE OFF, THE CHILLED WATER AND HOT WATER CONTROL VALVES SHALL BE CLOSED TO THE UNIT AND THE TERMINAL UNIT SPACE TEMPERATURE SETPOINTS SHALL BE SET TO UNOCCUPIED SETTINGS OF 60° FOR HEATING (ADJ) AND 85° FOR COOLING (ADJ.) UPON A CALL FOR HEATING OR COOLING TO MEET UNOCCUPIED SETPOINTS, THE UNIT FAN SHALL BE STARTED AND THE HEATING OR CHILLED WATER CONTROL VALVES SHALL BE OPENED TO THE HEATING OR COOLING COIL AS REQUIRED BY THE SPACE TEMPERATURE. THE BOILER PLANT OR CHILLER PLANT SHALL ALSO BE STARTED AS REQUIRED TO SATISFY SETPOINTS. THE UNIT AND ASSOCIATED CENTRAL PLANT SHALL OPERATE FOR A MINIMUM OF 30 MINUTES (OR AS REQUIRED TO SATISFY UNOCCUPIED SETPOINT) AND SHALL NOT BE ALLOWED TO RESTART FOR A MINIMUM OF 15 MINUTES FOLLOWING SATISFACTION OF UNOCCUPIED SETPOINT AND SYSTEM SHUT-DOWN.

OUTSIDE AIR INTAKE SHALL BE PROVIDED WITH (2) MOTORIZED DAMPERS (1) SIZED FOR MINIMUM OUTSIDE (2-POSITION) AND (1) SIZED FOR THE REMAINING CO2 CONTROL AND ECONOMIZER OUTSIDE AIRFLOW (MODULATING), ON UNIT START UP, THE O.A. DAMPERS SHALL REMAIN CLOSED UNTIL THE RETURN AIR TEMPERATURE RISES ABOVE 65° (ADJ.) OR FALLS BELOW 78° (ADJ.). ONCE RETURN AIR TEMPERATURE IS SATISFIED, THE MINIMUM O.A. INTAKE DAMPER SHALL BE OPEN WHILE THE AIR HANDLING UNIT IS IN THE OCCUPIED MODE. DAMPER SHALL OPEN TO MAINTAIN THE MINIMUM OUTSIDE AIRFLOW. DAMPER SHALL REMAIN CLOSED WHILE THE UNIT IS IN THE UNOCCUPIED MODE. BAS SHALL BE CAPABLE OF OPENING AND CLOSING OUTSIDE AIR DAMPERS.

SMOKE DETECTOR SHALL BE PROVIDED IN THE RETURN DUCT (UPSTREAM OF THE OUTSIDE AIR DUCT CONNECTION). DETECTOR SHALL SHUT DOWN SUPPLY FAN UPON ACTIVATION.

A FREEZE-STAT SHALL BE LOCATED IN THE MIXED AIR STREAM TO SHUT-DOWN SUPPLY FAN IF THE MIXED AIR TEMPERATURE FALLS BELOW 40° F. FREEZE-STAT SHALL HAVE MANUAL RESET ONLY. (FREEZE-STAT SHALL BE LOCATED DOWNSTREAM OF PREHEAT COIL.)

FAN COIL UNITS

FAN COIL UNITS SHALL BE STOPPED/STARTED ON A PROGRAMMED BASIS THROUGH THE BAS.

WHILE IN THE OCCUPIED MODE, THE SUPPLY FAN SHALL OPERATE CONTINUOUSLY. A WALL MOUNTED TEMPERATURE SENSOR SHALL BE UTILIZED TO MAINTAIN SPACE TEMPERATURE OF 72° (ADJ.). CHILLED WATER CONTROL VALVE SHALL MODULATE OPEN TO THE COIL ON A RISE IN TEMPERATURE ABOVE SENSOR SETPOINT. AS THE TEMPERATURE SPACE FALLS BELOW SETPOINT, CHILLED WATER CONTROL VALVE SHALL CLOSE AND HOT WATER CONTROL VALVE SHALL MODULATE OPEN TO MAINTAIN SPACE TEMPERATURE.

WHERE NOTED ON FCU SCHEDULE THE MINIMUM O.A. AIRFLOW SHALL BE PROVIDED VIA INTERLOCKED O.A.-MOTOR OPERATED DAMPER, OUTSIDE AIR ROOF HOOD, AND RELIEF AIR-MOTOR OPERATED DAMPER, AND RELIEF HOOD. DAMPERS SHALL BE OPEN DURING ALL TIMES FCU IS IN OPERATION. BALANCING DAMPER IN O.A. DUCT SHALL BE BALANCED TO PROVIDE MIN. OUTSIDE AIR LISTED IN SCHEDULE.

WHILE IN THE UNOCCUPIED MODE, THE UNIT SUPPLY FAN SHALL BE OFF, THE CHILLED WATER AND HOT WATER CONTROL VALVES SHALL BE CLOSED TO THE UNIT AND THE SPACE TEMPERATURE SETPOINTS SHALL BE SET TO UNOCCUPIED SETTINGS OF 60° FOR HEATING (ADJ) AND 85° FOR COOLING (ADJ.) UPON A CALL FOR HEATING OR COOLING TO MEET UNOCCUPIED SETPOINTS, THE UNIT FAN SHALL BE STARTED AND THE HEATING OR CHILLED WATER CONTROL VALVES SHALL BE OPENED TO THE HEATING OR COOLING COIL AS REQUIRED BY THE SPACE TEMPERATURE. THE BOILER PLANT OR CHILLER PLANT SHALL ALSO BE STARTED AS REQUIRED TO SATISFY SETPOINTS. THE UNIT AND ASSOCIATED CENTRAL PLANT SHALL OPERATE FOR A MINIMUM OF 30 MINUTES (OR AS REQUIRED TO SATISFY UNOCCUPIED SETPOINT) AND SHALL NOT BE ALLOWED TO RESTART FOR A MINIMUM OF 15 MINUTES (ADJ.) FOLLOWING SATISFACTION OF UNOCCUPIED SETPOINT AND SYSTEM SHUT-DOWN.

DRAIN PAN FLOAT ALARM SHALL BE INTERLOCKED WITH UNIT OPERATION, AND SHALL SHUT-DOWN UNIT UPON BEING ACTIVATED.

HEAT TAPE

HEAT TAPE FOR ABOVE GRADE EXTERIOR PIPING AND CHILLER HEATER SHALL PROVIDE FREEZE PROTECTION FOR EXTERIOR CHILLED WATER SYSTEMS. THESE SYSTEM SHALL BE PROVIDED WITH EMERGENCY POWER TO CONTINUE FREEZE PROTECTION DURING A POWER OUTAGE. A TEMPERATURE SENSOR SHALL BE PROVIDED WITHIN THE INSULATION ON ALL EXTERIOR PIPING WITH HEAT TAPE TO VERIFY HEAT TAPE OPERATION. IF TEMPERATURE FALLS BELOW 35° F. (ADJ.) AN ALARM SHALL BE SENT AND THE PRIMARY CHILLED WATER PUMPS (P-1, P-2,) SHALL BE STARTED.

WATER HEATER

BAS SHALL HAVE GLOBAL CONTROL OVER DOMESTIC WATER HEATING SYSTEM.

OFFICE / SHOPS:

- WH1: HEATER SET TO 140 DEGREES, WITH MIXING VALVE DELIVERING 120-DEGREE SUPPLY
- RCPI: SUPPLY AT 120 DEGREES AND RETURN AT 110 DEGREES
- HIGH TEMP ALARM AT 125 DEGREES

WAREHOUSE:

- WH4: HEATER SET TO 140 DEGREES (NO MAIN MIXING VALVE)
- RCPI: SUPPLY AT 140 DEGREES AND RETURN AT 130 DEGREES (DUE TO EMERGENCY SHOWERS)
- HIGH TEMP ALARM AT 150 DEGREES

WATER HEATER SHALL CYCLE ON AND OFF BASED ON TANK TEMPERATURE, TO MAINTAIN NOTED TEMPERATURES. AN ALARM SHALL BE GENERATED SHOULD TANK DEVIATE FROM SETPOINT BY 10° EITHER HIGH OR LOW. AN ALARM SHALL ALSO BE GENERATED SHOULD THE DOMESTIC HWRS TEMPERATURE DEVIATE FROM SETPOINT BY 10° EITHER HIGH OR LOW. CIRCULATION PUMPS SHALL OPERATE BASED ON THE AQUASTAT TEMPERATURE SETTINGS. A TEMPERATURE SENSOR SHALL BE MOUNTED IN THE END OF THE LINE CAPABLE OF OVERRIDING THE PUMP SHOULD THE LOOP TEMPERATURE FALL BELOW NOTED TEMPERATURES FOR RCP-1 & 4. BAS SHALL ALSO MONITOR BOTH DOMESTIC HWR TEMPERATURES AND DOMESTIC WATER SUPPLY TEMPERATURE FOR TRACKING PURPOSES. COORDINATE ALL TEMPERATURE SENSOR LOCATIONS WITH PLUMBING CONTRACTOR.

DUCTLESS SPLIT SYSTEMS:

UNITS SHALL PROVIDE COOLING ON A CONTINUOUS BASIS. SUPPLY FAN SHALL RUN CONTINUOUSLY AND COOLING CYCLE SHALL CYCLE WITH A CALL FOR COOLING TO MAINTAIN ROOM TEMPERATURE SETPOINT OF 75° F. (ADJ.). UNITS SHALL BE PROVIDED WITH STANDBY MODE. THE UNIT SHALL BE STARTED AS REQUIRED TO SATISFY SETPOINTS AND SHALL ALSO MONITOR ROOM TEMPERATURE WITH A WALL MOUNTED TEMPERATURE SENSOR. AN ALARM SHALL BE GENERATED UPON AN EQUIPMENT FAILURE OR IF THE ROOM TEMPERATURE RISES ABOVE 85° F. (ADJ.)

DUCT MOUNTED SMOKE DETECTORS:

SMOKE DETECTOR SHALL BE PROVIDED IN THE RETURN DUCT PRIOR TO THE OUTSIDE AIR DUCT CONNECTION. DETECTOR SHALL INTERFACE WITH FIRE ALARM SYSTEM AND SHUT-DOWN UNIT FANS UPON ACTIVATION. A NOTIFICATION ALARM SHALL BE GENERATED WHEN A SMOKE DETECTOR IS ACTIVATED. SMOKE DETECTORS SHALL BE INDICATED ON EQUIPMENT GRAPHICS WITH WHICH DETECTOR IS ASSOCIATED.

VARIABLE AIR VOLUME BOXES

A TEMPERATURE SENSOR SHALL BE UTILIZED TO MAINTAIN SPACE TEMPERATURE SETPOINT OF 72° (ADJ.) ON RISE IN SPACE TEMPERATURE ABOVE SETPOINT. THE VOLUME DAMPER SHALL OPEN AS REQUIRED TO MAINTAIN SPACE TEMPERATURE. ON DROP IN SPACE TEMPERATURE BELOW SETPOINT, THE VOLUME DAMPER SHALL CLOSE UNTIL THE MINIMUM DAMPER POSITION IS REACHED. THE HOT WATER CONTROL VALVE SHALL BE MODULATED OPEN TO THE HEATING COIL AND THE TERMINAL UNIT DAMPER SHALL OPEN TO THE MIN O.P.M. AS INDICATED IN THE SCHEDULE. AS THE TEMPERATURE RISES ABOVE SETPOINT THE HOT WATER CONTROL VALVE SHALL CLOSE AND THE DAMPER SHALL RETURN TO THE MINIMUM POSITION.

WHEN WARM AIR IS SENSED BY THE TERMINAL UNIT DURING MORNING WARM-UP, THE DAMPER SHALL RESPOND TO THE SPACE TEMPERATURE. THE TERMINAL UNIT DAMPER SHALL OPEN ON A CALL FOR HEATING AND SHALL REMAIN CLOSED IF THE SPACE TEMPERATURE IS AT OR ABOVE OCCUPIED SETPOINT.

THE TEMPERATURE SENSOR SHALL BE PROVIDED WITH AN OVERRIDE FUNCTION THAT WILL PLACE THE SYSTEM IN THE OCCUPIED MODE FOR A PERIOD OF UP TO 2 HOURS. THE OVERRIDE SHALL ACTIVATE THE SYSTEM AHU AND THE HEATING OR COOLING CENTRAL PLANT AS REQUIRED TO MAINTAIN SPACE TEMPERATURE. TEMPERATURE SENSORS SHALL HAVE A MIN 5°F DEADBAND

FREEZE PROTECTION (LOSS OF POWER)

HEAT TAPE FOR EXTERIOR PIPING AT CHILLER SHALL BE PROVIDED WITH EMERGENCY POWER TO PROVIDE FREEZE PROTECTION. A TEMPERATURE SENSOR SHALL BE PROVIDED WITHIN THE INSULATION ON ALL EXTERIOR PIPING WITH HEAT TAPE TO VERIFY HEAT TAPE OPERATION. IF TEMPERATURE FALLS BELOW 35° F. (ADJ.) AN ALARM SHALL BE SENT.

DUST COLLECTOR

PROVIDE CONTROL RELAY FOR AUTOMATIC SHUTDOWN WHEN SIGNAL RECEIVED FROM (FA/EPO) SYSTEM

OPERATION SHALL BE VIA A WALL MOUNTED CONTROL BOX WITH PUSH BUTTON MAGNETIC STARTER PROVIDED TO RUN DUST COLLECTOR FOR 4 HOURS (ADJ.) THEN SHUT OFF.

ASSOCIATED MOTOR OPERATED DAMPER IN O.A. PLENUM SHALL BE OPEN WHENEVER DUST COLLECTOR IS IN OPERATION, AND CLOSED WHEN NOT IN OPERATION.

PROVIDE WITH MANUAL OVERRIDE FOR ON/OFF OPERATION

UTILITY MONITORING:

THE INTENT OF THE SYSTEM IS TO CONSTANTLY MEASURE THE NOTED UTILITIES. THE CONTROLS CONTRACTOR (SYSTEM INTEGRATOR) WILL PROVIDE THE DATA LOGGING DEVICES AS REQUIRED TO MONITOR THE BUILDING UTILITIES FOR THIS PROJECT.

UTILITY MONITORING NOTES:

- DOMESTIC WATER AND NATURAL GAS PULSE METERS SHALL BE PROVIDED AND INSTALLED BY THE PLUMBING CONTRACTOR. METERS SHALL PROVIDE BOTH CUBIC FEET (CF) TOTAL USAGE AND CUBIC FEET PER HOUR (CFH) DEMAND.
- ELECTRICAL CIRCUITS AND CT'S FOR MONITORING POWER SHALL BE PROVIDED AND INSTALLED BY THE ELECTRICAL CONTRACTOR. ELECTRICAL CONTRACTOR SHALL ALSO PROVIDE AND INSTALL 3-PHASE AND MULTI-CIRCUIT METERS.
- THE CONTROLS CONTRACTOR (SYSTEM INTEGRATOR) SHALL COORDINATE COMMUNICATION PROTOCOL REQUIREMENTS FOR ALL METERS AND MONITORING DEVICES WITH ALL OTHER DIVISIONS TO ENSURE SYSTEM COMPATIBILITY.
- DATA LOGGER SHALL BE EQUAL TO TRIDUIM JACE

CONTROL SYSTEM NOTES

1. SEE SPECIFICATIONS (SECTION 230900) FOR ADDITIONAL REQUIREMENTS.

2. THE SEQUENCE OF OPERATION OF OPERATION AND POINTS LIST IS INTENDED TO COMMUNICATE THE MINIMUM REQUIREMENTS AND GENERAL DESIGN INTENT TO THE CONTROLS CONTRACTOR AND IS NOT INTENDED TO BE A FULLY DEVELOPED OR COMPLETED SEQUENCE OF OPERATION. AN INSTRUMENT SUBMITTAL THE CONTROLS CONTRACTOR SHALL FULLY DEVELOP THE SEQUENCE OF OPERATIONS FOR ALL SYSTEMS IDENTIFIED AND SHALL PRESENT ALL SETPOINTS, CONTROL PARAMETERS, TIME DELAYS, ALARM SETTINGS, ETC. AS REQUIRED TO COMPLY WITH THE DESIGN INTENT. THE CONTROLS CONTRACTOR SHALL INCORPORATE STANDARD FEATURES SUCH AS MINIMUM RUN TIME DELAYS, TRIP AND SHUT-DOWN ALARMS, ETC. ALL MONITORED POINTS SHALL INCLUDE EARLY HIGH/LOW ALARM NOTIFICATIONS PRIOR TO REQUIRED CORRECTIVE ACTIONS OR UNIT SHUT-DOWNS. CONTROL CONTRACTOR SHALL SPECIFY IN THE CONTROL SUBMITTAL FAIL SAFE POSITION FOR CUT OF RANGE, FAIL SAFE POSITIONING FOR OPEN CIRCUITS OR LOSS OF COMMUNICATION.


3. SYSTEM SHALL USE CAMPUS SYSTEM GLOBAL OUTSIDE AIR TEMPERATURE AND HUMIDITY SENSORS FOR PRIMARY SYSTEM OPERATION. LOCAL OUTSIDE AIR TEMPERATURE AND HUMIDITY SENSORS SHALL BE PROVIDED FOR SYSTEM OPERATION UPON LOSS OF NETWORK COMMUNICATION.

4. ALL CONTROL SETPOINTS SHALL BE ADJUSTABLE AND TRENDABLE. INDICATED TEMPERATURE SETPOINTS SHOULD BE USED FOR ORIGINAL SYSTEM SET-UP. ANY CHANGES IN SETPOINT SETTINGS REQUIRED FOR INTENDED SYSTEM OPERATION SHALL BE NOTED ON AS-BUILT CONTROL DRAWINGS.

5. FLOW SWITCHES OR ADJUSTABLE TYPE CURRENT SWITCHES SHALL BE PROVIDED IN THE PIPING OF EACH PUMP TO VERIFY PUMP STATUS.

6. IONIZATION TYPE DUCT SMOKE DETECTORS SHALL BE FURNISHED AND WIRED TO THE FIRE ALARM SYSTEM BY THE ELECTRICAL CONTRACTOR. MECHANICAL CONTRACTOR SHALL INSTALL DETECTORS IN THE DUCT AND WIRE UNIT FROM FIRE ALARM SYSTEM (DRY CONTACTS) FOR UNIT SHUT-DOWN UPON ACTIVATION.

7. ELECTRICAL CONTRACTOR SHALL PROVIDE DEDICATED 120V CIRCUITS IN A J-BOX FOR CONTROL POWER. CONTROLS CONTRACTOR SHALL EXT

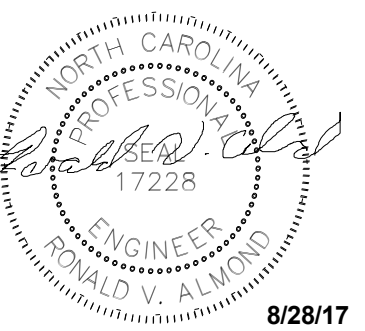

8/28/17

MEMBERS OF THE AMERICAN INSTITUTE OF ARCHITECTS

COPYRIGHT 2016 ALL RIGHTS RESERVED
PRINTED OR ELECTRONIC DRAWINGS AND DOCUMENTATION MAY NOT BE REPRODUCED IN ANY FORM WITHOUT WRITTEN PERMISSION FROM LS3P ASSOCIATES LTD.

REVISIONS:

No.	Description	Date
1	Addendum #4	8.28.2017

PROJECT: 9202-164730
SCO ID: 16-15656-02B
ITEM: 315 CODE: 41526
DATE: AUGUST 21, 2017
DRAWN BY: CAH
CHECKED BY: RVA


MECHANICAL POINTS LIST

M-006

OPTIMA #: 16-0265













INPUT/OUTPUT SUMMARY

SYSTEM APPARATUS, OR AREA POINT DESCRIPTION	INPUTS										OUTPUTS										SYSTEM FEATURES										GENERAL	SUPPLEMENTAL NOTES	
	ANALOG					BINARY					DIGITAL					ANALOG					ALARMS					PROGRAMS							
	TEMPERATURE	PRESSURE	PH	ANALOG	CALC.	STATUS	FREEZE	SMOKE	METER	OVERRIDE	OFF-ON	OFF-HOLD	OFF-ALLO	OPER-CLOSE	DMPR. POS.	VALVE POS.	VALVE POS. ADJ.	STEP CONTROL	HI ANALOG	LO ANALOG	LO BINARY	PROOF	TIME SCHEDULING	DEMAND LIMITING	DEMAND LIMITING	ENTHALPY OPT.	ENTHALPY OPT.	TREND	ALARM INSTRUCT	MANUAL OVRD.			COLOR GRAPHIC
Chiller Plant																																	
CHLR On/Off																																	
CHLR Status																																	
CHLR Panel Interface	X	X	X	X	X	X	X	X	X	X					X	X	X	X	X	X	X	X											
CHLR CHS Temp	X																																Mount 48" downstream of outlet
CHLR CHR Temp	X																																
VFD on/off																																	
VFD Speed																																	
VFD Status																																	
Pump P-1																																	
Pump P-2																																	
Pump P-3																																	
Pump P-4																																	
BLDG CHWS Temp	X																																
BLDG CHWR Temp	X																																
Diff Press	X																																
AHU-1,2,3																																	
Return & Supply Fan																																	
VFD on/off																																	
VFD Speed																																	
VFD Status																																	
Supply Static Pressure	X																																
HW Valve (Preheat)																																	
Preheat Coil Disch. Temp	X																																
CHW Valve																																	
Cooling Coil Disch. Temp	X																																
Supply Temp	X																																
Return Temp	X																																
Return CO2																																	
Return RH																																	
Mixed Air Temp	X																																
OA Damper																																	
SARA Airflow Mon.																																	
Return Damper																																	
Smoke Detector																																	
Freeze-stat																																	
Filter Status																																	
Over-ride																																	
Space Humidity	X																																
Pump P-9,10,11																																	
Fans																																	
Toilet Fans																																	
Electrical Room Fans																																	
Welding Gen Fan																																	
Hot Water Boilers																																	
Boiler On/Off																																	
Boiler Status																																	
HWS Temp	X																																
HWR Temp	X																																
Pump P-5,6																																	
Pump P-7,8																																	
HWS Temp	X																																
HWR Temp	X																																
Diff Press.	X																																
Boiler Rm Oxygen Depletion																																	
Boiler Rm Solenoid Valve																																	
Boiler Rm CO Detector																																	
Fan Coil Unit & CUH																																	
Supply Fan																																	
CHW Valve																																	
HW Valve																																	
Space Temp	X																																
Supply Temp	X																																
Setpoint Adjust																																	
Drain Pan Float Alarm																																	
GENERAL NOTE:	INPUT/OUTPUT SUMMARY IS A GENERAL LIST OF CONTROL POINTS REQUIRED FOR THE OPERATION OF THE MECHANICAL SYSTEM. IN ADDITION TO CONTROL POINTS INDICATED, THE CONTROLS CONTRACTOR SHALL BE RESPONSIBLE FOR PROVIDING ADDITIONAL POINTS AS REQUIRED FOR OPERATION OF THE MECHANICAL SYSTEM AS SPECIFIED AND OUTLINED IN THE SEQUENCE OF OPERATION AND TO COMPLY WITH THE SPECIFICATIONS/PLANS.																																

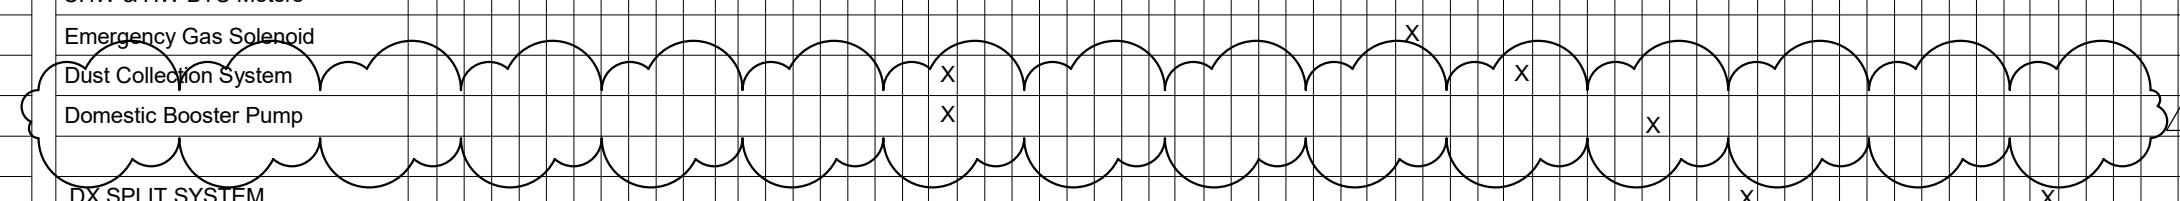

C:\Users\Chanccol\Documents\16-0265_R16_MEP_Chanccol.rvt 8/29/2017 6:29:10 AM

No.	Description	Date
1	Addendum #4	8.28.2017

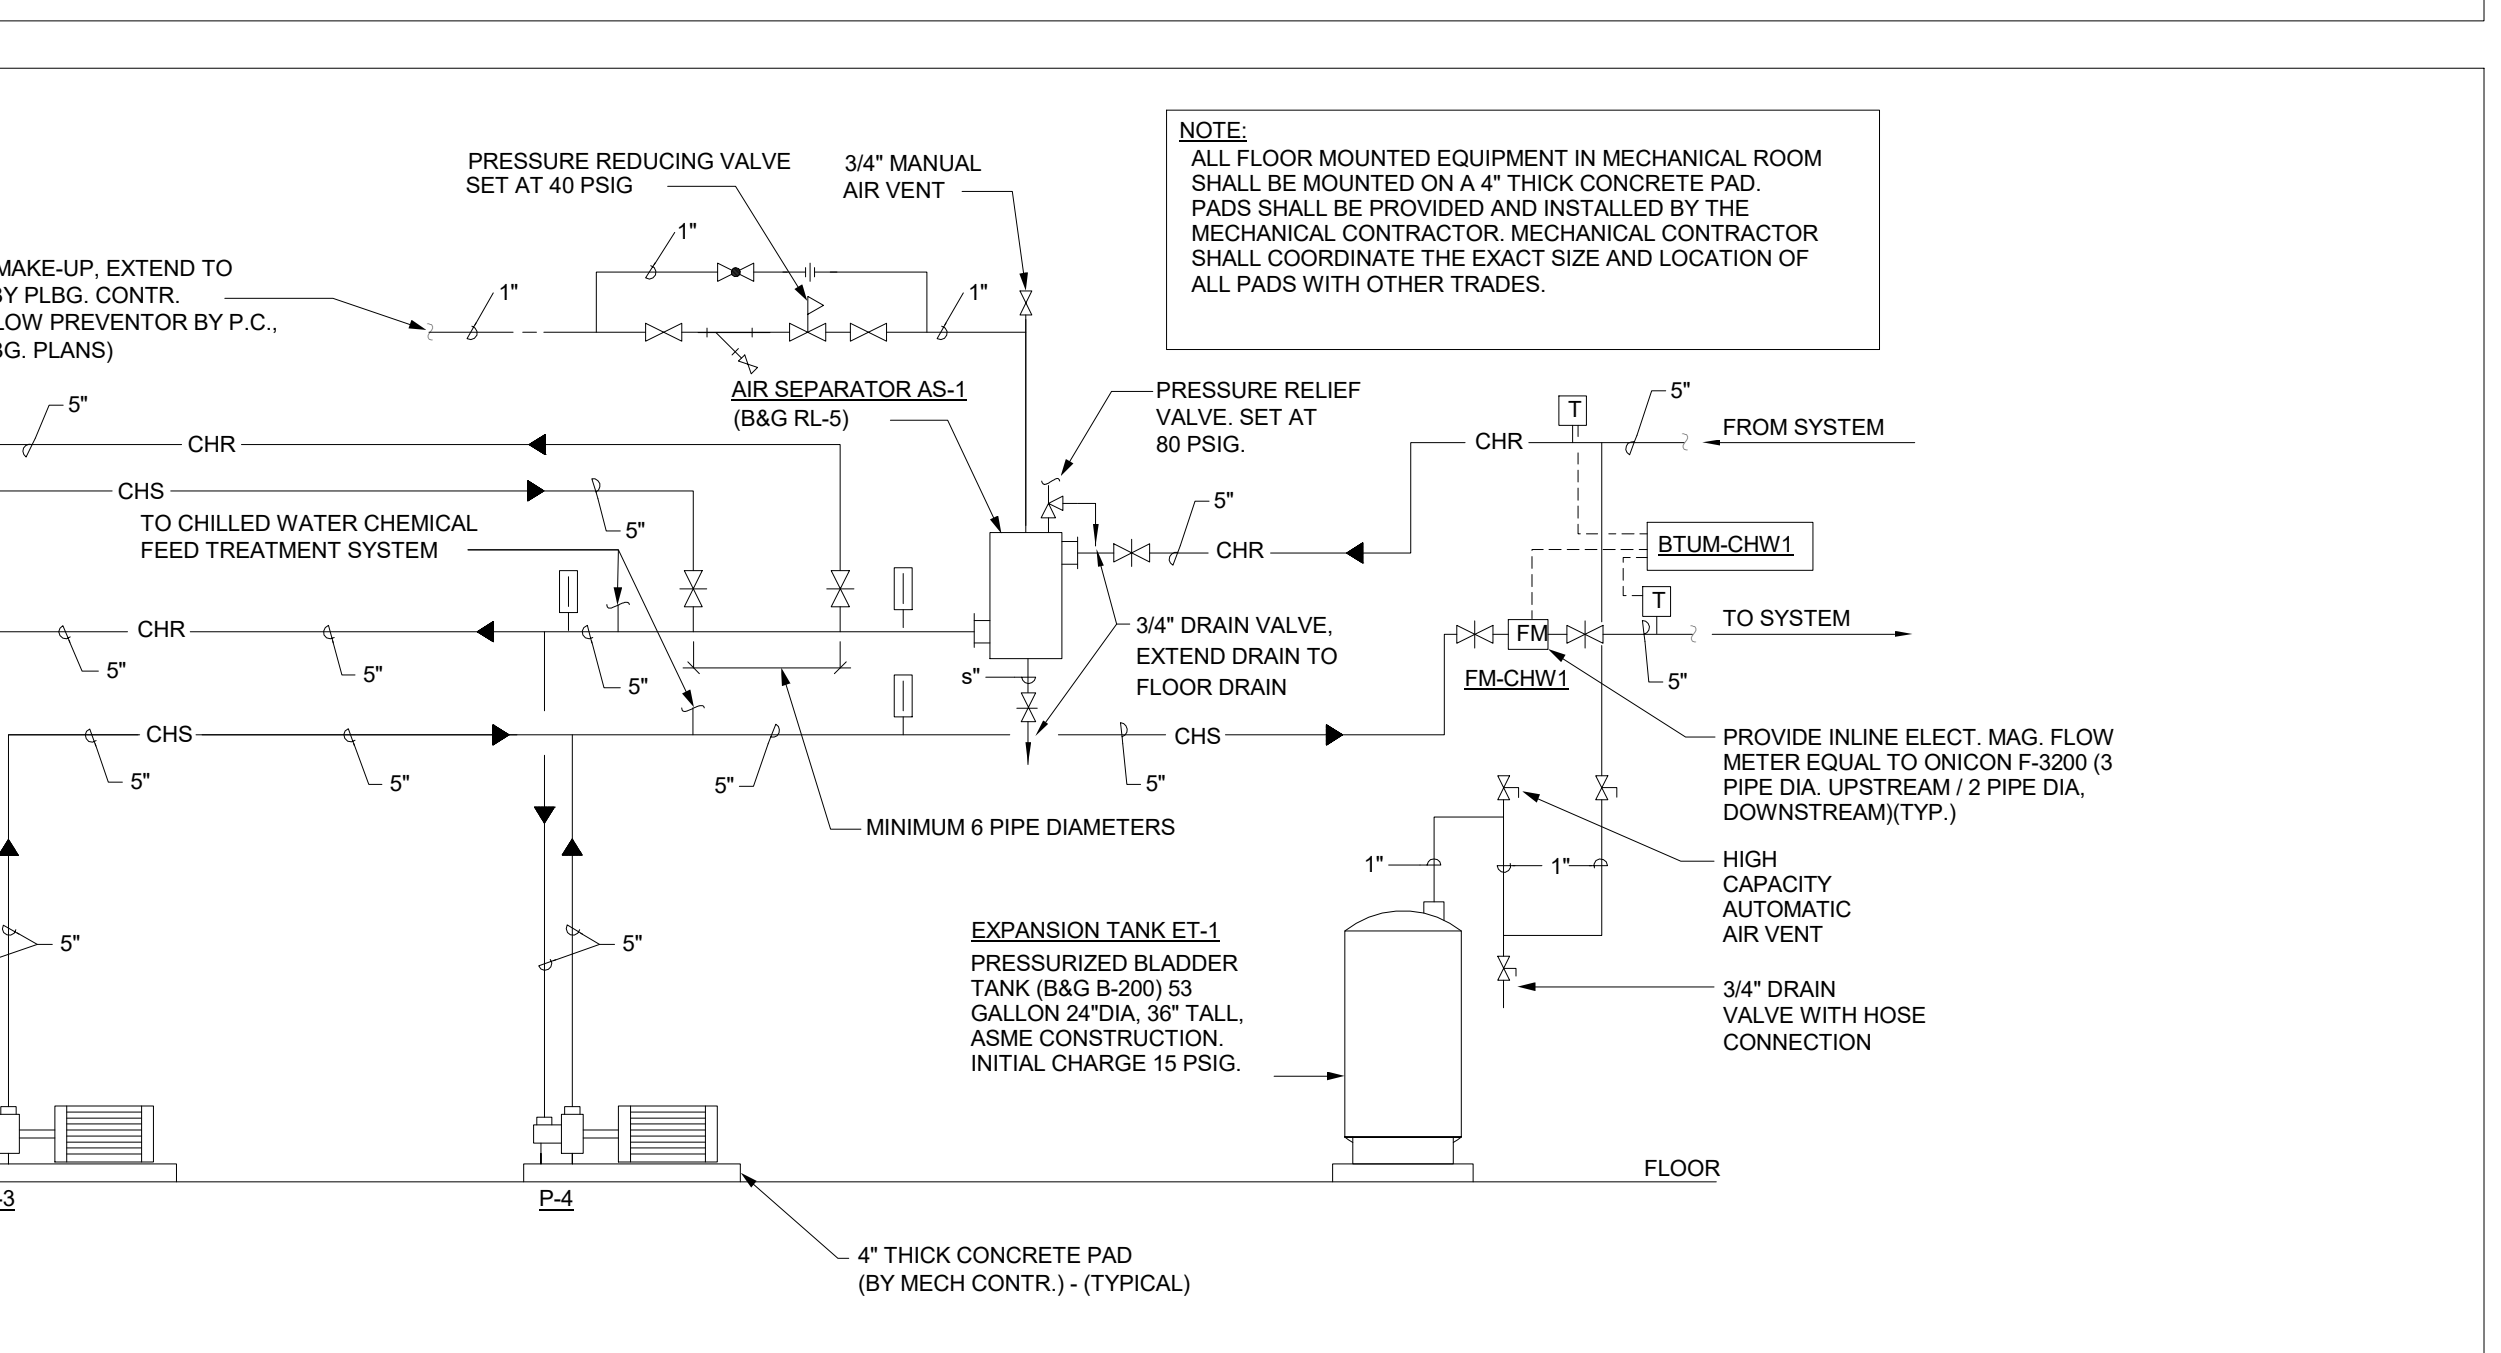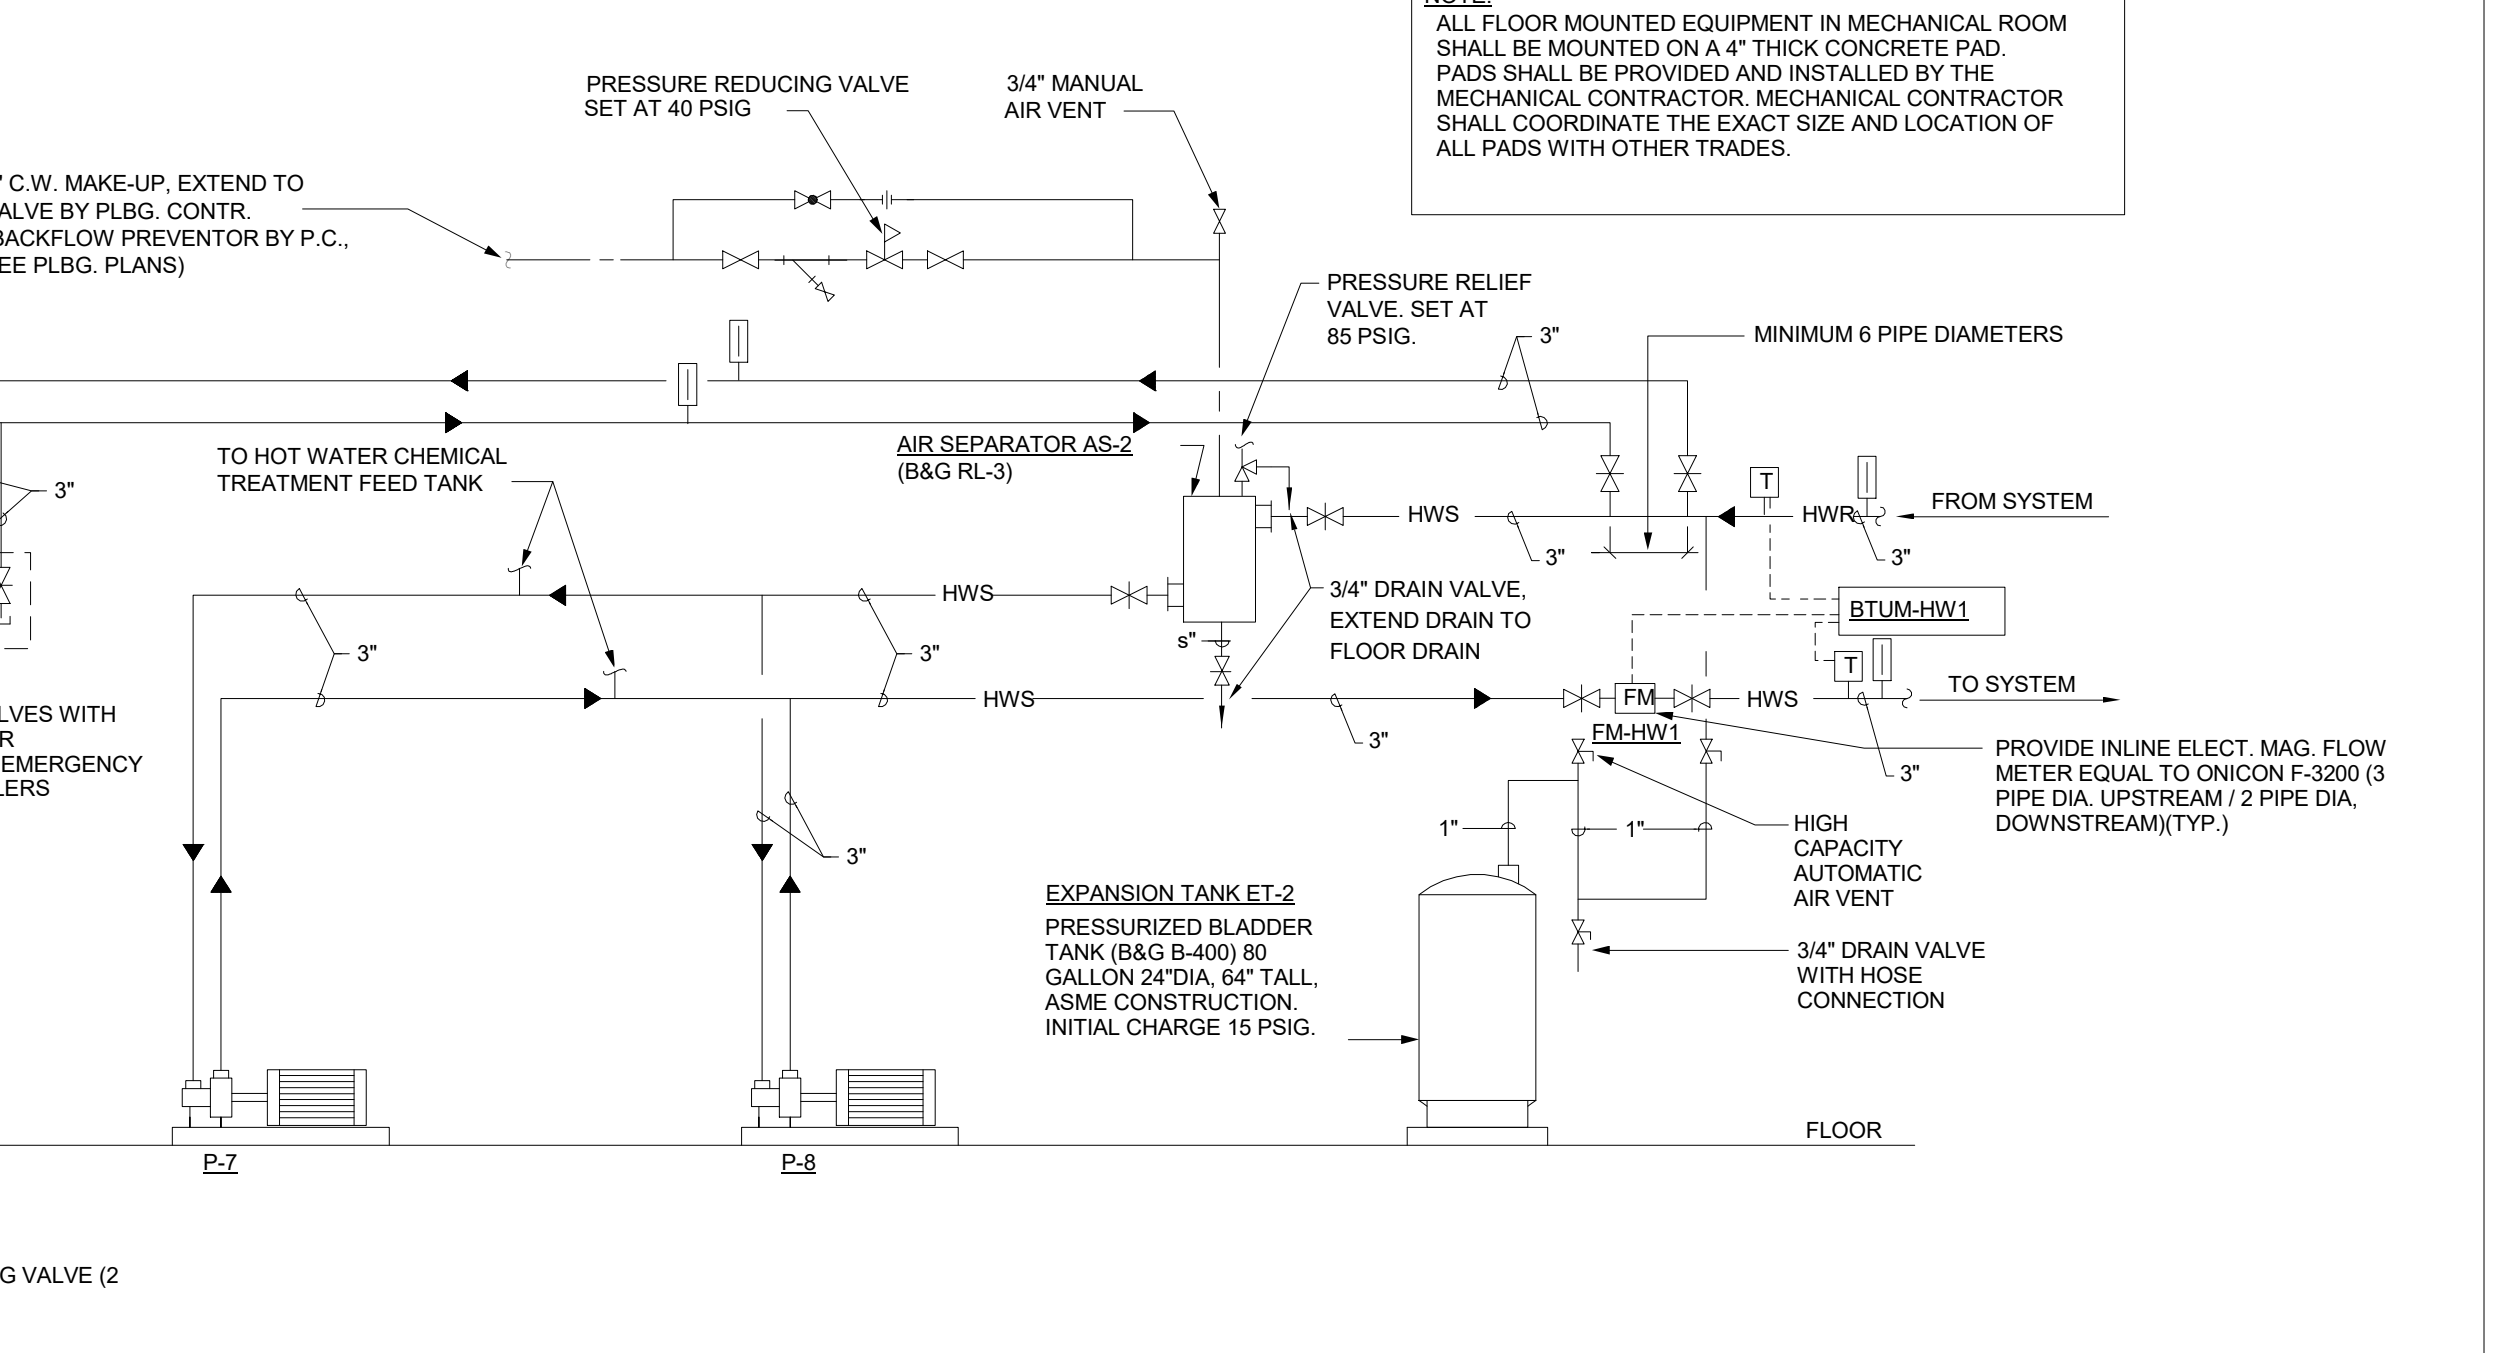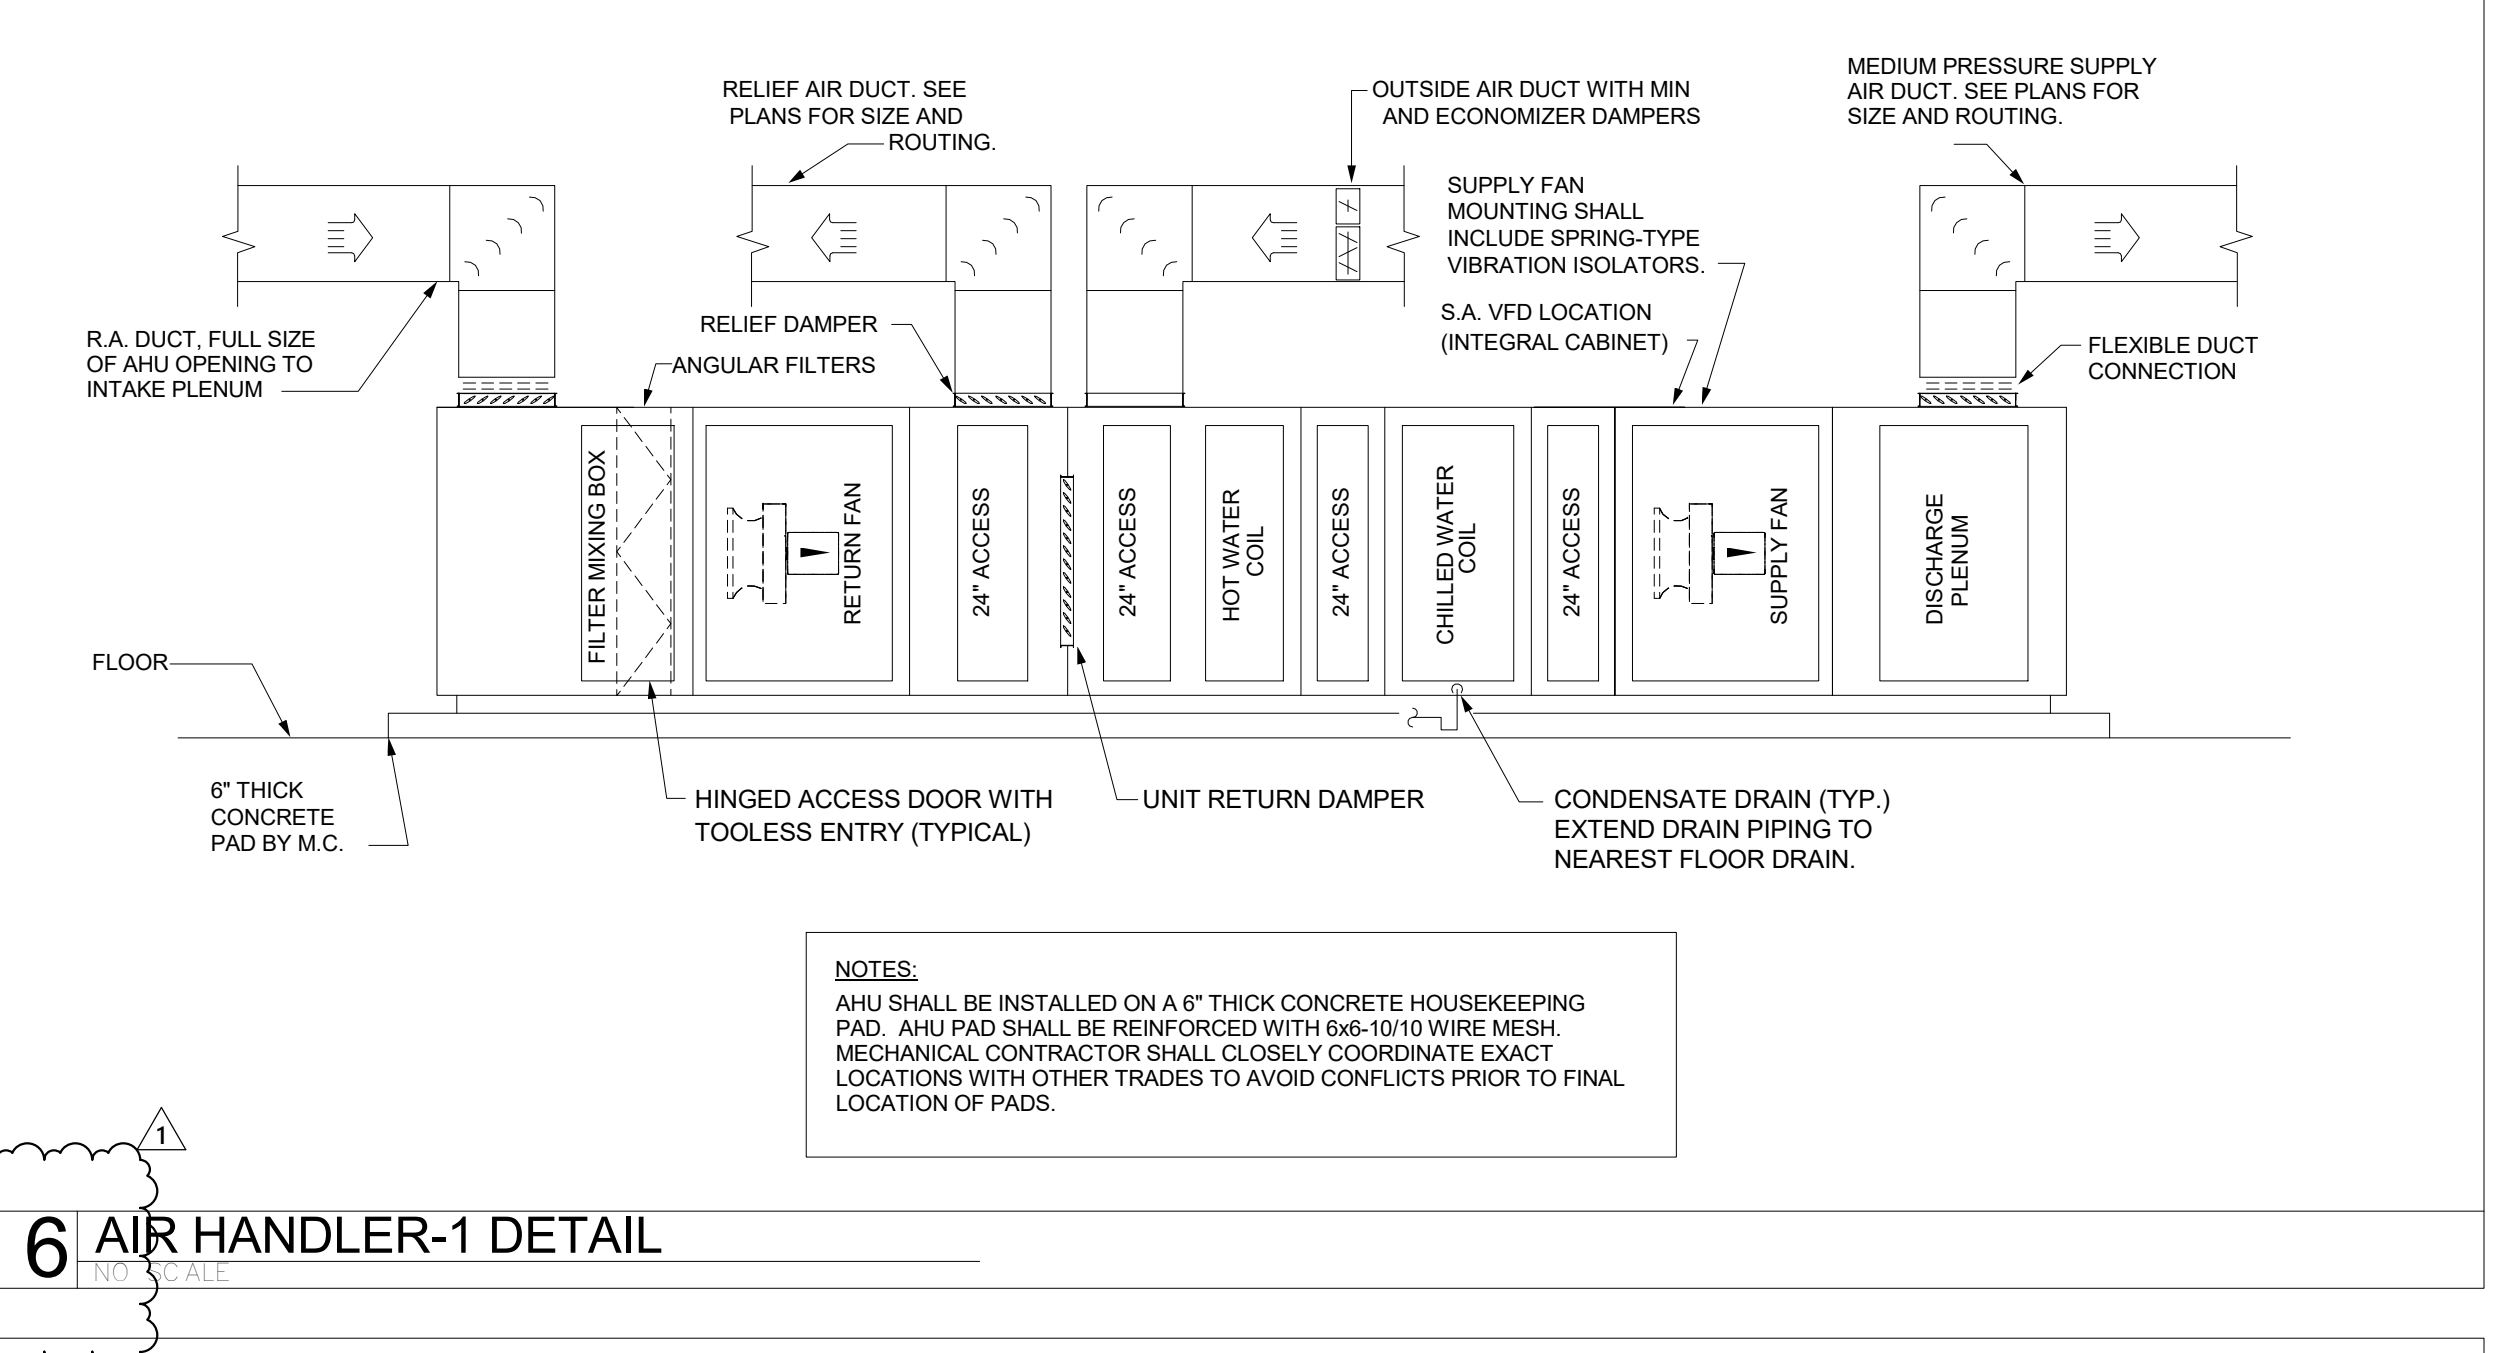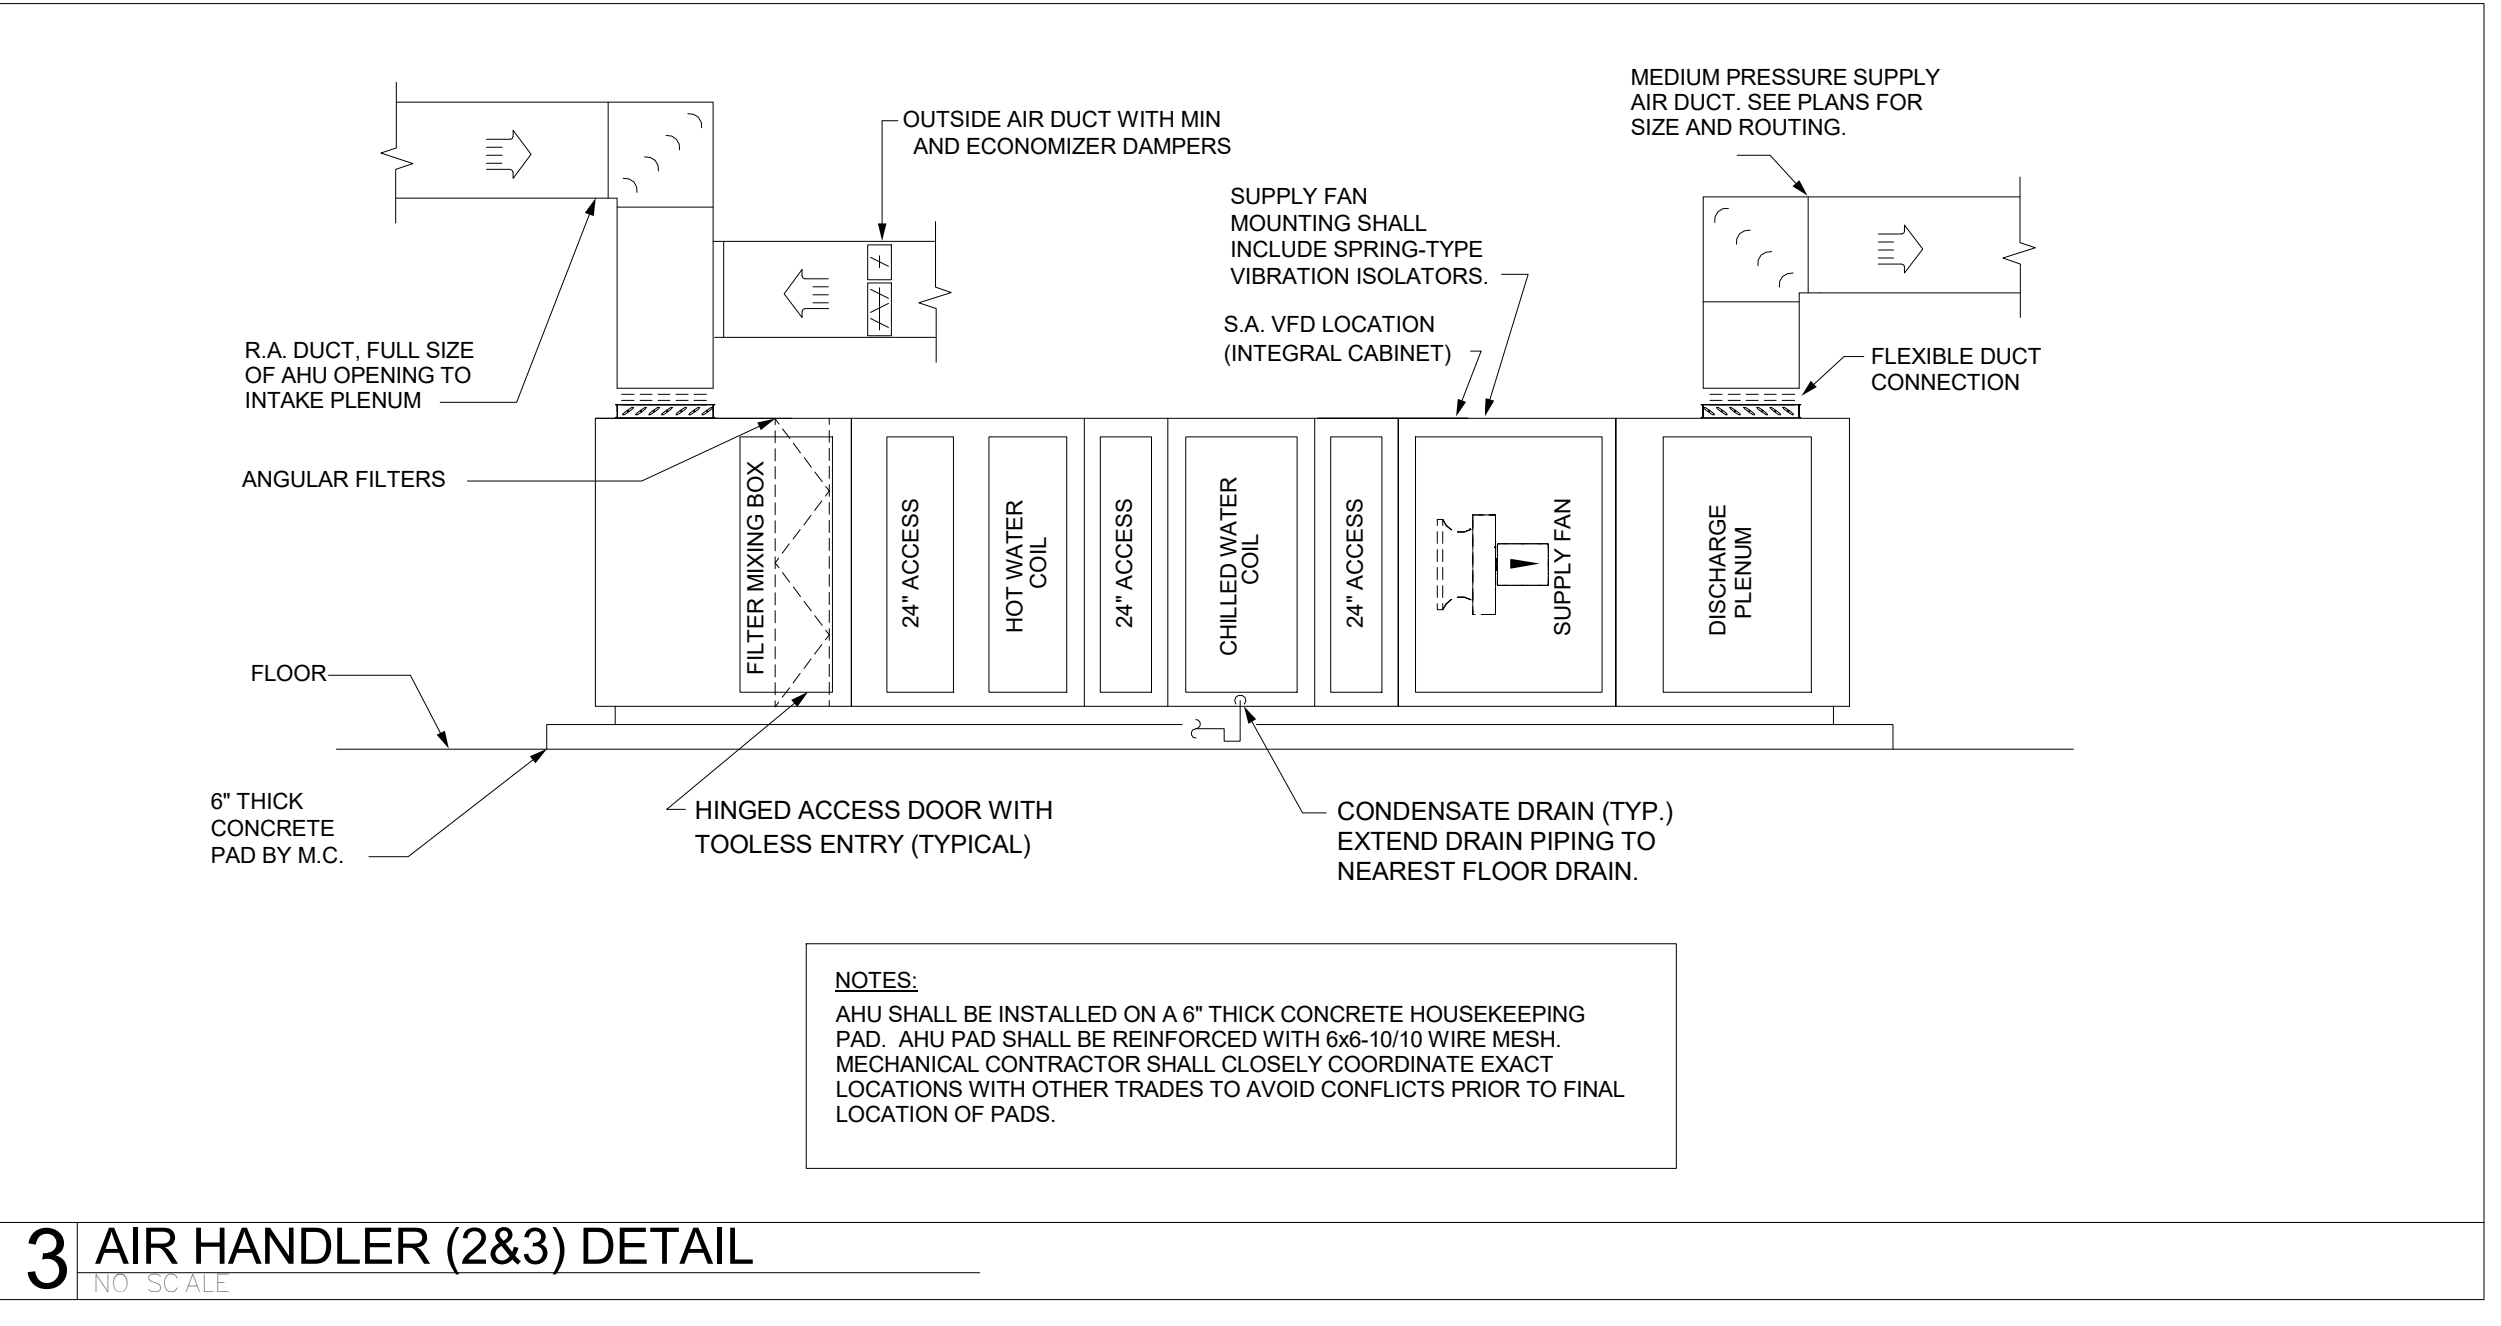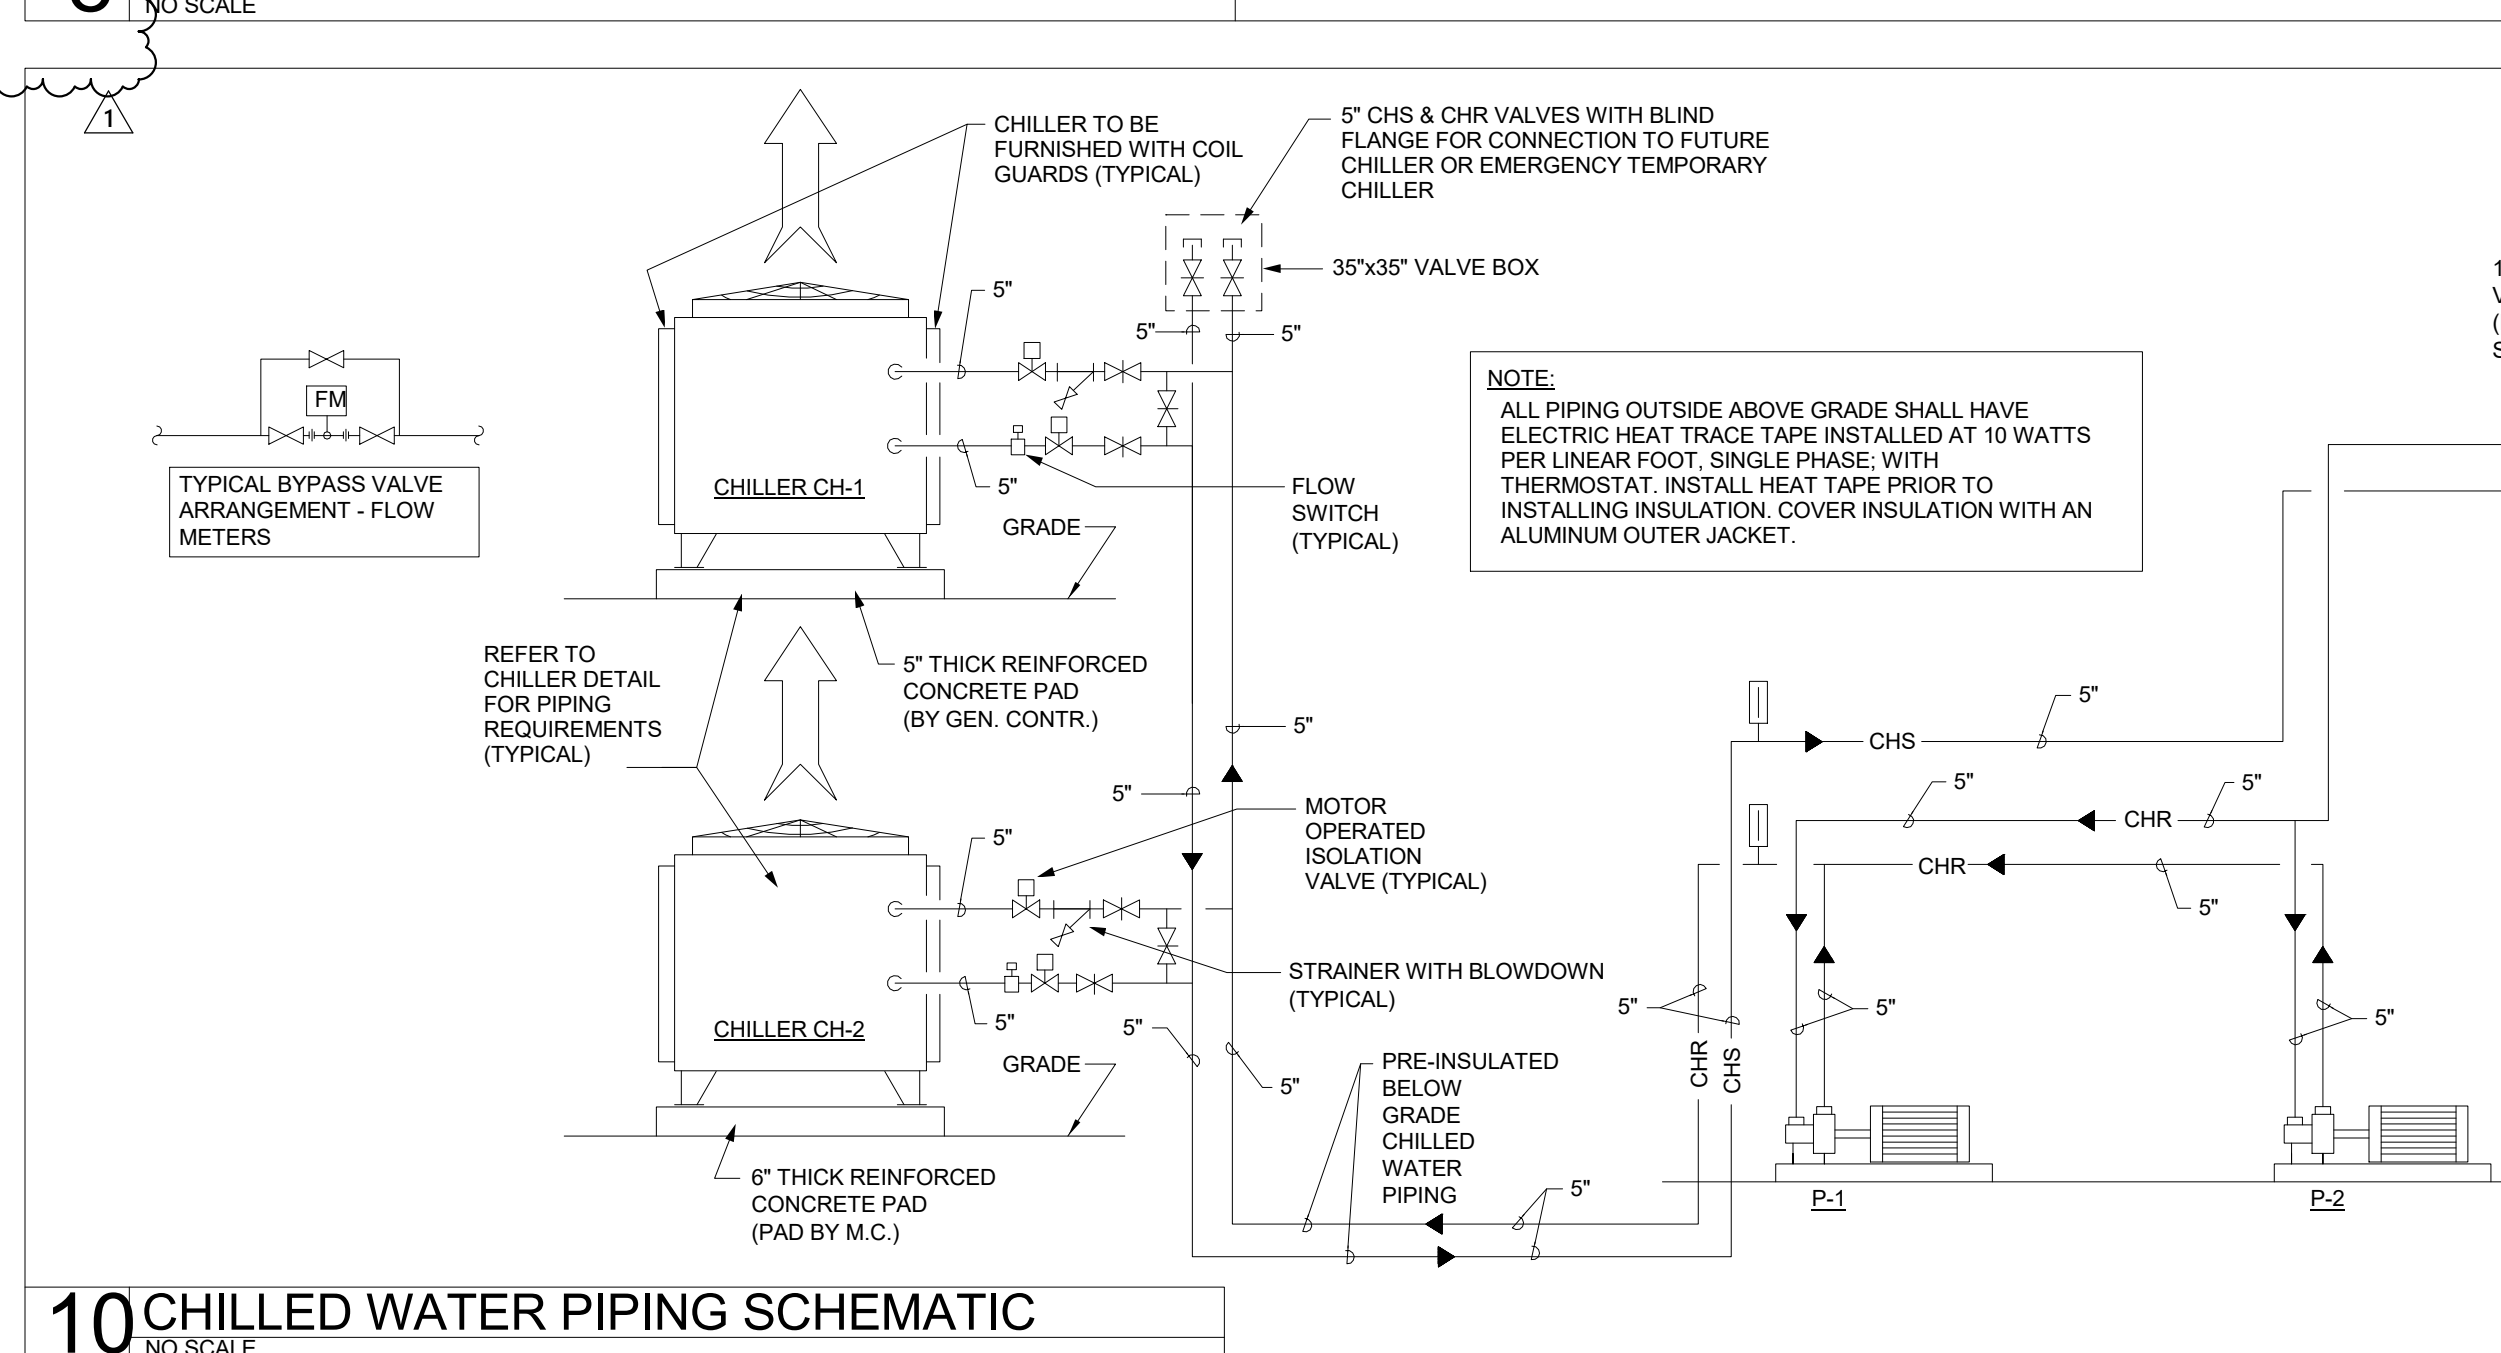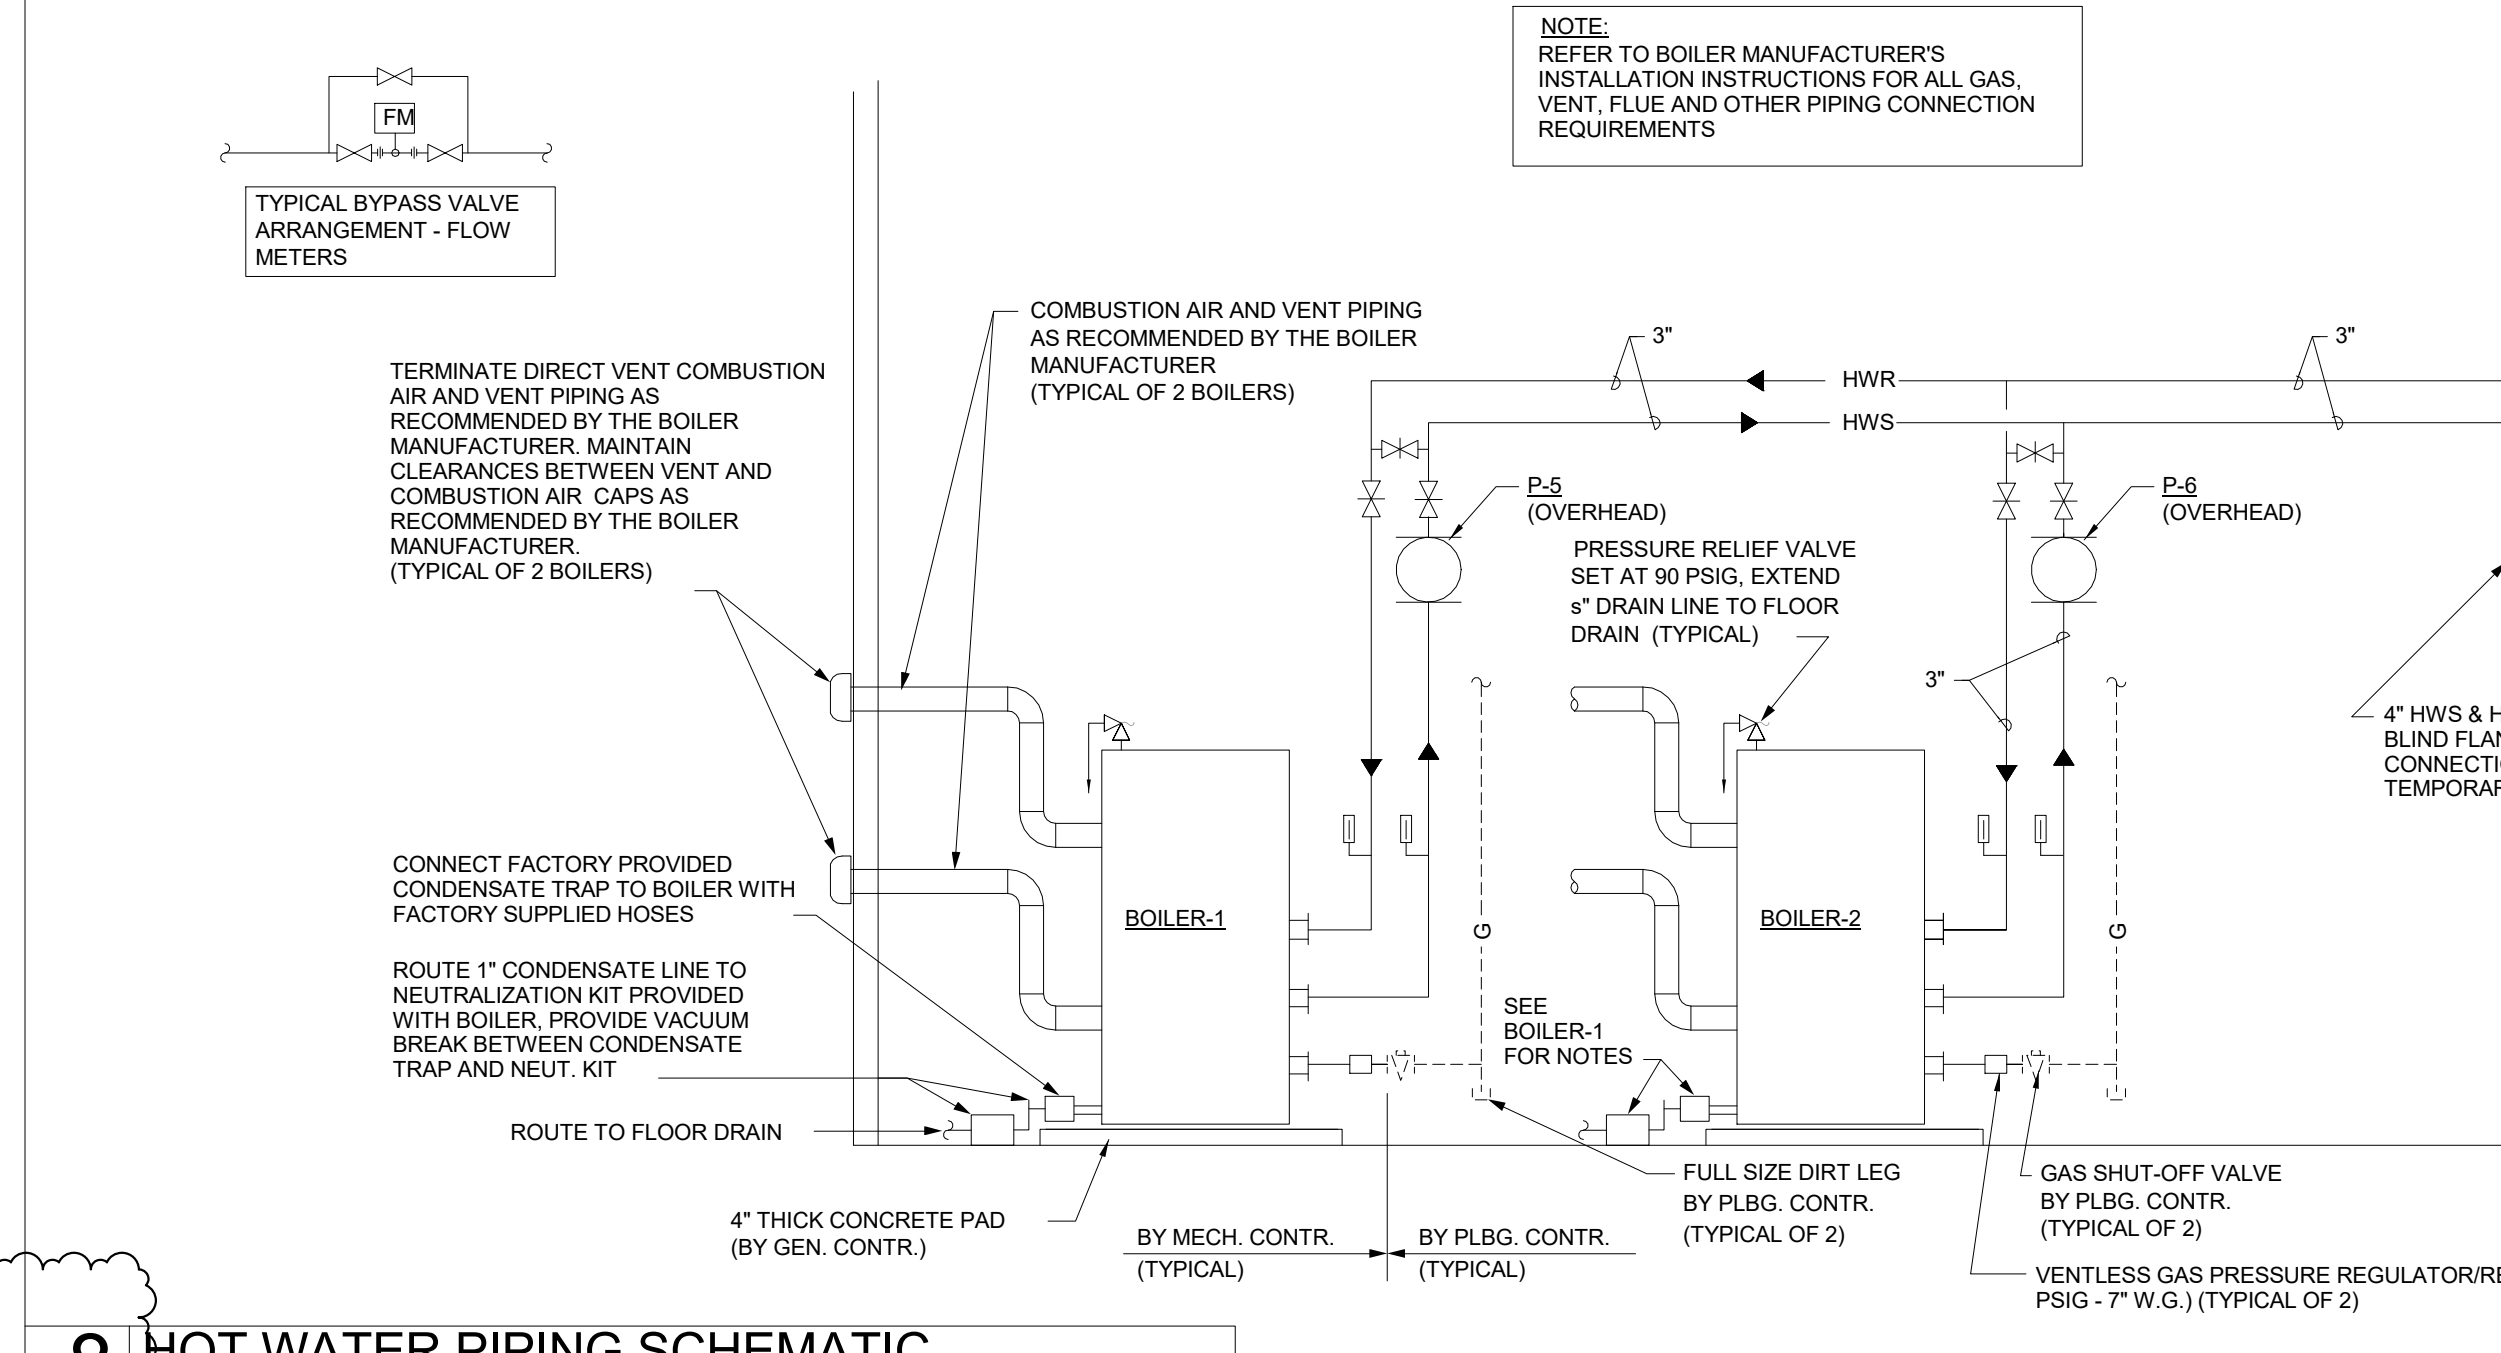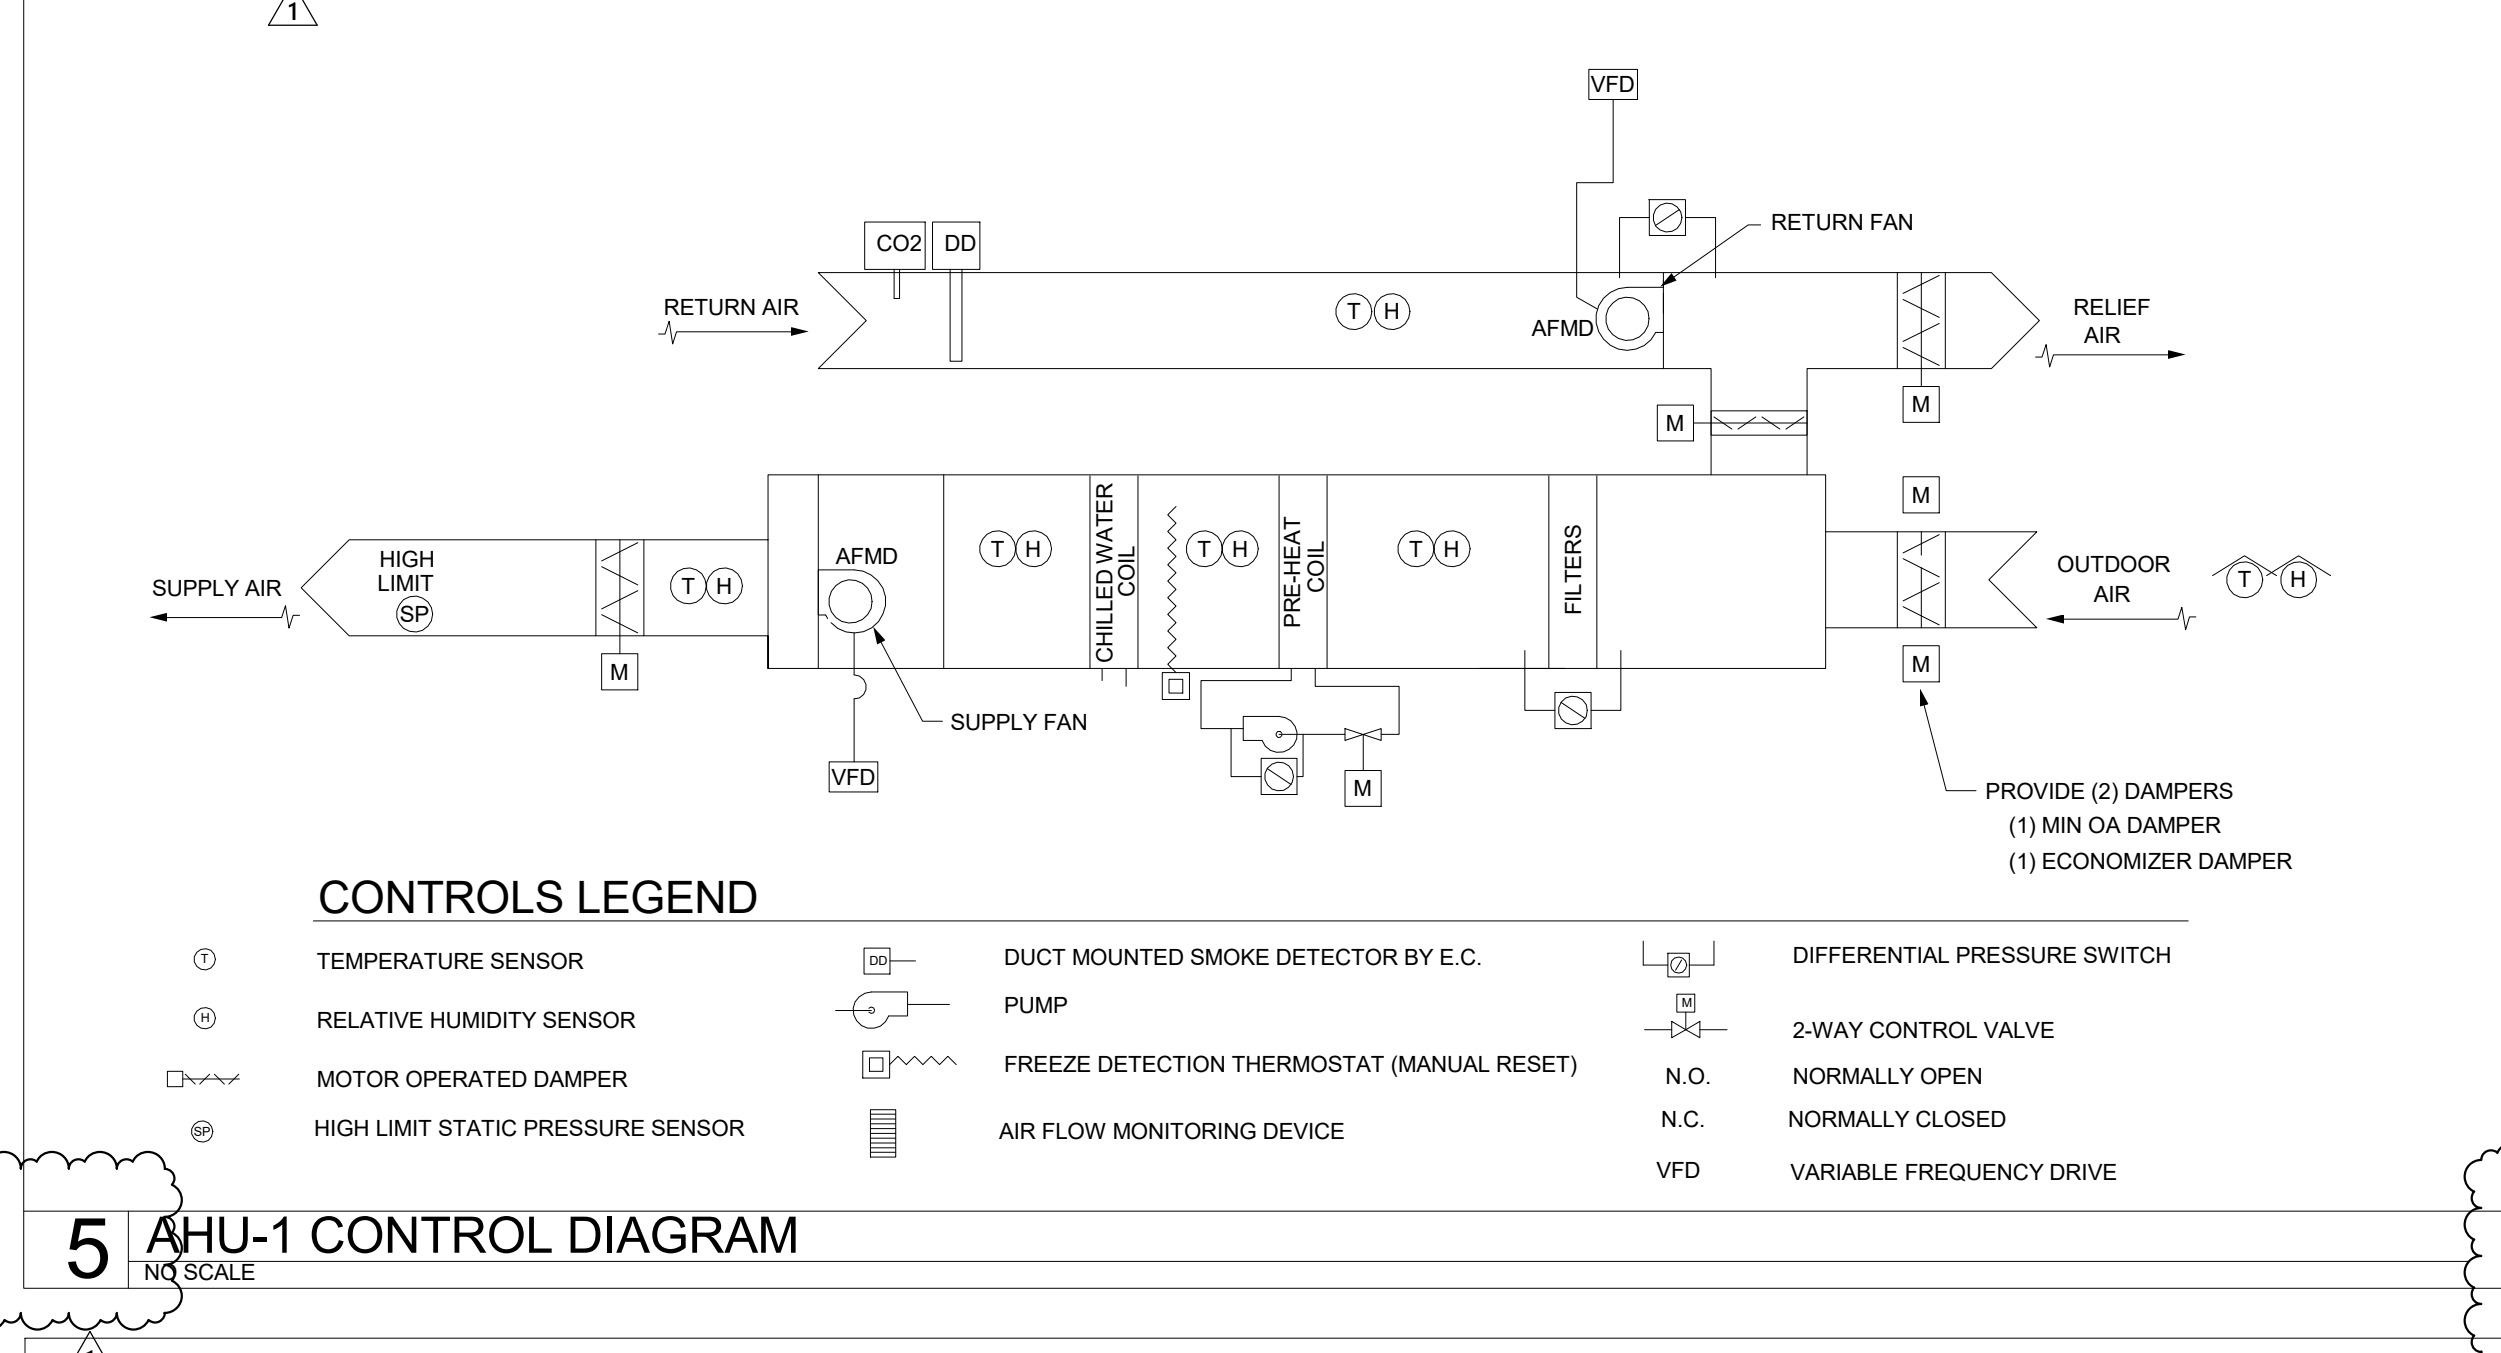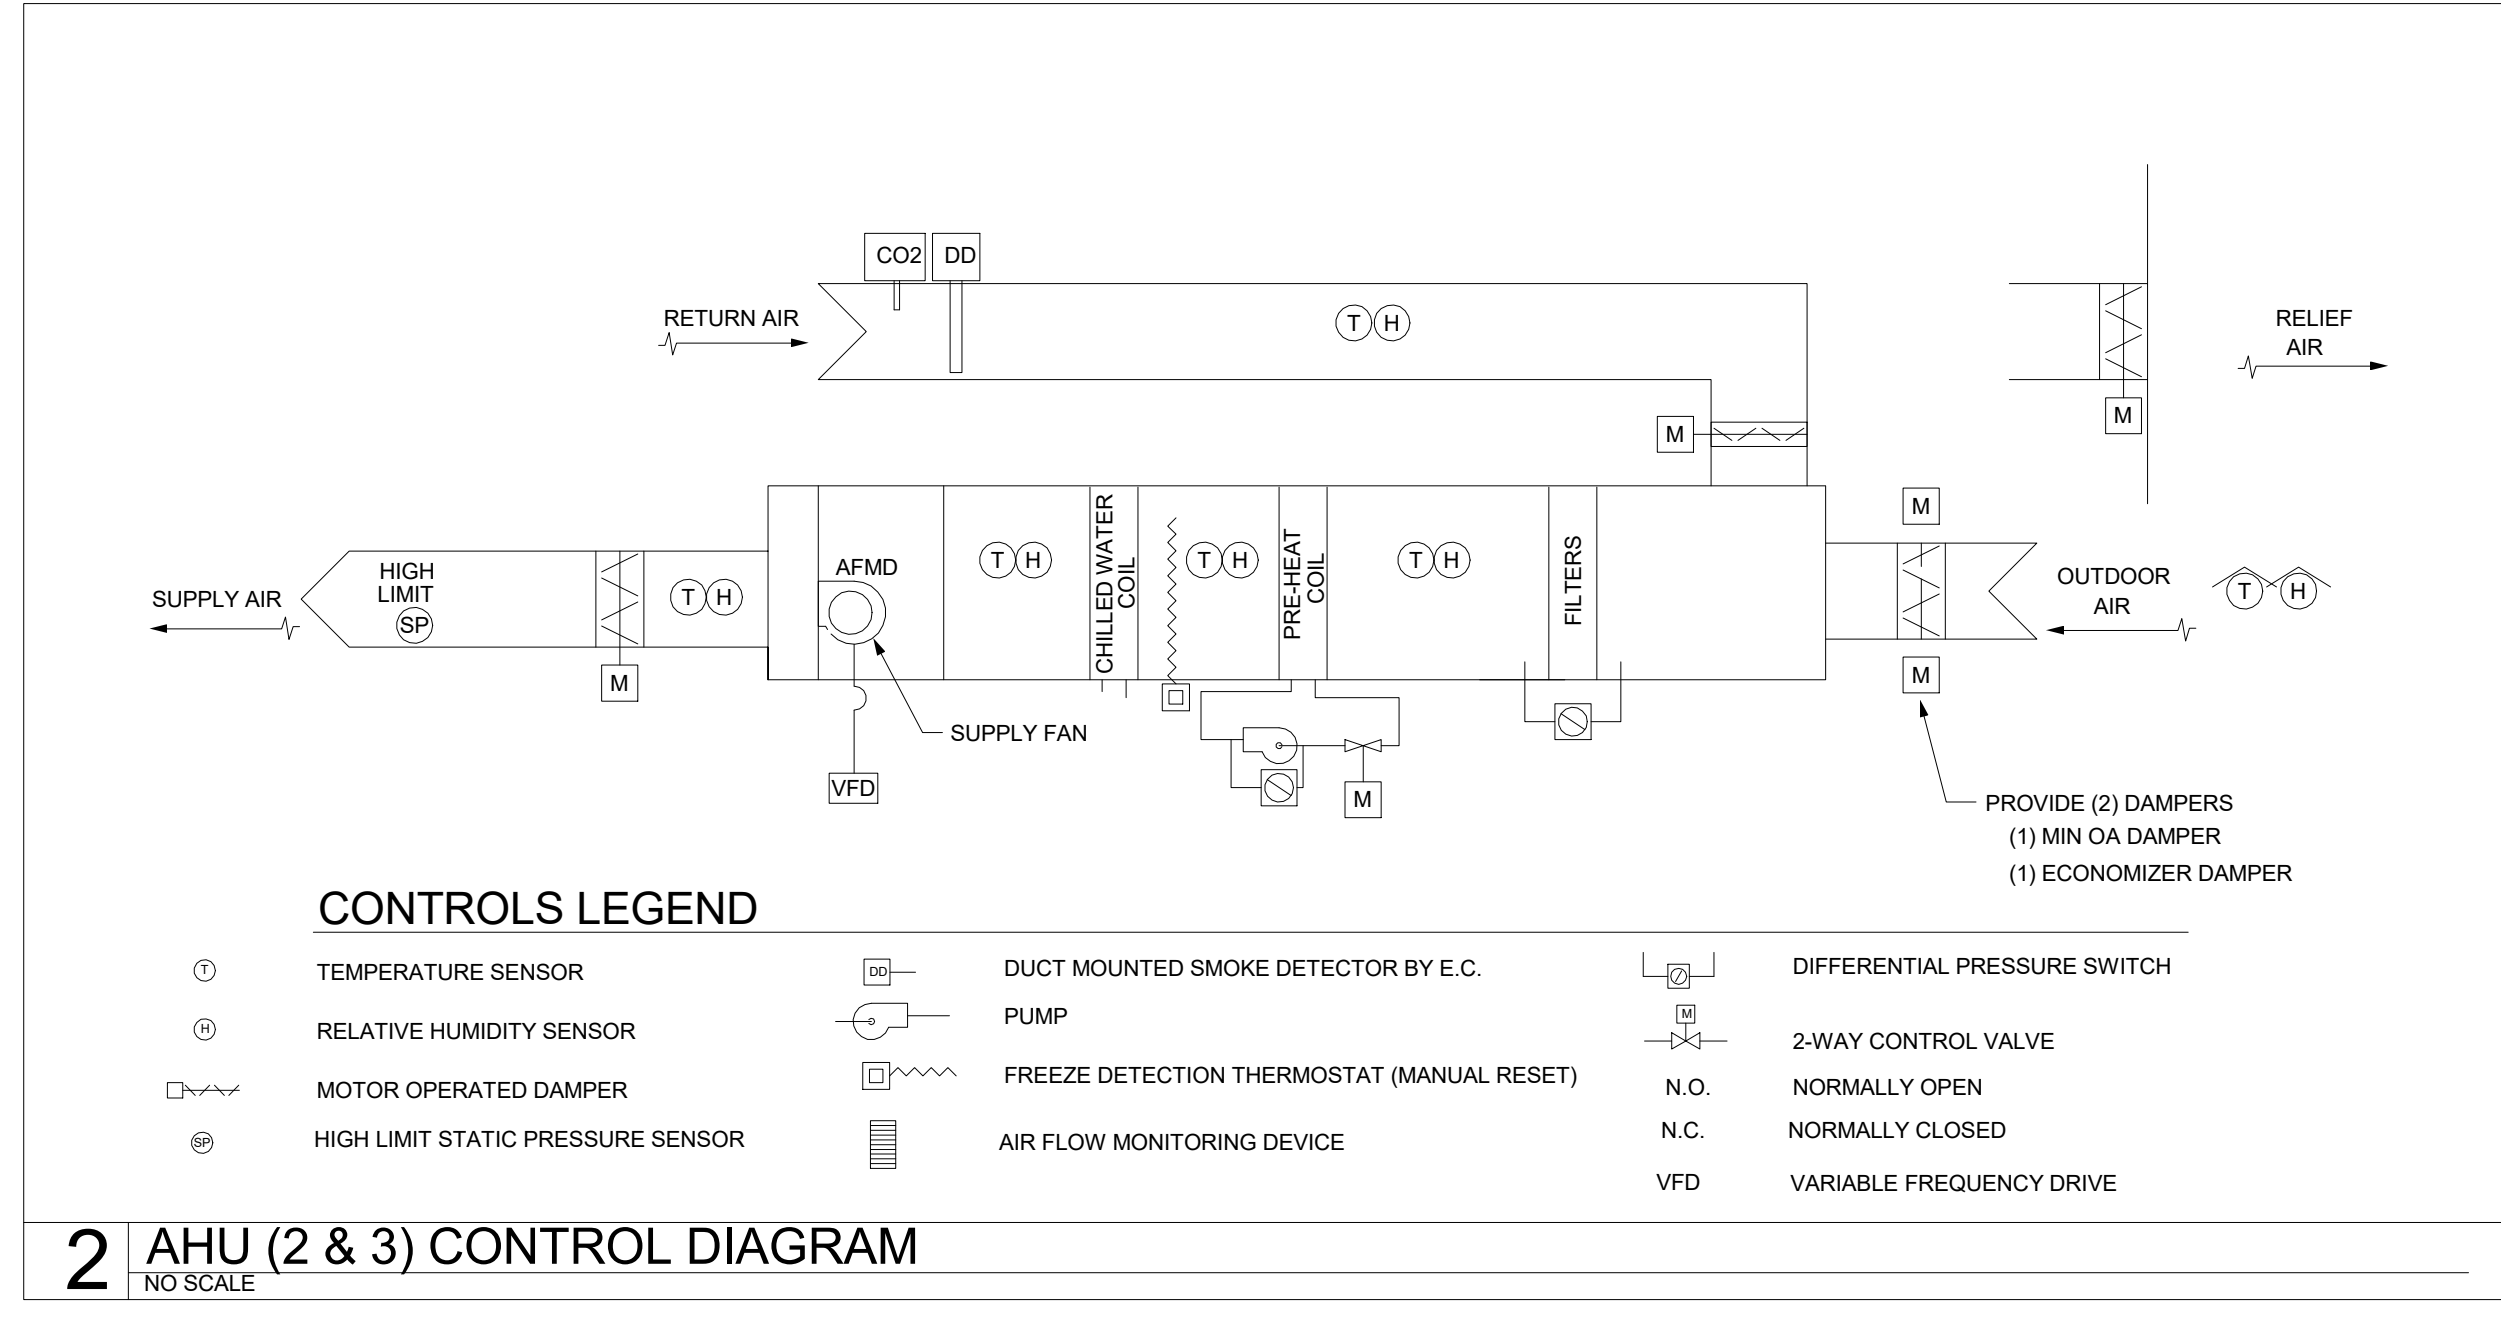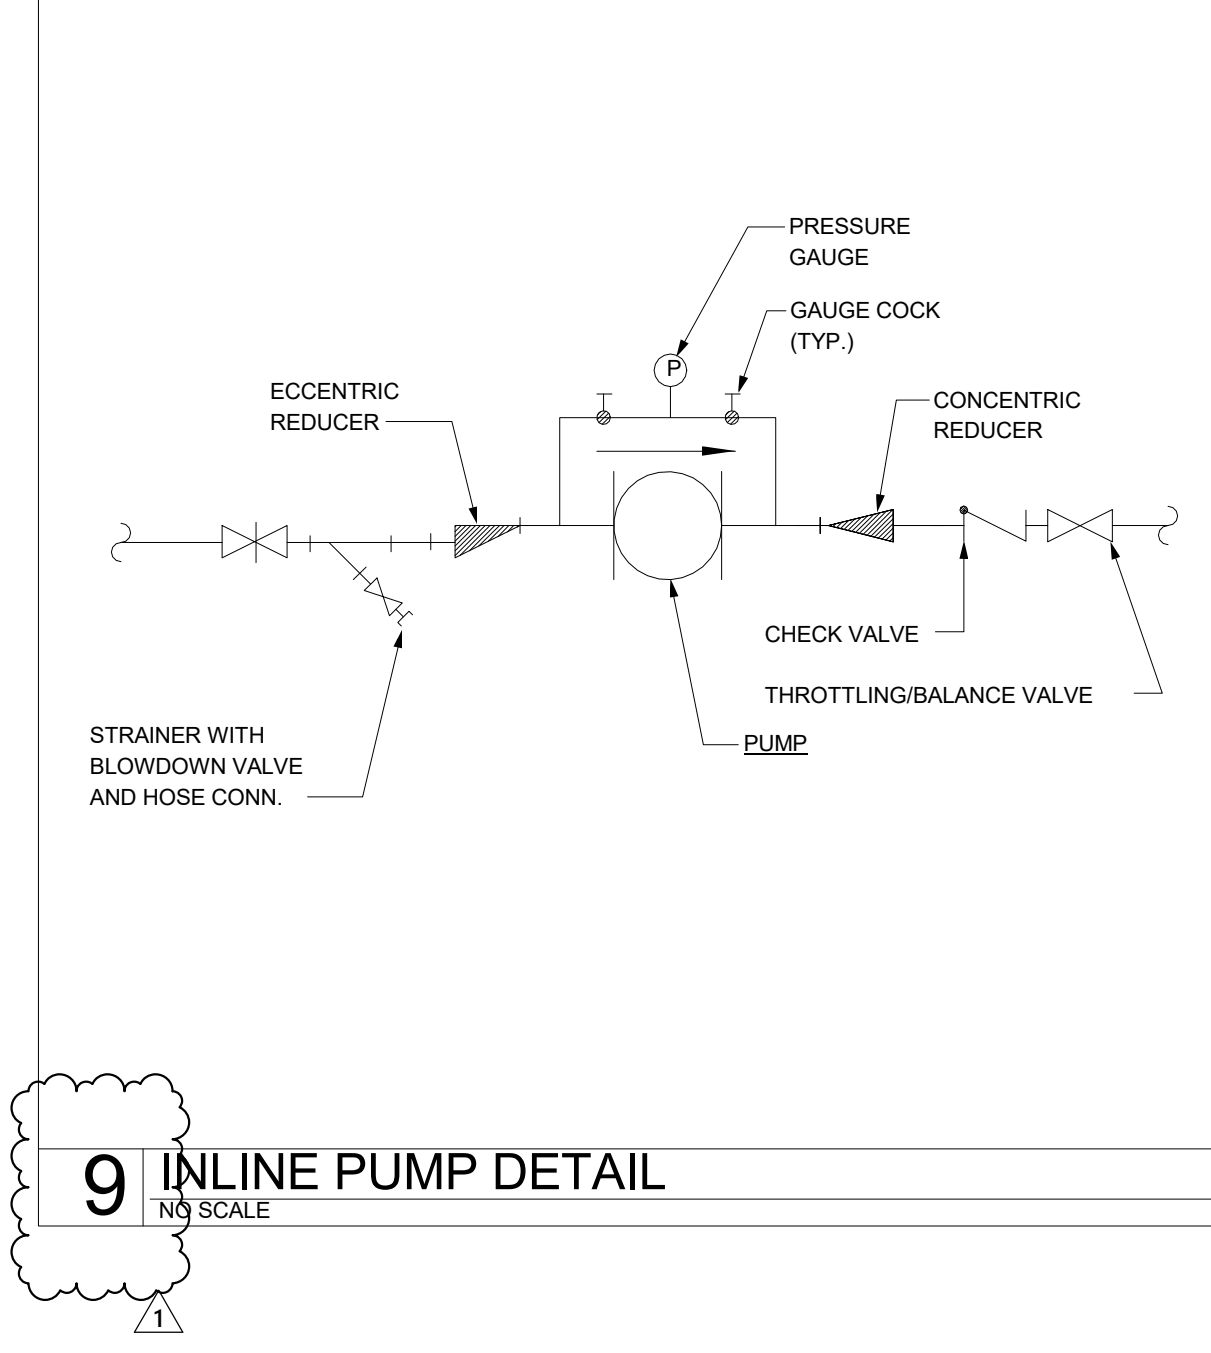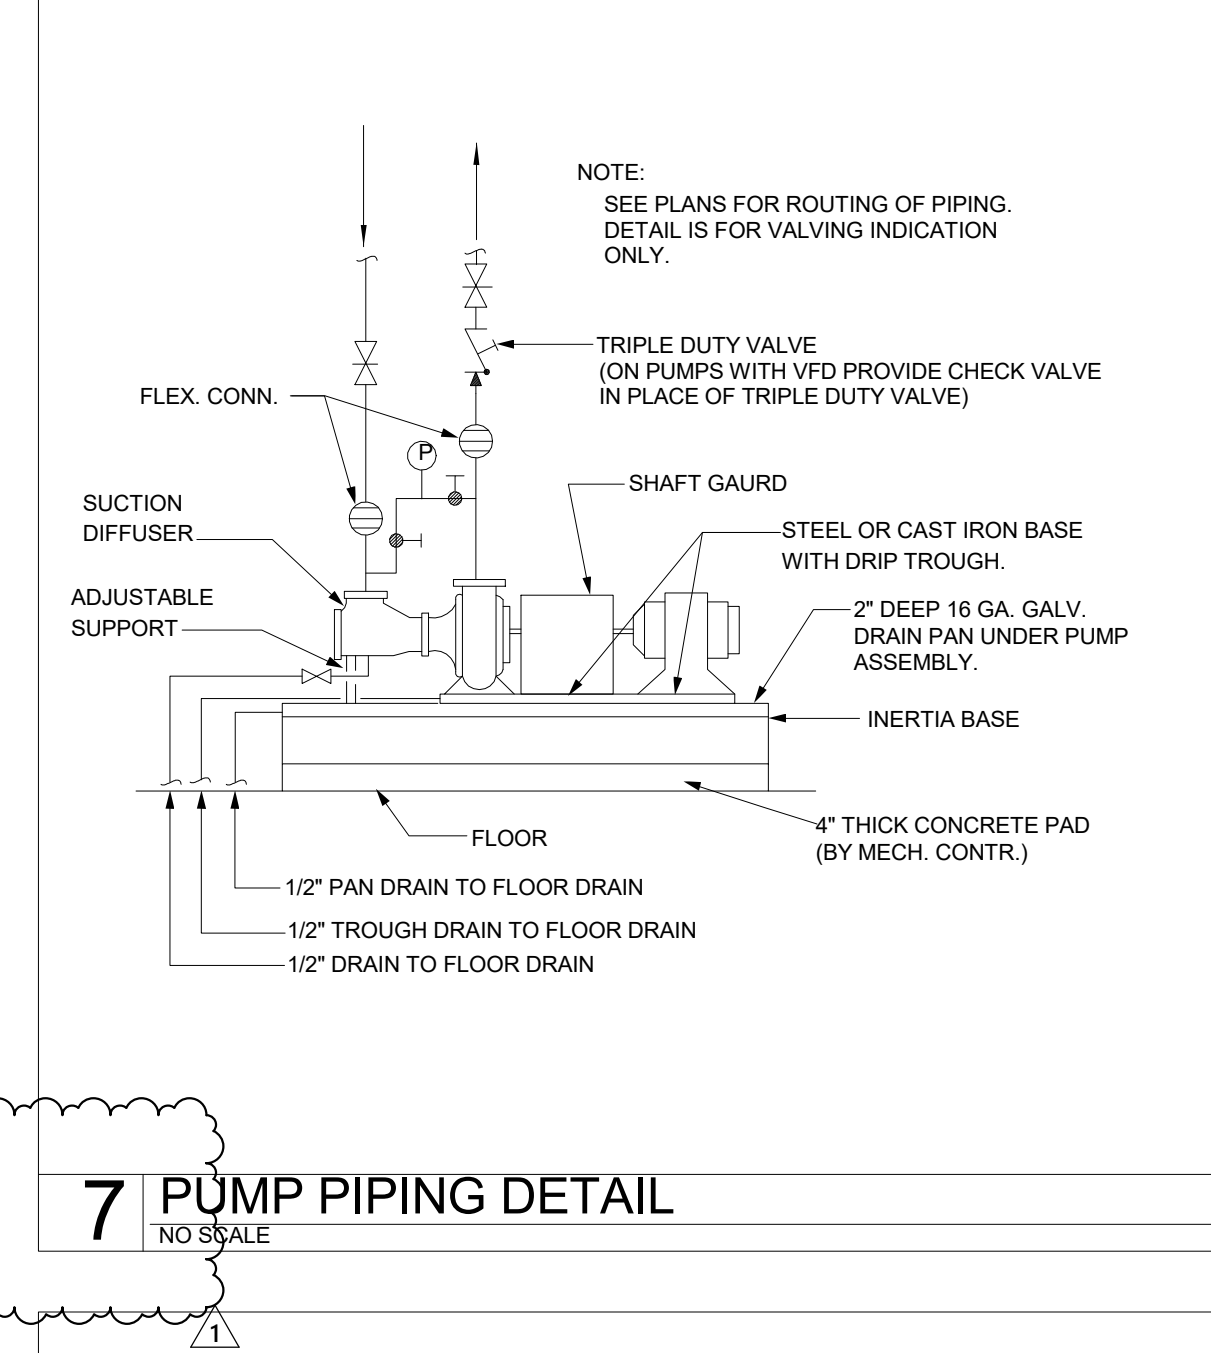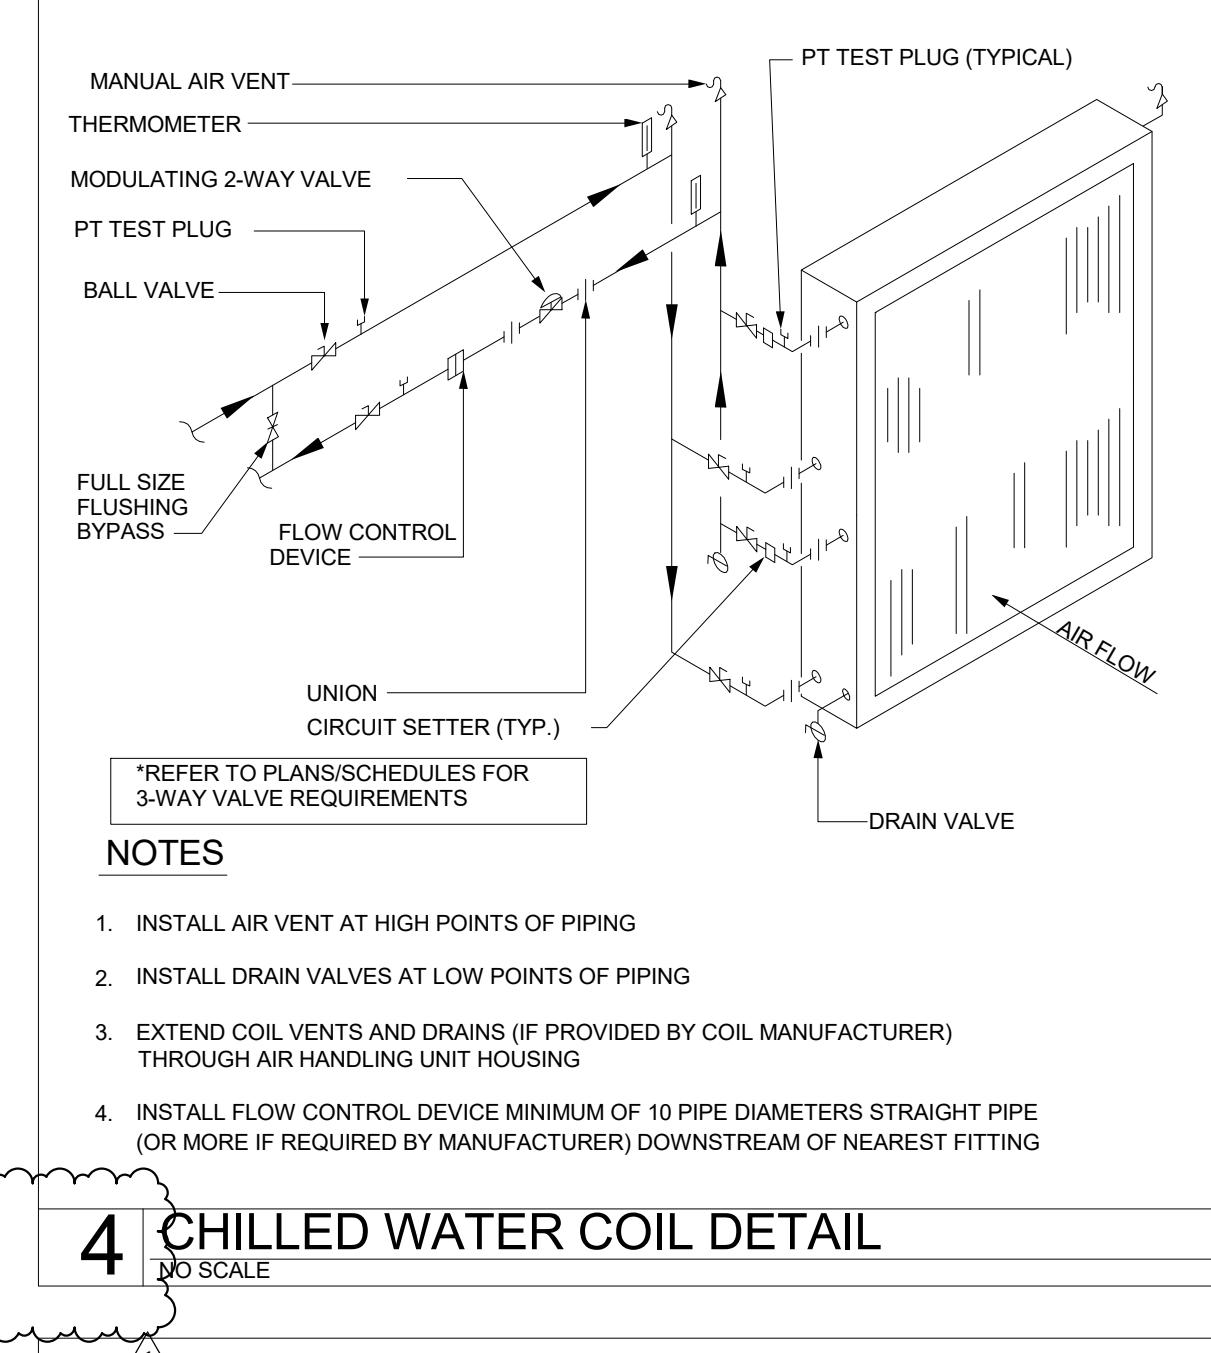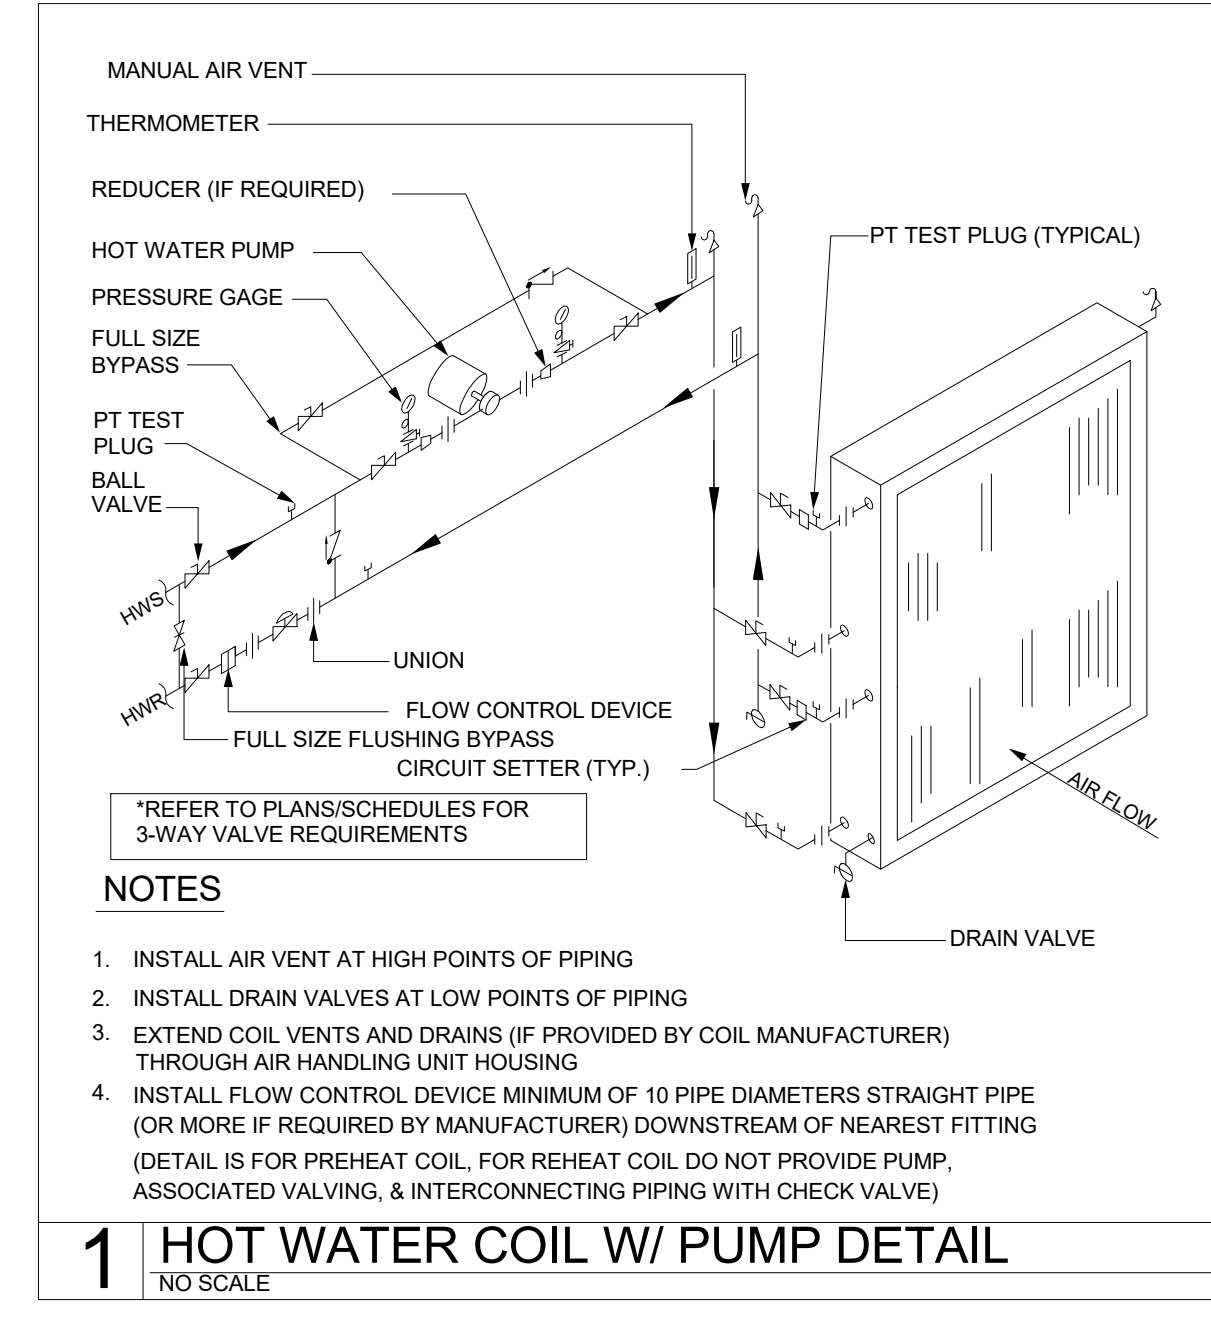

E
D
C
B
A

C:\Users\Chanccol\Documents\16-0265_R16 MEP_chanccol.rvt
8/29/2017 1:50:46 PM

1 2 3 4 5

SYMBOL SCHEDULE

FIRE ALARM

F FIRE ALARM MANUAL STATION WITH CLEAR POLYCARBONATE PROTECTIVE COVER. COVER SHALL HAVE INTEGRAL BATTERY BACKED UP AUDIBLE ALARM.

ADA COMPLIANT FIRE ALARM STROBE LIGHT, 75cd, UNLESS OTHERWISE NOTED. WHITE FINISH.

ADA COMPLIANT FIRE ALARM STROBE LIGHT, 75cd, UNLESS OTHERWISE NOTED. WHITE FINISH.

CEILING MOUNTED SMOKE DETECTOR.

DUCT MOUNTED SMOKE DETECTOR. FURNISHED AND CONNECTED BY ELECTRICAL CONTRACTOR. INSTALLED BY MECHANICAL CONTRACTOR. CUTTING OF DUCT, INSTALLATION OF DETECTOR, AND DETERMINATION OF SAMPLING TUBE LENGTH SHALL BE THE MECHANICAL CONTRACTOR. PROVIDE REMOTE INDICATING LIGHT WITH EACH DETECTOR. CLIMB MOUNTED HEAT DETECTOR.

FIRE ALARM REMOTE GRAPHIC ANNUNCIATOR.

ADA COMPLIANT FIRE ALARM SPEAKER STROBE LIGHT, 75cd, UNLESS OTHERWISE NOTED. WHITE FINISH. (CEILING MOUNTED)

ADA COMPLIANT FIRE ALARM STROBE LIGHT, 75cd, UNLESS OTHERWISE NOTED. WHITE FINISH. (CEILING MOUNTED)

FIRE ALARM CONTROL PANEL WITH LOCAL SMOKE DETECTOR

BEAM TYPE SMOKE DETECTOR

DUCT DETECTOR REMOTE INDICATING LIGHT, WITH TEST SWITCH.

CEILING MOUNTED CARBON MONOXIDE DETECTOR (CENTRAL SYSTEM CONNECTED)

DUCT DETECTOR REMOTE INDICATING LIGHT WITH TEST SWITCH. 24VDC WITH SUPERVISION BY FIRE ALARM SYSTEM.

MULTI-SENSOR DETECTOR. SMOKE, HEAT AND CO.

SPECIAL SYSTEMS

FLUSH-MOUNTED CEILING SPEAKER. E.C. IS TO PROVIDE EPISODE KIT EC5-650-1C. VERIFY FINISH PRIOR TO ORDERING.

EXTERIOR WEATHERPROOF SPEAKER 3/4" CONDUIT TO LOCAL CABLE TRAY PROVIDE WEATHERPROOF J-BOX. E.C. IS TO PROVIDE EPISODE EC5-AW70-4-WHT. VERIFY FINISH PRIOR TO ORDERING.

VOLUME CONTROL. SINGLE GANG BOX AND 3/4" CONDUIT TO ABOVE CEILING WITH PULL STRING. SEE APPLICABLE DETAIL AND/OR SPECIFICATIONS FOR ADDITIONAL CONDUIT AND CABLING REQUIREMENTS.

SEE TV DETAIL FOR TYPE AND REQUIREMENTS. STUB 1/2" CONDUIT FROM BOX TO CABLE TRAY ABOVE ACCESSIBLE CEILING IN CORRIDOR. AND 3/4" CONDUIT FOR POWER. PROVIDE PULL STRING FOR LOW VOLTAGE CABLE. SEE ARCHITECTURAL ELEVATIONS FOR MOUNTING HEIGHTS.

SEE TV DETAIL FOR TYPE AND REQUIREMENTS. STUB 1/2" CONDUIT FROM BOX TO CABLE TRAY ABOVE ACCESSIBLE CEILING IN THIS ROOM AND 3/4" CONDUIT FOR POWER. PROVIDE PULL STRING FOR LOW VOLTAGE CABLE. SEE ARCHITECTURAL ELEVATIONS FOR MOUNTING HEIGHTS.

GENERATOR ANNUNCIATOR PANEL 3/4" CONDUIT TO ATS. PROVIDE BOX AS REQUIRED PER MANUFACTURER RECOMMENDATION. PROVIDE CABLING PER MANUFACTURER RECOMMENDATIONS.

ACCESSIBLE DOOR OPENER PUSH BUTTON. PROVIDE MINIMUM (2) GANG BOX WITH SINGLE GANG OPENING. 3/4" TO DOOR OPERATOR. COORDINATE WITH EQUIPMENT PROVIDED. SEE DETAIL.

TELECOMMUNICATIONS

VOICE AND DATA OUTLET. 42" AFF. 5" x 5" SQUARE BOX WITH A TWO-GANG PLASTER RING. STUB 1/2" CONDUIT FROM BOX TO CABLE TRAY ABOVE ACCESSIBLE CEILING IN CORRIDOR. PROVIDE AND INSTALL FIRE RATED "PUTTY PACK" WHERE LOCATED IN FIRE RATED WALLS.

VOICE AND DATA OUTLET. 18" AFF. 5" x 5" SQUARE BOX WITH A TWO-GANG PLASTER RING. STUB 1/2" CONDUIT FROM BOX TO CABLE TRAY ABOVE ACCESSIBLE CEILING IN CORRIDOR. MATCH HEIGHT OF RECEPTACLES LOCATED ON THE SAME WALL. PROVIDE AND INSTALL FIRE RATED "PUTTY PACK" WHERE LOCATED IN FIRE RATED WALLS.

WIRELESS ACCESS POINT. ABOVE CEILING. SURFACE MOUNTED TERMINATION BOX. FOR LOCATIONS NOT LOCATED WITHIN A CORRIDOR. STUB 1/2" CONDUIT FROM BOX TO CABLE TRAY ABOVE ACCESSIBLE CEILING IN CORRIDOR.

EXTERIOR WIRELESS ACCESS POINT. STUB 1/2" CONDUIT FROM BOX TO CABLE TRAY ABOVE ACCESSIBLE CEILING IN CORRIDOR.

ABBREVIATIONS

+42" DIMENSION INDICATES HEIGHT ABOVE FINISHED FLOOR AT WHICH CENTER OF DEVICE IS TO MOUNTED. SEE PLANS.

3R NEMA 3R

AFB ABOVE FINISHED FLOOR

AHU AUTHORITY HAVING JURISDICTION

AHU AIR HANDLER UNIT

C CONDUIT WITH PULL CORD

C.B. CIRCUIT BREAKER

EC EMPTY CONDUIT WITH PULL CORD

E.C. ELECTRICAL CONTRACTOR

EWC ELECTRIC WATER COOLER

EWH ELECTRIC WATER HEATER

FACP FIRE ALARM CONTROL PANEL

FPN FUSE PER NAMEPLATE

LC LIGHTING CONTACTOR

M.C. MECHANICAL CONTRACTOR

P.C. PLUMBING CONTRACTOR

U.G. UNDERGROUND

WP WEATHERPROOF

S.E. SERVICE ENTRANCE

EM EMERGENCY FIXTURE WITH BATTERY OR GEN. BACK-UP

ER EXISTING ITEM RELOCATED TO THIS LOCATION.

RL EXISTING ITEM TO BE RELOCATED.

RM EXISTING ITEM TO BE REPLACED.

RP EXISTING ITEM TO BE REPLACED.

RV EXISTING ITEM TO BE REMOVED.

ISC RMS SYMMETRICAL SHORT CIRCUIT CURRENT

AIC AMPERE INTERRUPTING CAPACITY (EQUIPMENT RATING)

SCHEDULE NOTES:

- SEE DETAIL FOR STANDARD MOUNTING HEIGHTS OF ALL DEVICES. UNLESS OTHERWISE NOTED.
- ALL DEVICES (SWITCHES AND RECEPTACLES) SHALL BE GRAY AND EMERGENCY SHALL BE RED. COVER PLATE SHALL BE 302 STAINLESS STEEL. ALL COVER PLATES IN MASONRY WALLS SHALL BE JUMBO PLATES.
- DEVICE BOXES SHALL NOT BE MOUNTED BACK TO BACK IN COMMON WALLS UNLESS OTHERWISE NOTED.
- ALL FIRE ALARM SHALL BE IN CONDUIT.
- ALL LOW VOLTAGE CABLING SHALL BE PLENUM RATED.
- M.C. CABLE SHALL NOT BE PERMITTED.
- ALL PLAN DRAWINGS SHALL SUPERSEDE SPECIFICATIONS WHEN PLANS AND SPECIFICATIONS ARE IN CONFLICT.
- ALL COST ASSOCIATED WITH SUBSTITUTED EQUIPMENT TO COMPLY WITH BASIS OF DESIGN, INCLUDING PROVIDING MAINTENANCE ACCESS, CLEARANCE, CONDUIT, WIRE, REPLACEMENT OF OTHER SYSTEM COMPONENTS, BUILDING ALTERATIONS, ETC., SHALL BE INCLUDED IN THE ORIGINAL BASE BID. NO ADDITIONAL COST ASSOCIATED WITH SUBSTITUTED EQUIPMENT WILL BE APPROVED DURING CONSTRUCTION AND ALL COST WILL BE THE RESPONSIBILITY OF THE ELECTRICAL CONTRACTOR.
- SHARED NEUTRAL OR "SUPER NEUTRAL" CONDUCTORS SHALL NOT BE PERMITTED UNLESS SPECIFICALLY SHOWN ON THESE DRAWINGS.
- ALL WALL MOUNTED OCCUPANCY/VACANCY SENSOR SWITCH OUTLETS SHALL BE PROVIDED WITH A GROUNDING CONDUCTOR AS PART OF THE WIRING SYSTEM.

DEVICES AND PATHWAYS

WIRING SYSTEM CONCEALED IN WALL OR CEILING.

WIRING SYSTEM CONCEALED IN OR UNDER SLAB OR UNDERGROUND.

WIRING SYSTEM EXPOSED

CONDUIT TURNED UP TO FLOOR ABOVE.

CONDUIT TURNED DOWN TO FLOOR BELOW.

BRANCH CIRCUIT HOMERUN TO PANEL.

JUNCTION BOX WITH CONNECTION TO EQUIPMENT SERVED.

4" SQUARE BOX WITH A SINGLE-GANG OPENING AND PLASTER RING.

JUNCTION BOX FOR HAND DRYER CONNECTION. SEE MOUNTING HEIGHTS DETAIL FOR EXACT HEIGHTS. SEE ARCH. SHEETS FOR COORDINATION.

4" SQUARE BOX WITH A SINGLE-GANG OPENING AND PLASTER RING.

JUNCTION BOX FOR AV CONNECTION. COORDINATE REQUIREMENTS WITH AV PLANS.

DUPLEX RECEPTACLE, 20 AMP, 120 VOLT (USE 20 AMP FOR SINGLE RECEPTACLE ON A CIRCUIT). HUBBELL 5352, OR EQUAL.

DUPLEX RECEPTACLE MOUNTED ABOVE COUNTER BACKSPLASH, OR AT HEIGHT NOTED. THESE ARE TO BE MOUNTED HORIZONTALLY.

QUAD RECEPTACLE, TWO NEMA 5-20R DUPLEX RECEPTACLES.

QUAD RECEPTACLE ABOVE COUNTER BACKSPLASH, TWO NEMA 5-20R DUPLEX RECEPTACLES.

STANDARD NEMA 5-20R GFI DUPLEX RECEPTACLE FOR ELECTRIC WATER COOLER. COORDINATE LOCATION WITH PLUMBING CONTRACTOR.

GROUND FAULT RECEPTACLE, NEMA 5-20R DUPLEX. ALL RECEPTACLES INSTALLED OUTSIDE, WITHIN 6' OF A SINK OR IN A KITCHEN SHALL BE GFCI.

ISOLATED GROUND RECEPTACLE, NEMA 5-20R DUPLEX.

WEATHERPROOF RECEPTACLE, NEMA 5-20R DUPLEX. COVER SHALL BE INTERMATIC #P1020 (CLEAR) OR EQUAL.

DUPLEX SWITCHED TAMPER RESISTANT RECEPTACLE, 20 AMP, 120 VOLT.

SURGE PROTECTION DEVICE (SPD); SEE DETAIL.

WIREMOLD 2400 PLUGMOLD, NEMA 5-15R RECEPTACLES ON 12" CENTERS. ALTERNATE CIRCUITS.

KITCHEN RECEPTACLE. SEE KITCHEN EQUIPMENT SCHEDULE.

PANELS, DISCONNECTS

FRACTIONAL HORSEPOWER MANUAL MOTOR STARTER, WITH OVERLOAD PROTECTION

NON-FUSED HEAVY DUTY DISCONNECT SWITCH. NUMERALS INDICATE SWITCH RATING. NEMA 1 ENCLOSURE, UNLESS OTHERWISE NOTED.

FUSED HEAVY DUTY DISCONNECT SWITCH. NUMERALS INDICATE SWITCH RATING/FUSE SIZE. NEMA 1 ENCLOSURE, UNLESS OTHERWISE NOTED.

CIRCUIT BREAKER. NUMERALS INDICATE RATING. NEMA 1 ENCLOSURE, UNLESS OTHERWISE NOTED.

PLYWOOD TELEPHONE BACKBOARD. SIZE AS INDICATED ON PANEL.

PANELBOARD. SEE SCHEDULE FOR MOUNTING. TOP OF PANEL AT 6'-6" AFF.

DOOR MOTOR CONTROL. MOUNT +48" AFF. CONTROLS SHALL BE UP, DOWN AND STOP MOUNTED ON 4" SQUARE BOX (FLUSH BOX)

CONNECTION TO MOTOR. STARTER PROVIDED BY OTHERS UNLESS OTHERWISE NOTED.

SECURITY

SECURITY CAMERA LOCATION. PROVIDE JUNCTION BOX AND 1" TO CABLE TRAY SYSTEM ABOVE ACCESSIBLE CORRIDOR CEILING. CLOSELY REVIEW VENDOR REQUIREMENTS FOR COMPLETE INFRASTRUCTURE REQUIREMENTS. SUBSCRIPT "WP" INDICATES WEATHERPROOF. PROVIDE WATER TIGHT JUNCTION BOX.

WALL MOUNTED SECURITY CAMERA LOCATION. PROVIDE JUNCTION BOX AND 1" TO CABLE TRAY SYSTEM ABOVE ACCESSIBLE CORRIDOR CEILING. CLOSELY REVIEW VENDOR REQUIREMENTS FOR COMPLETE INFRASTRUCTURE REQUIREMENTS. SUBSCRIPT "WP" INDICATES WEATHERPROOF. PROVIDE WATER TIGHT JUNCTION BOX.

CARD READER. MINIMUM 1/2" CONDUIT. PROVIDE SINGLE GANG JUNCTION BOX AND PULL STRING. SEE CARD READER DETAIL FOR ADDITIONAL REQUIREMENTS OF PATHWAYS AND CABLING.

DOOR CONTACT. MINIMUM 1/2" CONDUIT. PROVIDE SINGLE GANG JUNCTION BOX AND PULL STRING. SEE CARD READER DETAIL FOR ADDITIONAL REQUIREMENTS OF PATHWAYS AND CABLING.

OFFICE/SHOPS BUILDING

2012 NORTH CAROLINA ENERGY CONSERVATION CODE
 COMMERCIAL ENERGY EFFICIENCY - ELECTRICAL SUMMARY

501.1 METHOD OF COMPLIANCE: NC SPECIFIC COMCHECK PROVIDED
 2012 NCECC CHAPTER 5
 20% IMPROVEMENT OVER ASHRAE 90.1-2007
 NOT APPLICABLE BASED ON PROJECT SCOPE

501.2 APPLICATION COMPLIANCE:
 506.2.1 EFFICIENT MECH EQUIPMENT
 506.2.4 HI EFFICIENCY DOMESTIC HW
 506.2.2 REDUCED LTG DENSITY
 506.2.5 ONSITE RENEWABLE ENERGY
 506.2.3 ENERGY RECOVERY SYSTEMS
 506.2.6 DAYLIGHTING CONTROLS
 NOT APPLICABLE BASED ON PROJECT SCOPE

505.2 - INTERIOR LIGHTING CONTROLS (MANDATORY REQUIREMENTS):
 INTERIOR LIGHTING SYSTEMS ARE PROVIDED WITH CONTROLS AS REQUIRED PER SECTION 505.2, EXCEPT WHERE EXEMPT.
 NOT APPLICABLE

505.3 - TANDEM WIRING (MANDATORY REQUIREMENTS):
 FLUORESCENT LUMINAIRES LOCATED WITHIN THE SAME AREA ARE TANDEM WIRED AS REQUIRED PER SECTION 505.3, EXCEPT WHERE EXEMPT.
 NOT APPLICABLE

505.4 - EXIT SIGNS (MANDATORY REQUIREMENTS):
 INTERNALLY ILLUMINATED EXIT SIGNS DO NOT EXCEED 5 WATTS PER SIDE.
 NOT APPLICABLE

505.5 - INTERIOR LIGHTING POWER REQUIREMENTS (PRESCRIPTIVE) (NON-EXEMPT):
 NOT APPLICABLE PER 2012 NCECC 101.4.3, EXCEPTION 1.G.
 505.5.1 - TOTAL CONNECTED INTERIOR LIGHTING POWER:
 16,100 WATTS SPECIFIED
 22 % REDUCTION OF SPECIFIED VS. ALLOWED (APPLICABLE IF 506.2.2 IS SELECTED)
 505.5.2 - TOTAL ALLOWABLE INTERIOR LIGHTING POWER:
 METHOD OF COMPLIANCE:
 BUILDING AREA METHOD
 SPACE-BY-SPACE METHOD
 27,845 WATTS ALLOWED

505.6.1 - EXTERIOR BUILDING GROUNDS LIGHTING:
 LAMPS OPERATING AT GREATER THAN 100 WATTS FOR EXTERIOR BUILDING GROUNDS LUMINAIRES HAVE A MINIMUM EFFICACY OF 60 LUMENS PER WATT, EXCEPT WHERE EXEMPT.
 NOT APPLICABLE

505.6.2 - EXTERIOR BUILDING LIGHTING POWER (NON-EXEMPT):
 NOT APPLICABLE
 TOTAL CONNECTED EXTERIOR LIGHTING POWER:
 2,100 WATTS SPECIFIED
 TOTAL ALLOWABLE EXTERIOR LIGHTING POWER:
 4,250 WATTS ALLOWED

505.6.3 - SHIELDING OF EXTERIOR BUILDING LIGHTING FIXTURES:
 ONLY FULLY SHIELDED EXTERIOR BUILDING LIGHTING FIXTURES ARE PROVIDED, EXCEPT WHERE EXEMPT.
 ALTERNATIVE EXTERIOR BUILDING LIGHTING FIXTURES ARE PROVIDED FOR GREATER ENERGY EFFICIENCY OVER FULLY SHIELDED EXTERIOR BUILDING LIGHTING FIXTURES.
 NOT APPLICABLE

505.7 - ELECTRICAL ENERGY CONSUMPTION (DWELLING UNITS):
 SEPARATE TENANT METERING TO DETERMINE ELECTRICAL ENERGY CONSUMPTION HAS BEEN PROVIDED FOR BUILDINGS HAVING INDIVIDUAL DWELLING UNITS.
 NOT APPLICABLE

OFFICE SHOPS OVERALL BUILDING

LOADS IN KVA	EXISTING DEMAND			NEW CONNECTED			DIVERSITY FACTOR (%)	NEW DEMAND			TOTAL KVA		
	SINGLE PHASE	THREE PHASE	PHASE (%)	SINGLE PHASE	THREE PHASE	PHASE (%)		SINGLE PHASE	THREE PHASE	PHASE (%)	EXISTING AND NEW DEMAND	EXISTING AND NEW DEMAND	EXISTING AND NEW DEMAND
LIGHTS	28.0	129	35.0	0.0	35.0	125	35.0	0.0	35.0	212.0	0.0	212.0	
HVAC	62.0	301.0	100	62.0	301.0	96.0	96.0	0.0	96.0	123.0	0.0	123.0	
MOTORS	10.3	95.0	100	27.0	96.0	65	65	0.0	65	8.7	0.0	8.7	
KITCHEN	10.3	65	6.7	0.0	6.7	NEC	80.5	0.0	80.5	0.0	0.0	80.5	
RECEPTACLES	151.0	NEC	18.7	0.0	18.7	125	26.7	0.0	26.7	156.0	0.0	156.0	
WATER HEATER	21.4	125	26.7	0.0	26.7	100	0.0	0.0	60.0	80.0	0.0	80.0	
MISC.	106.0	100	106.0	0.0	106.0	100	0.0	0.0	0.0	106.0	0.0	106.0	
FUTURE ALLOWANCE		213.0	100	0.0	213.0								
TOTAL				343.9	810.0				649.9				

OFFICE SHOPS LIFE SAFETY

LOADS IN KVA	EXISTING DEMAND			NEW CONNECTED			DIVERSITY FACTOR (%)	NEW DEMAND			TOTAL KVA		
	SINGLE PHASE	THREE PHASE	PHASE (%)	SINGLE PHASE	THREE PHASE	PHASE (%)		SINGLE PHASE	THREE PHASE	PHASE (%)	EXISTING AND NEW DEMAND	EXISTING AND NEW DEMAND	EXISTING AND NEW DEMAND
LIGHTS	19.3	125	28.1	1	28.1	125	28.1	0.0	28.1	7.5	0.0	7.5	
HEATING													
COOLING													
VENTILATION													
MOTORS													
KITCHEN													
RECEPTACLES													
WATER HEATER													
MISC.													
FUTURE ALLOWANCE													
TOTAL									14.1	10.0		24.1	

WAREHOUSE LIFE SAFETY

LOADS IN KVA	EXISTING DEMAND			NEW CONNECTED			DIVERSITY FACTOR (%)	NEW DEMAND			TOTAL KVA		
	SINGLE PHASE	THREE PHASE	PHASE (%)	SINGLE PHASE	THREE PHASE	PHASE (%)		SINGLE PHASE	THREE PHASE	PHASE (%)	EXISTING AND NEW DEMAND	EXISTING AND NEW DEMAND	EXISTING AND NEW DEMAND
LIGHTS													
HEATING													
COOLING													
VENTILATION													
MOTORS													
KITCHEN													
RECEPTACLES													
WATER HEATER													
MISC.													
FUTURE ALLOWANCE													
TOTAL									16.6	10.0		26.6	

TOTAL GENERATOR LOAD

LOADS IN KVA	EXISTING DEMAND			NEW CONNECTED			DIVERSITY FACTOR (%)	NEW DEMAND			TOTAL KVA		
	SINGLE PHASE	THREE PHASE	PHASE (%)	SINGLE PHASE	THREE PHASE	PHASE (%)		SINGLE PHASE	THREE PHASE	PHASE (%)	EXISTING AND NEW DEMAND	EXISTING AND NEW DEMAND	EXISTING AND NEW DEMAND
LIGHTS	0.0	0.0	0.0	0.0	0.0	125	0.0	0.0	0.0	0.0	0.0	0.0	
HEATING													
COOLING													
VENTILATION													
MOTORS													
KITCHEN													
RECEPTACLES													
WATER HEATER													
MISC.													
FUTURE ALLOWANCE													
TOTAL									364.6	326.0		690.6	

WAREHOUSE BUILDING

2012 NORTH CAROLINA ENERGY CONSERVATION CODE
 COMMERCIAL ENERGY EFFICIENCY - ELECTRICAL SUMMARY

501.1 METHOD OF COMPLIANCE: NC SPECIFIC COMCHECK PROVIDED
 2012 NCECC CHAPTER 5
 20% IMPROVEMENT OVER ASHRAE 90.1-2007
 NOT APPLICABLE BASED ON PROJECT SCOPE

501.2 APPLICATION COMPLIANCE:
 506.2.1 EFFICIENT MECH EQUIPMENT
 506.2.4 HI EFFICIENCY DOMESTIC HW
 506.2.2 REDUCED LTG DENSITY
 506.2.5 ONSITE RENEWABLE ENERGY
 506.2.3 ENERGY RECOVERY SYSTEMS
 506.2.6 DAYLIGHTING CONTROLS
 NOT APPLICABLE BASED ON PROJECT SCOPE

505.2 - INTERIOR LIGHTING CONTROLS (MANDATORY REQUIREMENTS):
 INTERIOR LIGHTING SYSTEMS ARE PROVIDED WITH CONTROLS AS REQUIRED PER SECTION 505.2, EXCEPT WHERE EXEMPT.
 NOT APPLICABLE

505.3 - TANDEM WIRING (MANDATORY REQUIREMENTS):
 FLUORESCENT LUMINAIRES LOCATED WITHIN THE SAME AREA ARE TANDEM WIRED AS REQUIRED PER SECTION 505.3, EXCEPT WHERE EXEMPT.
 NOT APPLICABLE

505.4 - EXIT SIGNS (MANDATORY REQUIREMENTS):
 INTERNALLY ILLUMINATED EXIT SIGNS DO NOT EXCEED 5 WATTS PER SIDE.
 NOT APPLICABLE

505.5 - INTERIOR LIGHTING POWER REQUIREMENTS (PRESCRIPTIVE) (NON-EXEMPT):
 NOT APPLICABLE PER 2012 NCECC 101.4.3, EXCEPTION 1.G.
 505.5.1 - TOTAL CONNECTED INTERIOR LIGHTING POWER:
 16,100 WATTS SPECIFIED
 22 % REDUCTION OF SPECIFIED VS. ALLOWED (APPLICABLE IF 506.2.2 IS SELECTED)
 505.5.2 - TOTAL ALLOWABLE INTERIOR LIGHTING POWER:
 METHOD OF COMPLIANCE:
 BUILDING AREA METHOD
 SPACE-BY-SPACE METHOD
 27,845 WATTS ALLOWED

505.6.1 - EXTERIOR BUILDING GROUNDS LIGHTING:
 LAMPS OPERATING AT GREATER THAN 100 WATTS FOR EXTERIOR BUILDING GROUNDS LUMINAIRES HAVE A MINIMUM EFFICACY OF 60 LUMENS PER WATT, EXCEPT WHERE EXEMPT.
 NOT APPLICABLE

505.6.2 - EXTERIOR BUILDING LIGHTING POWER (NON-EXEMPT):
 NOT APPLICABLE
 TOTAL CONNECTED EXTERIOR LIGHTING POWER:
 2,100 WATTS SPECIFIED
 TOTAL ALLOWABLE EXTERIOR LIGHTING POWER:
 4,250 WATTS ALLOWED

505.6.3 - SHIELDING OF EXTERIOR BUILDING LIGHTING FIXTURES:
 ONLY FULLY SHIELDED EXTERIOR BUILDING LIGHTING FIXTURES ARE PROVIDED, EXCEPT WHERE EXEMPT.
 ALTERNATIVE EXTERIOR BUILDING LIGHTING FIXTURES ARE PROVIDED FOR GREATER ENERGY EFFICIENCY OVER FULLY SHIELDED EXTERIOR BUILDING LIGHTING FIXTURES.
 NOT APPLICABLE

505.7 - ELECTRICAL ENERGY CONSUMPTION (DWELLING UNITS):
 SEPARATE TENANT METERING TO DETERMINE ELECTRICAL ENERGY CONSUMPTION HAS BEEN PROVIDED FOR BUILDINGS HAVING INDIVIDUAL DWELLING UNITS.
 NOT APPLICABLE

LOAD TABULATION - OFFICE AND SHOPS BUILDING


LOADS IN KVA	EXISTING DEMAND			NEW CONNECTED			DIVERSITY FACTOR (%)	NEW DEMAND			TOTAL KVA		
	SINGLE PHASE	THREE PHASE	PHASE (%)	SINGLE PHASE	THREE PHASE	PHASE (%)		SINGLE PHASE	THREE PHASE	PHASE (%)	EXISTING AND NEW DEMAND	EXISTING AND NEW DEMAND	EXISTING AND NEW DEMAND
LIGHTS	28.0	129	35.0	0.0	35.0	125	35.0	0.0	35.0	212.0	0.0	212.0	
HVAC	62.0	301.0	100	62.0	301.0	96.0	96.0	0.0	96.0	123.0	0.0	123.0	
MOTORS	10.3	95.0	100	27.0	96.0	65	65	0.0	65	8.7	0.0		

No.	Description	Date
1	Addendum #4	8.28.2017

VOLTAGE TO GROUND NOMINAL	MINIMUM CLEAR DISTANCE (FEET)		
	CONDITION: 1	2	3
0 - 150	3	3	3
151 - 600	3	3 1/2	4

WHERE THE "CONDITIONS" ARE AS FOLLOWS:

- EXPOSED LIVE PARTS ON ONE SIDE AND NO LIVE OR GROUNDING PARTS ON THE OTHER SIDE OF THE WORKING SPACE, OR EXPOSED PARTS ON BOTH SIDES EFFECTIVELY GUARDED BY SUITABLE WOOD OR OTHER INSULATING MATERIALS. INSULATED WIRE OR INSULATED BUSBARS OPERATING AT NOT OVER 300V SHALL NOT BE CONSIDERED LIVE PARTS.
- EXPOSED LIVE PARTS ON ONE SIDE AND GROUNDING PARTS ON THE OTHER SIDE.
- EXPOSED LIVE PARTS ON BOTH SIDES OF THE WORK SPACE (NOT GUARDED AS PROVIDED IN CONDITION 1) WITH THE OPERATOR BETWEEN.

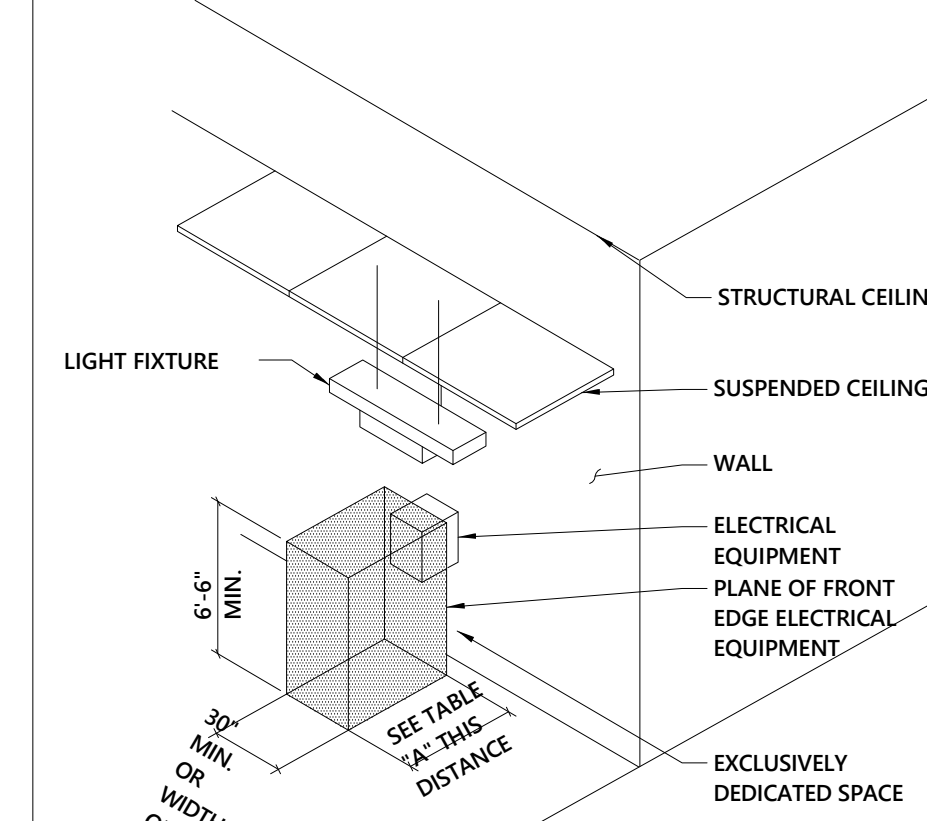


THIS FIGURE ILLUSTRATES THE WORKING SPACE IN FRONT OF THE ELECTRICAL EQUIPMENT REQUIRED BY SECTION 11-26 OF THE NATIONAL ELECTRICAL CODE.


4 WORKING CLEARANCE FOR ELECTRICAL EQUIPMENT
NO SCALE

ELECTRICAL NOTES:

- EQUIPMENT OF TRADES OTHER THAN ELECTRICAL.
- CONDUIT AND WIRING BY HVAC PLUMBING CONTRACTOR OR OTHER TRADES.
- IF AN ADDITIONAL DISCONNECT IS REQUIRED BY NEC, IT SHALL BE PROVIDED AND INSTALLED BY THE EQUIPMENT CONTRACTOR.
- A COMBINATION STARTER OR VFD MAY BE USED IN LIEU OF A SEPARATE DISCONNECT SWITCH AND STARTER LOCATE ADJACENT TO EQUIPMENT.
- FEEDER CIRCUIT WIRING AND CONDUIT IN ELECTRICAL WORK SEE PANELBOARD SCHEDULES FOR WIRE AND BREAKER SIZES.
- JUNCTION BOX MAY BE SHOWN ON ELECTRICAL PLANS FOR SOME EQUIPMENT: IF NO STARTER OR DISCONNECT IS SUPPLIED, A JUNCTION BOX SHALL BE INSTALLED ADJACENT TO EQUIPMENT. THE ELECTRICAL CONTRACTOR SHALL PROVIDE LINE SIDE WIRING TO THE JUNCTION BOX. LOAD SIDE WIRING WILL BE PROVIDED BY MECHANICAL CONTRACTOR OR OTHER TRADES.
- PROJECTS UTILIZING AN MCC, THE STARTER, CB, OR VFD IN THE MCC ARE PROVIDED BY THE ELECTRICAL CONTRACTOR.
- IN ALL CASES THE EQUIPMENT CONTRACTOR SHALL MAKE FINAL CONNECTIONS STARTUP, AND TEST EQUIPMENT.
- IF THE ROOF TOP EQUIPMENT IS NOT PROVIDED WITH BUILT IN SWITCH, THE ELECTRICAL CONTRACTOR SHALL PROVIDE AND INSTALL DISCONNECT SWITCH.

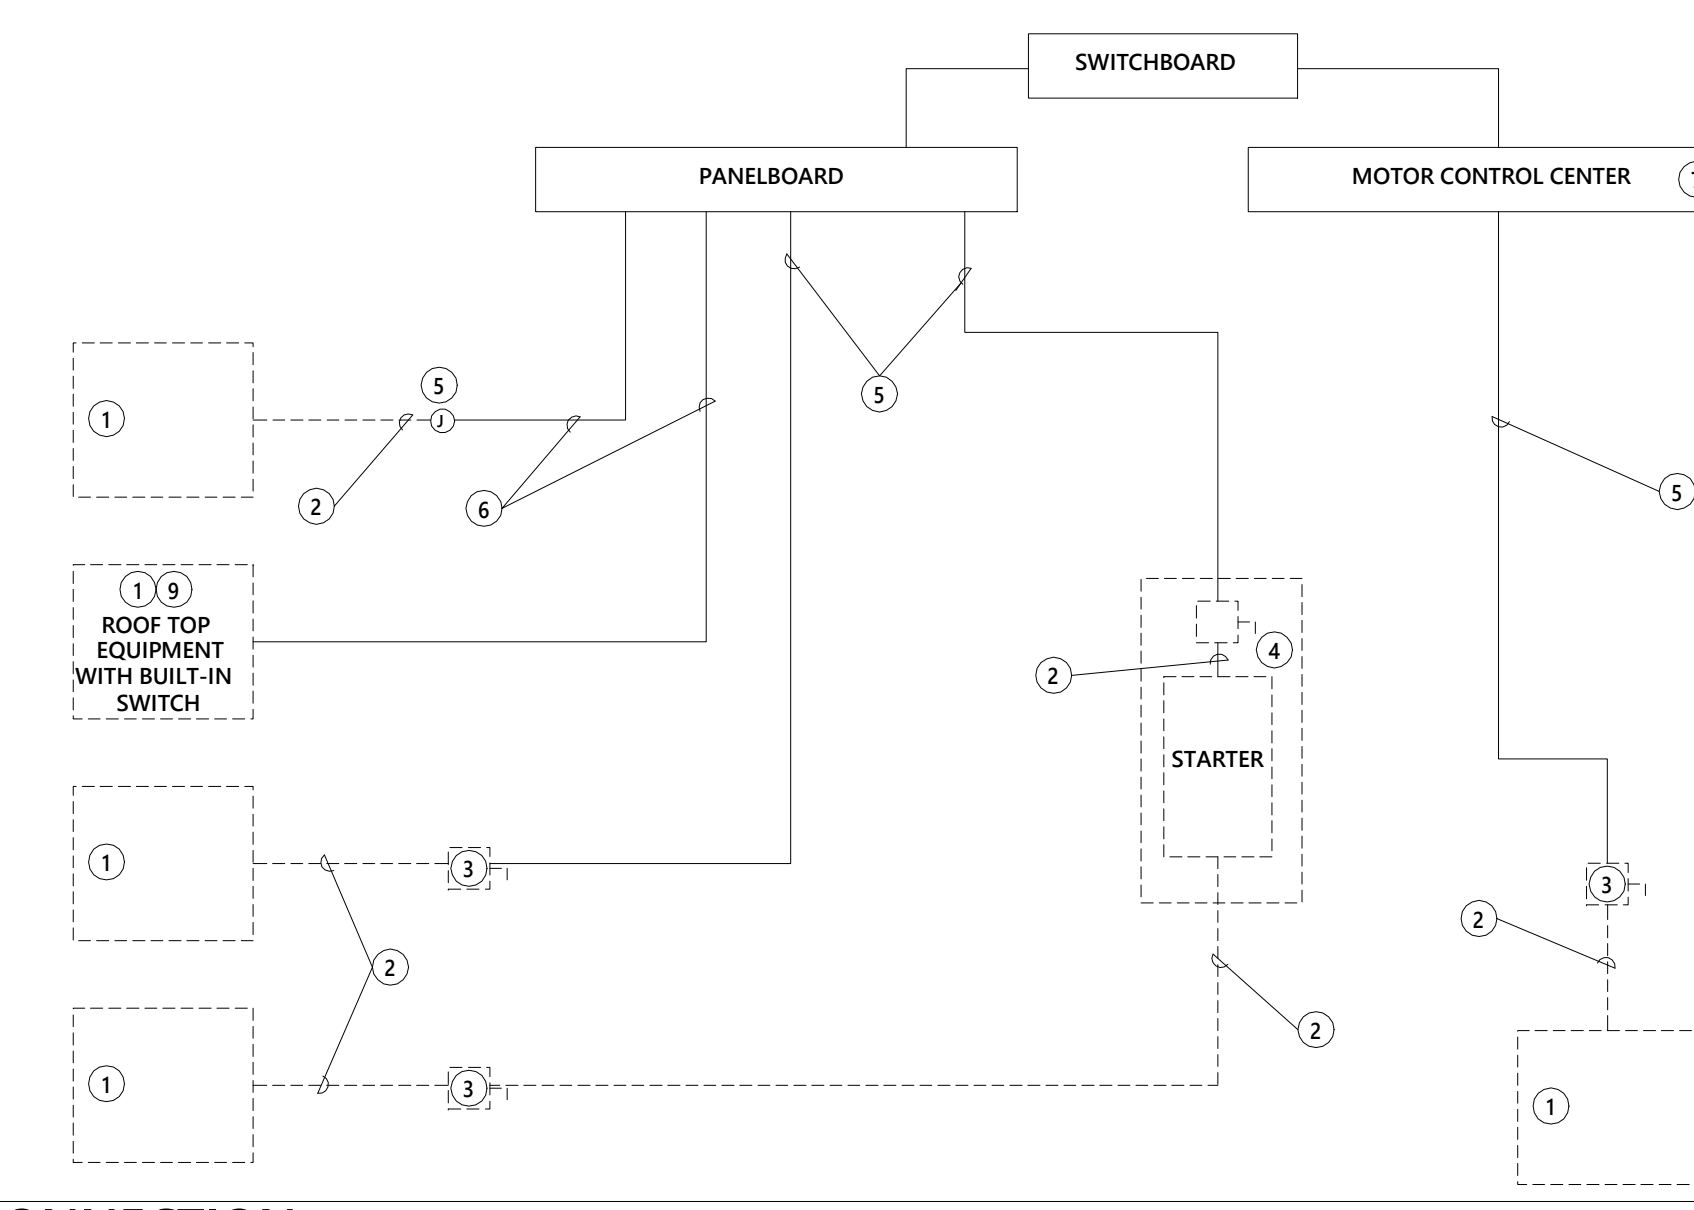


7 ELECTRICAL EQUIPMENT CONNECTION
NO SCALE

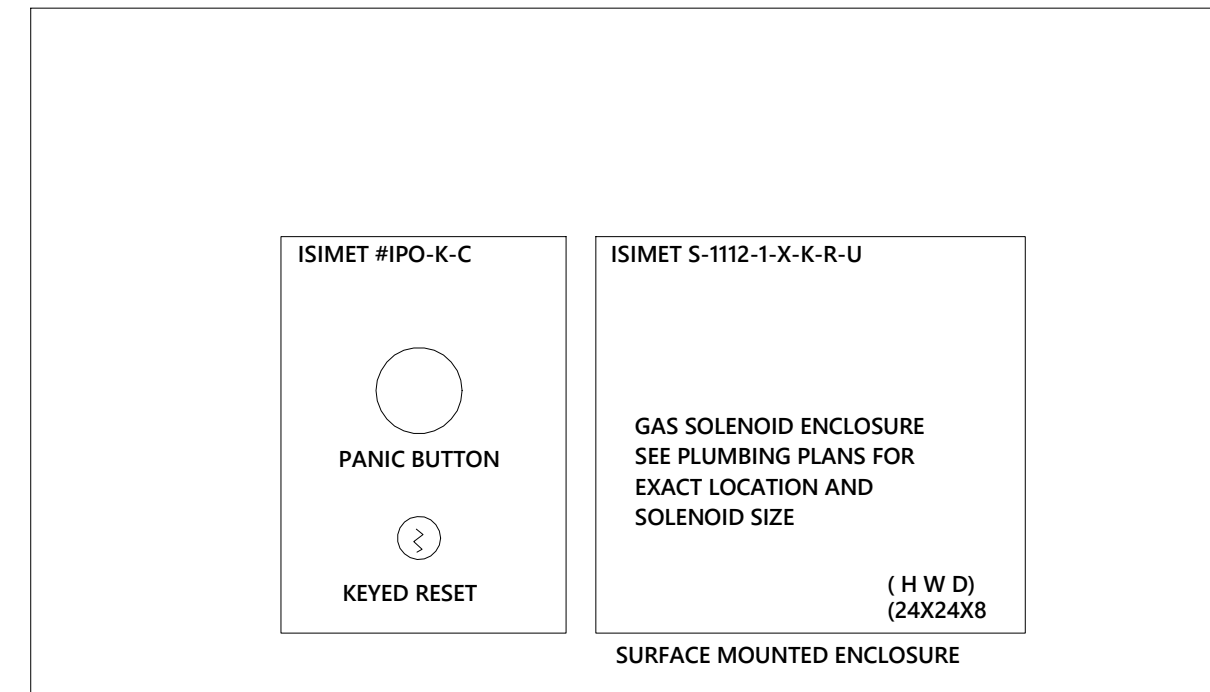


- NOTES:
- PROVIDE PHENOLIC LABEL ABOVE PUSH BUTTON.
 - PROVIDE REMOTE PANIC ASSEMBLY IPO-K-C WITH OPTION "C", PANIC BUTTON COVER.
 - CONNECT TO LOCAL 120V CIRCUIT FOR CONTROLLER.
 - SEE PLUMBING PLANS FOR EXACT LOCATION AND SOLENOID SIZE.
 - 3/4" CONDUIT FROM PANIC BUTTON TO SOLENOID ENCLOSURE.

3 EMERG. SHUT OFF CONTROL DETAIL (ISIMET)
NO SCALE

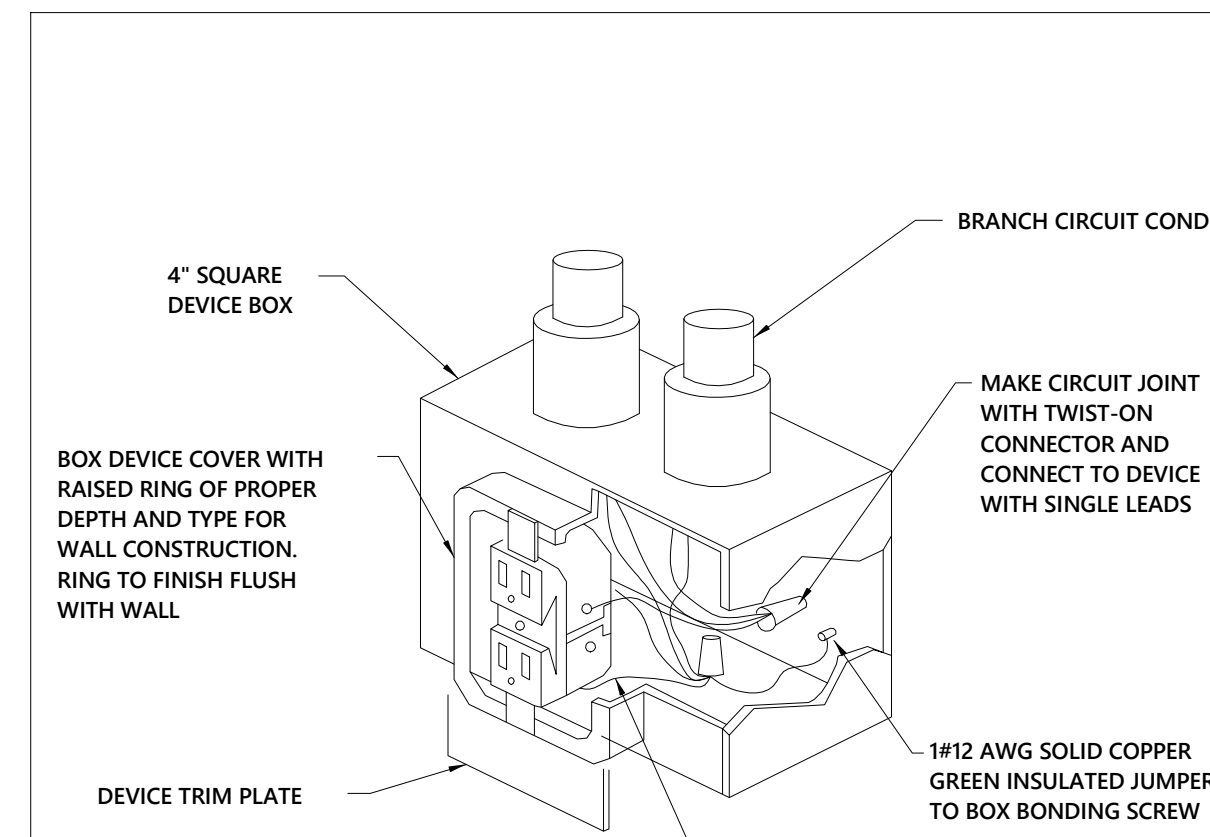


6 RECEPTACLE GROUNDING DETAIL
NO SCALE

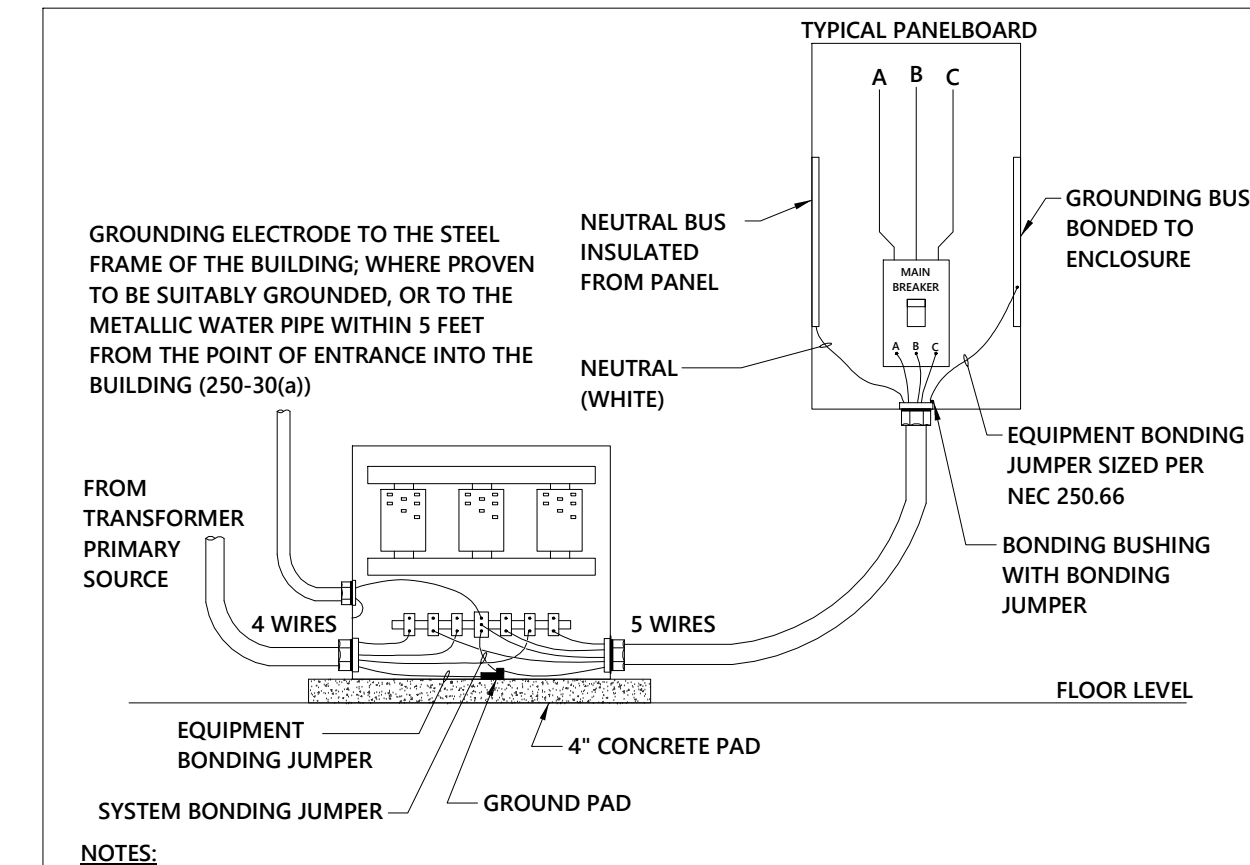

- NOTES:
- TRANSFORMER BONDING STRAP, IF NOT PROVIDED BY THE TRANSFORMER MANUFACTURER THIS STRAP SHOULD BE THE SAME SIZE AS THE SYSTEM BONDING JUMPER (250.30).
 - USE A BONDING BUSHING AND EQUIPMENT BONDING JUMPER AT THE CONDUIT TERMINATION. JUMPER SHOULD BE THE SAME SIZE AS THE GROUNDING ELECTRODE CONDUCTOR TO THE ELECTRODE.
 - USE A BONDING CLAMP AT THE TERMINATION OF THE GROUNDING ELECTRODE CONDUCTOR TO THE ELECTRODE.
 - IF STRUCTURAL STEEL OR WATER PIPE IS NOT AVAILABLE, CONNECT GROUND TO ALTERNATIVE GROUNDING ELECTRODE PER NEC 250.52A.

2 DRY-TYPE TRANSFORMER GROUNDING DIAGRAM
NO SCALE

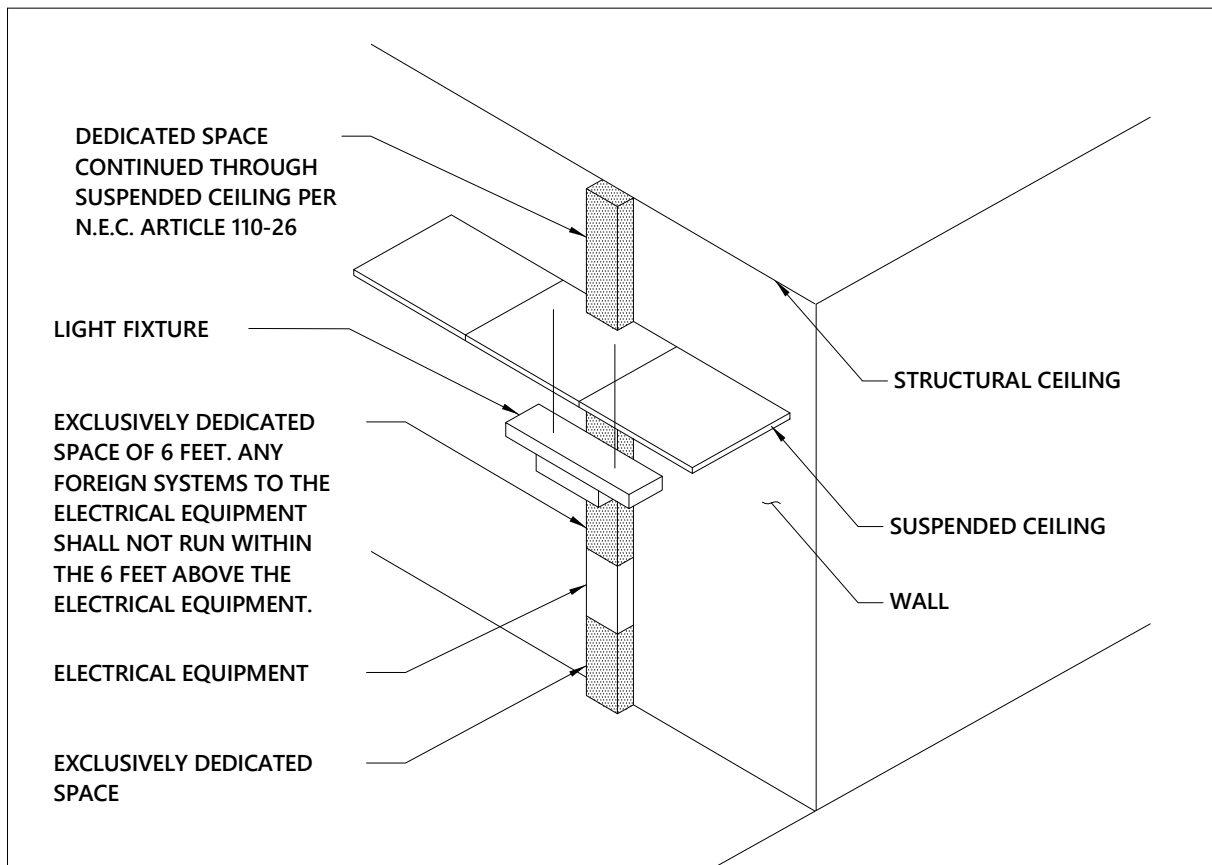


THIS FIGURE ILLUSTRATES THE ADDITIONAL EXCLUSIVELY DEDICATED SPACE REQUIRED OVER AND UNDER THE ELECTRICAL EQUIPMENT FOR THE CABLES, RECEAVALS, ETC. TO AND FROM THE ELECTRICAL EQUIPMENT REQUIRED BY SECTION 11-26 OF THE NATIONAL ELECTRICAL CODE.


1 DEDICATED SPACE FOR ELECTRICAL EQUIPMENT
NO SCALE

- NOTES:
- THE PRIMARY NEUTRAL CONDUCTOR MUST BE BONDED CONTINUOUSLY TO THE PRIMARY CONDUIT (IF METALLIC), THE GROUND ROD, THE TRANSFORMER TANK GROUND PAD IN THE PRIMARY COMPARTMENT, AND THE HO/XO NEUTRAL BUSHING. THIS STEP SHALL BE REPEATED IF LOOP FEED TRANSFORMER.
 - THE STRESS CONES AND THE PRIMARY CABLE SHIELD MUST BE GROUND TO THE NEUTRAL CONDUCTOR. THIS STEP SHALL BE REPEATED IF LOOP FEED TRANSFORMER.
 - A #4 COPPER GROUND WIRE IS TO BE BONDED TO THE HO/XO BUSHING, TO THE GROUND PAD IN SECONDARY COMPARTMENT, TO THE SECONDARY CONDUIT (IF METALLIC), AND TO THE GROUND ROD.
 - GROUND STRAP MUST CONNECT THE HO/XO BUSHING TO THE TRANSFORMER TANK.
 - A SUITABLE FLEXIBLE #6 COPPER ARRESTER LEAD SHALL BE INSTALLED FROM EACH ARRESTER DIRECTLY TO THE GROUND ROD (NOT SHOWN).
 - THE PRIMARY AND SECONDARY CONDUIT SHALL EXTEND TWO INCHES ABOVE THE CONCRETE PAD.
 - IF THE RESISTANCE OF THE GROUND ROD EXCEEDS 25 OHMS, INSTALL AN ADDITIONAL GROUND ROD AT LEAST 10' AWAY. INTER-CONNECT THE TWO USING #4 COPPER GROUND WIRE.
 - COMPLETE INSTALLATION MUST BE IN COMPLIANCE WITH THE NATIONAL ELECTRICAL SAFETY CODE, ANSI C2.


5 TYPICAL GROUNDING DETAILS FOR THREE PHASE TRANSFORMERS
NO SCALE

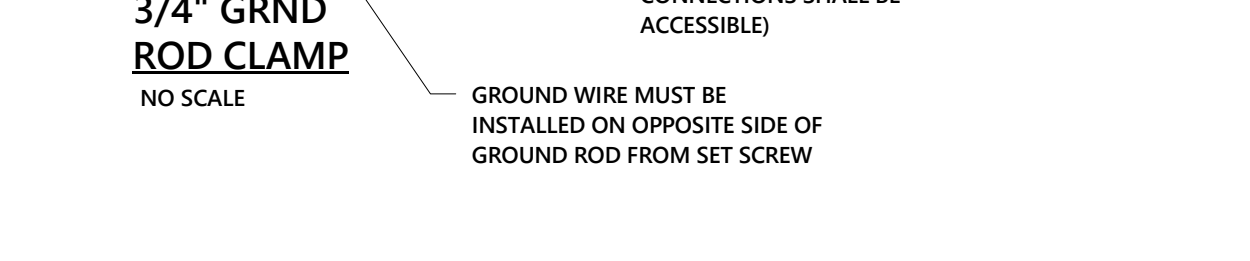


3/4" GRND ROD CLAMP
NO SCALE

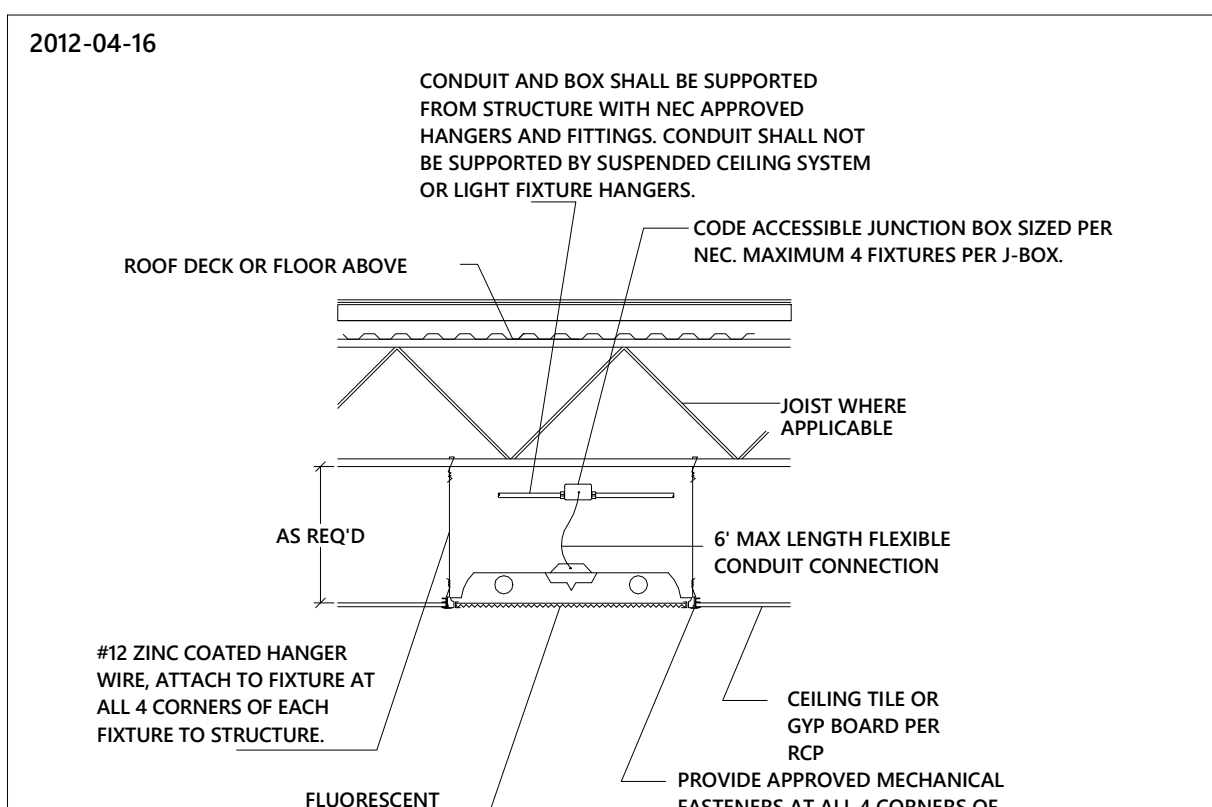

8 TYPICAL LAY-IN FIXTURE DIAGRAM
NO SCALE

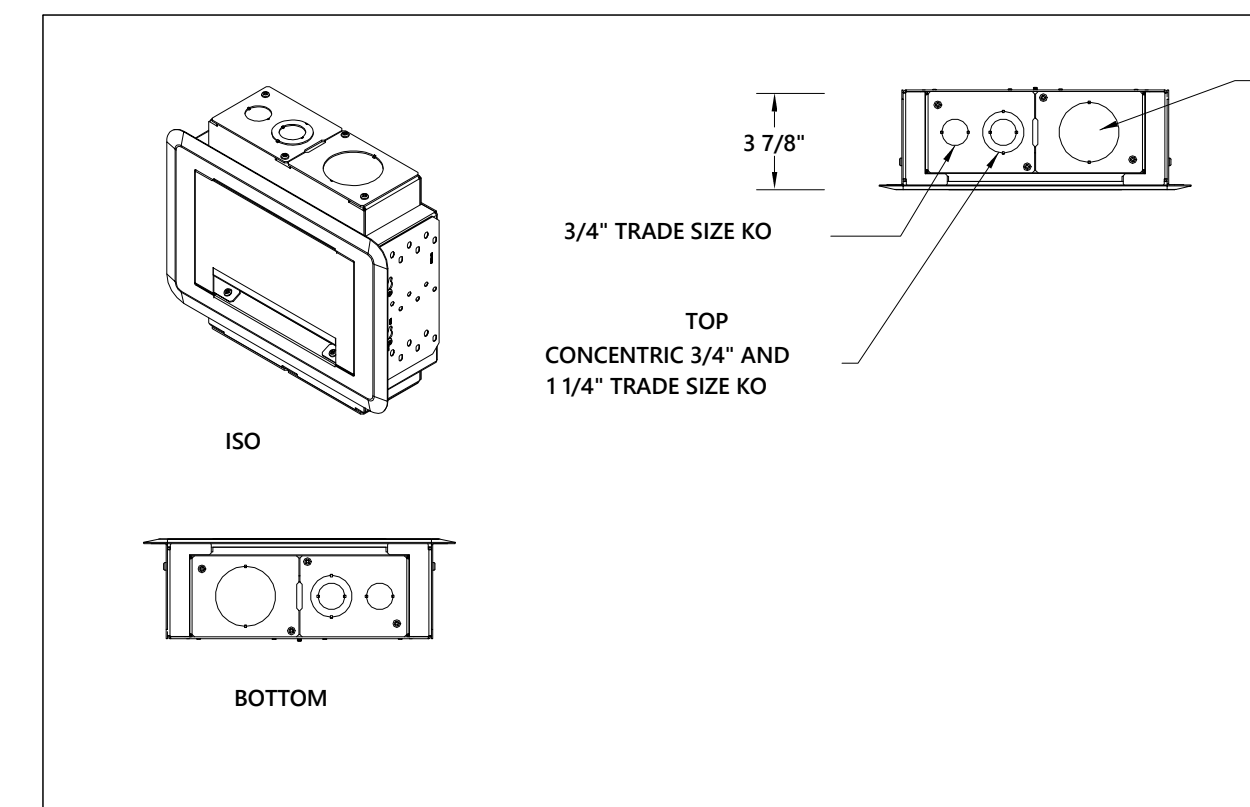

9 TYPICAL TV/MONITOR AND POWER BACK BOX DIAGRAM FOR WALL MOUNTED FLAT SCREEN
NO SCALE

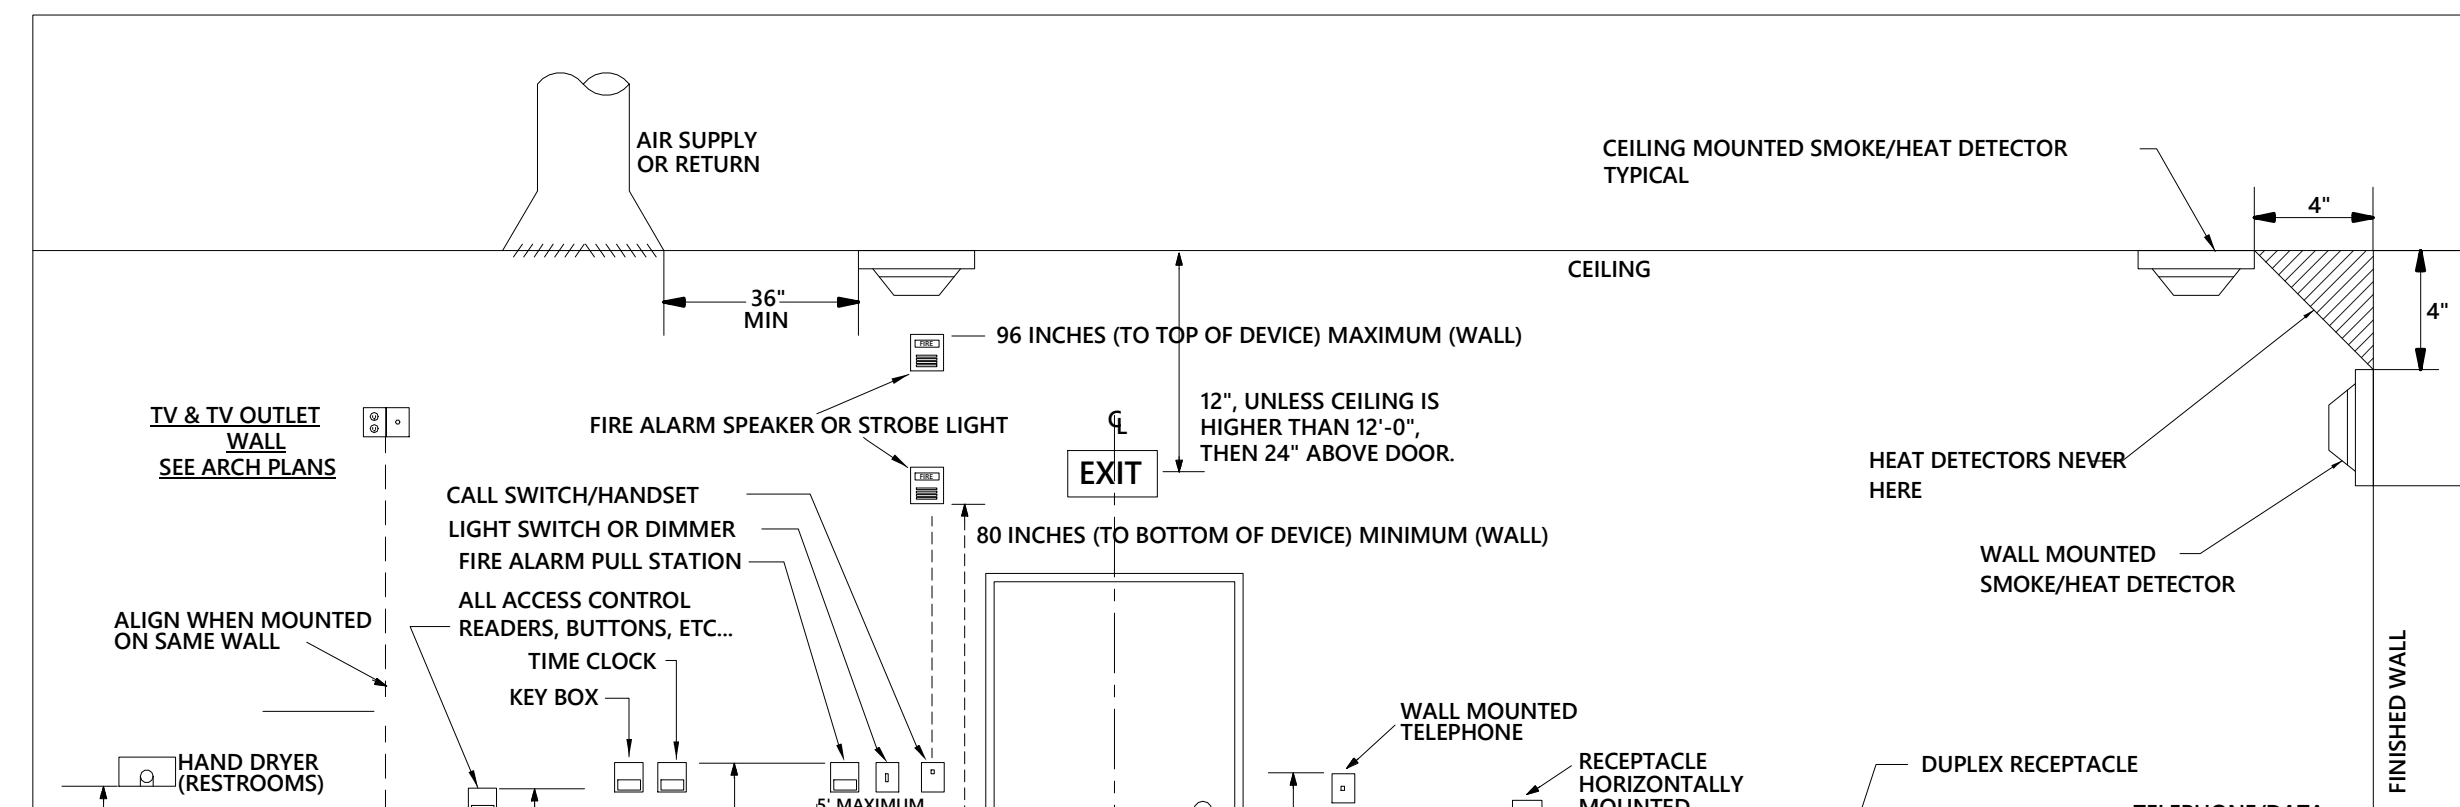

10 MOUNTING HEIGHTS OF DEVICES - ELEVATION
NO SCALE

- NOTES:
- BASED ON SYSTEM: LEGRAND EVOLUTION WALL BOX EFS84 OR APPROVED SUBMITTED EQUAL. PROVIDE PLATES AND MODULES PER REQUIRED CONDUIT SIZING. MINIMUM LAYOUT IS (1) 3/4", (1) 1/4", AND (1) 2" KNOCKOUT.
 - PROVIDE DEVICE PLATE PER SPECIFICATIONS.
 - PROVIDE (2) NEMA 5-20R RECEPTACLES, COMMERCIAL GRADE PER SPECIFICATIONS WITH PLATE.
 - DEVICE BRACKETS, BACK BOX, UL LISTED BARRIER, TUNNEL, AND KNOCKOUT PLATES ARE STANDARD. PROVIDE ADDITIONAL KNOCKOUT PLATE BASED ON SPECIFIED CONDUIT.
 - COORDINATE DEVICE LAYOUT IN DEVICE MODULES SO CABLING IS MAXIMIZED TO BE ROUTED OUT OF TRIM FLANGE COVER.
 - (4) TOTAL DEVICES PER BOX, WITH (2) BEING USED FOR RECEPTACLES.
 - FOR ALL MASONRY/CML APPLICATIONS PROVIDE MASONRY BRACKETS FOR INSTALLATION.

ELECTRICAL/MECHANICAL DEMARCATION

REFER TO DETAIL 7/E-002 FOR MECHANICAL CONTRACTOR'S RESPONSIBILITIES RELATED TO ELECTRICAL DISCONNECTS, STARTERS AND WIRING OF MECHANICAL EQUIPMENT. ALL DISCONNECTS, STARTERS AND WIRING (LOAD SIDE OF DISCONNECTS) SHALL BE FURNISHED AND INSTALLED BY M.C. UNLESS OTHERWISE NOTED IN DETAIL 13/M-502. COORDINATE ALL ELECTRICAL REQUIREMENTS WITH E.C. PRIOR TO ASSEMBLING SHOP DRAWING SUBMITTALS OR ORDERING EQUIPMENT.

MEASUREMENT & VERIFICATION NOTE

THIS IS A NORTH CAROLINA STATE CONSTRUCTION PROJECT WITH MANDATED MEASUREMENT AND VERIFICATION OF POST-OCCUPANCY WATER, AND ELECTRIC CONSUMPTION. DESIGN ANALYSIS AND PROJECTED CONSUMPTION WILL BE COMPARED TO ACTUAL USAGE AT BOTH 10 MONTH AND 12 MONTH POST-OCCUPANCY INTERVALS.

THE COMMISSIONING AGENT AND OWNER WILL PROVIDE WATER AND ELECTRIC CONSUMPTION AND TRENDDING DATA FROM THE MEASUREMENT AND VERIFICATION SYSTEM AT THE 10 MONTH AND 12 MONTH INTERVALS. THIS INFORMATION WILL BE PROVIDED TO THE ENGINEER FOR EVALUATION AND COMPARISON TO THE DESIGN ANALYSIS, ENERGY MODEL SIMULATION AND CONSUMPTION GOALS OF THE PROJECT.

RESULTS DEVIATING BY GREATER THAN 15% FROM PROJECTIONS WILL BE FURTHER ANALYZED AND A SYSTEM ADJUSTMENT REPORT PROVIDED FROM THE ENGINEER TO THE OWNER FOR SUGGESTED OPERATIONAL MODIFICATIONS.


COMMISSIONING NOTE

ELECTRICAL CONTRACTOR SHALL COORDINATE WITH OWNER'S COMMISSIONING AGENT AND PROVIDE ALL NECESSARY TIME, MATERIALS, AND PROCEDURES REQUIRED FOR A FULLY COMMISSIONED PROJECT.

COORDINATION DRAWINGS


PER SPECIFICATION SECTION 01 31 00 PROJECT MANAGEMENT AND COORDINATION, THE MECHANICAL CONTRACTOR SHALL ORGANIZE COORDINATION MEETINGS TO DEVELOP A SET OF COORDINATION DRAWINGS WITH ALL CONTRACTORS (ELECTRICAL, MECHANICAL, PLUMBING, FIRE PROTECTION, IT/DATA, AND GENERAL CONTRACTOR). THE MECHANICAL CONTRACTOR WILL HAVE THE LEAD RESPONSIBILITY FOR THE COORDINATION DRAWINGS. THE MECHANICAL CONTRACTOR SHALL PRODUCE THE ORIGINAL DRAWINGS AND FORWARD THE DRAWINGS TO EACH OF THE OTHER CONTRACTORS FOR THEM TO ADD THEIR SYSTEMS TO THIS SET OF COORDINATION DRAWINGS. THE CONTRACTORS WILL DEVELOP THE DRAWINGS IN THIS ORDER: MECHANICAL, FIRE PROTECTION, ELECTRICAL, IT/DATA, AND GENERAL. THIS SHALL ALSO BE THE ORDER OF PRECEDENCE FOR INSTALLATION OF SYSTEMS. ANY RELOCATION OF SYSTEM ROUTINGS WILL BE FOUND IN THE COORDINATION PHASE AND NOTICED BY EACH OF THE CONTRACTORS. THESE DRAWINGS, WHEN COMPLETED, SHALL BE SIGNED OFF BY ALL OF THE ABOVE LISTED PARTIES. DRAWINGS SHALL BE COMPLETED PRIOR TO FABRICATION AND INSTALLATION OF DUCTWORK AND PIPING SYSTEMS, OR PURCHASE OF EQUIPMENT. THE FOLLOWING ITEMS REPRESENT THE MINIMUM REQUIREMENTS AND COORDINATION DRAWINGS:

- ALL COORDINATION DRAWINGS WILL BE PRODUCED AT 1/4" = 1'-0" SCALE
- COORDINATION DRAWINGS WILL BE DISTRIBUTED ON REPRODUCIBLE MATERIAL 48"x36"
- COORDINATION DRAWINGS ARE NOT SHOP DRAWINGS AND ARE REQUIRED IN ADDITION TO SHOP DRAWINGS.
- ONCE THE COMPLETE COORDINATION DRAWINGS HAVE BEEN COMPILED, THE MECHANICAL CONTRACTOR WILL DISTRIBUTE ONE SIGNED SET TO EACH OF THE FOLLOWING CONTRACTORS: ELECTRICAL, PLUMBING, FIRE PROTECTION, AND GENERAL. ADDITIONAL SETS WILL BE SENT TO THE OWNER, ARCHITECT, AND ENGINEER.

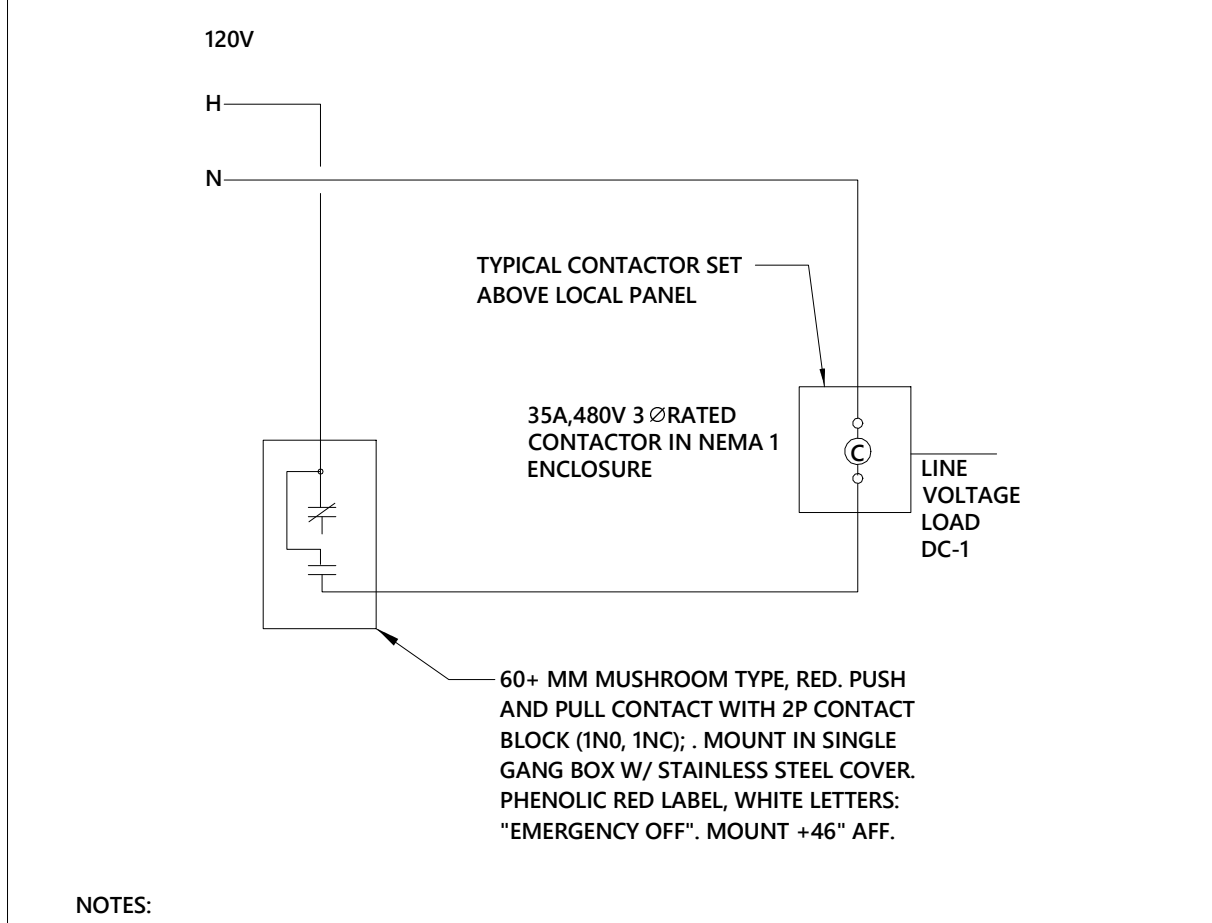

11 EPO WIRING DETAIL - DUST COLLECTOR
NO SCALE

- NOTES:
- CIRCUIT NEAREST RECEPT CIRCUIT FOR CONTROL VOLTAGE OF PUSHBUTTON CONTACTOR. LABEL SCHEDULE: "EMERGENCY CONTACTOR CONTROL VOLTAGE".
 - PROVIDE PROTECTIVE CLEAR COVER OVER PUSHBUTTON.
 - PROVIDE PHENOLIC EMERGENCY LABEL "EMERGENCY SHUTDOWN FOR DUST COLLECTOR POWER".

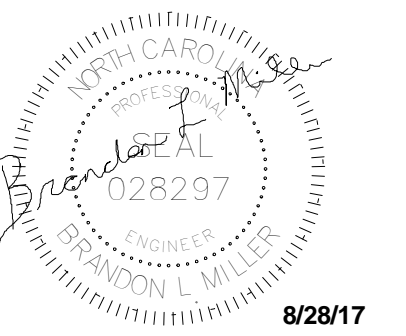









REVISIONS:

No.	Description	Date
1	Addendum #4	8.28.2017


PROJECT: 9202-164730
SCO ID: 16-15656-02B
ITEM: 315 CODE: 41526
DATE: AUGUST 21, 2017
DRAWN BY: J. Holcolmb
CHECKED BY: M. Mazzone

ELECTRICAL DETAILS

E-005

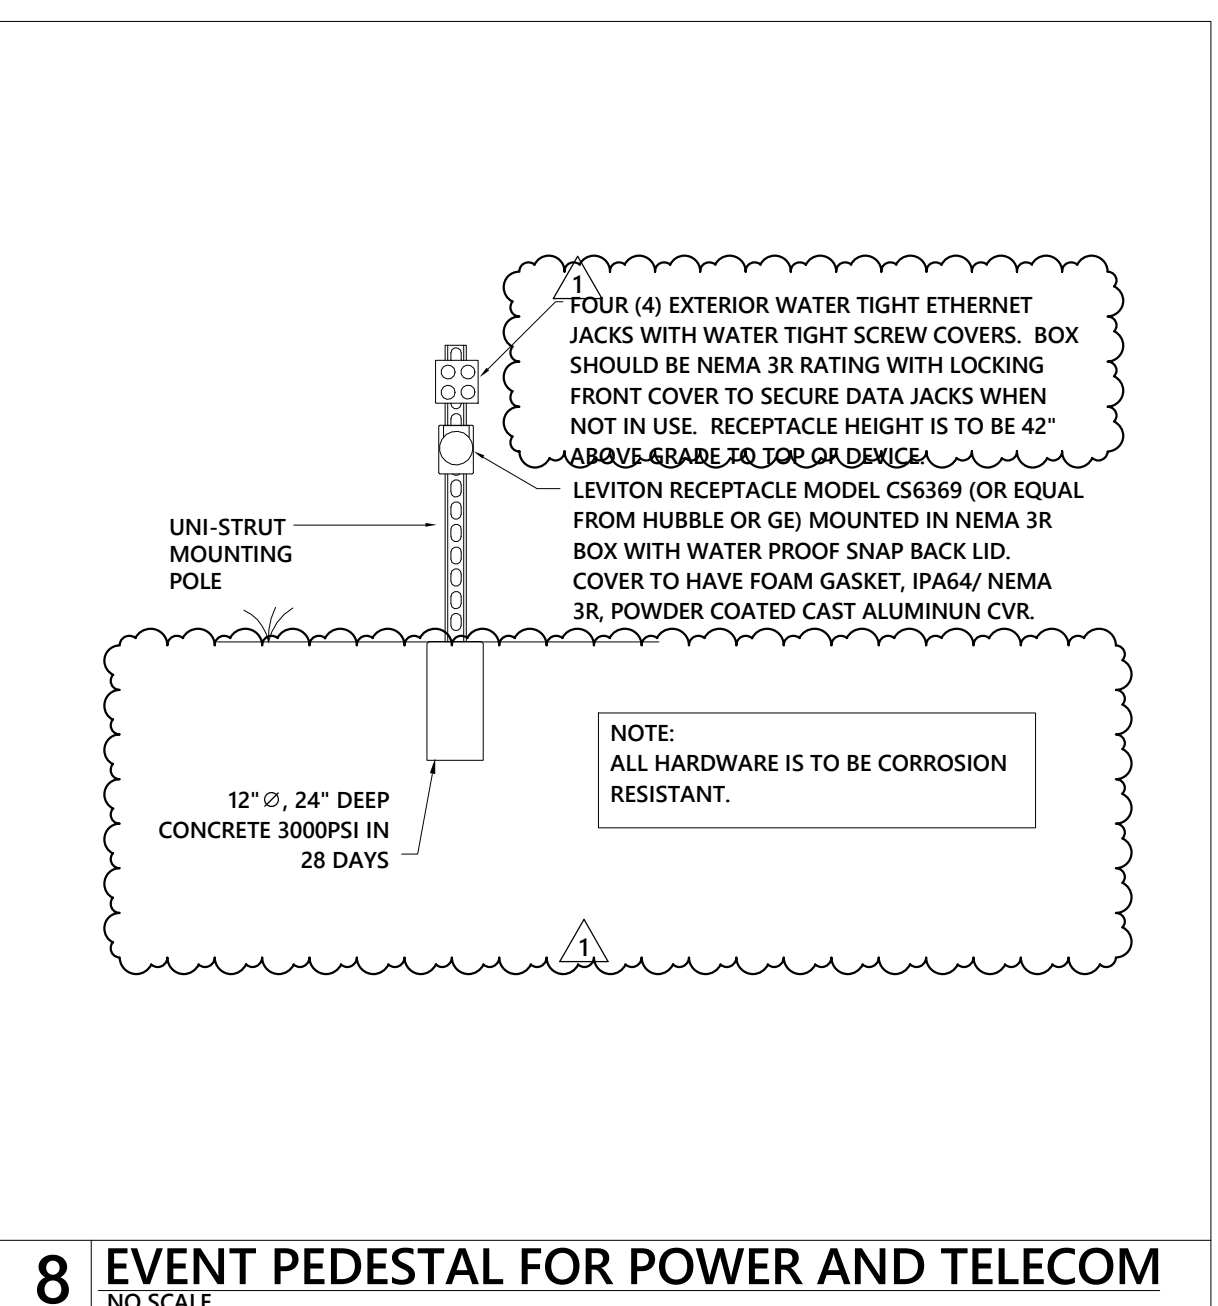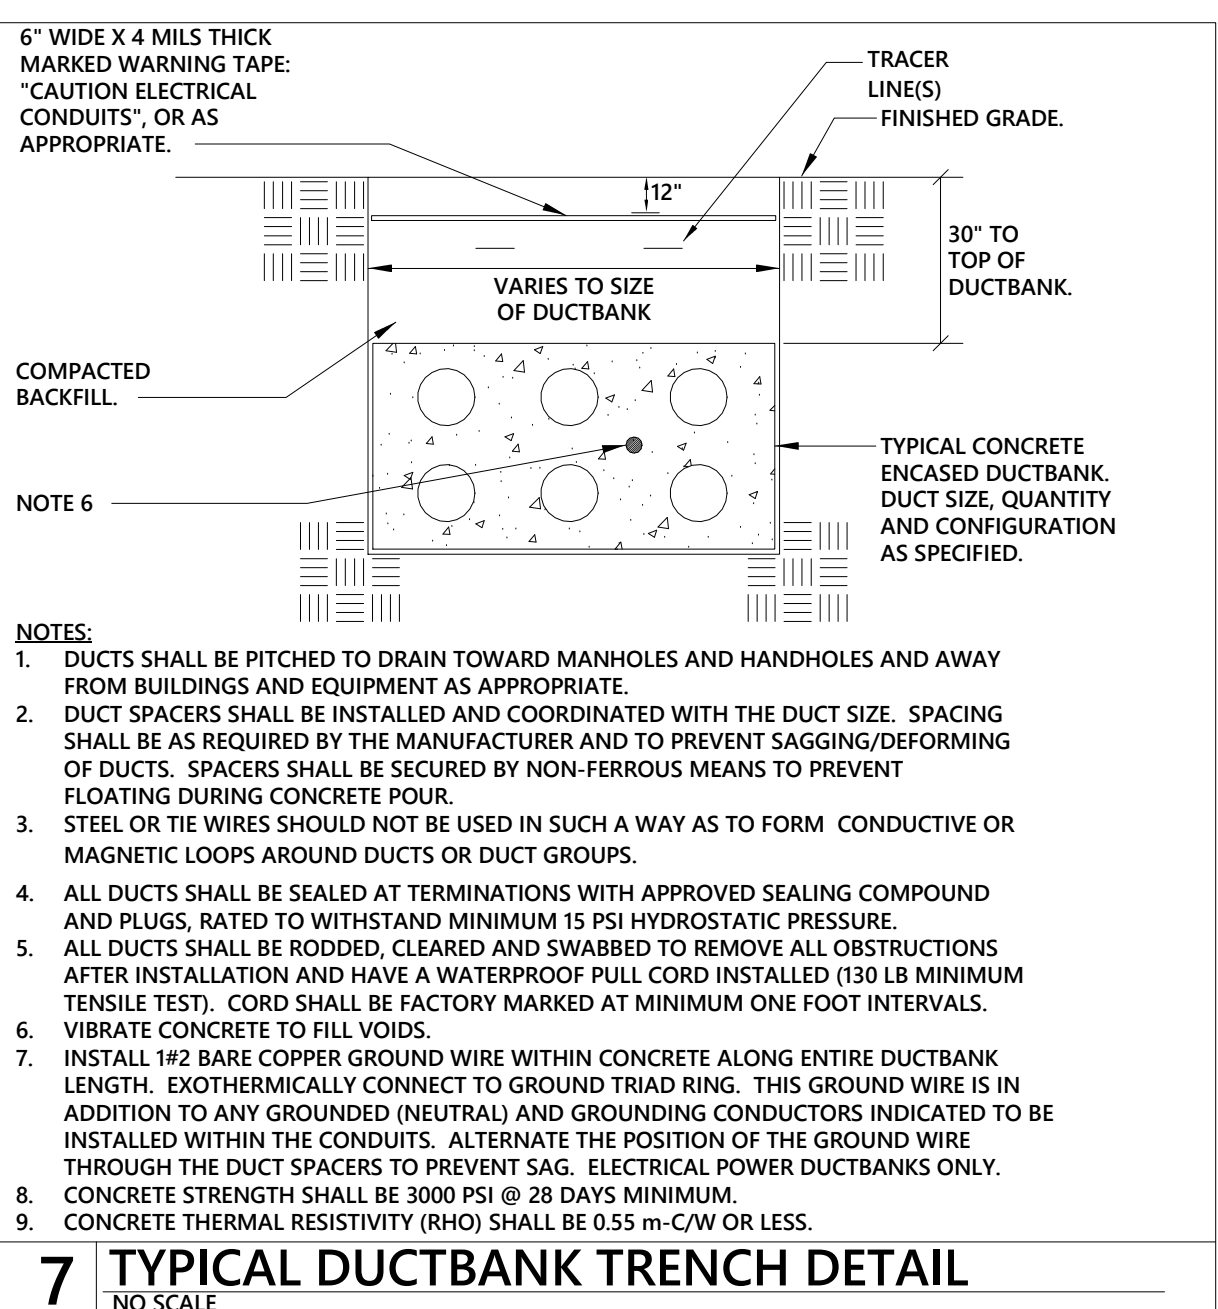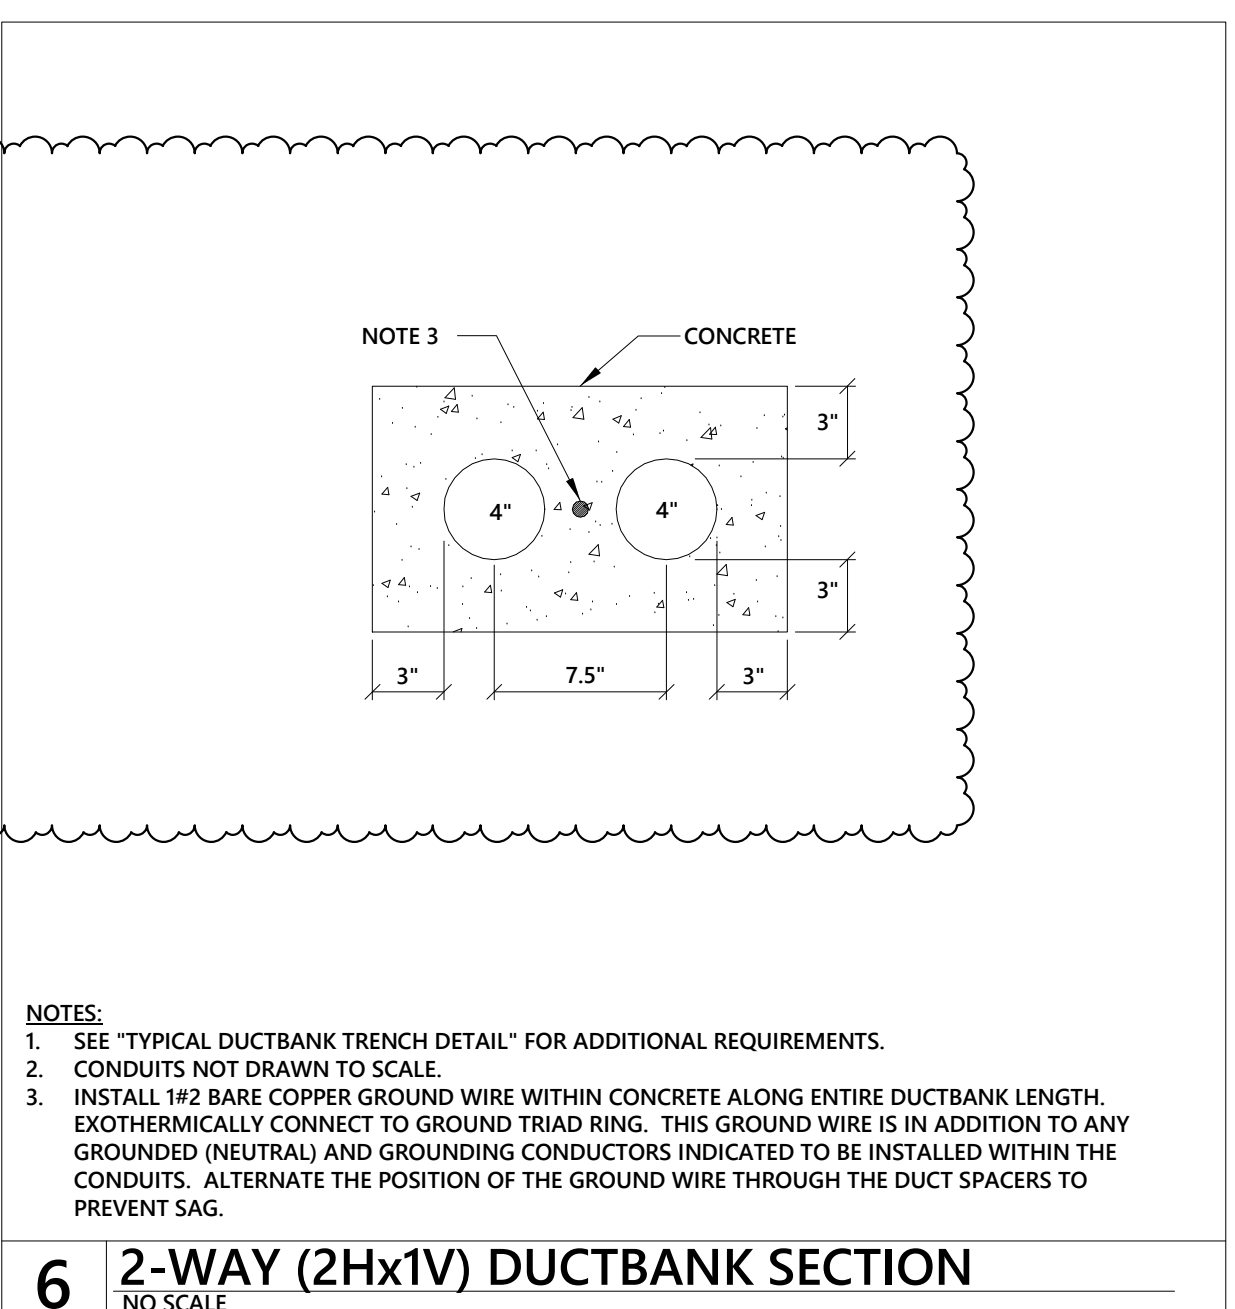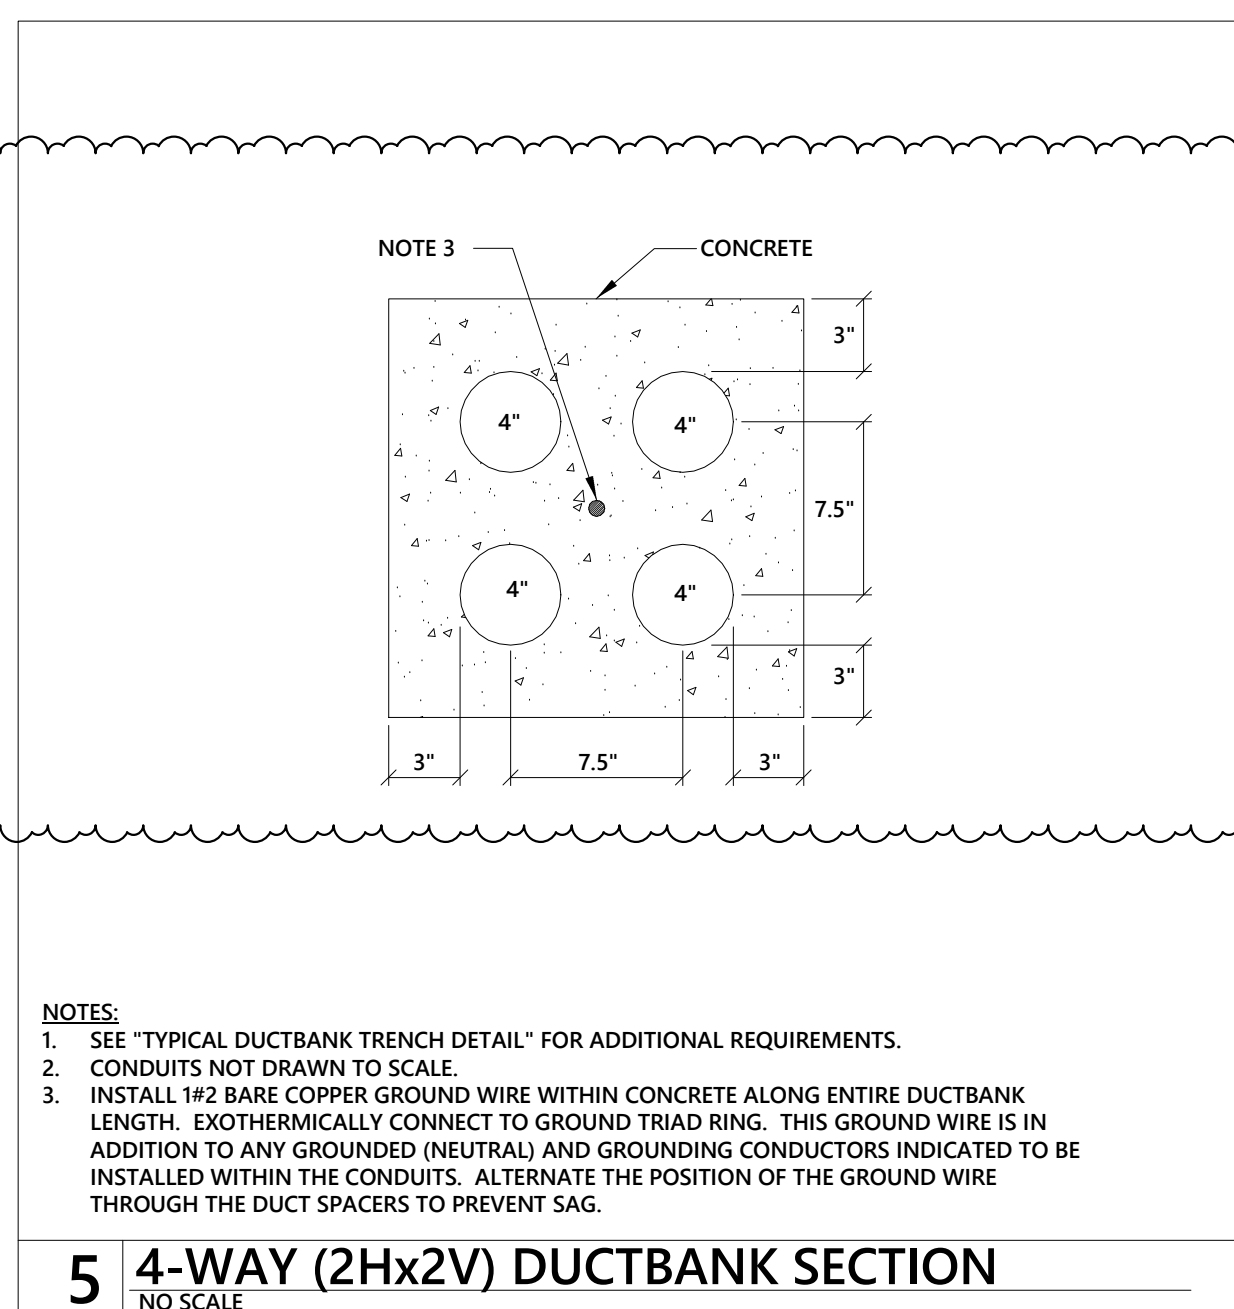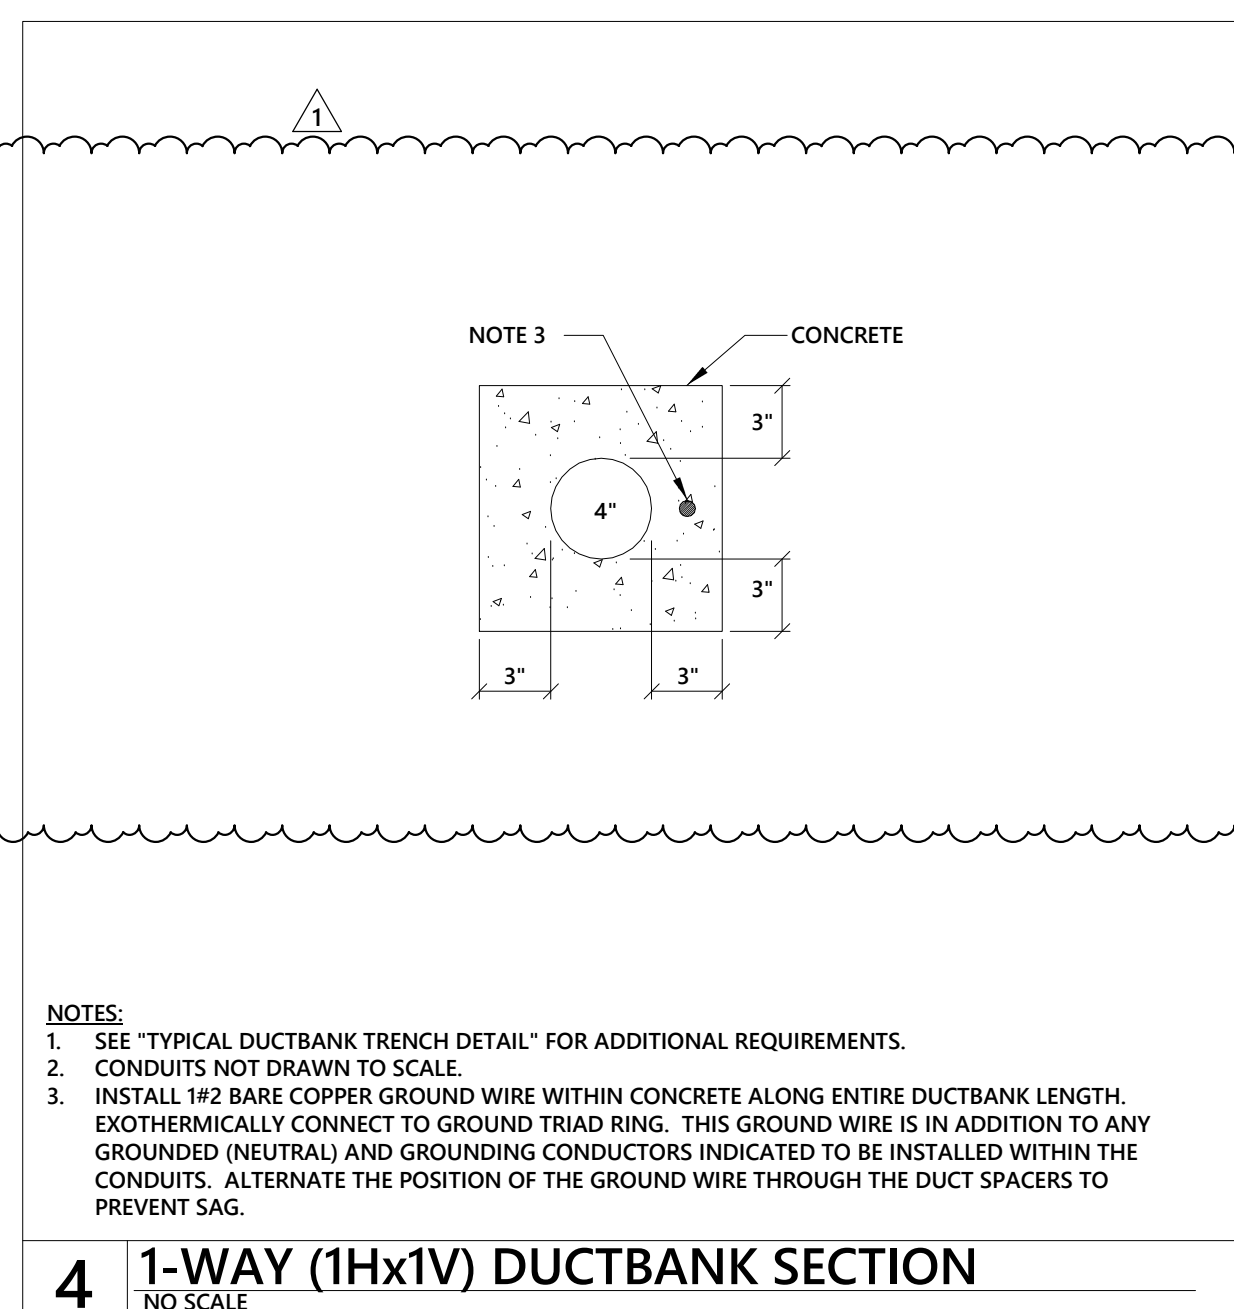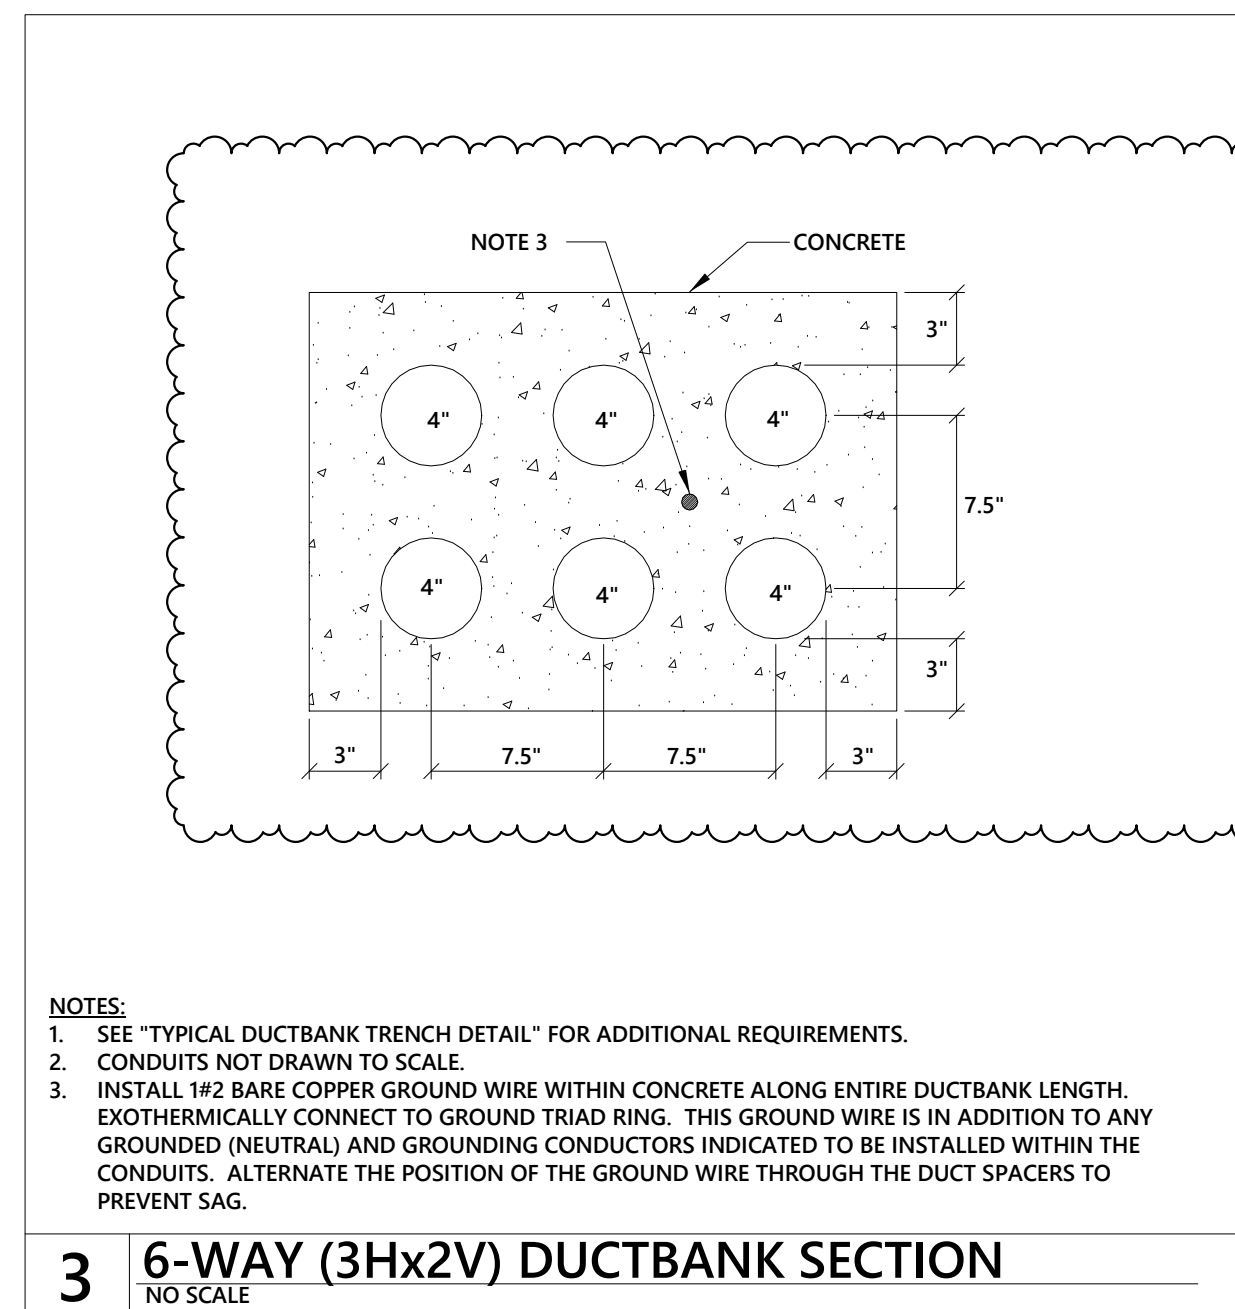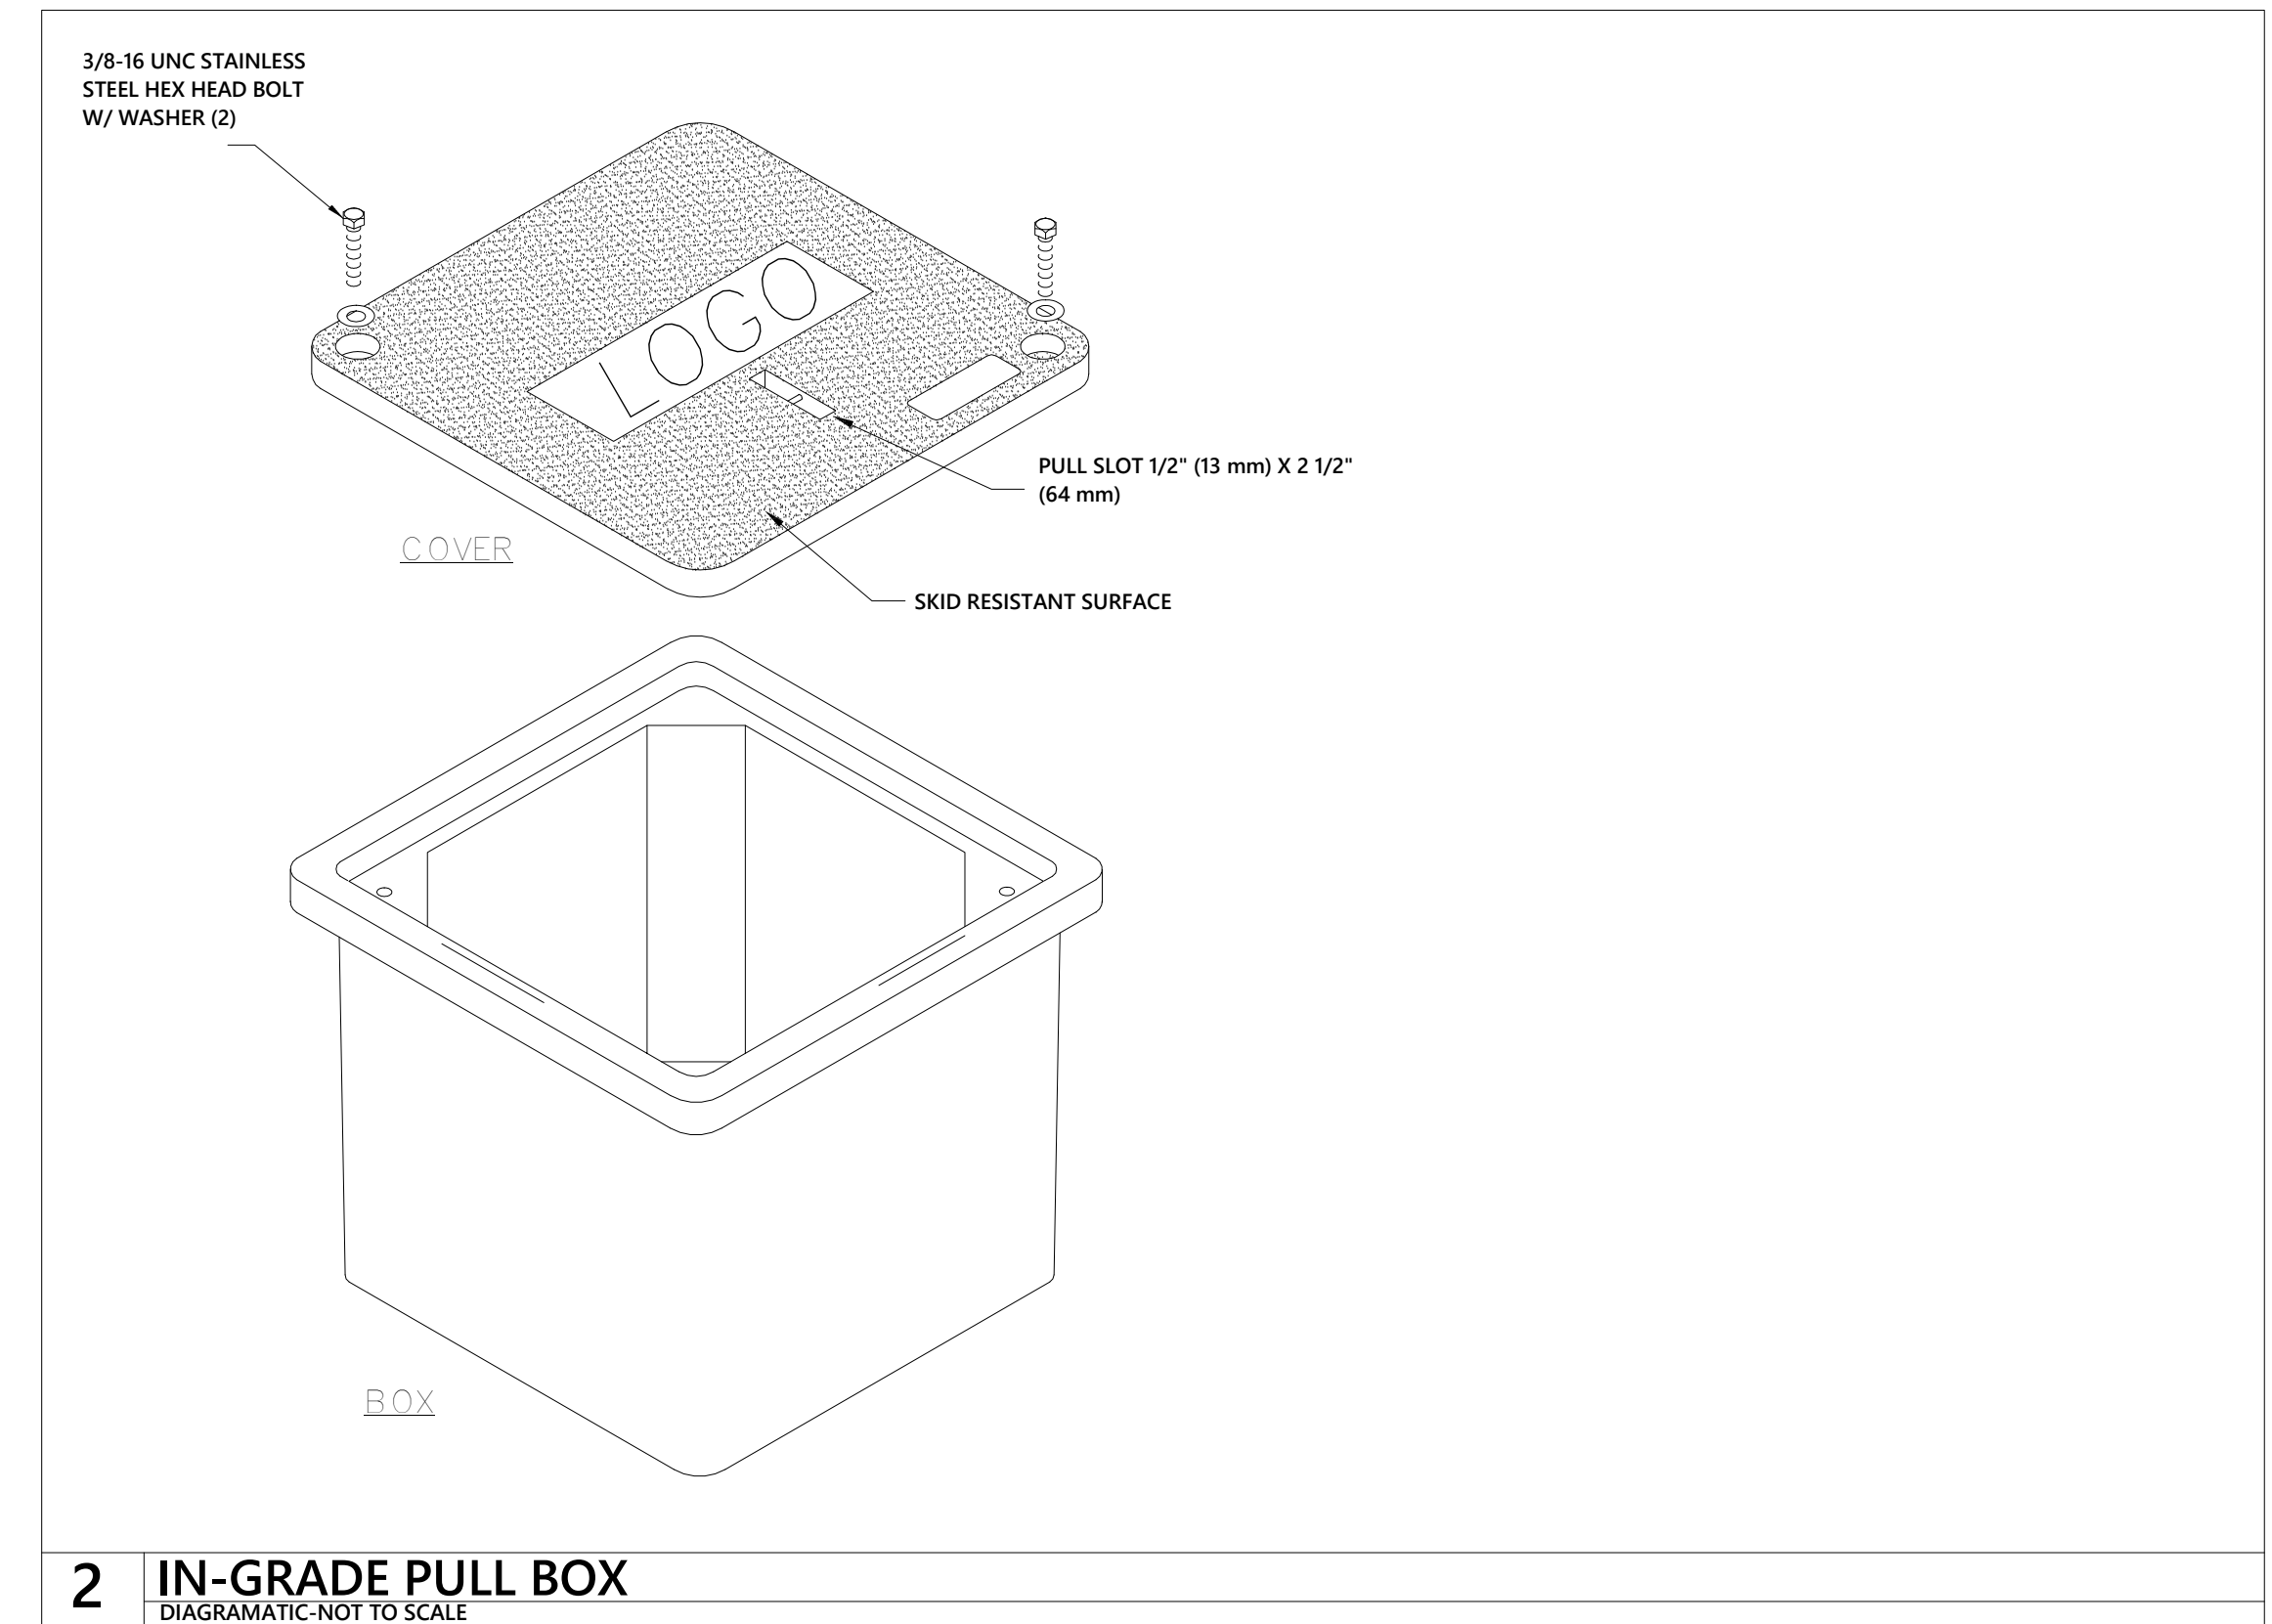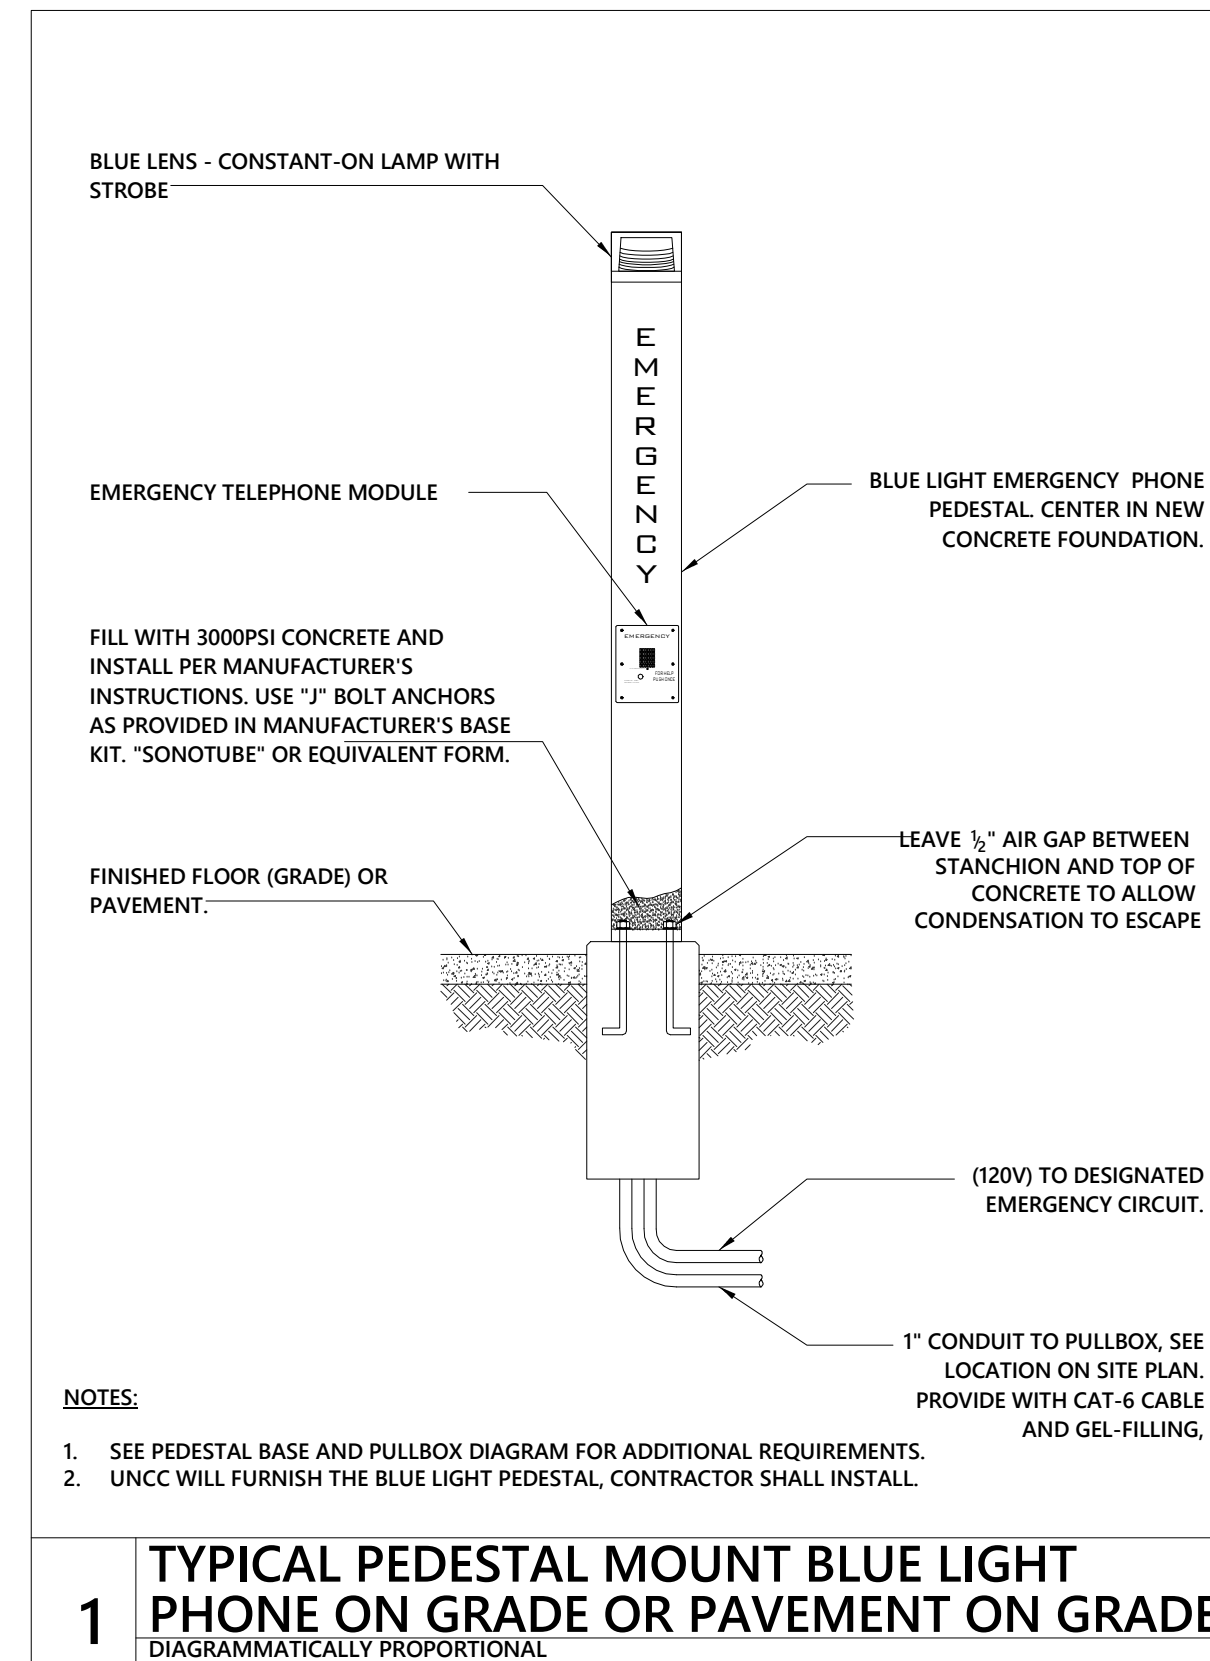

C:\Users\bmiller\Documents\16-0265_R16 MEP_BMiller.rvt
8/29/2017 8:44:19 AM

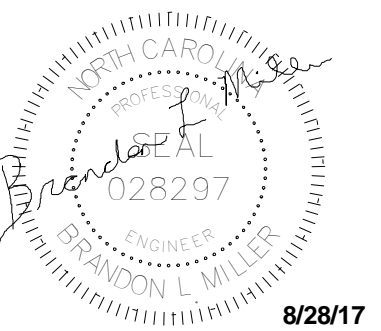

8/28/17

MEMBERS OF THE AMERICAN INSTITUTE OF ARCHITECTS

COPYRIGHT 2016 ALL RIGHTS RESERVED
PRINTED OR ELECTRONIC DRAWINGS AND DOCUMENTATION MAY NOT BE REPRODUCED IN ANY FORM WITHOUT WRITTEN PERMISSION FROM LS3P ASSOCIATES LTD.

REVISIONS:


No.	Description	Date
1	Addendum #4	8.28.2017

PROJECT: 9202-164730
SCO ID: 16-15656-02B
ITEM: 315 CODE: 41526
DATE: AUGUST 21, 2017
DRAWN BY: J. Holcolmb
CHECKED BY: M. Mazzone


ELECTRICAL DETAILS

E-006


OPTIMA #: 16-0265

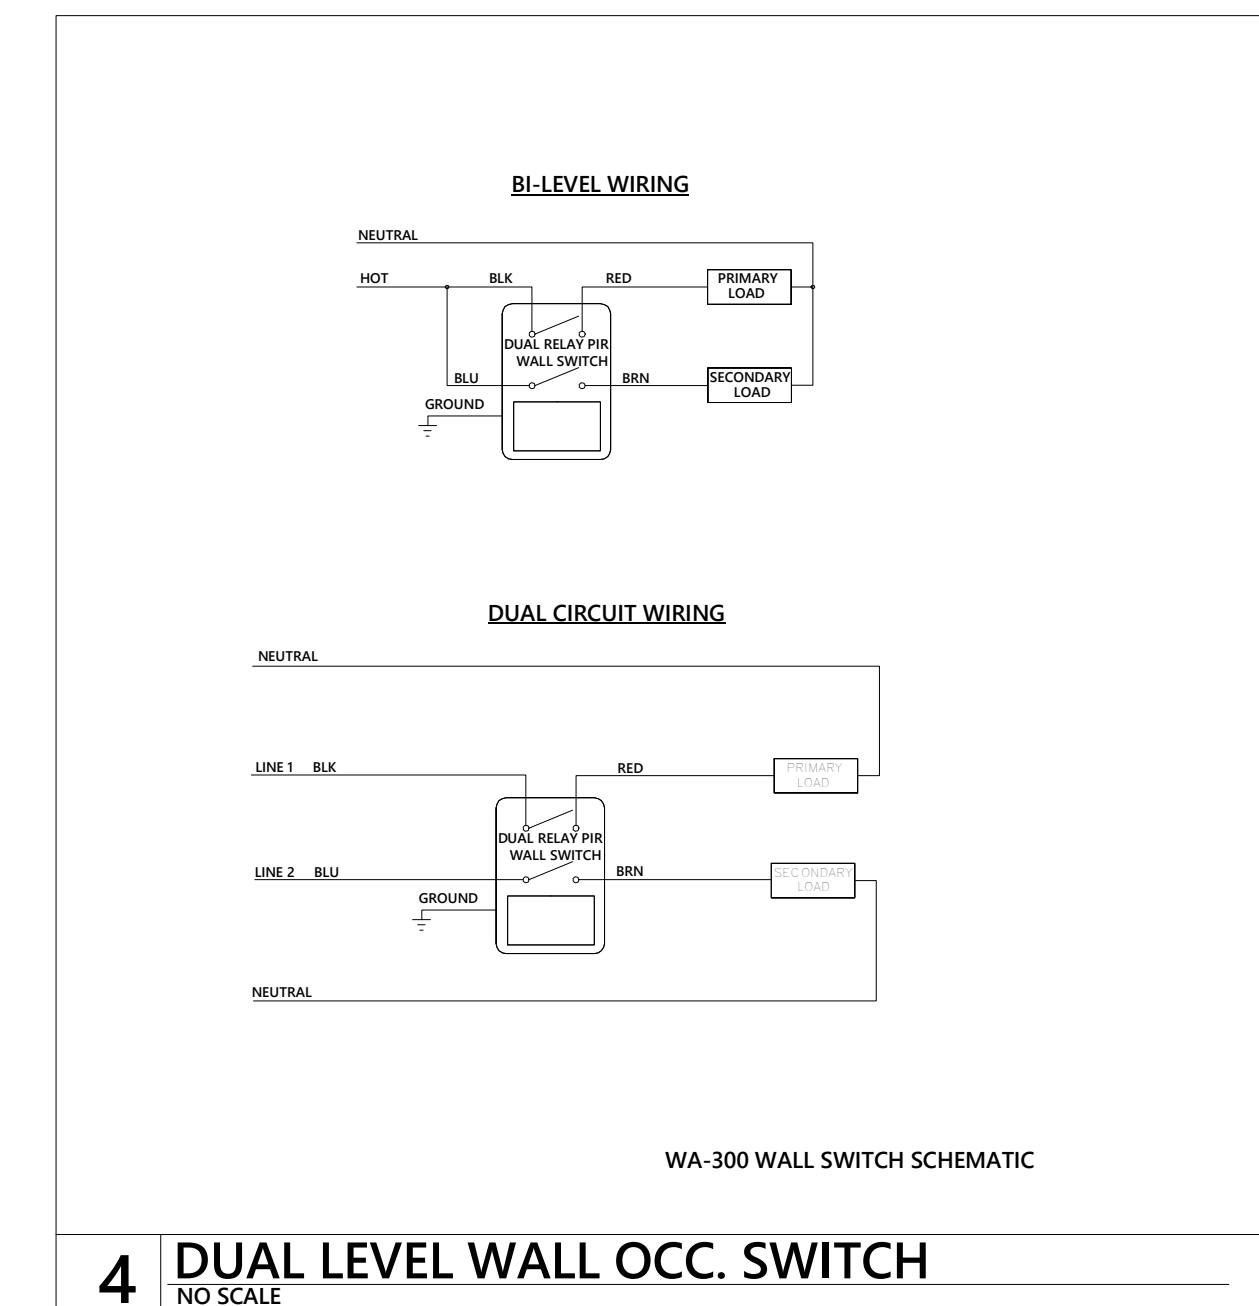


4 DUAL LEVEL WALL OCC. SWITCH
NO SCALE

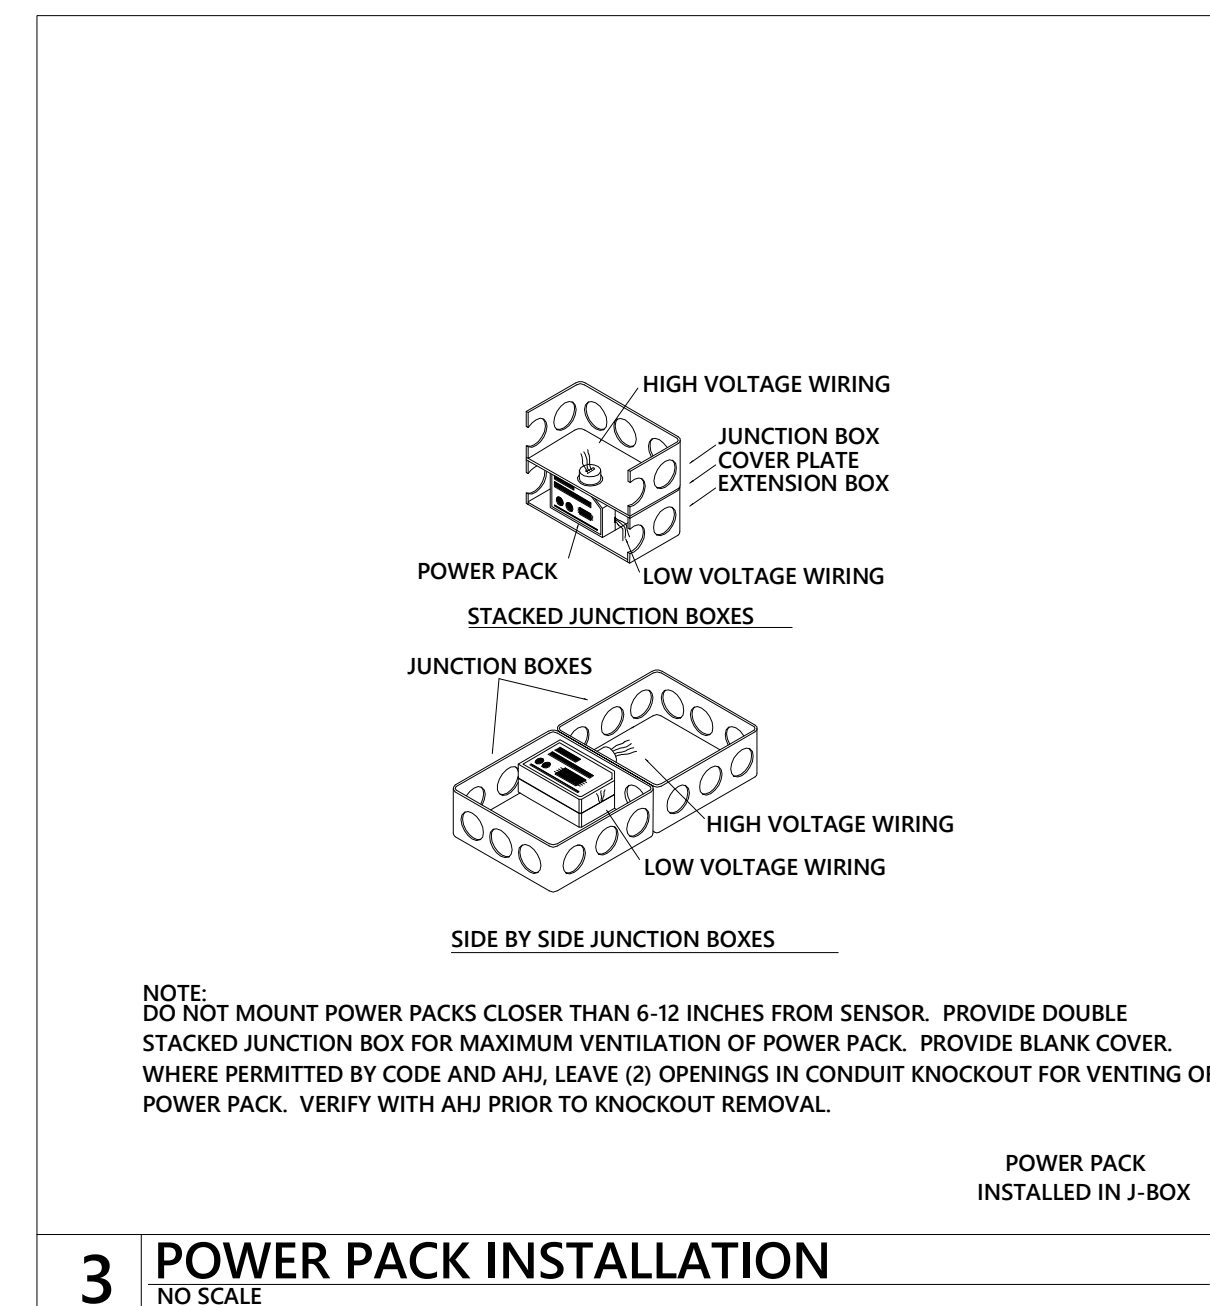


3 POWER PACK INSTALLATION
NO SCALE

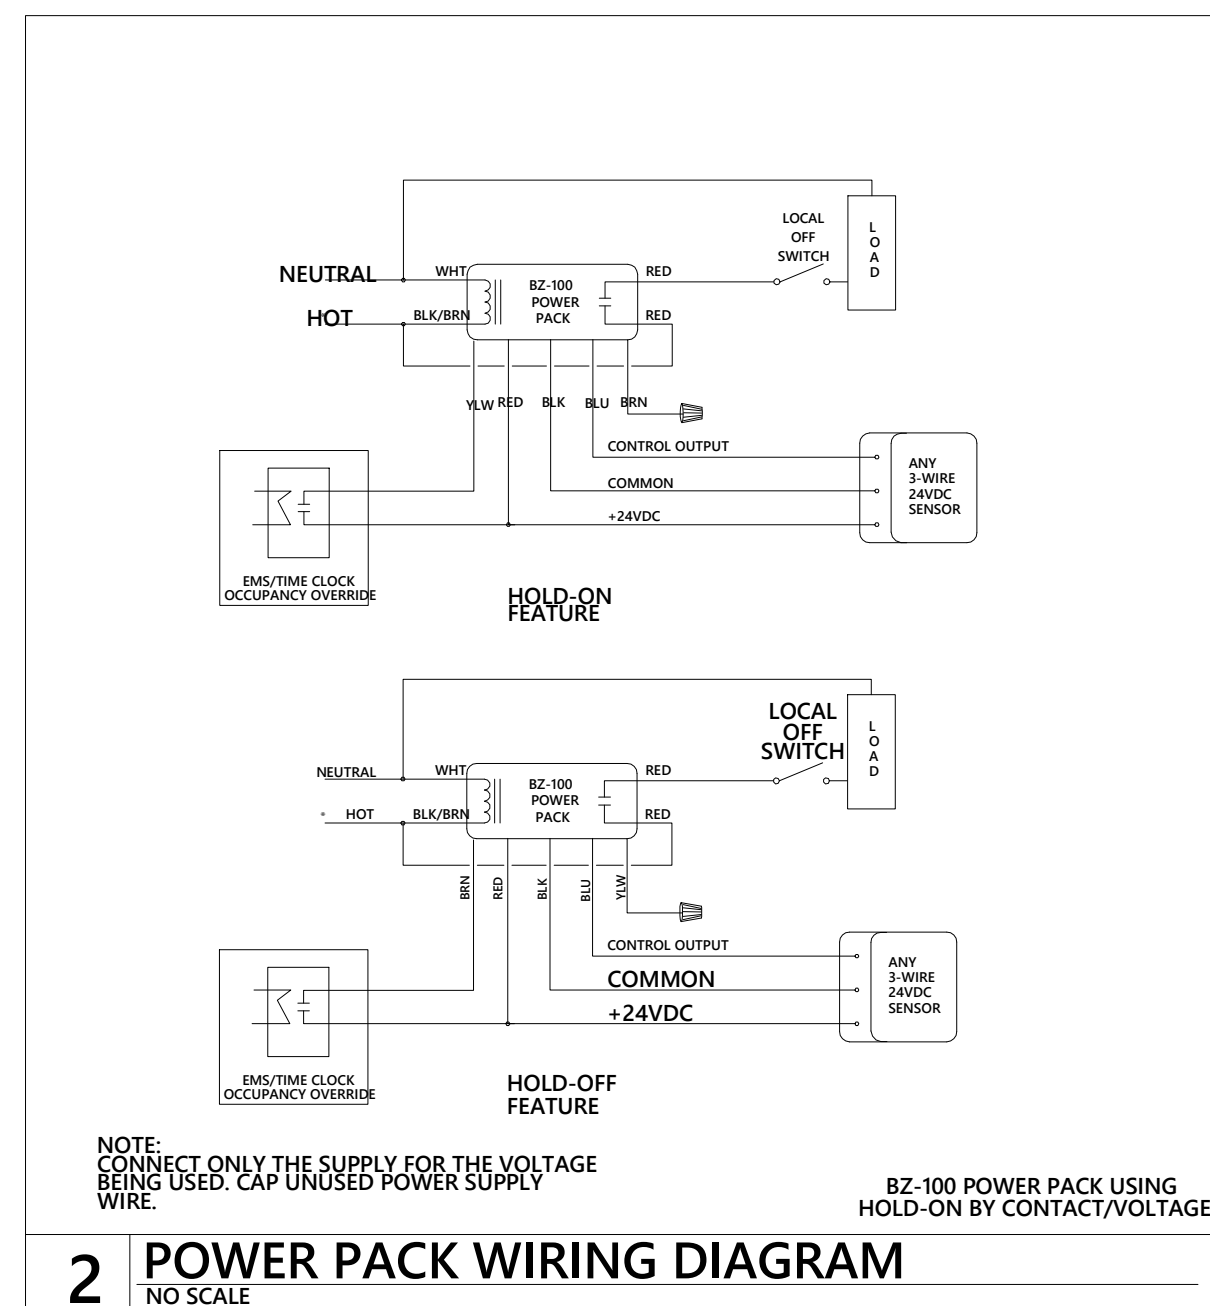


2 POWER PACK WIRING DIAGRAM
NO SCALE

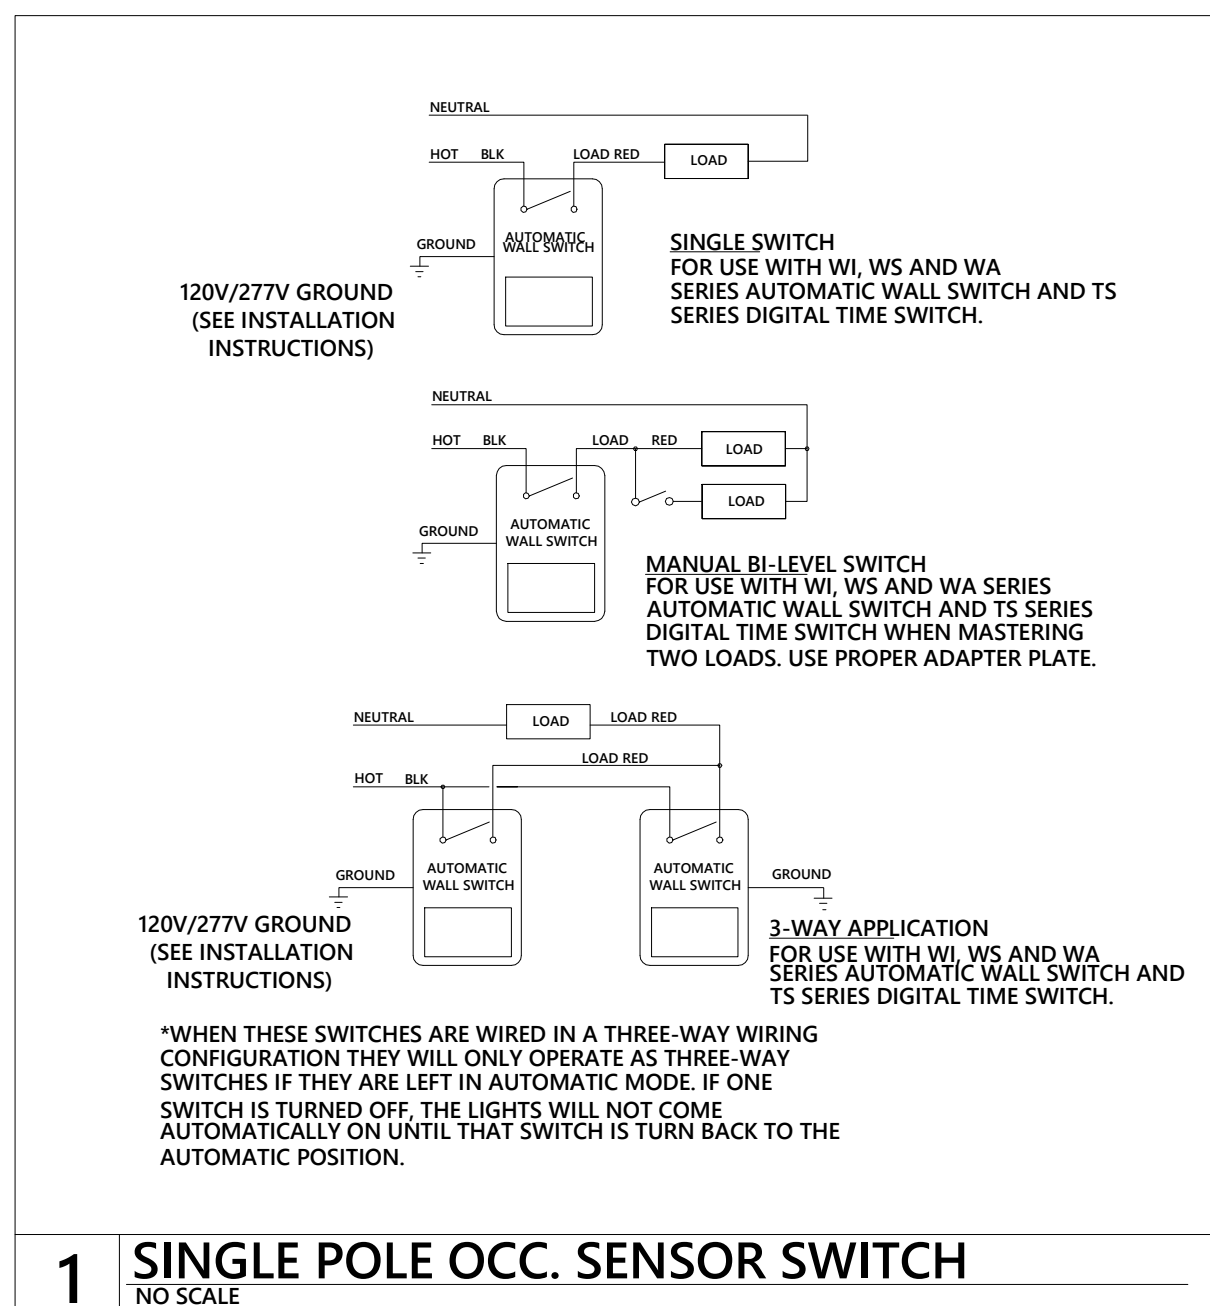


1 SINGLE POLE OCC. SENSOR SWITCH
NO SCALE

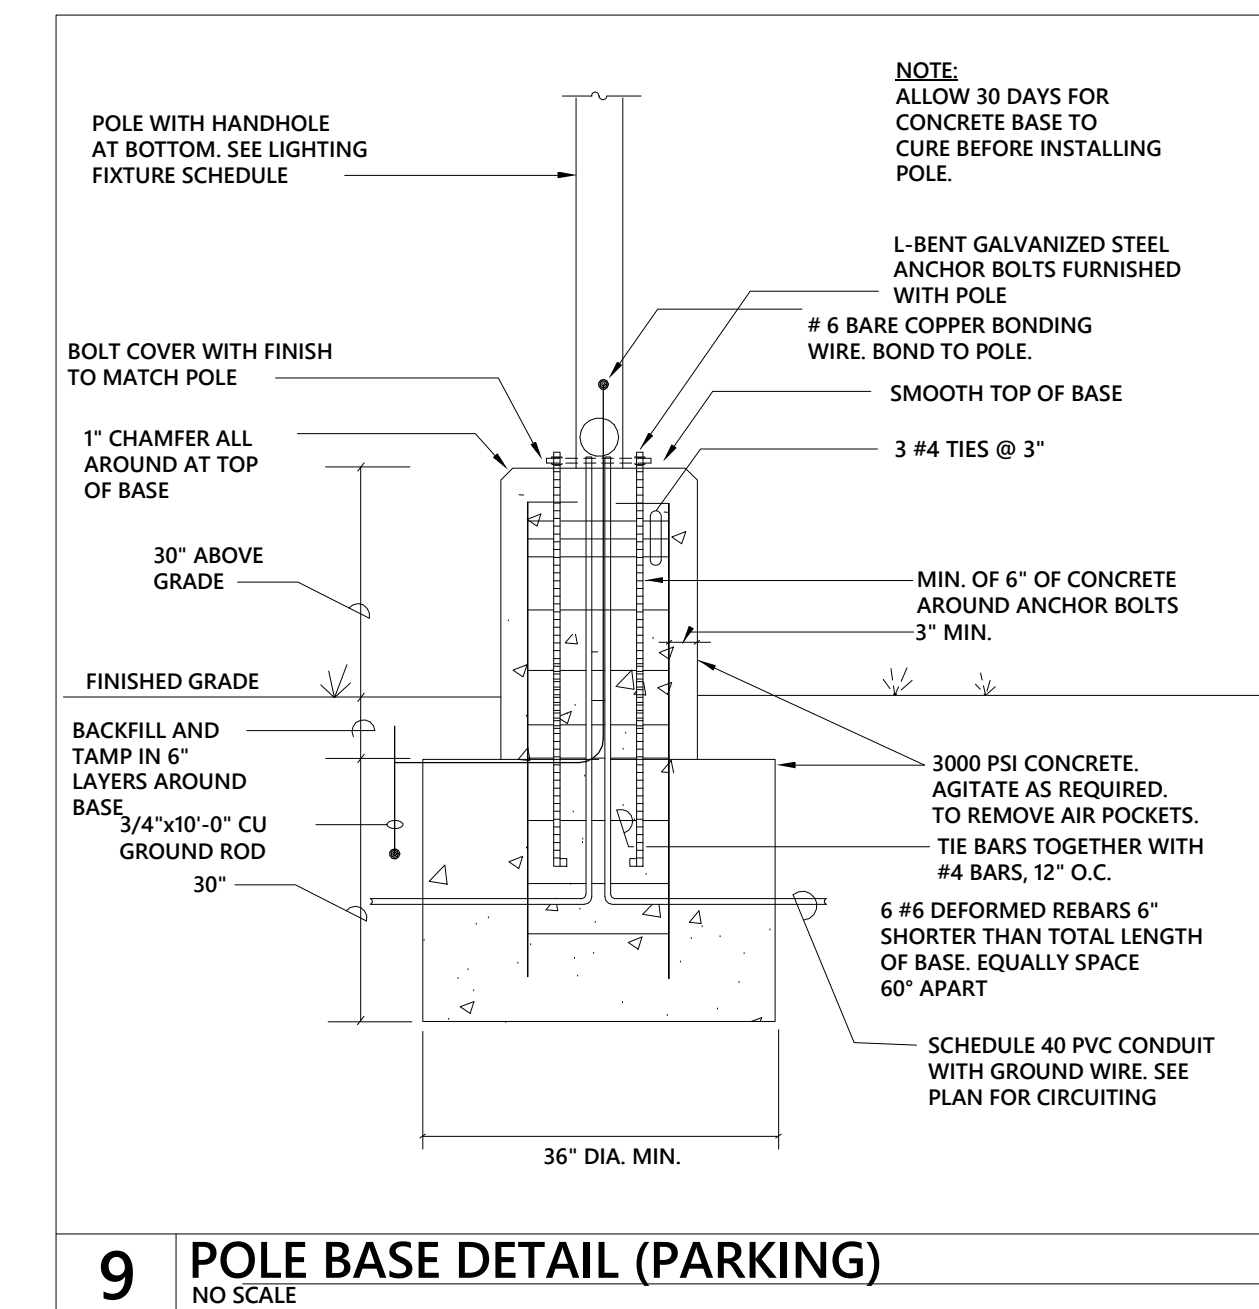


9 POLE BASE DETAIL (PARKING)
NO SCALE

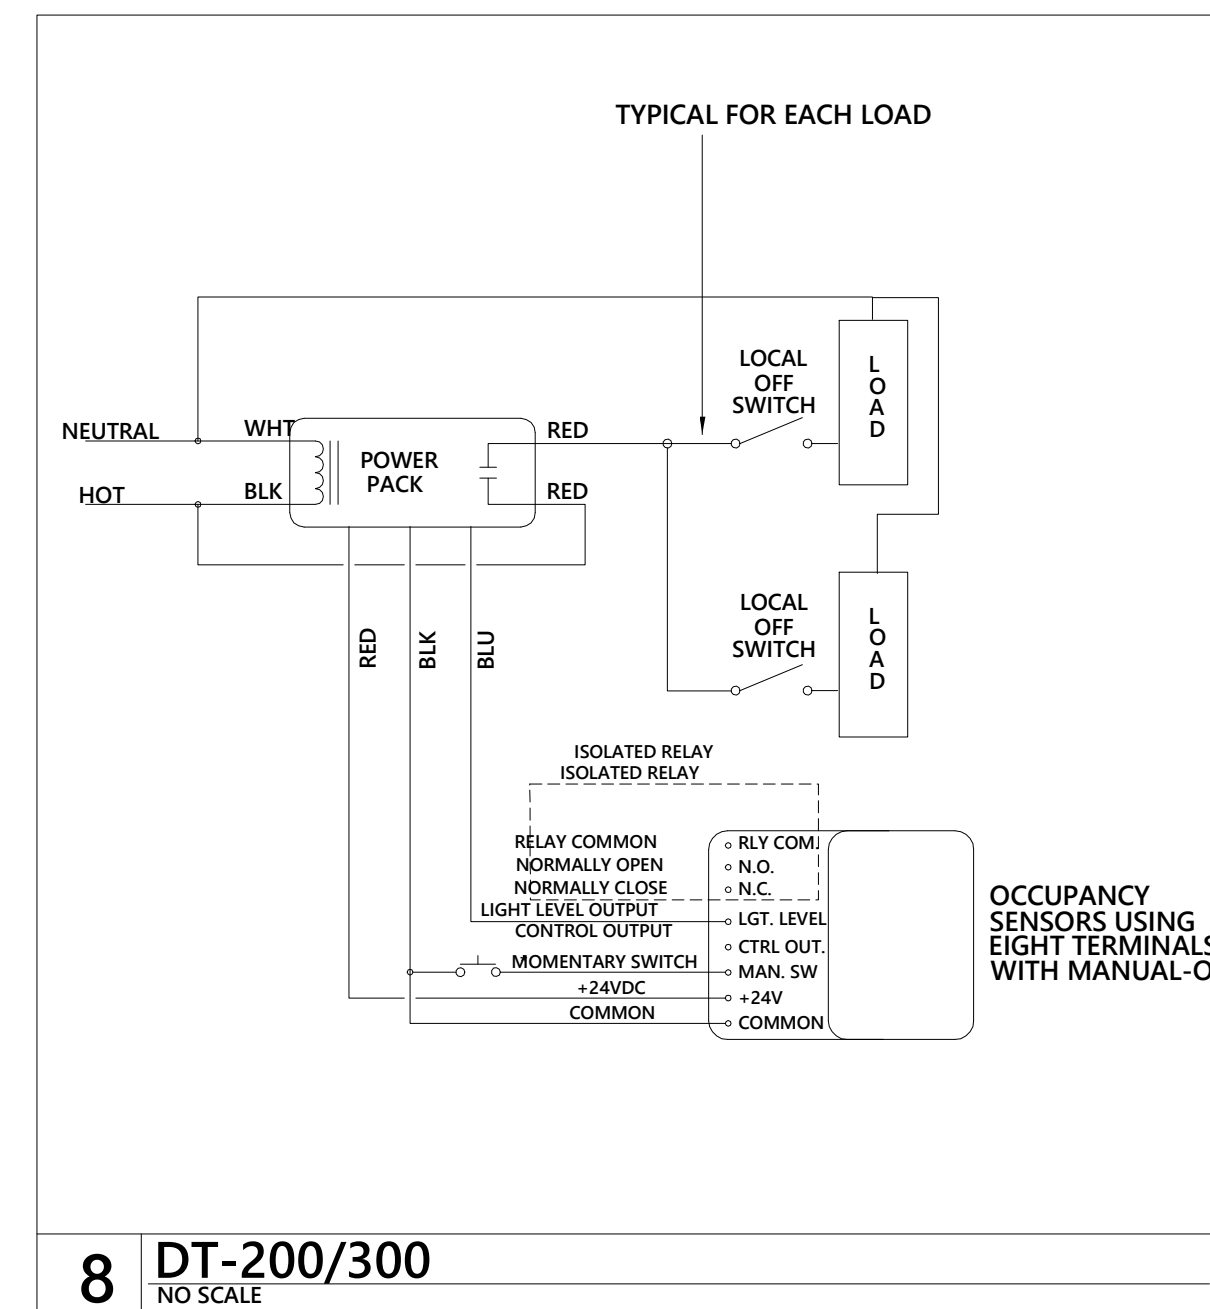


8 DT-200/300
NO SCALE

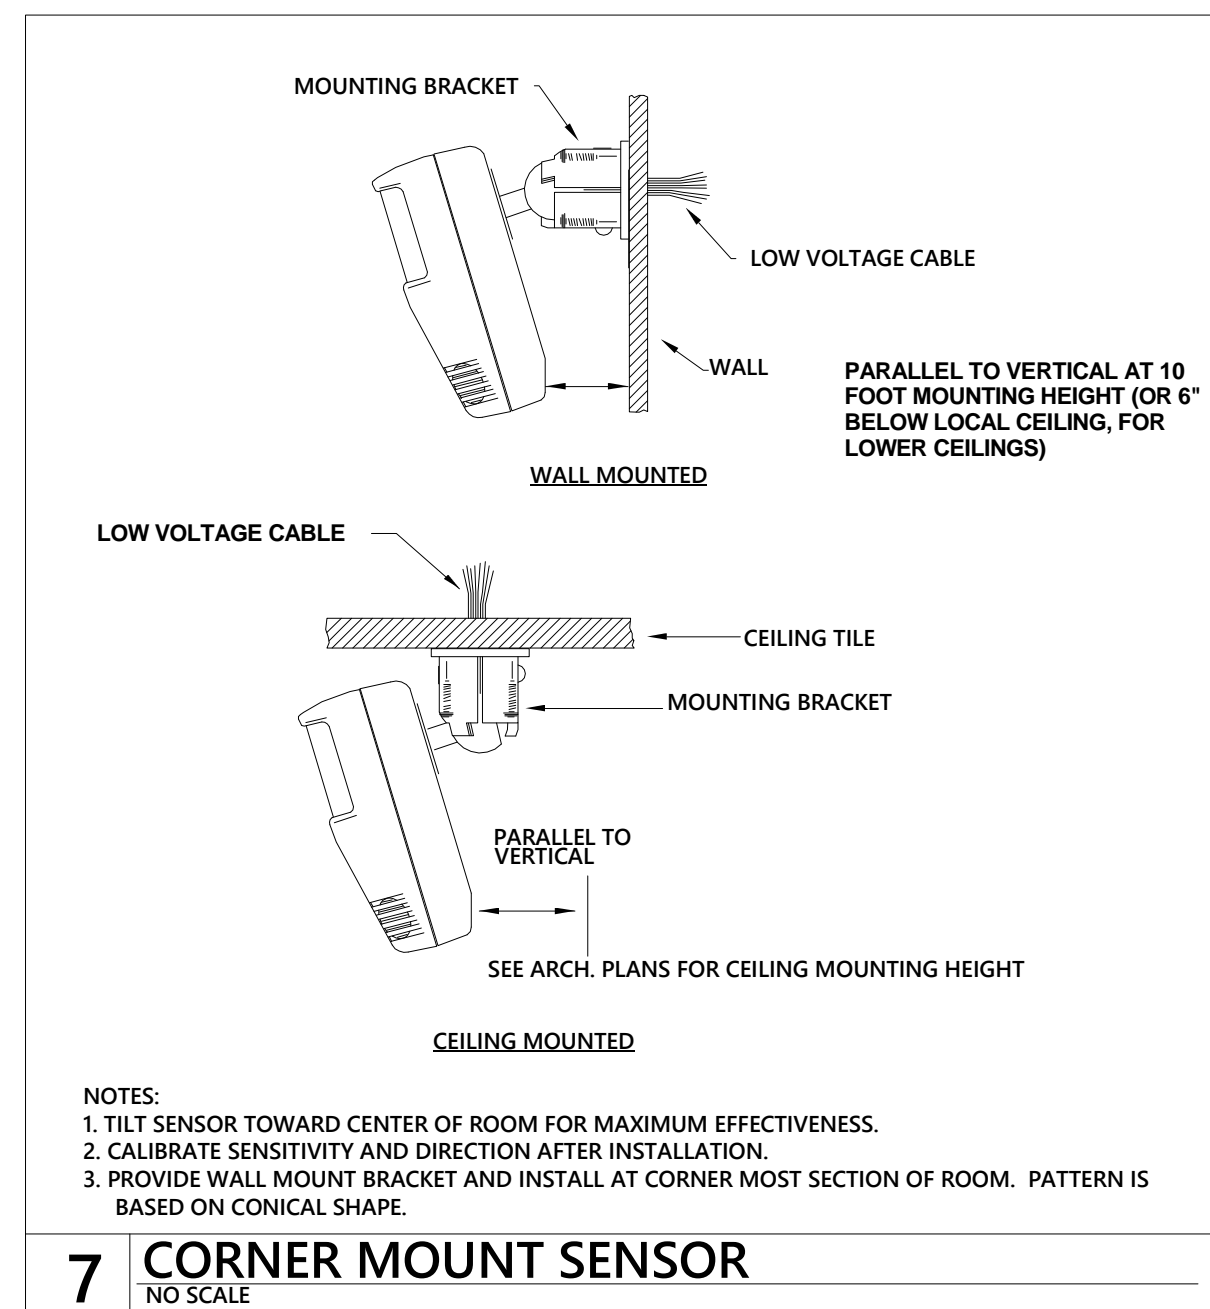


7 CORNER MOUNT SENSOR
NO SCALE

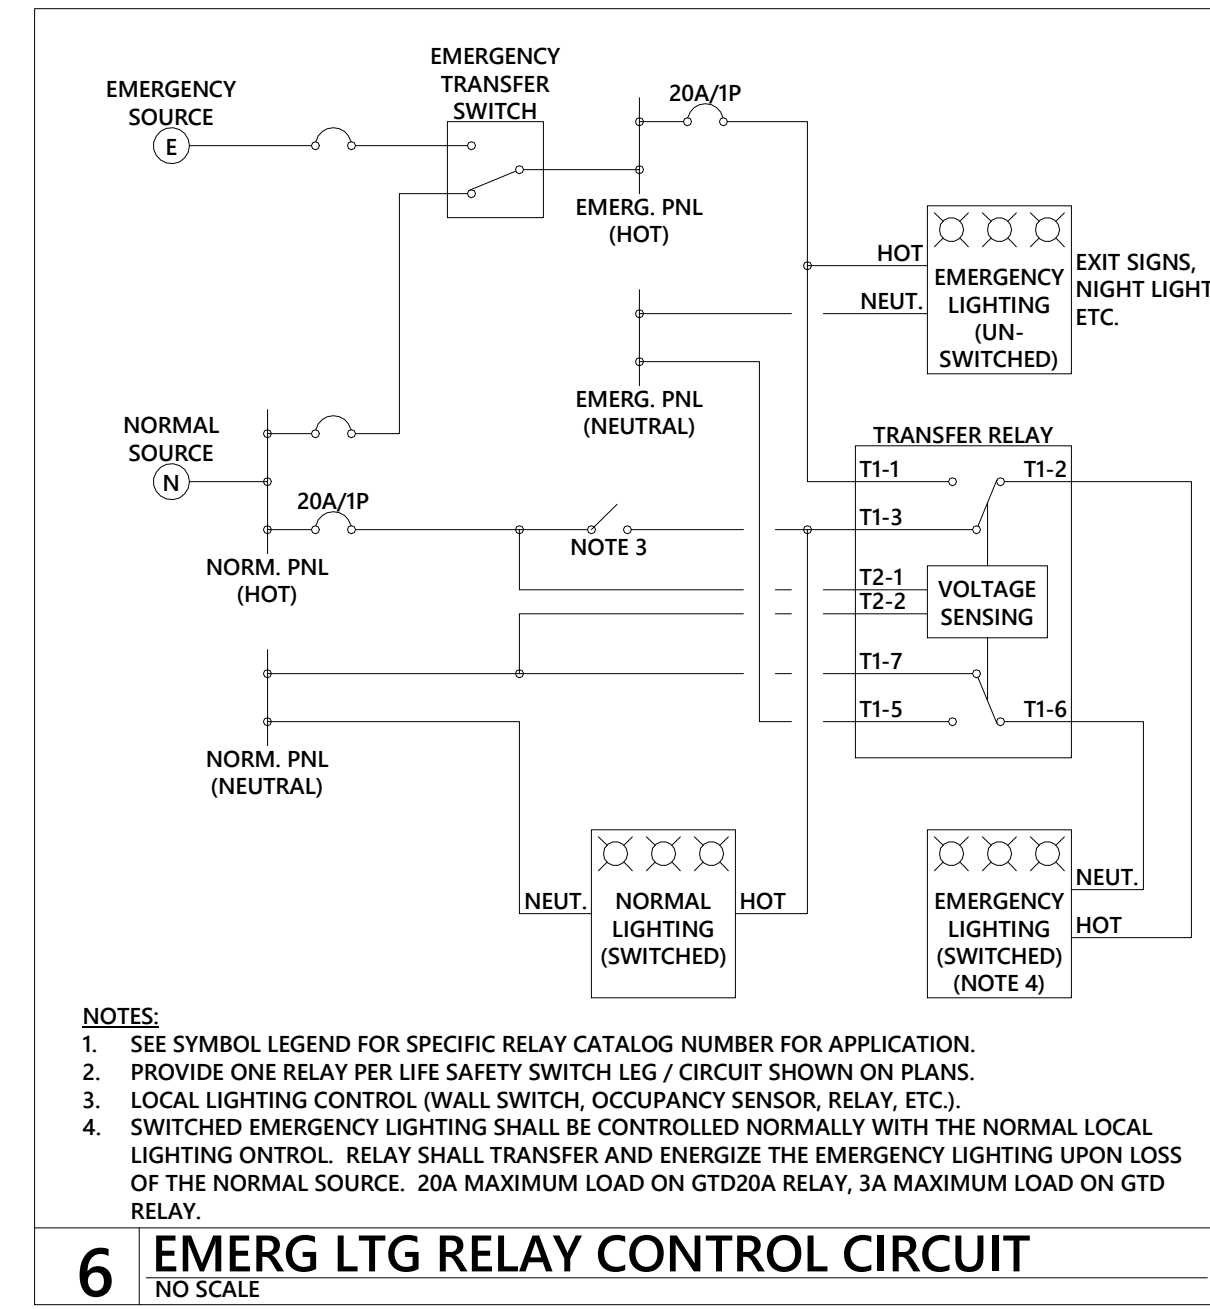


6 EMERG LGT RELAY CONTROL CIRCUIT
NO SCALE

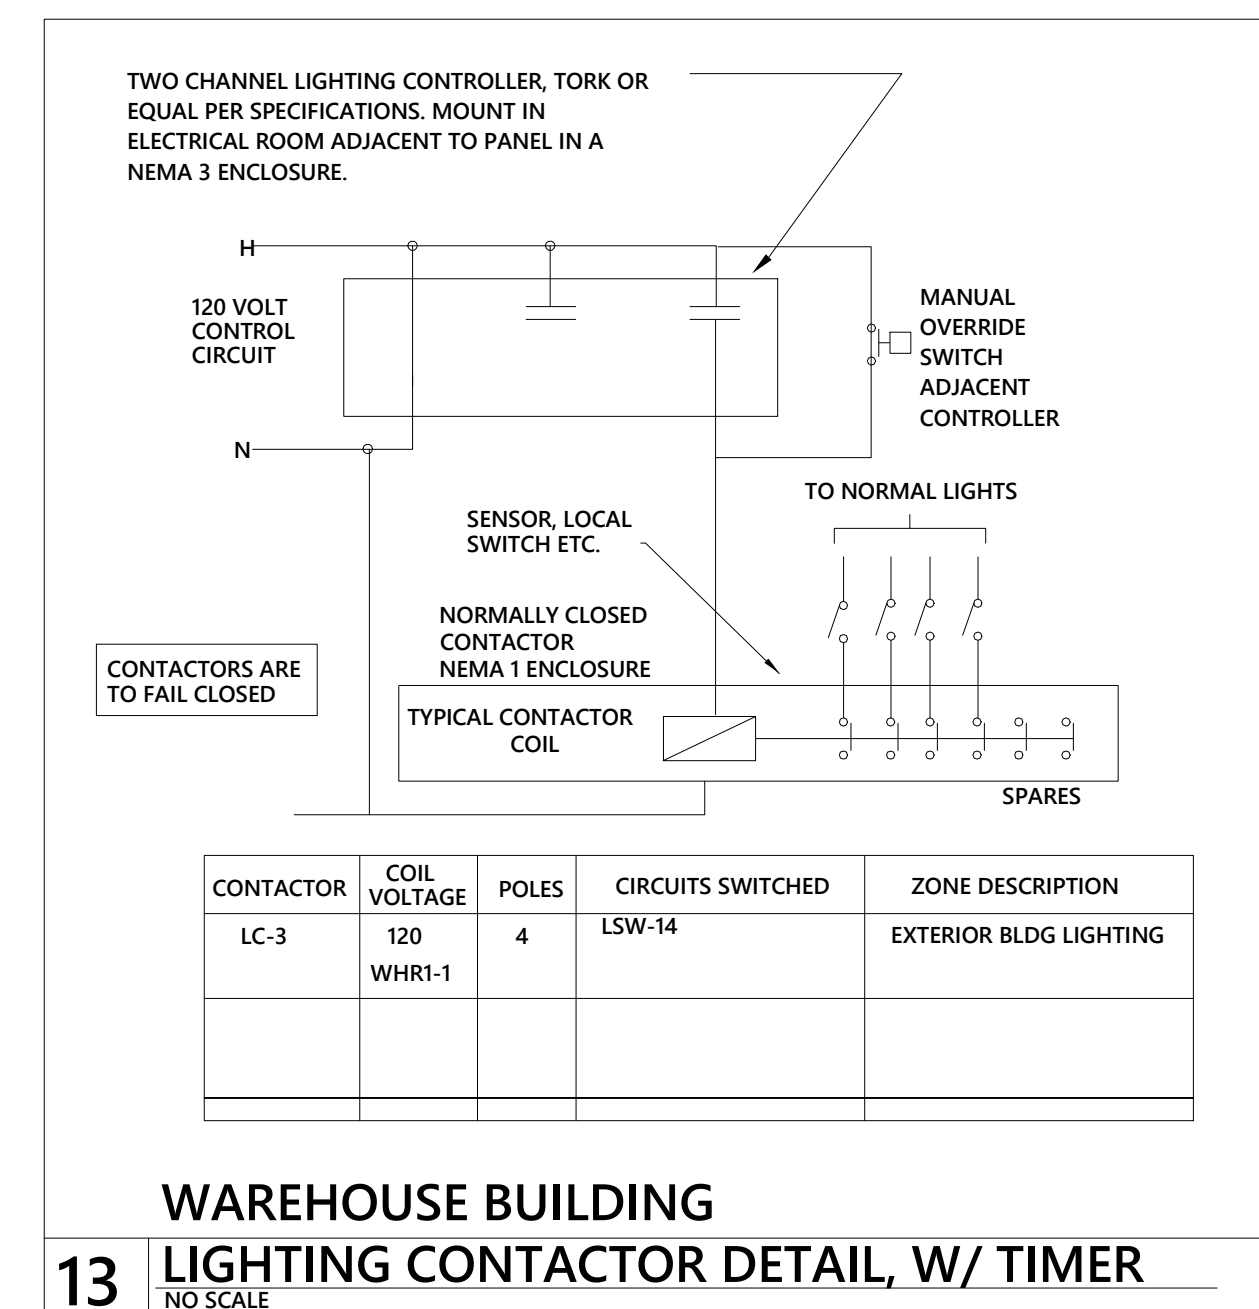


13 LIGHTING CONTACTOR DETAIL, W/ TIMER
NO SCALE

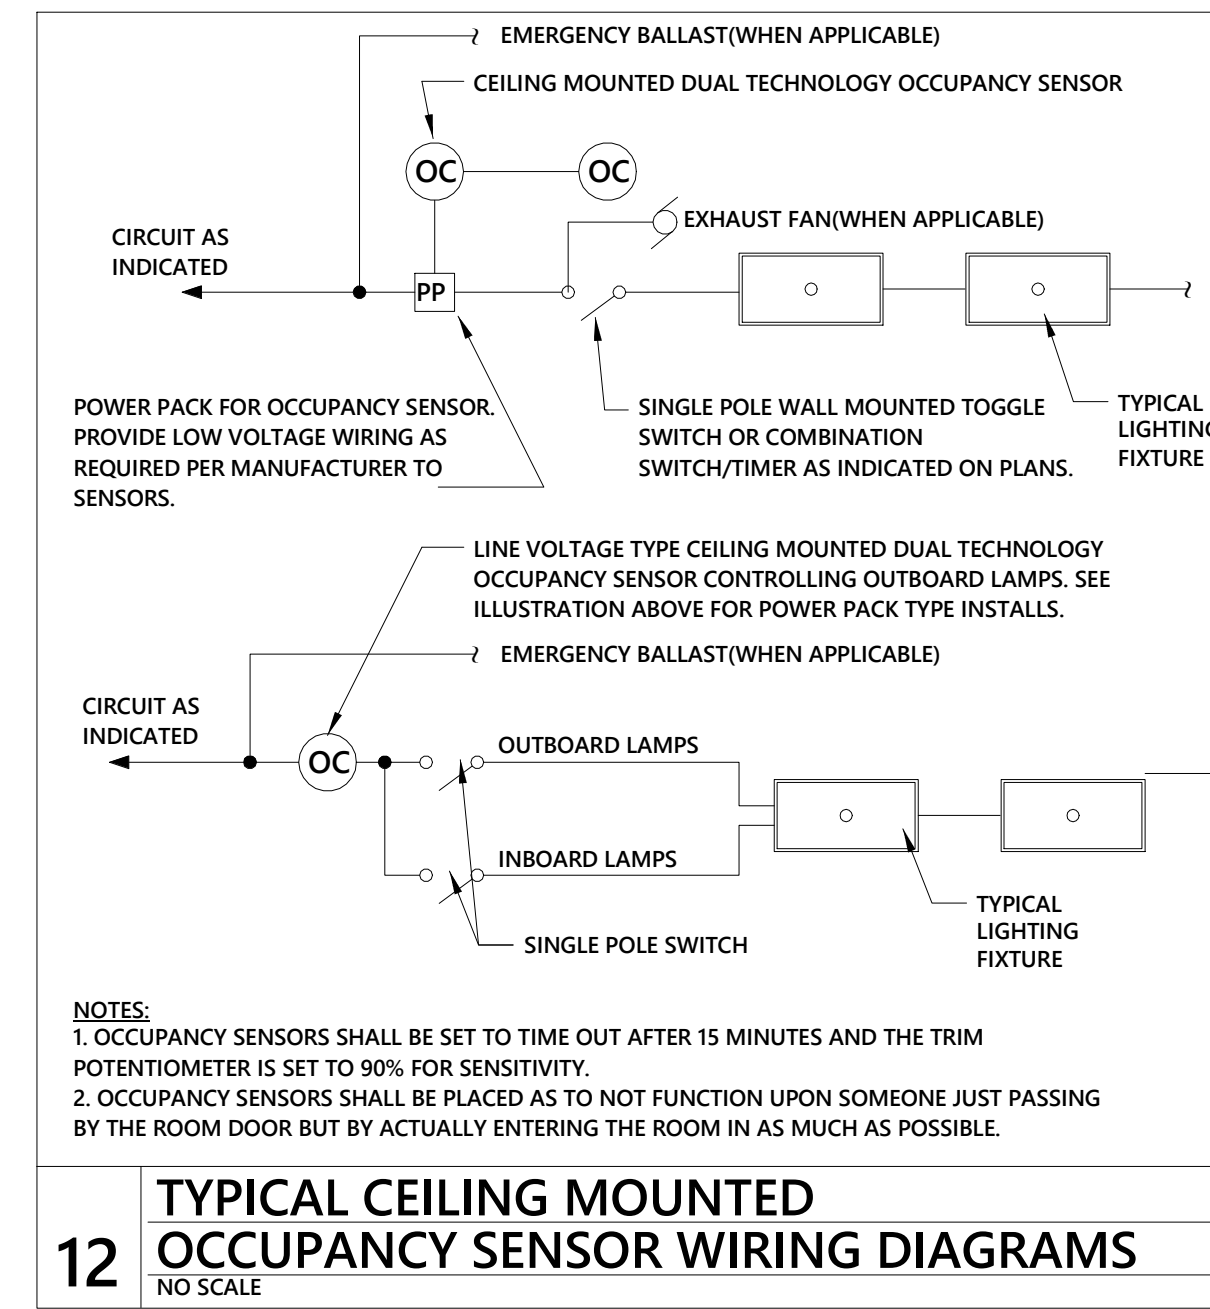


12 TYPICAL CEILING MOUNTED OCCUPANCY SENSOR WIRING DIAGRAMS
NO SCALE

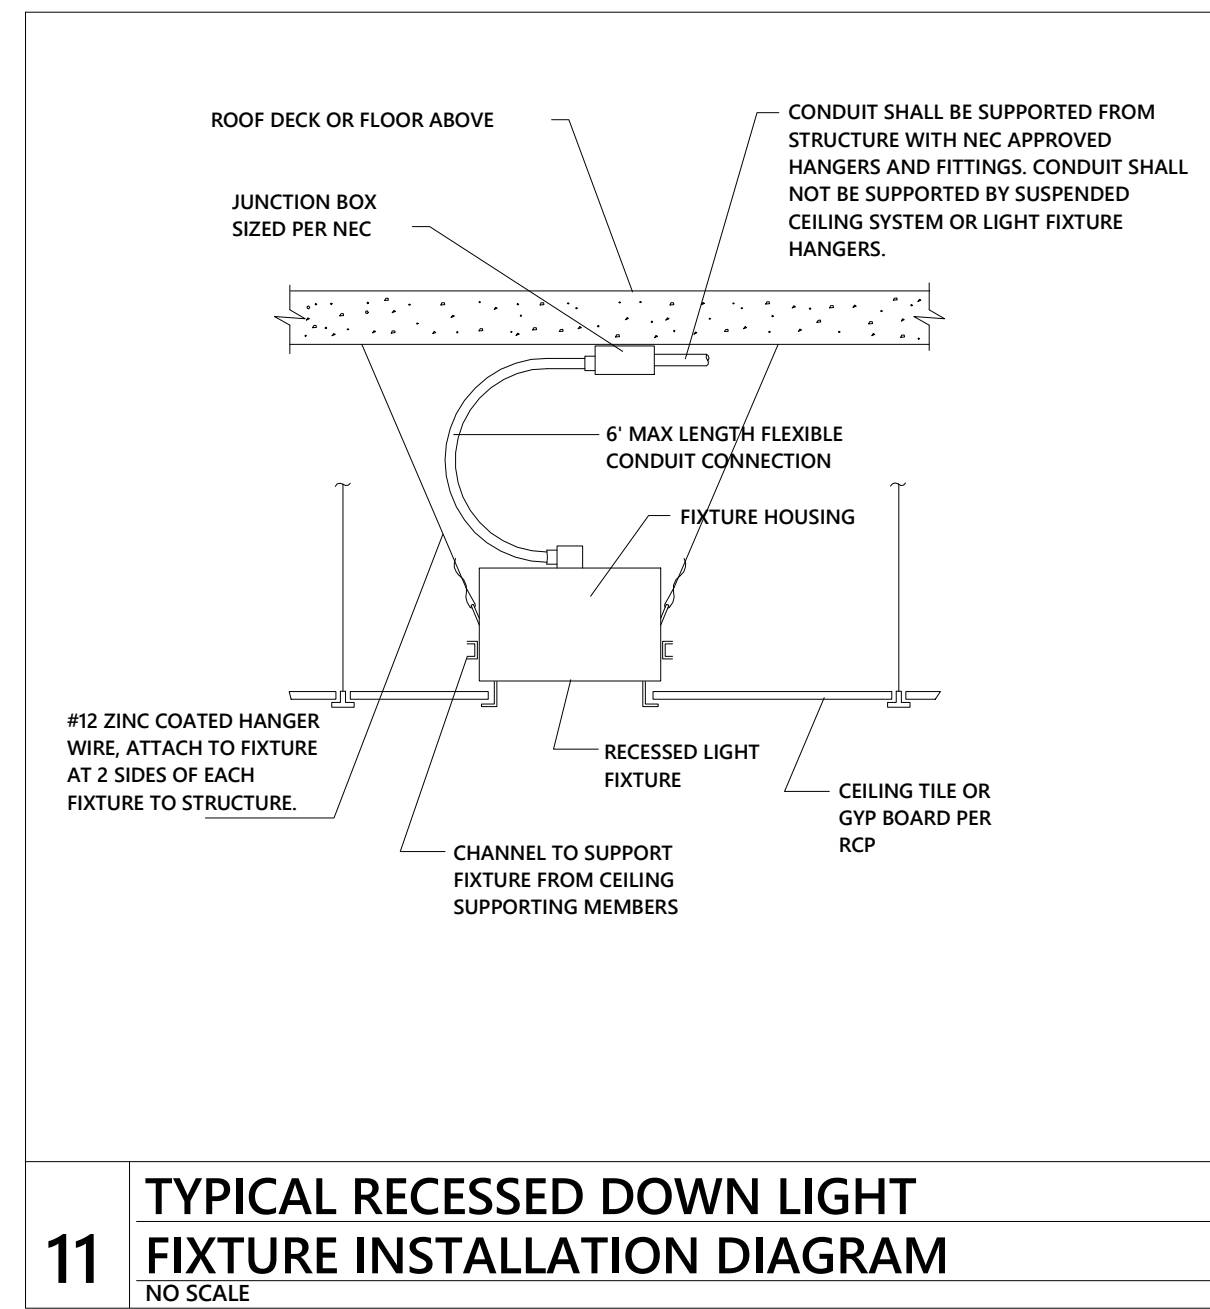

11 TYPICAL RECESSED DOWN LIGHT FIXTURE INSTALLATION DIAGRAM
NO SCALE

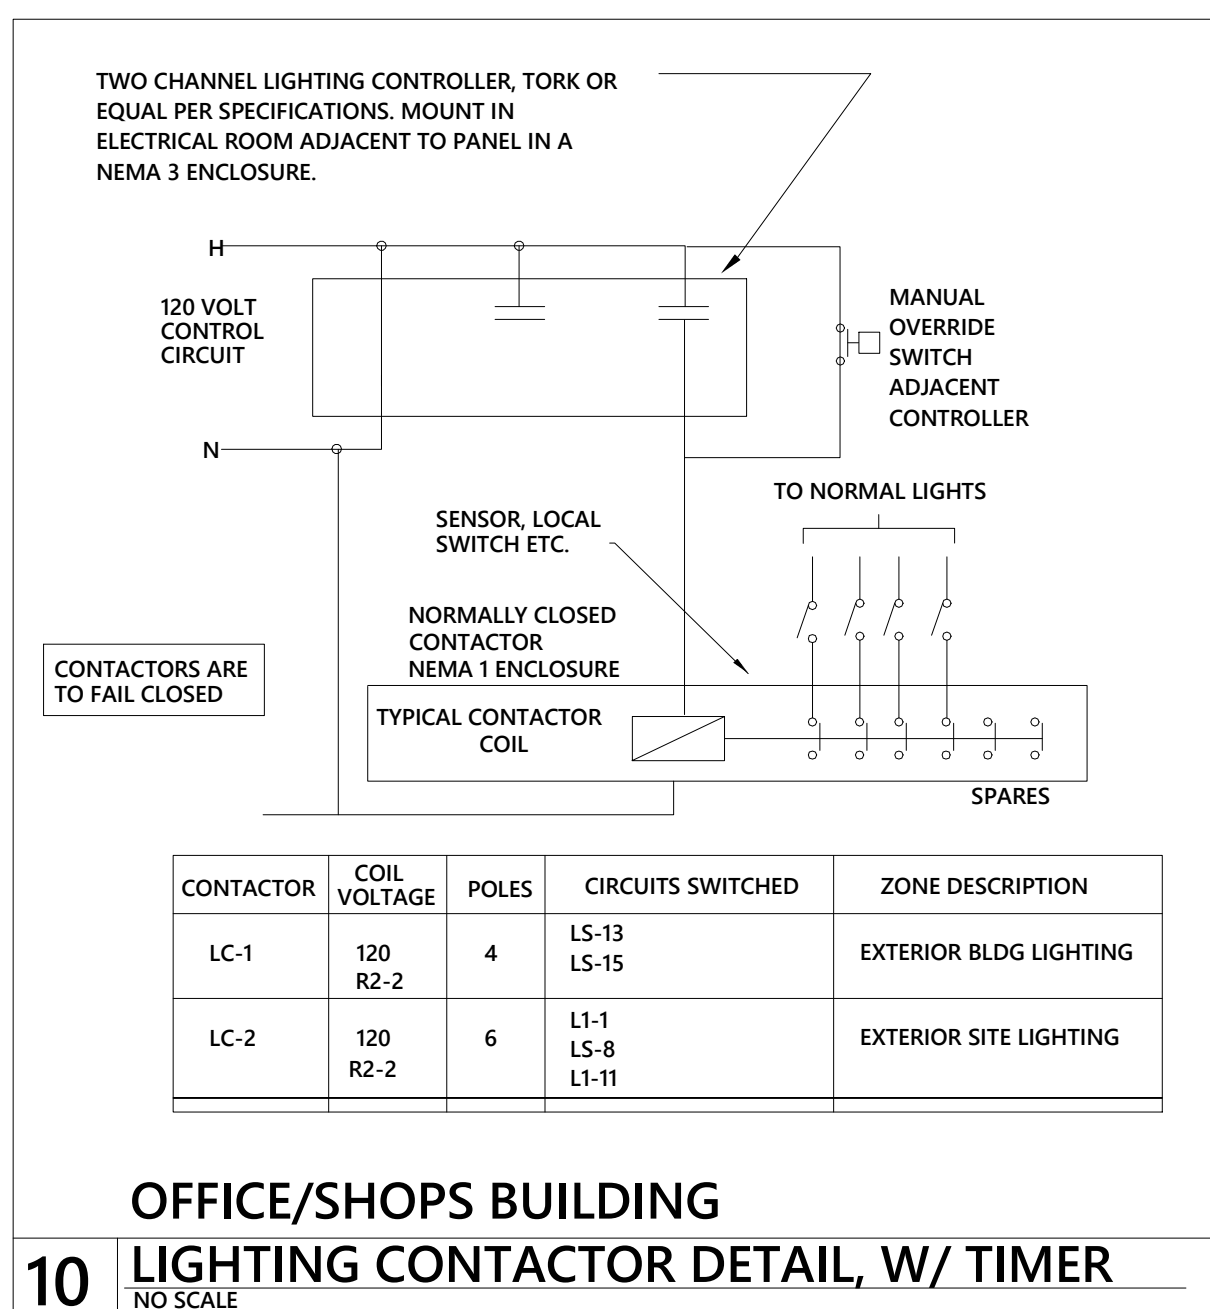

10 LIGHTING CONTACTOR DETAIL, W/ TIMER
NO SCALE

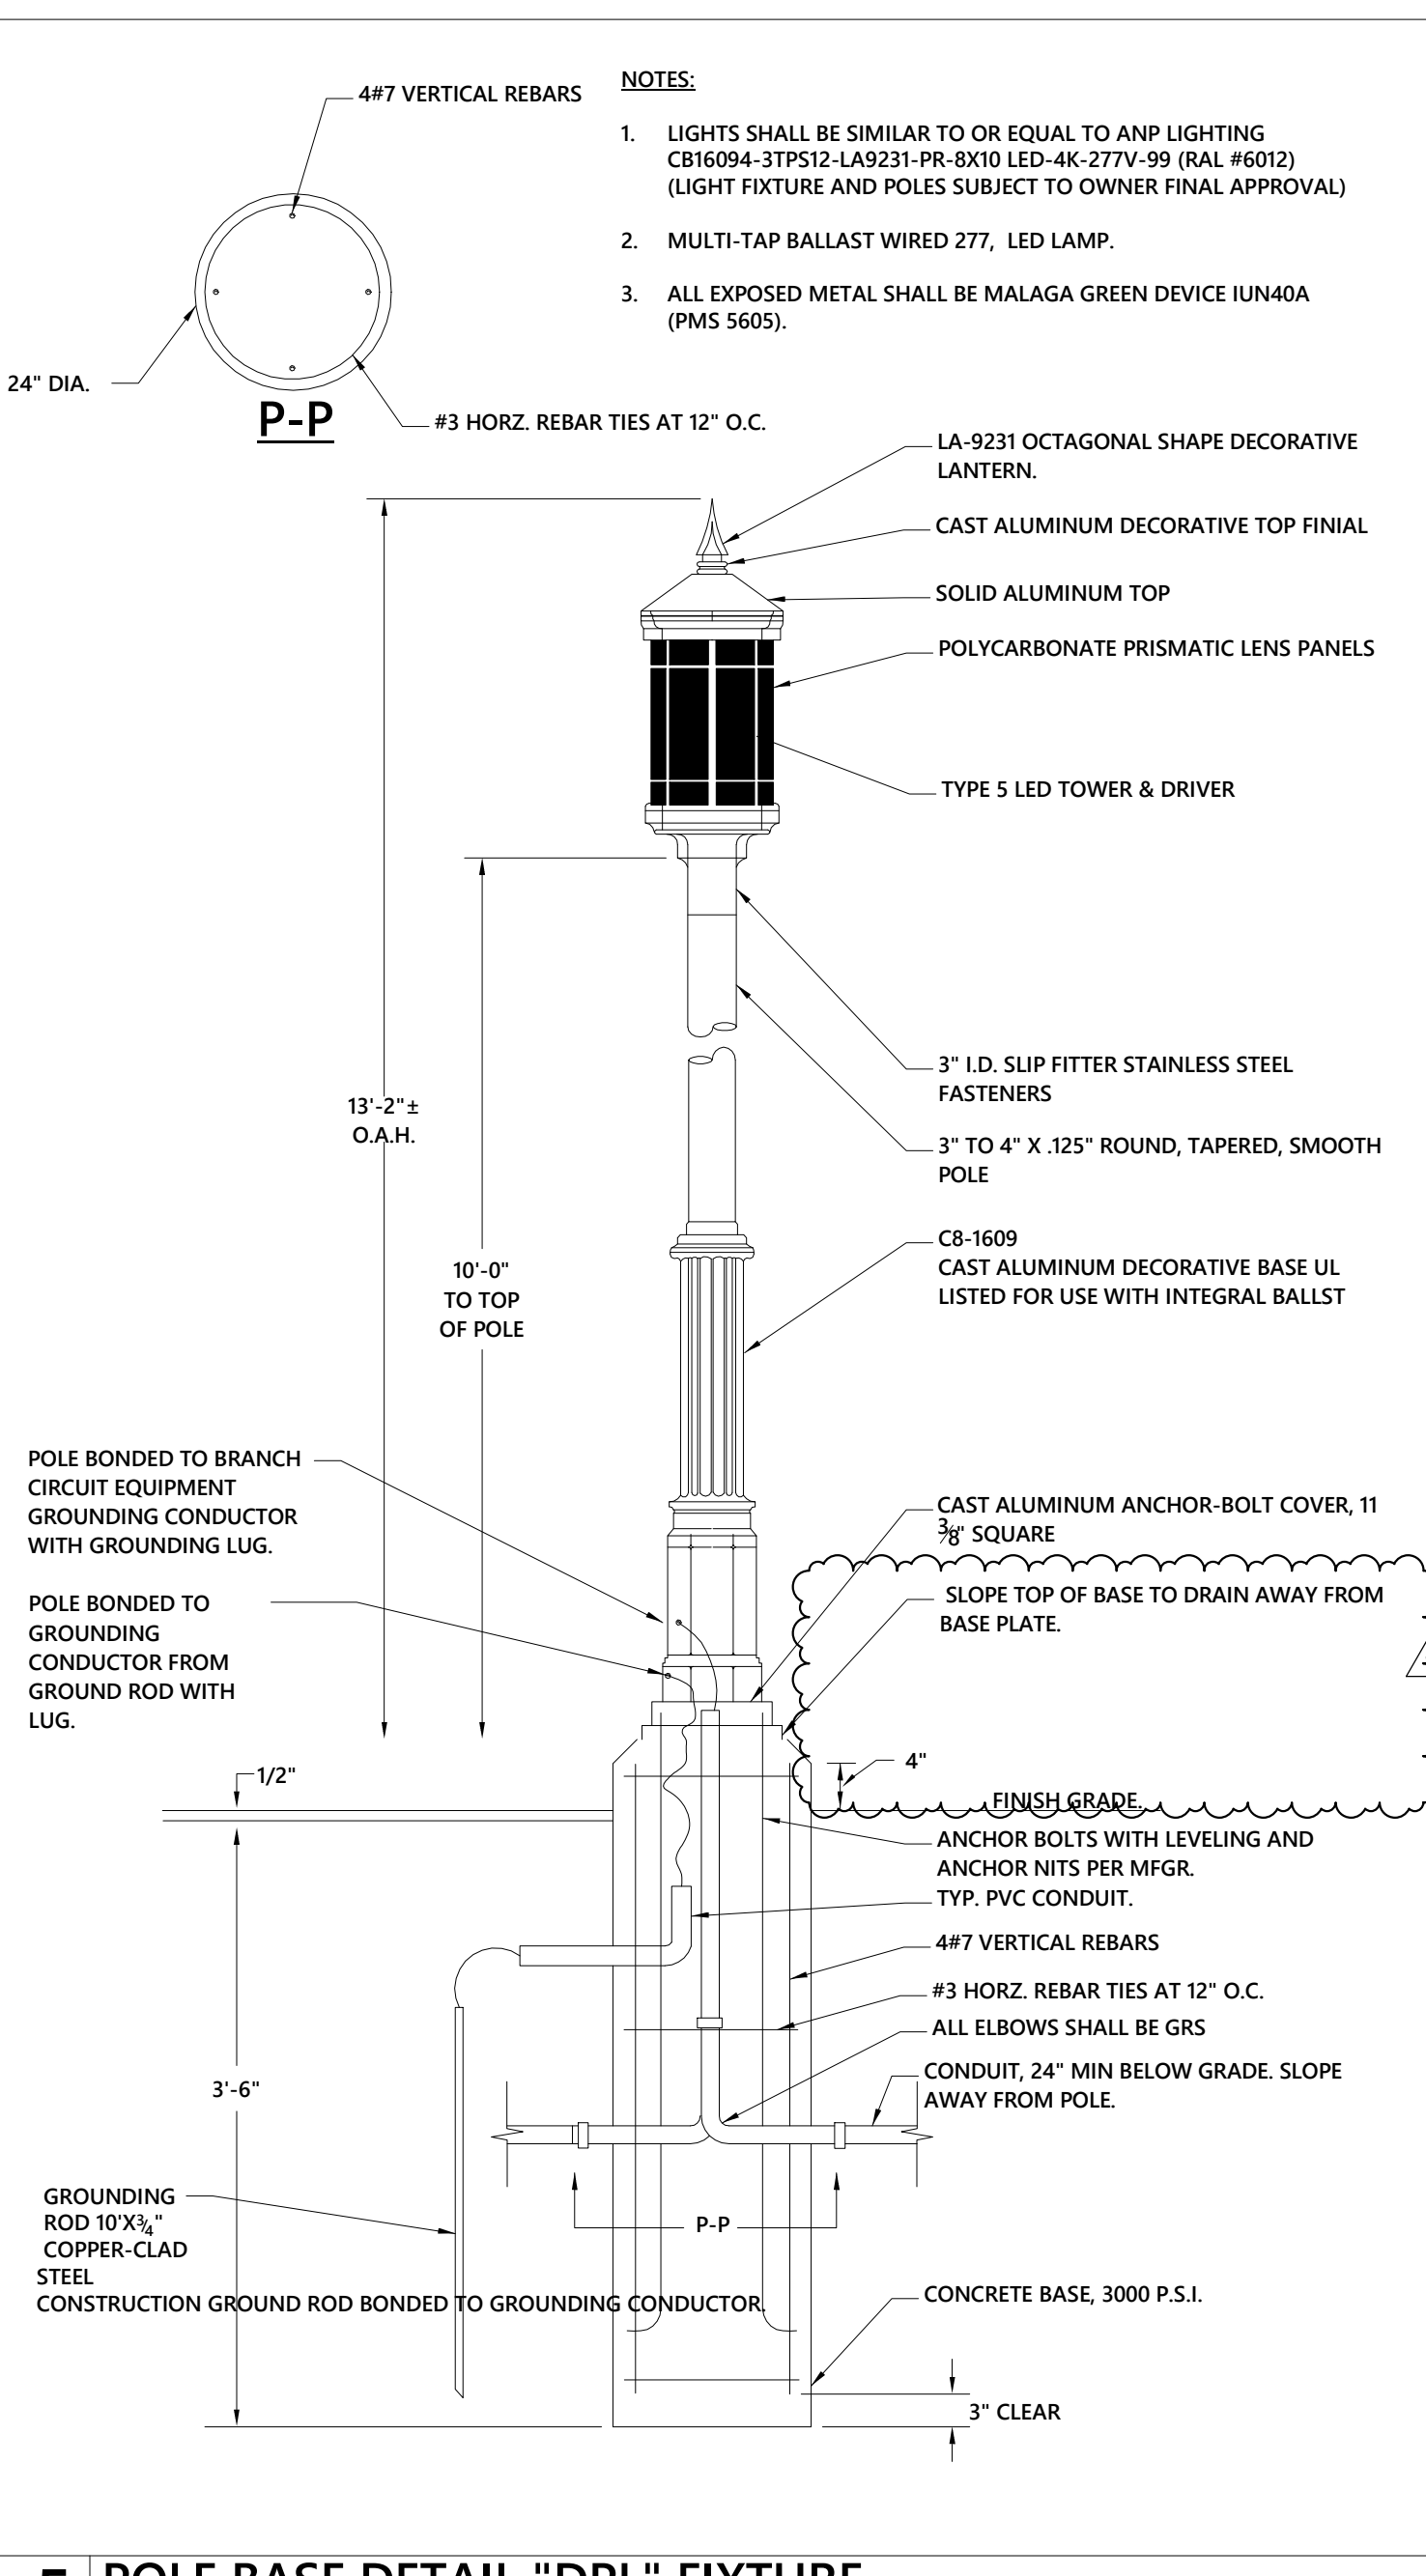

5 POLE BASE DETAIL "DPL" FIXTURE
NO SCALE



MEMBERS OF THE AMERICAN INSTITUTE OF ARCHITECTS

COPYRIGHT 2016 ALL RIGHTS RESERVED
PRINTED OR ELECTRONIC DRAWINGS AND DOCUMENTATION MAY NOT BE REPRODUCED IN ANY FORM WITHOUT WRITTEN PERMISSION FROM LS3P ASSOCIATES LTD.

REVISIONS:


No.	Description	Date
1	Addendum #4	8.28.2017

PROJECT: 9202-164730
SCO ID: 16-15656-02B
ITEM: 315 CODE: 41526
DATE: AUGUST 21, 2017
DRAWN BY: J. Holcomb
CHECKED BY: M. Mazzone


ELECTRICAL SITE PLAN - OVERALL

E-009


GENERAL NOTE:
ALL NEW UNDERGROUND UTILITIES SHALL BE LOCATED AND RECORDED BY A SURVEYOR REGISTERED IN NORTH CAROLINA UTILIZING A GPS LOCATING SERVICE. SURVEY SHALL BE TIED TO THE NC STATE PLANE COORDINATE SYSTEM AND SHALL MEET NC STANDARDS FOR POSITIONAL ACCURACY. PROVIDE X,Y,Z COORDINATES IN ACCORDANCE WITH THE SPECIFICATIONS AND IN A FORMAT APPROVED BY THE OWNER TO INCLUDE THE FOLLOWING:
DUCT BANKS (POWER AND TELECOM), LOCATIONS SHALL BE MADE AT 25' INTERVALS ALONG TOP EDGE AND BOTH SIDES OF DUCT BANK AT ALL STRUCTURE CONNECTIONS AND ALL CHANGES IN DIRECTION. NOTE DUCT BANK THICKNESS ON SURVEY.
MANHOLES (POWER AND TELECOM), LOCATIONS TO INCLUDE STRUCTURE WIDTH LENGTH AND DEPTH WITH ELEVATIONS OF TOP AND BOTTOM OF VAULT. TOP OF MANHOLE ENTRANCE AND ALL CONDUIT ENTERING AND EXITING THE MANHOLE.

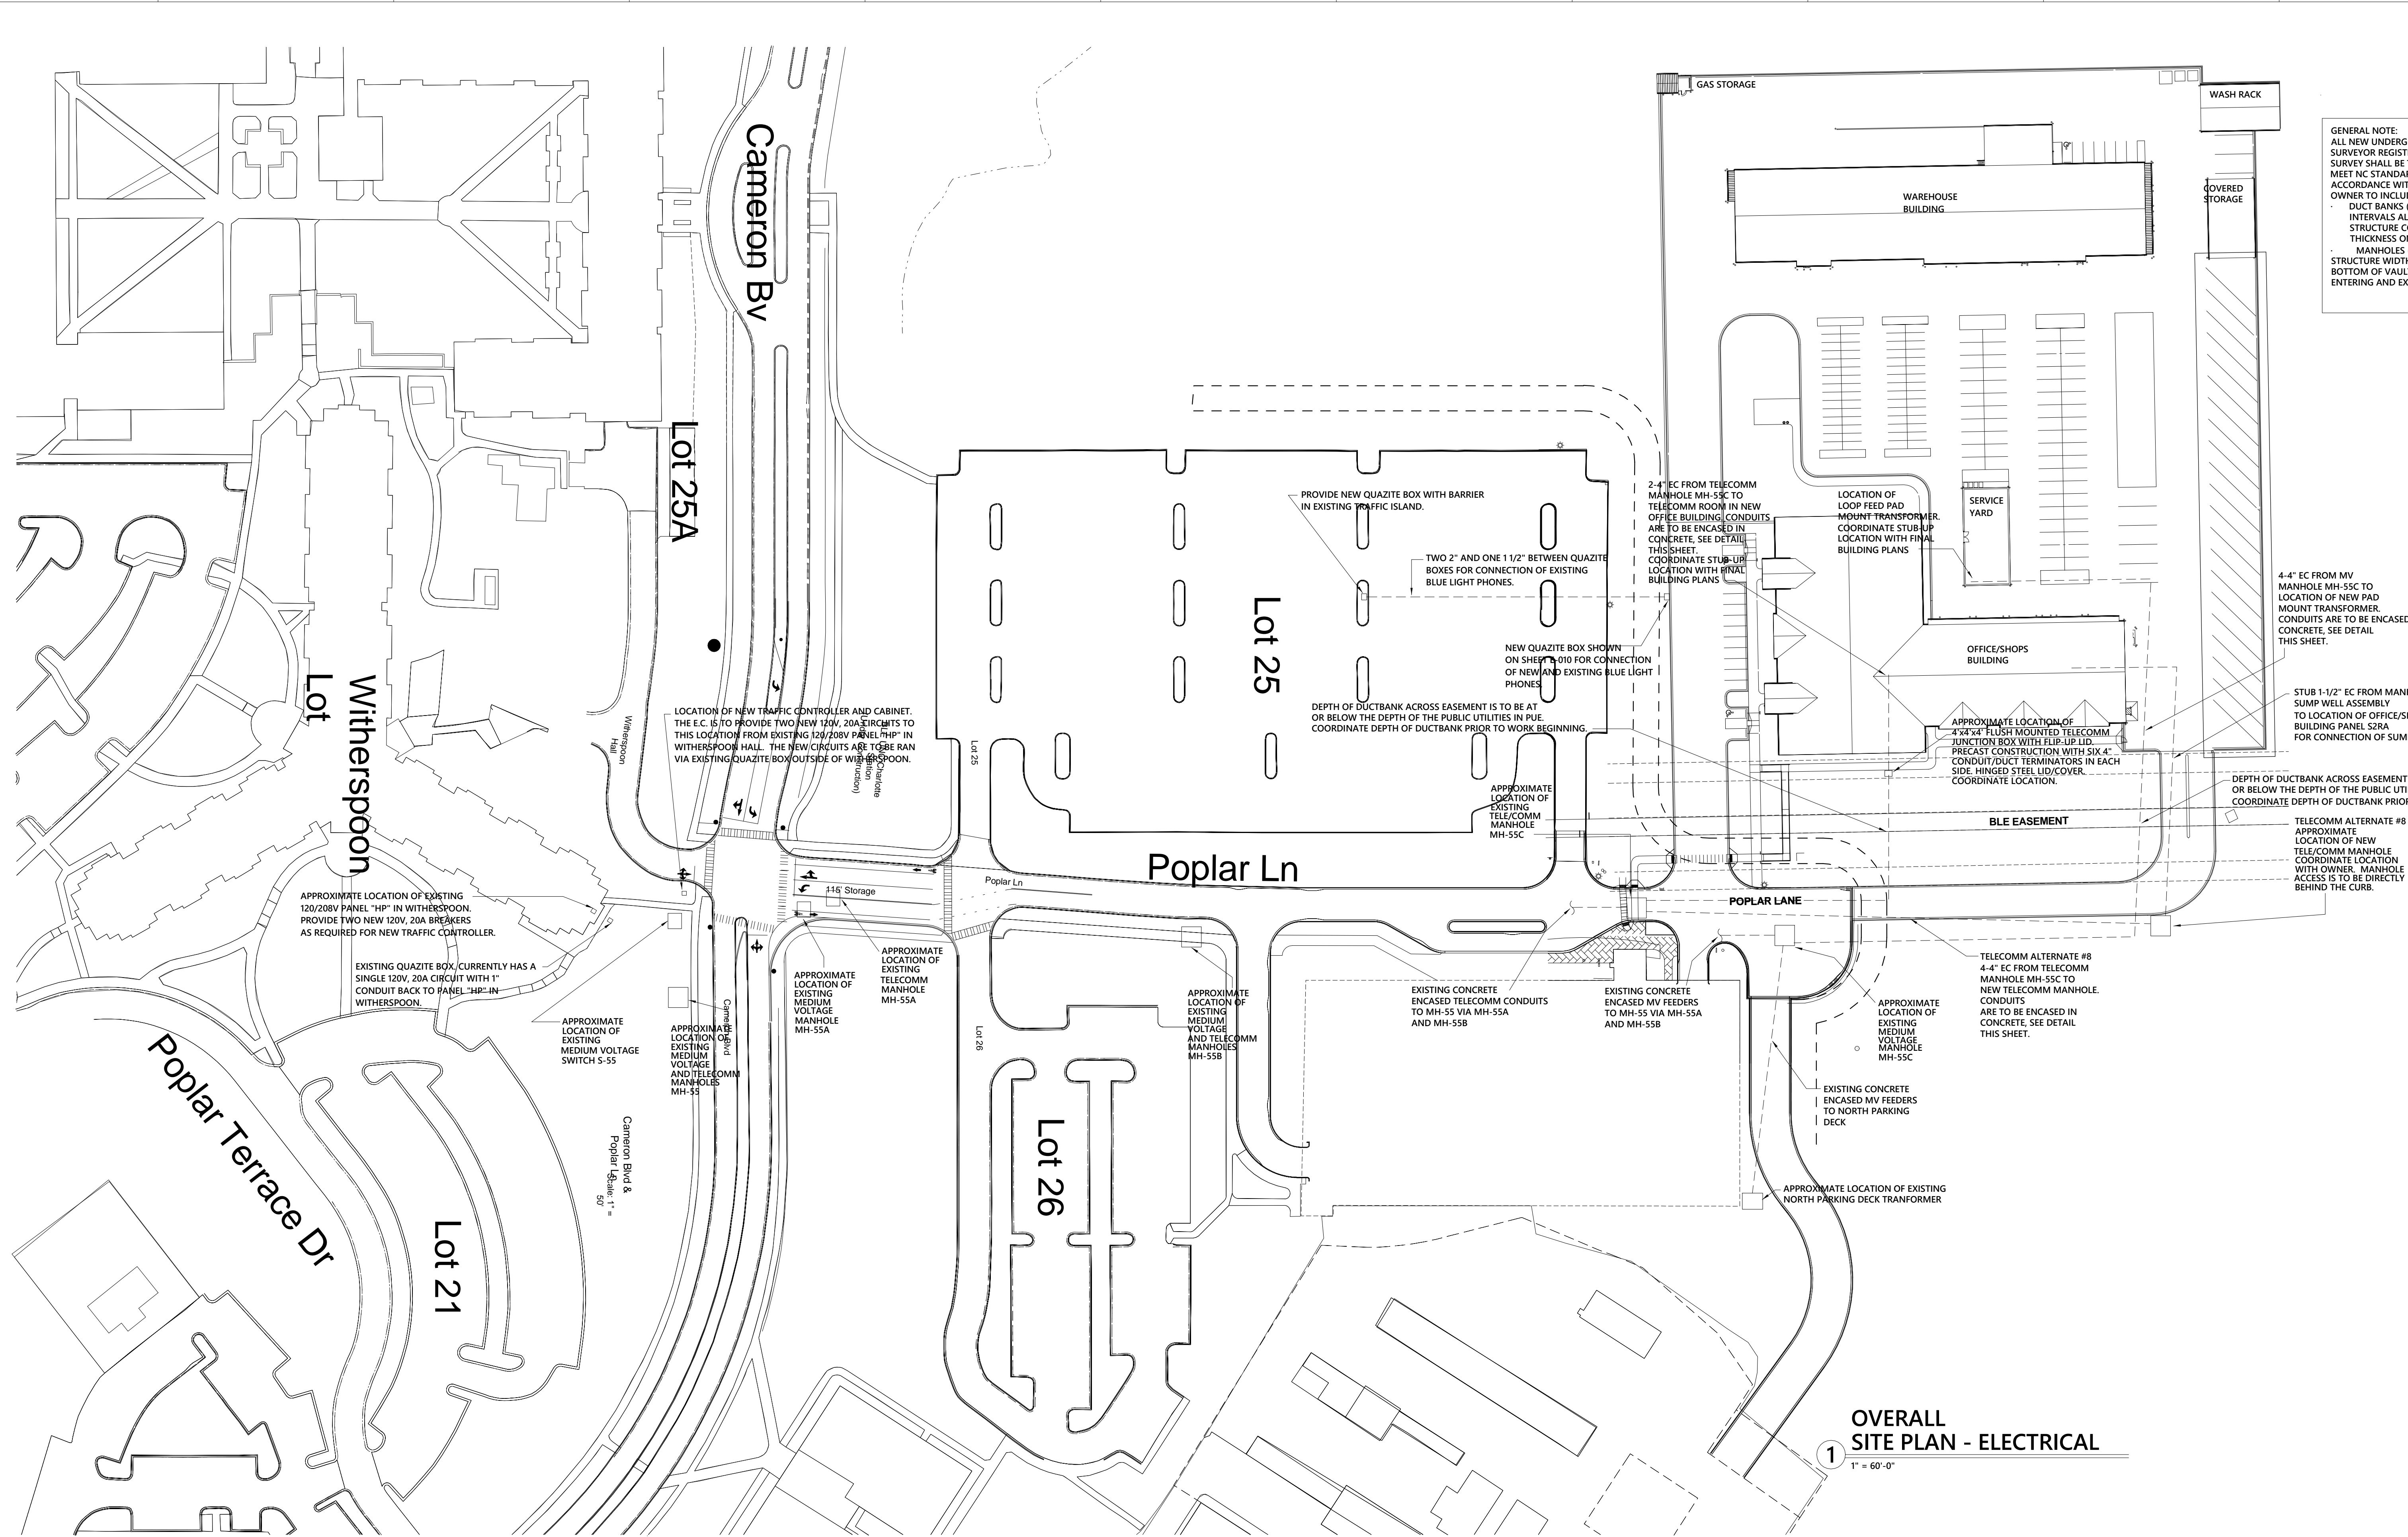

OVERALL SITE PLAN - ELECTRICAL
1
1" = 60'-0"

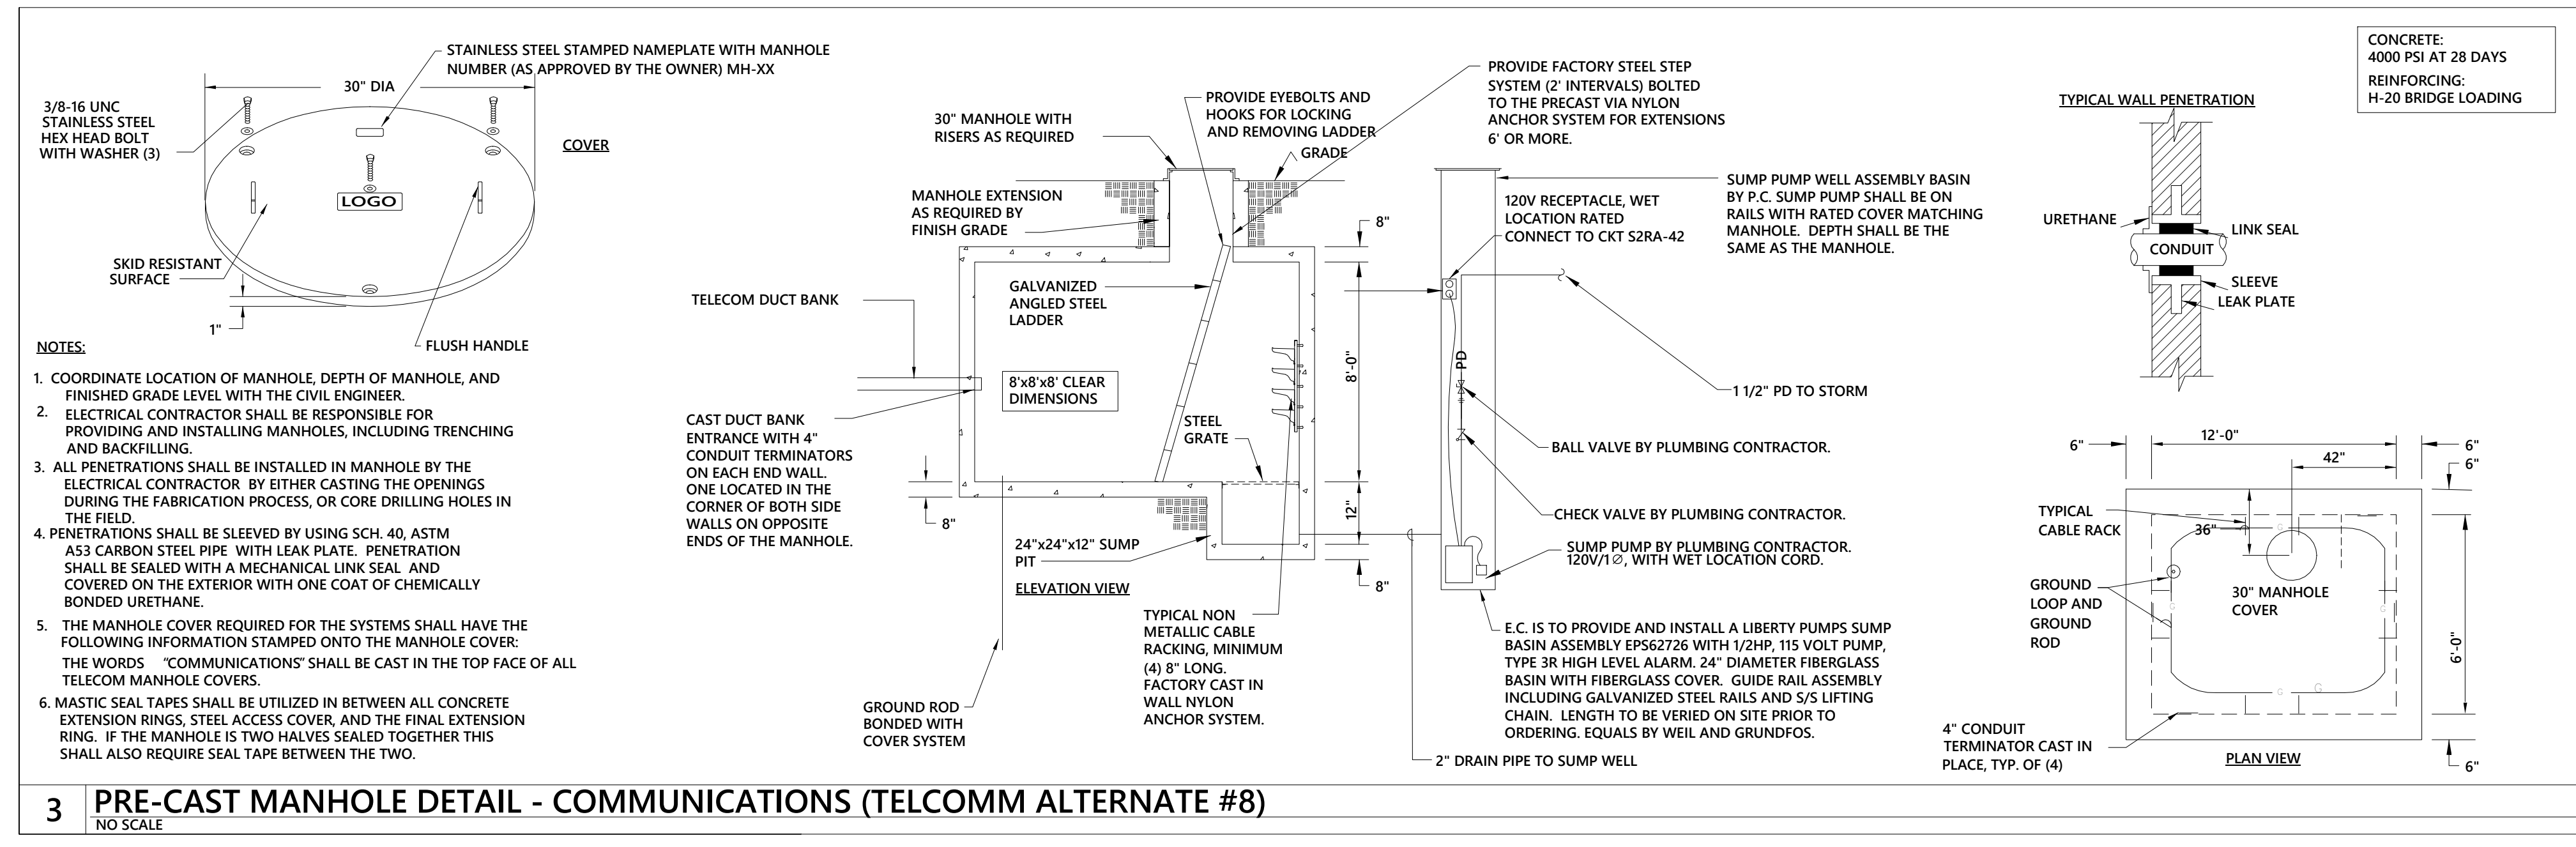



3 PRE-CAST MANHOLE DETAIL - COMMUNICATIONS (TELCOMM ALTERNATE #8)
NO SCALE

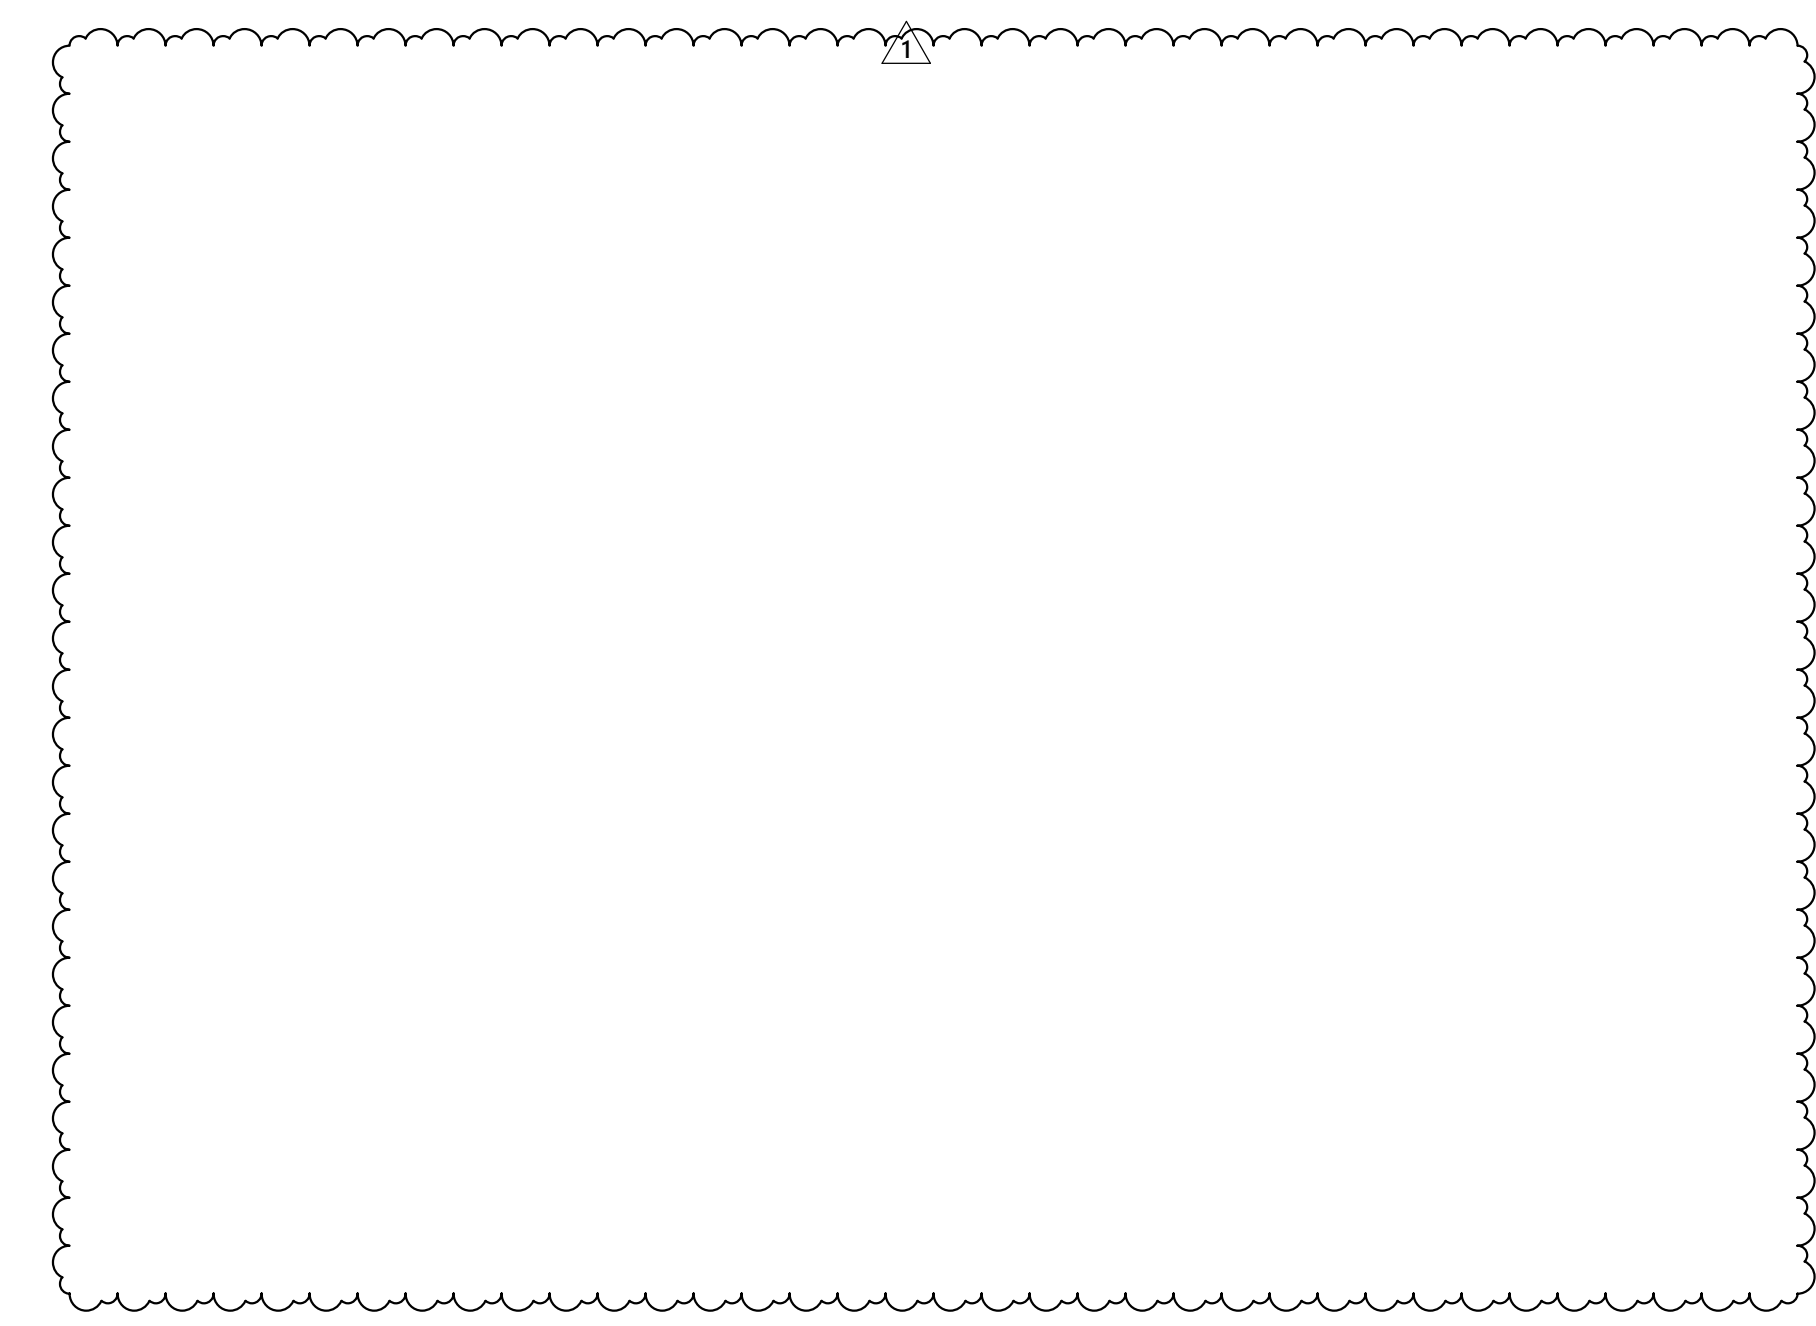

TYPICAL WALL PENETRATION
TYPICAL CABLE RACK

C:\Users\bmiller\Documents\16-0265_R16 MEP_BMiller.rvt
8/29/2017 8:44:25 AM

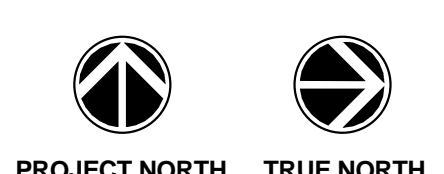

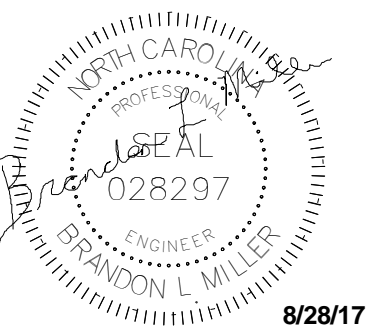

8/28/17

MEMBERS OF THE AMERICAN INSTITUTE OF ARCHITECTS

COPYRIGHT 2016 ALL RIGHTS RESERVED
PRINTED OR ELECTRONIC DRAWINGS AND DOCUMENTATION MAY NOT BE REPRODUCED IN ANY FORM WITHOUT WRITTEN PERMISSION FROM LS3P ASSOCIATES LTD.

REVISIONS:

No.	Description	Date
1	Addendum #4	8.28.2017

PROJECT: 9202-164730
SCO ID: 16-15656-02B
ITEM: 315 CODE: 41526
DATE: AUGUST 21, 2017
DRAWN BY: J. Holcomb
CHECKED BY: M. Mazzone

FLOOR PLAN - PATS/FO - POWER

E-101A


OPTIMA #: 16-0265

GENERAL NOTES


1. COORDINATE EXACT LOCATIONS OF ALL DEVICES IN FIELD WITH UNIVERSITY REPRESENTATIVE PRIOR TO ROUGH-IN.

KEY NOTES

- E.C. IS TO PROVIDE 24 STRAND, MULTIMODE, 62.5 MICRON FIBER OPTIC CABLE FROM OPS CENTER TO MAIN TELECOM ROOM. LEAVE ENOUGH SLACK FOR THE OWNER TO MAKE FINAL CONNECTION ANYWHERE IN THIS ROOM.
- TIME CLOCK LOCATION. COORDINATE MOUNTING HEIGHT WITH OWNER.
- PROVIDE LIGHTING CONTACTOR. REFER TO DETAIL #10/606.
- E.C. IS TO VERIFY ALL MOUNTING HEIGHTS OF ELECTRICAL DEVICES AND ROUGH-IN LOCATIONS IN THIS ROOM WITH OWNER PRIOR TO ROUGH-IN.
- J-BOX FOR CONNECTION TO MOTORIZED DOOR. DOORS ARE TO BE POWERED THROUGH A UPS. PROVIDE 120V, 20A, 1500W UPS, FOR EACH SET OF MOTORIZED DOORS. WALL MOUNT UPS UP HIGH IN THE MAIN ELECTRICAL ROOM. APC SMART PRO SERIES OR EQUAL BY EATON OR SQUARE D.
- RECEPTACLES FOR KEY BOXES. COORDINATE MOUNTING HEIGHT WITH OWNER.
- SEE SYMBOL SCHEDULE ON EMT FOR ALL IN-BOX RECEPTACLES AND ASSOCIATED CONNECTIONS FOR WORK IN THE FIELD.
- MOUNT RECEPTACLES INDEPENDENTLY FROM STRUCTURE. CONTRACTOR IS TO ATTACH RECEPTACLE TO CABLE TRAY FOR LATERAL STABILITY. REFER TO TELECOMMUNICATIONS DRAWINGS FOR ADDITIONAL INFORMATION. TYPICAL OF EQUIPMENT RACK POWER.
- PROVIDE 2" CONDUITS ABOVE ACCESSIBLE CEILING ROUTED TO ROOF FOR ANTENNA CABLING. PROVIDE WEATHERPROOF NECK AND CAP FOR FUTURE USE.
- SEE DETAIL #3/E-002 FOR EMERGENCY GAS BOILER SHUT-OFF.
- ROUTE CONDUIT TO PLENUM BOX LOCATED IN TRANSPORTATION DRIVER ROOM 104E.
- PROVIDE (2) 2" CONDUITS FROM EQUIPMENT RACK LOCATION TO WALL ADJACENT TO CUBICALS. COORDINATE EXACT LOCATION OF JUNCTION BOX AT EQUIPMENT RACK AND WALL LOCATIONS.
- PROVIDE (2) 2" CONDUITS FROM ACCESSIBLE CEILING SPACE IN CORRIDOR TO WALL ADJACENT TO CUBICALS. COORDINATE EXACT LOCATION OF JUNCTION BOX.

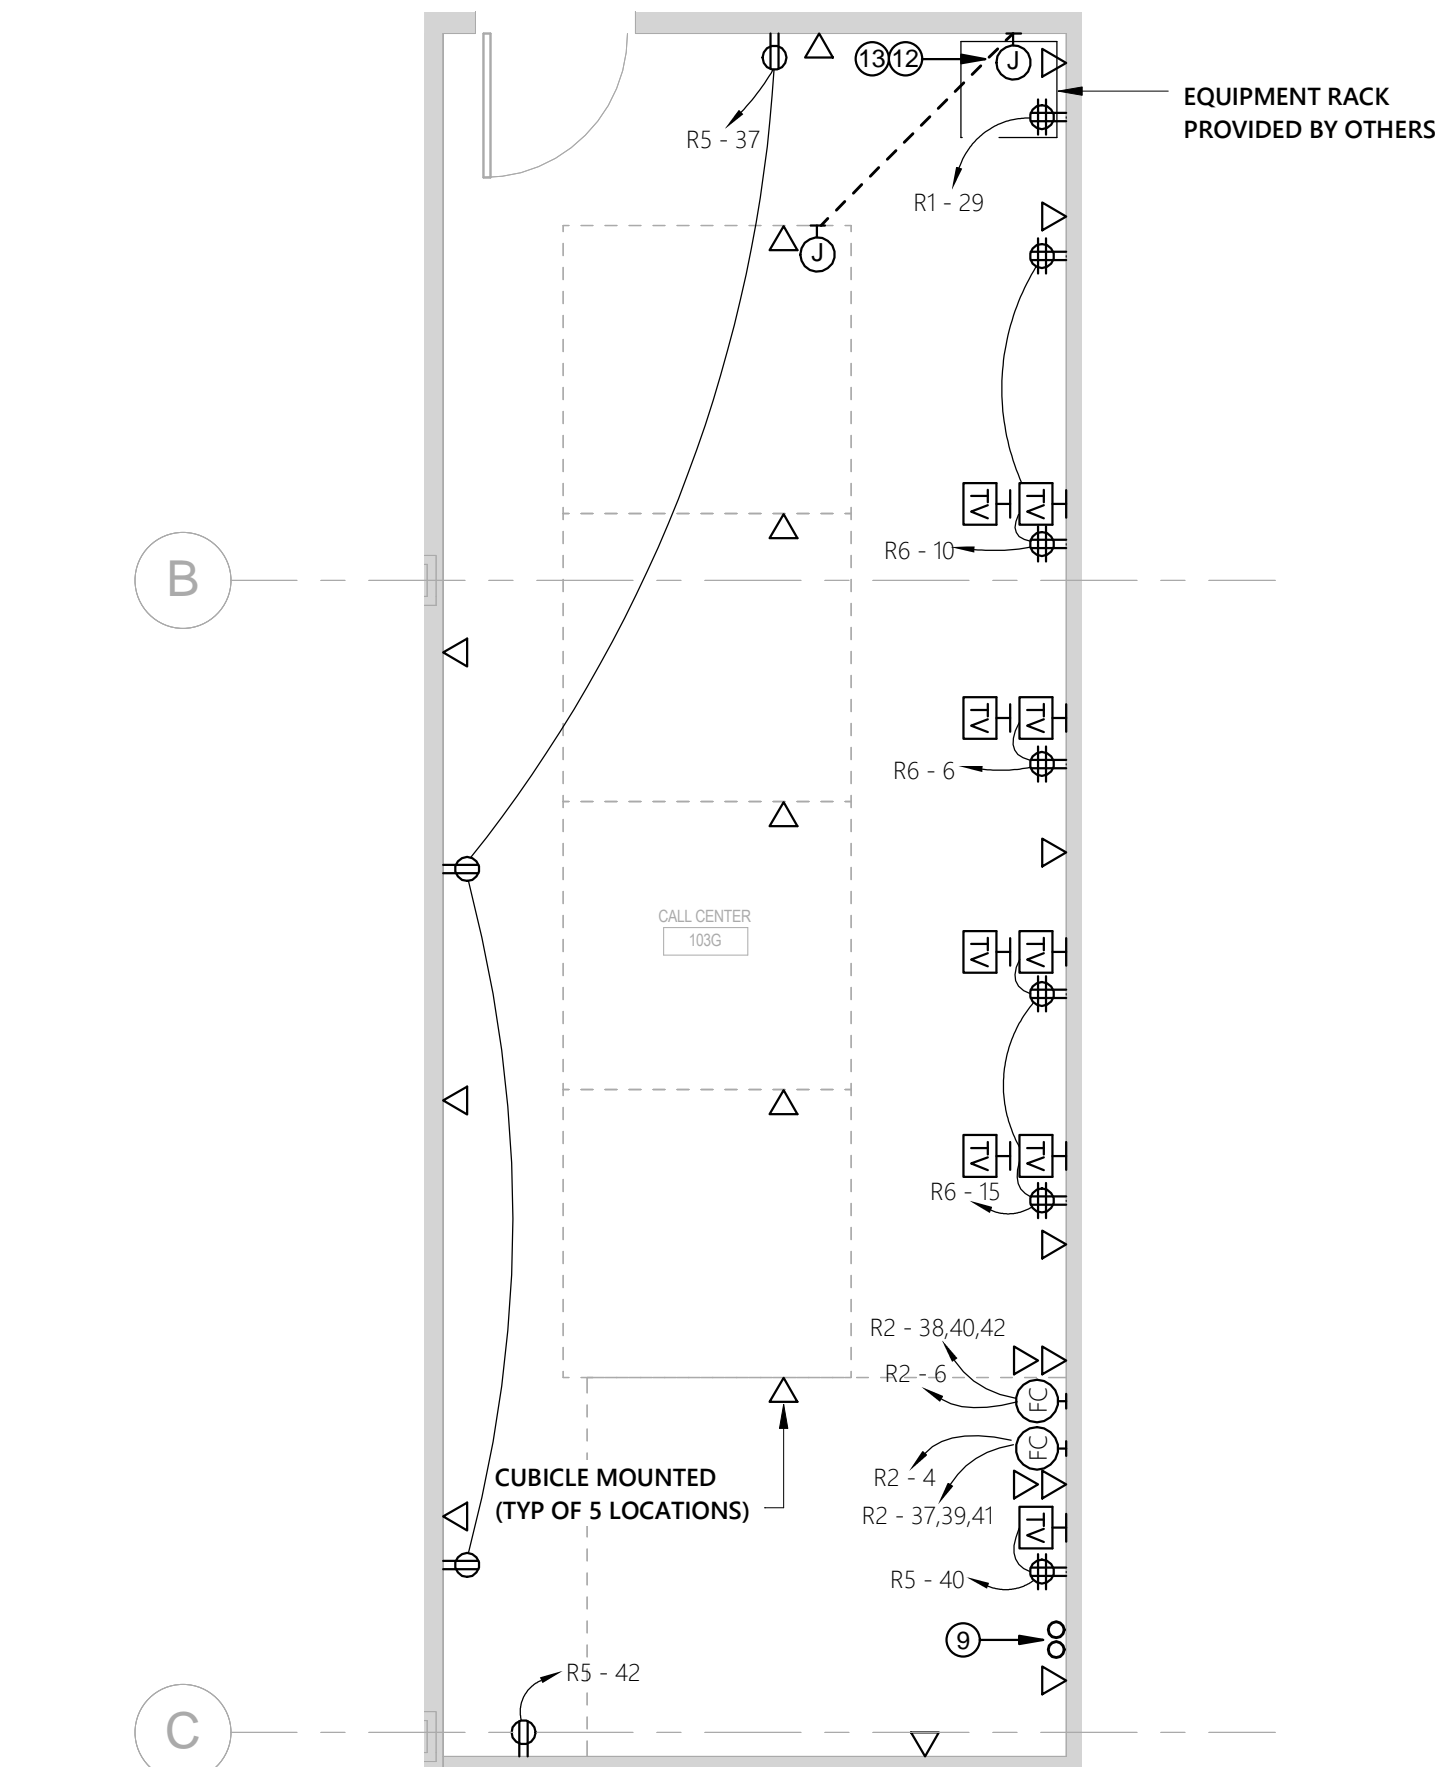

3 FLOOR PLAN - POWER - PATS/FO - ENLARGED CALL CENTER

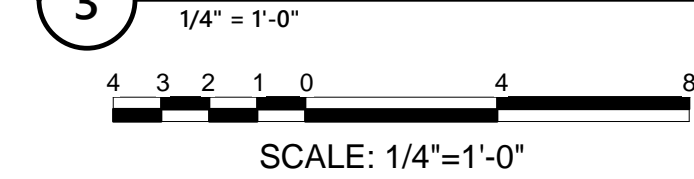


PARTITION LEGEND


- ALL EXTERIOR WALLS TO BE W1 U.N.O.
- ALL INTERIOR METAL STUD PARTITIONS TO BE TYPE G32 U.N.O.

- NON-RATED PARTITION TO CEILING
- NON-RATED PARTITION TO DECK
- 1 HR. RATED PARTITION TO DECK
- 2 HR. RATED PARTITION TO DECK

NOTE: SEE SHEET A-004 FOR CONSTRUCTION OF PARTITION TYPES.

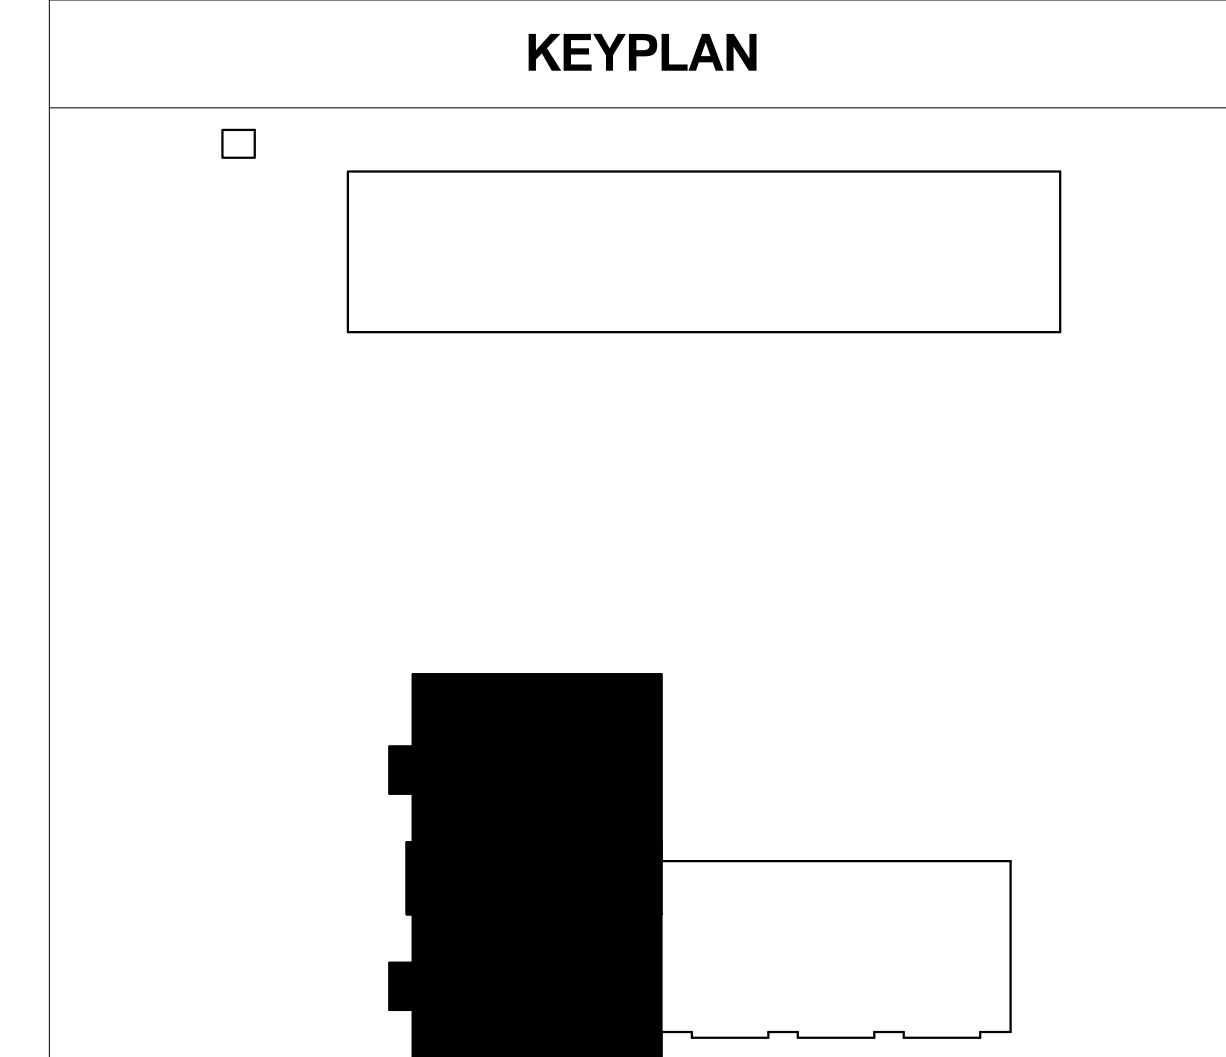

2 FLOOR PLAN - POWER - PATS/FO - ENLARGED TELE

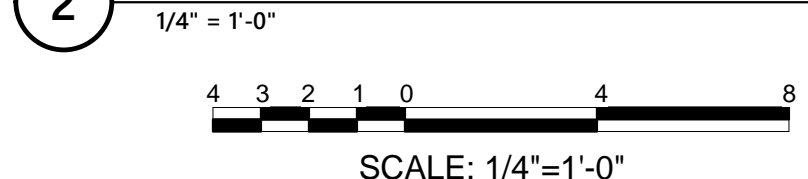

1 FLOOR PLAN - POWER - PATS/FO





8/28/17

MEMBERS OF THE AMERICAN INSTITUTE OF ARCHITECTS

COPYRIGHT 2016 ALL RIGHTS RESERVED
PRINTED OR ELECTRONIC DRAWINGS AND DOCUMENTATION MAY NOT BE REPRODUCED IN ANY FORM WITHOUT WRITTEN PERMISSION FROM LS3P ASSOCIATES LTD.

REVISIONS:

No.	Description	Date
1	Addendum #4	8.28.2017

PROJECT: 9202-164730
SCO ID: 16-15656-02B
ITEM: 315 CODE: 41526
DATE: AUGUST 21, 2017
DRAWN BY: J. Holcolmb
CHECKED BY: M. Mazzone

REFLECTED CEILING PLAN - PATS/FO SYSTEMS

E-301A

OPTIMA #: 16-0265



GENERAL NOTES:

A. COORDINATE EXACT LOCATIONS OF ALL DEVICES IN FIELD WITH UNIVERSITY REPRESENTATIVE PRIOR TO ROUGH-IN.


KEY NOTES:

- DUCT DETECTOR FOR AHU-1. COORDINATE WITH MECHANICAL CONTRACTOR AND DRAWINGS FOR MORE INFO. PROVIDE (8) 4" CONDUITS (16) TELECOMMUNICATIONS & (2) SECURITY/CAMERAS AS INDICATED ABOVE CEILING. STACK CONDUITS AS REQUIRED. CONDUIT SLEEVES SHALL BE COLOR CODED. REFER TO DRAWING TC-001 FOR ADDITIONAL INFORMATION.
- FIRE ALARM AND GENERATOR REMOTE ANNUCIATOR PANEL LOCATION. COORDINATE WITH OWNER.
- CONNECT TO 120V CONTROL CIRCUIT RM-33.
- PROVIDE 120V POWER TO CARD READER DOOR LOCATION. CONNECT TO CIRCUIT RM-39.
- PROVIDE 120V POWER TO CARD READER DOOR LOCATION. CONNECT TO CIRCUIT RM-41.

PARTITION LEGEND

- ALL EXTERIOR WALLS TO BE W1 U.N.O.
 - ALL INTERIOR METAL STUD PARTITIONS TO BE TYPE G32 U.N.O.
- NON-RATED PARTITION TO CEILING
 - NON-RATED PARTITION TO DECK
 - 1 HR. RATED PARTITION TO DECK
 - 2 HR. RATED PARTITION TO DECK
- NOTE: SEE SHEET A-004 FOR CONSTRUCTION OF PARTITION TYPES.

KEYPLAN

 



No.	Description	Date
1	Addendum #4	8.28.2017

PROJECT: 9202-164730
SCO ID: 16-15656-02B
ITEM: 315 CODE: 41526
DATE: AUGUST 21, 2017
DRAWN BY: J. Holcolmb
CHECKED BY: M. Mazzone

FLOOR PLAN - FO SHOPS - POWER/HVAC

E-401C

GENERAL NOTES

- COORDINATE EXACT LOCATIONS OF ALL DEVICES IN FIELD WITH MECHANICAL/PLUMBING PLANS/CONTRACTOR PRIOR TO ROUGH-IN.
- FOR THIS PLAN, REFER TO PANEL SCHEDULE "RM ALTERNATE" ON SHEET E-605.

GENERAL NOTES

- COORDINATE EXACT LOCATIONS OF ALL DEVICES IN FIELD WITH MECHANICAL/PLUMBING PLANS/CONTRACTOR PRIOR TO ROUGH-IN.
- KEY NOTES:
- PROVIDE J-BOX WITH REQUIRED NEMA PLUG CONFIGURATION. (COORDINATE WITH EQUIPMENT MANUFACTURER FOR PLUG TYPE, VERIFY HEIGHT WITH MECHANICAL CONTRACTOR.

PARTITION LEGEND

- ALL EXTERIOR WALLS TO BE W1 U.N.O.
- ALL INTERIOR METAL STUD PARTITIONS TO BE TYPE G32 U.N.O.


- NON-RATED PARTITION TO CEILING
- NON-RATED PARTITION TO DECK
- 1 HR. RATED PARTITION TO DECK
- 2 HR. RATED PARTITION TO DECK

NOTE: SEE SHEET A-004 FOR CONSTRUCTION OF PARTITION TYPES.


KEYPLAN



2 FLOOR PLAN - POWER/HVAC - FO SHOPS ALTERNATE-10
1/8" = 1'-0"

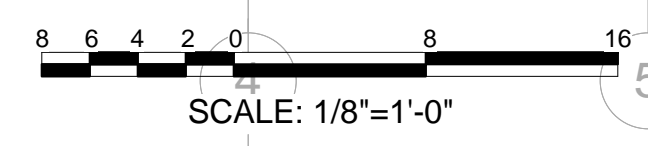

1 FLOOR PLAN - POWER/HVAC - FO SHOPS - BASE BID
1/8" = 1'-0"



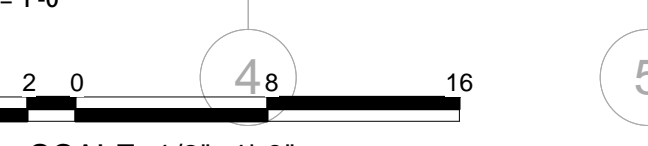


C:\Users\bmiller\Documents\16-0265_R16 MEP_BMiller.rvt 8/25/2017 8:46:13 AM

DRY-TYPE TRANSFORMER SCHEDULE

TRANSF. TYPE	PRIMARY VOLTAGE	SECONDARY VOLTAGE	KVA	SQUARE "D"	GROUNDING ELECTRODE CONDUCTOR		SIZE
					PRIMARY	SECONDARY	
T-5	480	208/120 Y	30		(3)-#8, #10 Gnd. -3/4" C. 50 AMP	(4)-#3, #8 Gnd. -1 1/2" C. 100 A	#8 25/14
T-6	480	208/120 Y	45		(3)-#4, #8 Gnd. -1 1/4" C. 70 AMP	(4)-#1/0, #6 Gnd. -2" C. 150 A	#6 30/20
T-7	480	208/120 Y	75		(3)-#1, #6 Gnd. -1 1/2" C. 125 AMP	(4)-#4/0, #2 Gnd. -2 1/2" C. 225 A	#2 30/20
T-8	480	208/120 Y	112.5		(3)-#2/0, #6 Gnd. -1 1/2" C. 175 AMP	(2) SETS(4)-#3/0, #1/0 Gnd. -2" C. 400 A	#1/0 35/29
T-9	480	208/120 Y	150		(3)-#4/0, #4 Gnd. -2 1/2" C. 225 AMP	(2)-SETS (4)-#250, #1/0 Gnd. -3" C. 500A	#1/0 41/32
T-10	480	208/120 Y	225		(3) #500kcmil, #3 Gnd. 3" C. 350 AMP	(3)-SETS (4)-#300kcmil, #2/0 Gnd. -3" C. EA. / 800 AMP	#2/0 48/30

NOTE: NOT ALL SIZES OR TYPES MAY BE USED.

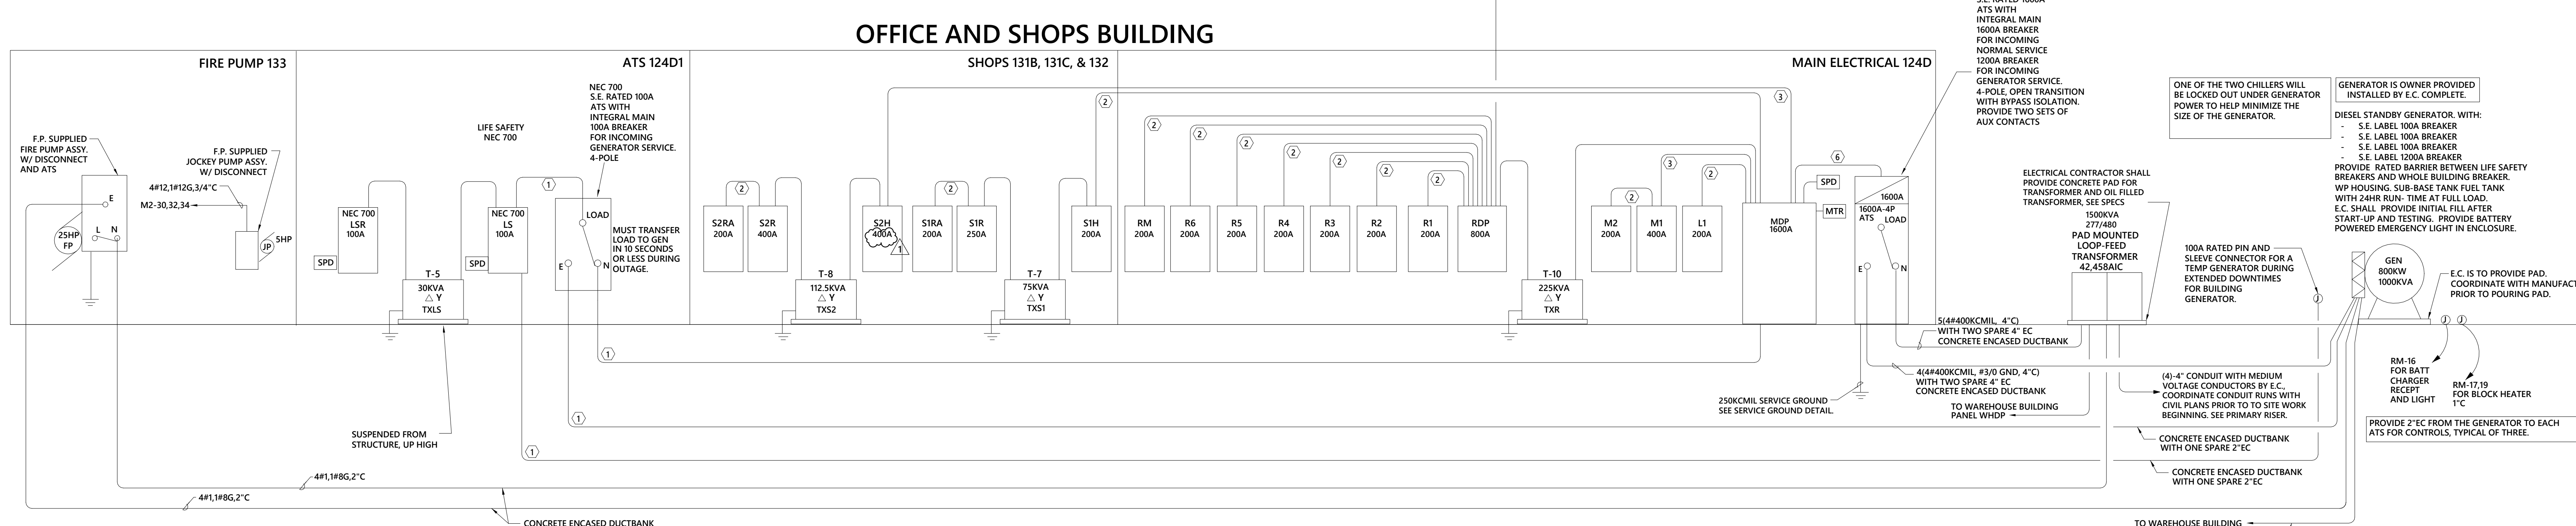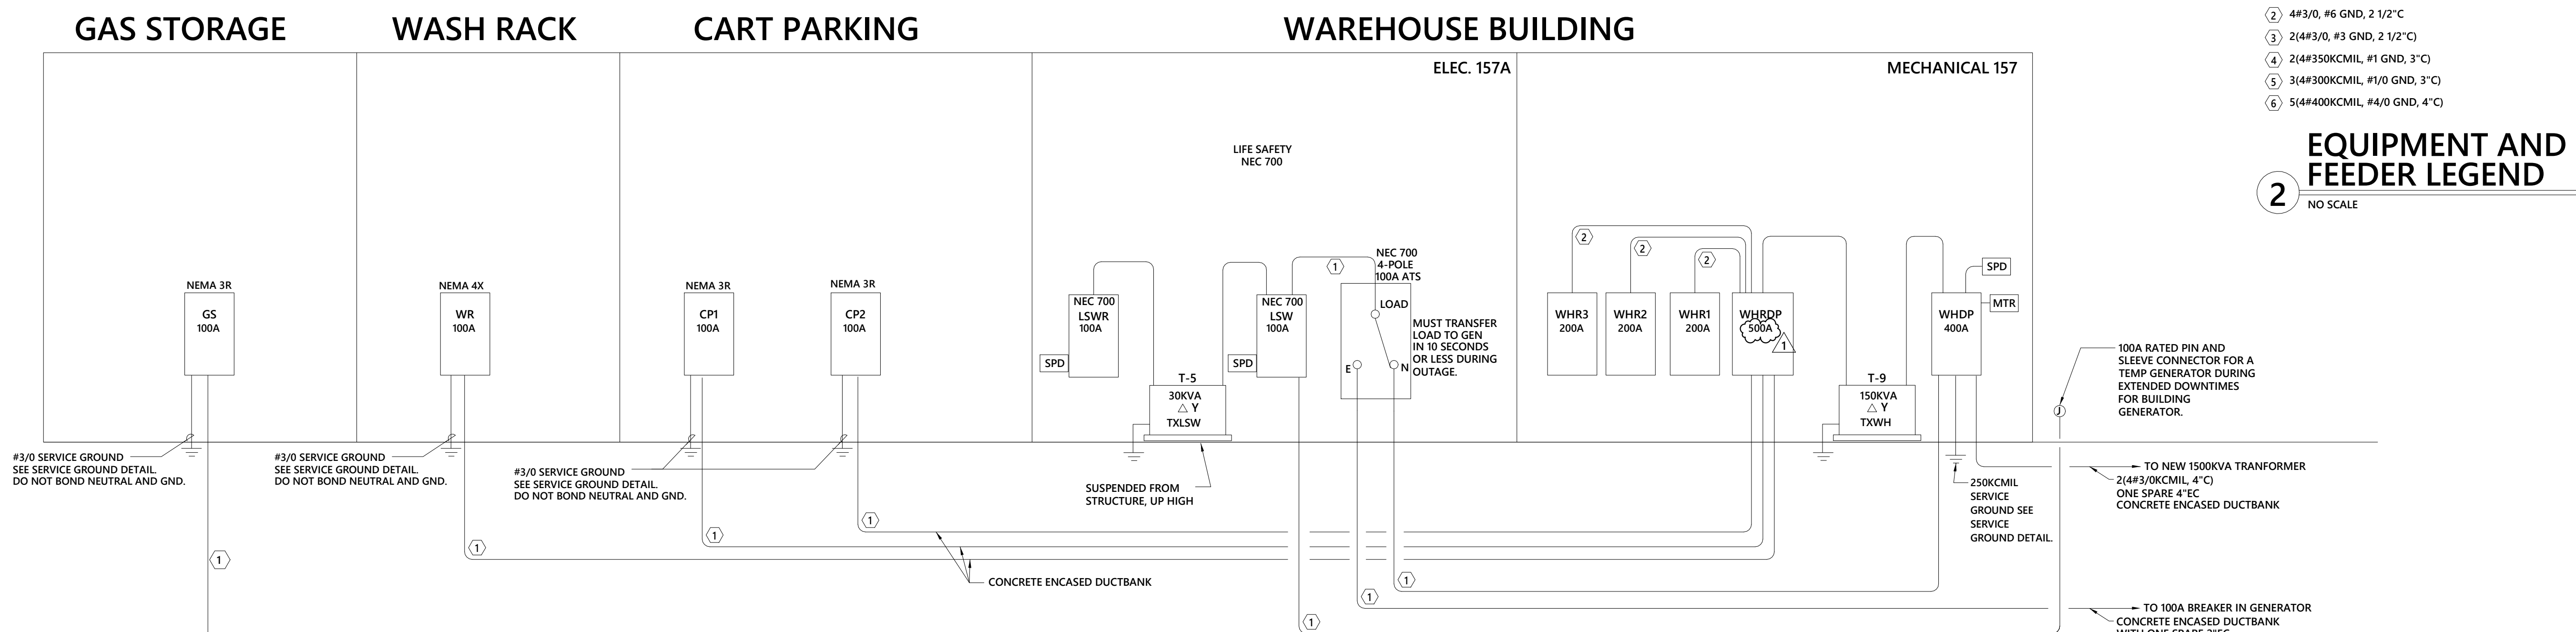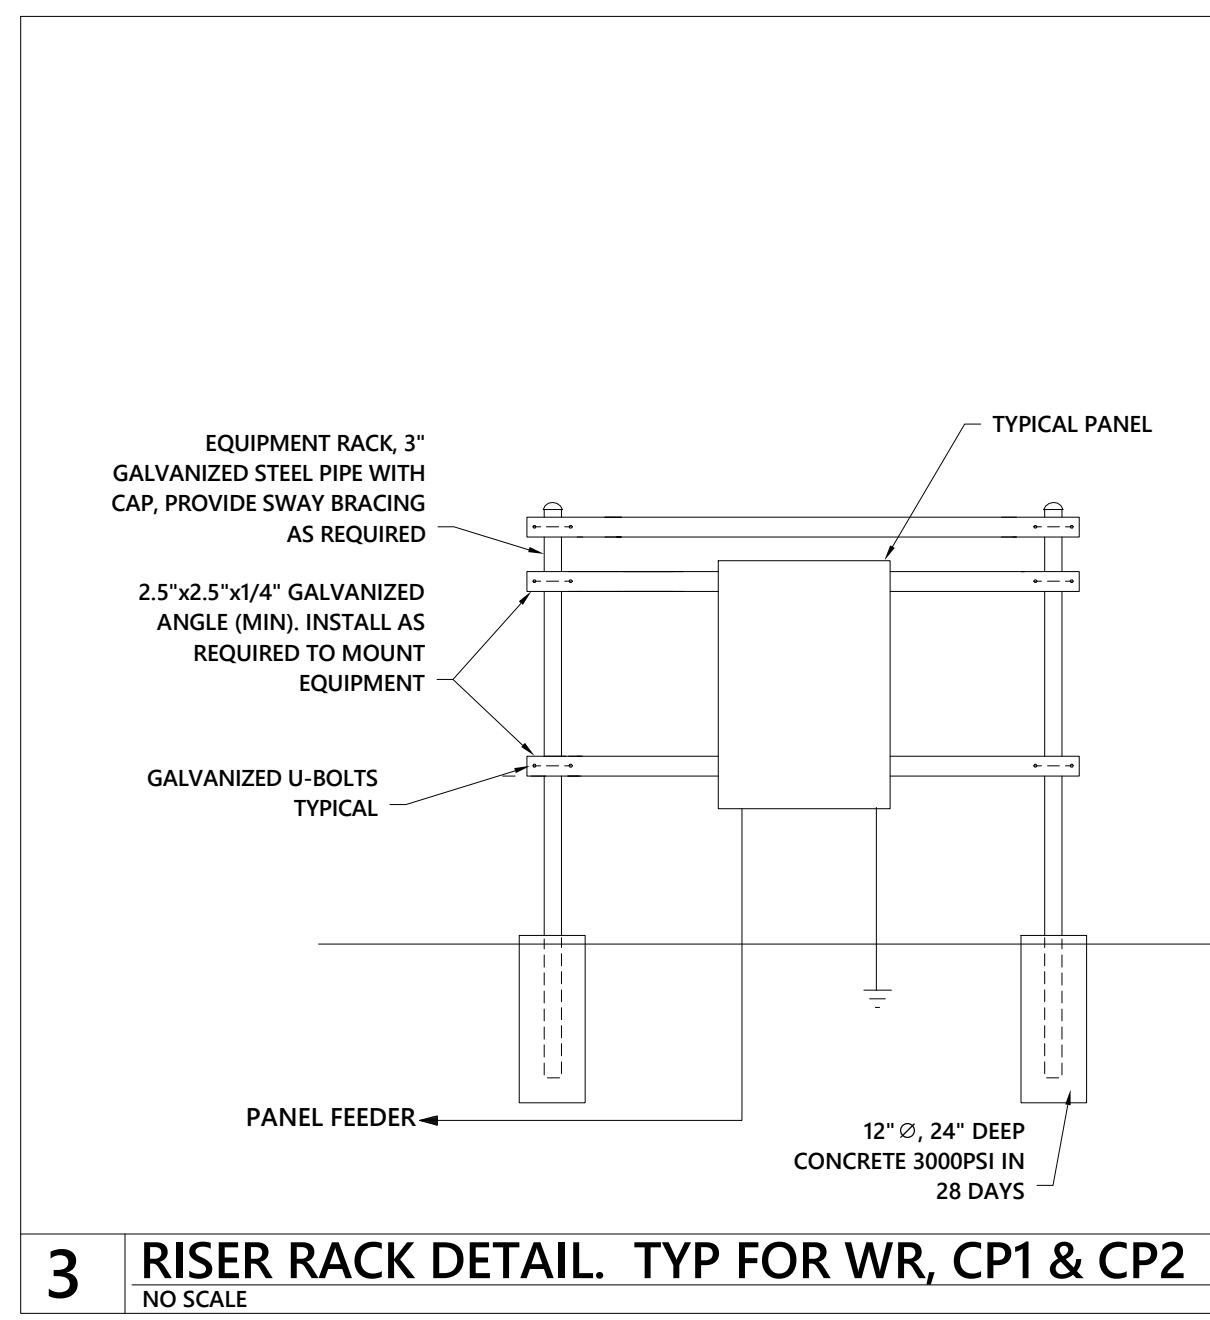

- TYPE OF METER ON "MDP" IS VERIFIED WITH OWNER PRIOR TO ORDERING. BASIS OF DESIGN IS "CUTLER HAMMER" IQ-250 OR EQUAL. METERS ARE SHOWN AS "MTR". COORDINATE COMMUNICATION PROTOCOL WITH M.C. PRIOR TO ORDERING.
- FEEDERS THAT ARE REQUIRED TO BE CONCRETE ENCASED ARE TO BE CONCRETE ENCASED UNTIL TERMINATION POINT, INCLUDING UNDER BUILDING SLABS. EXCAVATION WILL BE REQUIRED IN EXISTING MAIN ELECTRICAL ROOM.
- PROVIDE CONCRETE PAD FOR INDOOR TRANSFORMER. PAD SPECS ARE TO BE COORDINATED WITH TRANSFORMER MANUFACTURER.
- MOTOR(S), CONTROLLER(S), AND ASSOCIATED ACCESSORIES FOR THE FIRE PUMP SYSTEM SHALL BE LISTED FOR FIRE PROTECTION SERVICE. COORDINATE EXACT SIZING REQUIREMENTS WITH MANUFACTURER. ADJUST BREAKER/FUSE/WIRING SIZING AS REQUIRED BASE ON THE MANUFACTURER'S REQUIREMENTS.
- FIRE/JOCKEY PUMPS CONTROLLER DISCONNECTS SHALL BE LISTED FOR USE AS SERVICE ENTRANCE EQUIPMENT. LOCKABLE IN THE "ON" POSITION. LABELLED PER NEC 905-400(3) AND SUPERVISED IN THE CLOSED POSITION BY THE FIRE ALARM CONTROL PANEL. LOCATE DISCONNECTS ADJACENT TO FIRE/JOCKEY PUMPS CONTROLLER.

1 POWER RISER DIAGRAM
1/8" = 1'-0"

MEMBERS OF THE AMERICAN INSTITUTE OF ARCHITECTS

COPYRIGHT 2016 ALL RIGHTS RESERVED PRINTED OR ELECTRONIC DRAWINGS AND DOCUMENTATION MAY NOT BE REPRODUCED IN ANY FORM WITHOUT WRITTEN PERMISSION FROM LS3P ASSOCIATES LTD.


REVISIONS:

No.	Description	Date
1	Addendum #4	8.28.2017

PROJECT: 9202-164730
SCO ID: 16-15656-02B
ITEM: 315 CODE: 41526
DATE: AUGUST 21, 2017
DRAWN BY: J. Holcomb
CHECKED BY: M. Mazzone

POWER RISER
E-501

C:\Users\bmiller\Documents\16-0265_R16 MEP - BMiller.rvt 8/29/2017 8:46:25 AM

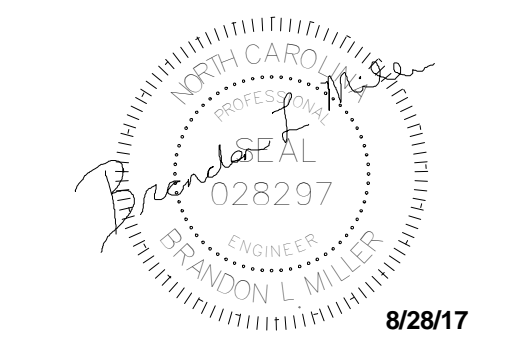

SWITCHBOARD: MDP VOLTAGE: 480Y/277 MOUNTING: FLOOR PHASE: 3 WIRE: 4 MANUFACTURER: MAIN: 1000A MCB TYPE: AIC: 65000

MAIN CB NOTES: 100% RATED MAIN BREAKER SHALL BE PROVIDED WITH ENERGY-REDUCING MAINTENANCE SWITCH WITH LOCAL INDICATOR. NEC 240.87(B) PROVIDE MAIN BREAKER SHALL BE PROVIDED WITH ADJUSTABLE LSI & GFI TRIP FUNCTIONS.

PANEL: R4 VOLTAGE: 208Y/120 MOUNTING: SURFACE MAIN: 200 A MFR: TYPE: AIC: 22,000 AMPS SYMMETRICAL

PANEL: RDP VOLTAGE: 208Y/120 MOUNTING: SURFACE MAIN: 200 A MFR: TYPE: AIC: 22,000 AMPS SYMMETRICAL

PANEL: R3 VOLTAGE: 208Y/120 MOUNTING: SURFACE MAIN: 200 A MFR: TYPE: AIC: 22,000 AMPS SYMMETRICAL

PANEL: R1 VOLTAGE: 208Y/120 MOUNTING: SURFACE MAIN: 800 A MFR: TYPE: AIC: 22,000 AMPS SYMMETRICAL

PANEL: R2 VOLTAGE: 208Y/120 MOUNTING: SURFACE MAIN: 200 A MFR: TYPE: AIC: 22,000 AMPS SYMMETRICAL

PANEL: R5 VOLTAGE: 208Y/120 MOUNTING: SURFACE MAIN: 200 A MFR: TYPE: AIC: 22,000 AMPS SYMMETRICAL


PANEL: R6 VOLTAGE: 208Y/120 MOUNTING: SURFACE MAIN: 200 A MFR: TYPE: AIC: 22,000 AMPS SYMMETRICAL

PANEL: RM VOLTAGE: 208Y/120 MOUNTING: SURFACE MAIN: 200 A MFR: TYPE: AIC: 22,000 AMPS SYMMETRICAL


LOAD Classification Connected Load Demand Factor Estimated Demand NOTES: LIGHTS 0.00 kVA 0.00% 0.00 kVA 1. BREAKER FRAME SHALL BE AS REQ'D PER PANEL AIC RATING.

LOAD Classification Connected Load Demand Factor Estimated Demand NOTES: LIGHTS 0.00 kVA 0.00% 0.00 kVA 1. BREAKER FRAME SHALL BE AS REQ'D PER PANEL AIC RATING.

LOAD Classification Connected Load Demand Factor Estimated Demand NOTES: LIGHTS 0.00 kVA 0.00% 0.00 kVA 1. BREAKER FRAME SHALL BE AS REQ'D PER PANEL AIC RATING.

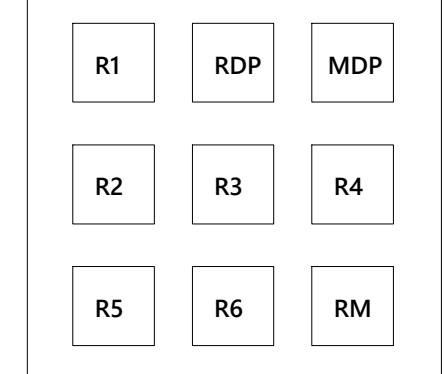

C:\Users\billmiller\Documents\16-0265_R10_MEP_BMiller.rvt 8/20/2017 8:46:33 AM

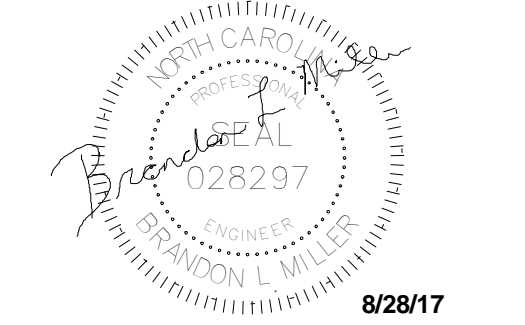

8/28/17

MEMBERS OF THE AMERICAN INSTITUTE OF ARCHITECTS

COPYRIGHT 2016 ALL RIGHTS RESERVED PRINTED OR ELECTRONIC DRAWINGS AND DOCUMENTATION MAY NOT BE REPRODUCED IN ANY FORM WITHOUT WRITTEN PERMISSION FROM LS3P ASSOCIATES LTD.

REVISIONS:

No.	Description	Date
1	Addendum #4	8.28.2017

PROJECT: 9202-164730
SCO ID: 16-15656-02B
ITEM: 315 CODE: 41526
DATE: AUGUST 21, 2017
DRAWN BY: J. Holcomb
CHECKED BY: M. Mazzone

PANEL SCHEDULES

E-603

PANEL: M2		VOLTAGE: 480Y/277 MOUNTING: SURFACE MAIN: 200 A		MAIN TYPE: MLO PHASE: 3 WIRE: 4		MFR: TYPE: AIC: 35,000 AMPS SYMMETRICAL						
LOAD SERVED	Wire Size	TRIP	POLE S	A	B	C	POLE S	TRIP	Wire Size	LOAD SERVED		
SPARE	-- 20 A	1	1	0.0	0.0		1	2	20 A	SPARE		
WH3	12 20 A	3	1	4.1	4.1		1	4	20 A	12 WH3		
WH3	12 20 A	7	1	4.1	0.7		3	8	20 A	12 P-5		
P-6	12 20 A	11	3			0.7	2.0		12	20 A 12 P-1		
P-2	12 20 A	17	3	2.0	2.0		2.0	2.0	12	20 A 12 P-7		
P-8	12 20 A	23	3			2.0	3.7		12	20 A 10 P-3		
P-4	10 25 A	29	3	3.7	3.7		3.7	2.0	10	25 A 12 JOCKEY PUMP		
SPARE	-- 20 A	33	1			0.0	0.0		1	36 20 A -- SPARE		
SPARE	-- 20 A	35	1			0.0	0.0		1	38 20 A -- SPARE		
SPARE	-- 20 A	37	1	0.0	0.0				1	40 20 A -- SPARE		
SPARE	-- 20 A	39	1			0.0	0.0		1	42 20 A -- SPARE		
SPARE	-- 20 A	41	1			0.0	0.0		1	42 20 A -- SPARE		
LOAD	Connected Load	Demand Factor	Estimated Demand	NOTES:								
LIGHTS	0.00 kVA	0.00%	0.00 kVA	1. BREAKER FRAME SHALL BE AS REQ'D PER PANEL AIC RATING.								
HEATING	0.00 kVA	0.00%	0.00 kVA	2. SHALL BE FULLY RATED - SERIES RATINGS NOT ALLOWED.								
COOLING	0.00 kVA	0.00%	0.00 kVA	3. ALL BUSSING, INCL GND AND NEUTRAL, SHALL BE COPPER.								
VENTILATION	0.00 kVA	0.00%	0.00 kVA	4. ALL INCOMING PANEL & BRKR LUGS SHALL MATCH FEEDERS.								
MOTORS	56.74 kVA	104.91%	59.53 kVA	5. PROVIDE HINGED DOOR-IN-DOOR WITH OUTER DOOR LOCK.								
KITCHEN	0.00 kVA	0.00%	0.00 kVA	6. PROVIDE METAL DIRECTORY FRAME.								
RECEPTACLES	0.00 kVA	0.00%	0.00 kVA	7. ** - SEE POWER RISER DIAGRAM FOR WIRE SIZE								
WATER HEATER	21.30 kVA	100.00%	21.30 kVA									
MISC.	0.00 kVA	0.00%	0.00 kVA									
SPARE	0.00 kVA	0.00%	0.00 kVA									
TOTAL KVA (CONNECTED):	78.0 kVA	TOTAL PER PHASE: (CONNECTED)										
TOTAL KVA (DEMAND):	80.8 kVA	83 A	100 A	103 A								
TOTAL AMP. (CONNECTED):	94 A	TOTAL PER PHASE: (CONNECTED @ 125%)										
TOTAL AMP. (DEMAND):	97 A	104 A	125 A	129 A								


PANEL: M1		VOLTAGE: 480Y/277 MOUNTING: SURFACE MAIN: 200 A		MAIN TYPE: MLO PHASE: 3 WIRE: 4		MFR: TYPE: AIC: 35,000 AMPS SYMMETRICAL						
LOAD SERVED	Wire Size	TRIP	POLE S	A	B	C	POLE S	TRIP	Wire Size	LOAD SERVED		
PANEL "M2"	** 200 A	1	3	23.0	0.5		3	4	20 A	F-3		
SPARE	-- 20 A	9	3	0.0	3.7		3	10	20 A	12 RAF-1		
BP1	10 30 A	15	3	4.0	0.0		3	16	20 A	-- SPARE		
AHU-1	6 50 A	21	3	7.2	7.2		3	22	50 A	6 AHU-1		
SPARE	-- 20 A	25	1	0.0	0.0		1	26	20 A	-- SPARE		
SPARE	-- 20 A	27	1			0.0	0.0		1	28 20 A -- SPARE		
SPARE	-- 20 A	29	1			0.0	0.0		1	30 20 A -- SPARE		
SPARE	-- 20 A	31	1	0.0	0.0		1	32	20 A	-- SPARE		
SPARE	-- 20 A	33	1			0.0	0.0		1	34 20 A -- SPARE		
SPARE	-- 20 A	35	1			0.0	0.0		1	36 20 A -- SPARE		
SPARE	-- 20 A	37	1	0.0	0.0		1	38	20 A	-- SPARE		
SPARE	-- 20 A	39	1			0.0	0.0		1	40 20 A -- SPARE		
SPARE	-- 20 A	41	1			0.0	0.0		1	42 20 A -- SPARE		
LOAD	Connected Load	Demand Factor	Estimated Demand	NOTES:								
LIGHTS	0.00 kVA	0.00%	0.00 kVA	1. BREAKER FRAME SHALL BE AS REQ'D PER PANEL AIC RATING.								
HEATING	0.00 kVA	0.00%	0.00 kVA	2. SHALL BE FULLY RATED - SERIES RATINGS NOT ALLOWED.								
COOLING	0.00 kVA	0.00%	0.00 kVA	3. ALL BUSSING, INCL GND AND NEUTRAL, SHALL BE COPPER.								
VENTILATION	43.14 kVA	100.00%	43.14 kVA	4. ALL INCOMING PANEL & BRKR LUGS SHALL MATCH FEEDERS.								
MOTORS	81.43 kVA	103.72%	84.46 kVA	5. PROVIDE HINGED DOOR-IN-DOOR WITH OUTER DOOR LOCK.								
KITCHEN	0.00 kVA	0.00%	0.00 kVA	6. PROVIDE METAL DIRECTORY FRAME.								
RECEPTACLES	0.00 kVA	0.00%	0.00 kVA	7. ** - SEE POWER RISER DIAGRAM FOR WIRE SIZE								
WATER HEATER	21.30 kVA	100.00%	21.30 kVA									
MISC.	0.00 kVA	0.00%	0.00 kVA									
SPARE	0.00 kVA	0.00%	0.00 kVA									
TOTAL KVA (CONNECTED):	145.9 kVA	TOTAL PER PHASE: (CONNECTED)										
TOTAL KVA (DEMAND):	148.9 kVA	165 A	182 A	185 A								
TOTAL AMP. (CONNECTED):	175 A	TOTAL PER PHASE: (CONNECTED @ 125%)										
TOTAL AMP. (DEMAND):	179 A	206 A	227 A	231 A								

PANEL: S1RA		VOLTAGE: 208Y/120 MOUNTING: SURFACE MAIN: 200 A		MAIN TYPE: MCB PHASE: 3 WIRE: 4		MFR: TYPE: AIC: 10,000 AMPS SYMMETRICAL						
LOAD SERVED	Wire Size	TRIP	POLE S	A	B	C	POLE S	TRIP	Wire Size	LOAD SERVED		
GARAGE DOOR - 132	12 20 A	1	1	1.5	0.0		1	2	20 A	12 GARAGE DOOR - 131C		
SPARE	-- 20 A	3	1			0.0	0.0		1	4 20 A -- SPARE		
SPARE	-- 20 A	5	1			0.0	0.0		1	6 20 A -- SPARE		
SPARE	-- 20 A	7	1	0.0	0.0		1	8	20 A	-- SPARE		
SPARE	-- 20 A	9	1			0.0	0.0		1	10 20 A -- SPARE		
SPARE	-- 20 A	11	1			0.0	0.0		1	12 20 A -- SPARE		
SPARE	-- 20 A	13	1	0.0	0.0		1	14	20 A	-- SPARE		
SPARE	-- 20 A	15	1			0.0	0.0		1	16 20 A -- SPARE		
SPARE	-- 20 A	17	1			0.0	0.0		1	18 20 A -- SPARE		
SPARE	-- 20 A	19	1	0.0	0.0		1	20	20 A	-- SPARE		
SPARE	-- 20 A	21	1			0.0	0.0		1	22 20 A -- SPARE		
SPARE	-- 20 A	23	1			0.0	0.0		1	24 20 A -- SPARE		
SPARE	-- 20 A	25	1	0.0	0.0		1	26	20 A	-- SPARE		
SPARE	-- 20 A	27	1			0.0	0.0		1	28 20 A -- SPARE		
SPARE	-- 20 A	29	1			0.0	0.0		1	30 20 A -- SPARE		
SPARE	-- 20 A	31	1	0.0	0.0		1	32	20 A	-- SPARE		
SPARE	-- 20 A	33	1			0.0	0.0		1	34 20 A -- SPARE		
SPARE	-- 20 A	35	1			0.0	0.0		1	36 20 A -- SPARE		
SPARE	-- 20 A	37	1	0.0	0.0		1	38	20 A	-- SPARE		
SPARE	-- 20 A	39	1			0.0	0.0		1	40 20 A -- SPARE		
SPARE	-- 20 A	41	1			0.0	0.0		1	42 20 A -- SPARE		
LOAD	Connected Load	Demand Factor	Estimated Demand	NOTES:								
LIGHTS	0.00 kVA	0.00%	0.00 kVA	1. BREAKER FRAME SHALL BE AS REQ'D PER PANEL AIC RATING.								
HEATING	0.00 kVA	0.00%	0.00 kVA	2. SHALL BE FULLY RATED - SERIES RATINGS NOT ALLOWED.								
COOLING	0.00 kVA	0.00%	0.00 kVA	3. ALL BUSSING, INCL GND AND NEUTRAL, SHALL BE COPPER.								
VENTILATION	0.00 kVA	0.00%	0.00 kVA	4. ALL INCOMING PANEL & BRKR LUGS SHALL MATCH FEEDERS.								
MOTORS	1.50 kVA	125.00%	1.88 kVA	5. PROVIDE HINGED DOOR-IN-DOOR WITH OUTER DOOR LOCK.								
KITCHEN	0.00 kVA	0.00%	0.00 kVA	6. PROVIDE METAL DIRECTORY FRAME.								
RECEPTACLES	0.00 kVA	0.00%	0.00 kVA	7. ** - SEE POWER RISER DIAGRAM FOR WIRE SIZE								
WATER HEATER	0.00 kVA	0.00%	0.00 kVA									
MISC.	0.00 kVA	0.00%	0.00 kVA									
SPARE	0.00 kVA	0.00%	0.00 kVA									
TOTAL KVA (CONNECTED):	1.5 kVA	TOTAL PER PHASE: (CONNECTED)										
TOTAL KVA (DEMAND):	1.9 kVA	13 A	0 A	0 A								
TOTAL AMP. (CONNECTED):	4 A	TOTAL PER PHASE: (CONNECTED @ 125%)										
TOTAL AMP. (DEMAND):	5 A	16 A	0 A	0 A								

PANEL: S2RA		VOLTAGE: 208Y/120 MOUNTING: SURFACE MAIN: 200 A		MAIN TYPE: MLO PHASE: 3 WIRE: 4		MFR: TYPE: AIC: 10,000 AMPS SYMMETRICAL					
LOAD SERVED	Wire Size	TRIP	POLE S	A	B	C	POLE S	TRIP	Wire Size	LOAD SERVED	
DEDICATED RECEPTACLE - SHOP 131A	12 20 A	1	1	0.5	0.5		1	2	20 A	12 RECEPTACLES - OFFICE 131A1	
RECEPTACLES - SHOP 131A	12 20 A	3	1			1.0	1.1		1	4 20 A 12 RECEPTACLES - EXTERIOR	
CEILING CORD REEL - SHOP 131A	12 20 A	5	1			0.5	0.7		1	6 20 A 12 RECEPTACLES - SHOP 131A	
FLOOR BOX - SHOP 131A	12 20 A	7	1	0.7	0.9				1	8 20 A 12 RECEPTACLES - EXTERIOR	
DEDICATED RECEPTACLE - SHOP 131A	12 20 A	9	1			0.2	2.1		2	10 30 A 10 RECEPTACLES DED - SHOP 131A	
RECEPTACLES - SHOP 131A	12 20 A	11	1				0.9	2.1	1	14 20 A 12 DEDICATED RECEPTACLE - SHOP 131A	
RECEPTACLE - SHOP 131A	12 20 A	13	1	1.5	0.2				1	16 20 A 12 PLOTTER - SHOP 131A	
DEDICATED RECEPTACLE - SHOP 131A	12 20 A	15	1			0.5	1.0		1	18 20 A 12 DEDICATED RECEPTACLE - SHOP 131A	
DEDICATED RECEPTACLE - SHOP 131A	12 20 A	17	1			0.2	0.5		1	20 20 A 12 DEDICATED RECEPTACLE - SHOP 131A	
DEDICATED RECEPTACLE - SHOP 131A	12 20 A	19	1	0.5	1.0				1	22 20 A 12 DEDICATED RECEPTACLE - SHOP 131A	
DEDICATED RECEPTACLE - SHOP 131A	12 20 A	21	1			1.0	1.0		1	24 20 A 12 DEDICATED RECEPTACLE - SHOP 131A	
RECEPTACLES - KEY SUIT 131A1	12 20 A	23	1						1	24 20 A -- SPARE	
DEDICATED RECEPTACLE - SHOP 131A	12 20 A	25	1	1.0	0.0				1	26 20 A -- SPARE	
SPARE	-- 20 A	27	1			0.0	0.0		1	28 20 A -- SPARE	
SPARE	-- 20 A	29	1			0.0	0.0		1	30 20 A -- SPARE	
SPARE	-- 20 A	31	1	0.0	0.0				1	32 20 A -- SPARE	
SPARE	-- 20 A	33	1			0.0	0.0		1	34 20 A -- SPARE	
SPARE	-- 20 A	35	1			0.0	0.0		1	36 20 A -- SPARE	
SPARE	-- 20 A	37	1	0.0	0.0				1	38 20 A -- SPARE	
SPARE	-- 20 A	39	1			0.0	0.0		1	40 20 A -- SPARE	
SPARE	-- 20 A	41	1			0.0	1.0		1	42 20 A 8 MANHOLE SUMP PUMP	
LOAD	Connected Load	Demand Factor	Estimated Demand	NOTES:							
LIGHTS	0.00 kVA	0.00%	0.00 kVA	1. BREAKER FRAME SHALL BE AS REQ'D PER PANEL AIC RATING.							
HEATING	0.00 kVA	0.00%	0.00 kVA	2. SHALL BE FULLY RATED - SERIES RATINGS NOT ALLOWED.							
COOLING	0.00 kVA	0.00%	0.00 kVA	3. ALL BUSSING, INCL GND AND NEUTRAL, SHALL BE COPPER.							
VENTILATION	0.00 kVA	0.00%	0.00 kVA	4. ALL INCOMING PANEL & BRKR LUGS SHALL MATCH FEEDERS.							
MOTORS	0.00 kVA	0.00%	0.00 kVA	5. PROVIDE HINGED DOOR-IN-DOOR WITH OUTER DOOR LOCK.							
KITCHEN	0.00 kVA	0.00%	0.00 kVA	6. PROVIDE METAL DIRECTORY FRAME.							
RECEPTACLES	9.74 kVA	100.00%	9.74 kVA	7. NOT USED							
WATER HEATER	0.00 kVA	0.00%	0.00 kVA								

PRE-BID MEETING

AUGUST 29, 2017

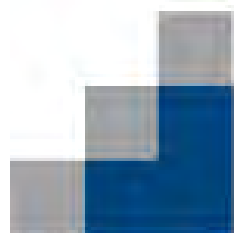

New Atlantic

CONTRACTING, INC.

AGENDA

- **Introduction of Team**
- **Project Overview**
- **Issuance of Construction Documents**
- **Bid Packages**
- **Important Preconstruction Dates**
- **HUB Participation Requirements**
- **Project Schedule / Milestone Dates**
- **Questions**

INTRODUCTION OF THE TEAM

UNC CHARLOTTE

Brian Kugler – Senior Project Manager

Doug Walters – Construction Manager

Dorothy Vick – HUB Coordinator

CONSTRUCTION MANAGER

Glenn Wise – Preconstruction Director

Grady Dwiggin – Project Engineer

Joe Crompton – Senior Project Manager

Chris Zananiri – Project Director

Steve Tabor – Project Superintendent

DESIGNERS

LS3P – *Sharon Huot* AIA, CDT, LEED AP

LS3P – *Krissy Ferguson* AIA, CDT, LEED AP

LAND DESIGN – Civil

SKA ENGINEERS – Structural

OPTIMA ENGINEERING – MEPF Engineer

KIMLEY HORN – Road Improvement

PROJECT OVERVIEW

EARLY SITE / STRUCTURAL PHASE

- 13 acres - *Currently underway*
- Site Demolition, Clearing, Grading, Utilities, Asphalt Paving, Curb & Gutter, Site Concrete, Building Concrete, Structural Steel, etc.

BUILDING PHASE


- Site Fencing, Polished Concrete, Masonry, Casework/Countertops, Waterproofing/Air Barriers, Joint Sealants, Roofing, Gutters & Downspouts, Doors/Frames/Hardware, Overhead Doors, Loading Dock Equipment, Storefront, Glass & Glazing, Gypsum Board Assemblies, Acoustical Ceilings, Tile, Carpet, VCT, LVT, Painting, Specialties, Signage, Metal Lockers, Window Treatments, Pre-Engineered Metal Buildings, Fire Protection, Plumbing, HVAC, Test & Balance, Electrical, Security, Fire Alarm, Telecom.




Project
Located North
of Lot 25,
across Poplar
Lane from the
North Deck




FACILITIES OPERATIONS AND PARKING SERVICES COMPLEX BUILDING PHASE

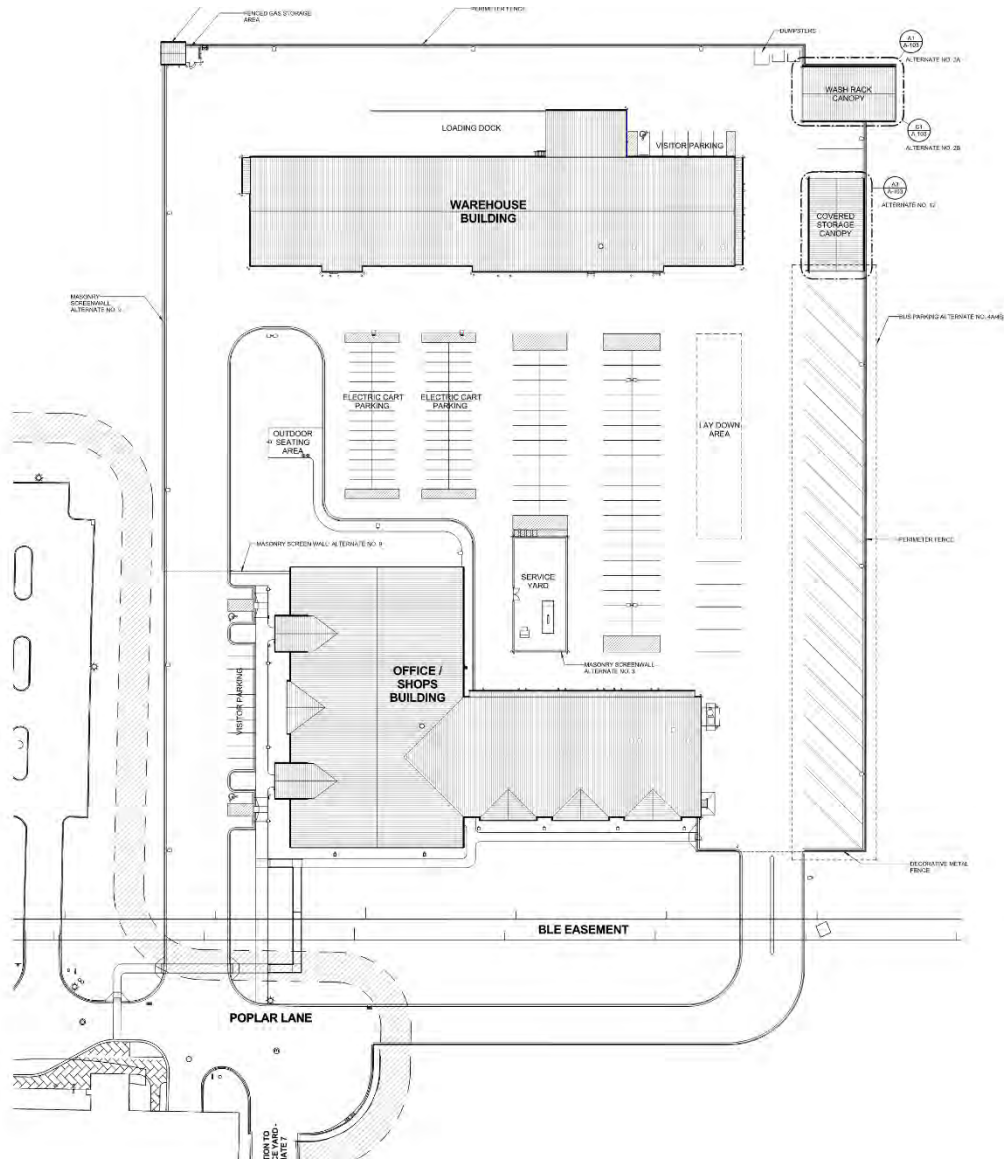

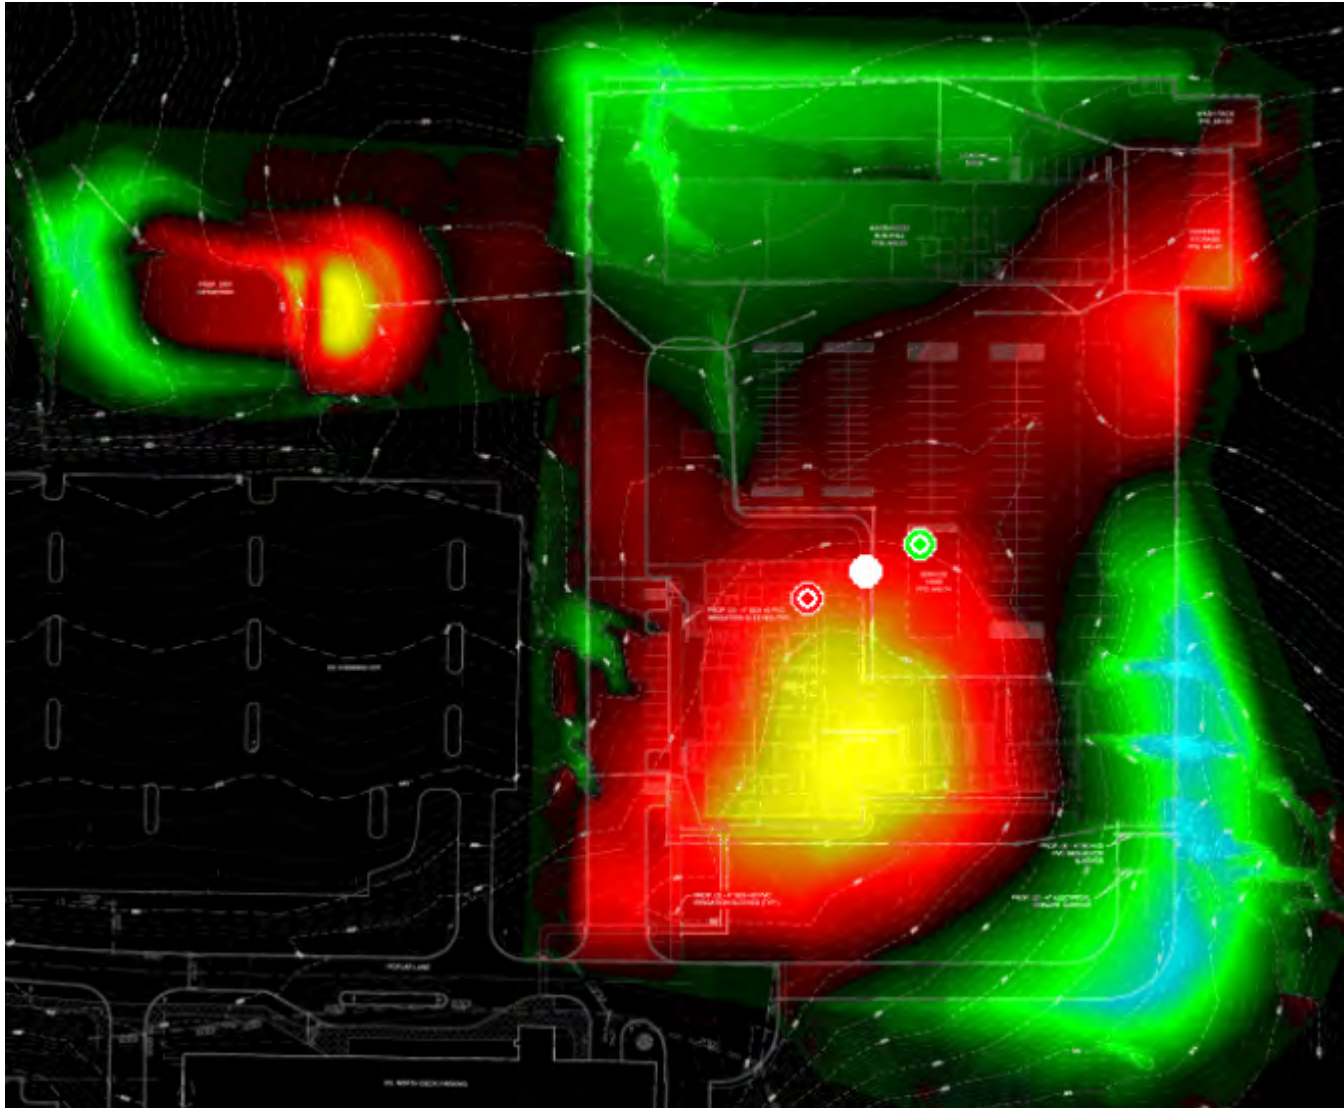


FACILITIES OPERATIONS AND PARKING SERVICES COMPLEX BUILDING PHASE

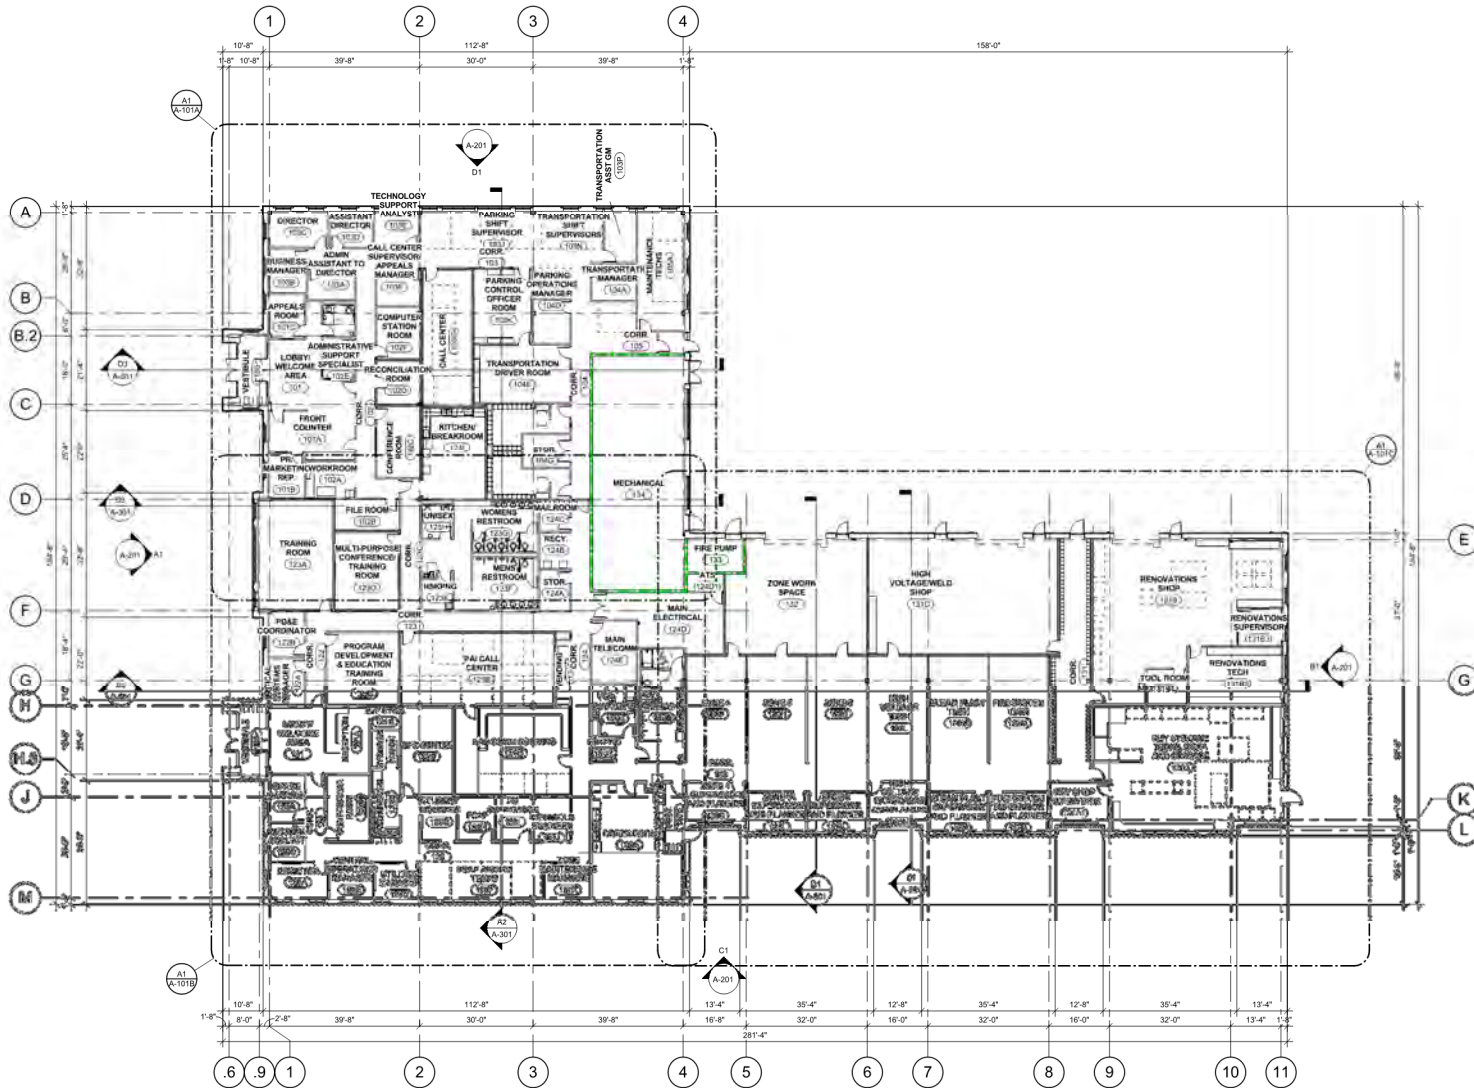


A1 OFFICE/SHOPS BUILDING OVERALL FLOOR PLAN
1/8" = 1'-0"


FACILITIES OPERATIONS AND PARKING SERVICES COMPLEX BUILDING PHASE

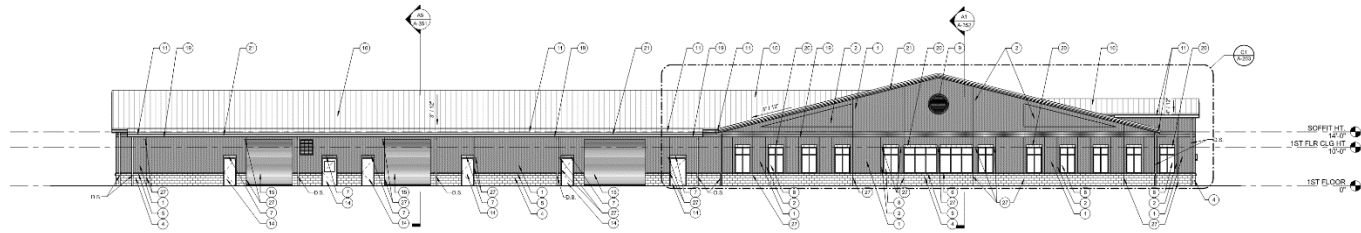

D1 NORTH - OFFICE/SHOPS
3/20' = 1/8"

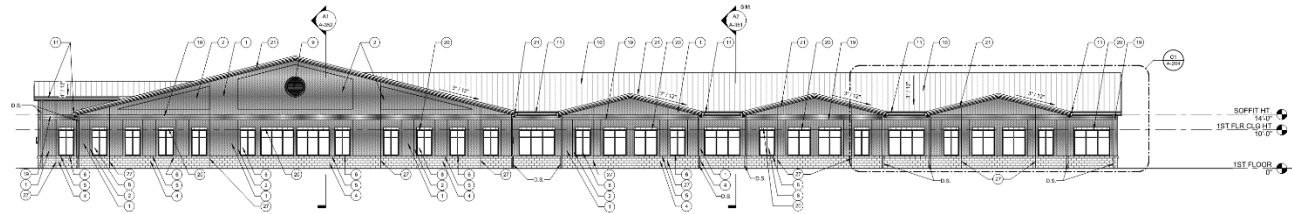


C1 SOUTH - OFFICE/SHOPS
3/20' = 1/8"

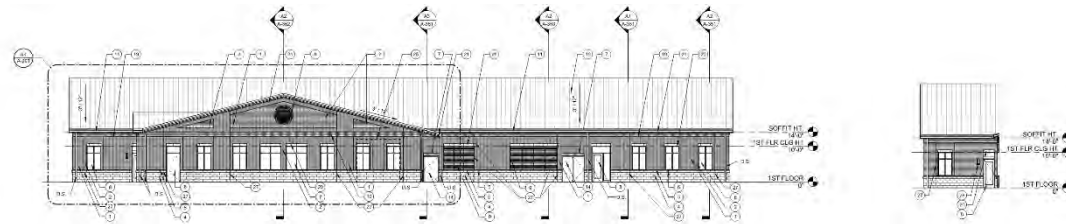


B1 EAST - OFFICE/SHOPS
3/20' = 1/8"

B4 EAST - PARTIAL ELEV AT DOOR 130EA
3/20' = 1/8"

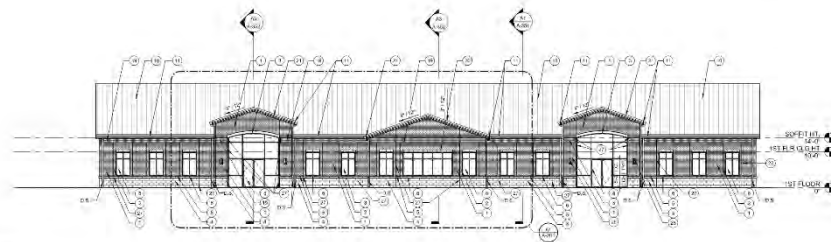


A1 WEST - OFFICE/SHOPS
3/20' = 1/8"

FACILITIES OPERATIONS AND PARKING SERVICES COMPLEX BUILDING PHASE

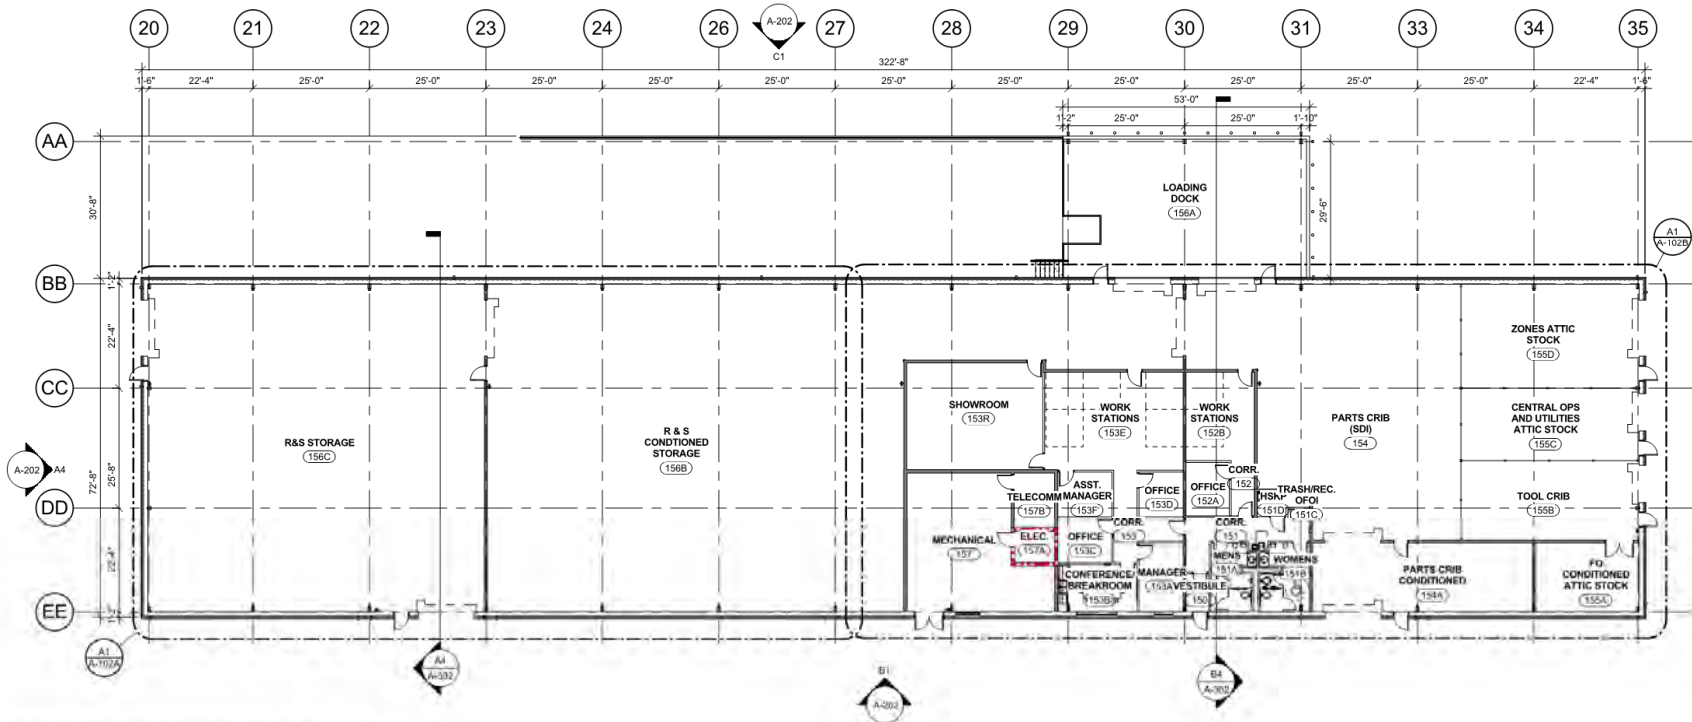


A1 WAREHOUSE OVERALL FLOOR PLAN
1/16" = 1'-0"


FACILITIES OPERATIONS AND PARKING SERVICES COMPLEX BUILDING PHASE

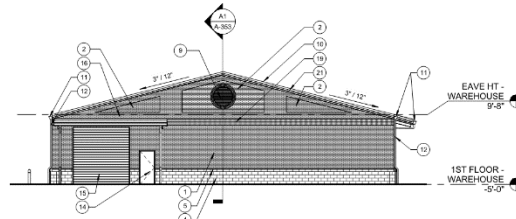


D3 WEST - WAREHOUSE - ALTERNATE NO. 1
332' x 1'-0"

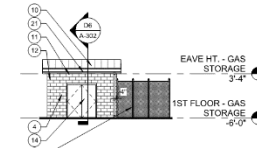


D5 SOUTH - GAS STORAGE
332' x 1'-0"

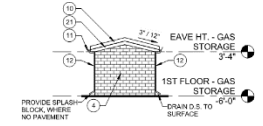


D6 WEST - GAS STORAGE
332' x 1'-0"

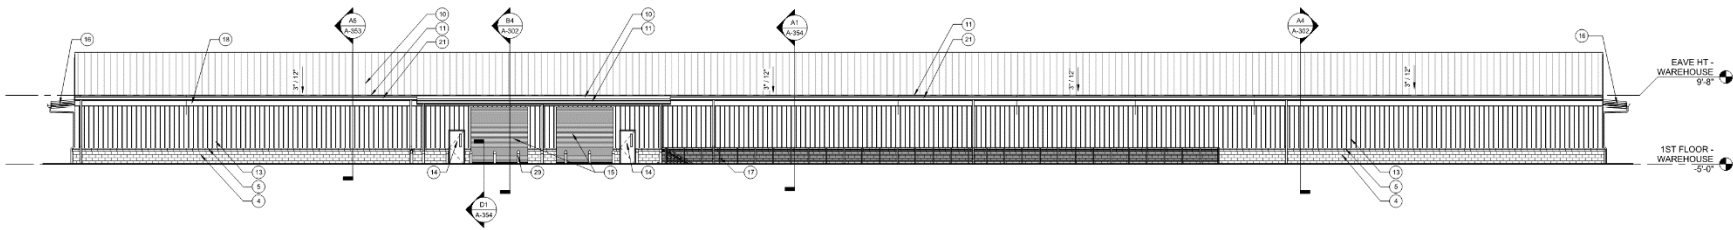


C1 NORTH - WAREHOUSE
332' x 1'-0"

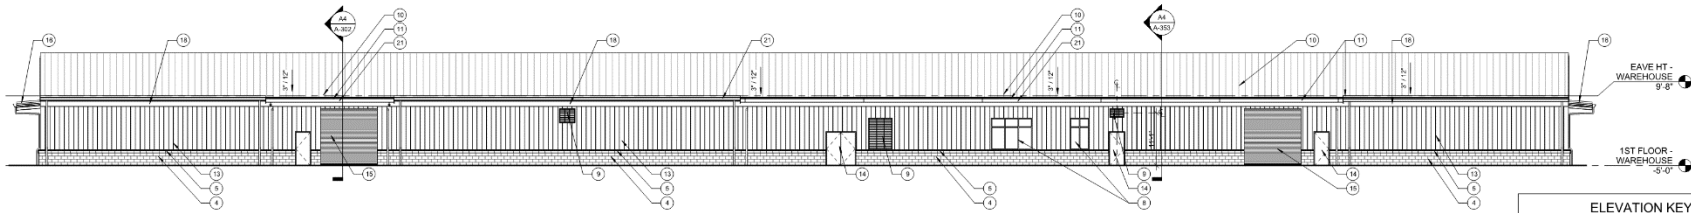

B1 SOUTH - WAREHOUSE
332' x 1'-0"

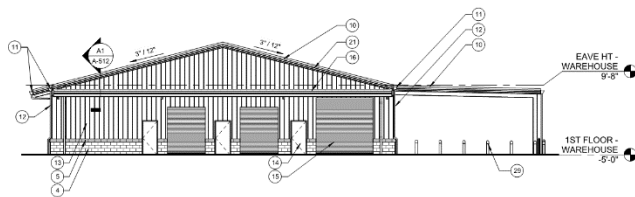

A1 EAST - WAREHOUSE
332' x 1'-0"










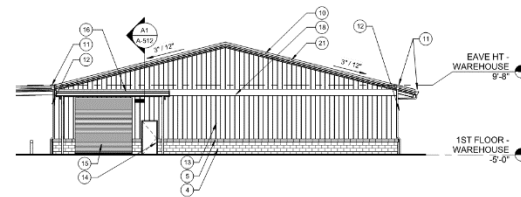


A4 WEST - WAREHOUSE
332' x 1'-0"
















ELEVATION KEYED NOTES

- (1) FACE BRICK - RUNNING BOND
- (2) 1" RECESSED FACE BRICK - RUNNING BOND
- (3) CAST STONE LINTEL - SPINAL COLOR TO BE APPROVED BY ARCHITECT
- (4) SHOTBLASTED CMU - RUNNING BOND
- (5) SHOTBLASTED CMU WATERTABLE
- (6) SHOTBLASTED CMU SILL
- (7) BRICK SOLDIER COURSE HEADER
- (8) ALUMINUM STOREFRONT
- (9) ALUMINUM LOUVERS
- (10) STANDING SEAM METAL ROOF
- (11) 6 1/2" W x 3" H ALUMINUM GUTTER, PREFINISHED
- (12) 2 3/4" x 4 1/4" ALUMINUM DOWNSPOUT, PREFINISHED
- (13) METAL PANEL (VERTICAL, DIRECTICAL), PREFINISHED
- (14) INSULATED HM DOOR AND FRAME
- (15) INSULATED OVERHEAD DOOR
- (16) PRE-ENGINEERED METAL CANOPY
- (17) GUARDRAIL, RE: CIVIL
- (18) METAL PANEL TRIM
- (19) DOUBLE SOLDIER COURSE FACE BRICK
- (20) CAST STONE HEADER
- (21) PREFINISHED ALUM FASCIA AND VENTED SOFFIT
- (22) HM DOOR AND FRAME
- (23) OVERHEAD DOOR
- (24) PRE-ENGINEERED METAL CANOPY, FASCIA AND TRIM
- (25) CHAINLINK FENCE, RE: CIVIL
- (26) DUST COLLECTOR, RE: MECH
- (27) CONTROL JOINT, REFER TO CE AND DE ON A-802
- (28) EXTERIOR LIGHT, RE: ELECTRICAL
- (29) BOLLARD, RE: CIVIL

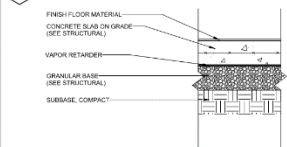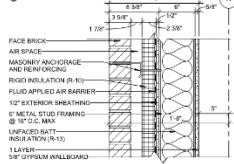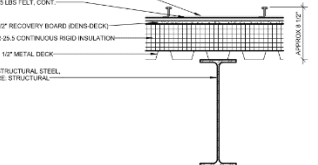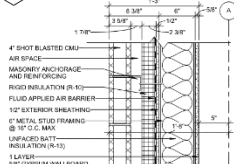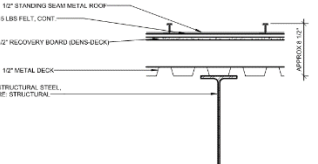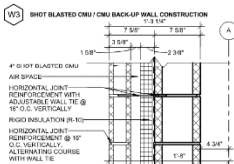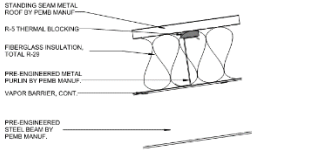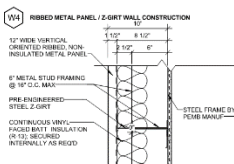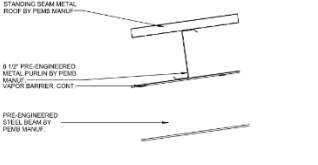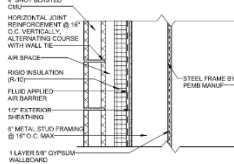
Exterior Walls & Roofing

CONSTRUCTION SUBSYSTEMS			CONSTRUCTION SUBSYSTEMS			CONSTRUCTION SUBSYSTEMS		
SYMBOL	DESCRIPTION	FIRE AND SOUND RATING REFERENCE	SYMBOL	DESCRIPTION	FIRE AND SOUND RATING REFERENCE	SYMBOL	DESCRIPTION	FIRE AND SOUND RATING REFERENCE
FLOOR SYSTEMS			EXTERIOR WALL SYSTEMS			ROOF SYSTEMS		
(S1)	TYPICAL SLAB ON GRADE CONSTRUCTION		(W1)	FACE BRICK / STEEL STUD CAVITY WALL CONSTRUCTION		(R1)	TYPICAL STANDING SEAM METAL ROOF CONSTRUCTION	
	 <p>FINISH FLOOR MATERIAL CONCRETE SLAB ON GRADE (SEE STRUCTURAL) VAPOR RETARDER GRANULAR BASE (SEE STRUCTURAL) SUBBASE, COMPACT</p>		 <p>FACE BRICK AIR SPACE MASONRY ANCHORAGE AND REINFORCING RIGID INSULATION (R-10) FLUID APPLIED AIR BARRIER 1/2" EXTERIOR SHEATHING 4" METAL STUD FRAMING @ 16" O.C. MAX. UNFACED BATT INSULATION (R-13) 1 LAYER 5/8" GYPSUM WALLBOARD</p>		 <p>1 1/2" STANDING SEAM METAL ROOF 15 LBS FELT, CONT. 1/2" RECOVERY BOARD (ENGINEER DECK) R-20.5 CONTINUOUS RIGID INSULATION 1 1/2" METAL DECK STRUCTURAL STEEL, RE STRUCTURAL</p>			
			(W2)	SHOT-BLASTED CMU / STEEL STUD CAVITY WALL CONSTRUCTION		(R1A)	TYPICAL STANDING SEAM METAL ROOF CONSTRUCTION	
			 <p>4" SHOT-BLASTED CMU AIR SPACE MASONRY ANCHORAGE AND REINFORCING RIGID INSULATION (R-10) FLUID APPLIED AIR BARRIER 1/2" EXTERIOR SHEATHING 4" METAL STUD FRAMING @ 16" O.C. MAX. UNFACED BATT INSULATION (R-13) 1 LAYER 5/8" GYPSUM WALLBOARD</p>		 <p>1 1/2" STANDING SEAM METAL ROOF 15 LBS FELT, CONT. 1/2" RECOVERY BOARD (ENGINEER DECK) 1 1/2" METAL DECK STRUCTURAL STEEL, RE STRUCTURAL</p>			
			(W3)	SHOT-BLASTED CMU / CMU BACKUP WALL CONSTRUCTION		(R2)	TYPICAL PRE-ENGINEERED METAL BLDG ROOF CONSTRUCTION	

			(W4)	RIBBED METAL PANEL / Z-GIRT WALL CONSTRUCTION		(R2A)	TYPICAL PRE-ENGINEERED METAL BLDG ROOF CONSTRUCTION	
			(W5)	SHOT-BLASTED CMU / Z-GIRT WALL CONSTRUCTION				
			 <p>4" SHOT-BLASTED CMU HORIZONTAL JOINT REINFORCEMENT @ 16" O.C. VERTICALLY, ALTERNATING COURSE WITH WALL TIE AIR SPACE RIGID INSULATION (R-10) FLUID APPLIED AIR BARRIER 1/2" EXTERIOR SHEATHING 4" METAL STUD FRAMING @ 16" O.C. MAX. 1 LAYER 5/8" GYPSUM WALLBOARD STEEL FRAME BY PEMB MANUF.</p>					

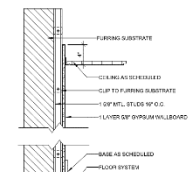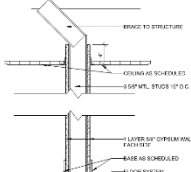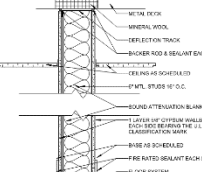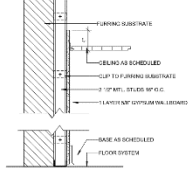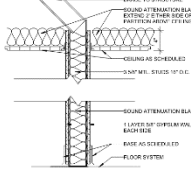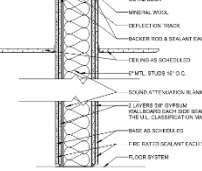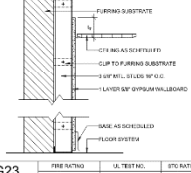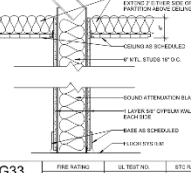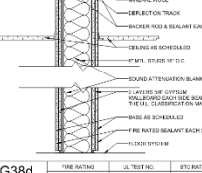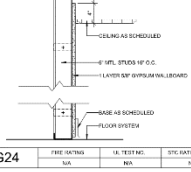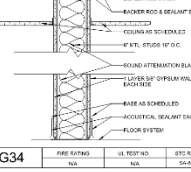
Interior Partitions

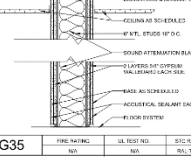		
		
		
		
		



Frames, Storefront, Glass, & Louvers

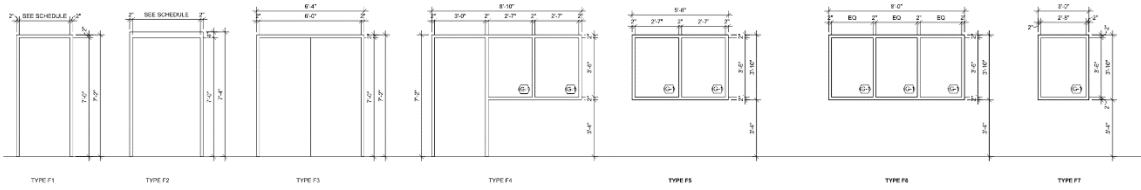

HOLLOW METAL FRAME ELEVATIONS
3/8" = 1'-0"








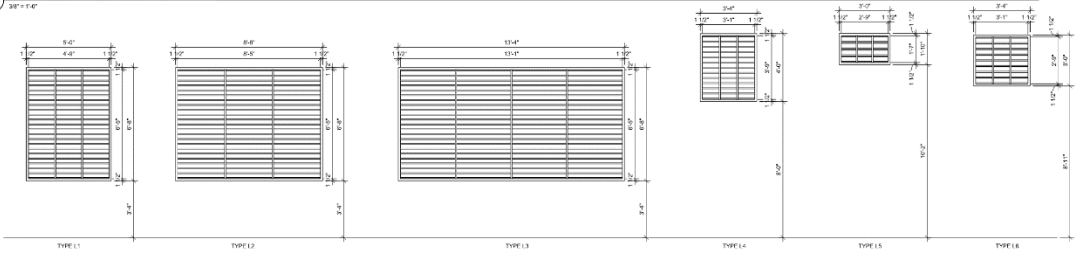


LOUVER ELEVATIONS
3/8" = 1'-0"

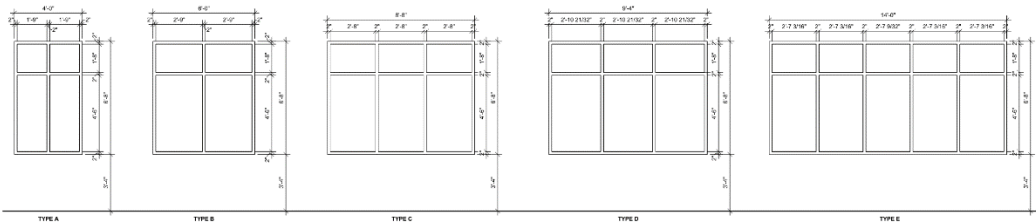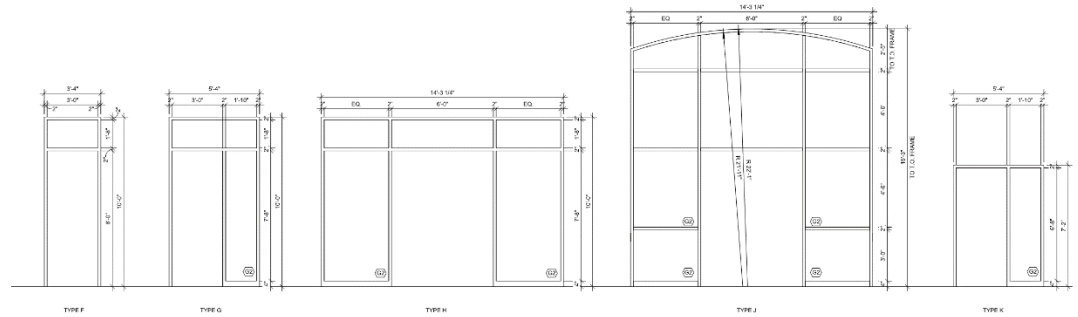

ALUMINUM STOREFRONT ELEVATIONS
3/8" = 1'-0"


Interior Elevations

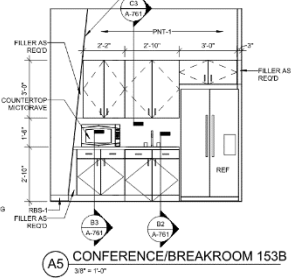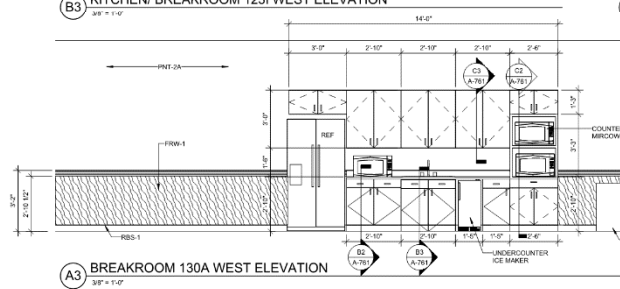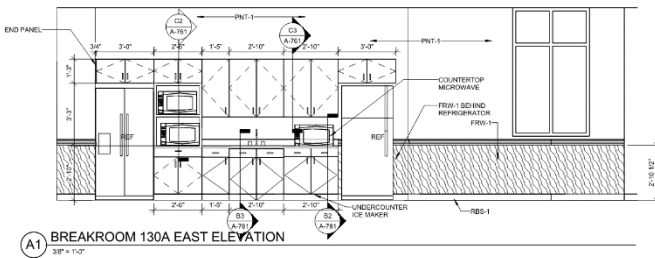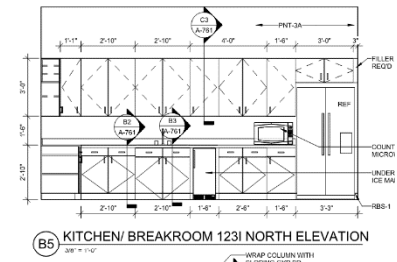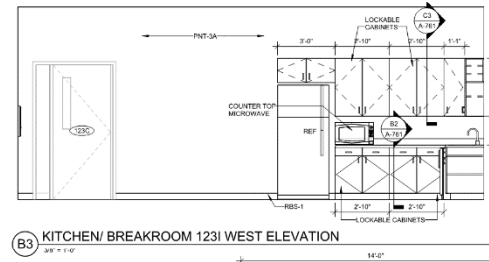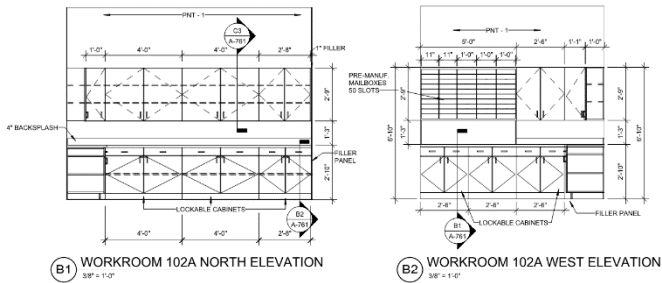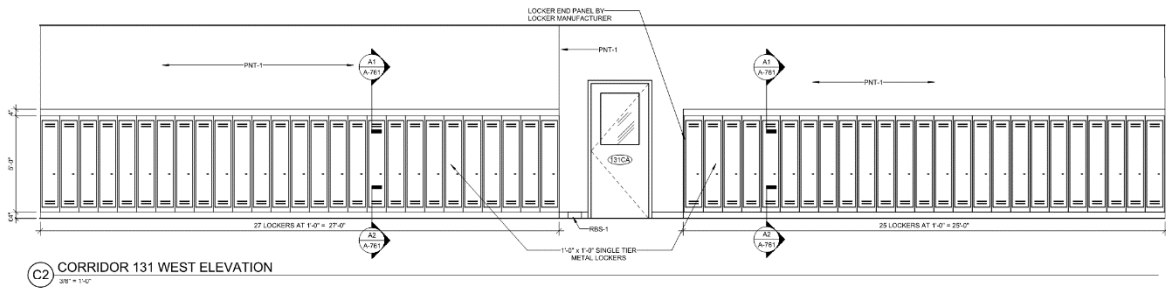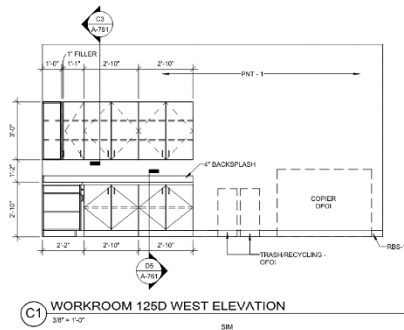


Plumbing – Office/Shops




Plumbing – Office/Shops

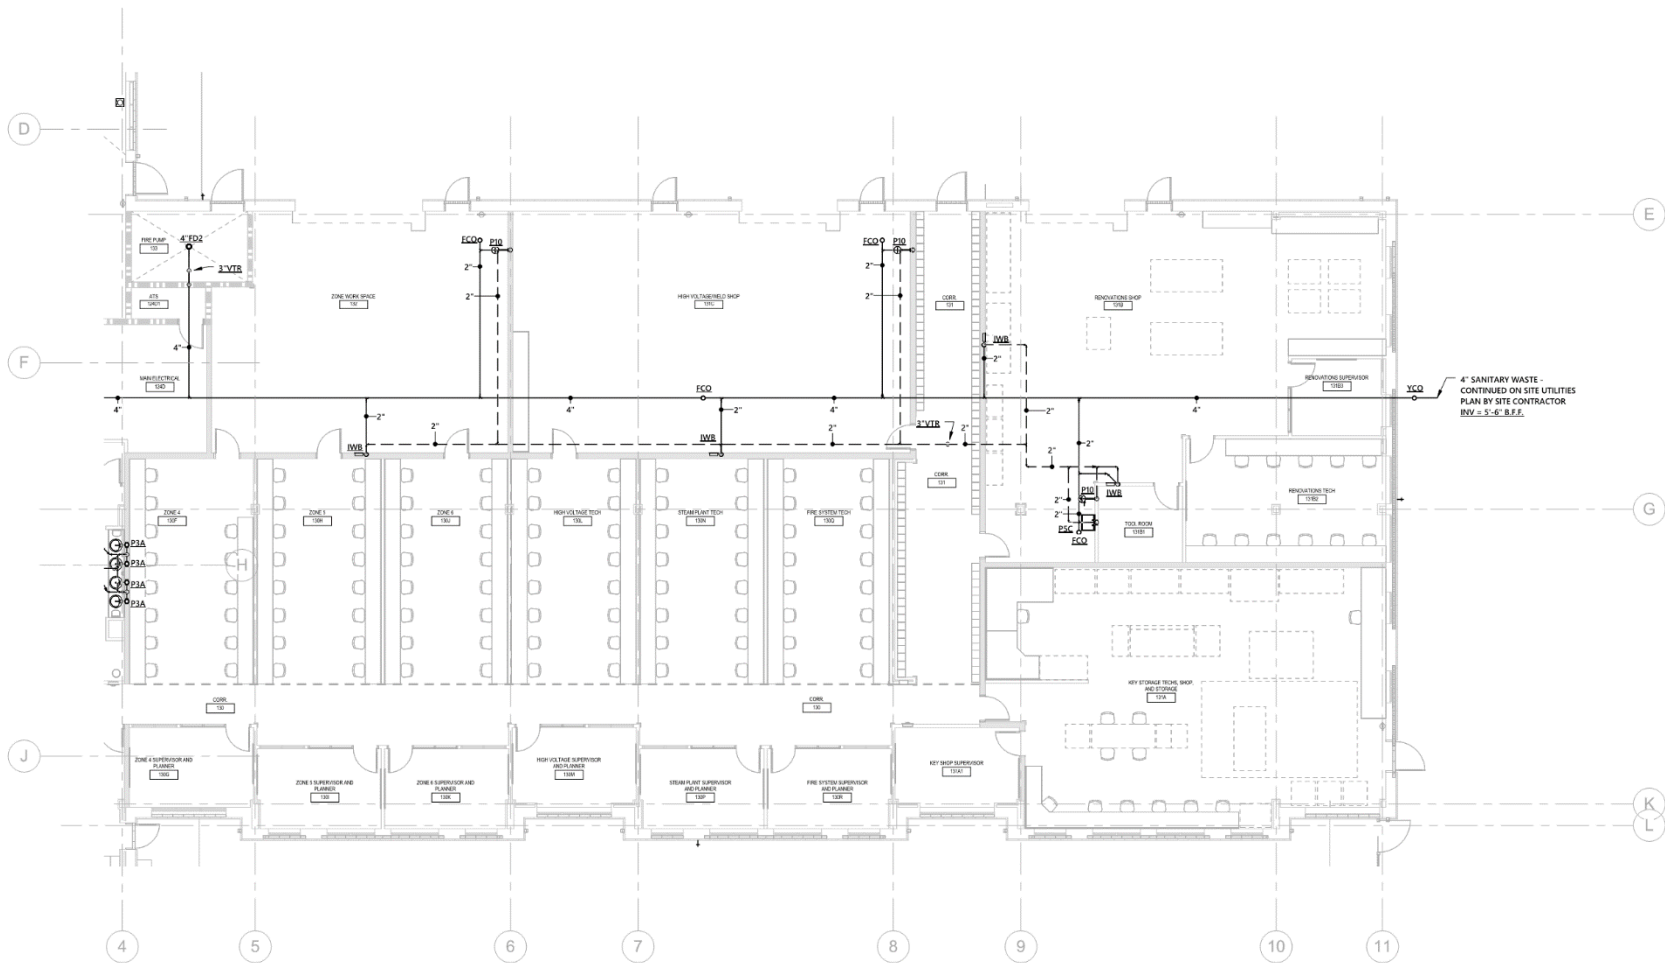


Plumbing - Warehouse

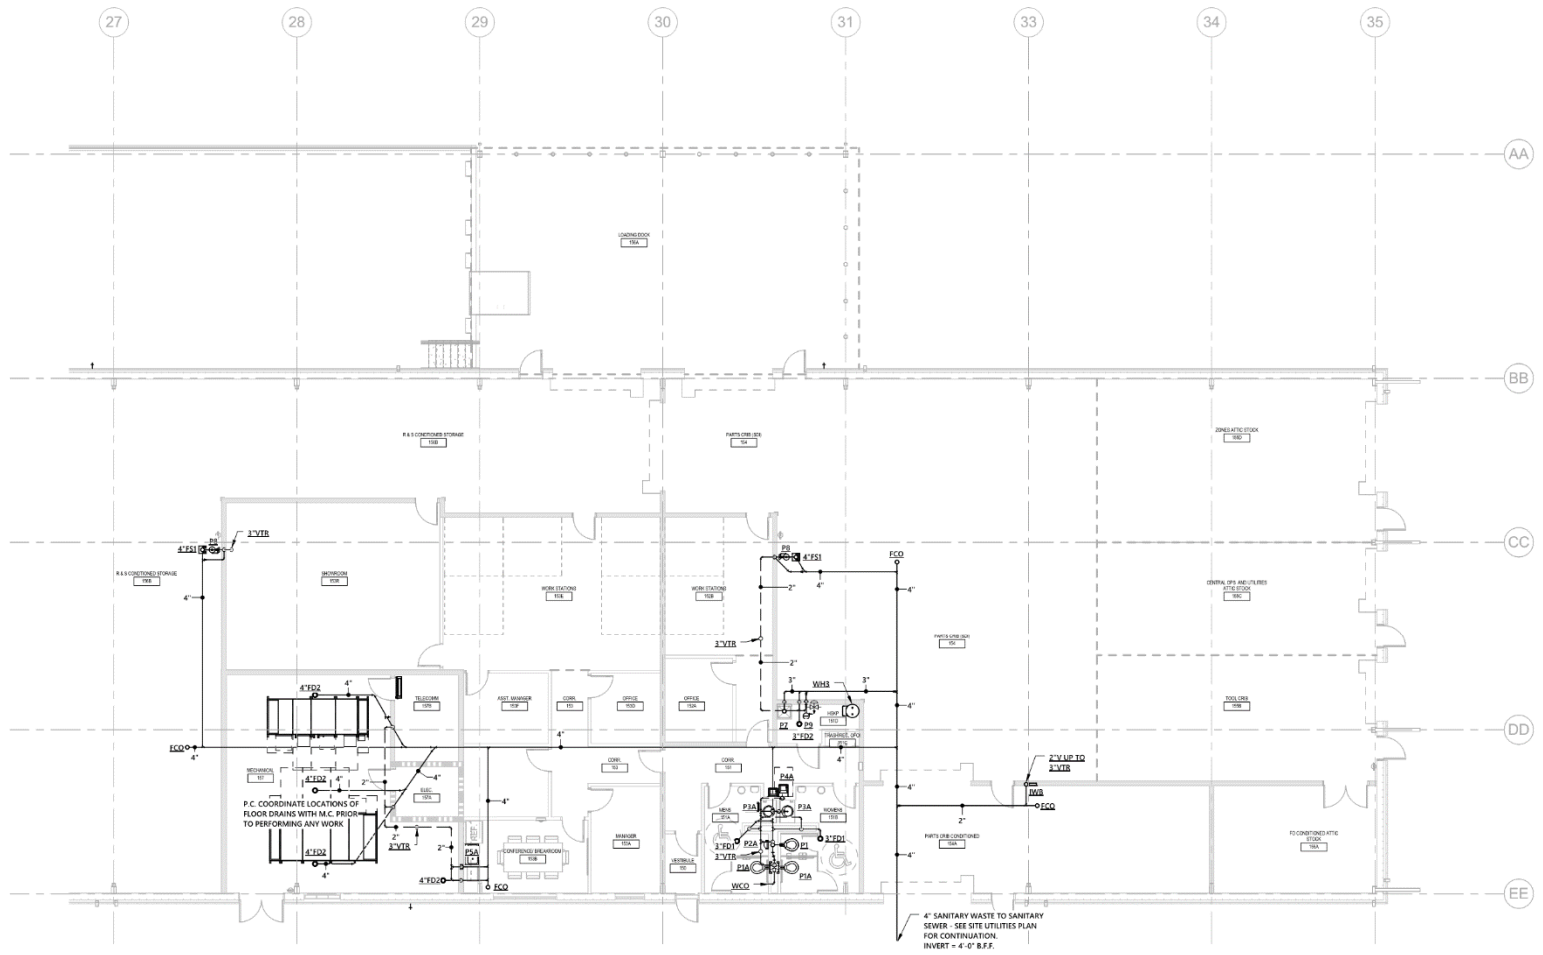



Mechanical – Site

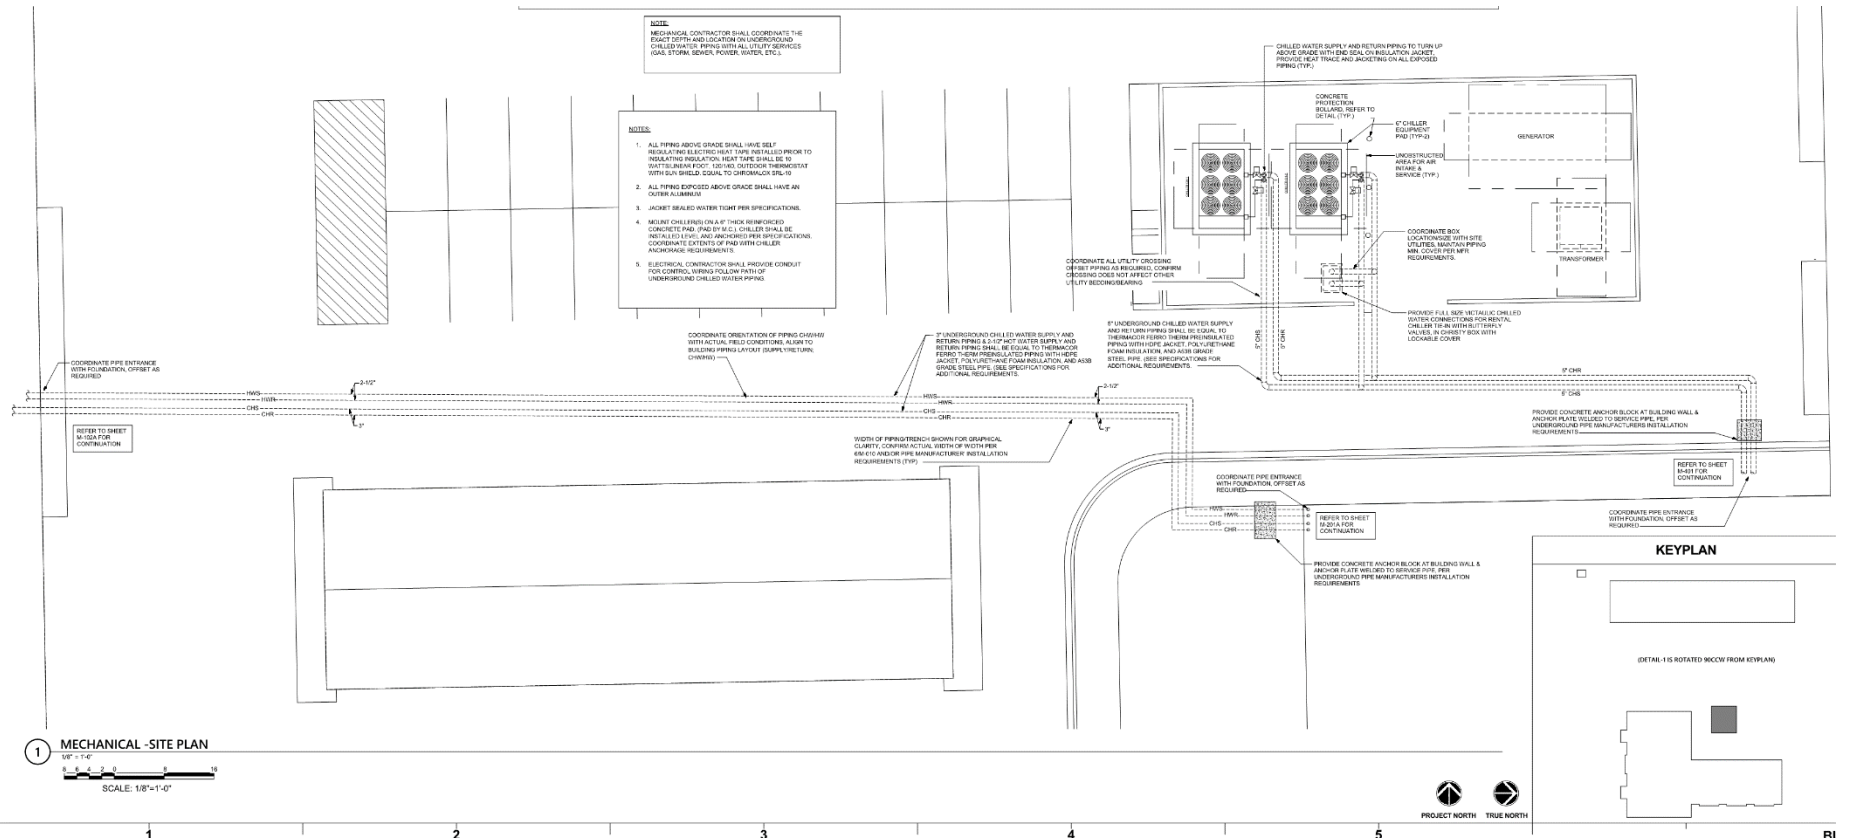


Mechanical – Office/Shops

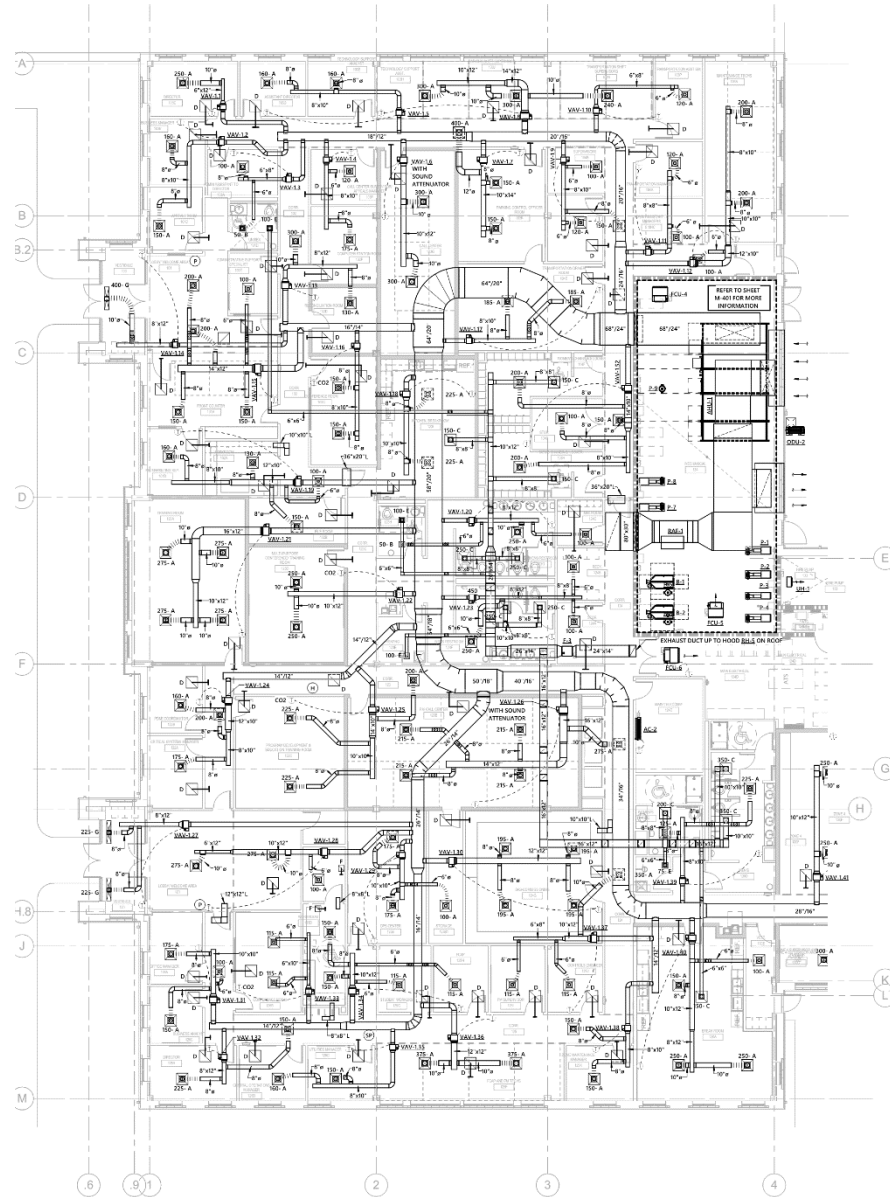


Mechanical - Warehouse

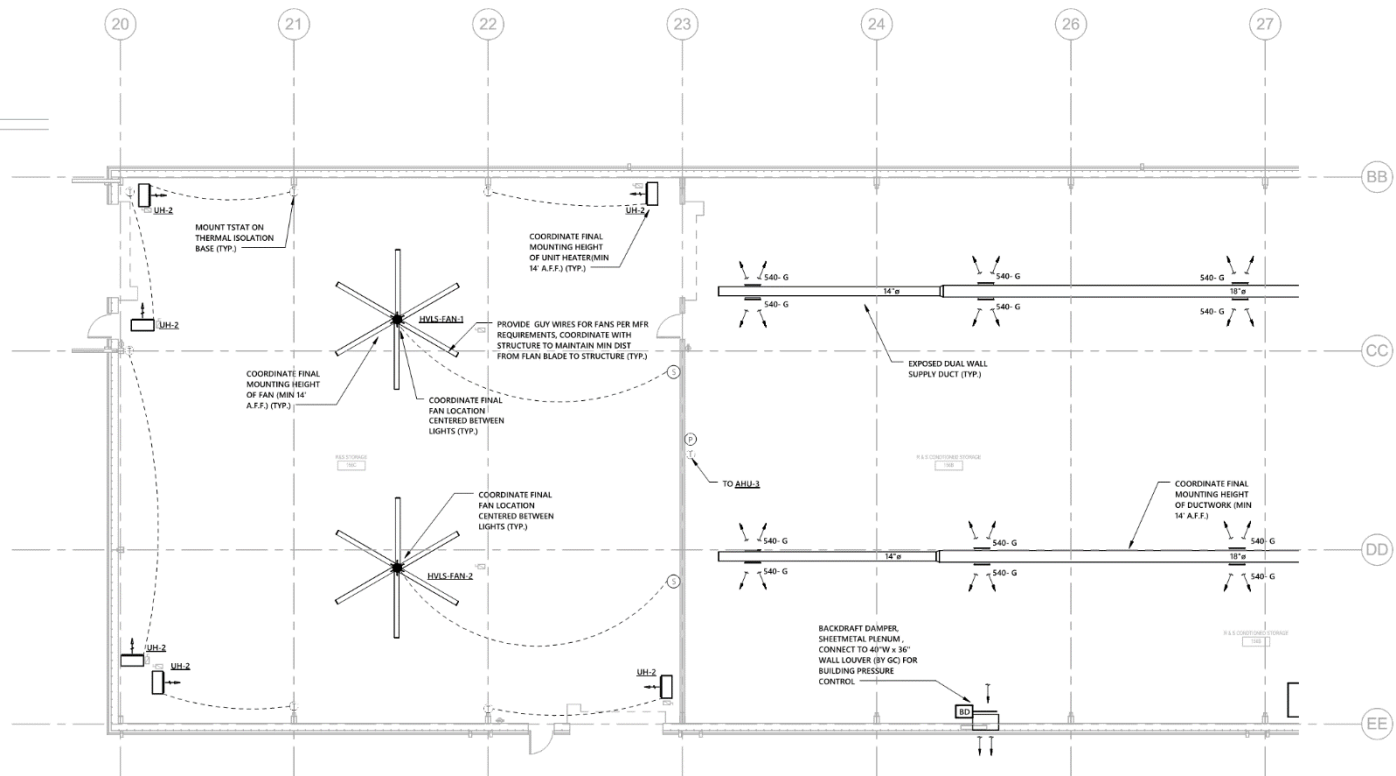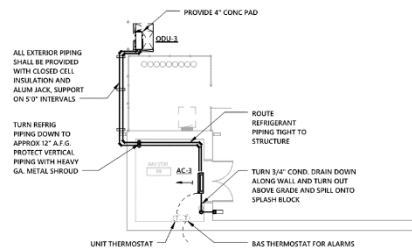


1 FLOOR PLAN - WAREHOUSE - MECHANICAL DUCT - WEST

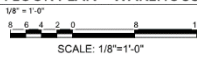


Mechanical - Warehouse

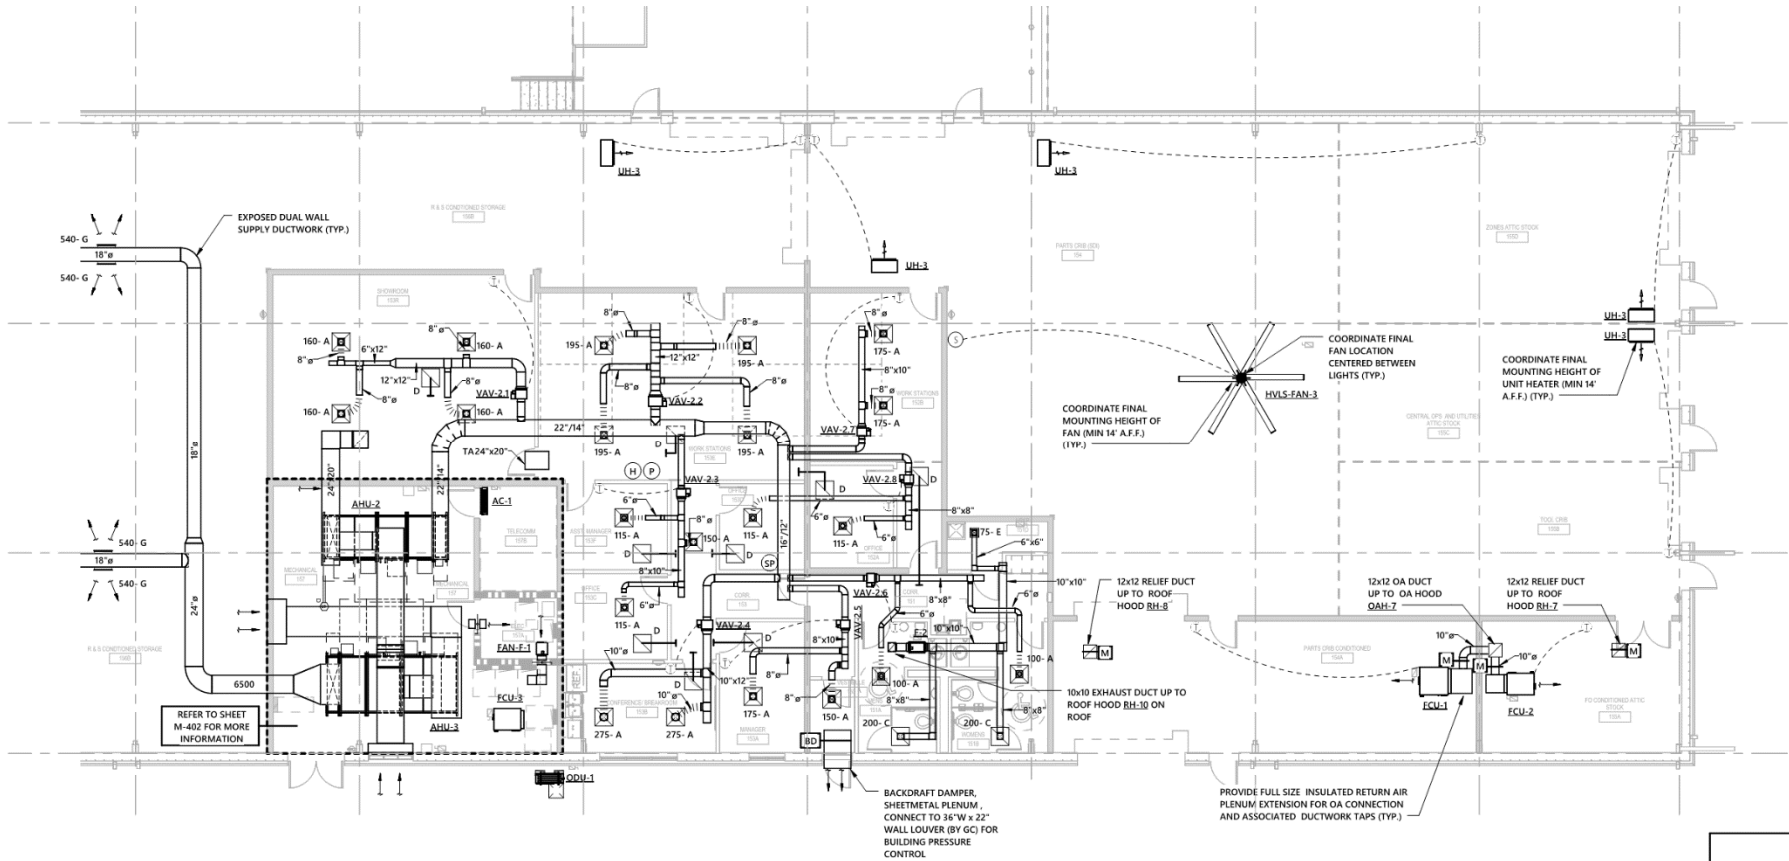


Electrical – Site

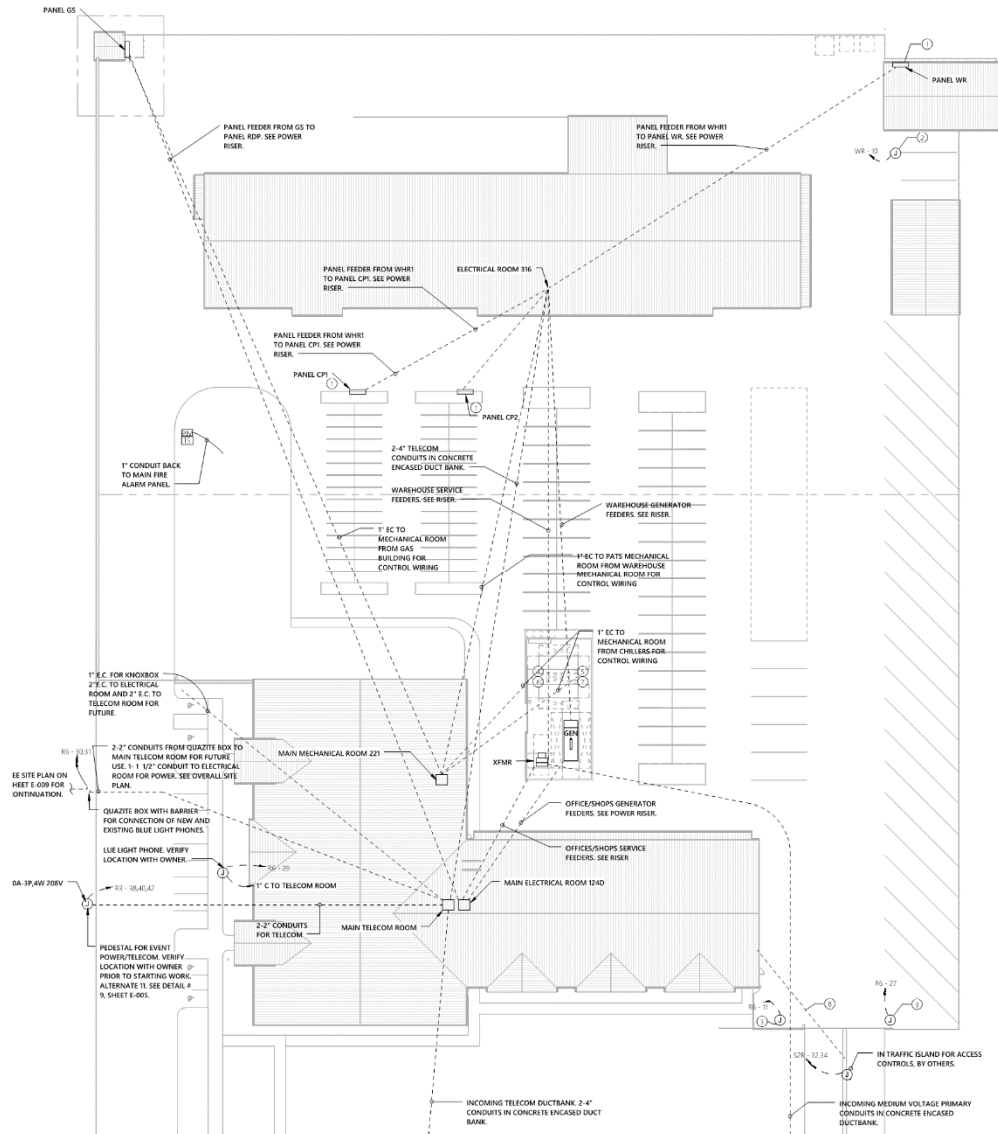

Electrical – Office/Shops

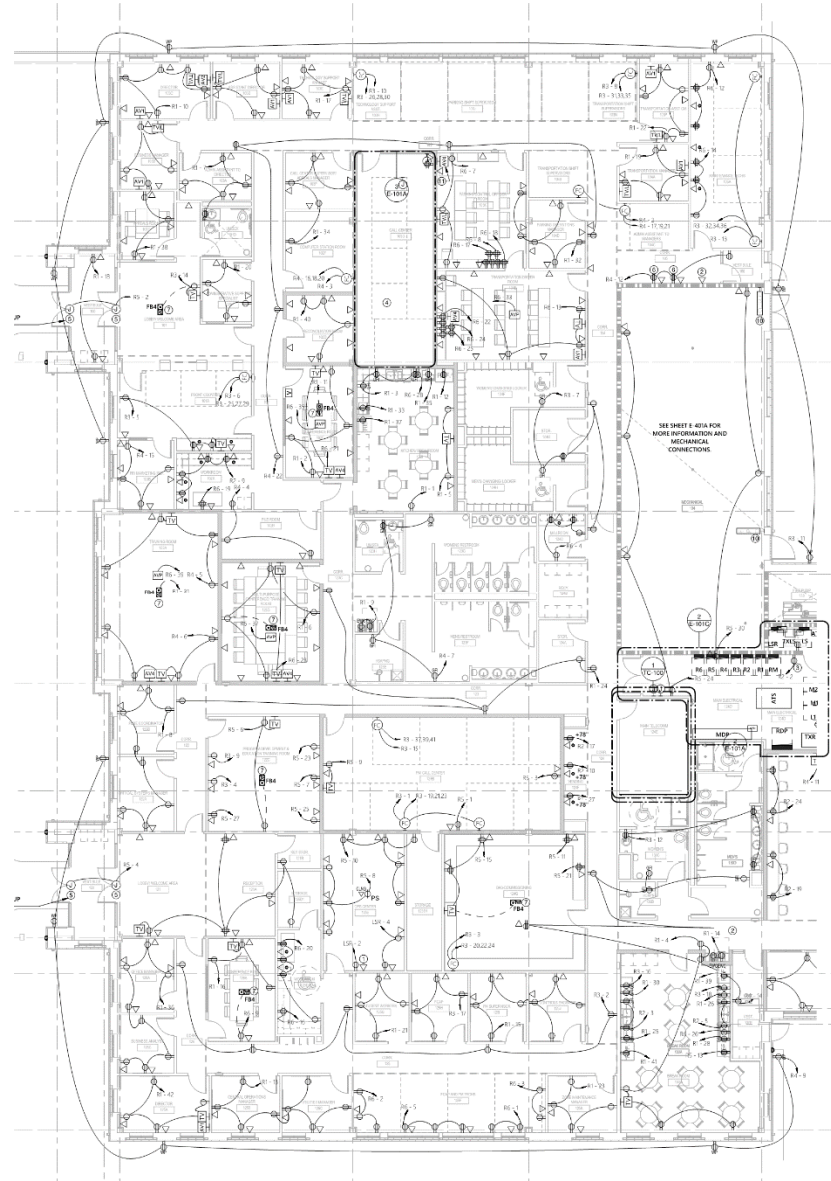


Electrical – Warehouse

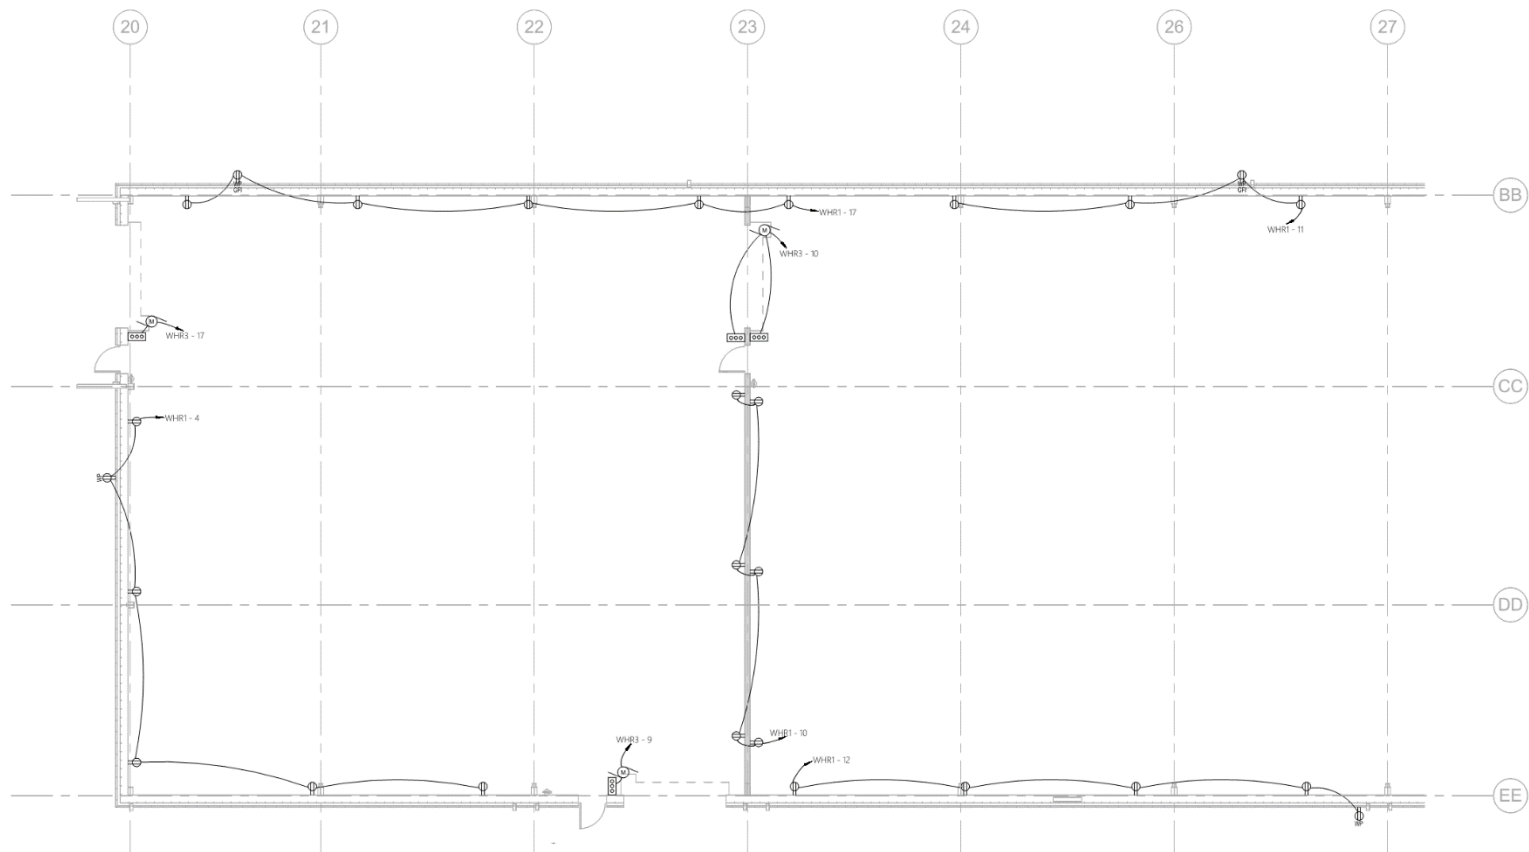


1 FLOOR PLAN - POWER - WAREHOUSE - WEST
1/8" = 1'-0"

Electrical – Warehouse

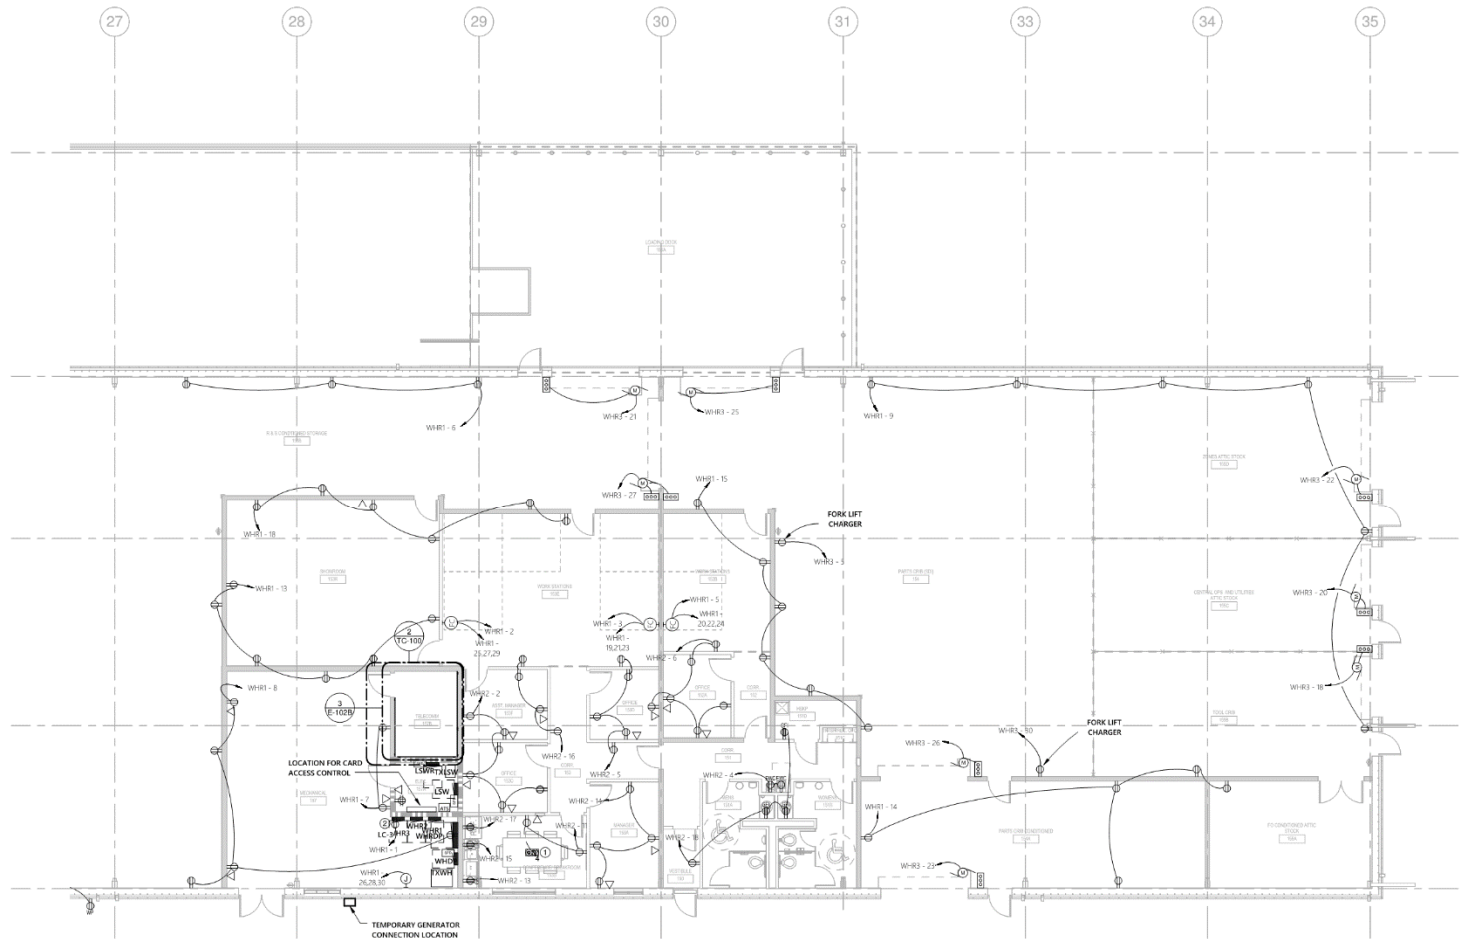

1 FLOOR PLAN - POWER - WAREHOUSE - EAST
WF-1-0'

Electrical – Washrack

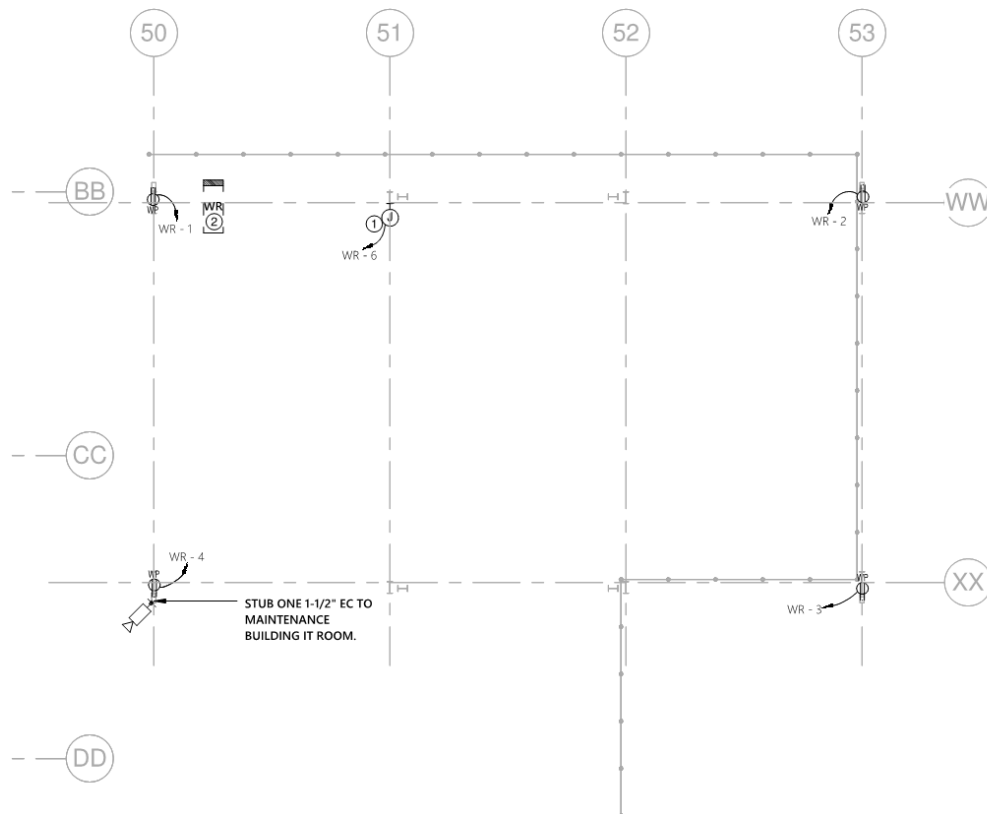

2 FLOOR PLAN - WAREHOUSE - WASH RACK
1/8" = 1'-0"

PROJECT ALTERNATES


Alternate No. 1: Provide brick façade in lieu of metal siding on the south facade of Warehouse building as detailed on the Drawings and described in the Specifications.

Alternate No. 2A: Provide pre-engineered metal canopy for Wash Rack as detailed on the Drawings and described in the Specifications.

Alternate No. 2B: Provide decorative CMU masonry walls, on two sides, and roof for Wash Rack in lieu of pre-engineered metal canopy as detailed on the Drawings and described in the Specifications.

Alternate No. 3: Provide decorative CMU with ribbed interior finish masonry screenwall with precast cap in lieu of chain link fence around Service Yard as detailed on the Drawings and described in the Specifications.

FACILITIES OPERATIONS AND PARKING SERVICES COMPLEX BUILDING PHASE

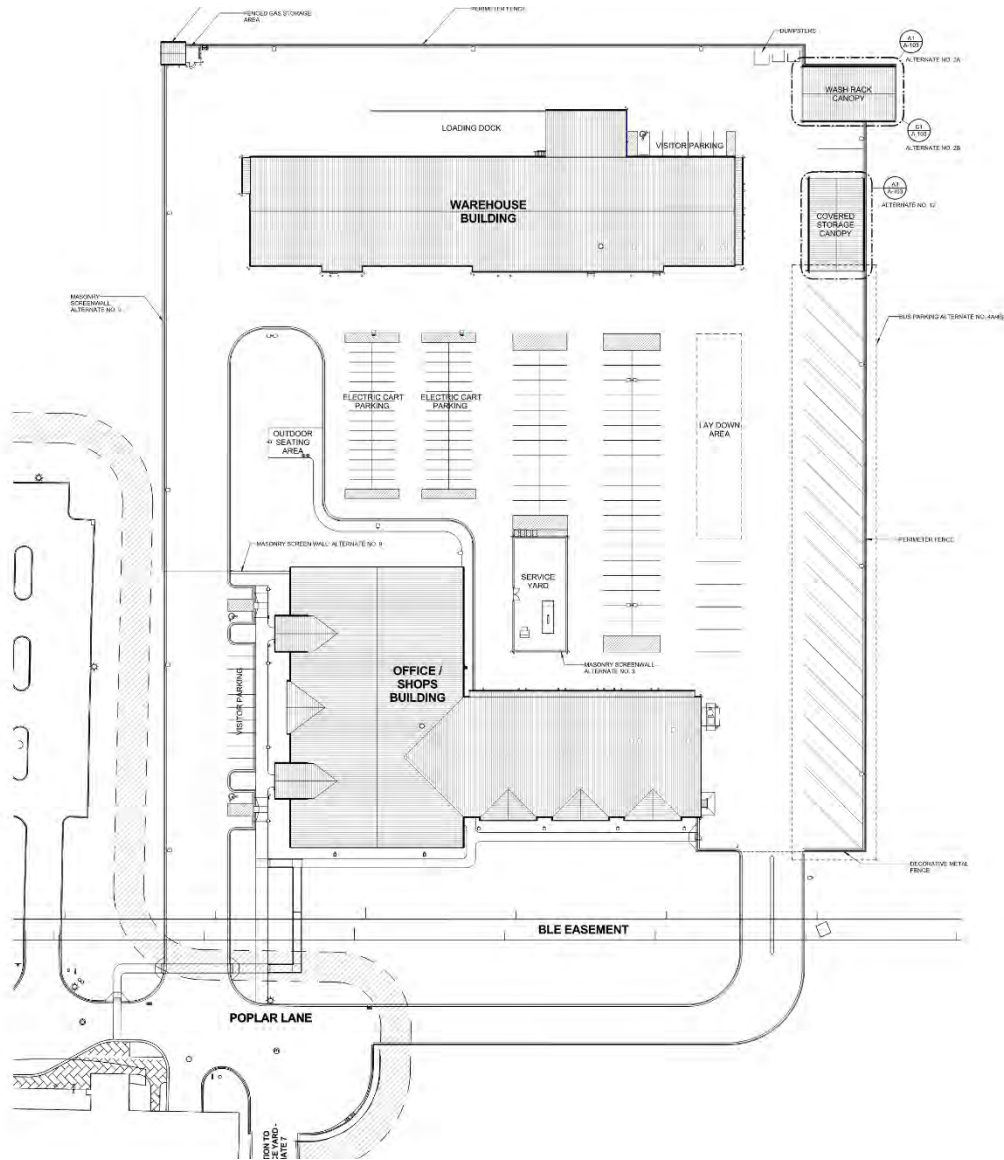

PROJECT ALTERNATES

Alternate No. 8: Extend telecomm infrastructure along Poplar Lane as detailed on the Drawings. Scope of work includes new concrete encased duct bank from existing manhole to new Telecommunications manhole.

Alternate No. 9: Provide decorative CMU masonry screenwall with precast cap in lieu of decorative metal fence along south edge of complex as detailed on the Drawings and described in the Specifications.


Alternate No. 10: Condition shops areas as indicated on the Drawings and described in the Specifications.

Alternate No. 11: Install event power as indicated on the Drawings and described in the Specifications.

Alternate No. 12: Provide pre-engineered metal canopy for Covered Storage as detailed on the Drawings and described in the Specifications.

Alternate No. 13: Provide lightning protection system as described in the specifications.

FACILITIES OPERATIONS AND PARKING SERVICES COMPLEX BUILDING PHASE

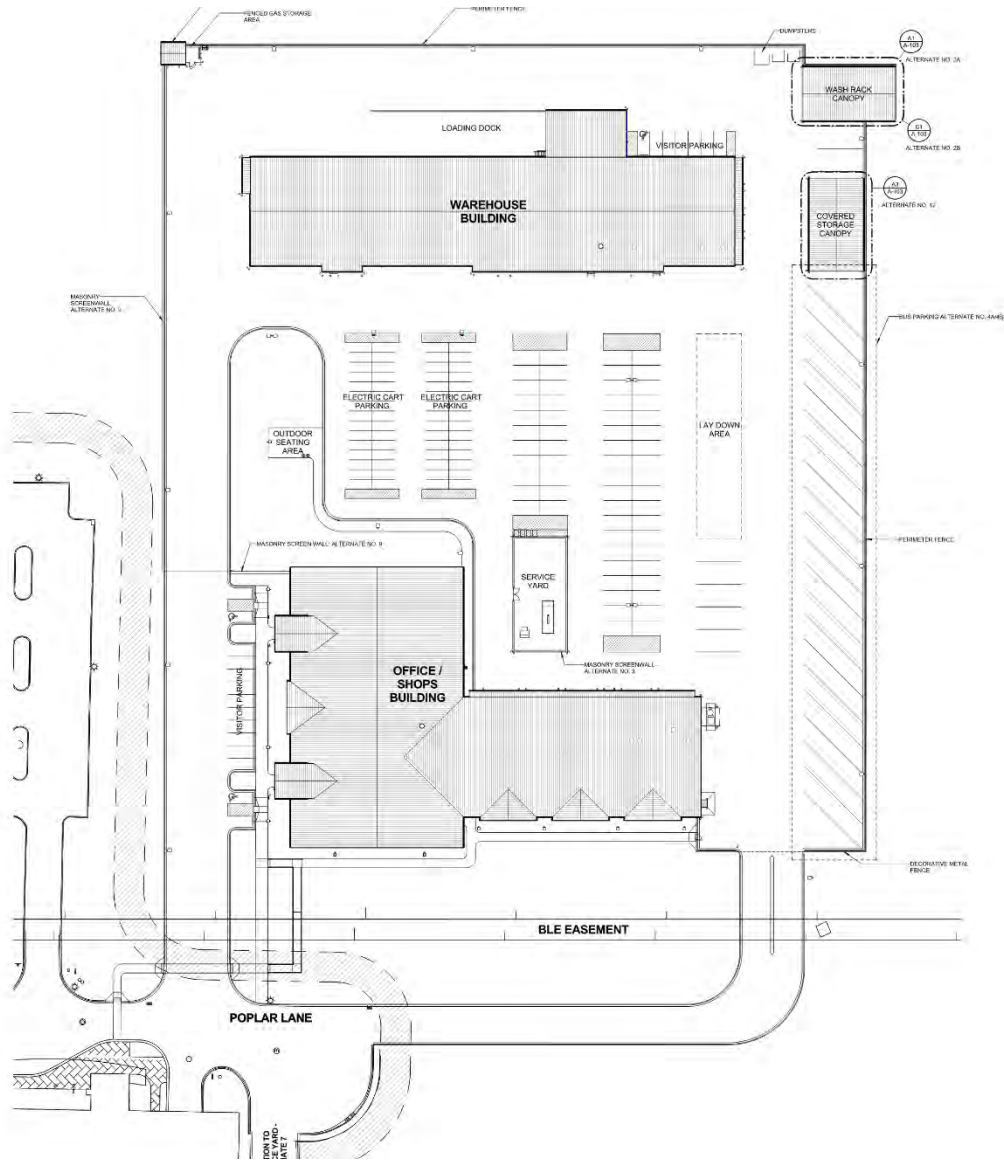

OWNER PREFERRED ALTERNATES

Alternate No. P1: Provide Schlage Locksets, (no substitutions) as described in Specification Section 087100.

Alternate No. P2: Provide Simplex Fire Detection Systems, (no substitutions) as described in Specification Section 283111.

Alternate No. P3: Provide Open Option Systems, (no substitutions) as described in Specification Section 281300.


Alternate No. P4: Provide Hanson Brick, “Morrocroft Special” brick (no substitutions), as described in Specification Section 042000.

Alternate No. P5: Provide Pine Hall, English Edge Pavers, (no substitutions) as described in Specification Section 321400.


CONSTRUCTION DOCUMENTS

- **Charlotte Area**
 - **Sharpe Images** (*Charlotte*)
- **Triad Area**
 - **Sharpe Images** (*Winston-Salem*)
 - **New Atlantic Contracting Office**
 - *Contact Grady Dwiggin to check availability*
- **www.new-atlantic.net**

www.new-atlantic.net

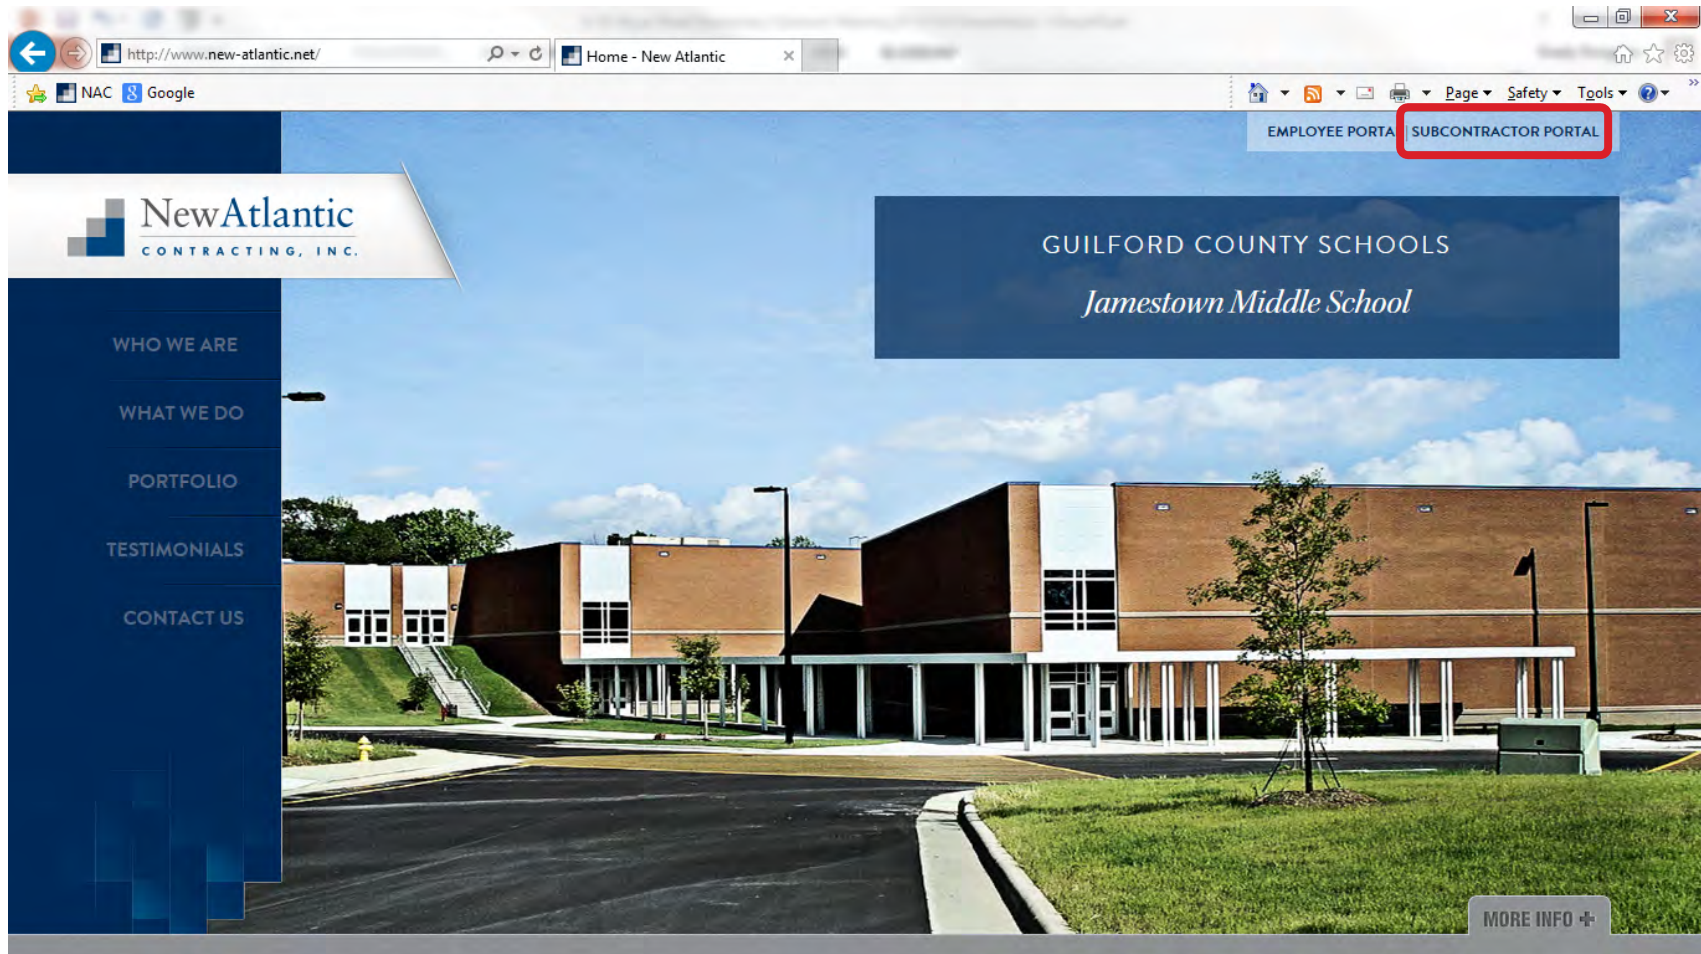

www.new-atlantic.net

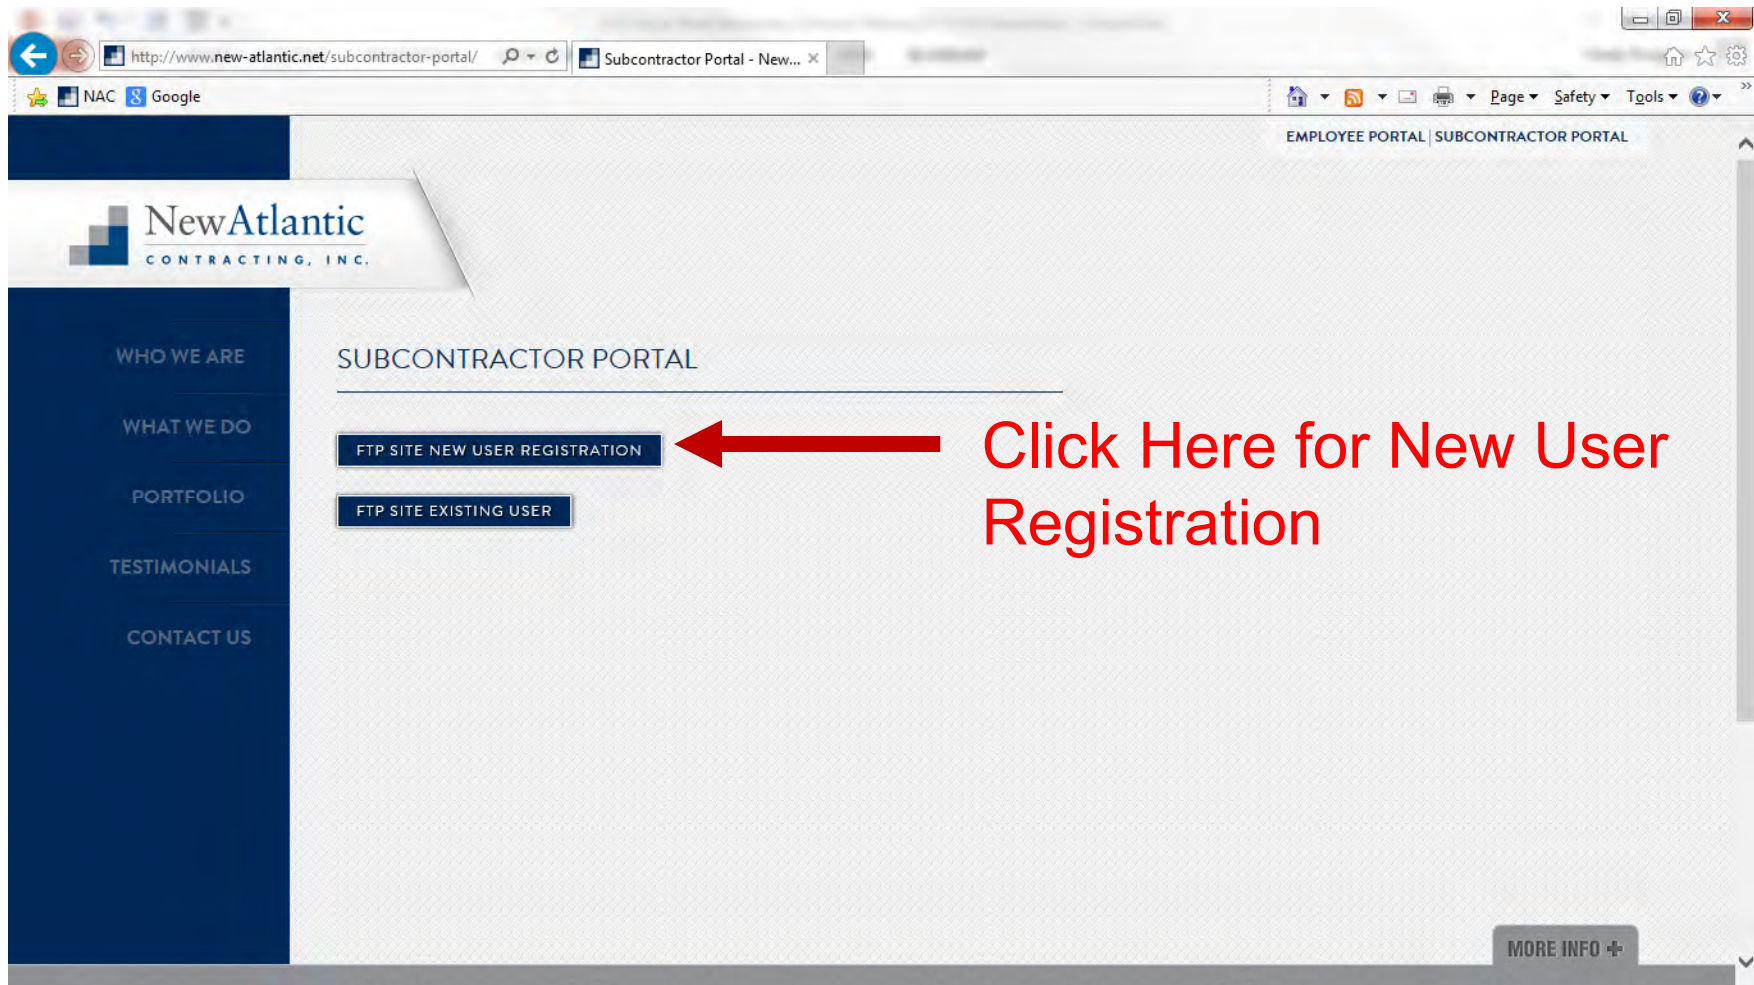

EMPLOYEE PORTAL | SUBCONTRACTOR PORTAL

NewAtlantic
CONTRACTING, INC.

WHO WE ARE

WHAT WE DO

PORTFOLIO

TESTIMONIALS

CONTACT US

SUBCONTRACTOR PORTAL


FTP SITE NEW USER REGISTRATION

FTP SITE EXISTING USER

Click Here for New User Registration

MORE INFO +


www.new-atlantic.net

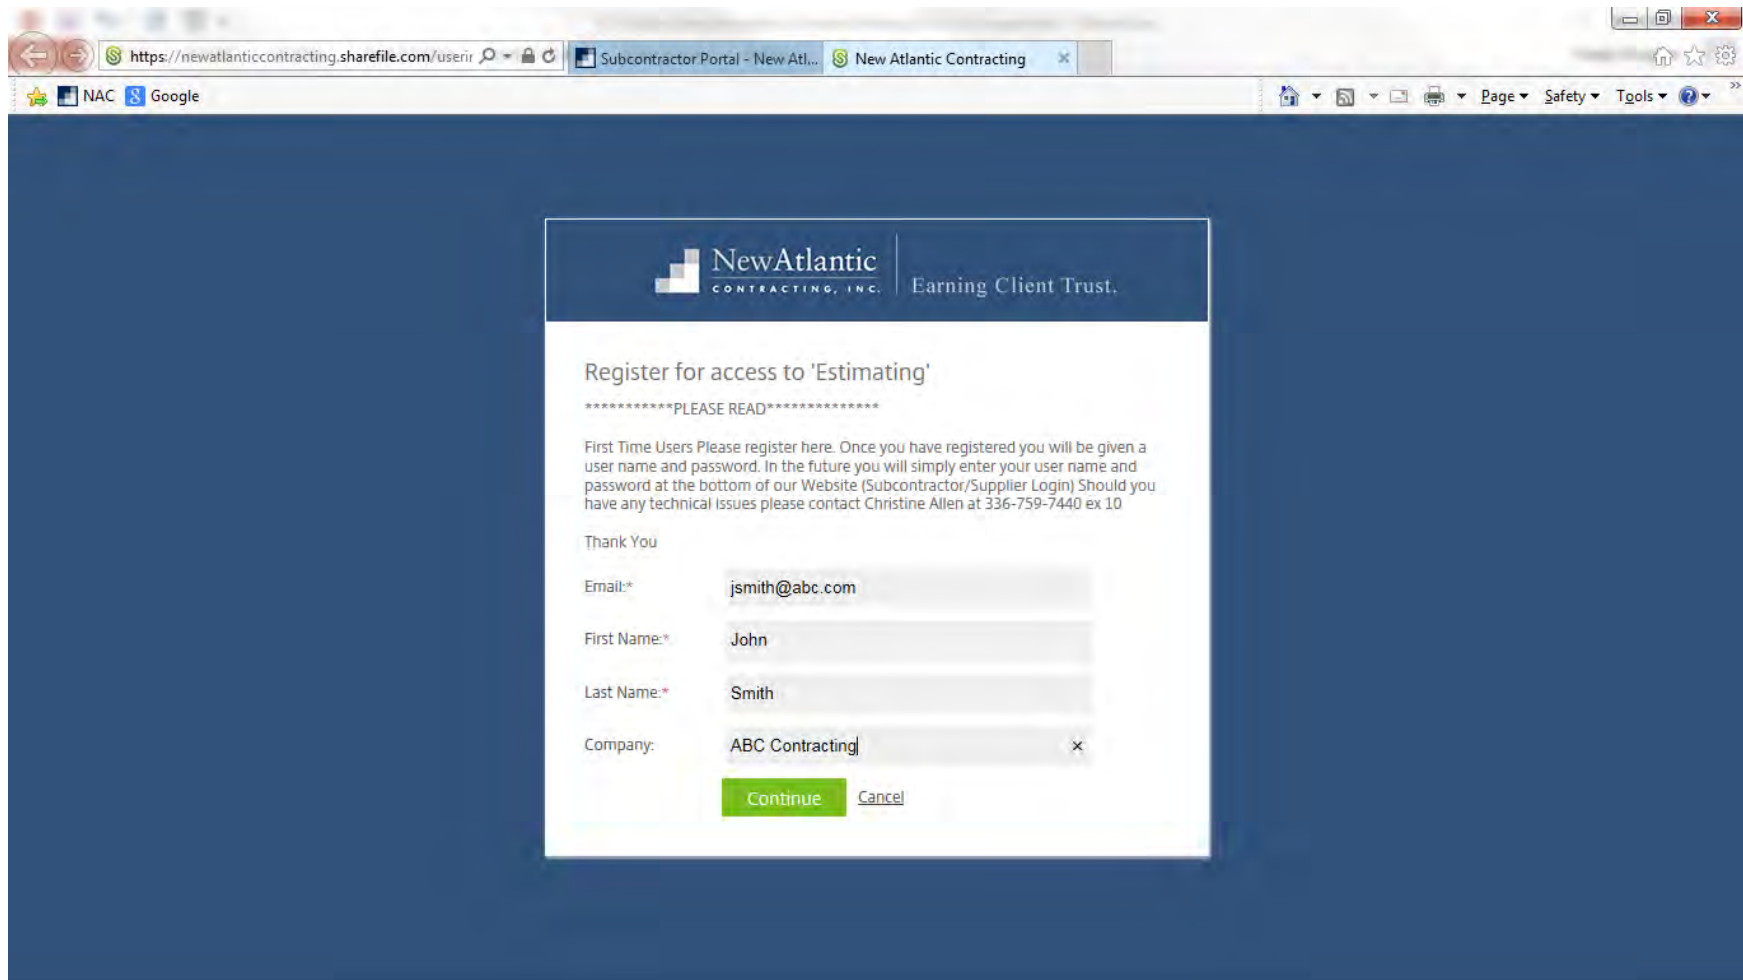

https://newatlanticcontracting.sharefile.com/userir Subcontractor Portal - New Atl... New Atlantic Contracting

NAC Google

Page Safety Tools

 **NewAtlantic**
CONTRACTING, INC. Earning Client Trust.

Register for access to 'Estimating'

*****PLEASE READ*****

First Time Users Please register here. Once you have registered you will be given a user name and password. In the future you will simply enter your user name and password at the bottom of our Website (Subcontractor/Supplier Login) Should you have any technical issues please contact Christine Allen at 336-759-7440 ex 10

Thank You

Email:*


First Name:*

Last Name:*

Company: x

[Cancel](#)

www.new-atlantic.net

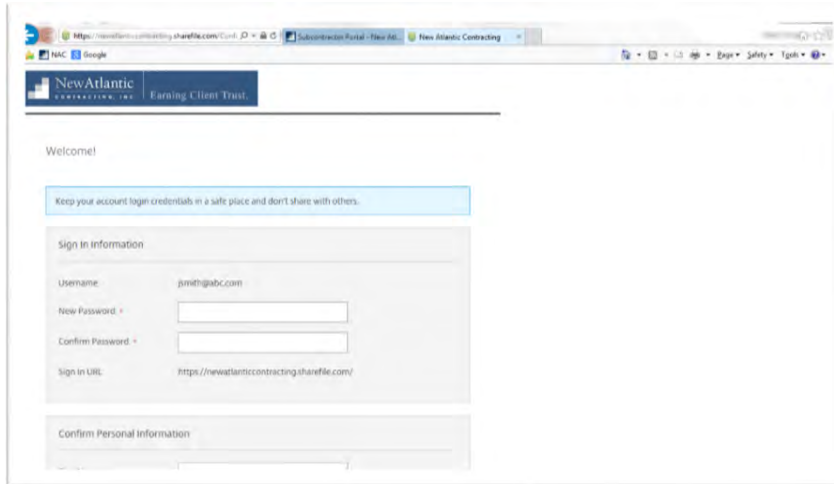

https://newatlanticcontracting.sharefile.com/Cont... | Subcontractor Portal - New At... | New Atlantic Contracting

NewAtlantic
Earning Client Trust

Welcome!

Keep your account login credentials in a safe place and don't share with others.

Sign in information


Username: jsmith@abc.com

New Password:

Confirm Password:

Sign in URL: https://newatlanticcontracting.sharefile.com/

Confirm Personal Information

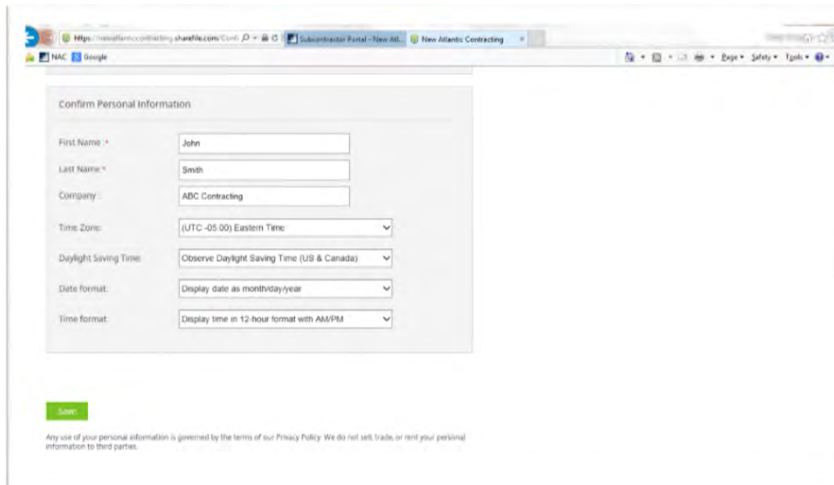

https://newatlanticcontracting.sharefile.com/Cont... | Subcontractor Portal - New At... | New Atlantic Contracting

NewAtlantic
Earning Client Trust

Confirm Personal Information

First Name: John

Last Name: Smith

Company: ABC Contracting

Time Zone: (UTC-05:00) Eastern Time

Daylight Saving Time: Observe Daylight Saving Time (US & Canada)


Date format: Display date as month/day/year

Time format: Display time in 12-hour format with AM/PM

Save

Any use of your personal information is governed by the terms of our Privacy Policy. We do not sell, trade, or rent your personal information to third parties.

www.new-atlantic.net

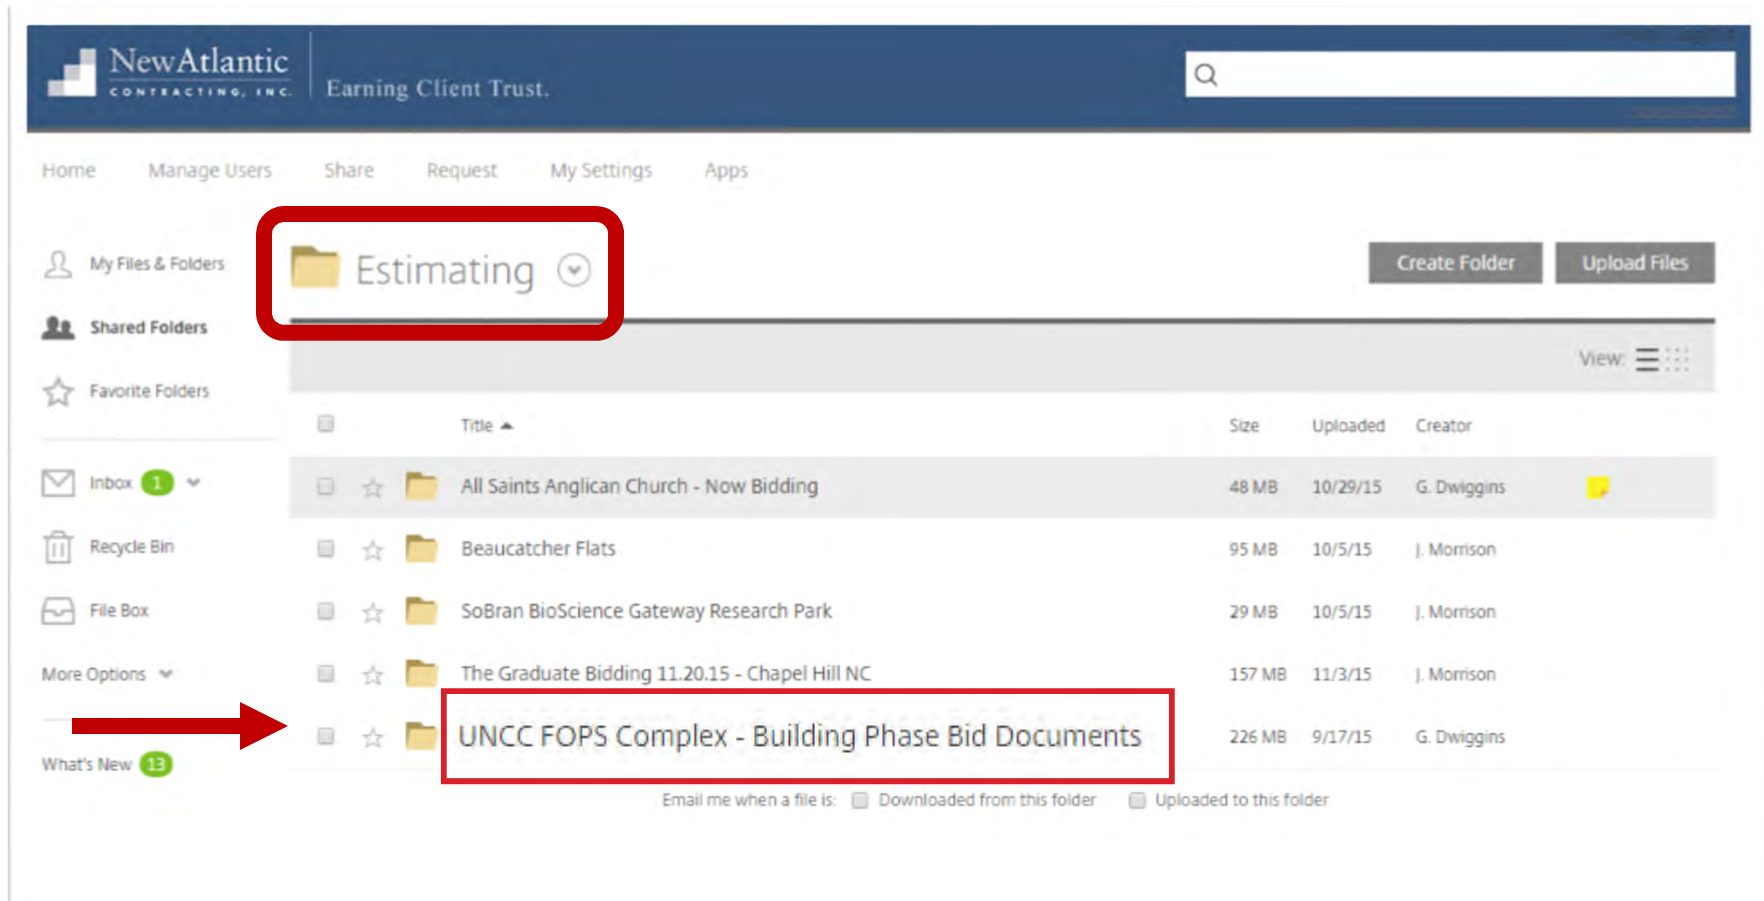

The screenshot displays the NewAtlantic web portal interface. At the top, the logo for NewAtlantic Contracting, Inc. is visible, along with the tagline "Earning Client Trust." and a search bar. The navigation menu includes "Home", "Manage Users", "Share", "Request", "My Settings", and "Apps".

The main content area shows a file management view. On the left, there are sections for "My Files & Folders", "Shared Folders", and "Favorite Folders". The "My Files & Folders" section is active, showing a folder named "Estimating" which is highlighted with a red box. Below this, there is a table of files and folders:

Title	Size	Uploaded	Creator
All Saints Anglican Church - Now Bidding	48 MB	10/29/15	G. Dwiggin
Beaucatcher Flats	95 MB	10/5/15	J. Morrison
SoBran BioScience Gateway Research Park	29 MB	10/5/15	J. Morrison
The Graduate Bidding 11.20.15 - Chapel Hill NC	157 MB	11/3/15	J. Morrison
UNCC FOPS Complex - Building Phase Bid Documents	226 MB	9/17/15	G. Dwiggin

At the bottom of the page, there is a section for "What's New" with a notification badge showing "13". A red arrow points from this section towards the "UNCC FOPS Complex - Building Phase Bid Documents" folder in the table. Below the table, there are options to "Email me when a file is:" with checkboxes for "Downloaded from this folder" and "Uploaded to this folder".

IMPORTANT DATES – PRECONSTRUCTION

- **Deadline for Questions & Substitution Requests**
 - Tuesday – September 5, 2017 @ 5:00pm
- **Last Addendum Issued**
 - Tuesday – September 12, 2017
- **BID OPENING**
 - Tuesday – September 19, 2017 @ 2:00pm

IMPORTANT DATES – PRECONSTRUCTION

- **BID OPENING**
 - **Tuesday – September 19, 2017 @ 2:00pm**
- **Bids may be hand delivered to bid room at bid time**
 - Lucas Room (#341) in the Cone University Center Building
- **Bids may be hand delivered or mailed prior to the bid opening – provided they arrive no later than 1:00pm on day of bid opening**

Addressed to: Ms. Joyce Clay
UNC Charlotte
Facilities Management / Capital Projects
9201 University City Blvd.
Charlotte, NC 28223
Reference: Facilities Operations and Parking Services Complex

REDUCING BARRIERS

- **HUB Goals – 30%**
 - **Focus on Diverse Workforce**
 - **Good Faith Efforts**
- **Bid Packaging**
 - **Building Phase First-Tier Opportunities**
 - **Intentional in creating multiple 2nd & 3rd tier opportunities**
 - Labor, Material Supplier, Equipment Rental, Dumpsters, Drug Testing
- **Quick Pay Arrangements**
 - **Available to Contractors with Cash Flow Demands**
 - On less than monthly basis
- **Joint Check Arrangements**
 - **Resource allows subcontractors to work with material vendors without establishing credit**

REDUCING BARRIERS

- **HUB Compliance**
 - Subcontractor / Supplier ID Form
 - Affidavit A / Affidavit B
 - Post Bid Documentation



FACILITIES OPERATIONS AND PARKING SERVICES COMPLEX BUILDING PHASE

Attach to Bid Attach to Bid Attach to Bid Attach to Bid Attach to Bid Attach to Bid Attach to Bid Attach to Bid

State of North Carolina AFFIDAVIT A - Listing of Good Faith Efforts

County of _____

(Name of Bidder)

Affidavit of _____

I have made a good faith effort to comply under the following areas checked:

Bidders must earn at least 50 points from the good faith efforts listed for their bid to be considered responsive. (1 NC Administrative Code 30 I 0101)

- 1 - (10 pts) Contacted minority businesses that reasonably could have been expected to submit a quote and that were known to the contractor, or available on State or local government maintained lists, at least 10 days before the bid date and notified them of the nature and scope of the work to be performed.
- 2 - (5 pts) Provided minority business with a written request for a quote at least 10 days before the bid date and notified them of the nature and scope of the work to be performed.




Date: _____ Name of Authorized Officer: _____
Signature: _____
Title: _____

State of _____, County of _____
Bidder's Head Office is located at _____ Ave of _____ St
City/Town _____
City/County/State _____



FACILITIES OPERATIONS AND PARKING SERVICES COMPLEX BUILDING PHASE

Attach to Bid Attach to Bid Attach to Bid Attach to Bid Attach to Bid Attach to Bid Attach to Bid Attach to Bid

State of North Carolina --AFFIDAVIT B-- Intent to Perform Contract with Own Workforce.

County of _____

Affidavit of _____
(Name of Bidder)

I hereby certify that it is our intent to perform 100% of the work required for the _____

_____ contract.
(Name of Project)

In making this certification, the Bidder states that the Bidder does not customarily subcontract elements of this type project, and normally performs and has the capability to perform and will perform all elements of the work on this project with its own personnel, resources, and

The Bidder agrees to provide any additional information or documentation requested by the owner to support the above statement. The Bidder agrees to make a good faith effort to utilize minority suppliers where possible.

The undersigned hereby certifies that he or she has read this certification and is authorized and the Bidder is not committing perjury contained.

Date: _____ Name of Authorized Officer: _____

Signature: _____

Title: _____



State of _____, County of _____

Subscribed and sworn to before me this _____ day of _____, 20____.

Notary Public _____

My commission expires _____

BONDING

- **Bid Bonds**
 - Not required for bids under \$500,000
- **Performance & Payment Bonds (P&P)**
 - Required for all “Building Envelope” packages
 - 04A, 07B, 08C, 13A
 - Not required for bids under \$500,000 (*except for the packages listed above*)
 - Bid P&P bonds as add alternate



FACILITIES OPERATIONS AND PARKING SERVICES COMPLEX BUILDING PHASE

FORM OF PROPOSAL

University of North Carolina at Charlotte
Facilities Operations and Parking Services Complex
Early Site / Structural Phase

Bidding Contractor: _____

NC License #: _____

Date: _____

COMPLIANCE STATEMENT

I hereby acknowledge that I have read and accept the complete Bidders Manual dated June 18, 2017. I acknowledge these documents in their entirety and agree that, if awarded a subcontract, these documents will be signed and executed as-is with no modifications. The undersigned bidder proposes to furnish all labor, materials, equipment, engineering, permits, fees, taxes, insurance, scaffolding, hoisting, clean-up, safety measures, and supervision and perform all work necessary for the construction of this Trade Package, in accordance with Drawings and Specifications dated 6/15/17 (as itemized in the Bidders Manual), and the addenda noted below for consideration of the following amount:

ADDENDA	Number: _____	Dated: _____
	Number: _____	Dated: _____
	Number: _____	Dated: _____

BASE BID for Bid Package # _____

Show amount both in words and figures.

_____ Dollars.
\$ _____ .00

ALTERNATE – PAYMENT & PERFORMANCE BOND (if accepted will be an add to base bid)

Show amount both in words and figures.

_____ Dollars.
\$ _____ .00



FACILITIES OPERATIONS AND PARKING SERVICES COMPLEX BUILDING PHASE

ALTERNATES:

Should any of the alternates as described in the contract documents be accepted, the amount written below shall be the amount to be "added to" or "deducted from" the base bid. (Strike out "Add" or "Deduct" as appropriate.)

Show amount both in words and figures.

Alternate No. 1: Provide foundations for brick façade in lieu of metal siding on the south facade of Warehouse building as detailed on the Drawings and described in the Specifications.

(Add) *(Deduct)* _____ Dollars (\$) _____

Alternate No. 2A: Provide foundations for Wash Rack pre-engineered metal canopy as detailed on the Drawings and described in the Specifications.

(Add) *(Deduct)* _____ Dollars (\$) _____

Alternate No. 2B: Provide foundations, for masonry walls, and roof structure for Wash Rack in lieu of pre-engineered metal canopy as detailed on the Drawings and described in the Specifications.

(Add) *(Deduct)* _____ Dollars (\$) _____

Alternate No. 3: Provide foundations for masonry screenwall in lieu of chain link fence around Service Yard as detailed on the Drawings.

(Add) *(Deduct)* _____ Dollars (\$) _____

Alternate No. 4A: Provide Gravel Bus Parking as detailed on the Drawings.

(Add) *(Deduct)* _____ Dollars (\$) _____

Alternate No. 4B: Provide Concrete Bus Parking in lieu of gravel as detailed on the Drawings.

(Add) *(Deduct)* _____ Dollars (\$) _____

Alternate No. 5: Provide Sanitary Dump Station as detailed on the Drawings.

(Add) *(Deduct)* _____ Dollars (\$) _____

Alternate No. 6: Provide Concrete Paving in lieu of Asphalt as detailed on the Drawings.

(Add) *(Deduct)* _____ Dollars (\$) _____

Alternate No. 7: Provide Connection to Facilities Maintenance Yard as detailed on the Drawings.

(Add) *(Deduct)* _____ Dollars (\$) _____



FACILITIES OPERATIONS AND PARKING SERVICES COMPLEX BUILDING PHASE

Alternate No. 8: *Extend telecomm infrastructure along Poplar Lane as detailed on the Drawings. Scope of work includes new concrete encased duct bank from existing manhole to new Telecommunications manhole.*

(Add) *(Deduct)* _____ Dollars (\$) _____

Alternate No. 9: *Provide foundations for masonry screenwall in lieu of decorative metal fence along south edge of complex as detailed on the Drawings.*

(Add) *(Deduct)* _____ Dollars (\$) _____

Alternate No. 12: *Provide foundations for Covered Storage pre-engineered metal canopy as detailed on the Drawings and described in the Specifications.*

(Add) *(Deduct)* _____ Dollars (\$) _____



FACILITIES OPERATIONS AND PARKING SERVICES COMPLEX BUILDING PHASE

UNIT PRICES / QUANTITY ALLOWANCES

Unit prices quoted and accepted shall apply throughout the life of the contract, except as otherwise specifically noted. Unit prices shall be applied, as appropriate, to compute the total value of changes in the base bid quantity of the work all in accordance with the contract documents. Reference Specification Section 012200 - UNIT PRICES for more details.

UP-1: Excavation of Unforeseen Unsuitable Materials, Off-Site Disposal, and Replacement with Off-Site Suitable Fill. Provide removal of unsuitable soils in accordance with Section 310000 and replacement of qualified unsuitable material volume with equal volume of off-site suitable structural fill, which will include purchase, transportation, placement and compaction.

QUANTITY ALLOWANCE 1: Bid Package 2A Base bid proposal to include **500 CY**, to be used at the discretion of the CMAR.

(\$/CY) Unit Price 1 = \$ _____

UP-2: Trench Rock Excavation, Off-Site Disposal, and Replacement with Off-Site Suitable Fill.

Include the removal of trench rock including all necessary equipment, material and labor for trench rock excavation and removal off-site. Provide the replacement of trench rock with compacted off-site suitable fill in accordance with Section 312316.26. See Bidder's Manual and Bid Form for quantities to be carried in individual trade package base bids

QUANTIFY ALLOWANCE 2: Bid Package 2A Base bid proposal to include **800 CY**, to be used at the discretion of the CMAR.

(\$/CY) Unit Price 2 = \$ _____

UP-3: Blast Rock Excavation, Off-Site Disposal, and Replacement with Off-Site Suitable Fill.

Include the removal of blast rock including all necessary equipment, material and labor for blast rock excavation and removal off-Site. Provide the replacement of rock with off-site suitable compacted fill in accordance with Section 312316.26.

QUANTITY ALLOWANCE 3: Bid Package 2A Base bid proposal to include **1000 CY**, to be used at the discretion of the CMAR.

(\$/CY) Unit Price 3 = \$ _____

UP-4: Excavation of Unforeseen Unsuitable Soil Materials and Disposal On-Site. Excavation of unsuitable material and disposal on-site. Include removal of unsuitable material quantified by geotechnical engineer and placed on-site in approved location per direction of Owner.

QUANTITY ALLOWANCE 4: Bid Package 2A Base bid proposal to include **500 CY**, to be used at the discretion of the CMAR.

(\$/CY) Unit Price 4 = \$ _____



FACILITIES OPERATIONS AND PARKING SERVICES COMPLEX BUILDING PHASE

UP-5: Cast-in-Place Concrete for Column Footings (Not Reinforced). Cast-in place concrete for column footings. Include placement and finishing of concrete in accordance with applicable project specification sections.

(\$/CY) Unit Price 5 = \$ _____

UP-6: Cast-in-Place Concrete for Column Footings (Not Reinforced). Cast-in place concrete for column footings. Include placement and finishing of concrete in accordance with applicable project specification sections.

(\$/CY) Unit Price 5 = \$ _____

UP-7: Cast-in-Place Concrete for Column Footings (Not Reinforced). Cast-in place concrete for column footings. Include placement and finishing of concrete in accordance with applicable project specification sections.

(\$/CY) Unit Price 5 = \$ _____



FACILITIES OPERATIONS AND PARKING SERVICES COMPLEX BUILDING PHASE

Proposal Signature Page

The undersigned further agrees that in the case of failure on his part to execute the said contract and the bonds within ten (10) consecutive calendar days after being given written notice of the award of contract, the certified check, cash or bid bond accompanying this bid shall be paid into the funds of the owner's account set aside for the project, as liquidated damages for such failure; otherwise the certified check, cash or bid bond accompanying this proposal shall be returned to the undersigned.

Respectfully submitted this day of _____

(Name of firm or corporation making bid)

WITNESS:

(Proprietorship or Partnership)

By: _____
Signature

Name: _____
Print or type

Title _____
(Owner/Partner/Pres./V.Pres)

Address _____

ATTEST:

By: _____

Title: _____
(Corp. Sec. or Asst. Sec. only)

License No. _____

Federal I.D. No. _____

Email Address: _____

(CORPORATE SEAL)

PROJECT MILESTONES *(start dates)*

- **Bid date:** September 19, 2017
- **Roofing:** January 3, 2018
- **MEPF OH Rough-in:** January 12, 2018
- **Masonry:** January 24, 2018
- **Framing:** February 2, 2018
- **Storefront/Glass:** February 7, 2018
- **Main Mechanical Room / Electrical:** February 21, 2018
- **Pre-Engineered Building:** March 6, 2018
- **Permanent Power:** March 13, 2018
- **Drywall:** March 16, 2018
- **Ceilings & Casework:** June 1, 2018
- **Flooring:** June 18, 2018
- **T&B:** June 22, 2018
- **Doors/Hardware & Paint:** June 25, 2018
- **SCO Final Inspections:** August 27, 2018

Questions?

Site Visit Available

**UNC Charlotte - Poplar Lane
North of Lot 25**

DIRECTIONS

- ↑ Head northwest on Mary Alexander Rd toward McEniry Ln
0.3 mi
- ↶ Turn left onto Cameron Blvd
0.2 mi
- ↷ Turn right onto Poplar Ln
Destination will be on the left

9628 Poplar Lane
Charlotte, NC
28223

